


- New manholes (3)
- New sewer line
- To be removed
- Expanded or new sewer easement

**PRELIMINARY
PLANS
NOT FOR
CONSTRUCTION**

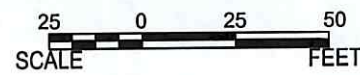

Rev'd.		SHEET NO.	
ALKALI CREEK ROAD		1	
MAINTENANCE AND SLOPE RECONSTRUCTION			
CITY OF BILLINGS, MT W.O. 04-12 - PHASE 3			
Kadmas Lee & Jackson		SEWER EXHIBIT	
ENGINEERS	DRWN. BY	CHK'D BY	PROJECT NO.
Surveyors	WCS	CCJ	2403126
Planners			DATE
© Kadmas, Lee & Jackson 2009			