


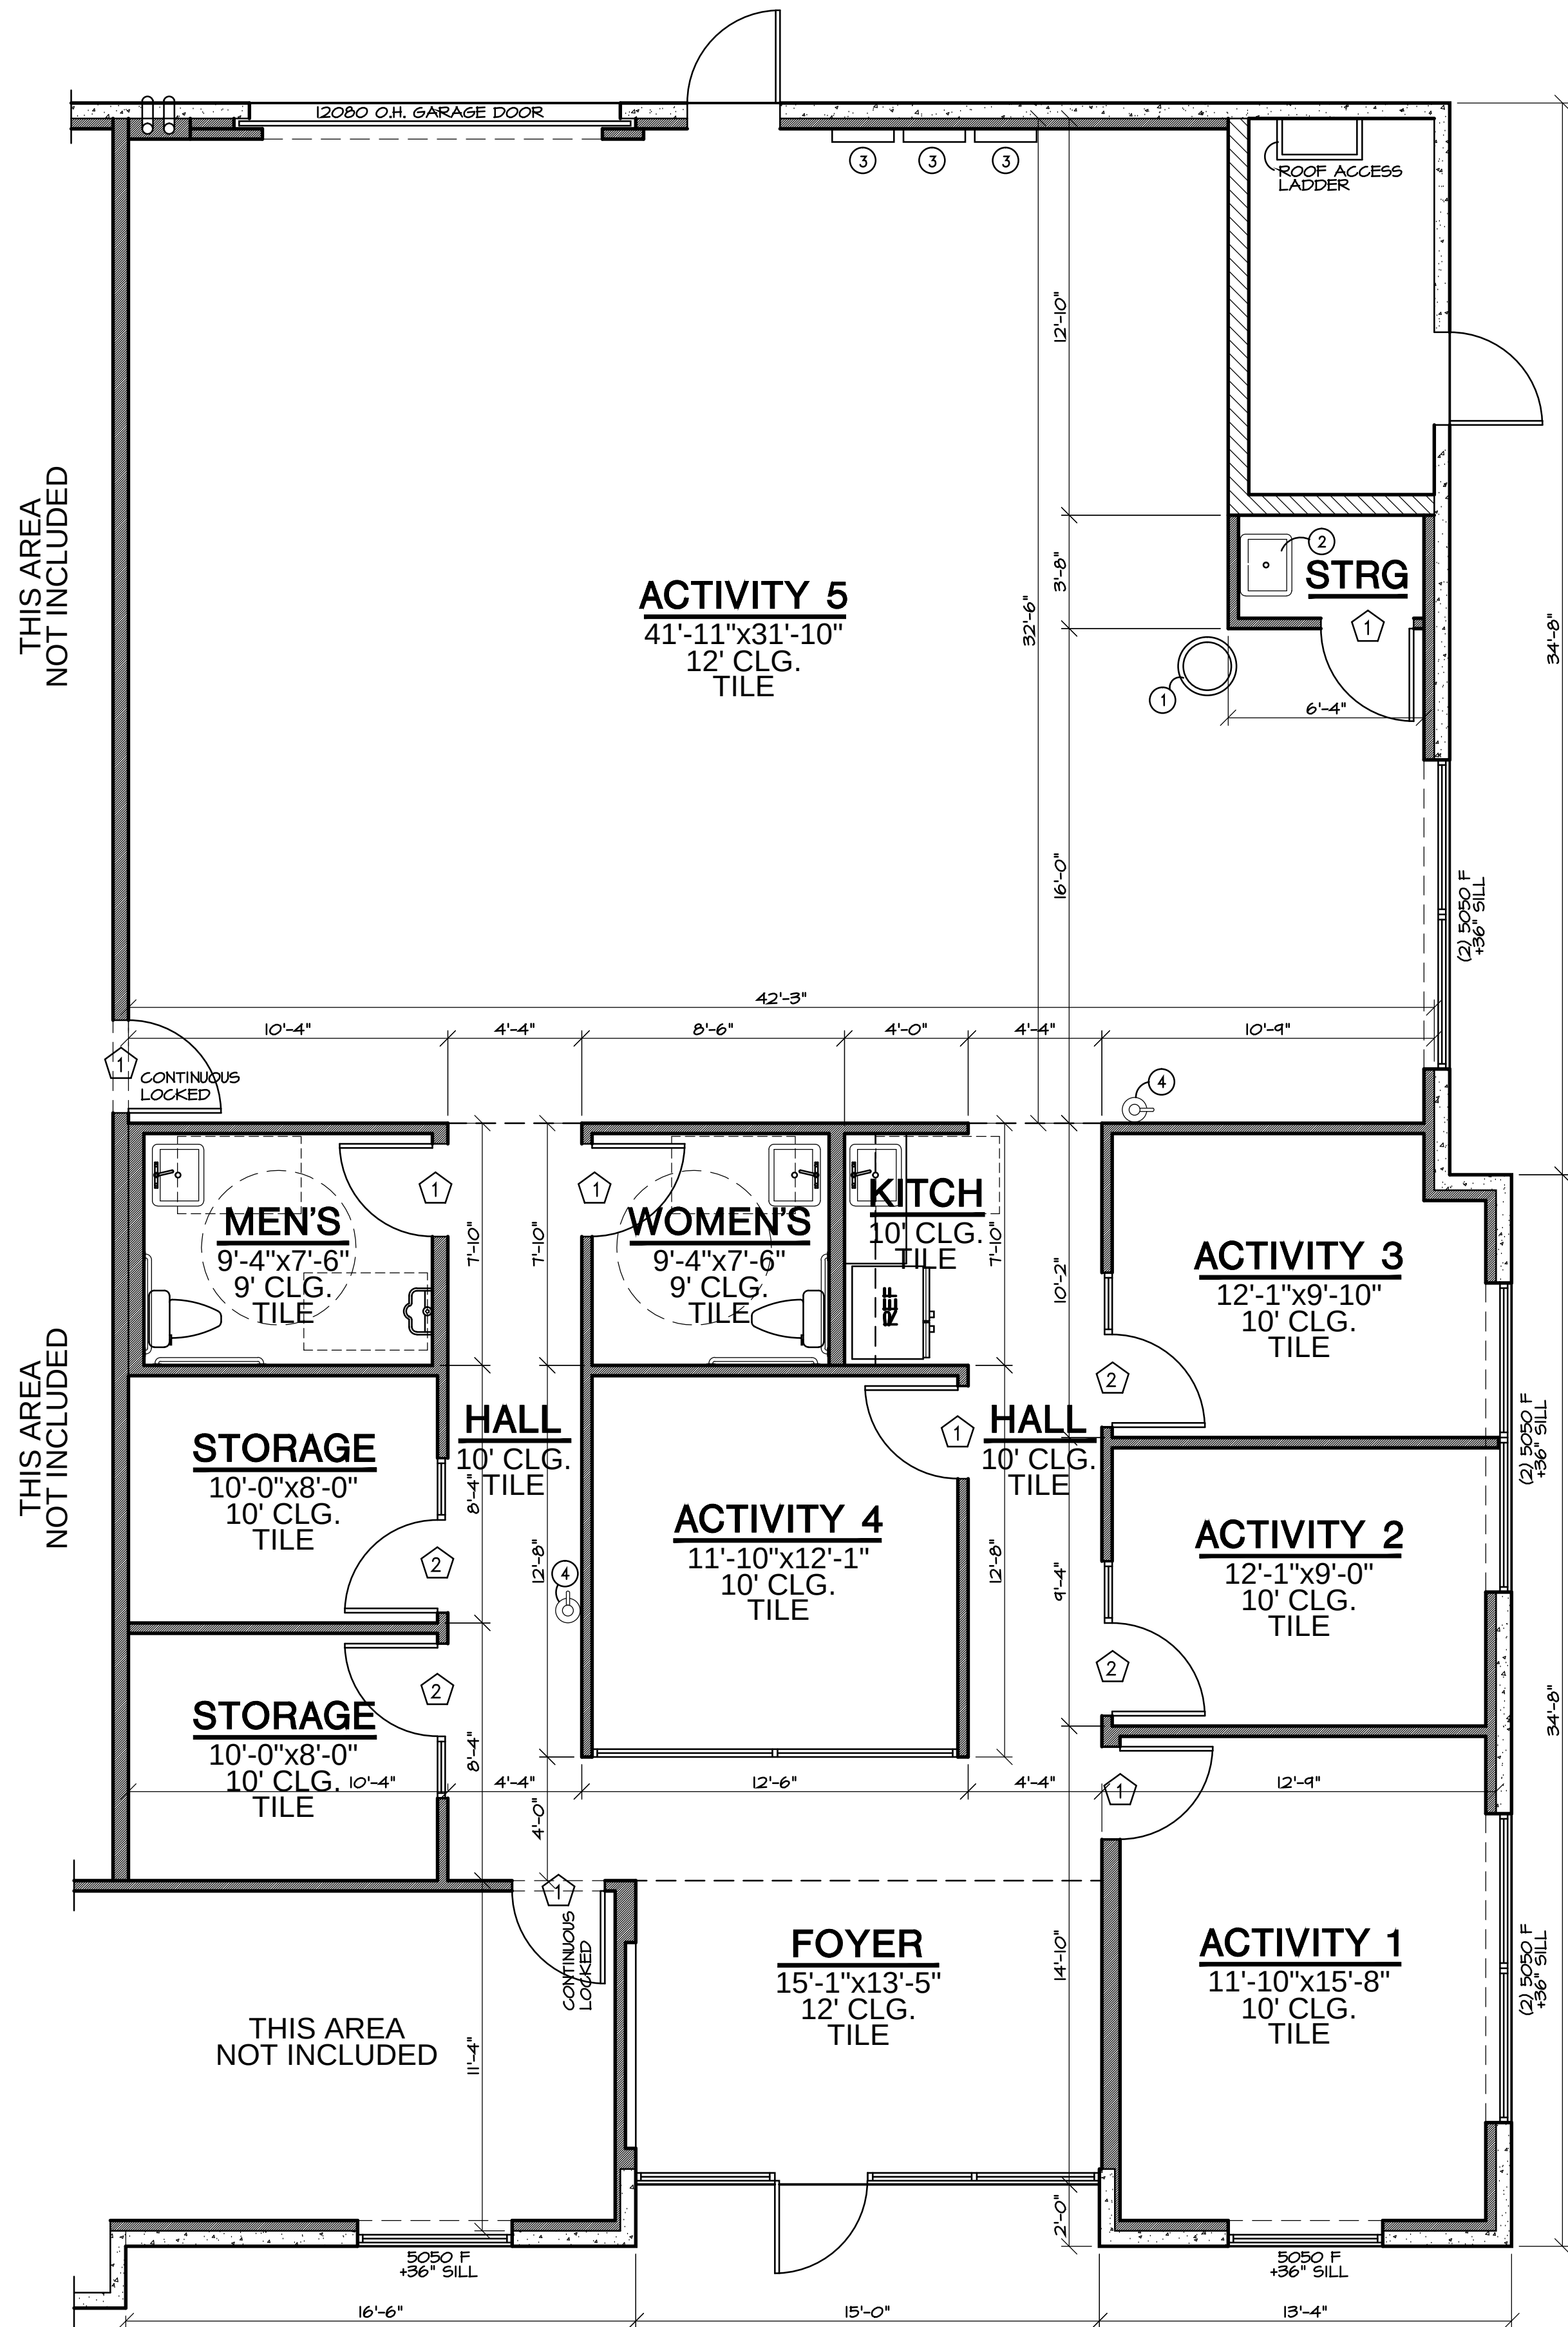

DOOR SCHEDULE (EXISTING)									
No.	DOOR			TYPE	MAT.	FINISH	FRAME		REMARKS
	WIDTH	HEIGHT	TH.				MAT.	FINISH	
1	3'-0"	7'-0"	1-3/4"	A	AL/GL	S#V	ALUM	MFR	LEVER
2	3'-0"	7'-0"	1-3/4"	B	SCWD	S#V	ALUM	MFR	LEVER

D.S.K., Design LLC

ARCHITECTURAL
DESIGNS
DRAFTING

EST. 1987
dsk_inc@msn.com

(o) 480.888.1336 (c) 480.518.0006

No.	DATE	REVISIONS
1		
2		
3		
4		

KEYED - NOTES :

- 1 - WATER COOLER
- 2 - FLOOR SINK
- 3 - ELECTRICAL PANELS
- 4 - FIRE EXTINGUISHER
- 5 -
- 6 -
- 7 -
- 8 -

GENERAL - NOTES :

This drawing is an instrument of service and the property of DSK, and shall remain their property. The use of this drawing shall be restricted to the original site for which it is prepared and publication thereof is expressly limited to such use.

BARNs FAMILY SERVICES
2221 W. PECOS RD., SUITE 2
CHANDLER, AZ 85224

ROCHELLE BARNs
2221 W. PECOS RD., SUITE 12
CHANDLER, AZ 85224
480-720-0887

AS-BUILT
FLOOR PLAN

Project No: 3489
Date: SEPT 2017
Scale: SEE PLAN
Drawn: DSK


Sheet No:
A1

WALL LEGEND	
	EXIST, EXTERIOR CMU WALL
	2x6 METAL STUDS @ 16" O.C. W/ R-19 MIN INSUL. 5/8" G.B. @ INT. OF WALL U.N.O. - SEE ELEVATION FOR EXTERIOR FINISH.
	2x4 METAL STUDS @ 16" O.C. - U.N.O. 5/8" G.B. @ BOTH SIDES OF WALL
	6" CONG. TILT PANEL WALL

SQUARE FOOTAGE	
OFFICE AREA	3483 sq.ft.

FLOOR PLAN - SUITE 2

SCALE: 1/4"=1'-0"

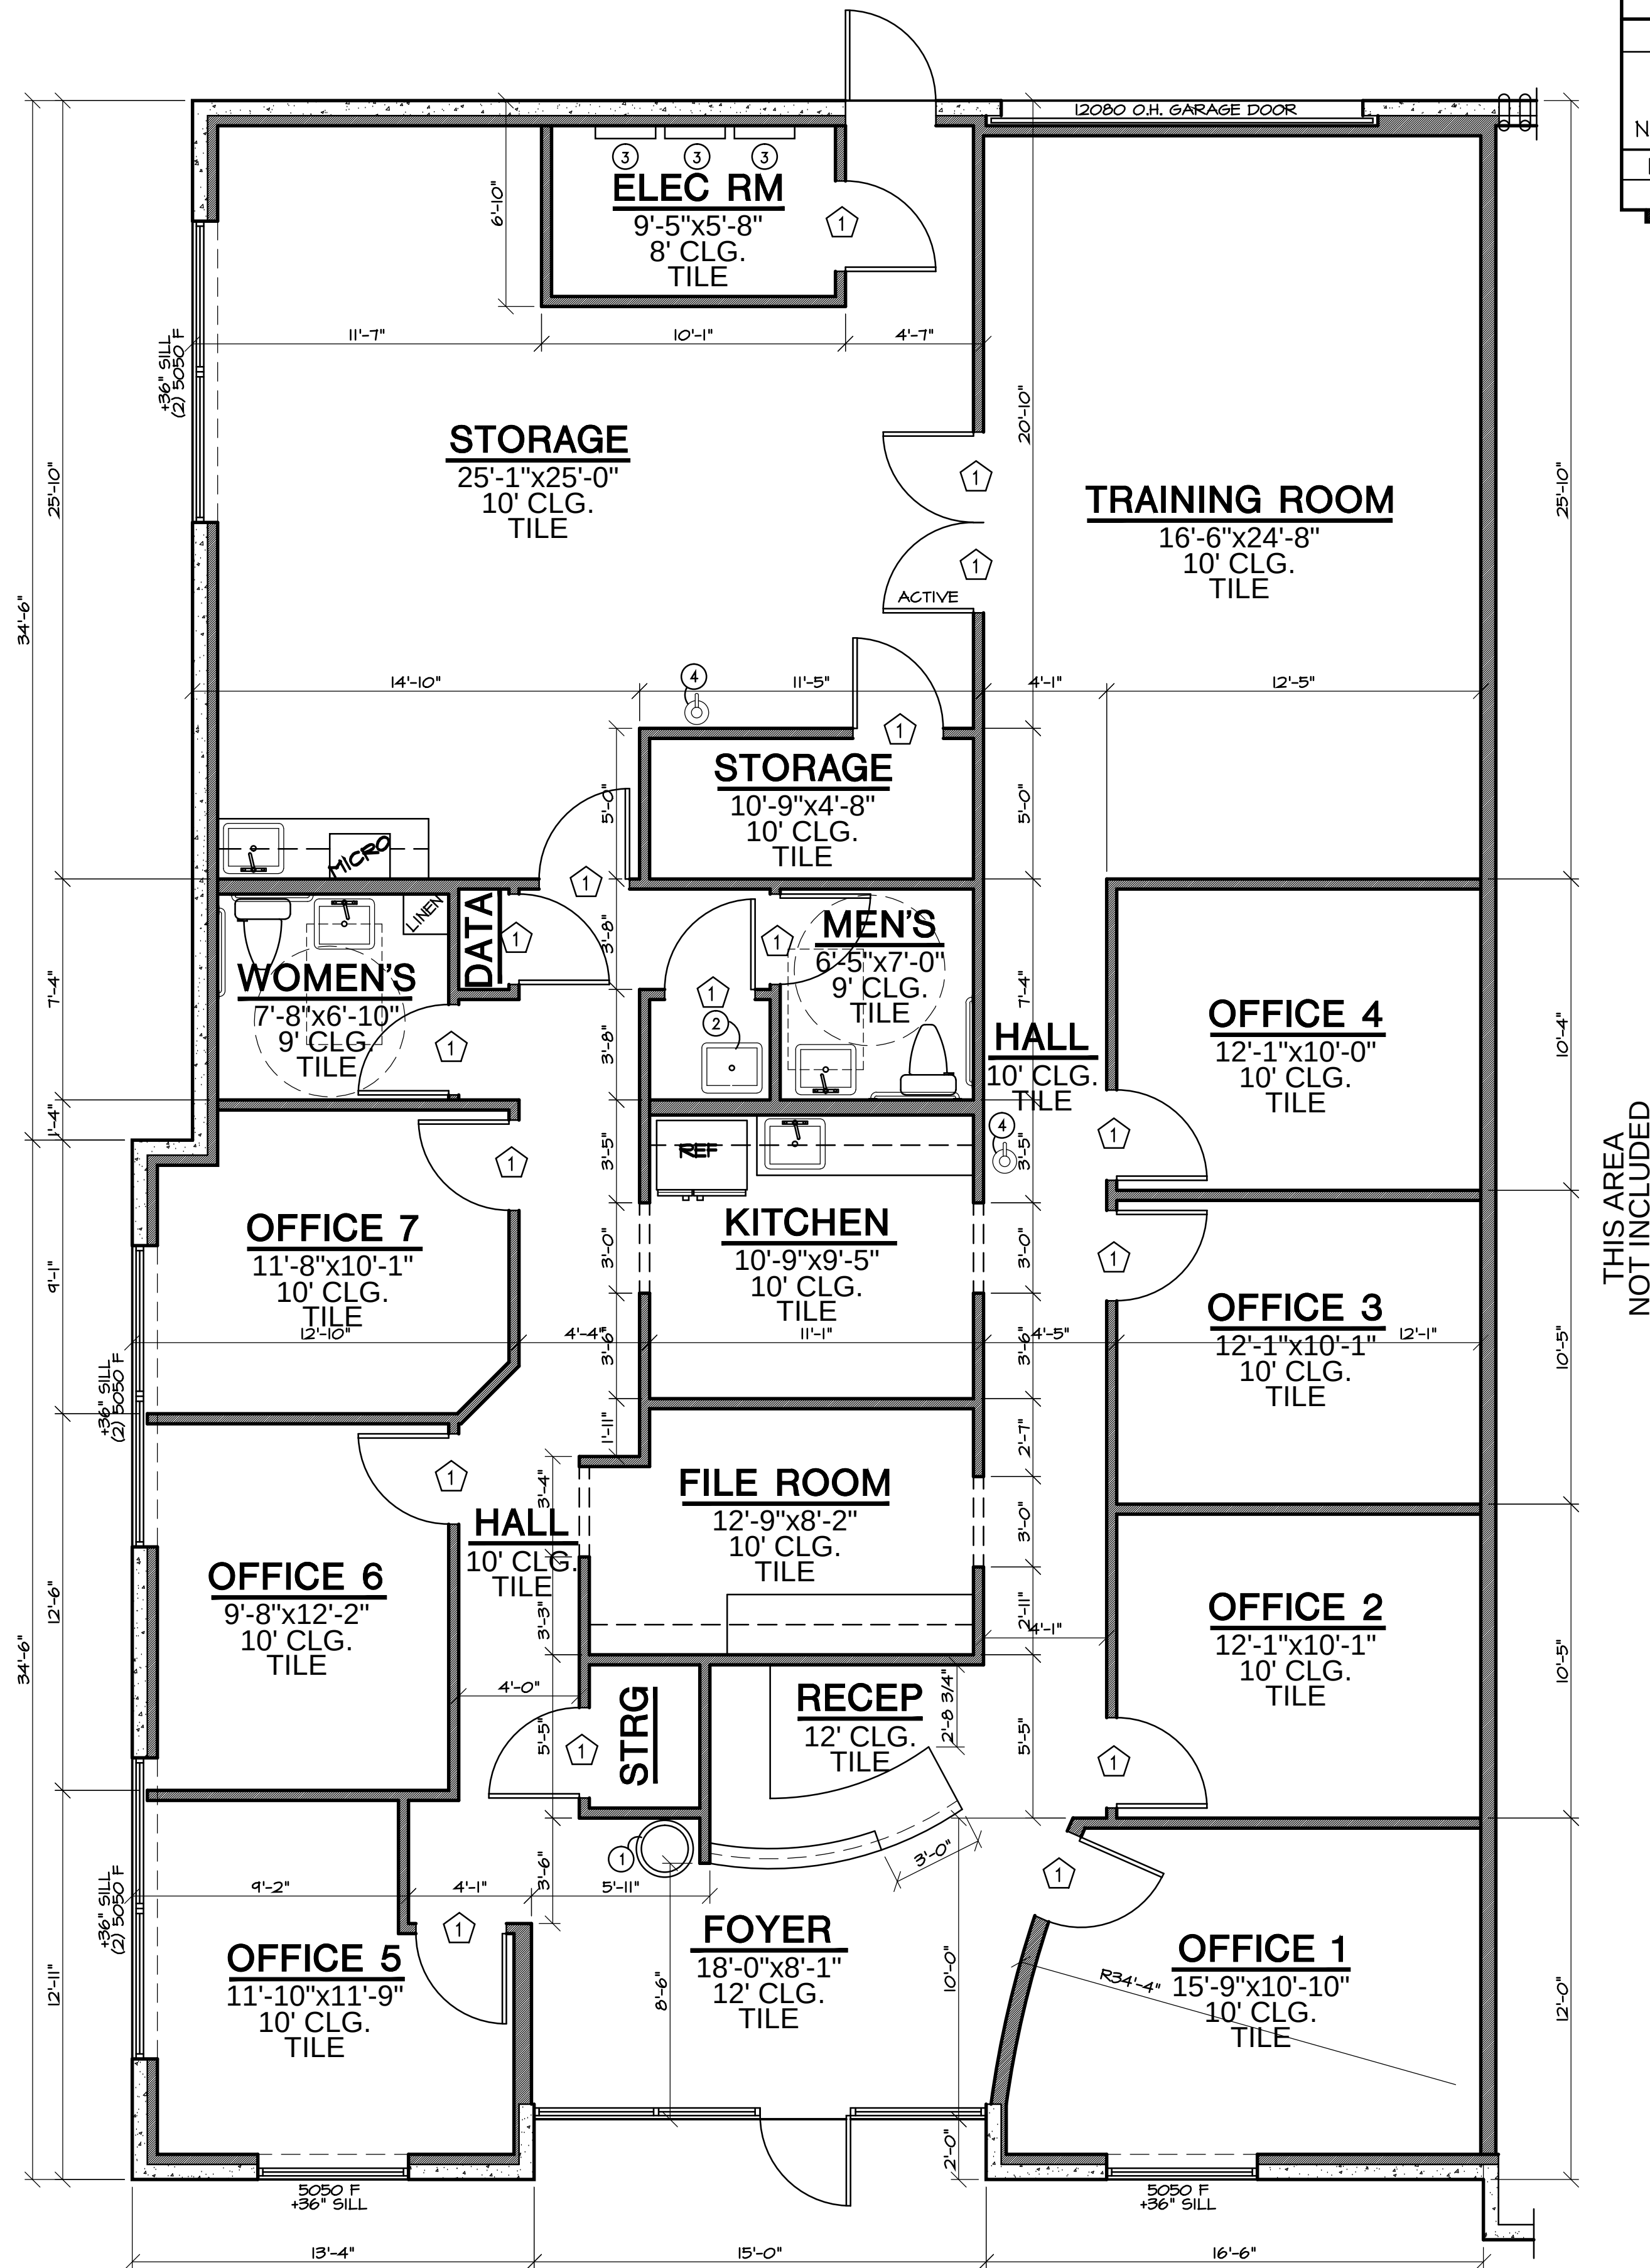

THIS AREA
NOT INCLUDED

DOOR SCHEDULE (EXISTING)									
No.	SIZE			TYPE	MAT.	FINISH	FRAME		REMARKS
	WIDTH	HEIGHT	TH.				MAT.	FINISH	
1	3'-0"	7'-0"	1-3/4"	A	AL/SL	S#V	ALUM	MFR	LEVER

WALL LEGEND	
	EXIST. EXTERIOR CMU WALL
	2x6 METAL STUDS @ 16" O.C. W/ R-19 MIN INSUL. 5/8" G.B. @ INT. OF WALL U.N.O. - SEE ELEVATION FOR EXTERIOR FINISH.
	2x4 METAL STUDS @ 16" O.C. - U.N.O. 5/8" G.B. @ BOTH SIDES OF WALL
	6" CONC. TILT PANEL WALL

SQUARE FOOTAGE	
OFFICE AREA	3000 sq.ft.

D.S.K., Design LLC

ARCHITECTURAL
DESIGNS
DRAFTING

EST. 1987
dsk_inc@msn.com
(o) 480.888.1336 (c) 480.518.0006

No.	DATE	REVISIONS
1		
2		
3		
4		

KEYED - NOTES :

- 1 - WATER COOLER
- 2 - FLOOR SINK
- 3 - ELECTRICAL PANELS
- 4 - FIRE EXTINGUISHER
- 5 -
- 6 -
- 7 -
- 8 -

GENERAL - NOTES :

This drawing is an instrument of service and the property of DSK, and shall remain their property. The use of this drawing shall be restricted to the original site for which it is prepared and publication thereof is expressly limited to such use.

BARNES FAMILY SERVICES
2221 W. PECOS RD., SUITE 12
CHANDLER, AZ 85224

ROCHELLE BARNES
2221 W. PECOS RD., SUITE 12
CHANDLER, AZ 85224
480-720-0887

AS-BUILT
FLOOR PLAN

Project No:	3000	Sheet No:
Date:	SEPT 2017	
Scale:	SEE PLAN	
Drawn:	DSK	

A1

FLOOR PLAN - SUITE 12

SCALE: 1/4"=1'-0"

