




418 S Leroux Floorplan

Approximately 880 ft² total

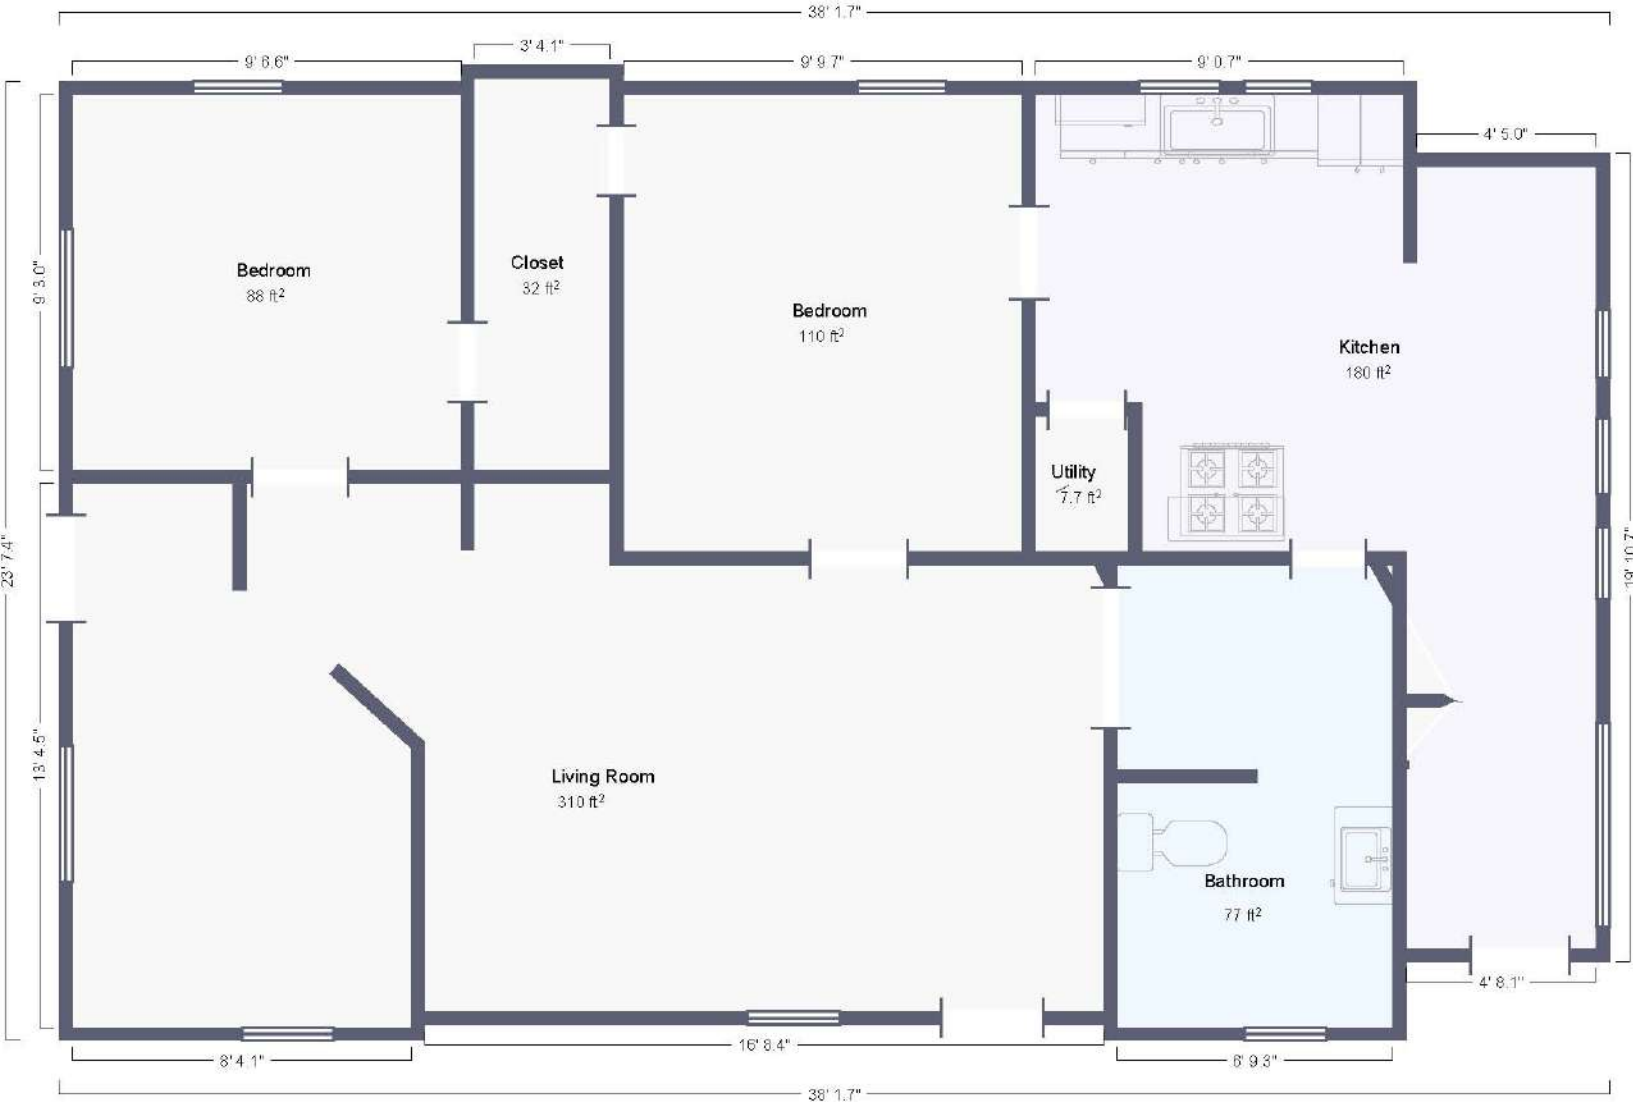

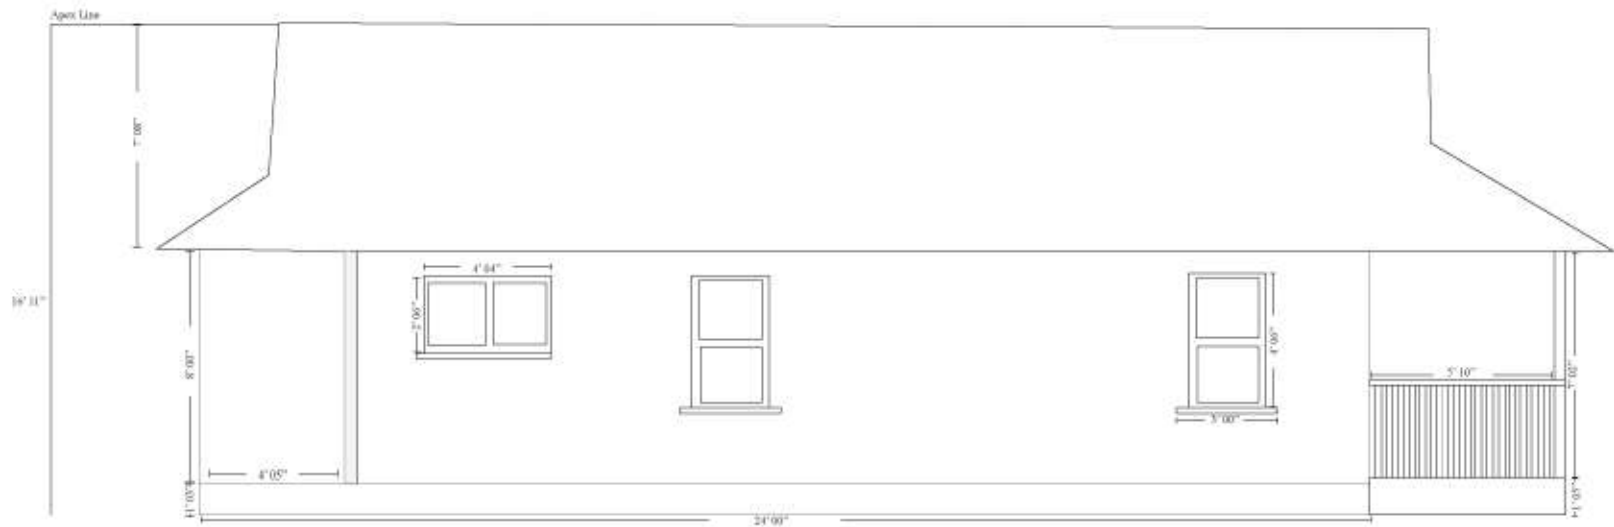


*North Elevation of 418 S Leroux
1:48 Scale*

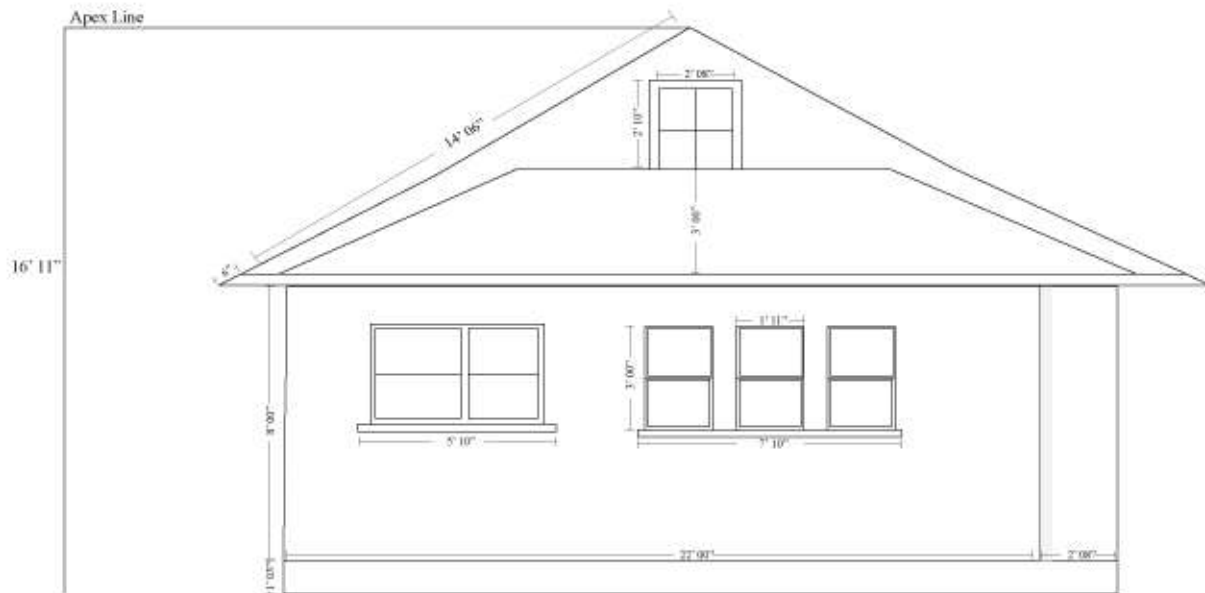


*East Elevation of 418 S Leroux
1 :48 Scale*

Wooden Shed


Approximately 540 ft² total

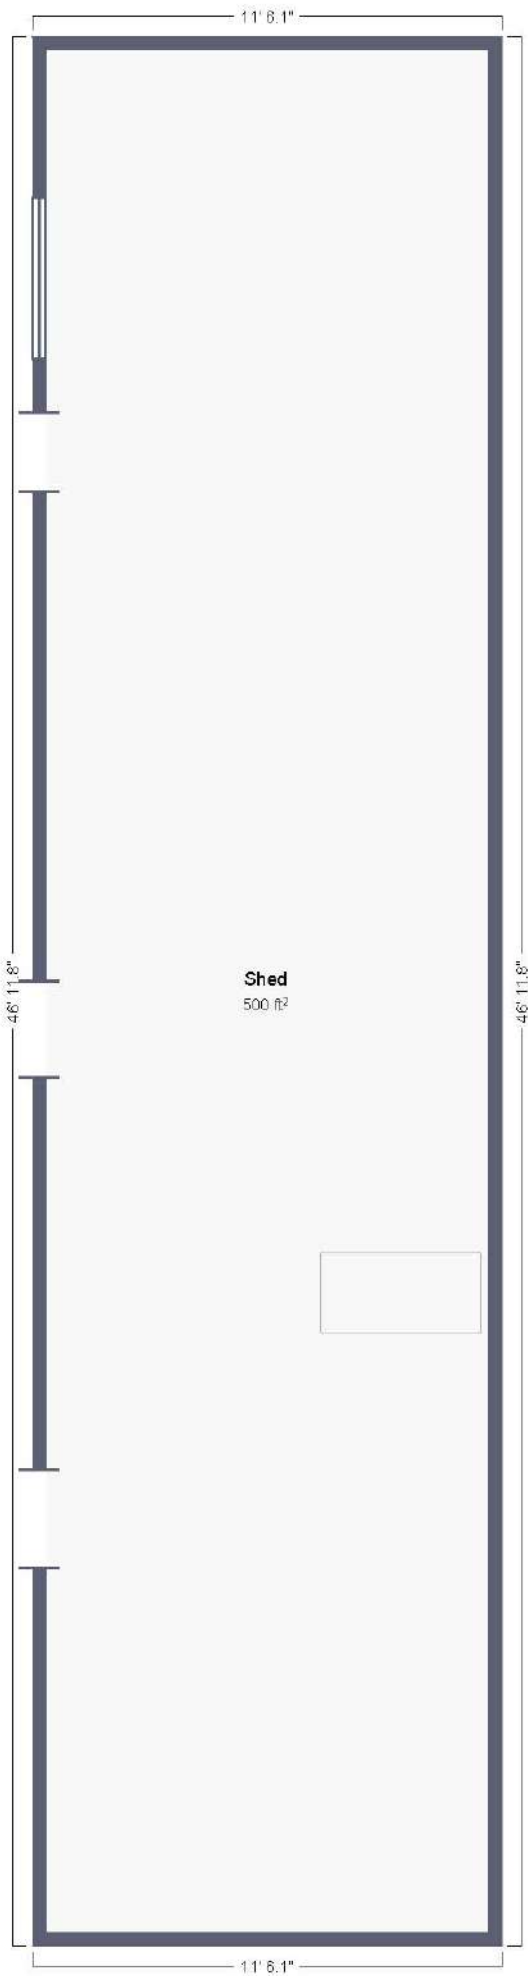


3 ft

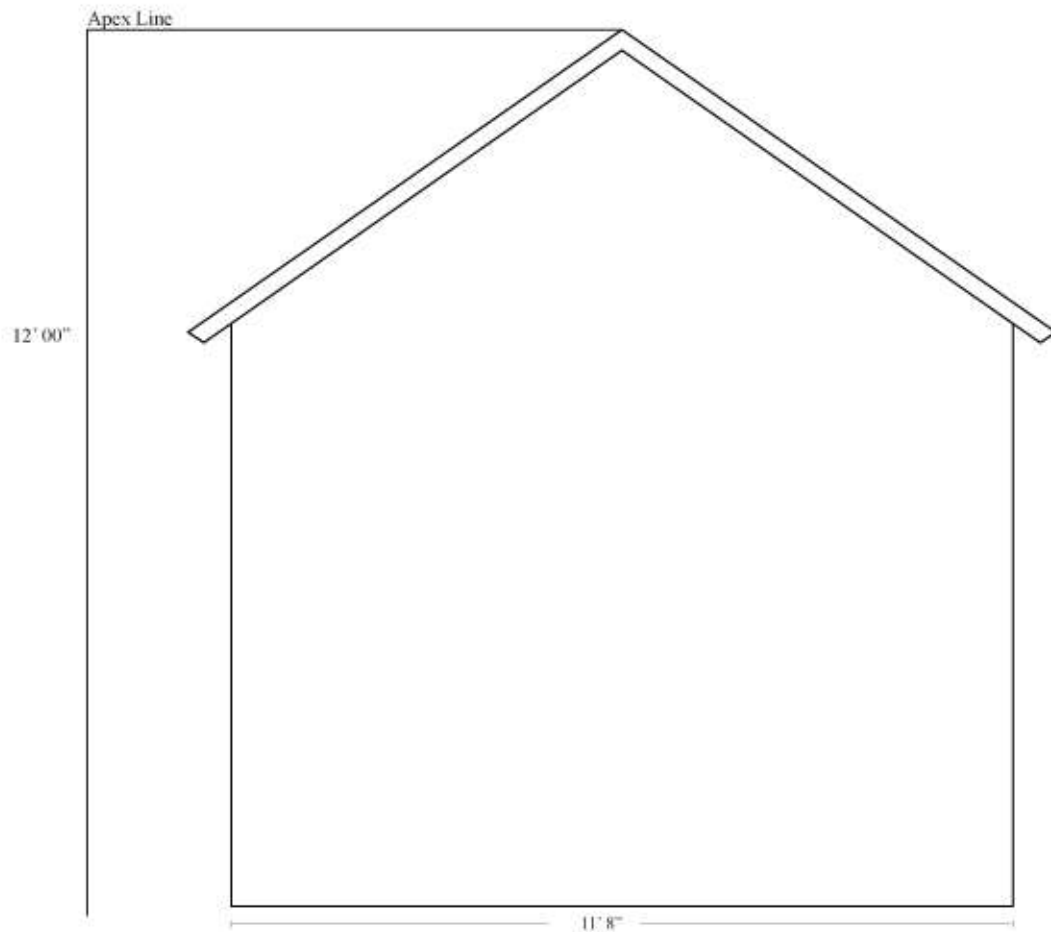


***North Elevation of Shed
1 :24 Scale***

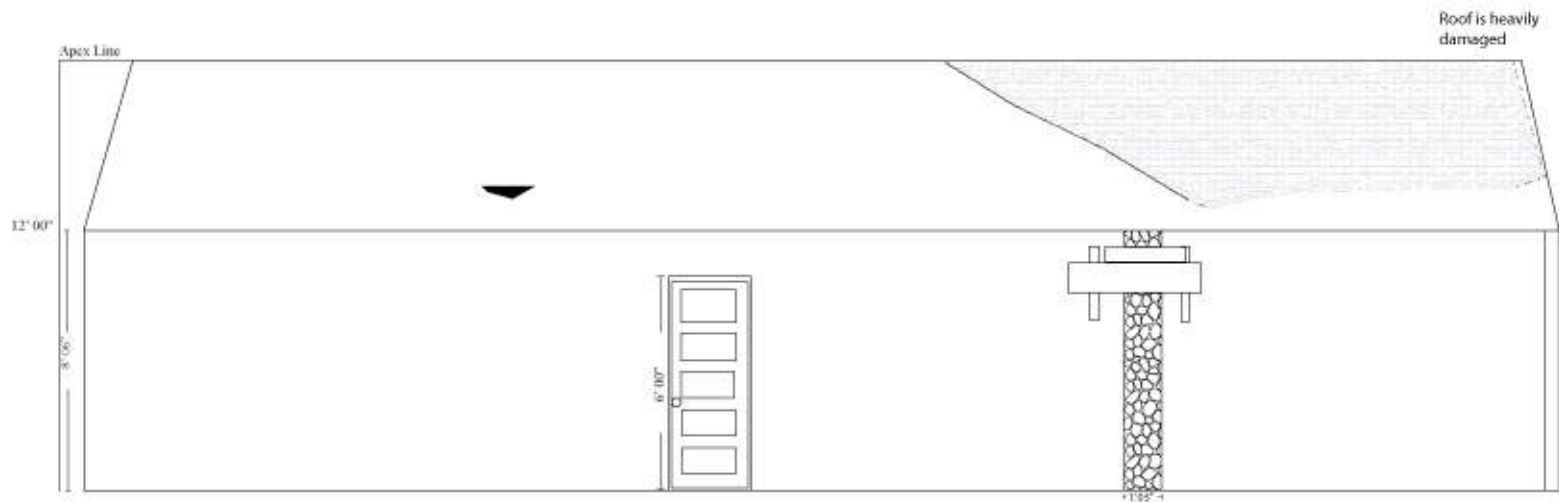

*East Elevation of Shed
1 : 48 Scale*

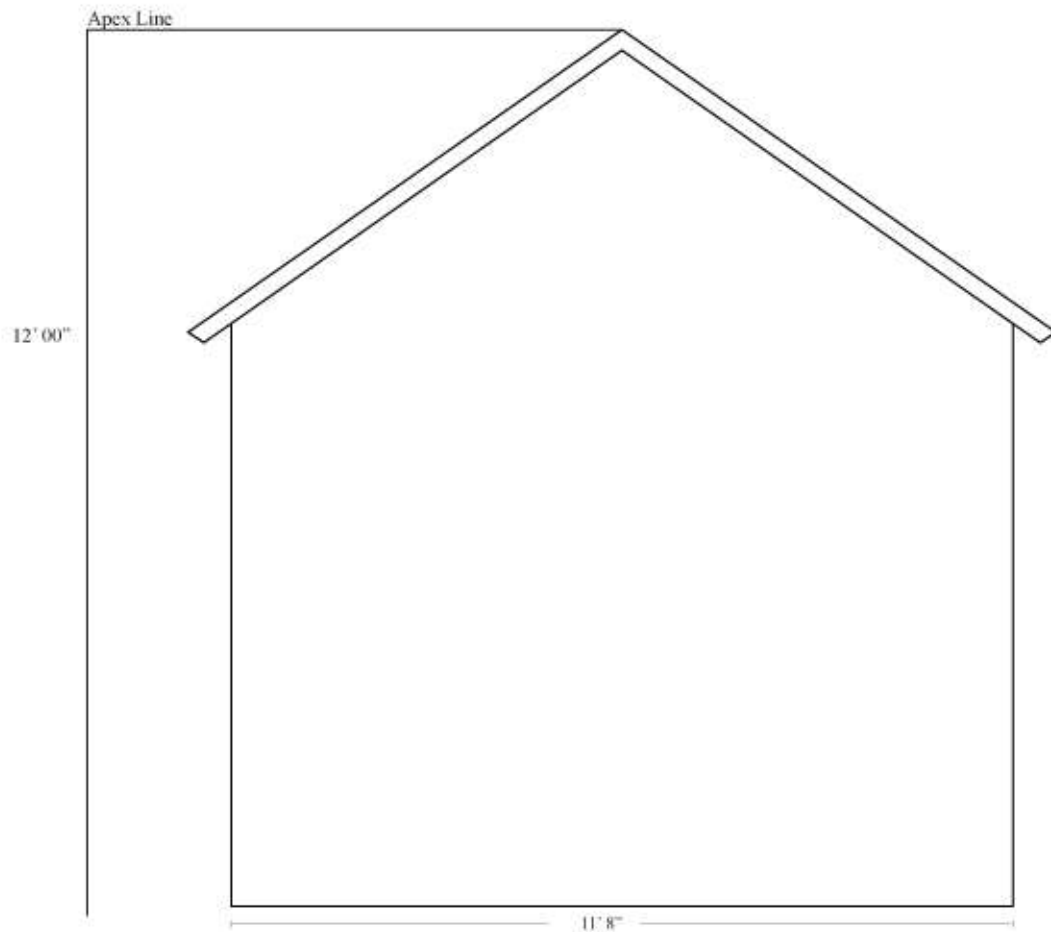

***South Elevation of Shed
1 :24 Scale***

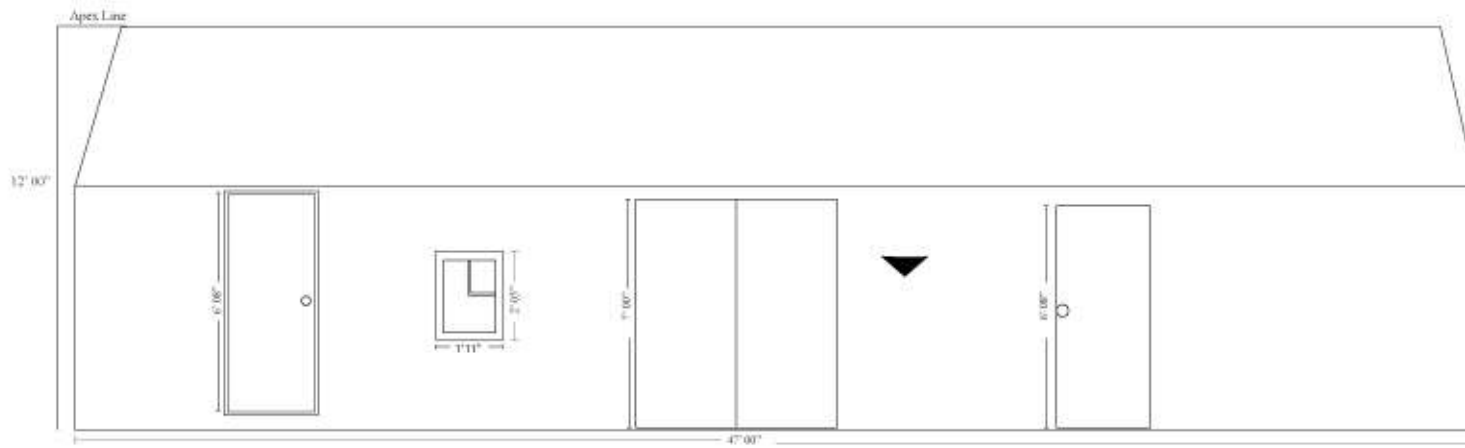

West Elevation of Shed
1 : 48 Scale