



AS-BUILT EAST ELEVATION 1/4" = 1'-0"

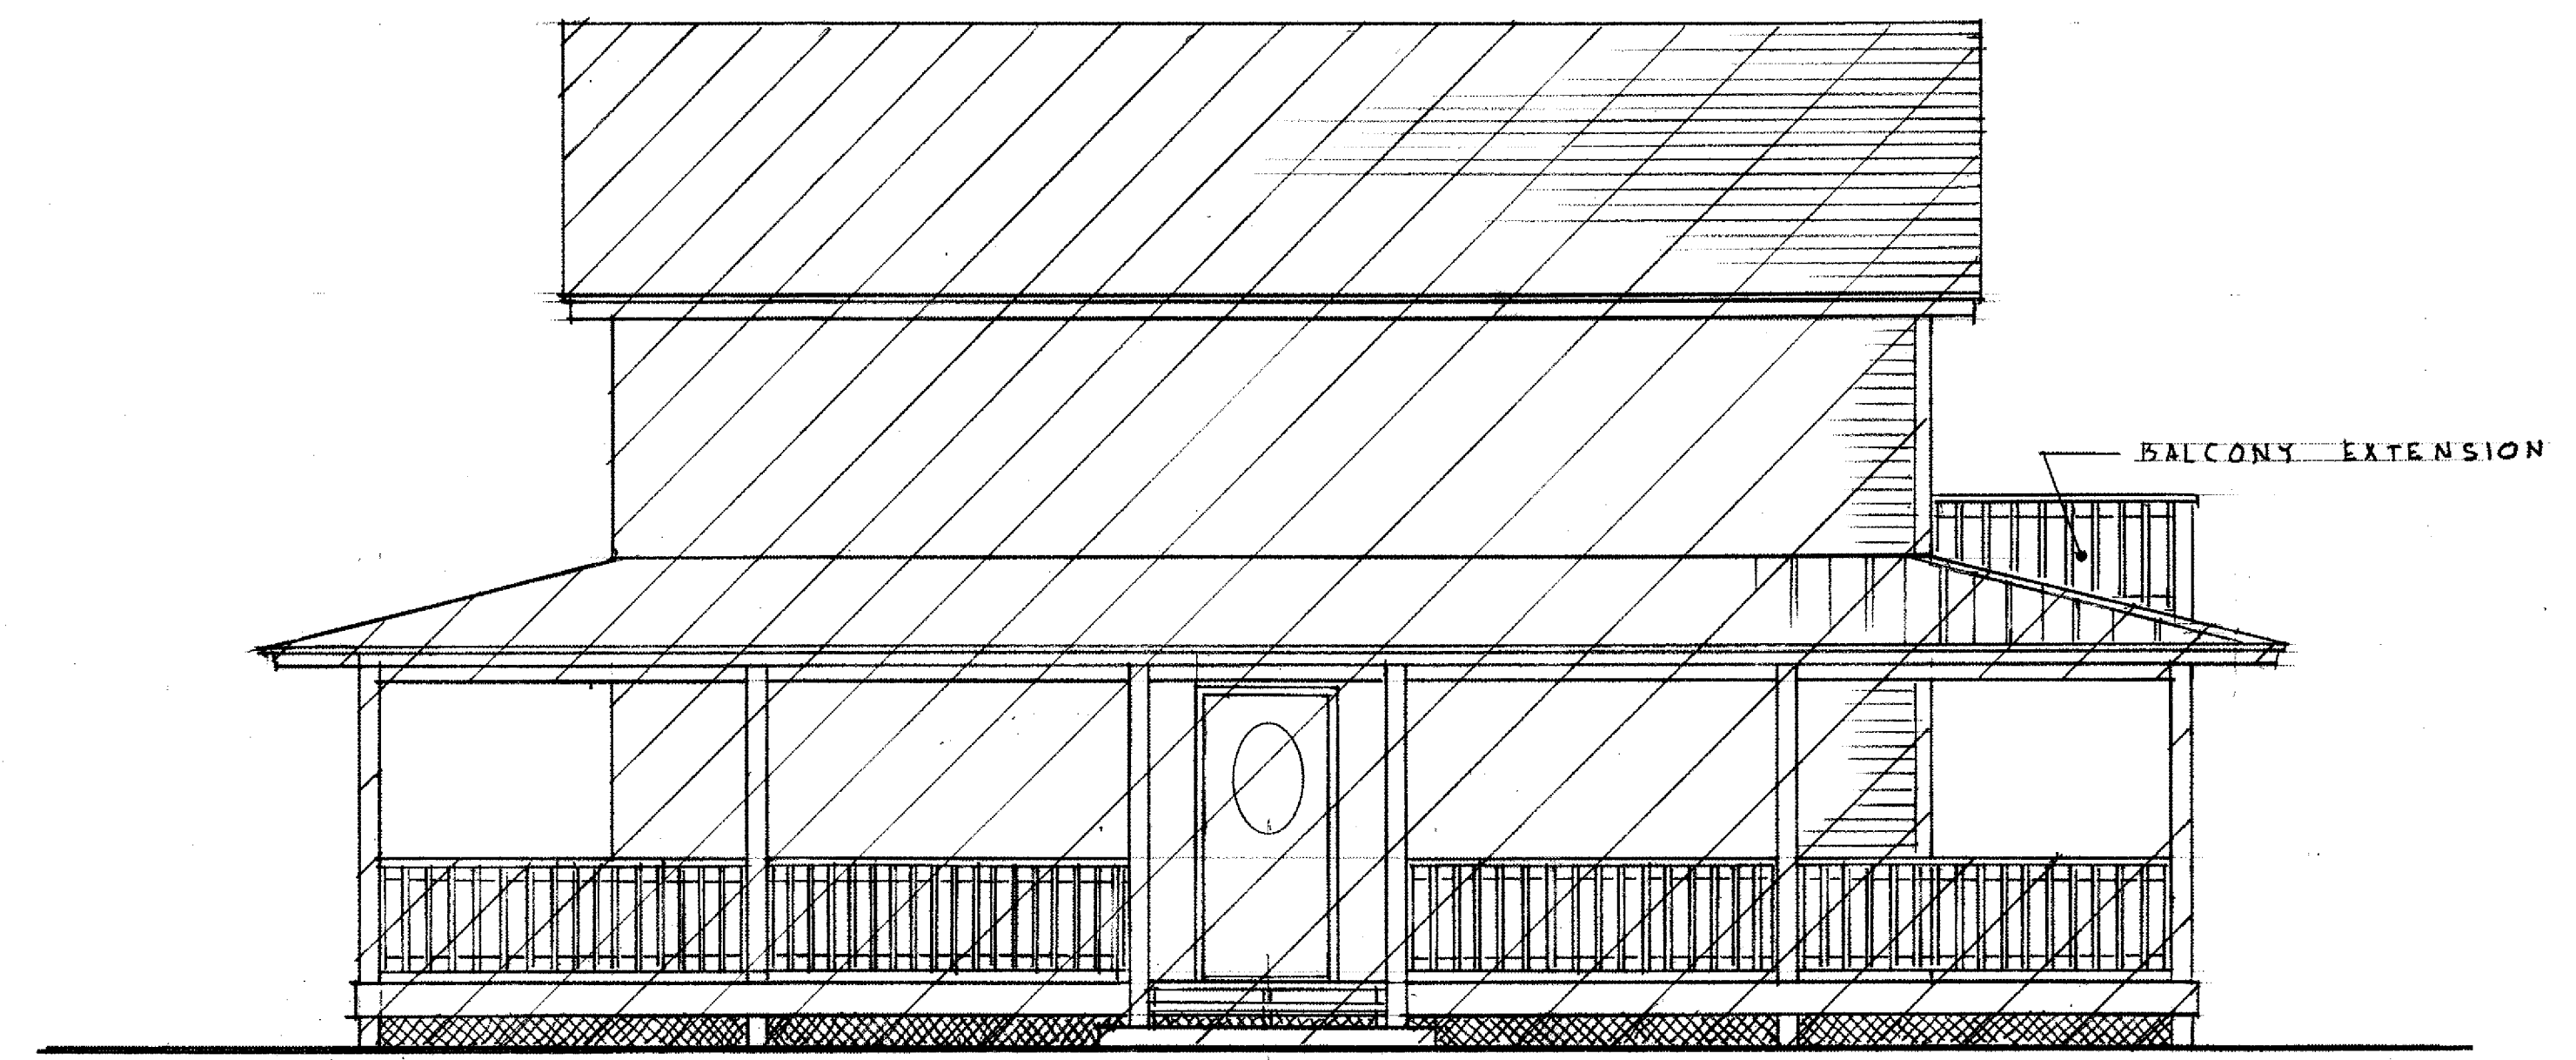


PROPOSED EAST ELEVATION 1/4" = 1'-0"


(NORTH SECOND STREET)

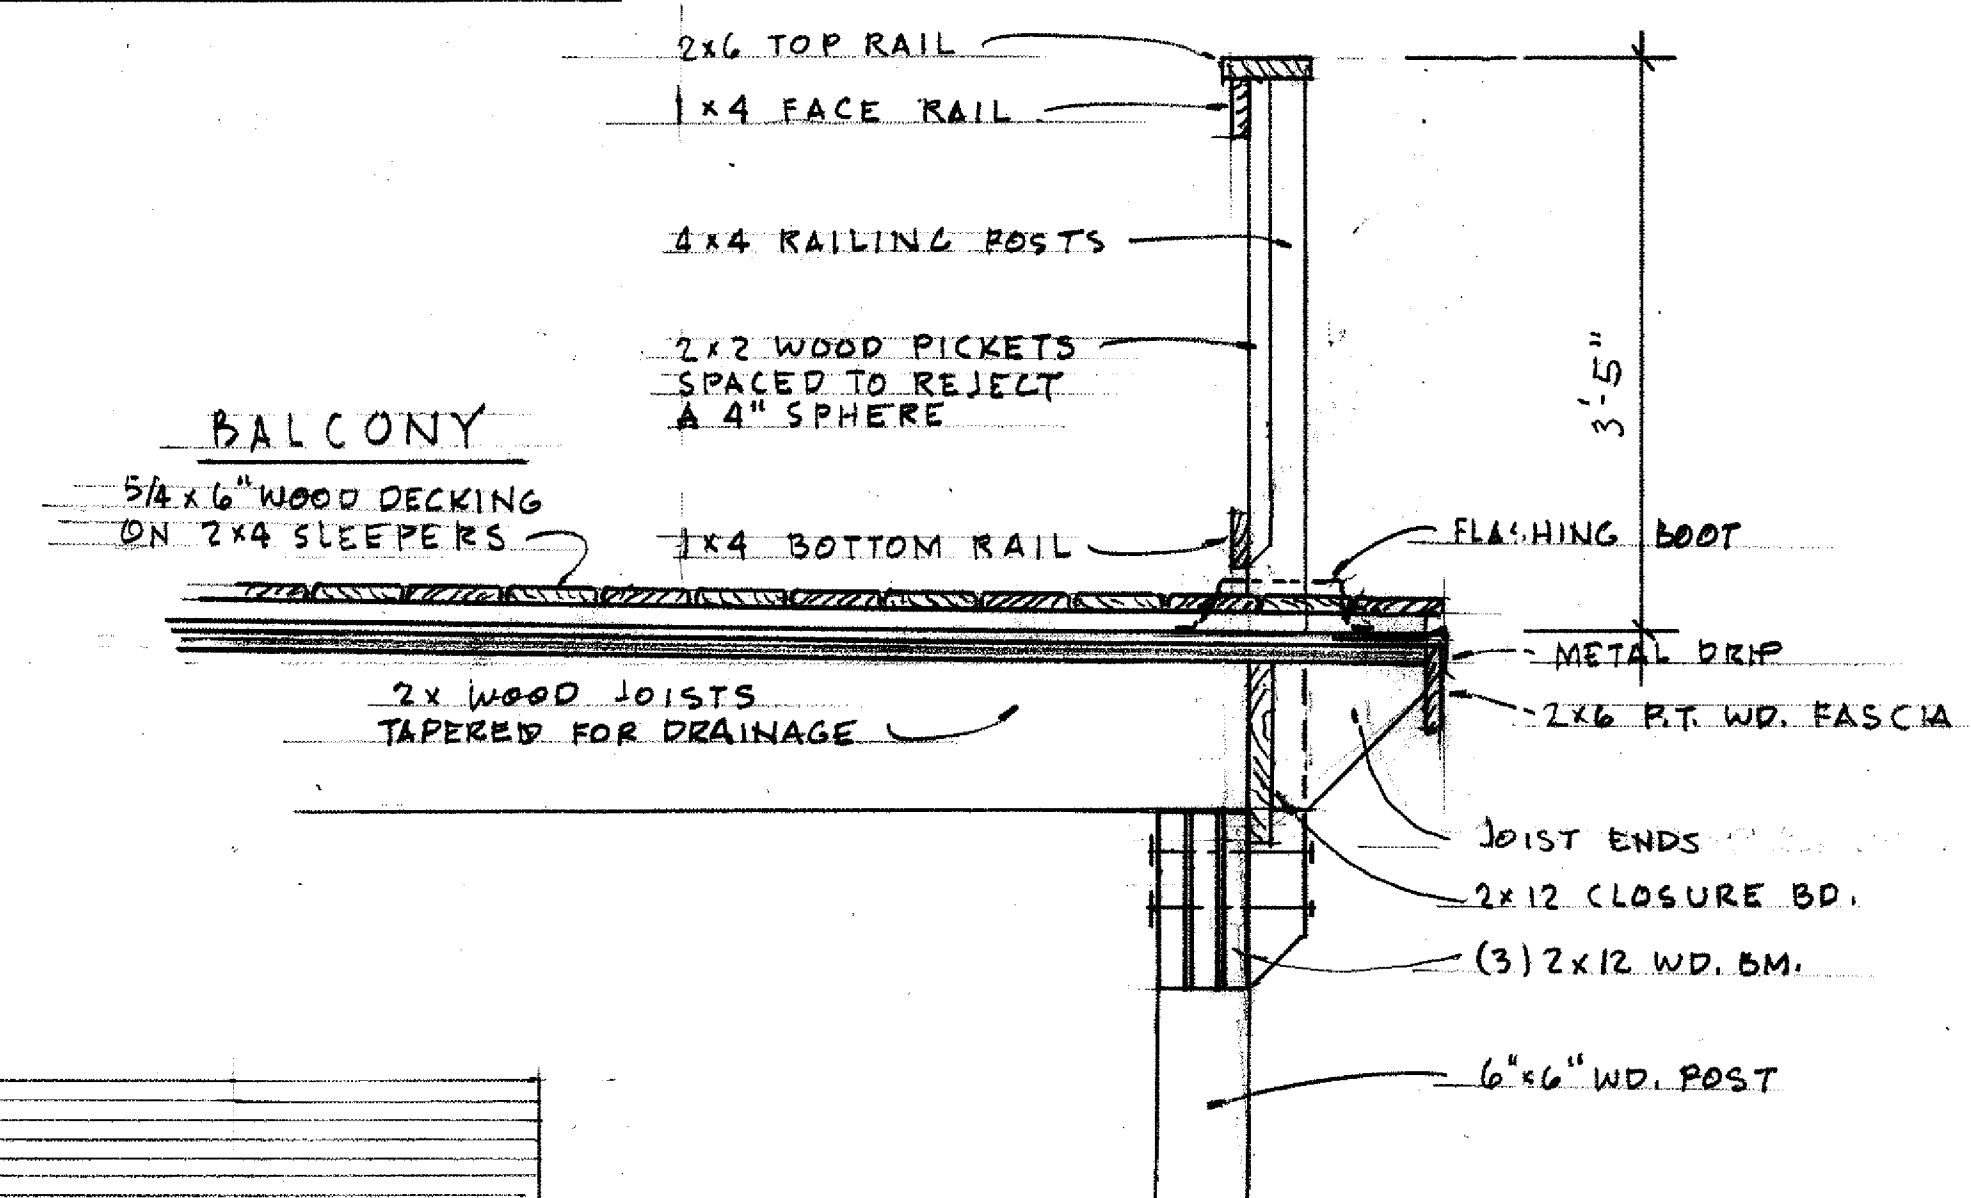

GUARDRAIL DETAIL 1" = 1'-0"

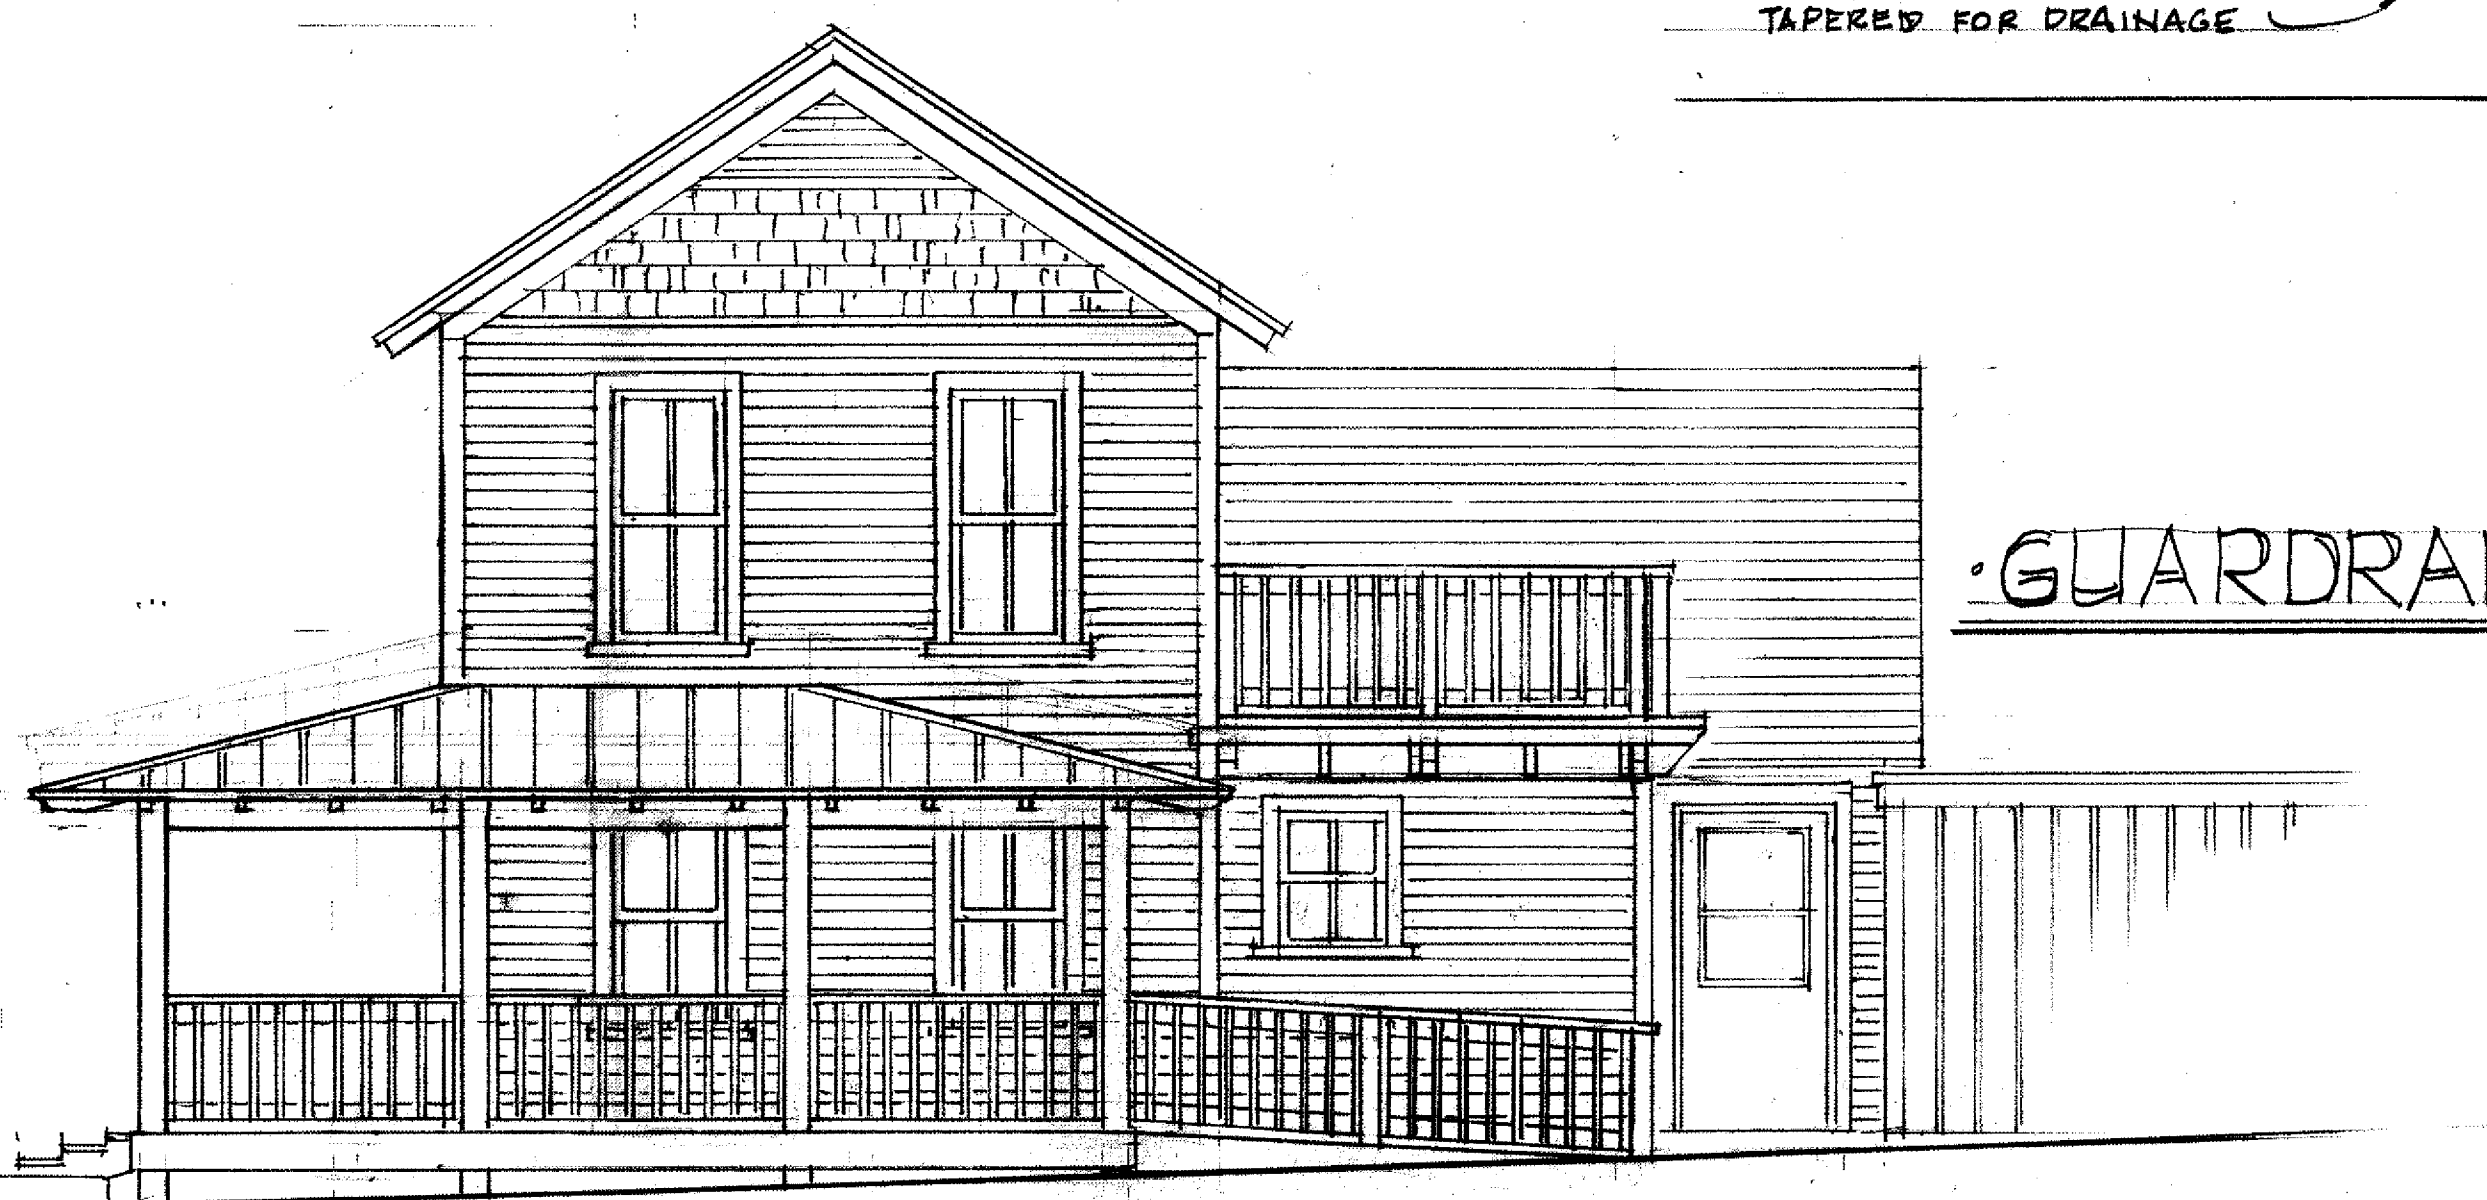

AS-BUILT NORTH ELEVATION 1/4" = 1'-0"

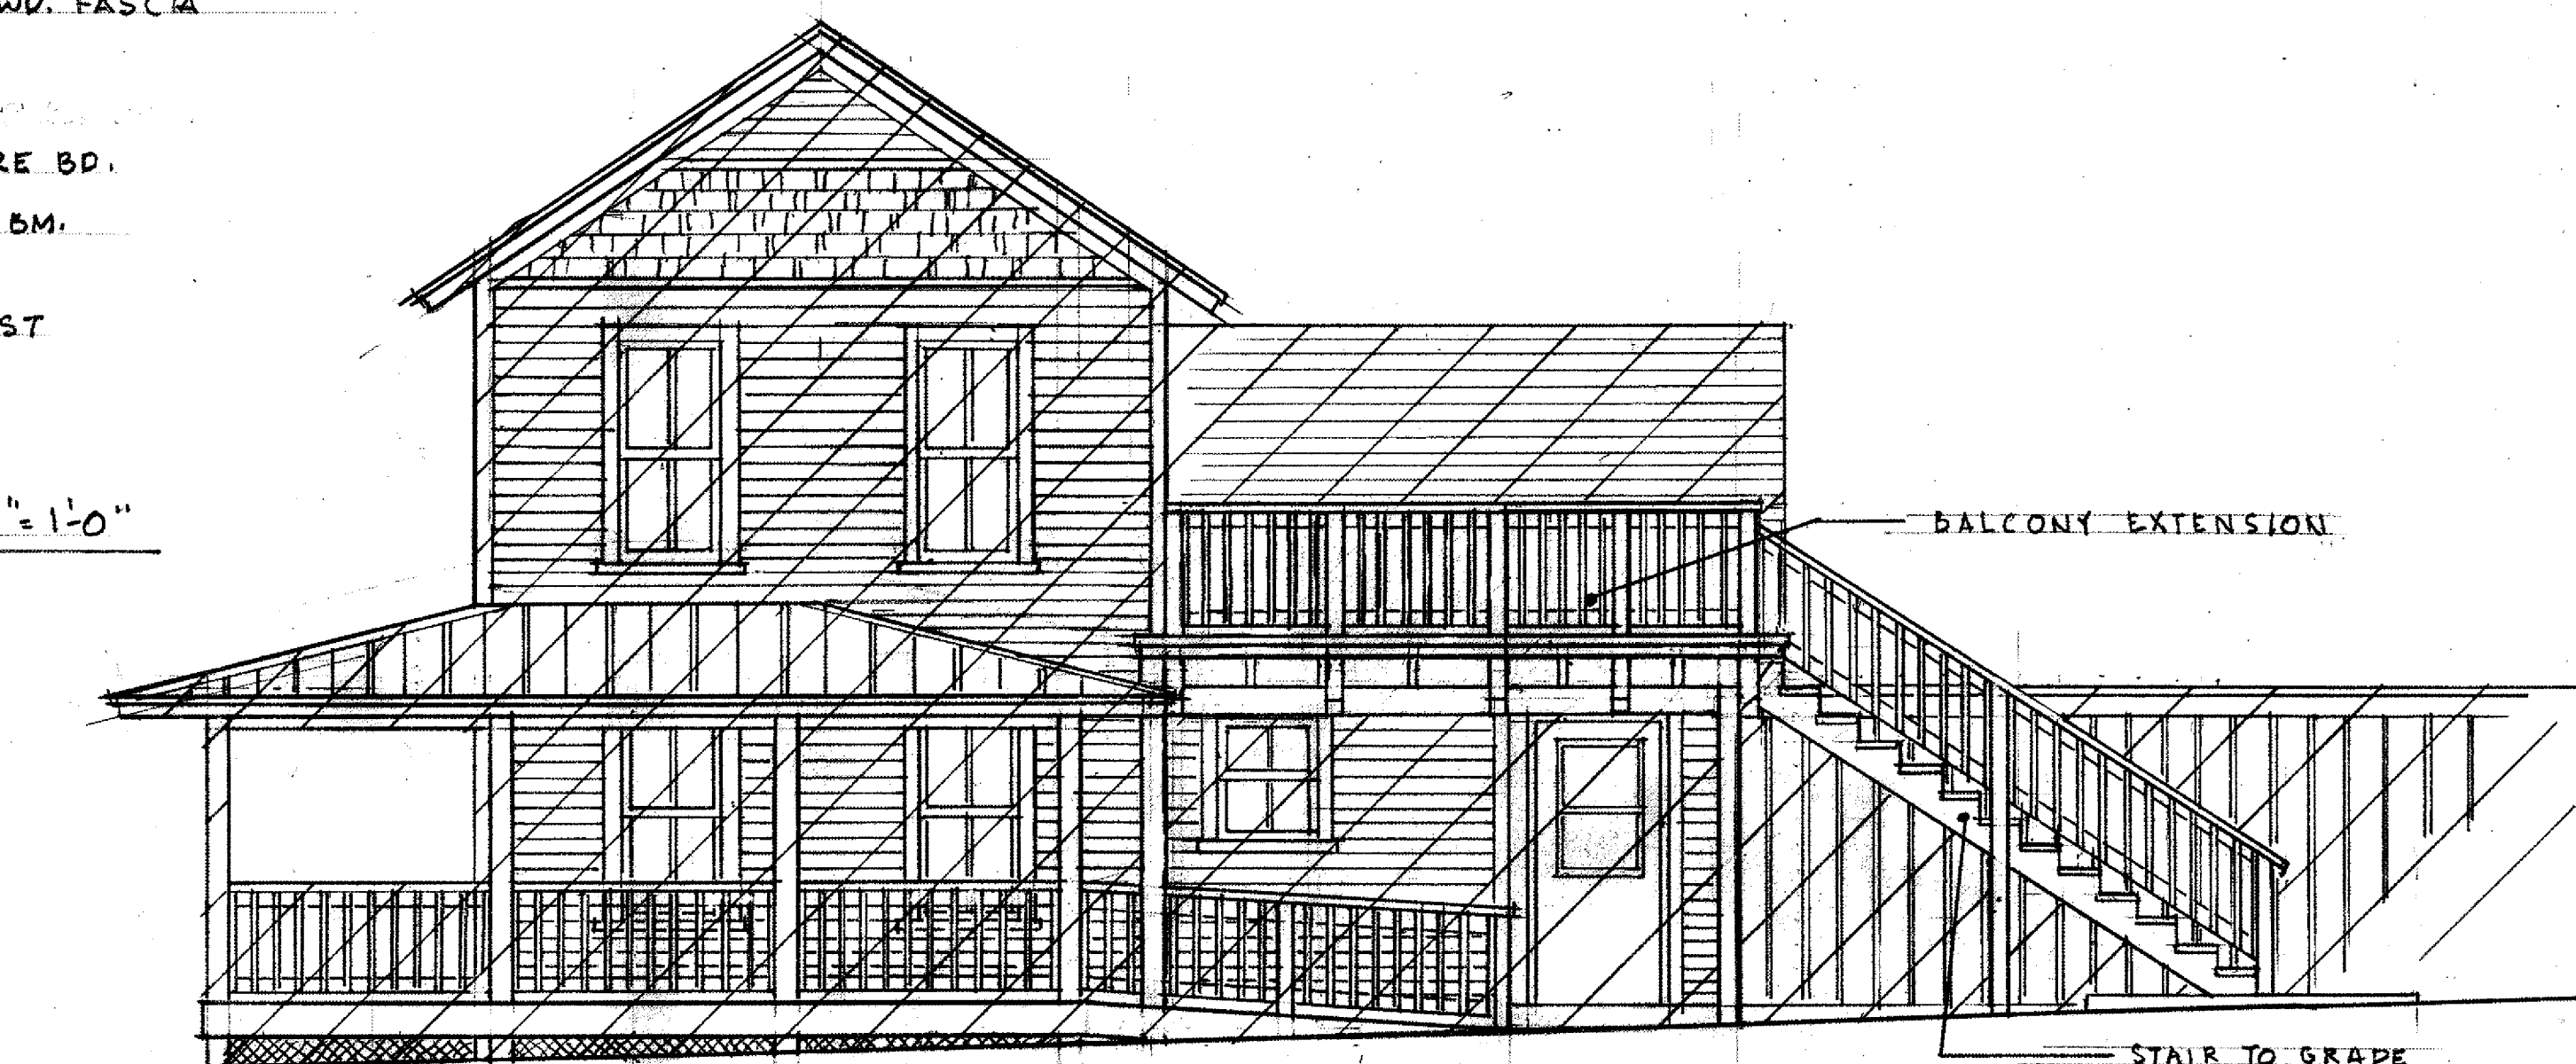

PROPOSED NORTH ELEVATION 1/4" = 1'-0"

(AVENUE E)


HIST. BD.  
3/12/14

PROPOSED RENOVATIONS  
STUBLEY RESIDENCE  
CITY OF FT. PIERCE, FLORIDA


PETER & COOK

COOK & MENARD  
ARCHITECTURE INC.  
STATE OF FLORIDA REGISTRATION NO. AA00044  
FT. PIERCE, FLORIDA 34959  
806 DELAWARE AVE.  
FT. PIERCE, FLORIDA 34959  
PHONE: (772) 466-7751  
FAX: (772) 466-4244


SHEET  
2  
OF  
TWO  
STUBLEY

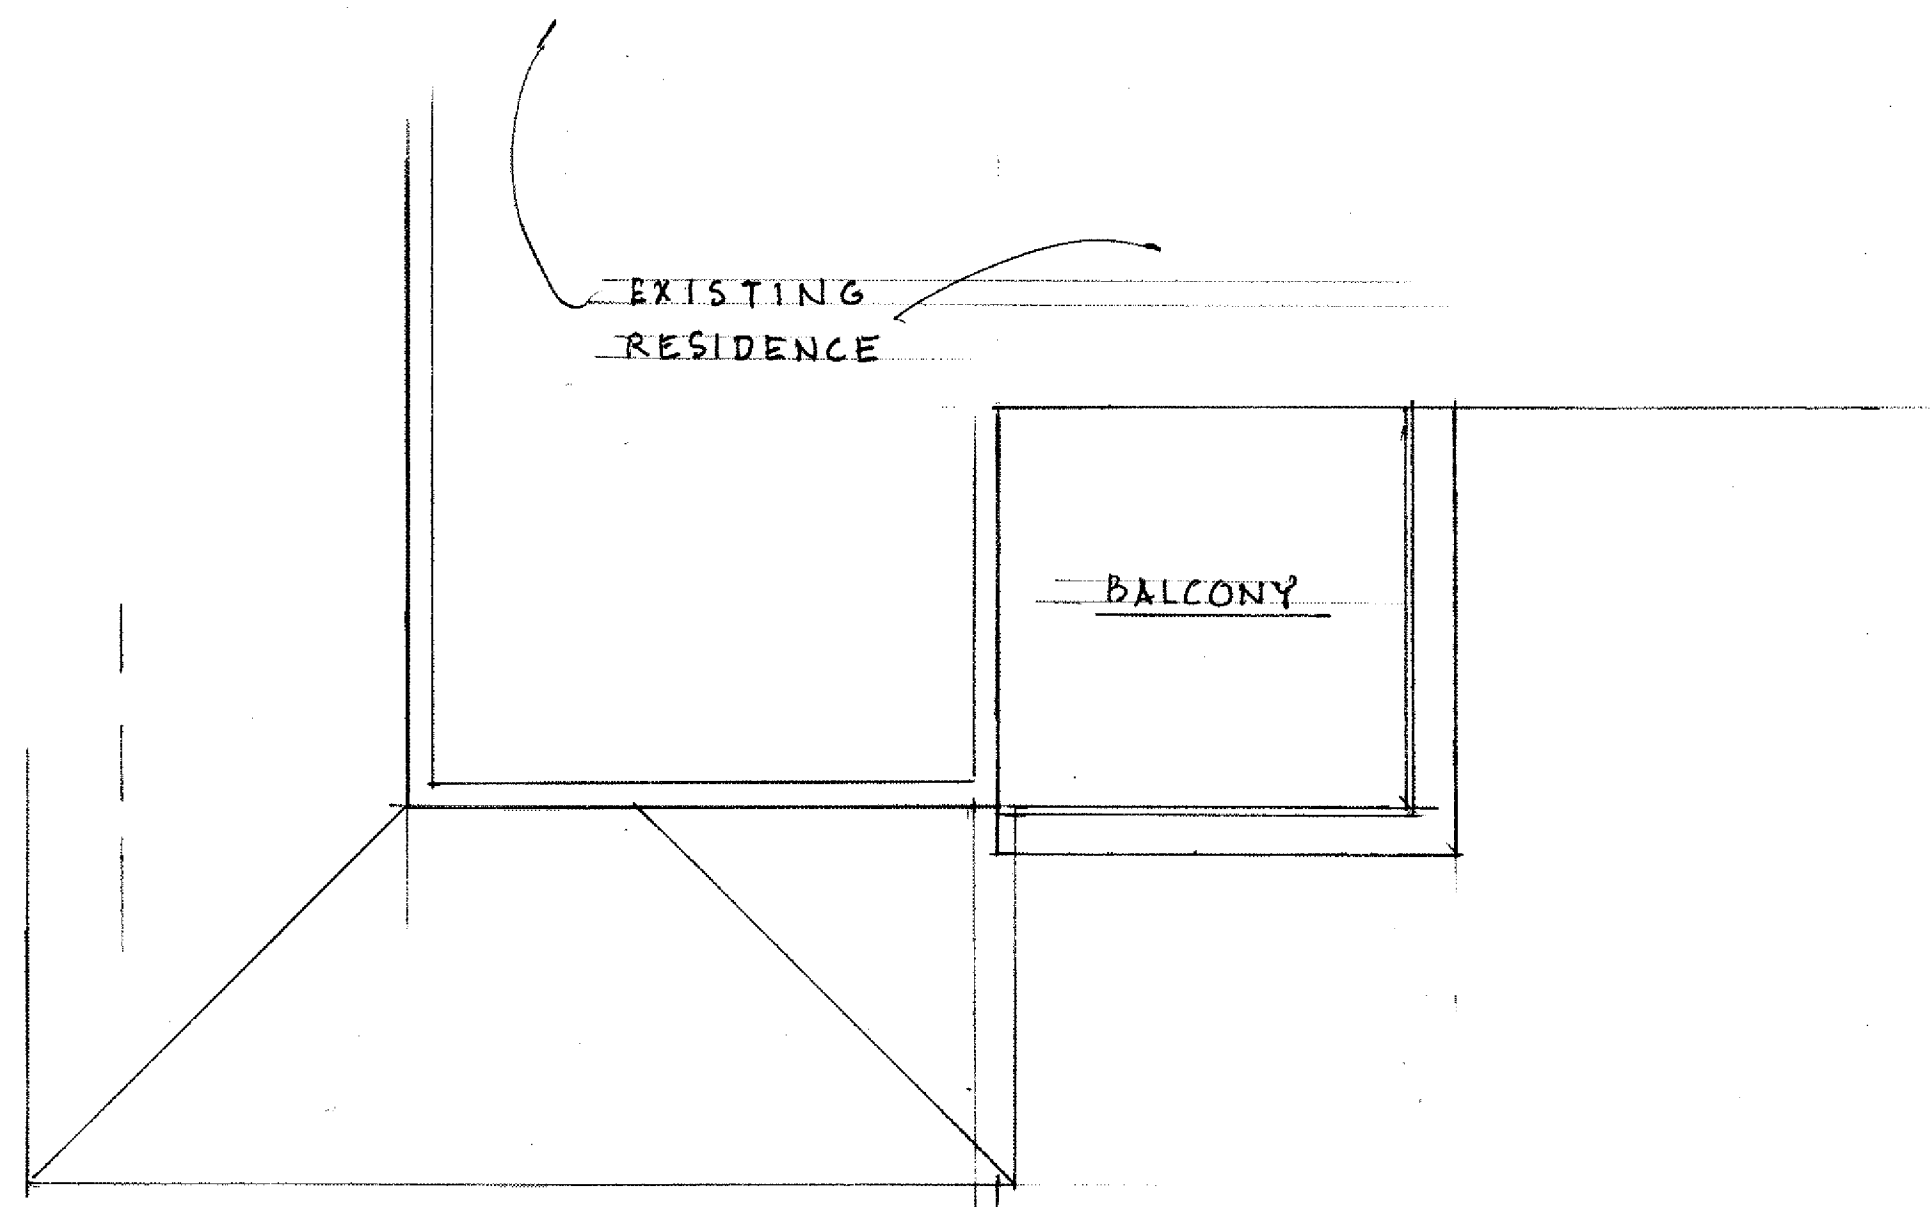


• 2<sup>nd</sup> FLOOR AS-BUILT PLAN • 1/4" = 1'-0"

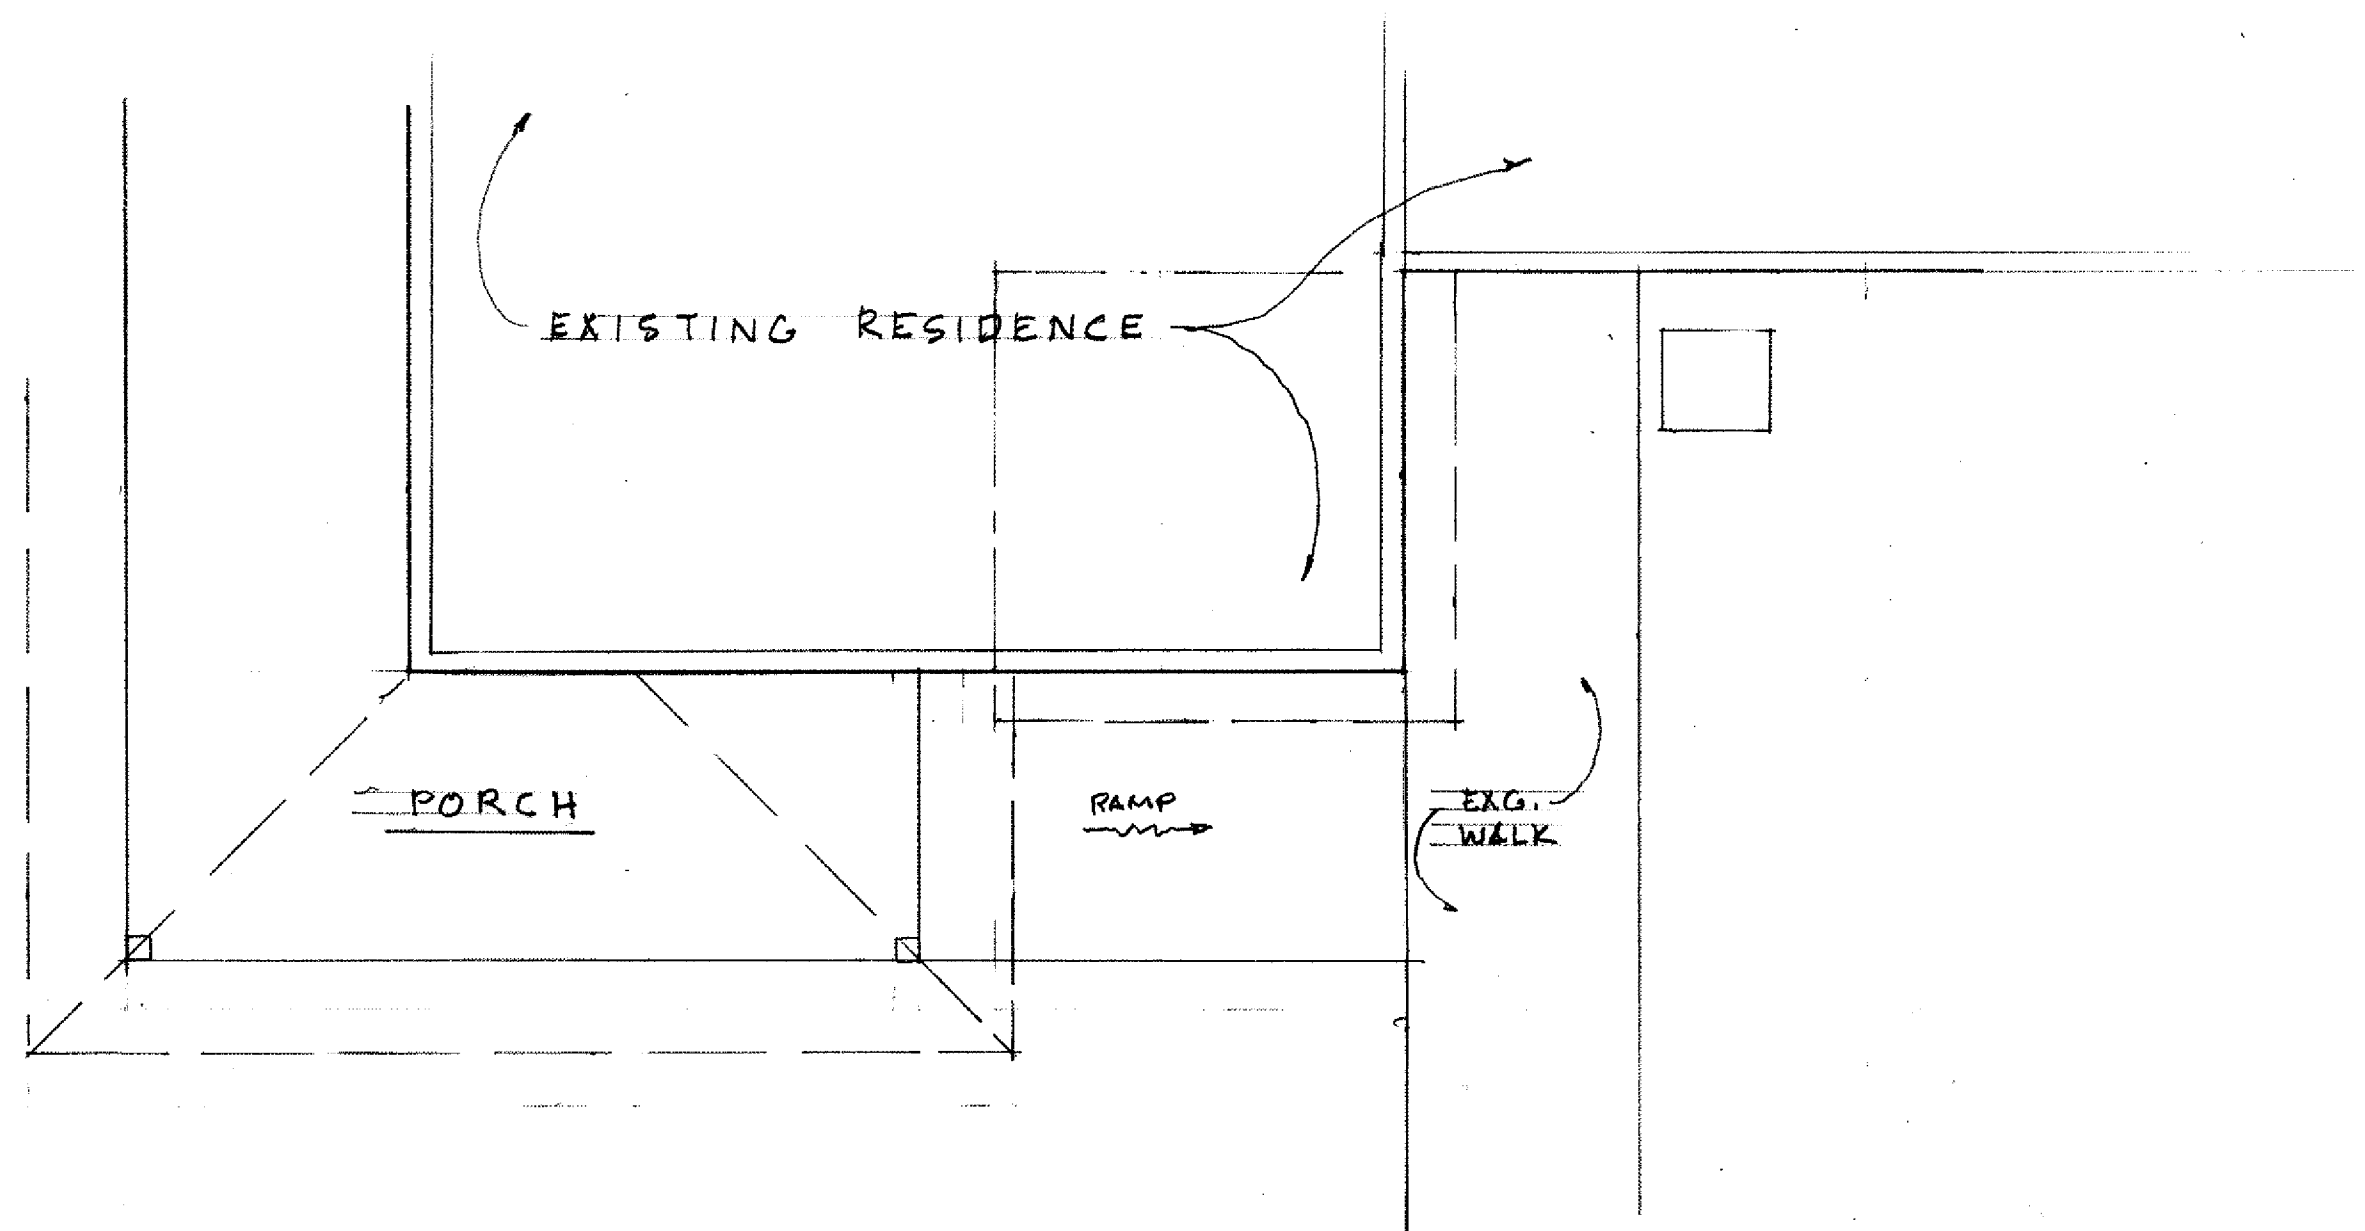

• 1<sup>st</sup> FLOOR AS BUILT PLAN • 1/4" = 1'-0"

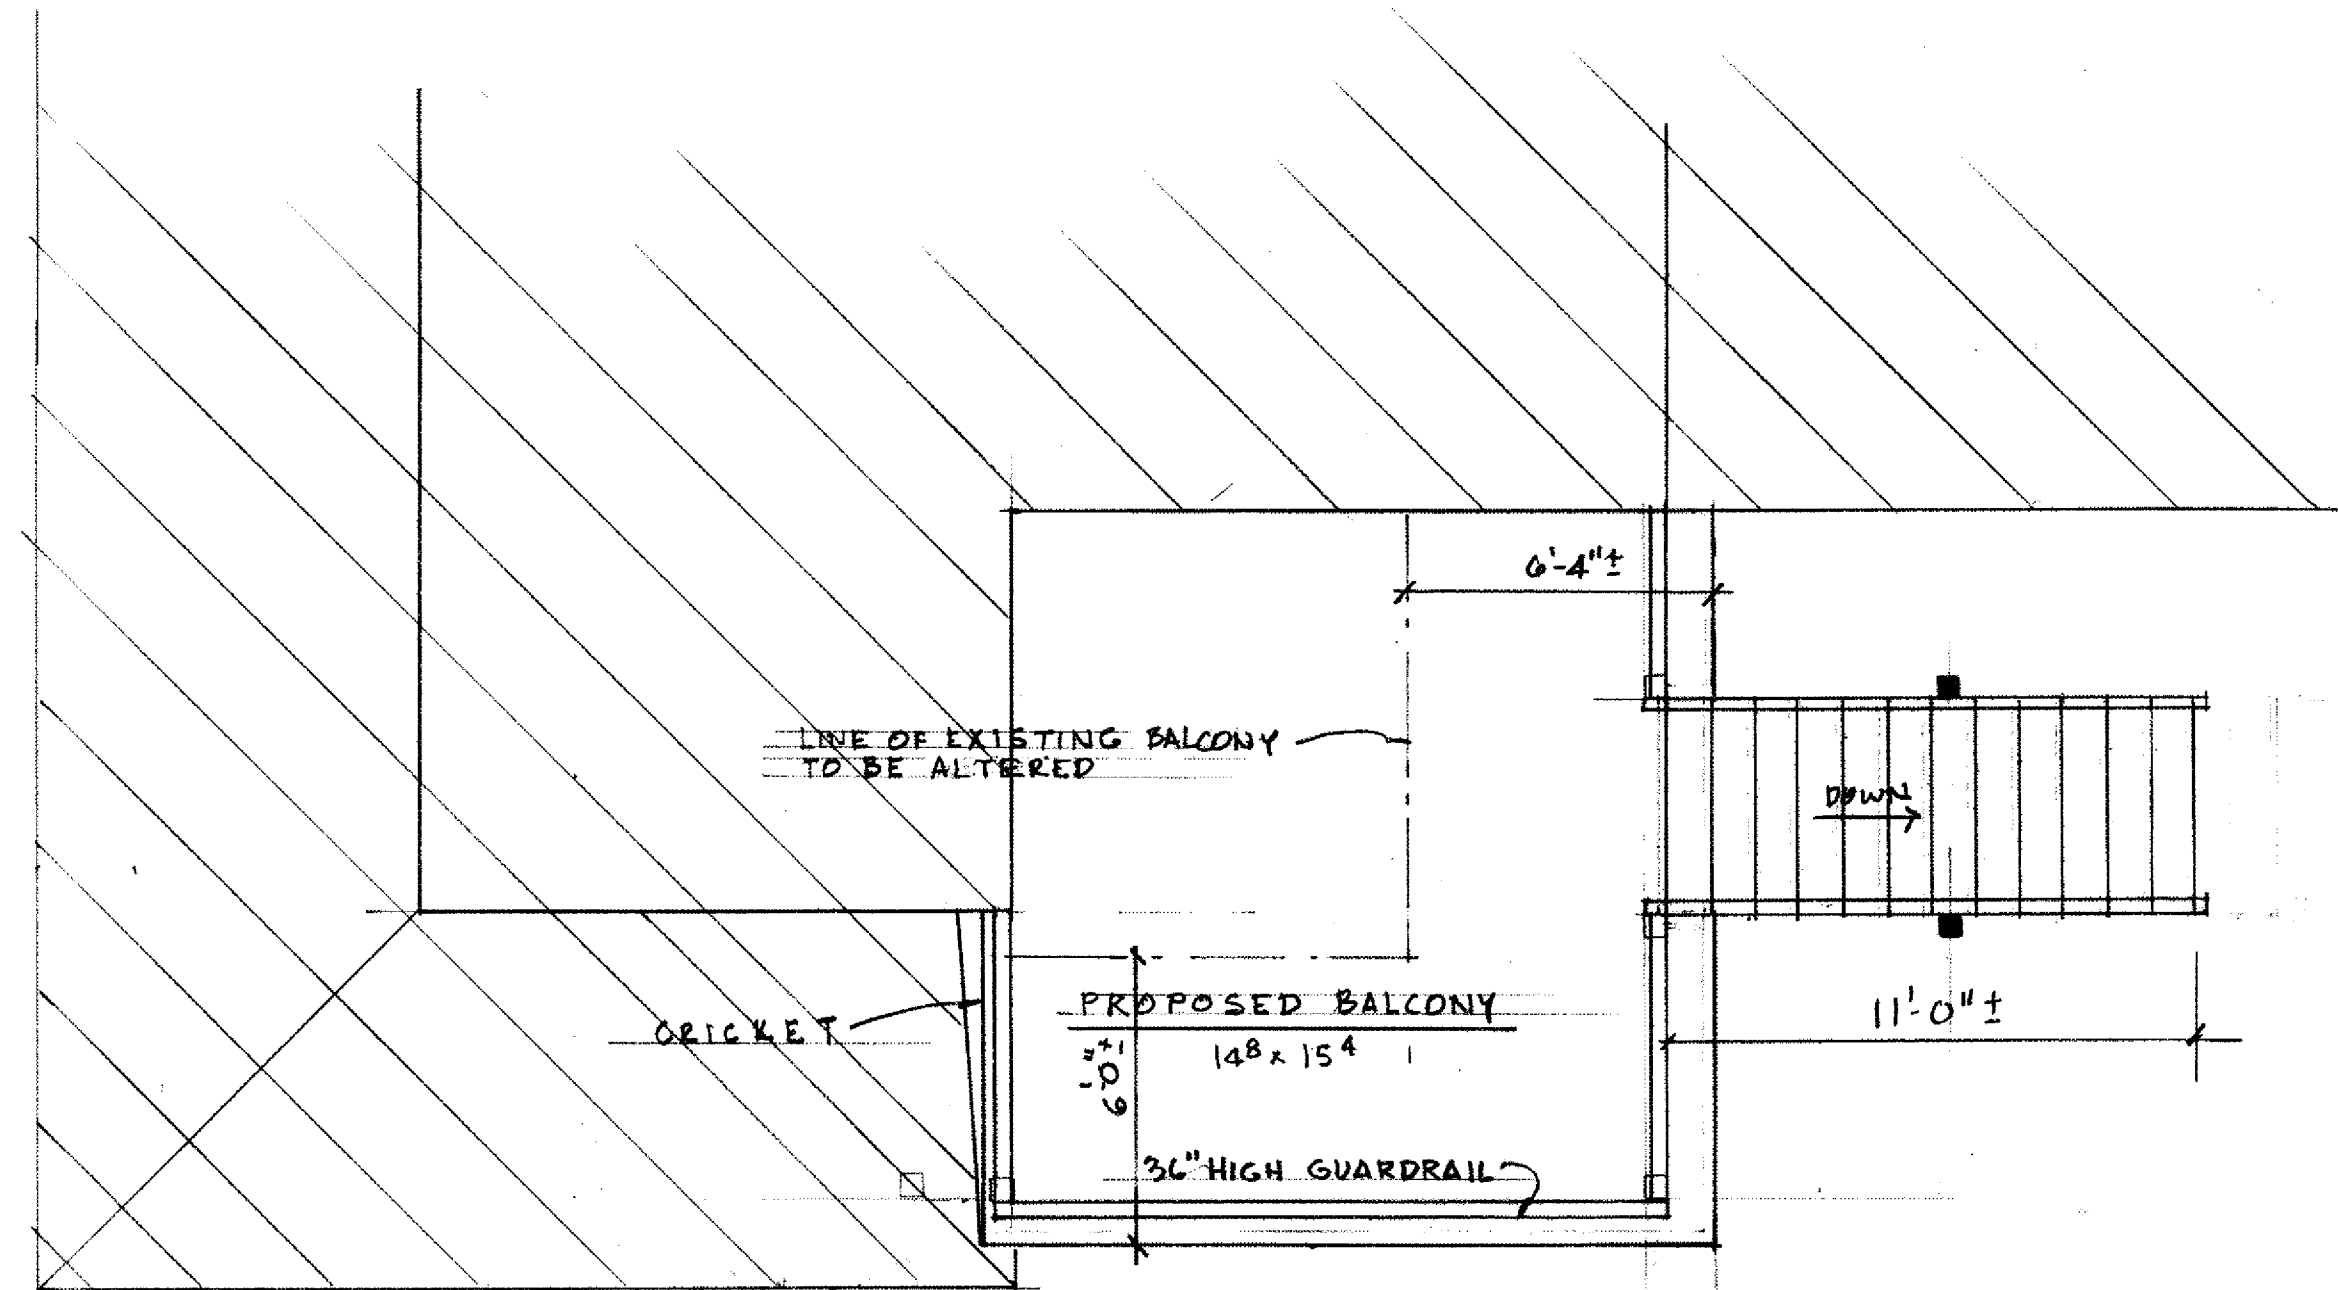

• PROPOSED 2<sup>nd</sup> FLOOR PLAN • 1/4" = 1'-0"

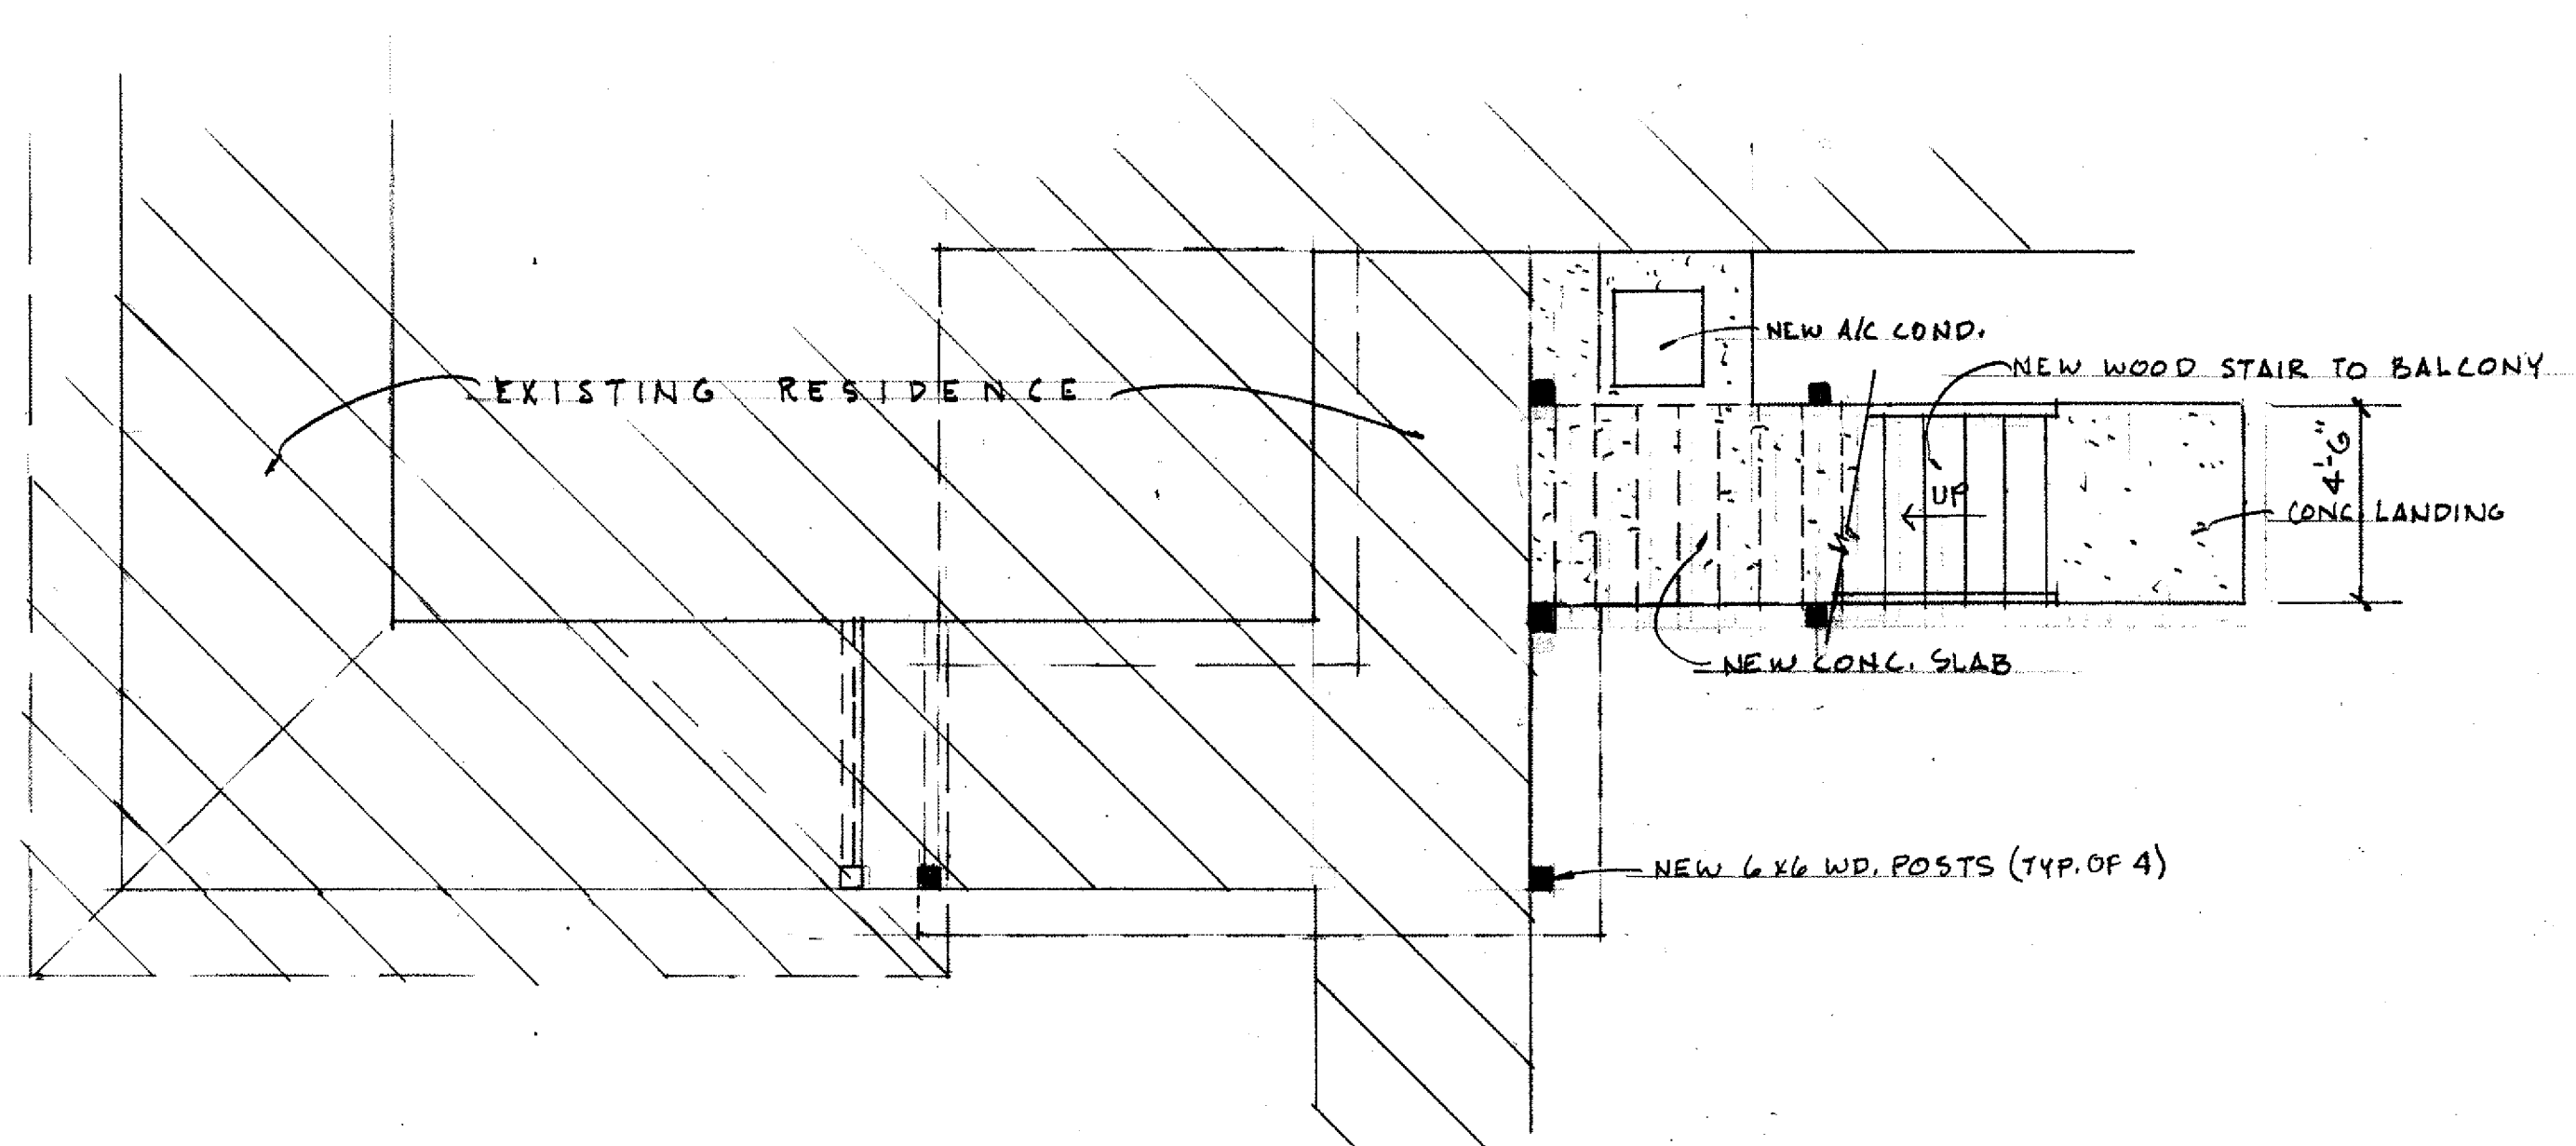

• PROPOSED 1<sup>st</sup> FLOOR PLAN • 1/4" = 1'-0"

HIST. BD.  
3/12/14

PROPOSED RENOVATIONS  
STUBLEY RESIDENCE  
CITY OF FT. PIERCE, FLORIDA

PETER B. COOK



COOK & MENARD  
ARCHITECTURE INC.  
STATE OF FLORIDA REGISTRATION NO. A48834  
906 DELAWARE AVE.  
FT. PIERCE, FLORIDA, 34950  
PHONE: (772) 468-7751  
FAX: (772) 468-4244

SHEET  
—  
OF  
TWO  
OF  
STUBLEY

# SKETCH/AREA TABLE ADDENDUM

SUBJECT

Property Address
City <span style="float: right;">State</span> <span style="float: right;">Zip</span>
Borrower
Lender/Client
Appraiser Name

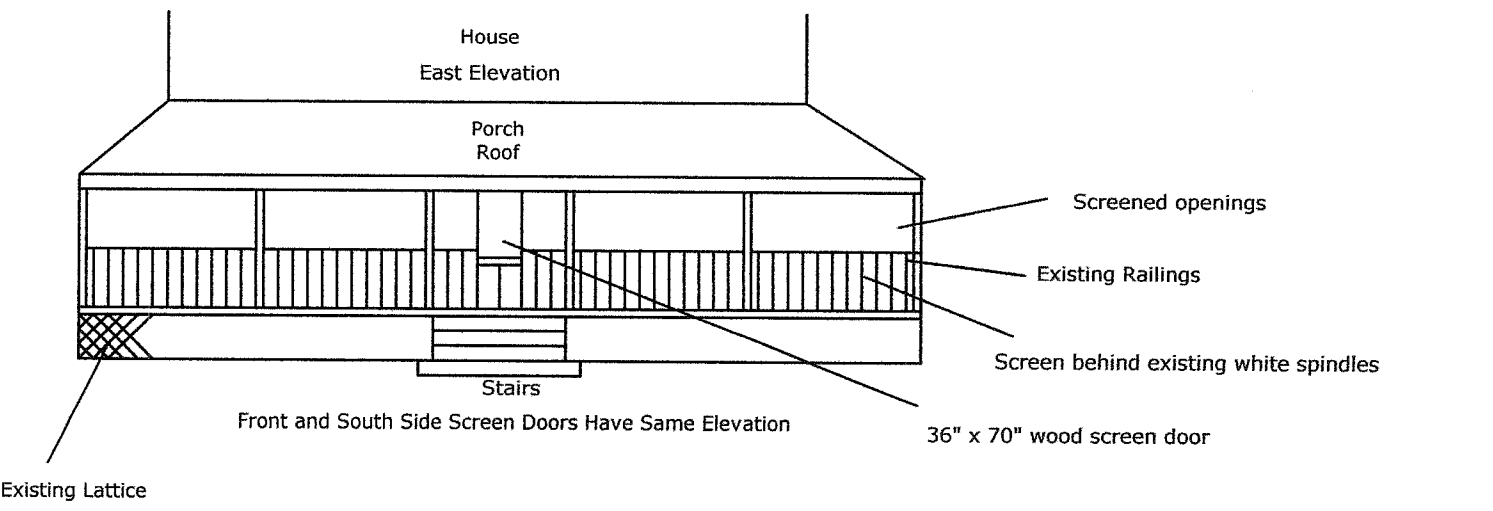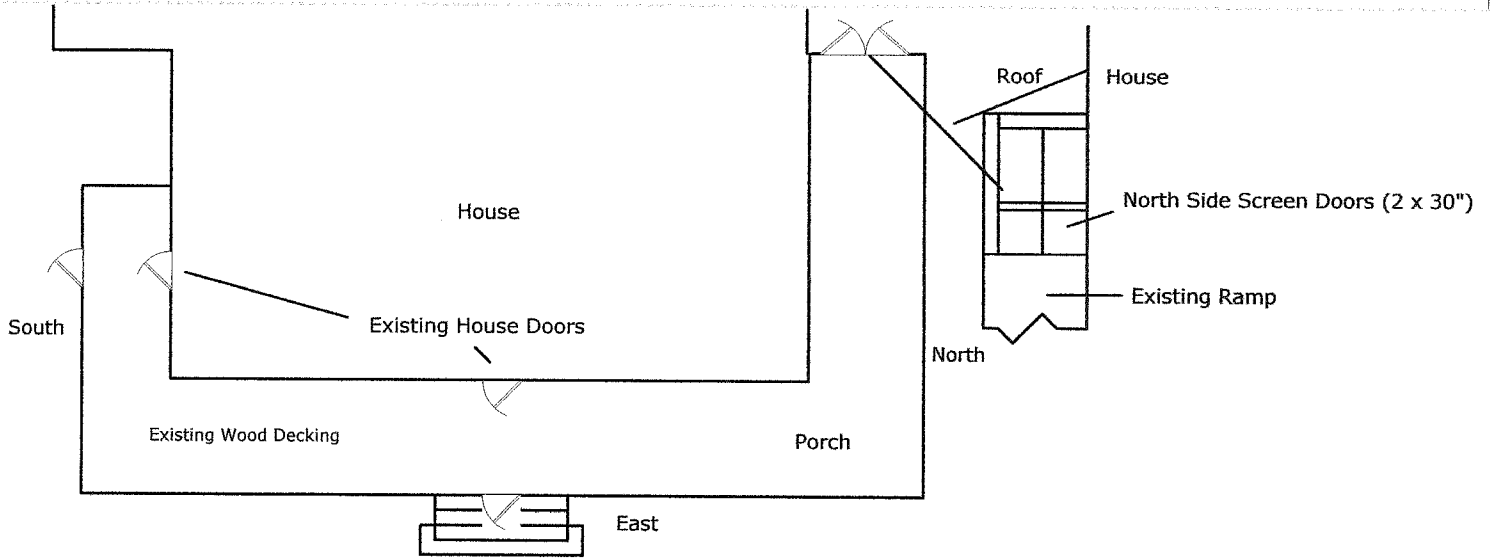

Scale: 1 = 13


Your Store: Port St Lucie, FL

Store Pickup

Your order may be available for pickup  
in Lowe's DR St Lucie 9801 FL

### Screen Tight T-Bar 36-in Natural Wood

### Screen Tight T-Bar 36-in Natural Wood Screen Door

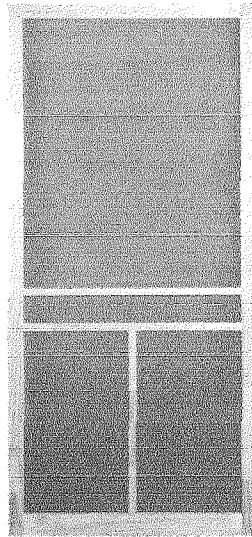

Depth

T-Bar

• Depth

• Area

Spec

Depth

Depth

Color

Over

Overall Height (Inches)

50.0

Series

T-Bar

Depth (Inches)

1.0

Movement/Swing

Winged

Hardware Included

No