

KEY NOTES:


- 1 DOOR TO BE REMOVED
- 2 WALL TO BE REMOVED
- 3 WINDOWS TO BE REMOVED
- 4 REMOVE WALL FOR 4'-0" OPENING

WALL LEGEND

- EXISTING WALLS TO BE REMOVED
- EXISTING WALLS TO REMAIN
- EXISTING DEMISING WALL
- PROPOSED FRAMED WALLS
- PROPOSED 1 HOUR WALL

FIRST FLOOR AS-BUILT / DEMOLITION FLOOR PLAN

1/8"

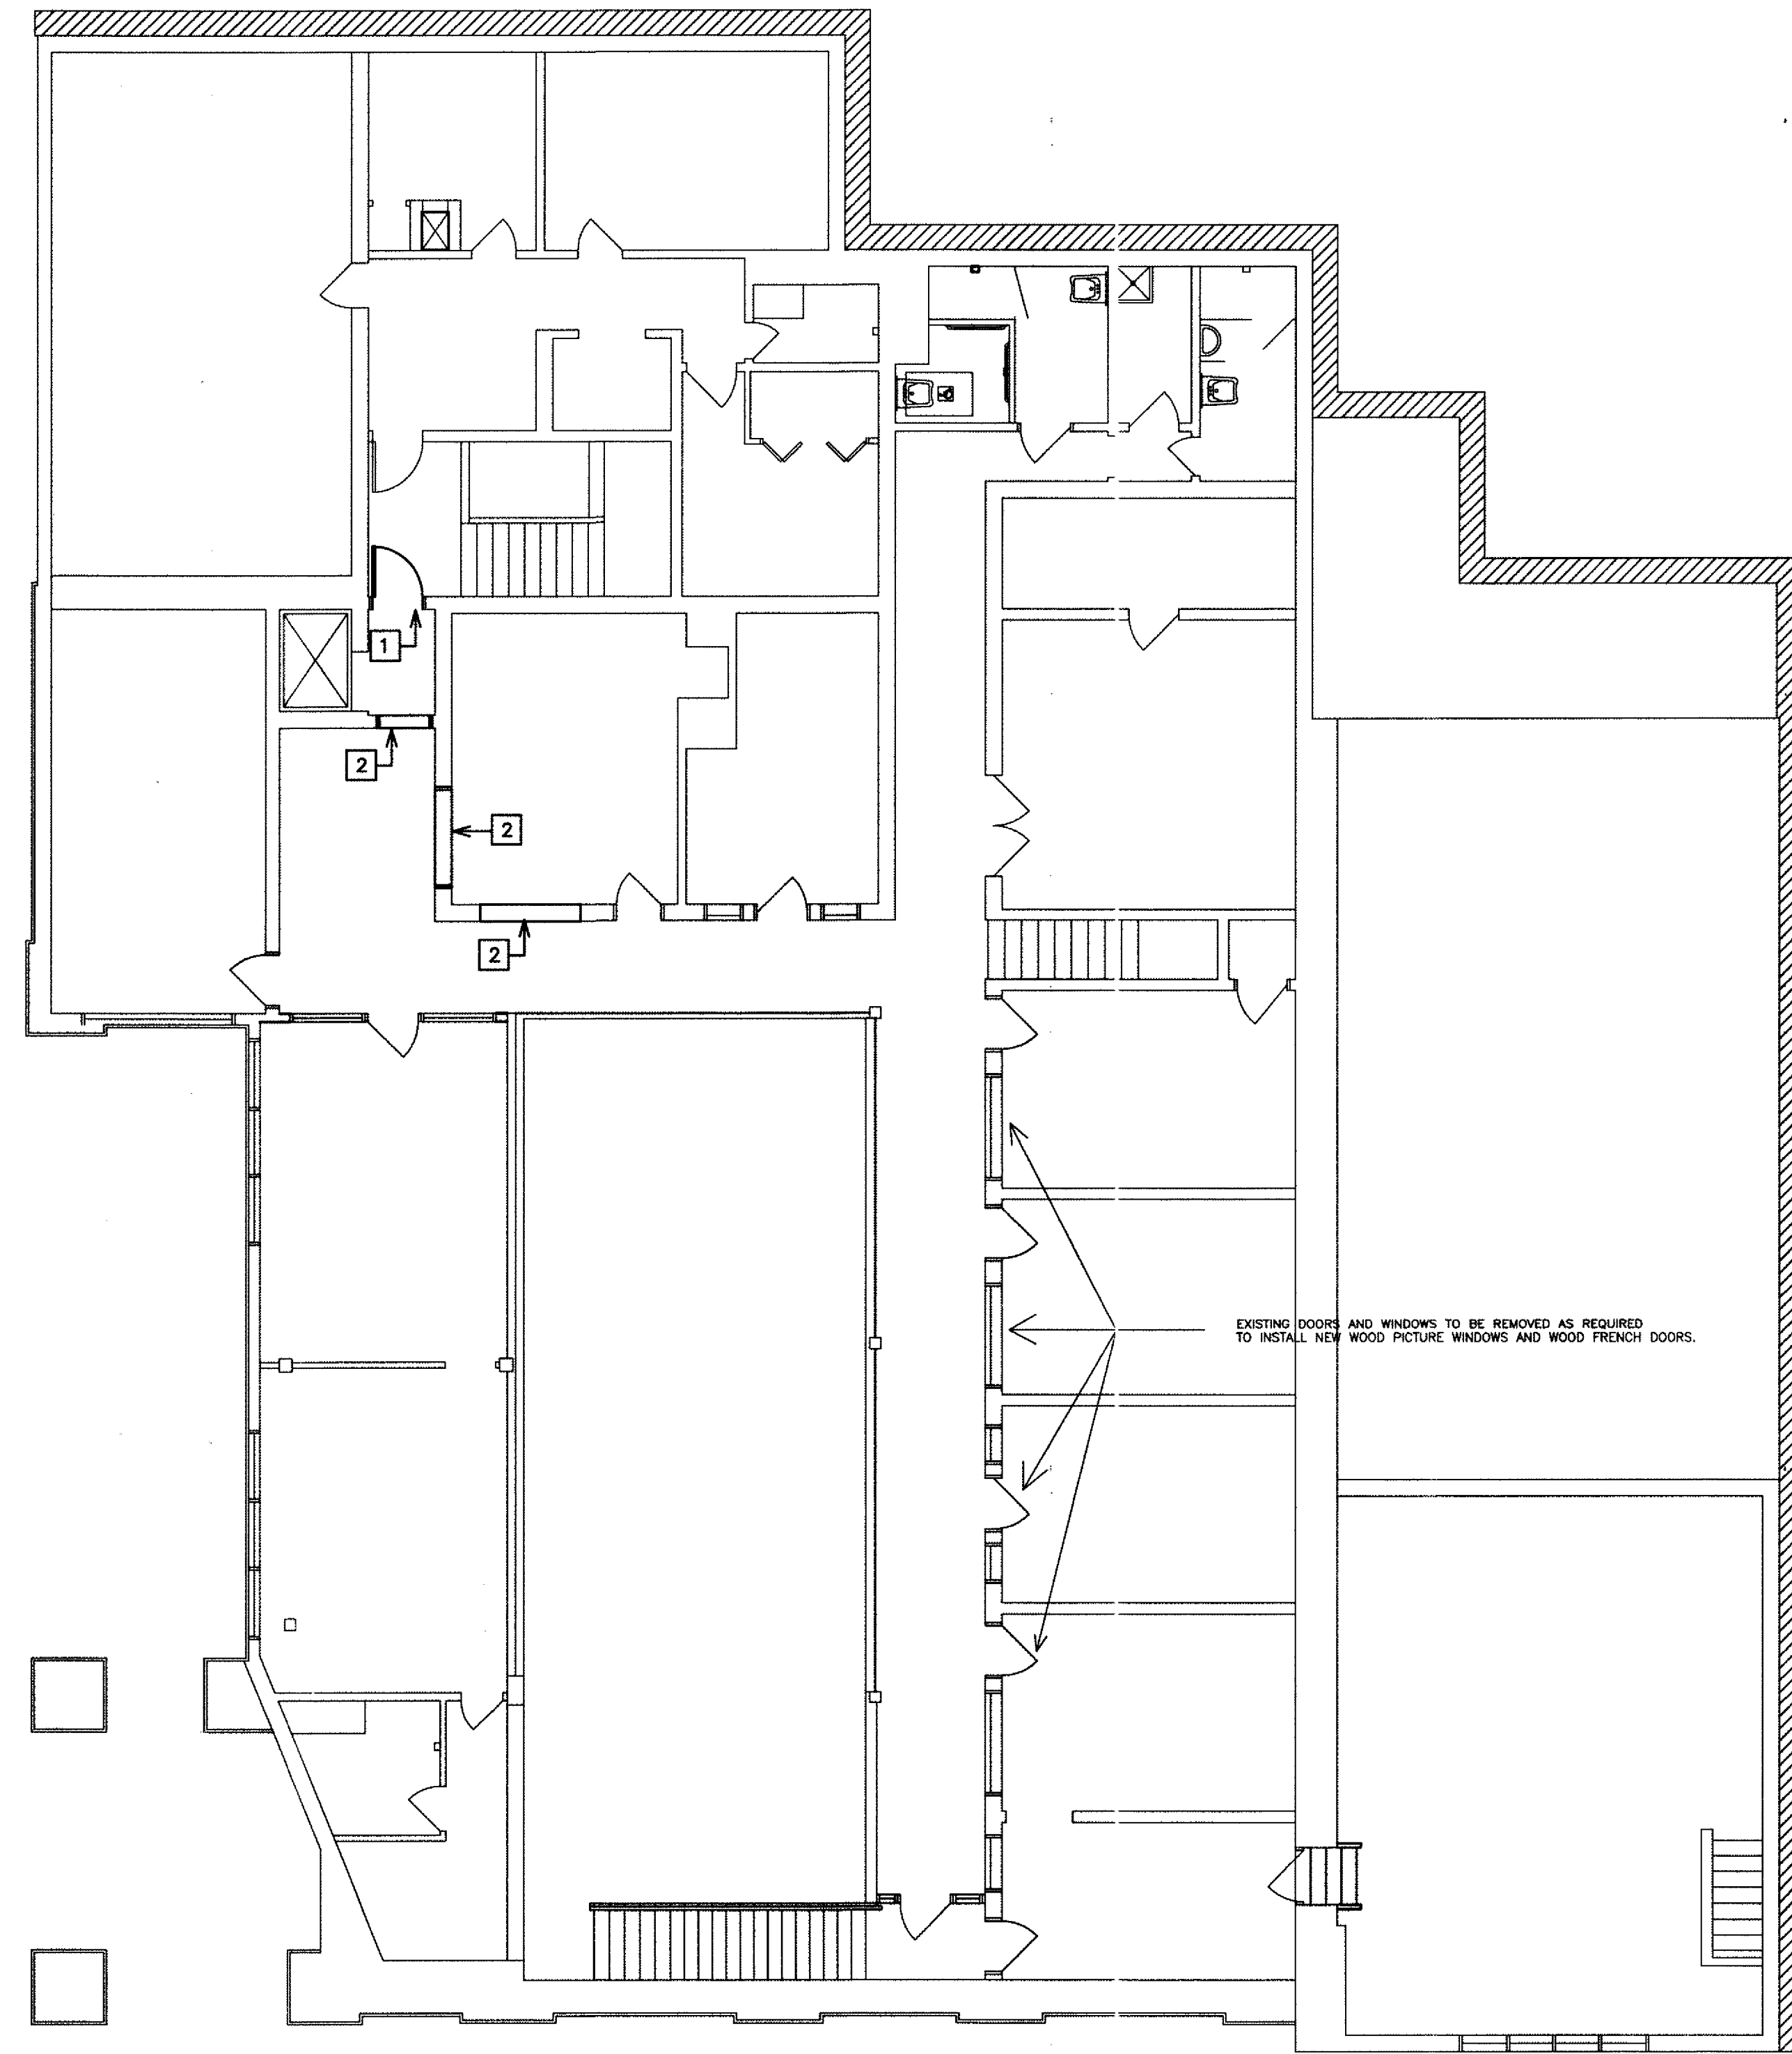

KEY NOTES:

- 1 DOOR TO BE REMOVED
- 2 WALL TO BE REMOVED
- 3 WINDOWS TO BE REMOVED
- 4 REMOVE WALL FOR 4'-0" OPENING

WALL LEGEND

- EXISTING WALLS TO BE REMOVED
- EXISTING WALLS TO REMAIN
- EXISTING DEMISING WALL
- PROPOSED FRAMED WALLS
- PROPOSED 1 HOUR WALL

EXISTING DOORS AND WINDOWS TO BE REMOVED AS REQUIRED TO INSTALL NEW WOOD PICTURE WINDOWS AND WOOD FRENCH DOORS.

REHABILITATION TO 100 SOUTH 2ND STREET  
THE GALLERIA OF PIERCE HARBOR  
CITY OF FT. PIERCE,  
FLORIDA

PETER B COOK


COOK & MENARD  
ARCHITECTURE INC.  
STATE OF FLORIDA REGISTRATION NO. AA 0003484  
806 DELAWARE AVE  
FT. PIERCE, FLORIDA 34950  
PHONE: (772) 460-4244  
FAX: (772) 460-4244

SECOND FLOOR AS-BUILT / DEMOLITION FLOOR PLAN

1/8"


- KEY NOTES:
- 1 DOOR TO BE REMOVED
  - 2 WALL TO BE REMOVED
  - 3 WINDOWS TO BE REMOVED
  - 4 REMOVE WALL FOR 4'-0" OPENING

- WALL LEGEND
- EXISTING WALLS TO BE REMOVED
  - EXISTING WALLS TO REMAIN
  - EXISTING DEMISING WALL
  - PROPOSED FRAMED WALLS
  - PROPOSED 1 HOUR WALL

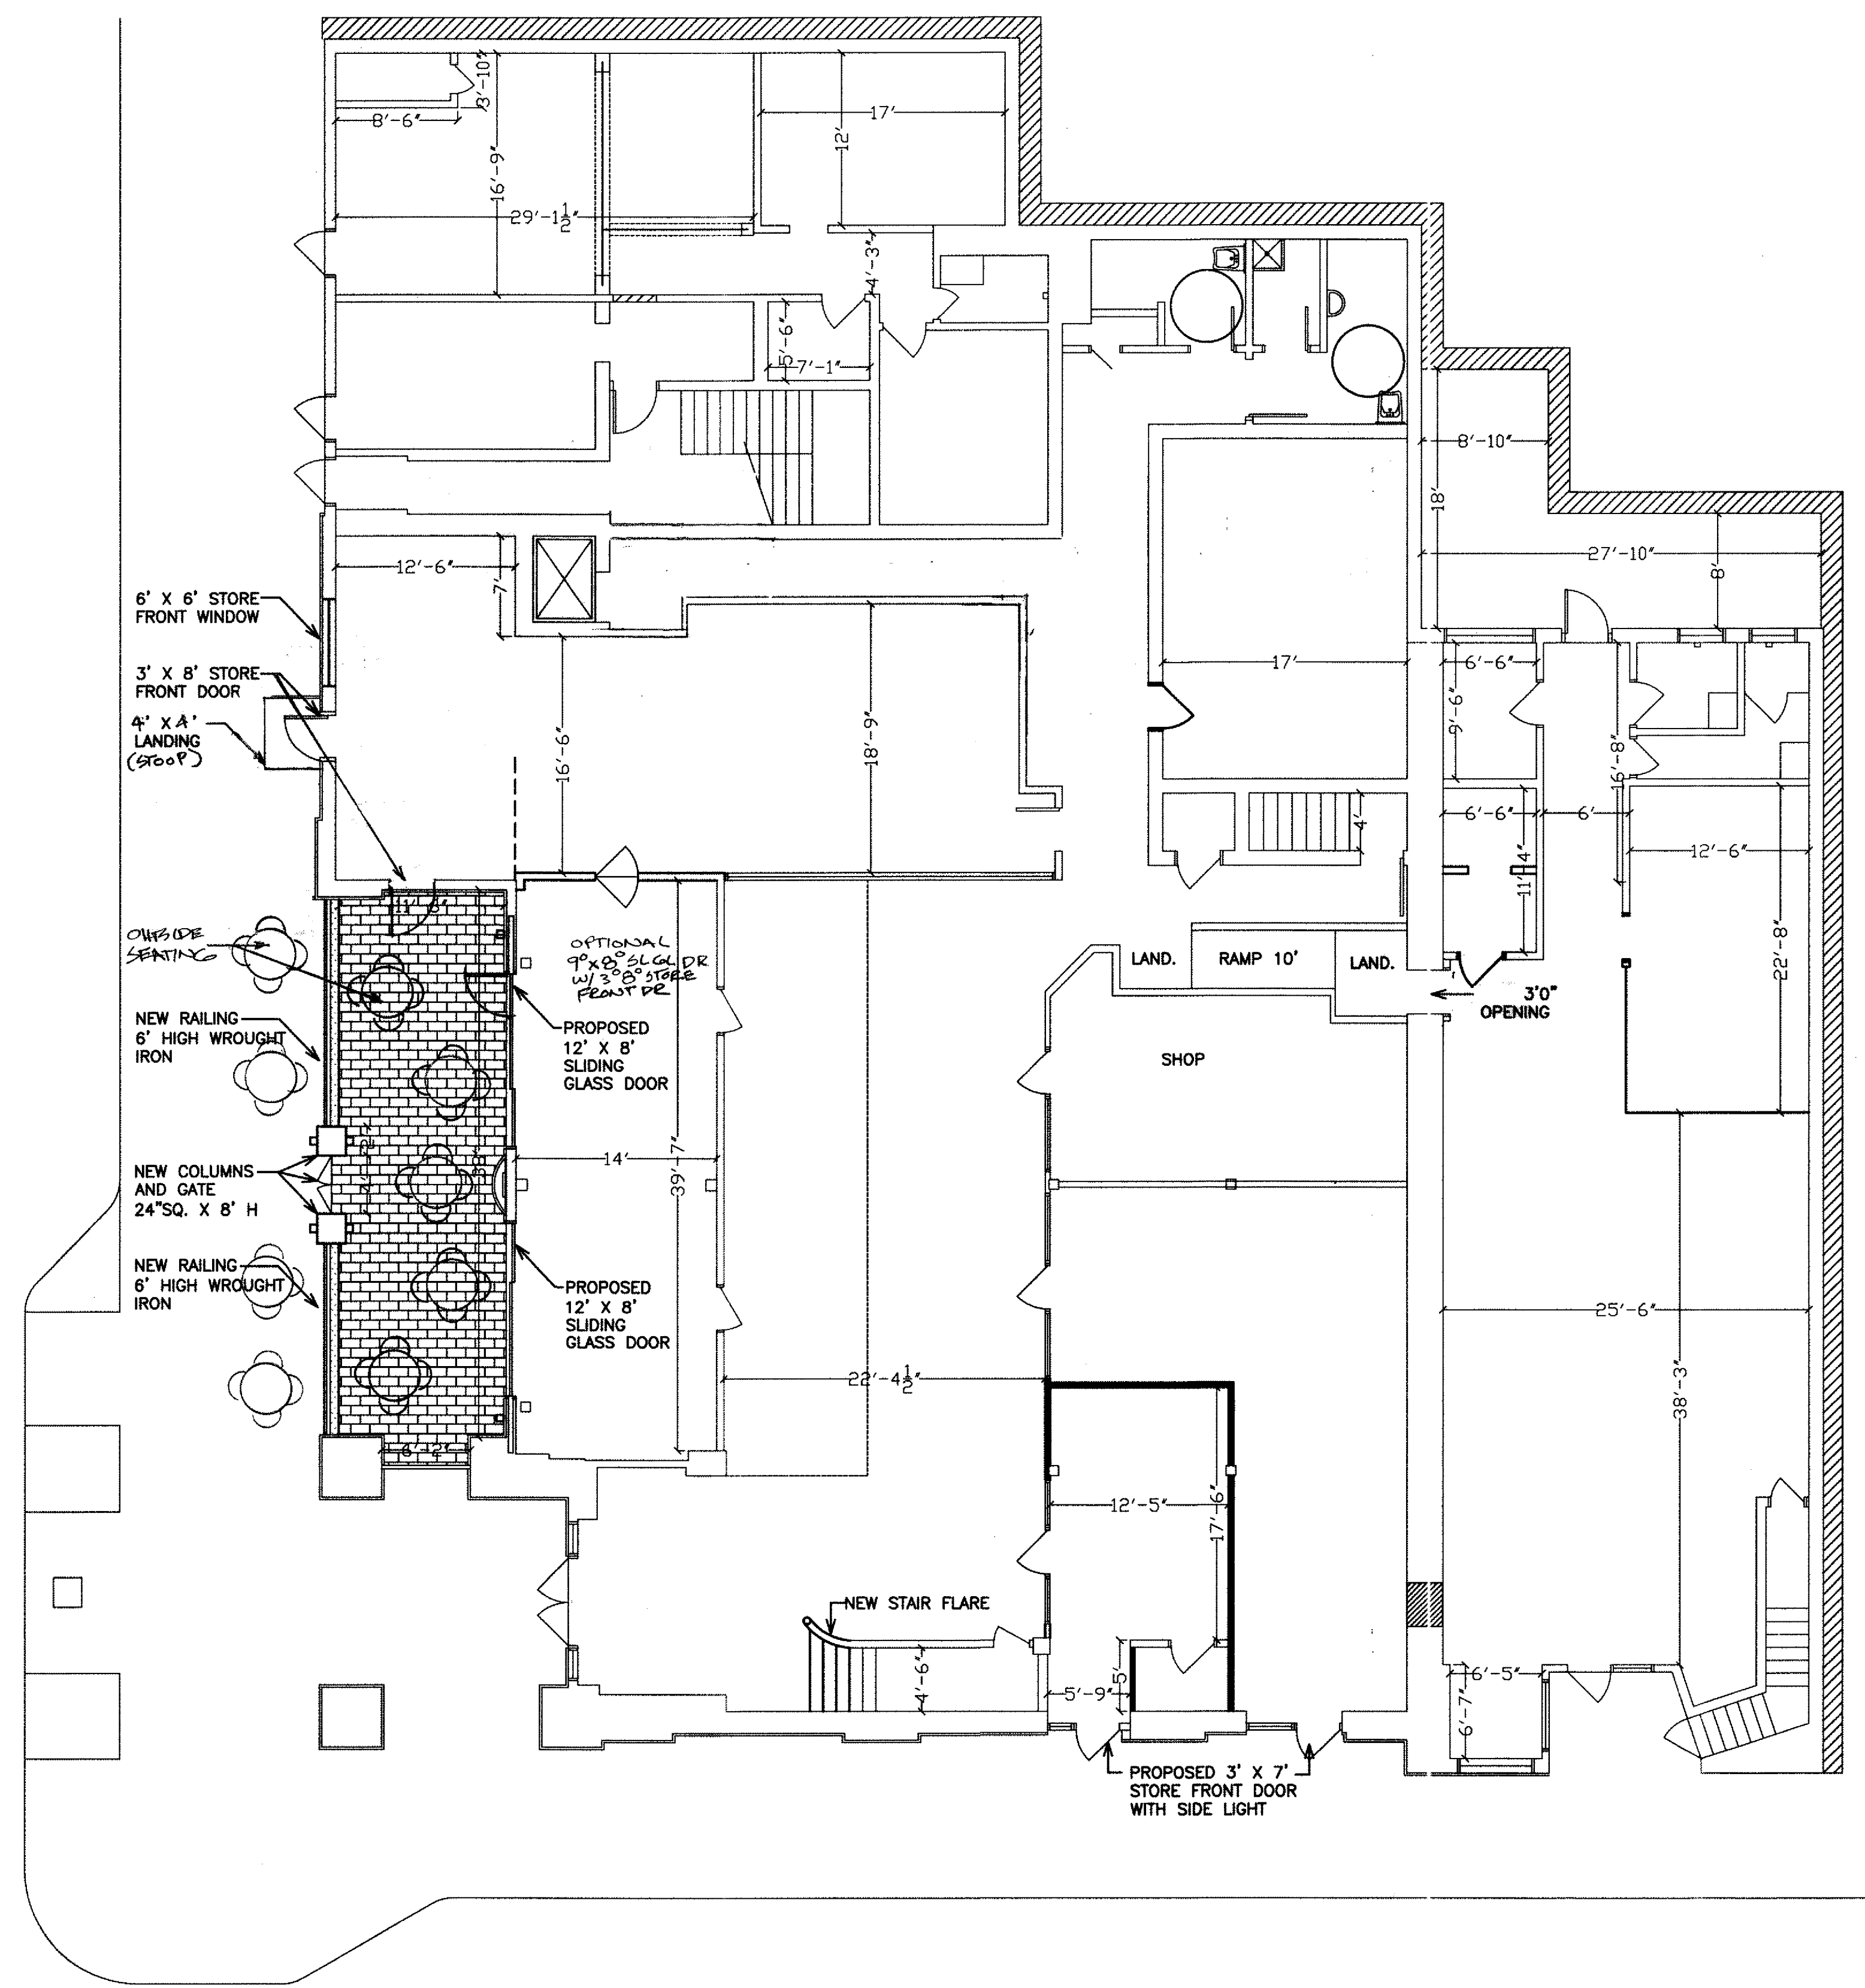

FIRST FLOOR RENOVATION FLOOR PLAN


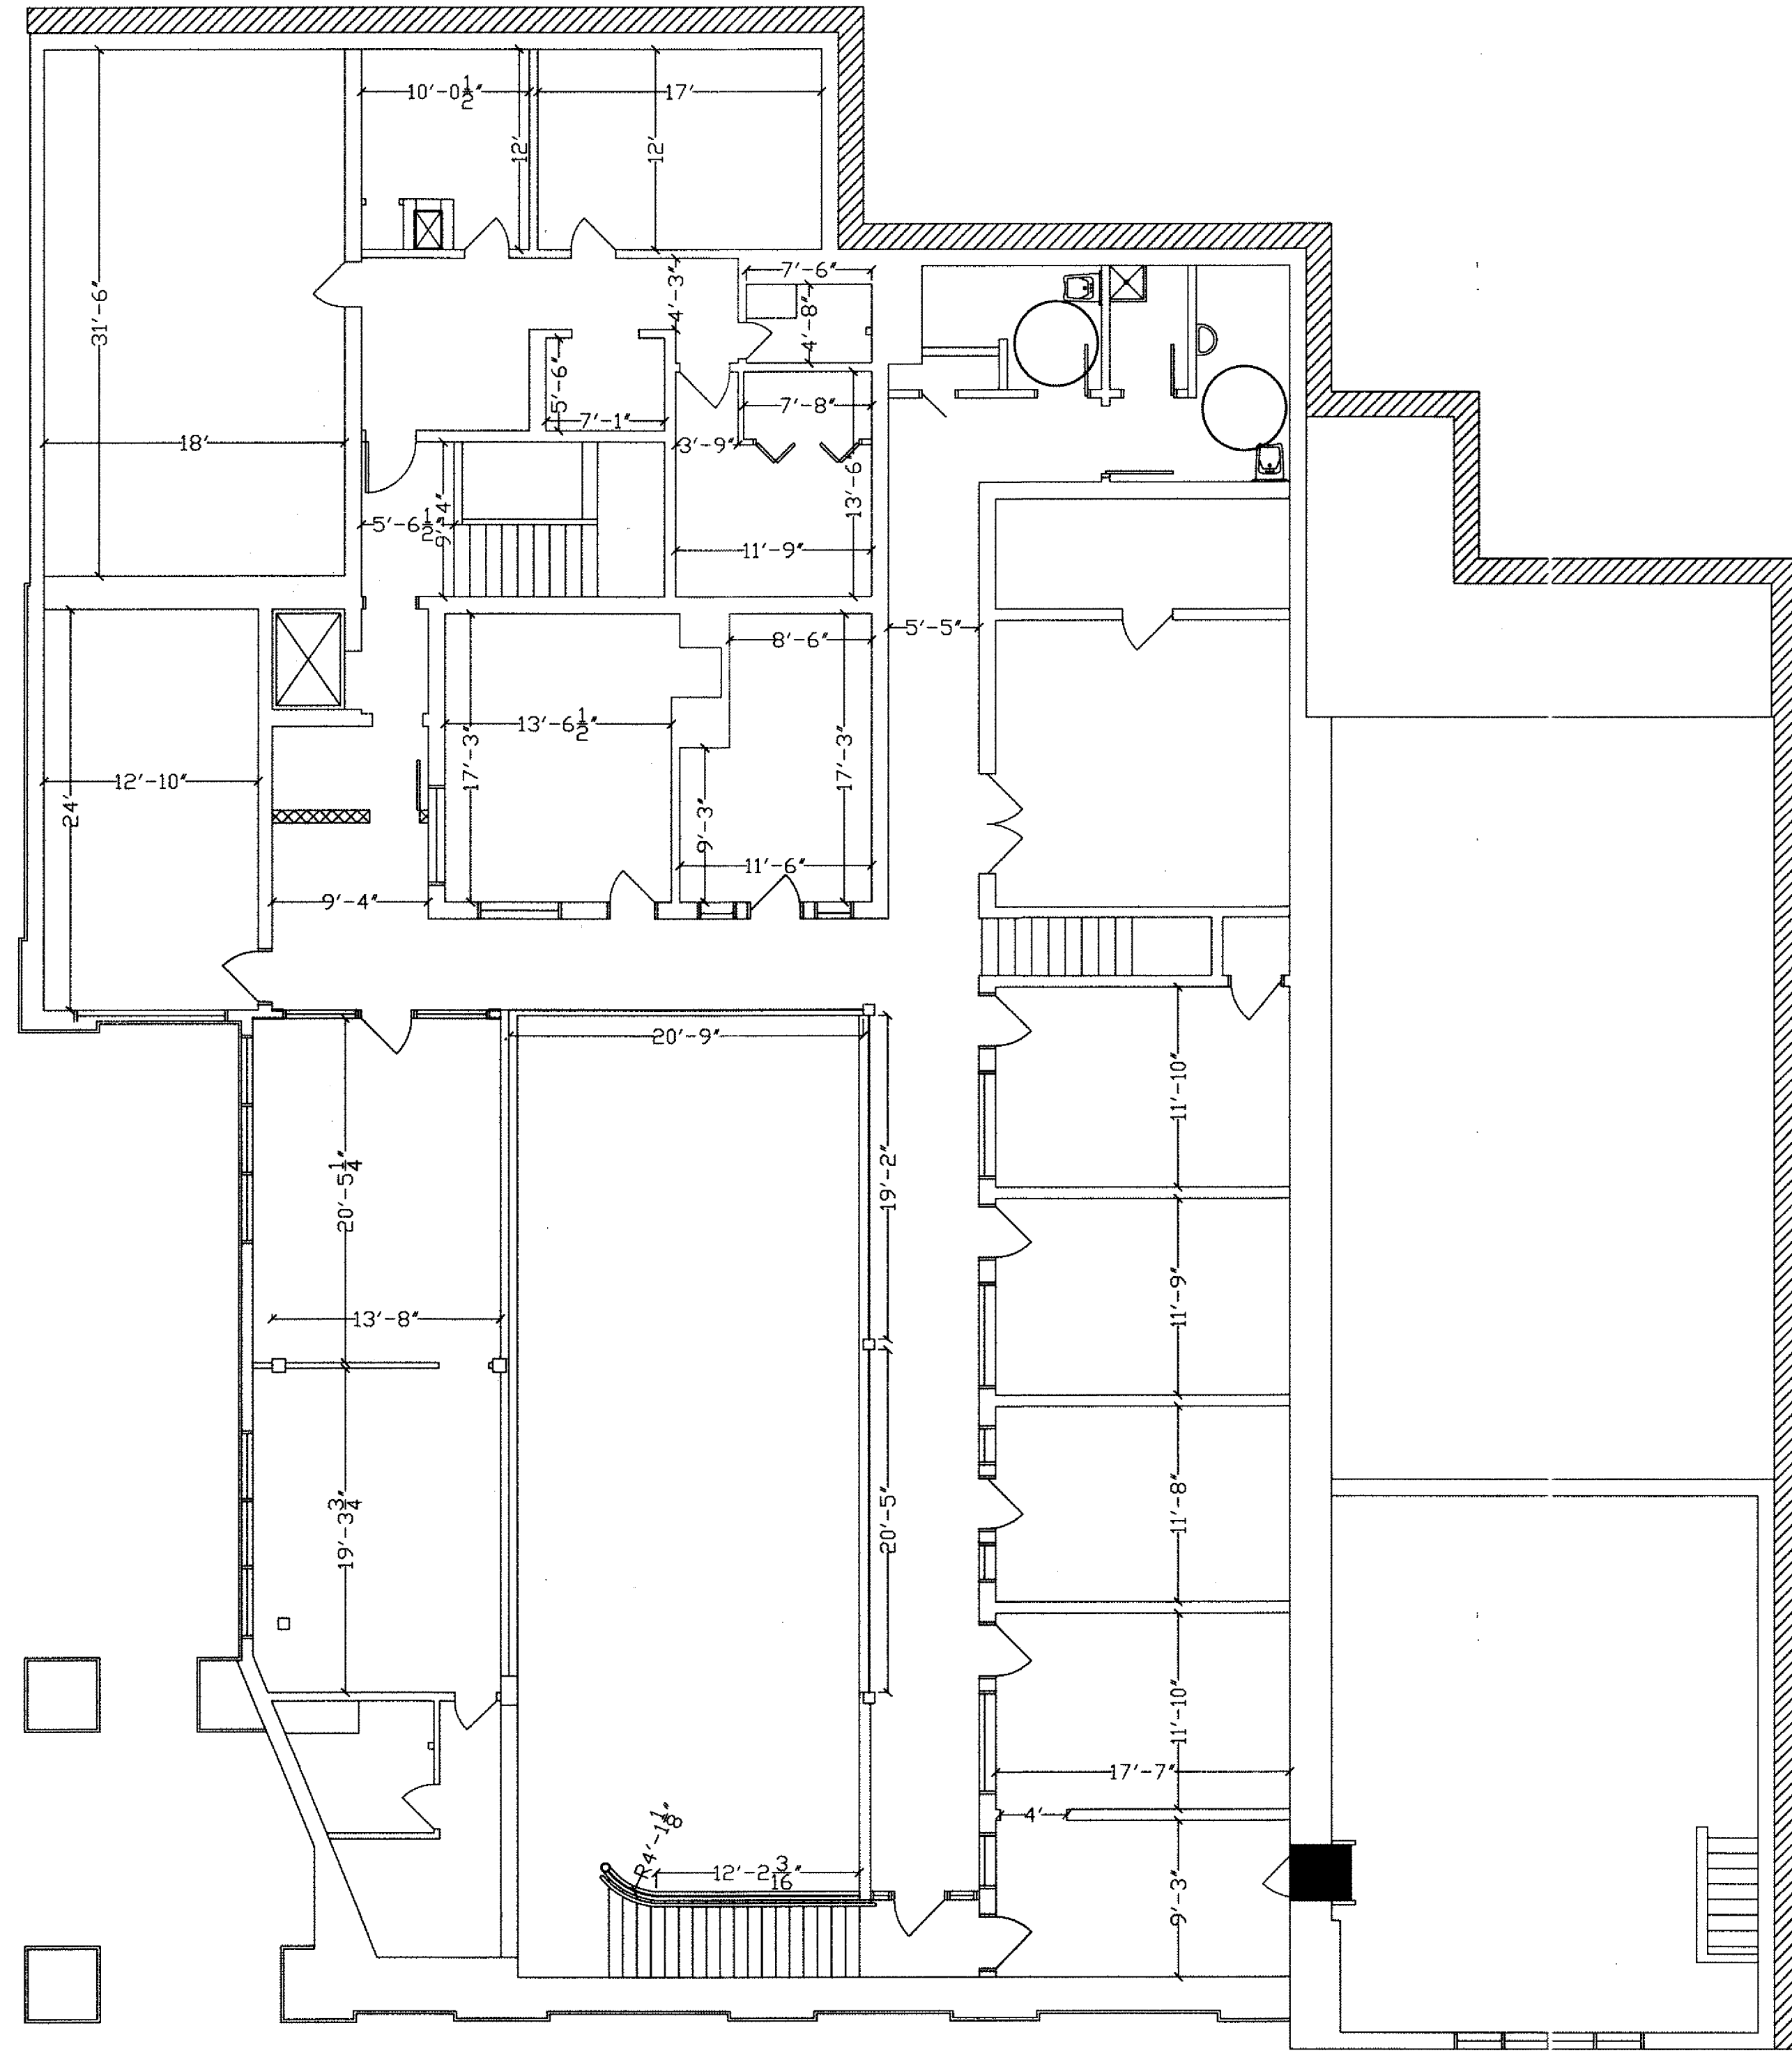



1/8"



KEY NOTES:

- 1 DOOR TO BE REMOVED
- 2 WALL TO BE REMOVED
- 3 WINDOWS TO BE REMOVED
- 4 REMOVE WALL FOR 4'-0" OPENING

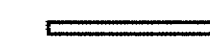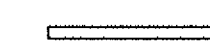WALL LEGEND

-  EXISTING WALLS TO BE REMOVED
-  EXISTING WALLS TO REMAIN
-  EXISTING DEMISING WALL
-  PROPOSED FRAMED WALLS
-  PROPOSED 1 HOUR WALL

SECOND FLOOR RENOVATION FLOOR PLAN

1/8"

DATE:  
9-4-14

HISTORICAL BOARD

REHABILITATION TO 100 SOUTH 2ND STREET  
THE GALLERIA OF PIERCE HARBOR  
CITY OF FT. PIERCE,  
FLORIDA

PETER B COOK

COOK & MENARD  
ARCHITECTURE INC.

STATE OF FLORIDA REGISTRATION NO. AA 0003464  
606 DELAWARE AVE.  
FT. PIERCE, FLORIDA 34950  
PHONE: (772) 460 - 7751  
FAX: (772) 460 - 4244


SHEET

A-4

OF  
2 OF X


DATE:  
9-4-14

HISTORICAL BOARD

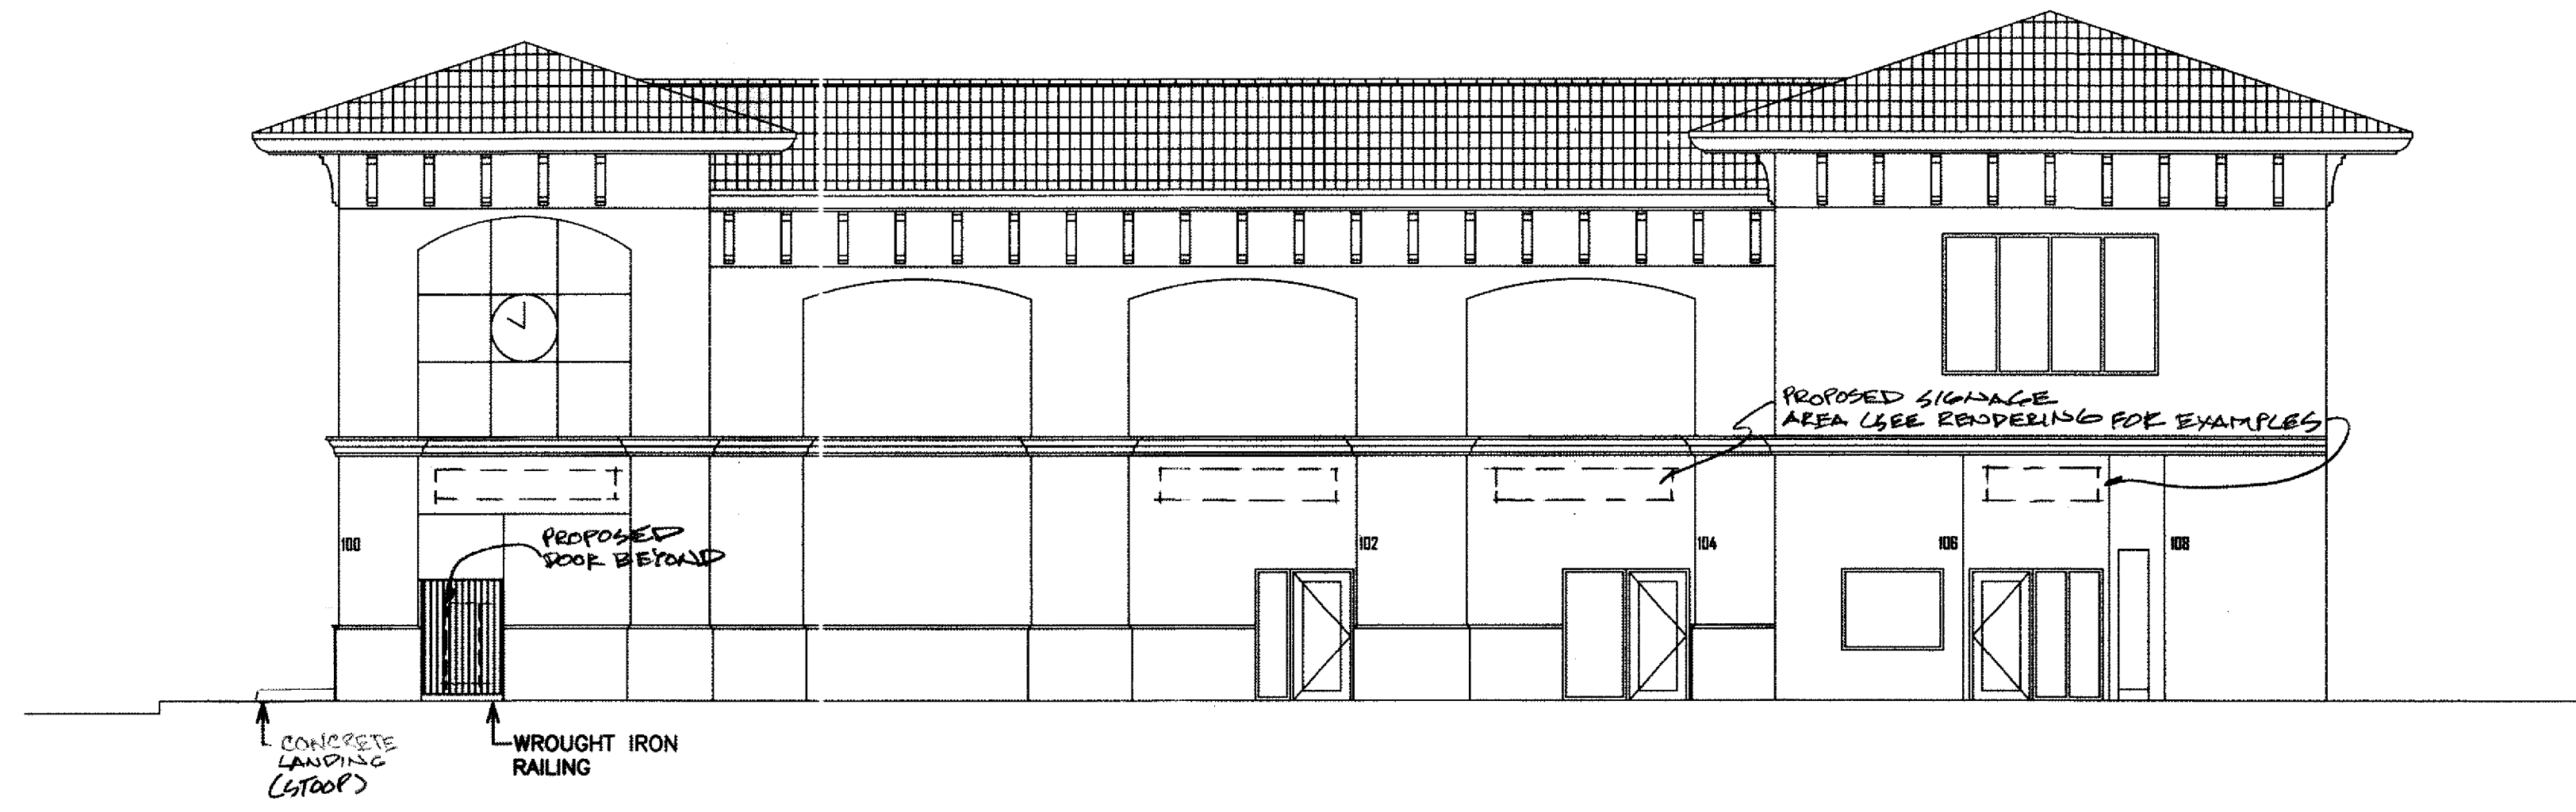

PROPOSED ELEVATION (SECOND STREET)

SCALE: 1/8" = 1' 0"

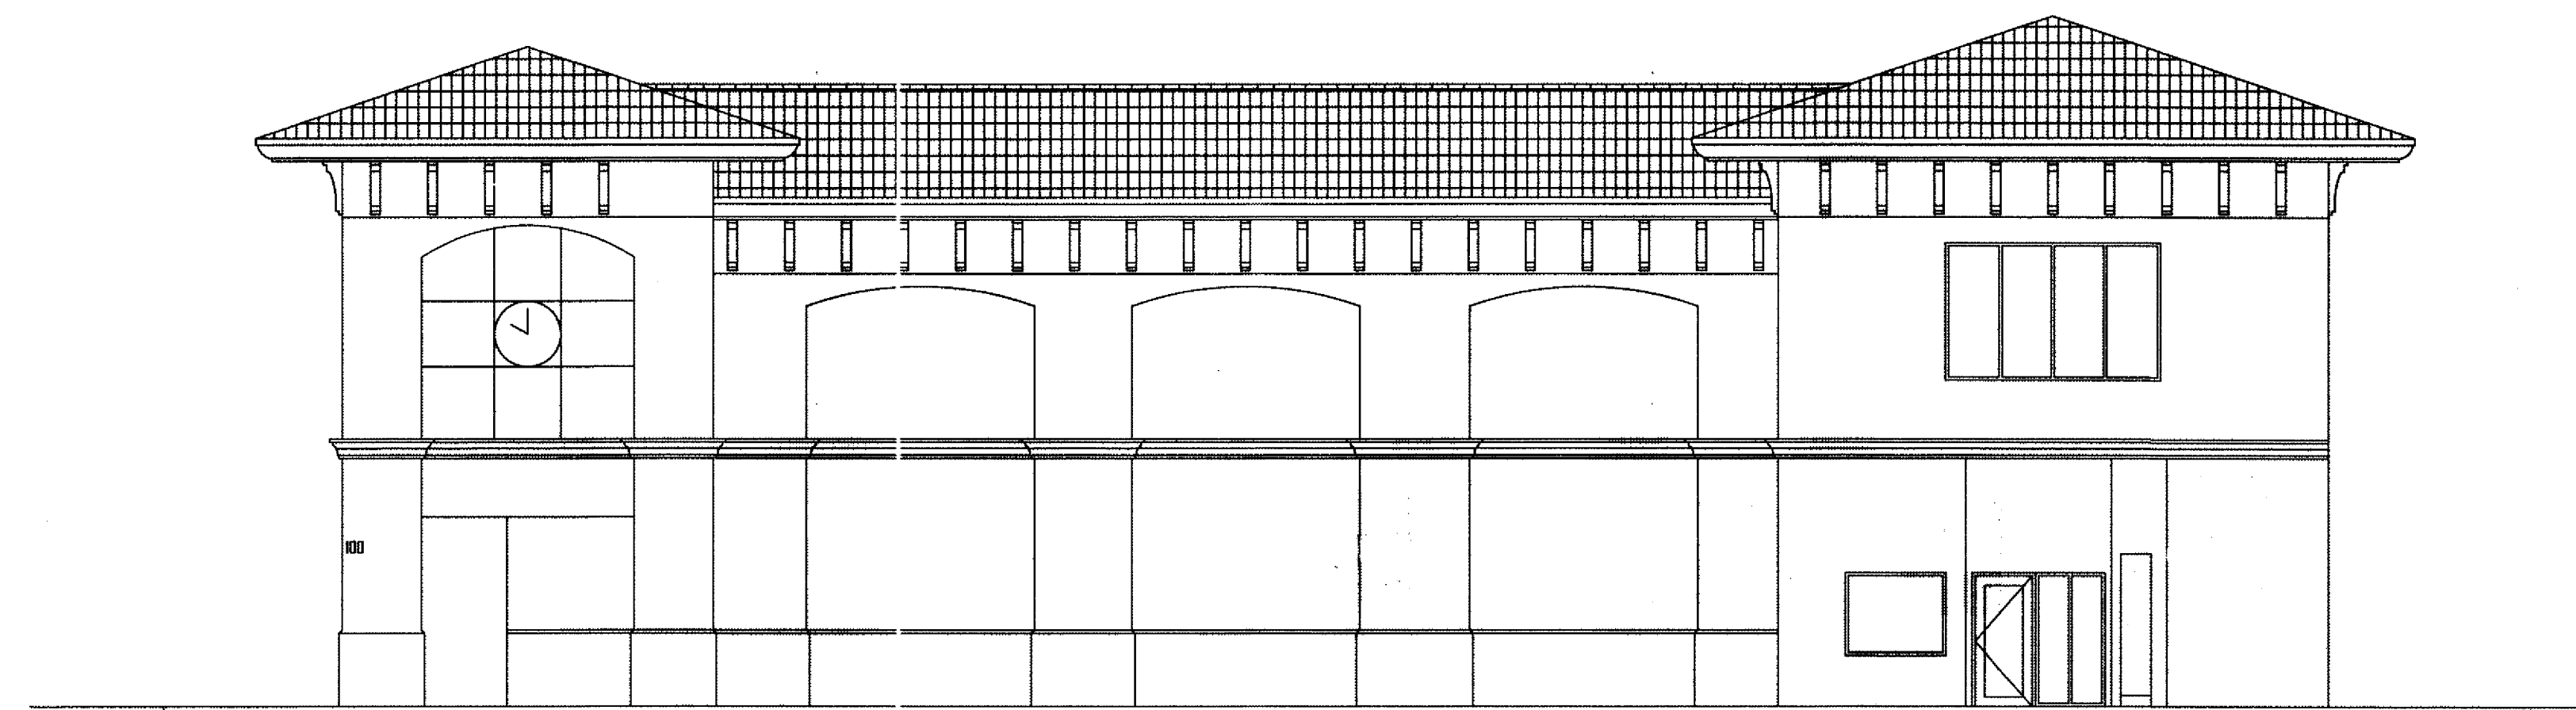

AS BUILT ELEVATION (SECOND STREET)

SCALE: 1/8" = 1' 0"

REHABILITATION TO 100 SOUTH 2ND STREET  
THE GALLERIA OF PIERCE HARBOR  
CITY OF FT. PIERCE,  
FLORIDA

PETER B COOK

COOK & MENARD  
ARCHITECTURE INC.


805 DELAWARE AVE.  
STATE OF FLORIDA REGISTRATION NO. AA 0003494  
FT. PIERCE, FLORIDA 34950  
PHONE: (772) 460 - 7751  
FAX: (772) 460 - 4244

SHEET

A-5


OF

2 OF X

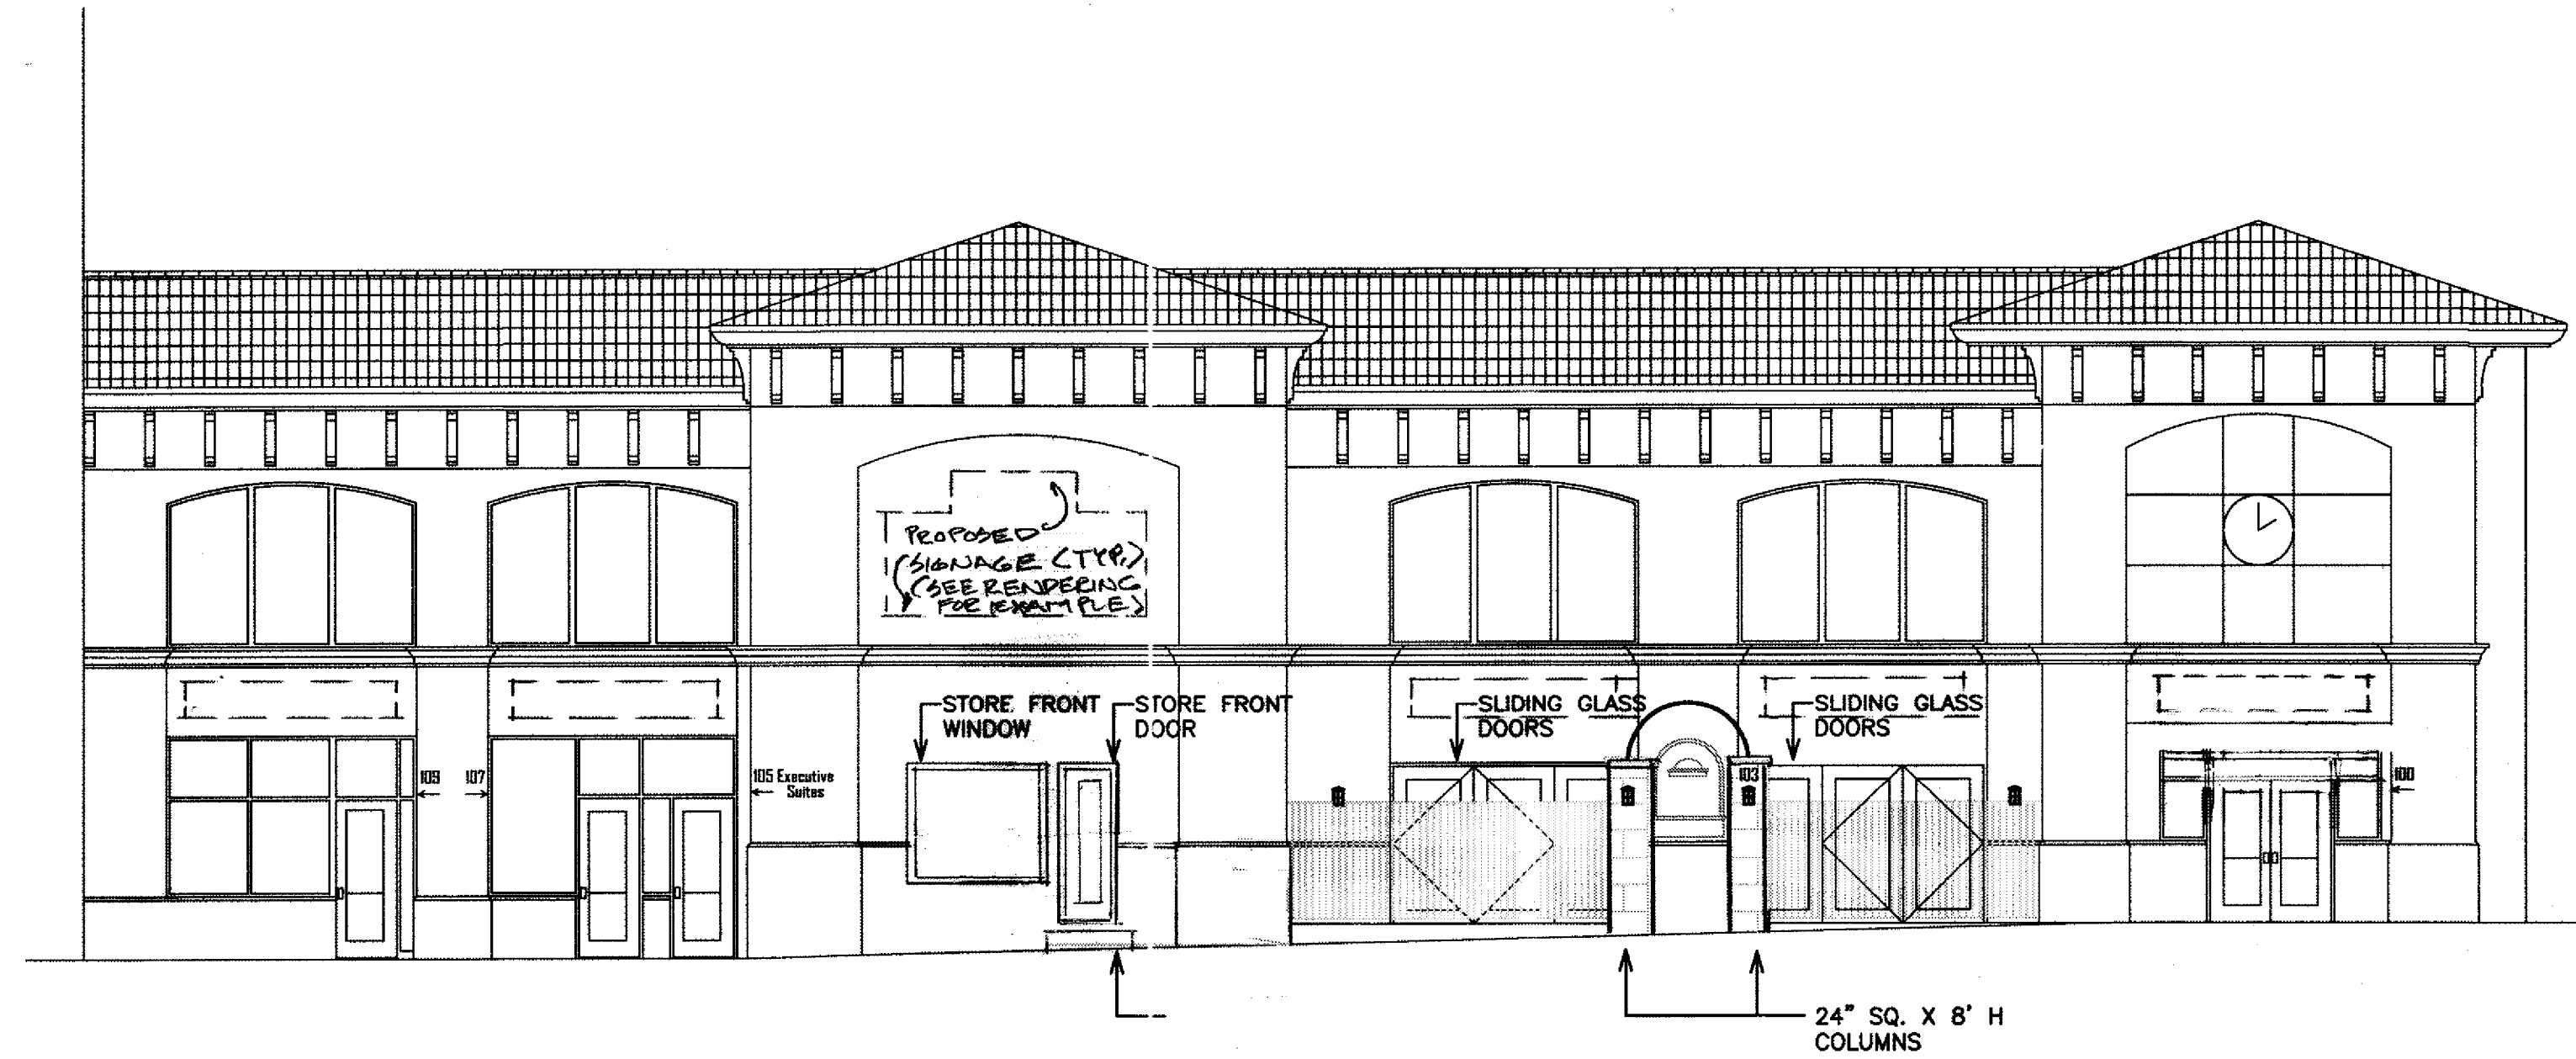


PROPOSED ELEVATION (ORANGE AVENUE)

SCALE: 1/8" = 1' 0"

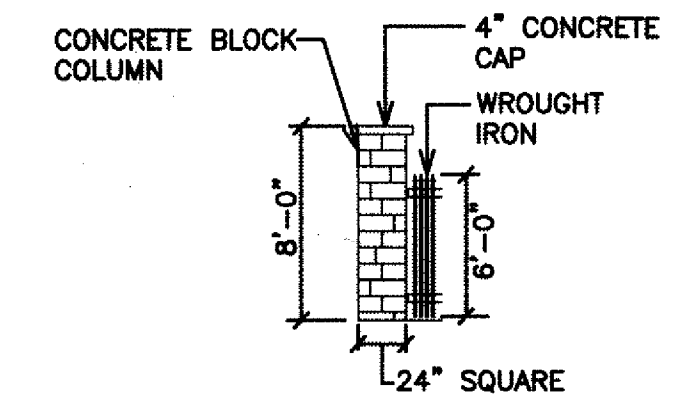

COLUMN / RAILING DETAIL  
SCALE: 1/8" = 1' 0"

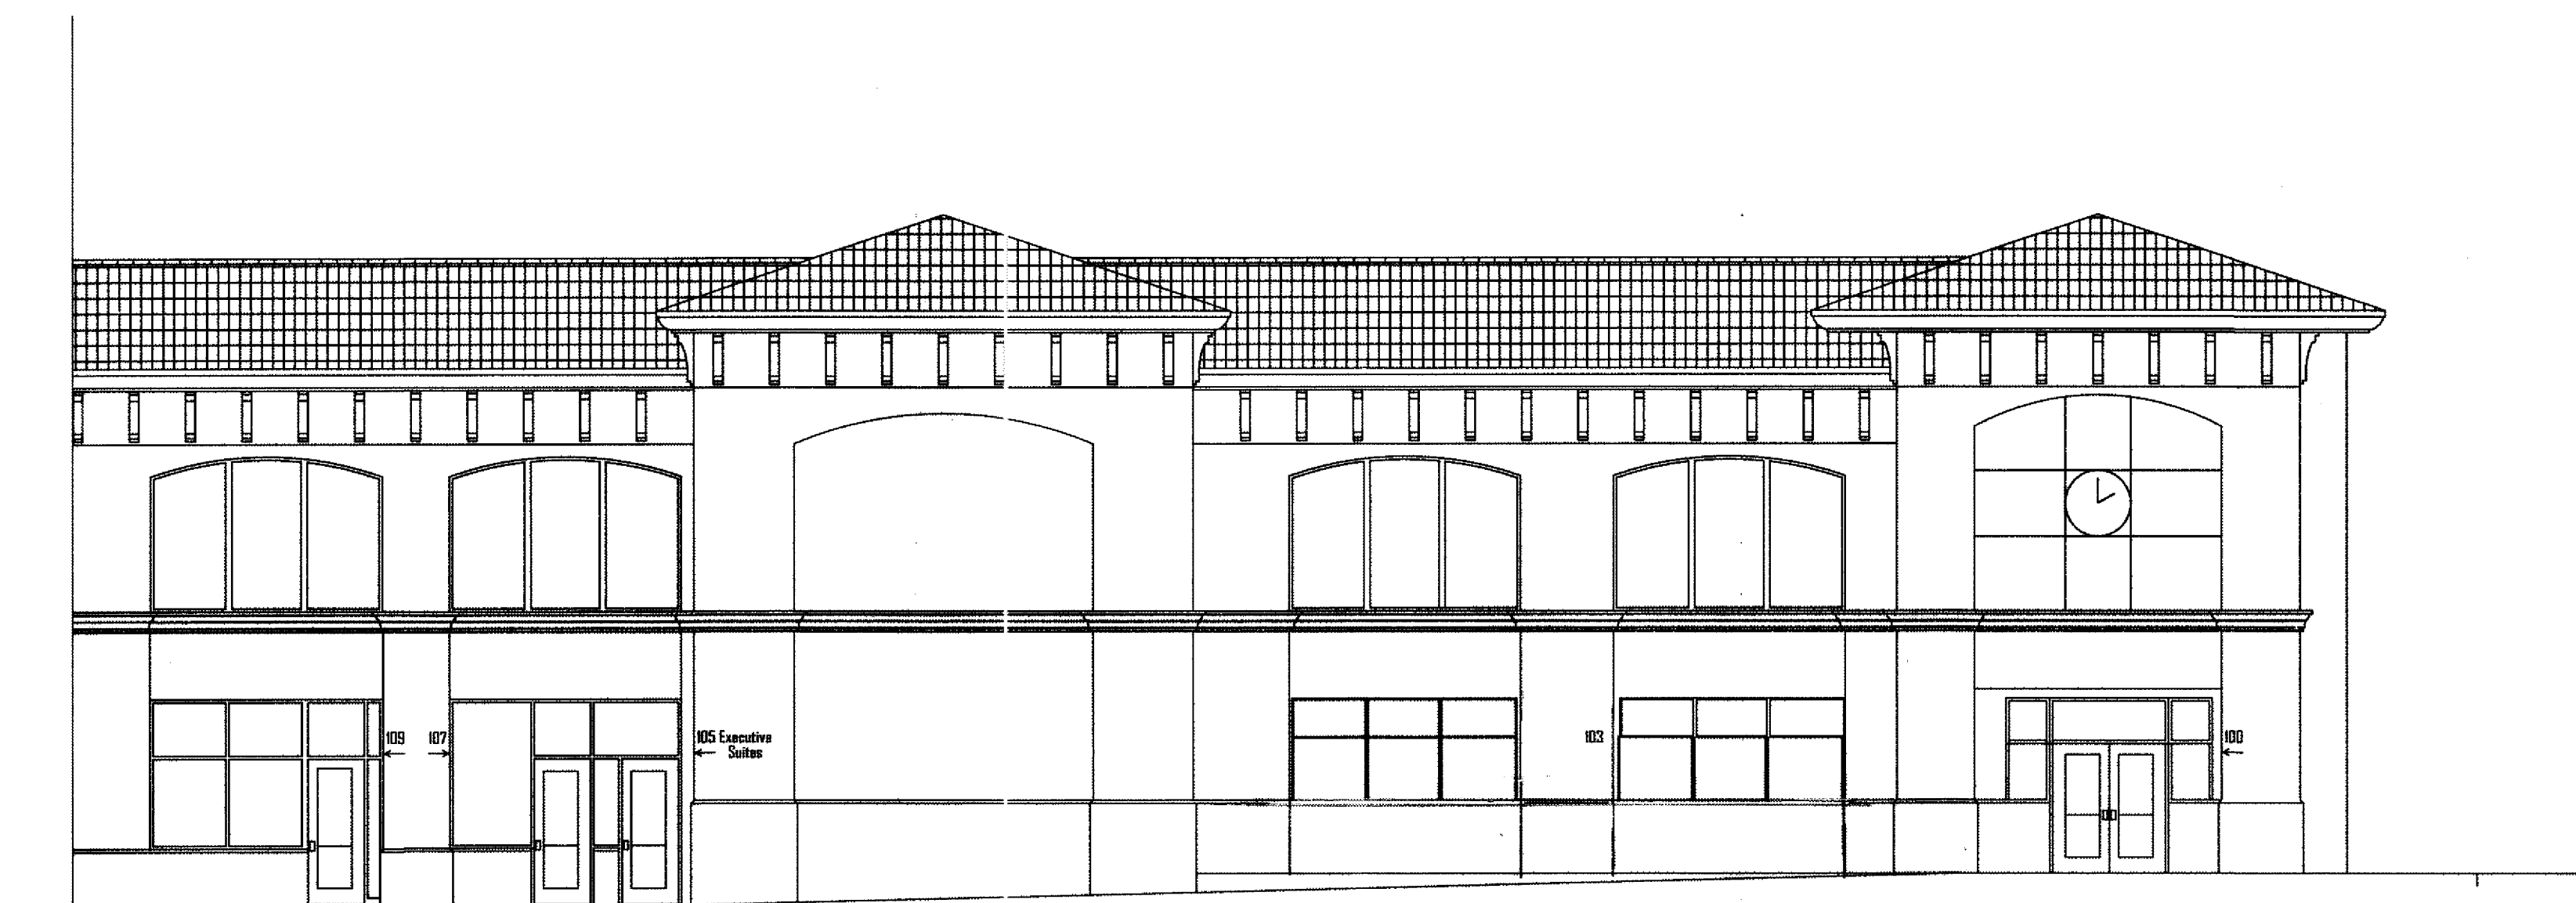

AS BUILT ELEVATION (ORANGE AVENUE)

SCALE: 1/8" = 1' 0"

DATE:  
9-4-14

HISTORICAL BOARD

REHABILITATION TO 100 SOUTH 2ND STREET  
THE GALLERIA OF PIERCE HARBOR  
CITY OF FT. PIERCE, FLORIDA

PETER B COOK

COOK & MENARD  
ARCHITECTURE INC.

STATE OF FLORIDA REGISTRATION NO. AA 0003484  
FT. PIERCE, FLORIDA 34950  
PHONE: (772) 460 - 7751  
FAX: (772) 460 - 4244

SHEET

A-6

OF  
2 OF X