

UNIT I

UNIT J

UNIT K

UNIT L

UNIT M

UNIT N

AS-BUILT FLOOR PLAN

1/4"


3/2/16
CONDITIONAL
USE
3/21/16 RANNING BC.

ADVANCED SCHOLARS
CHRISTIAN ACADEMY
FT. PIERCE, FLORIDA

PETER B. COOK

COOK & MENARD
ARCHITECTURE INC.
STATE OF FLORIDA REGISTRATION NO. A40005494
FT. PIERCE, FLORIDA 34950
806 DELAWARE AVE.
PHONE: (872) 460-7751
FAX: (872) 460-4244

SHEET
1
OF TWO
CHRISTIAN ACADEMY

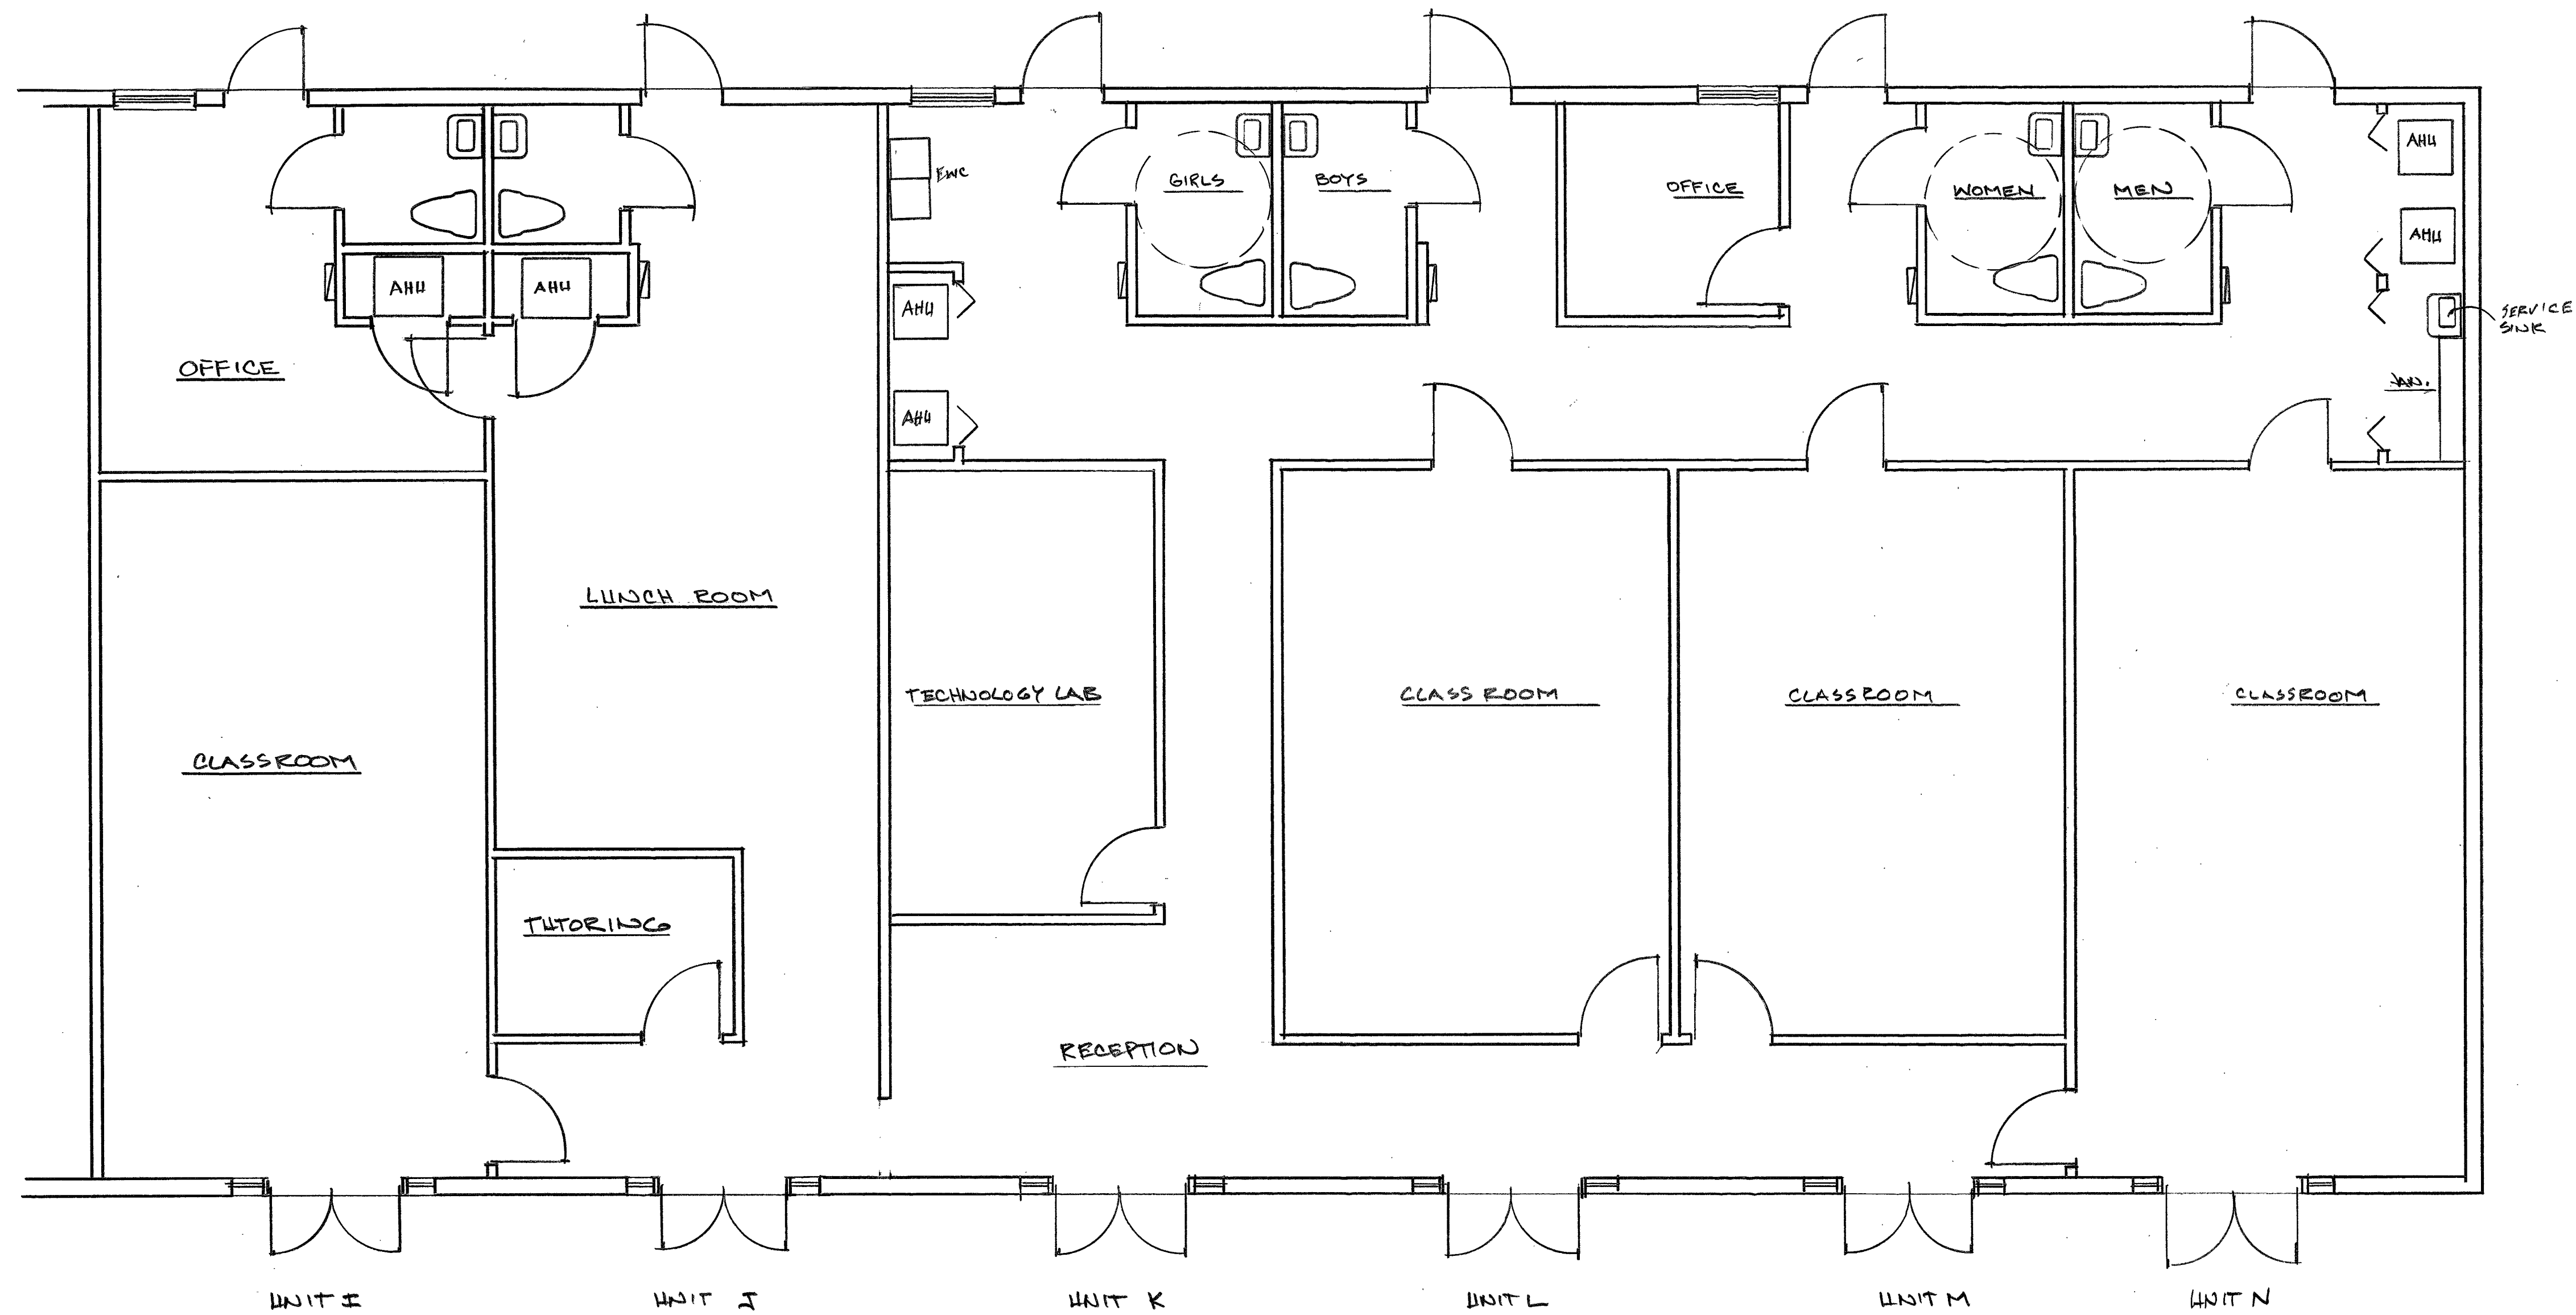

PROPOSED FLOOR PLAN

1/4"

3/20/16
 COORDINATION
 USE
 3/31/16 PLANNING Bd.

ADVANCED SCHOLARS
CHRISTIAN ACADEMY
 FT. PIERCE, FLORIDA

PETER B. COOK

COOK & MENARD
 ARCHITECTURE INC.
 STATE OF FLORIDA REGISTRATION NO. A0003494
 FT. PIERCE, FLORIDA 34950
 806 DELAWARE AVE.
 PHONE: (772) 460-7751
 FAX: (772) 460-4244

SHEET
2
 OF TWO
 CHRISTIAN
 ACADEMY