


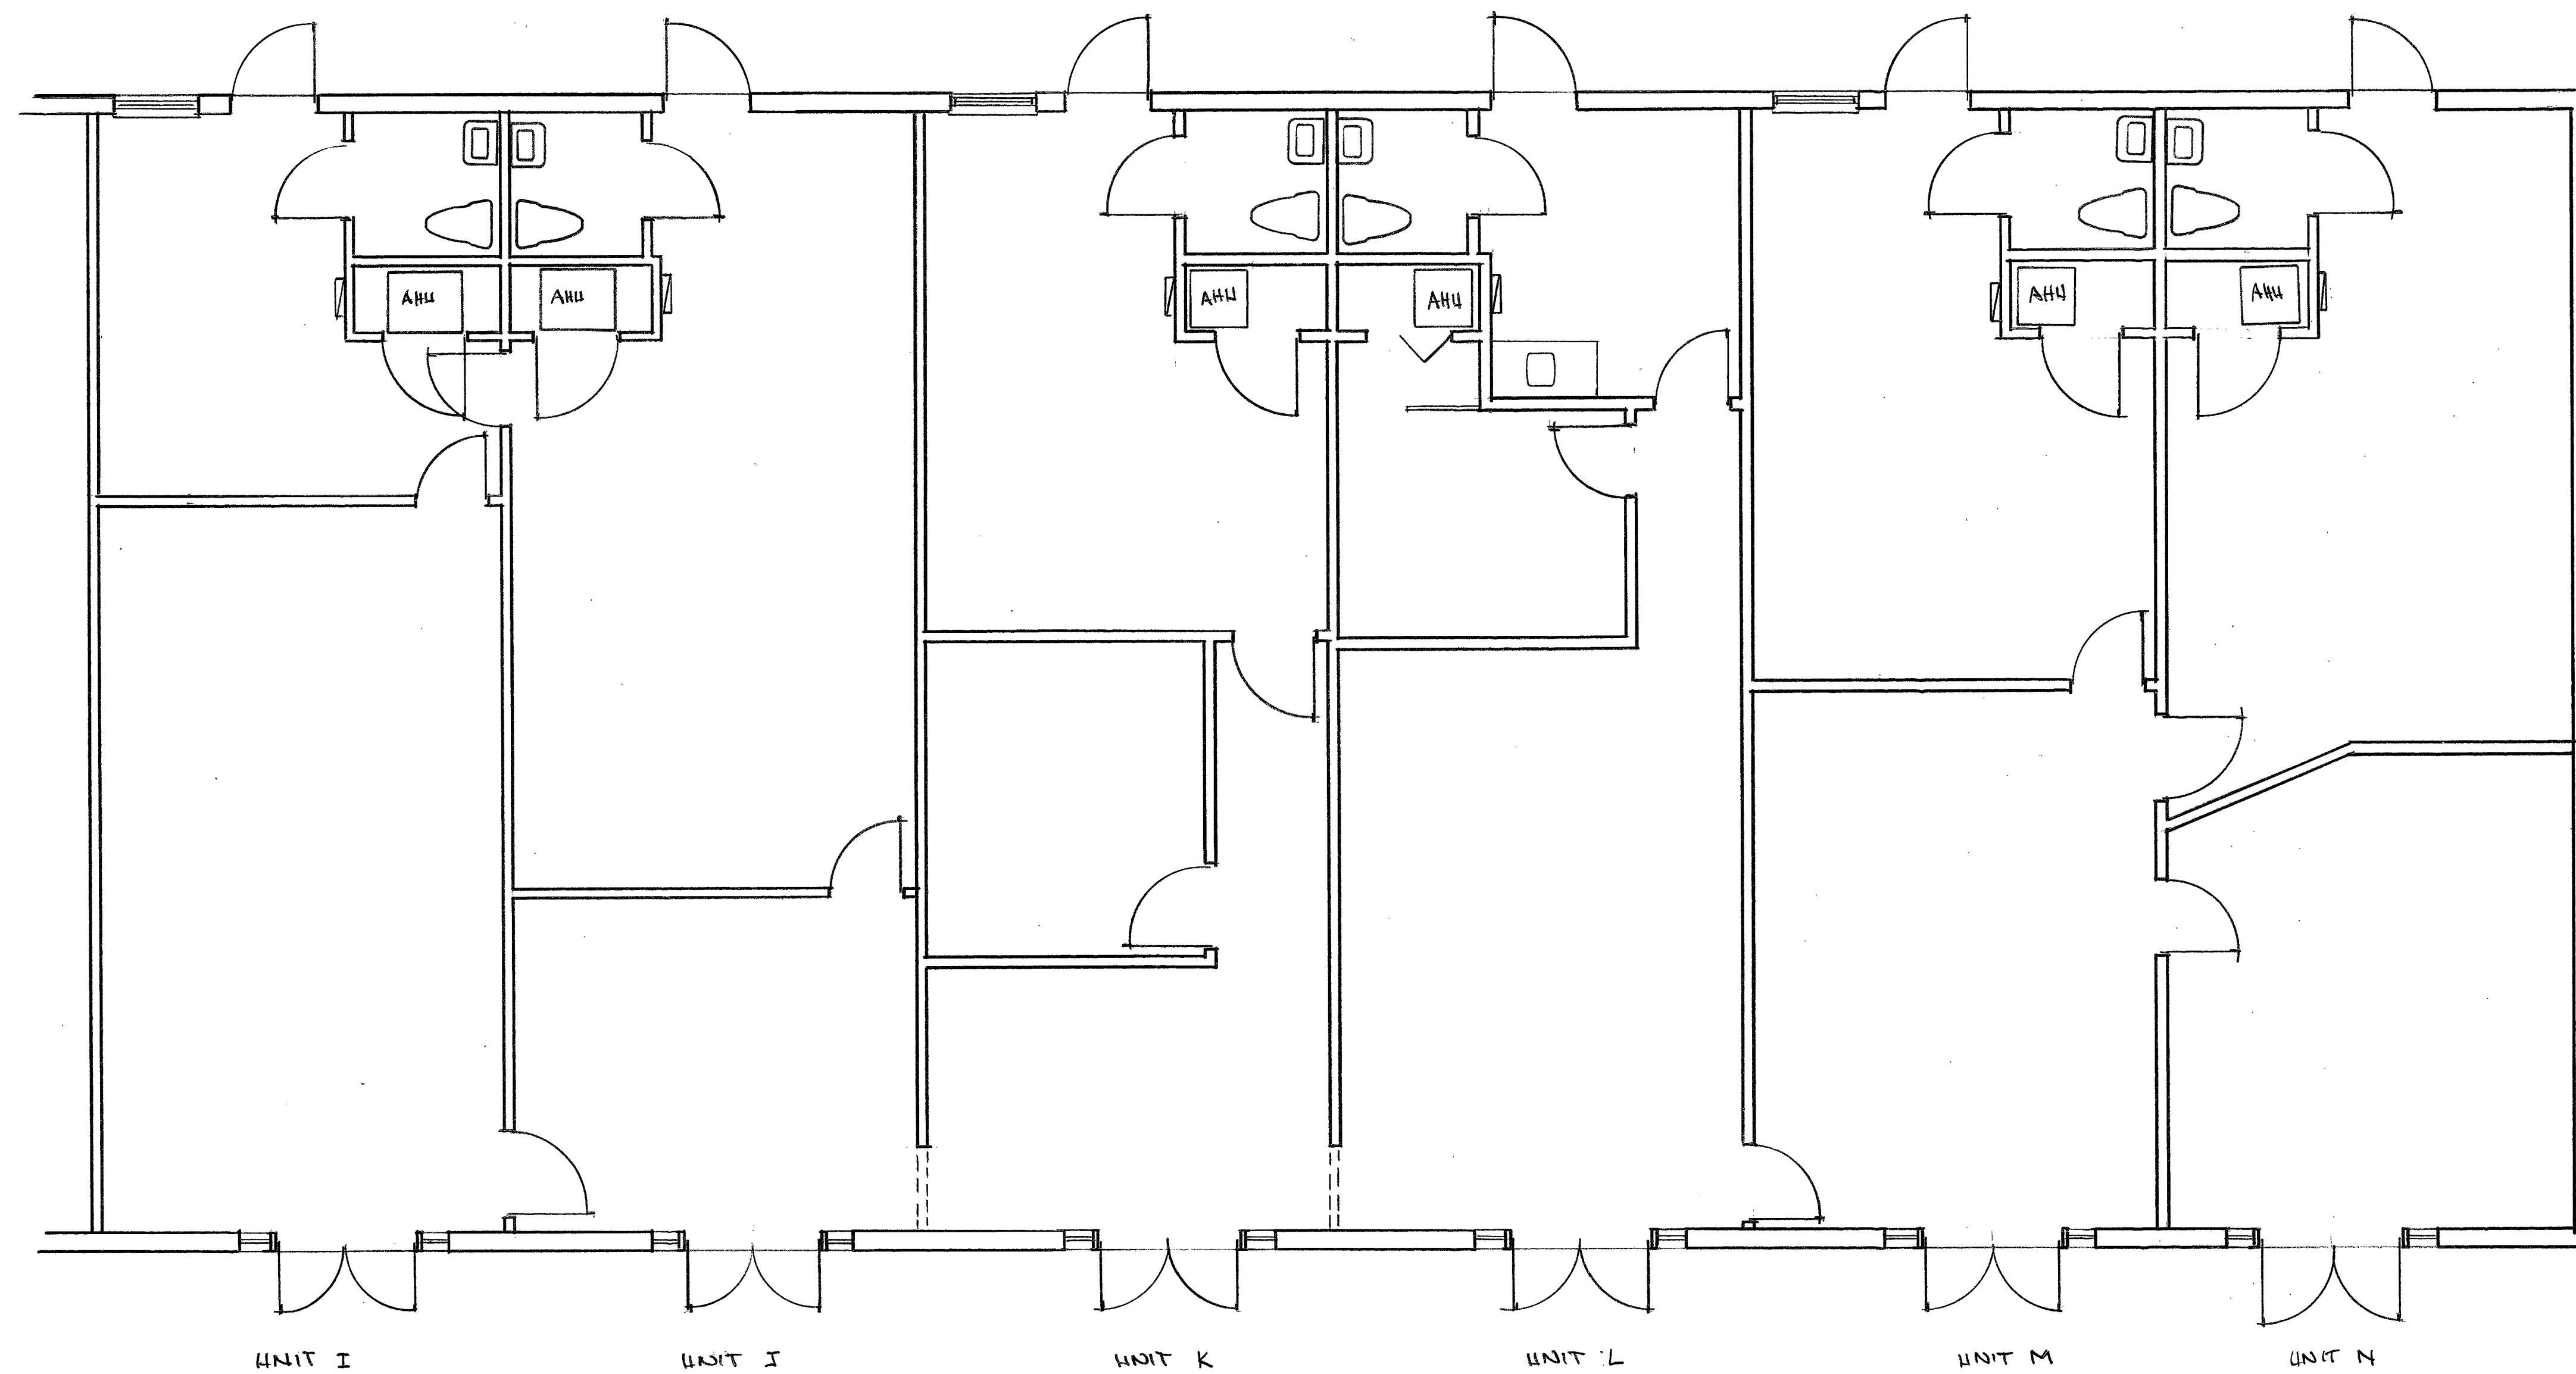

AS-BUILT FLOOR PLAN

1/4"


3/2/16
CONDITIONAL
USE
3/21/16 RANNING BC.

ADVANCED SCHOLARS
CHRISTIAN ACADEMY
FT. PIERCE,
FLORIDA

PETER B. COOK

COOK & MENARD
ARCHITECTURE INC.
STATE OF FLORIDA REGISTRATION NO. A40003494
806 DELAWARE AVE.
FT. PIERCE, FLORIDA 34950
PHONE: (872) 460-7751
FAX: (872) 460-4244

SHEET
OF TWO
CHRISTIAN ACADEMY

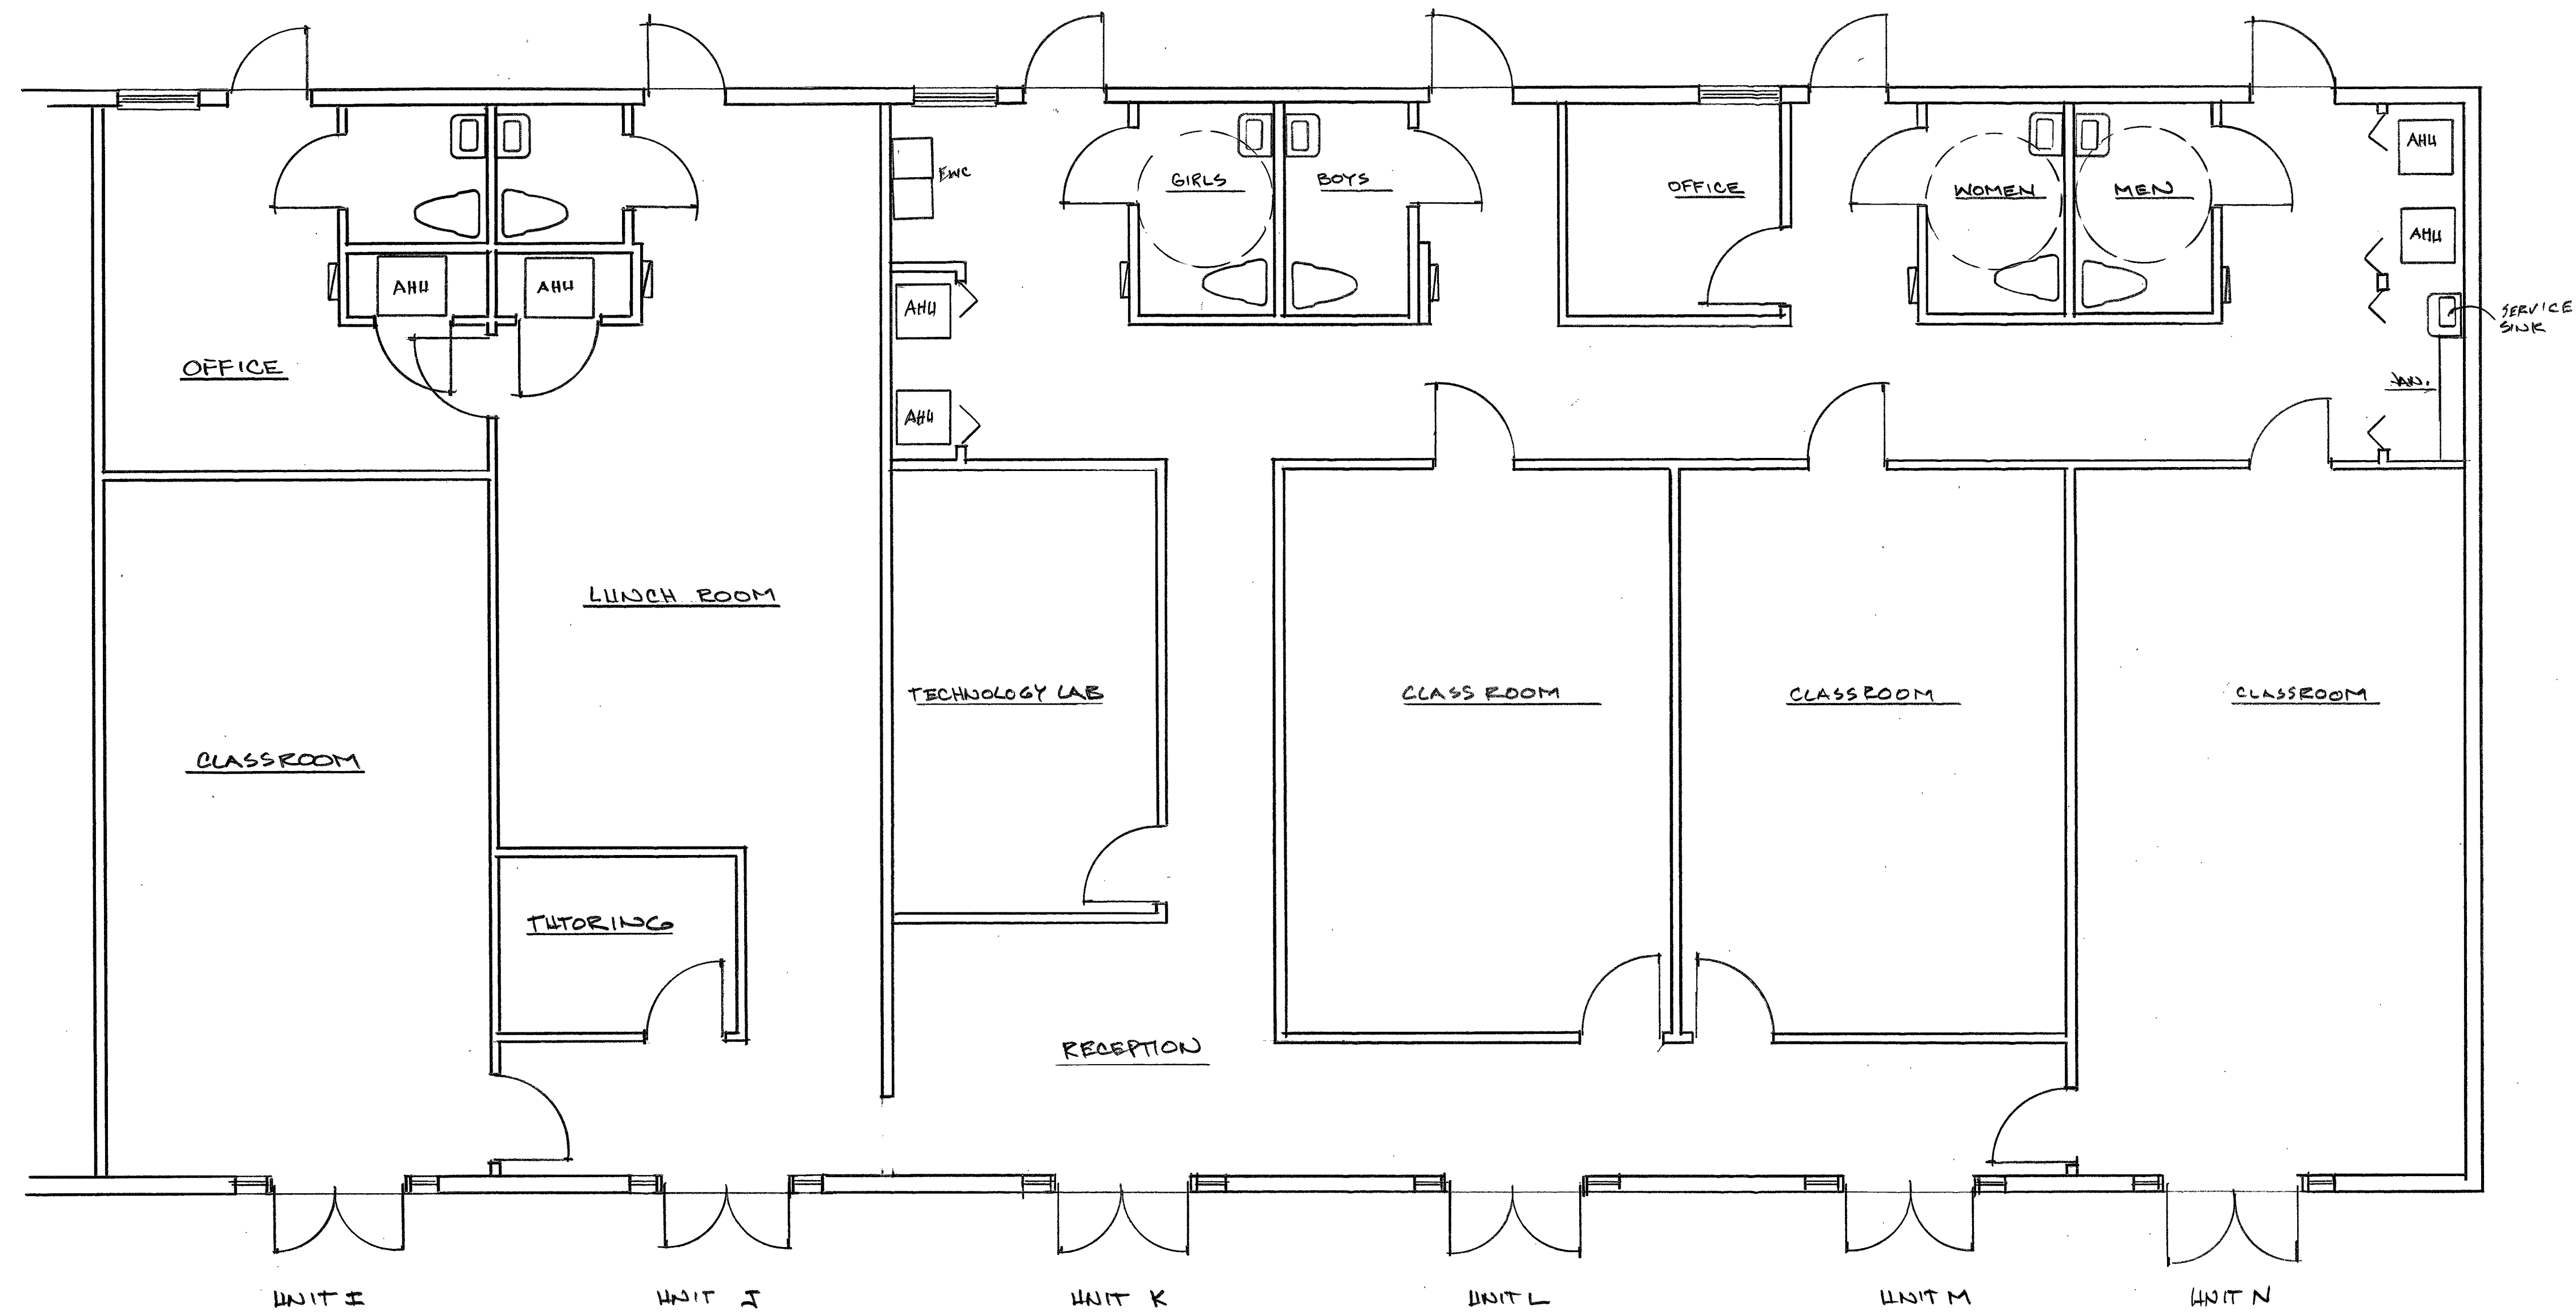

PROPOSED FLOOR PLAN

1/4"

3/20/16
CONDITIONAL
USE
3/31/16 PLANNING Bd.

ADVANCED SCHOLARS
CHRISTIAN ACADEMY
FT. PIERCE,
FLORIDA

PETER B. COOK

COOK & MENARD
ARCHITECTURE INC.
STATE OF FLORIDA REGISTRATION NO. A0003494
FT. PIERCE, FLORIDA 34950
806 DELAWARE AVE.
PHONE: (772) 460-7751
FAX: (772) 460-4244

SHEET
2
OF TWO
CHRISTIAN
ACADEMY