



CITY OF FORT PIERCE

PLANNING DEPARTMENT

COMPREHENSIVE PLANNING ♦ DEVELOPMENT REVIEW
HISTORIC PRESERVATION ♦ URBAN DESIGN ♦ URBAN FORESTRY ♦ ZONING



Certificate of Appropriateness Application

Building & Site Information

Address of the Site:

914 Delaware Ave, Fort Pierce FL 34950

Parcel ID #:

2410-705-0019-000-5

Type of Designation:

Contributing Non-contributing Site within the _____ Historic District

Individually Designated Site, City Commission Resolution No. _____

Property Owner/ Applicant Information

Property Owner(s)

Name(s):

Marco Otero

Mailing Address:

914 Delaware Ave Ft Pierce 34950

Phone Number(s):

727-237-2332

Email:

MOTEROSHSD@KARELINK.net

Applicant

Name(s): _____

Mailing Address: _____

Phone Number(s): _____

Email: _____

Representative

Name(s): _____

Mailing Address: _____

Phone Number(s): _____

Email: _____

Property Owner(s) Acknowledgements:- This application will not be considered complete without the signature of all property owners of record, which shall serve as an acknowledgement of the submission of this application. The property owner's signature below shall also authorize the Applicant (if other than the property owner) and/or Representative to act in his/her behalf for the purposes of seeking approval for the application described herein. The undersigned consents to inspection and photographing of the subject property by the Historic Preservation staff for purposes of consideration of this Application and/or presentation to the Historic Preservation Board.

I / We,

Marco Otero

as Owner(s) of the subject property do

hereby authorize the filing of this application on my/our behalf.

Marco Otero

Signature of Owner

3/14/2016

Date

Description of Requested Work

Please indicate the type of work requested:

Fence

Shed

Door(s)

Roof

Window(s)

Signage

Shutter(s)

Porch

Rehabilitation

New Construction

Demolition

Relocation

Site Improvements (describe) ReplACING OLD PICKET FENCE

Other (describe) PRIVACY & SECURITY

Please provide a detailed description of the proposed work to be performed: Want to
Replace my YARD FENCING wood ~~with~~
6 foot PRIVACY FENCE



Have other alterations been made to the site within the last 12 months? No Yes, Roof

Will the proposed work require a Zoning Variance? No Yes, Code Section(s): _____


Application Requirements

- \$10.00 Application fee
- Site Plan with dimensions.
- Architectural Drawings:
 - Drawings should show all current and proposed floor plans and elevations, fences, walls, and any other landscape features.
 - Drawings should indicate materials to be used.
- Photos - One (1) color photograph of the main façade of the site and photographs of any areas affected by the proposed project.
- Material(s) specifications and/or sample(s)
- Color samples. Noted in work
- Demolition - Plans for what will be taking the demolished structure's place should be submitted.

PROPERTY FRONT VIEW

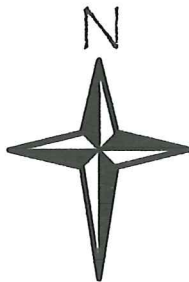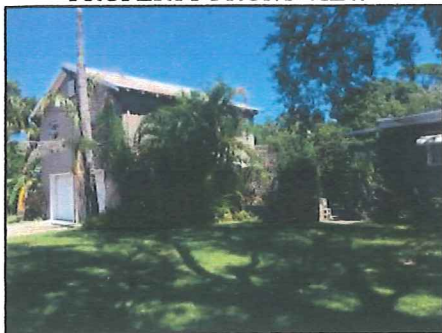


AERIAL PHOTOGRAPH
 (IMAGE NOT TO SCALE)

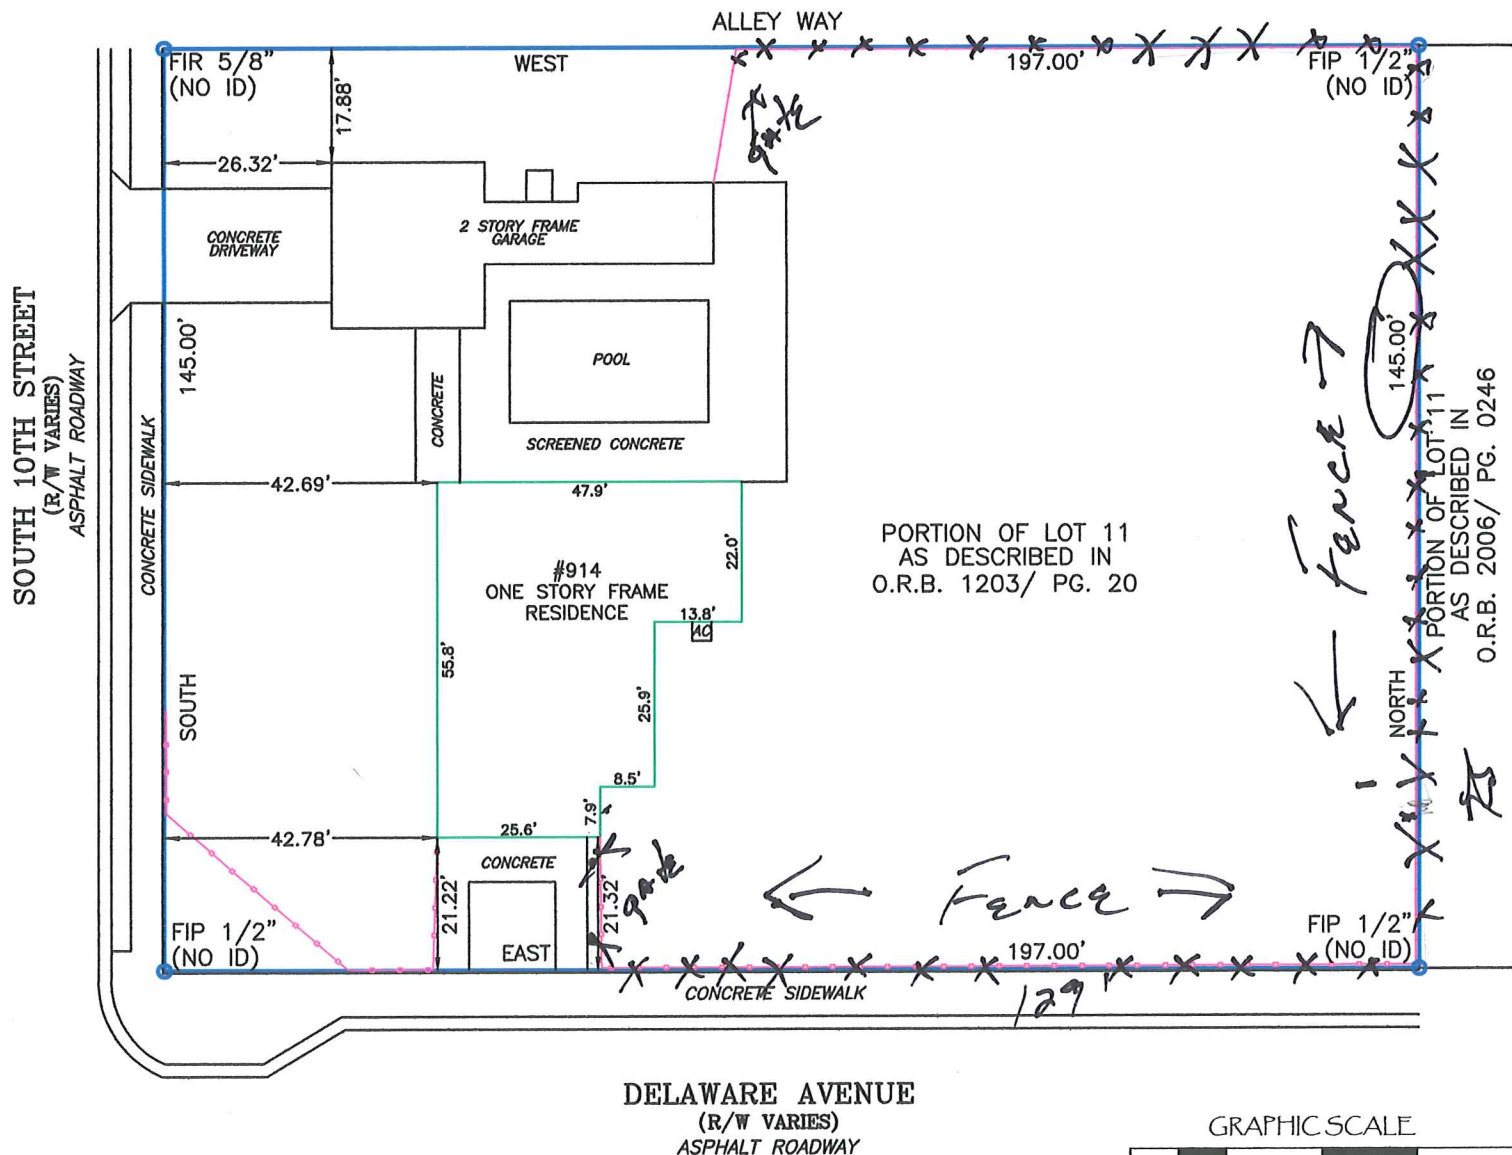

PORTION OF LOT 11
 AS DESCRIBED IN
 O.R.B. 1203/ PG. 20

GRAPHIC SCALE

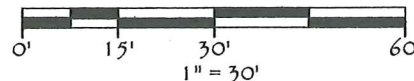

BEARING BASIS: BEARINGS ARE BASED UPON THE DEED BEARING FOR THE NORTH RIGHT OF WAY LINE OF DELAWARE AVENUE.

- VOTES:**
- PROPERTY APPEARS TO BE SERVICED BY PUBLIC UTILITIES.
 - ALL BEARINGS AND DISTANCES SHOWN ARE PLAT AND MEASURED.
 - U.&D.E. = PUBLIC UTILITY AND DRAINAGE EASEMENT

OB # - 1509-080	SCALE - 1" = 30'
FIELD DATE - 09/25/2015	DRAWN BY - M.W.S.
	REVISION -
	REVISION -
	REVISION -



BASEPOINT SURVEYORS
 PROFESSIONAL SURVEYING AND MAPPING
 WWW.BASEPOINTSURVEYORS.COM
 P.O. BOX 691152, Vero Beach, FL 32969
 Phone (888) 220-6805
 Fax (885) 219-5273

10:26

OKEECHOBEE
(863) 763-6255

VERO BEACH
(772) 562-0022

SEBRING
(863) 385-4493

JUPITER
(561) 744-1303

STUART
(772) 283-4540

BELLE GLADE
(561) 924-3419

FORT PIERCE
(772) 465-3890

"city"

Gunn

(800) 282-5172
FAX: (863) 763-8404



"FENCING YOU IN SINCE 1962"
CC# FE-1535



1132 NE 12th Street
Okeechobee, FL 34972

JOB NAME: Otero, Marco
JOB ADDRESS: 914 Delwan Ave
Ft Pierce, Fl. 34950
MAILING ADDRESS: _____
EMAIL ADDRESS: MOTEROHSD@earthlink.net
DIRECTIONS: _____

DATE: 3/14/16
CONTACT: _____
PHONE: _____
MOBILE: 727-237-2332
FAX: _____
JOB #: 13/4/16 OTEILM JWD
PERMIT #: _____

STYLE FENCE Board on Board wood, Customer to remove fence on site, and clean fence line.

POOL CODES no YES NO

HEIGHT 6 FOOTAGE 217-4-213

HEIGHT _____ FOOTAGE _____

~~1X6X6~~ PT SELVAGE
LINE POST 4X4X8 PT CONCRETE
TERMINAL POST 4X4X8 PT CONCRETE
TOP/BRACE/BOTTOM RAIL 2X4 PT POST SPACE O.C.

TENSION WIRE

BARBED WIRE

WALK GATE 1 SIZE 4 FRAME 2X4

WALK GATE _____ SIZE _____ FRAME _____

WALK GATE POST 4X6X8 PT CONCRETE

DRIVE GATE _____ SIZE _____ FRAME _____

DRIVE GATE POST CONCRETE

DRIVE GATE _____ SIZE _____ FRAME _____


DRIVE GATE POST CONCRETE

CORE DRILL/ASPHALT

PROP. LINES CLEARED By Owner YES NO

PROP. MARKS VISIBLE By Owner YES NO

SPECIAL INSTRUCTIONS careful digging.

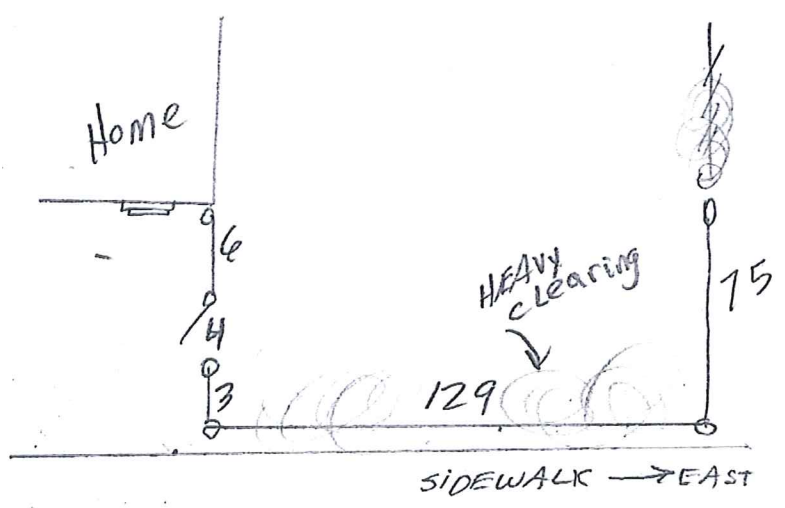

(Adron Fence is not responsible for being directed to dig on top of any unmarked sprinkler lines.)

CUSTOMER APPROVAL: _____

COST 4,954 DEPOSIT _____ BALANCE _____

TERMS 1/3 down, balance on completion

THIS PRICE EFFECTIVE UNTIL 30 day

PERSONNEL De - Jim

INSTALLER _____ DATE _____

