



RECEIVED
AUG 03 2017
CITY OF FORT PIERCE, FLORIDA

Bldg. Permit # _____

COA# 17-50

Certificate of Appropriateness Application

Building & Site Information

Address of the Site: 508 Means Ct Fort Pierce FL

Parcel ID #: _____

Type of Designation: Contributing Non-contributing Site within the _____ Historic District

somebody's house
should no
 Individually Designated Site, City Commission Resolution No. _____

Property Owner/ Applicant Information

Property Owner(s)

Name(s): Joseph Dunbar

Mailing Address: 508 Mean Ct

Phone Number(s): 561-654-0607 Email: cristal Dunbar@yahoo.com

Applicant

Name(s): Joseph Dunbar

Mailing Address: 508 Mean Ct Fort Pierce FL

Phone Number(s): 561 654-0607 Email: _____

Representative

Name(s): Joseph Dunbar

Mailing Address: 508 Mean Ct Fort Pierce FL

Phone Number(s): 561 654-0607 Email: _____

Property Owner(s) Acknowledgements:- This application will not be considered complete without the signature of all property owners of record, which shall serve as an acknowledgement of the submission of this application. The property owner's signature below shall also authorize the Applicant (if other than the property owner) and/or Representative to act in his/her behalf for the purposes of seeking approval for the application described herein. The undersigned consents to inspection and photographing of the subject property by the Historic Preservation staff for purposes of consideration of this Application and/or presentation to the Historic Preservation Board.

I / We, Joseph Dunbar as Owner(s) of the subject property do hereby authorize the filing of this application on my/our behalf.

[Signature]
Signature of Owner

8/3/2017
Date

Description of Requested Work

Please indicate the type of work requested:

Fence

Shed

Door(s)

Roof

Window(s)

Signage

Shutter(s)

Porch

Rehabilitation

New Construction

Demolition

Relocation

Site Improvements (describe) Front ~~gate~~ chain link fence

Other (describe) _____

Please provide a detailed description of the proposed work to be performed: ~~chain link fence~~ Metal picket fence in front of house white or black 4 Feet

Have other alterations been made to the site within the last 12 months? No Yes, _____

Will the proposed work require a Zoning Variance? No Yes, Code Section(s): may


Application Requirements

- \$10.00 Application fee
- Site Plan with dimensions.
- Architectural Drawings:
 - Drawings should show all current and proposed floor plans and elevations, fences, walls, and any other landscape features.
 - Drawings should indicate materials to be used.
- Photos - One (1) color photograph of the main façade of the site and photographs of any areas affected by the proposed project.
- Material(s) specifications and/or sample(s)
- Color samples.
- Demolition - Plans for what will be taking the demolished structure's place should be submitted.

CITY OF FORT PIERCE
 BUILDING DEPARTMENT
 FENCE FORM
 (772) 467-3725
 FAX (772) 467-3849

Owner Name Joseph H Dunbar
 Property Address 508 Means Ct Fort pierce FL 34950

*FENCES NOT PERMITTED ON VACANT LOTS

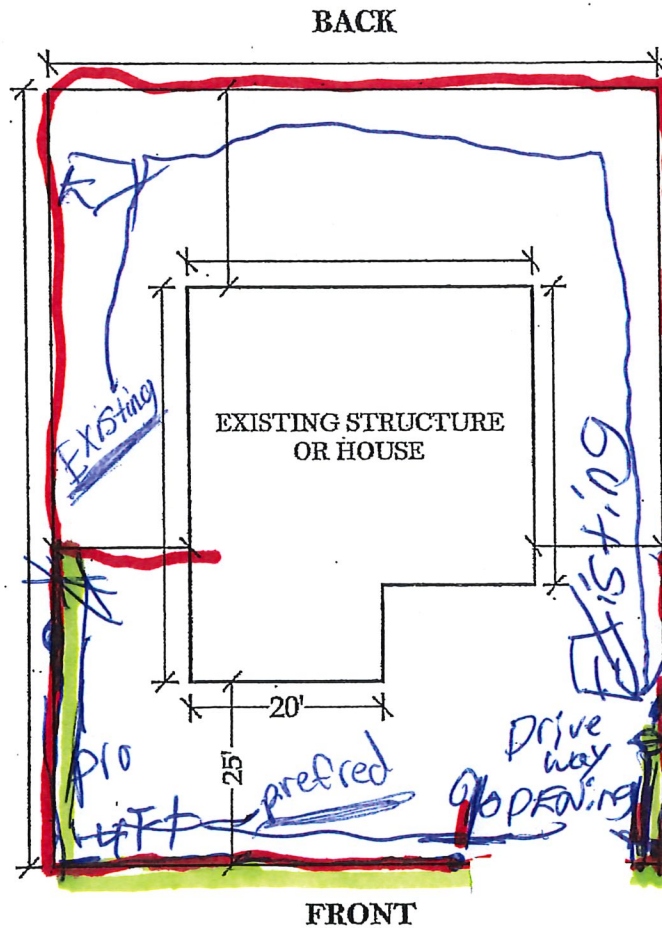

FENCE MINIMUM STANDARDS

INDIVIDUAL LENGTH AND HEIGHT TO BE SHOWN ON PLAN
 EX x 50' 6' CL x
 INDICATED FENCE AS X X X X X



FRONT

PLOT PLAN
 1" = 20' SCALE

TYPE Chain link fence
 TOTAL LENGTH 100 Ft. LF
 HEIGHT 40 Ft. FT
 GATE N° _____ SIZE front yard LOC

PROPOSED FENCE SECTION MUST BE CLOUDED
 ANY FENCES GOOD SIDE OUT