


NOTE: ALL ELEVATIONS SHOWN HEREON ARE BASED UPON MEAN SEA LEVEL DATUM

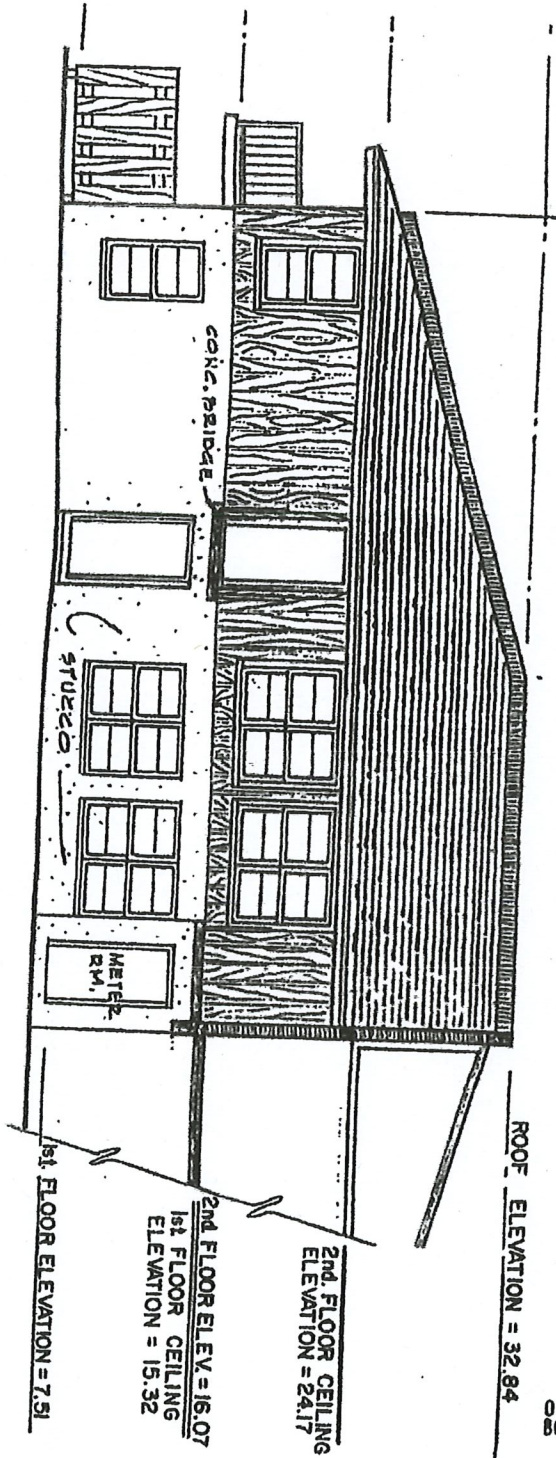

AS BUILT ELEVATION PLAN

ROOF ELEVATION = 32.84

D.R. BOOK 570 PAGE 2037

1
sheet of 1

drawn by: J.P.	rev. 001, 002, 003, 004
checked by: J.P.	revision: 001
date: 11/11/07	date: 11/11/07

PREPARED FOR:
MARTIN - BROWNE INVESTMENTS, INC.

STEPHEN J. BROWN INC.
SURVEYOR-DESIGNER-LAND PLANNING-CONSULTANTS
285 florida street Stuart, Florida
388/387/4000