
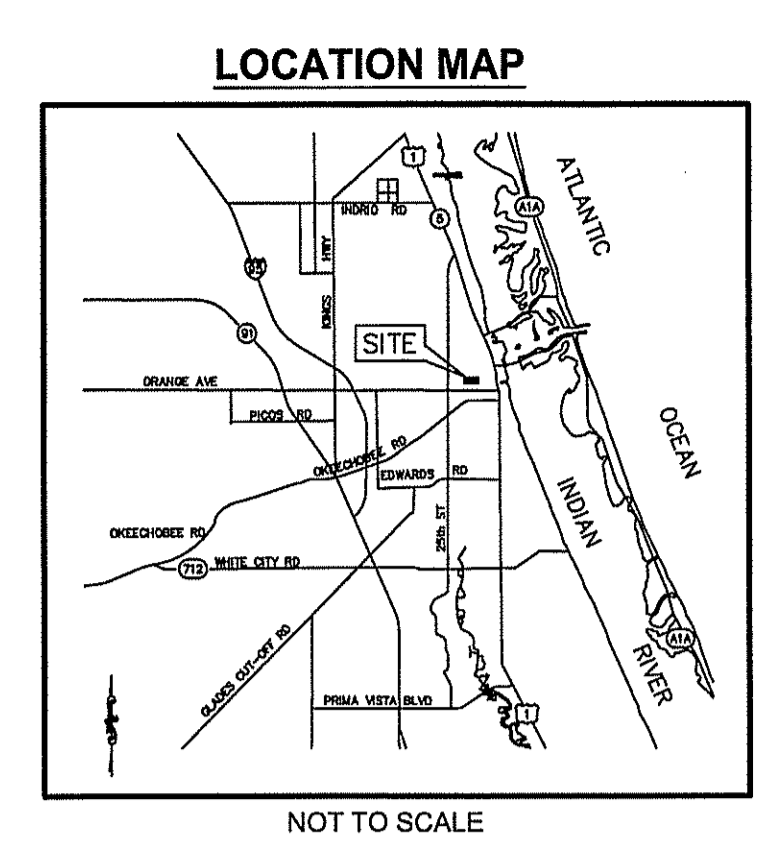


BOUNDARY & TOPOGRAPHIC SURVEY

LYING IN ST. LUCIE COUNTY, FLORIDA

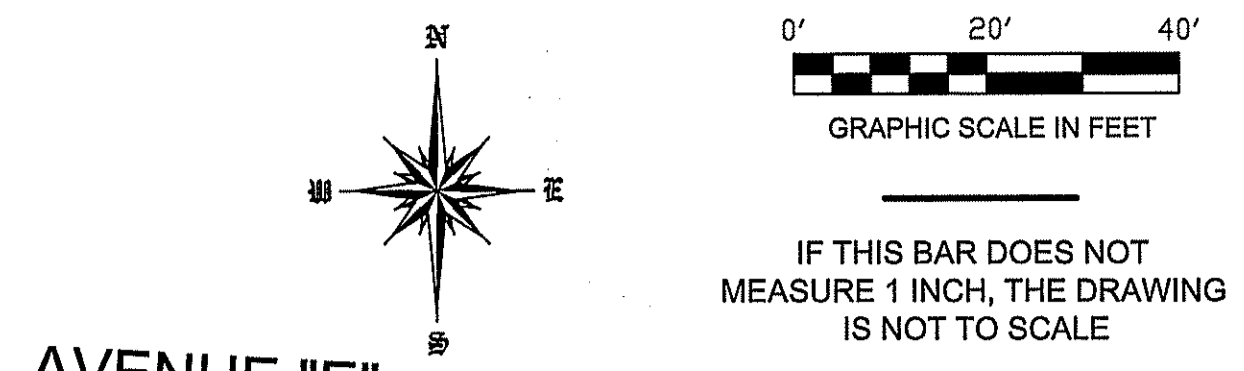

GLOBAL POSITIONING SYSTEM (GPS) NOTES

1. REAL TIME KINEMATICS (RTK) METHOD WAS UTILIZED USING CARLSON BRX-6+, 372 CHANNEL GNSS ATHENA, WITH ATLAS L-BAND RECEIVER.
2. TYPICALLY, A BASE RECEIVER IS SET UP ON AN ESTABLISHED CONTROL STATION WHILE A ROVING RECEIVER LOCATES EXISTING MONUMENTS, IMPROVEMENTS AND CONTROL ON THE PROJECT.
3. GPS SURVEY MEASUREMENTS WERE PROCESSED AND ADJUSTED USING CARLSON SURVEY 2018.
4. THE HORIZONTAL AND VERTICAL TARGET ACCURACY FOR THIS SURVEY EXCEEDS MINIMUM STANDARDS OF PRACTICE PER FLORIDA ADMINISTRATIVE CODE (F.A.C.) 5J-17.
5. THE COORDINATES SHOWN HEREON ARE RELATIVE TO THE STATE PLANE COORDINATE SYSTEM OF THE NORTH AMERICAN DATUM OF 1983 (2007 ADJUSTMENT).

ARNOLD SURVEYING, INC.
 PROFESSIONAL SURVEYORS & MAPPERS
 FLORIDA LICENSED BUSINESS NUMBER 7903
 24 VERDE VISTA, FORT PIERCE, FLORIDA 34951
 PHONE (772) 708-1819 SURVEY@ASI-SURVEY.COM

STREET ADDRESS
 1238 AVENUE D, FORT PIERCE, FLORIDA 34950

LEGAL DESCRIPTION
 THE SOUTH 13 FEET OF THE NORTH 63 FEET OF THE WEST 1.5 FEET OF LOT 3, LOT 4, BLOCK 1 OF LINCOLN PARK NO. 2, ACCORDING TO THE PLAT THEREOF AS RECORDED IN PLAT BOOK 4, PAGE 77, OF THE PUBLIC RECORDS OF ST. LUCIE COUNTY, FLORIDA.

CONTAINING 0.07 ACRES, MORE OR LESS.

PARCEL # 2409-501-0005-000-4

SURVEYOR'S NOTES

1. THE PURPOSE AND/OR EXPECTED USE OF THIS SURVEY AND/OR MAP IS ENGINEERING DESIGN FOR A MUSEUM. ANY OTHER USE IS PROHIBITED BY ASI.
2. REPRODUCTIONS AND/OR PHOTO COPIES, WHETHER PARTIAL OR IN ITS ENTIRETY, AS WELL AS ANY ADDITIONS AND/OR DELETIONS TO THIS SURVEY ARE PROHIBITED BY ASI AND WILL DEEM THIS SURVEY AND/OR MAP TO BE INVALID REGARDLESS OF ANY SIGNATURE OR SEAL, WHETHER THAT SIGNATURE OR SEAL IS DIGITAL OR NOT.
3. THE BEARINGS SHOWN HEREON ARE REFERENCED TO THE NORTH RIGHT OF WAY OF AVENUE "D" HAVING A BEARING OF N87°26'50"W, ACCORDING TO THE PLAT OF LINCOLN PARK NO. 2, AS RECORDED IN PLAT BOOK 4, PAGE 77, PUBLIC RECORDS, ST. LUCIE COUNTY, FLORIDA.
4. FLOOD NOTE: BY GRAPHIC PLOTTING ONLY, THIS PROPERTY IS IN ZONE "X", ACCORDING TO THE FLOOD INSURANCE RATE MAP, COMMUNITY PANEL NO. 12111 C 0179 K, EFFECTIVE DATE FEBRUARY 19, 2020.
5. ELEVATIONS, IF SHOWN, ARE IN NORTH AMERICAN VERTICAL DATUM (NAVD) OF 1988 AND ARE REFERENCED TO ST. LUCIE COUNTY BENCHMARK "M-350" HAVING AN ELEVATION OF 17.51'.
6. ALL MEASUREMENTS ARE IN ACCORDANCE WITH UNITED STATES STANDARDS, IN FEET AND DECIMALS THEREOF.
7. ALL ABOVE GROUND FIXED IMPROVEMENTS, IF ANY, HAVE BEEN LOCATED AND SHOWN HEREON.
8. UNDERGROUND UTILITIES AND UTILITY SERVICES HAVE NOT BEEN LOCATED ON THIS SURVEY.
9. THE SURVEYOR HAS NO KNOWLEDGE OF UNDERGROUND FOUNDATIONS WHICH MAY OCCUPY LAND SURVEYED OR LAND OF OTHERS.
10. LANDS SHOWN HEREON WERE NOT ABSTRACTED BY THIS OFFICE FOR RIGHTS-OF-WAY, EASEMENTS OF RECORD, OWNERSHIP, ABANDONMENT'S DEED RESTRICTIONS, OR MURPHY ACT DEEDS.
11. THE LAST DATE OF FIELD WORK AND/OR DATA ACQUISITION WAS JUNE 17, 2024. ANY CHANGES TO THE PROPERTY AFTER THAT DATE ARE NOT INCLUDED ON THIS SURVEY.


LEGEND & ABBREVIATIONS

A	ARC LENGTH
A/C	AIR CONDITIONER
BM OR	BENCHMARK
BRG	BEARING
C	CALCULATED DATA
CBS	CONCRETE BLOCK STRUCTURE
C/L	CENTERLINE
CM	CONCRETE MONUMENT
CMP	CORRUGATED METAL PIPE
CONC	CONCRETE
DB	DEED BOOK
DBH	DIAMETER AT BREAST HEIGHT
DEG OR °	DEGREE
ELEV	ELEVATION
FFE	FINISHED FLOOR ELEVATION
FND	FOUND
ID	IDENTIFICATION NUMBER
IP	IRON PIPE
IR	IRON ROD
IRC	IRON ROD & CAP
LB	LICENSED BUSINESS
LS	LICENSED SURVEYOR
M	MEASURED DATA
MHWL	MEAN HIGH WATER LINE
MON	MONUMENT
N&D	NAIL AND DISK
NAVD	NORTH AMERICAN VERTICAL DATUM
NGVD	NATIONAL GEODETIC VERTICAL DATUM
NO OR #	NUMBER
OHP	OVERHEAD UTILITIES
ORB	OFFICIAL RECORDS BOOK
P	PLATTED DATA
PB	PLAT BOOK
PG(S)	PAGE(S)
PLS	PROFESSIONAL LAND SURVEYOR
POB	POINT OF BEGINNING
POC	POINT OF COMMENCEMENT
PRM	PERMANENT REFERENCE MONUMENT
PSM	PROFESSIONAL SURVEYOR AND MAPPER
R	RADIUS
RLS	REGISTERED LAND SURVEYOR
R/W	RIGHT-OF-WAY
TB	TRAFFIC BOX
WM	WATER METER
Δ	DELTA
⊗	SANITARY SEWER
⊕	UTILITY BOX
○	UTILITY POLE

SURVEYOR'S CERTIFICATION
 NOT VALID WITHOUT THE ORIGINAL SIGNATURE AND SEAL OF A FLORIDA LICENSED SURVEYOR AND MAPPER.

I HEREBY CERTIFY THAT THE SURVEY OF THE PROPERTY SHOWN AND DESCRIBED HEREON WAS COMPLETED UNDER MY DIRECTION AND SAID SURVEY IS TRUE AND CORRECT TO THE BEST OF MY KNOWLEDGE AND BELIEF.

I FURTHER CERTIFY THAT THIS SURVEY MEETS OR EXCEEDS MINIMUM STANDARDS OF PRACTICE FOR SURVEYS AS SET FORTH BY THE FLORIDA BOARD OF PROFESSIONAL SURVEYORS AND MAPPERS PER FLORIDA ADMINISTRATIVE CODE (F.A.C.) 5J-17, PURSUANT TO SECTION 472.027 OF THE FLORIDA STATE STATUTES. NO SEARCH OF THE PUBLIC RECORDS HAS BEEN MADE BY THIS OFFICE. THIS SURVEY IS BASED ON INFORMATION FURNISHED BY CLIENT OR CLIENT'S.

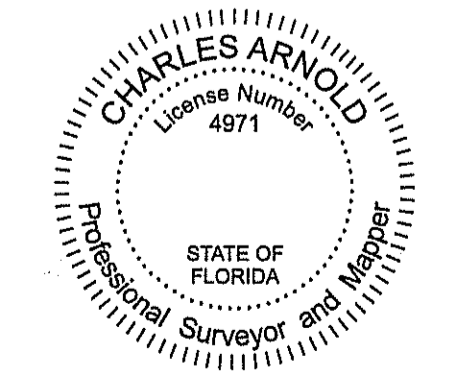

Digitally signed by
CHARLES ARNOLD
 Date: 2024.06.20
 13:36:30 -04'00'

CHARLES ARNOLD, PSM
 FLORIDA LICENSED NO. LS 4971


DATE

NOTE:
 If this is an electronically signed and sealed survey and/or map, it is done so per Florida Administrative Code (F.A.C.) 5J-17. Any printed survey and/or map and copies thereof are not valid without the original signature and seal of a Florida licensed surveyor and mapper.

CERTIFICATIONS:
 STEVEN GIORDANO

ALL DRAWINGS OR DOCUMENTS AND COPIES THEREOF ARE INSTRUCTIONS OF SERVICE AND REMAIN THE PROPERTY OF ARNOLD SURVEYING, INC. THE REPRODUCTION OR UNAUTHORIZED USE OF THESE DRAWINGS OR ANY OTHER PROJECT DOCUMENTS WITHOUT THE WRITTEN PERMISSION OF ARNOLD SURVEYING, INC. IS STRICTLY PROHIBITED. THIS DRAWING OR DOCUMENT IS PROTECTED BY FEDERAL COPYRIGHT LAWS.

DRAWN BY:	RC
CHECKED BY:	CA
DATE:	06/20/2024
HORIZONTAL SCALE	1"=20'
SHEET	1 OF 1
PROJECT NO.	24-809

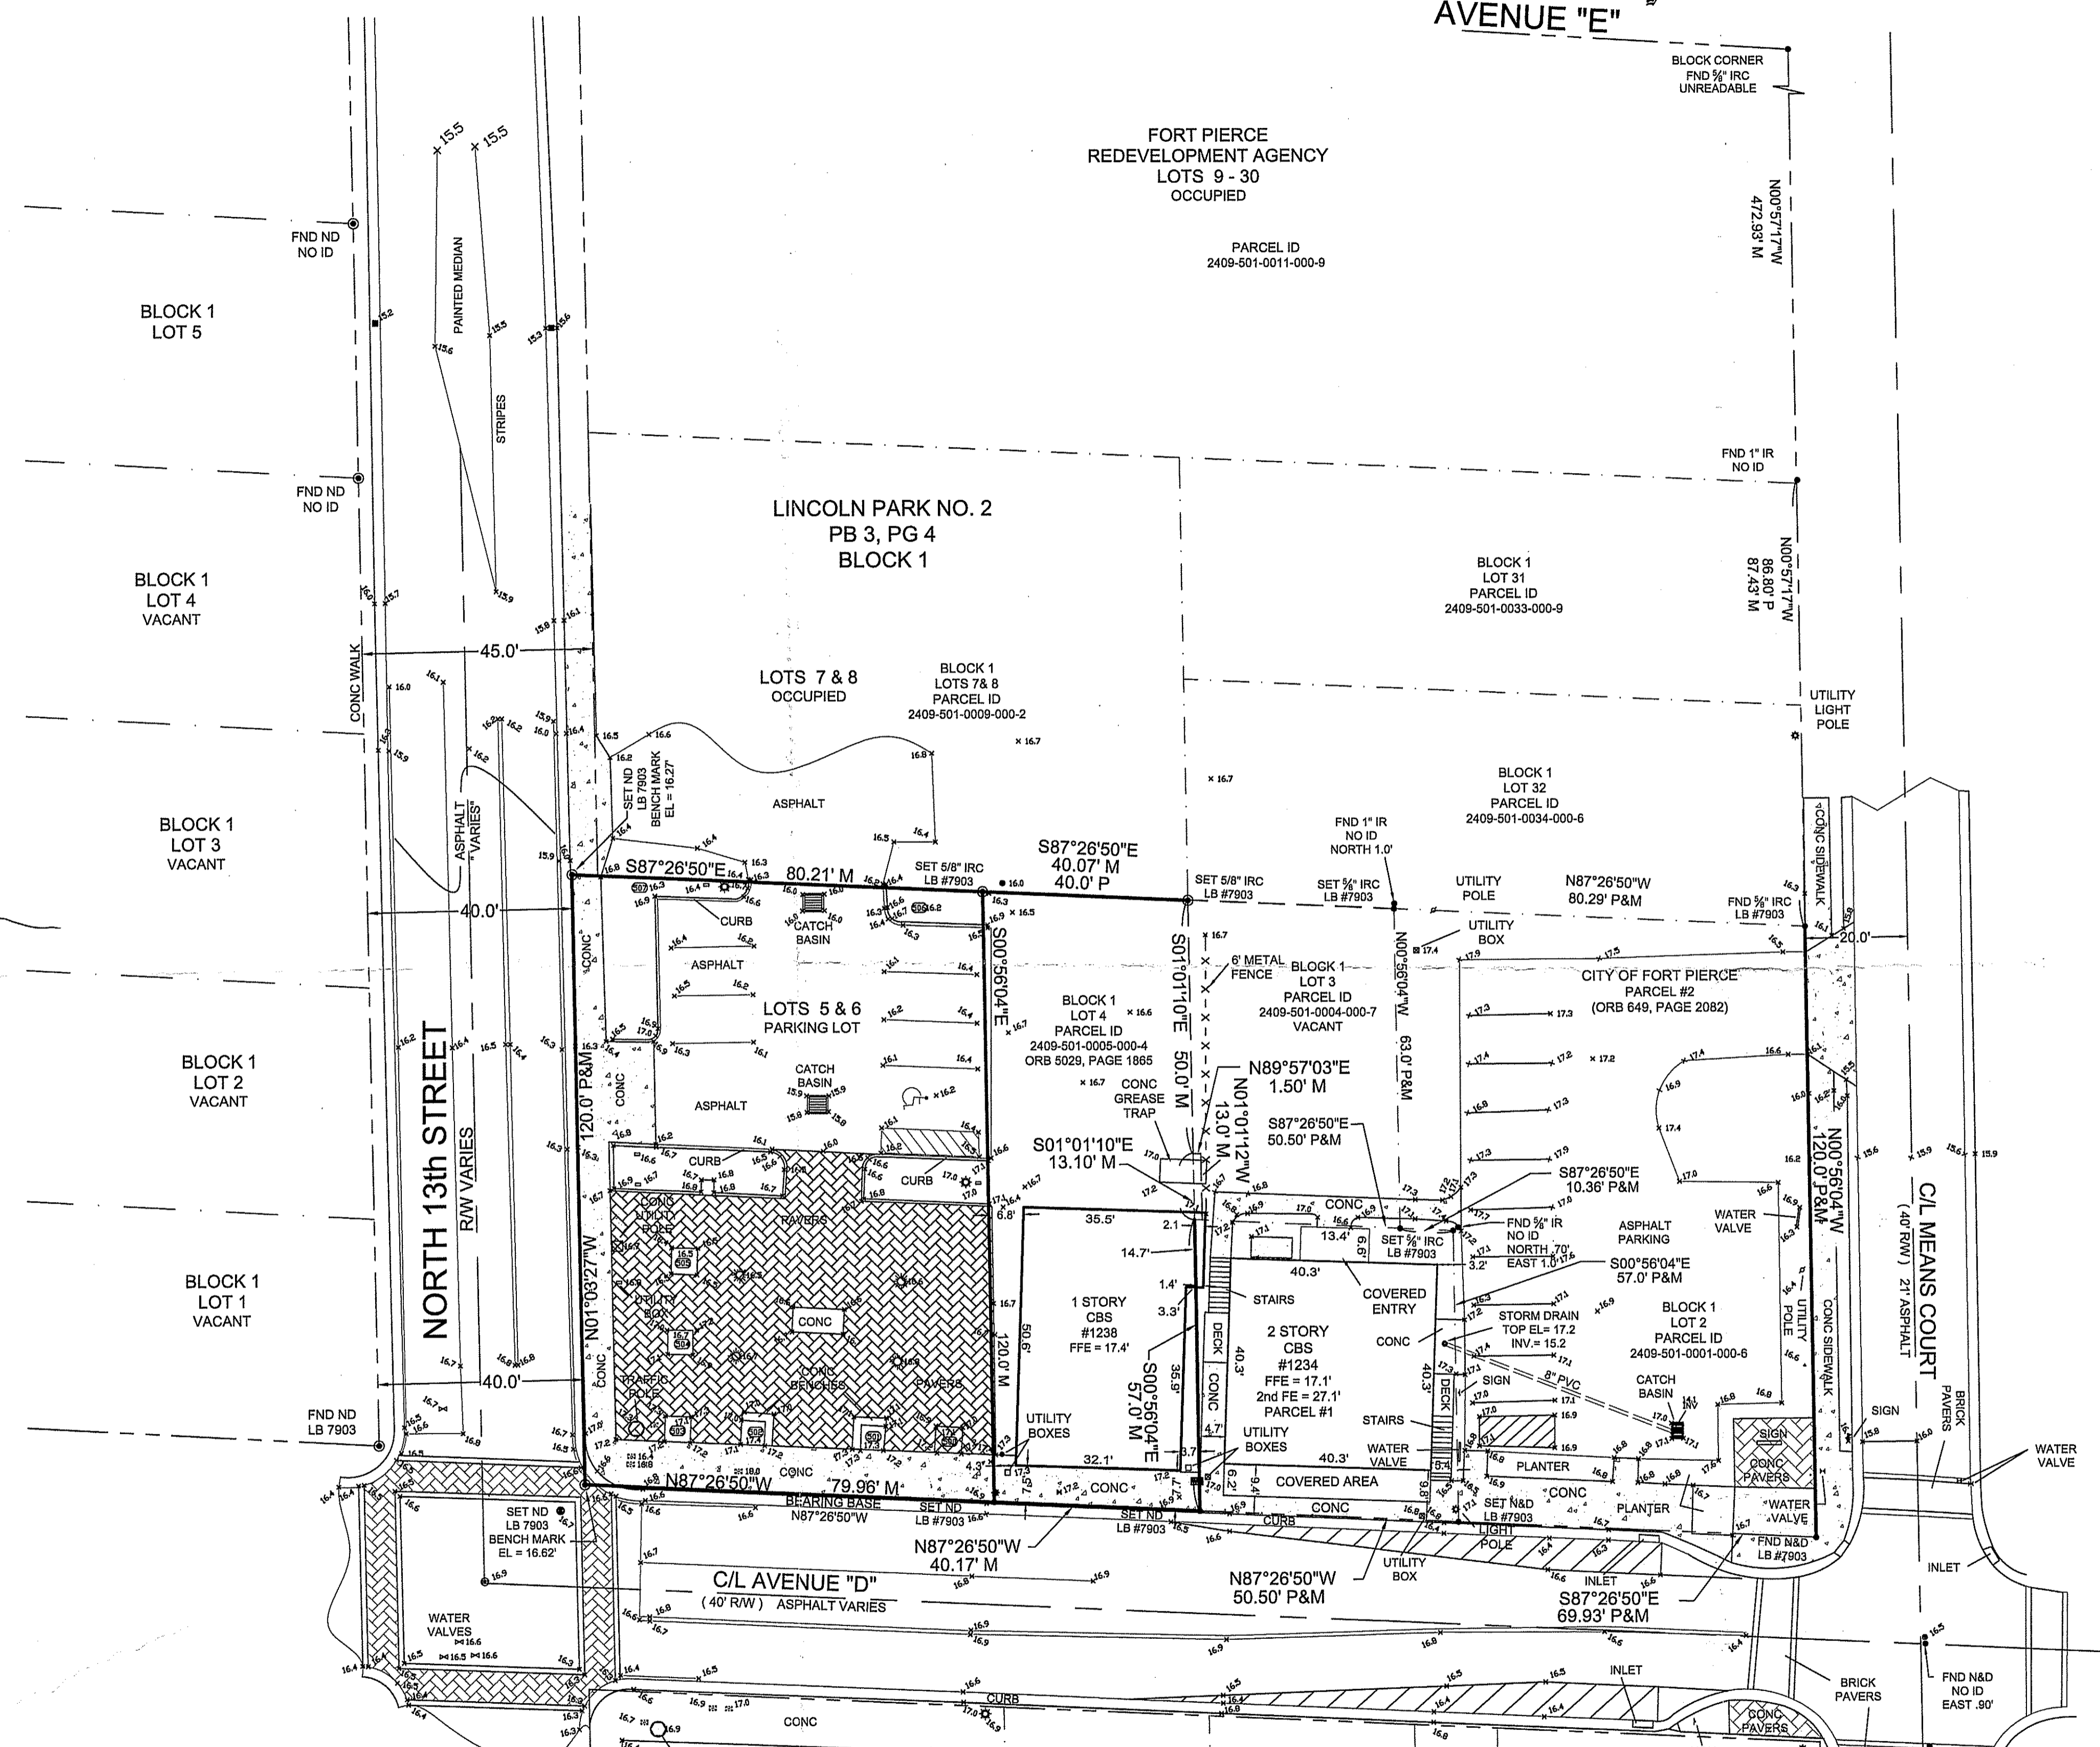

TREE LEGEND

Point No.	Description
500	14" PALM 15' DRIP
501	14" PALM 15' DRIP
502	18" PALM 15' DRIP
503	16" PALM 15' DRIP
504	12" OAK 25' DRIP
505	10" OAK 25' DRIP
506	14" OAK 30' DRIP
507	18" OAK 35' DRIP