


NARRATIVE:

- 1) Restrooms will be inside the double-wide 60x24 trailers for Caddell employees use. All Wal-Mart employees to continue to use the facilities within the distribution center.
- 2) Walmart has designated parking for its employees which is on the site plan.
- 3) Temporary Use will be needed for the duration of 6-7 months as this is the length of the schedule
- 4) Lighting will not be an issue. This is all work to occur during the daytime and within the facility.

1. ALL ELEVATIONS ON PLANS ARE BASED AND MUST BE CONSTRUCTED ON NAVD 88 DATUM.  
 2. NAVD 20 IS 1.48' HIGHER THAN NAVD 88 DATUM.

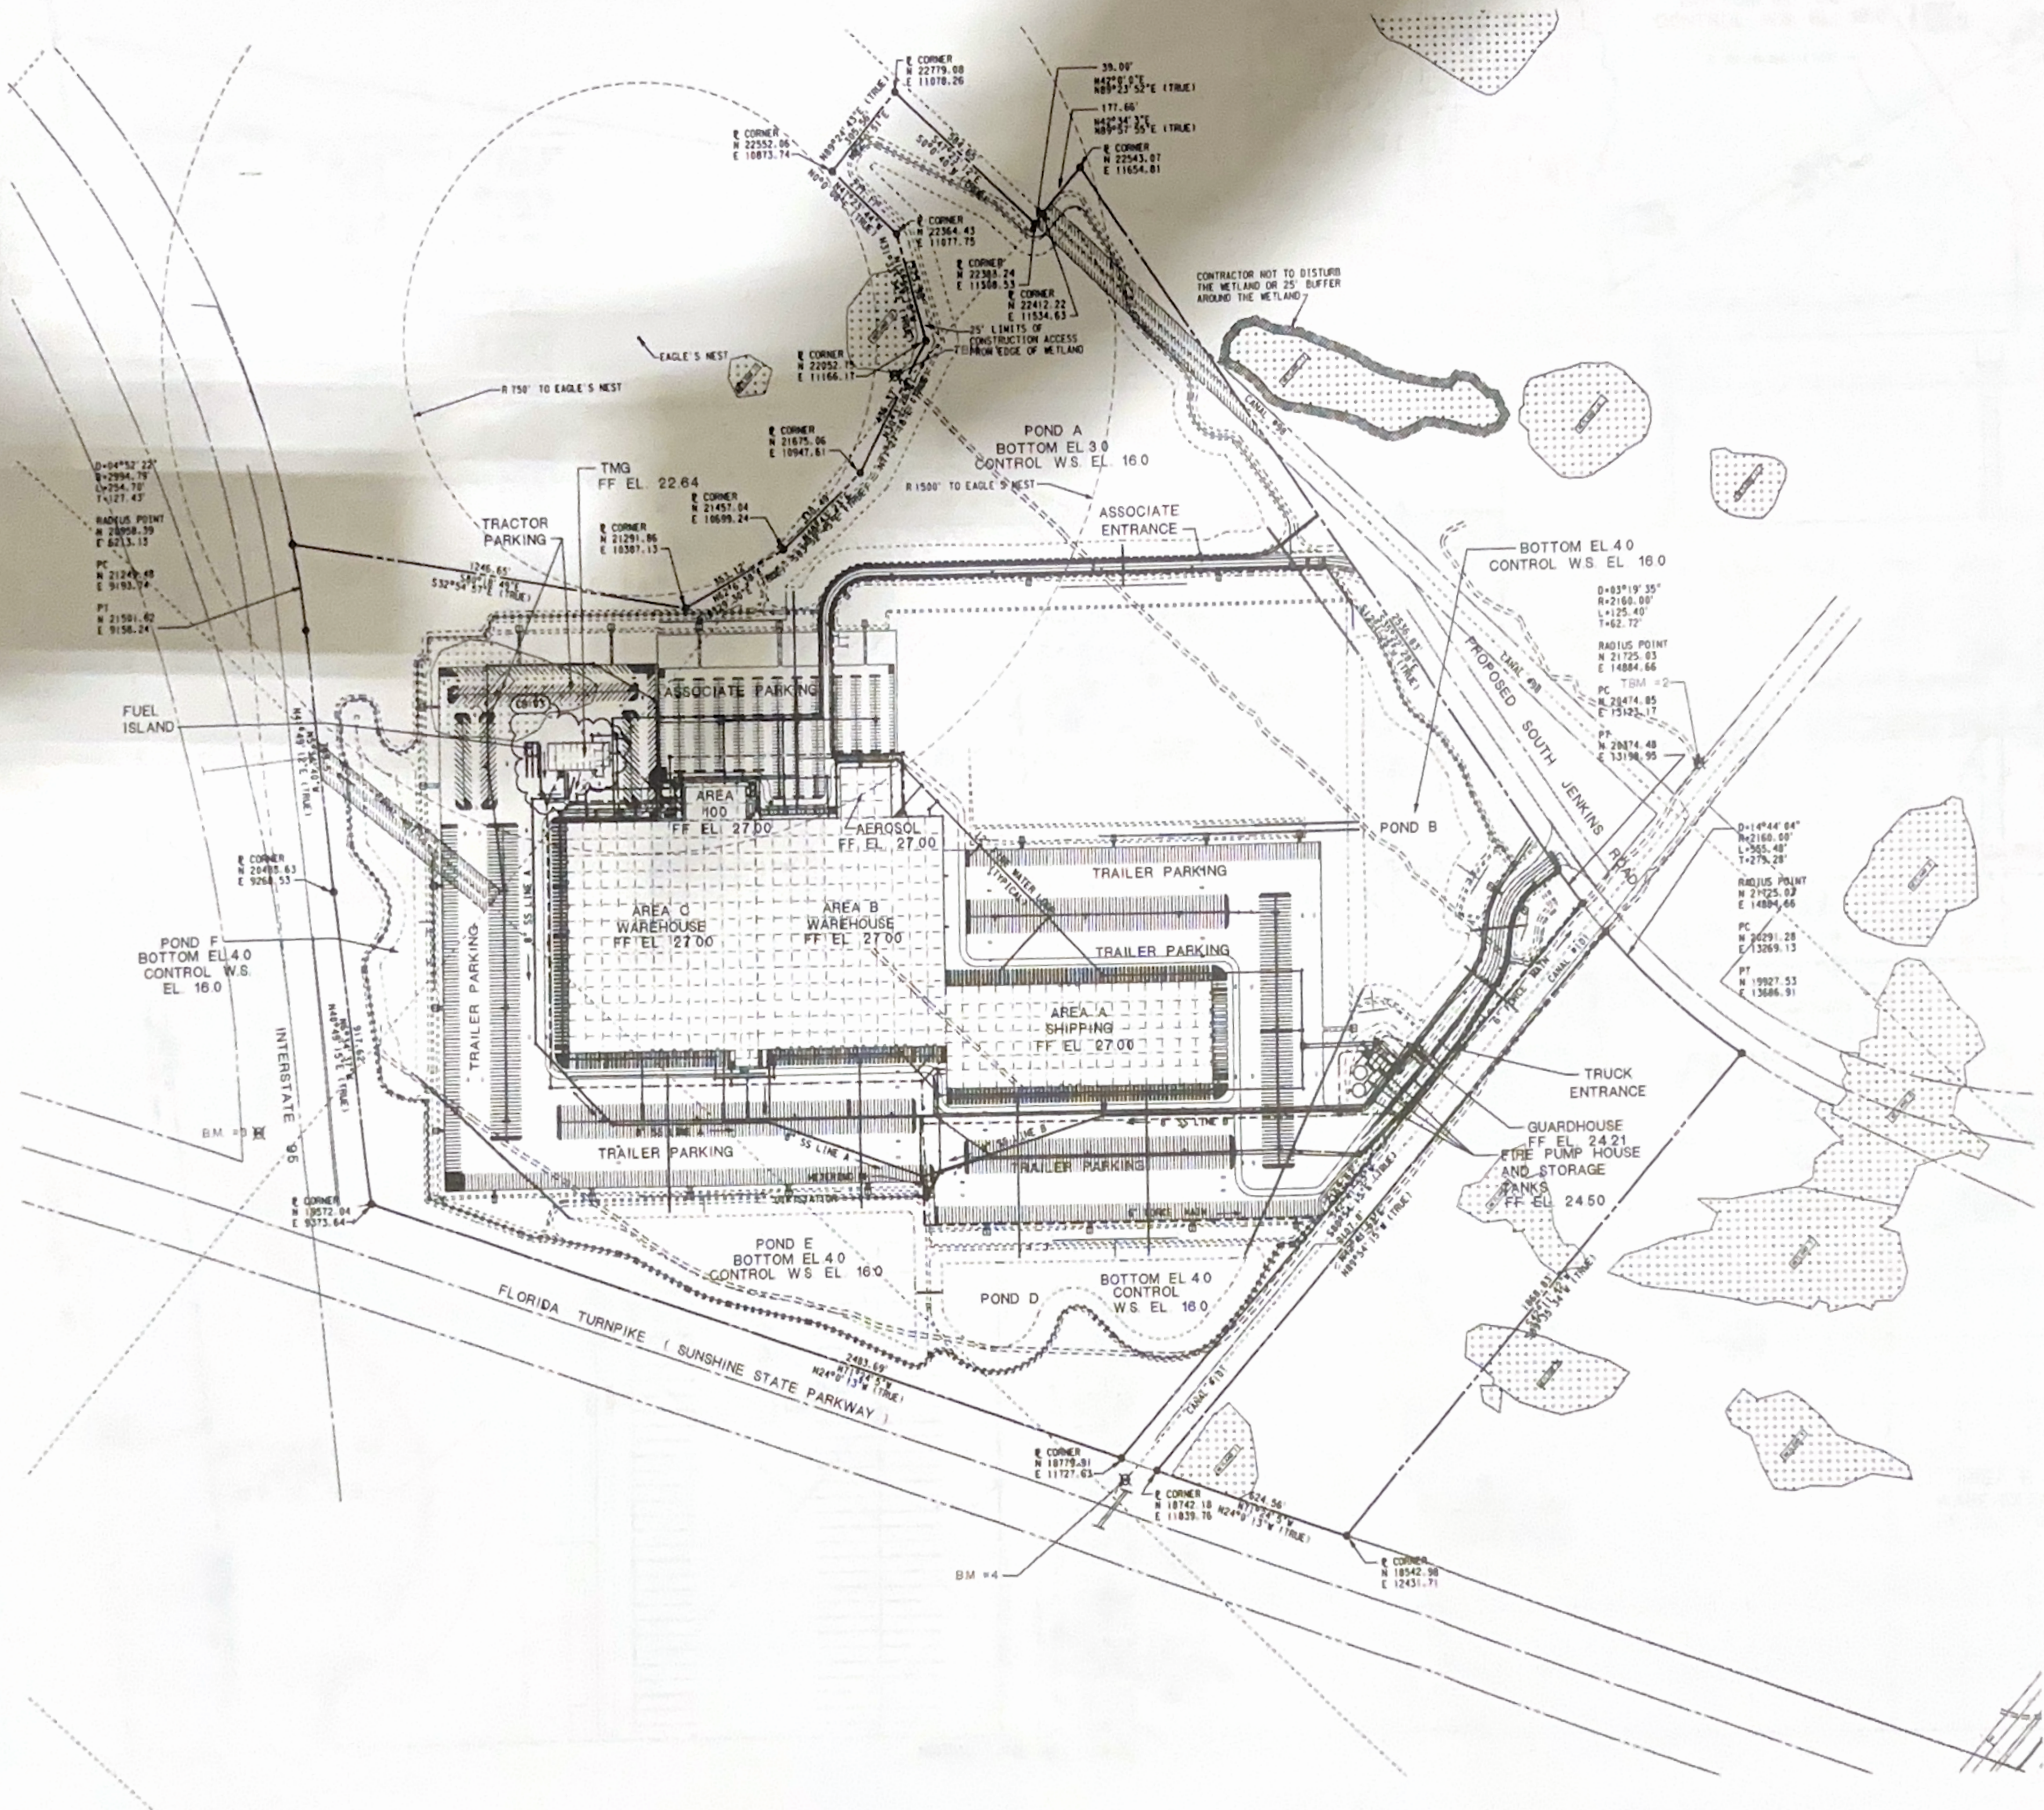

**BENCH MARKS:**  
 TBM #1  
 5/8" I.R. & C., "LB2856"  
 ELEV. 15.49  
 N 21954.20  
 E 11064.83  
 TBM #2  
 5/8" I.R. & C., "LB2856"  
 ELEV. 17.45  
 N 20769.76  
 E 13561.33  
 B.M. #3  
 DISK IN CONC., 195-Y-13  
 ELEV. 46.16  
 N 19786.66  
 E 9029.68  
 B.M. #4  
 5/8" I.R. & C., "LB2856"  
 ELEV. 15.20  
 N 18715.81  
 E 11730.97

NOTE:  
 1. ALL ELEVATIONS ON PLANS ARE BASED AND MUST BE CONSTRUCTED ON NAVD 88 DATUM.  
 2. NAVD 20 IS 1.48' HIGHER THAN NAVD 88 DATUM.

NO.	DATE	ISSUE
1	01/15/03	ISSUE FOR CONSTRUCTION
2	01/15/03	ISSUE FOR CONSTRUCTION
3	03/03/03	ISSUE FOR E & P PERMIT
4	03/11/03	ISSUE FOR PERMIT

**WAL-MART**  
 REGIONAL DISTRIBUTION CENTER NO. 7038  
 FORT PIERCE, FLORIDA

OVERALL - UTILITY PLAN

# PROJECT RECORD

Job #670

Date: 6-16-04


Regional Distribution Center #7038  
 Ft. Pierce, Florida Job #670  
 Carter Engineering & Construction  
 Telephone: (954) 585-4000  
 7901 SW 6th Court  
 Plantation, Florida 33324

This plan, with the as-built notations, accurately reflects the completed work.

M. William Kochal, Senior Project Manager

**Carter-Burgess**  
 Carter-Burgess is a Planning, Architecture, Engineering, Construction Management, and Real Estate Services firm. For more information, please contact:  
 777 South Main Street, Suite 700  
 Fort Pierce, Florida 34949  
 Phone: (888) 333-8888  
 Fax: (888) 333-8888  
 Website: www.carter-burgess.com

47° 23' 52" TRUE NORTH

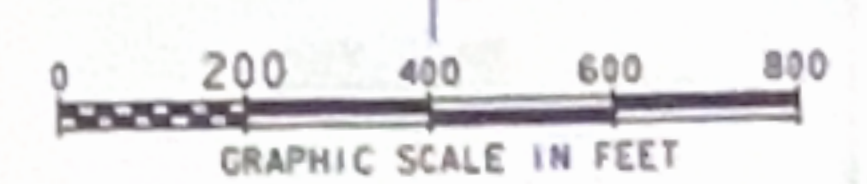

1 OVERALL - UTILITY PLAN  
 CB.01 SCALE: 1" = 200'

SHEET C8.01

NOTES BY SYMBOL

- 1 LIGHT POLE BASE
2 END 6" WATER
3 4"x2" TEE
4 END CONDUIT
5 STA. 0+76.99 - LAT A-3
6 END 2" GAS
7 NOTE USED
8 NOT USED
9 END 500 KVA 17MR PAD
10 STA. 30+79.57 - LINE A
11 12"x10" TEE
12 PULLBOX
13 12"x6" TEE
14 FH
15 NOT USED
16 12"x8" TEE
17 12"x6" TEE
18 6"x8" ELEC MH
19 12" 90° BEND
20 12"x8" TEE
21 NOT USED
22 PULLBOX
23 END CONDUIT
24 NOT USED
25 LIGHT POLE BASE
26 END 4" GAS
27 NOT USED
28 12"x8" TEE
29 12"x6" TEE
30 NOT USED

SANITARY SEWER MANHOLE DATA

- SS MH #9
SS MH #10
SS MH #10A
SS MH #10B
SS MH #11
SS MH #11A
SS MH #11B
SS MH #11C

POND A
BOTTOM EL. 3.0
CONTROL W.S. EL. 16.0

BENCH MARKS

- TBM #1
TBM #2
B.M. #3
B.M. #4

- NOTE 1: ALL ELEVATIONS ON PLANS ARE BASED ON NAVD 88 DATUM.
NOTE 2: MOVD 29 IS 1.48' HIGHER THAN NAVD 88 DATUM.

Table with columns: NO., DATE, ISSUE FOR PERMIT, ISSUE FOR CONSTRUCTION, ISSUE FOR SITE PLAN REVIEW, ISSUE FOR SITE PLAN APPROVAL.

WAL-MART STORES, INC. REGIONAL DISTRIBUTION CENTER NO. 7038 FORT PIERCE, FLORIDA

AREA 2 - UTILITY PLAN



PROJECT RECORD

Job #670

Date: 6-16-04

Regional Distribution Center #7038 Ft. Pierce, Florida Job #670
Carter & Burgess, Inc.
7901 SW 6th Court
Fort Pierce, Florida 33324

M. William Hochst, Senior Project Manager

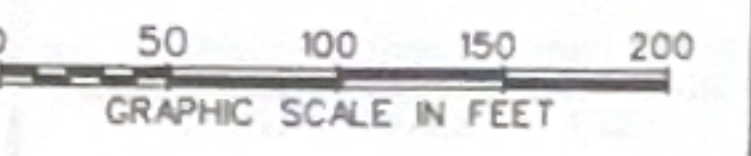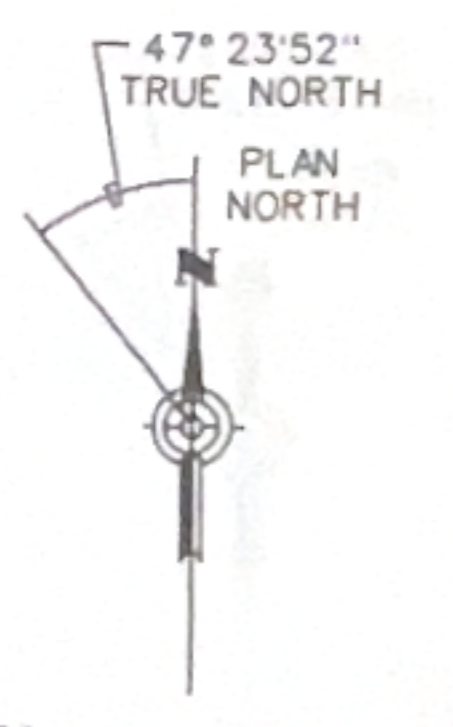


KEY PLAN

Carter-Burgess
Contributors in Planning, Architecture, Engineering, Construction Management, and Related Services
Carter & Burgess, Inc.
7901 SW 6th Court
Fort Pierce, Florida 33324
Cellular: 888.888.8888
Fax: 888.888.8888

SHEET C8.12

Vertical text on the left margin containing project details and dates.

Vertical text on the right margin containing project details and dates.

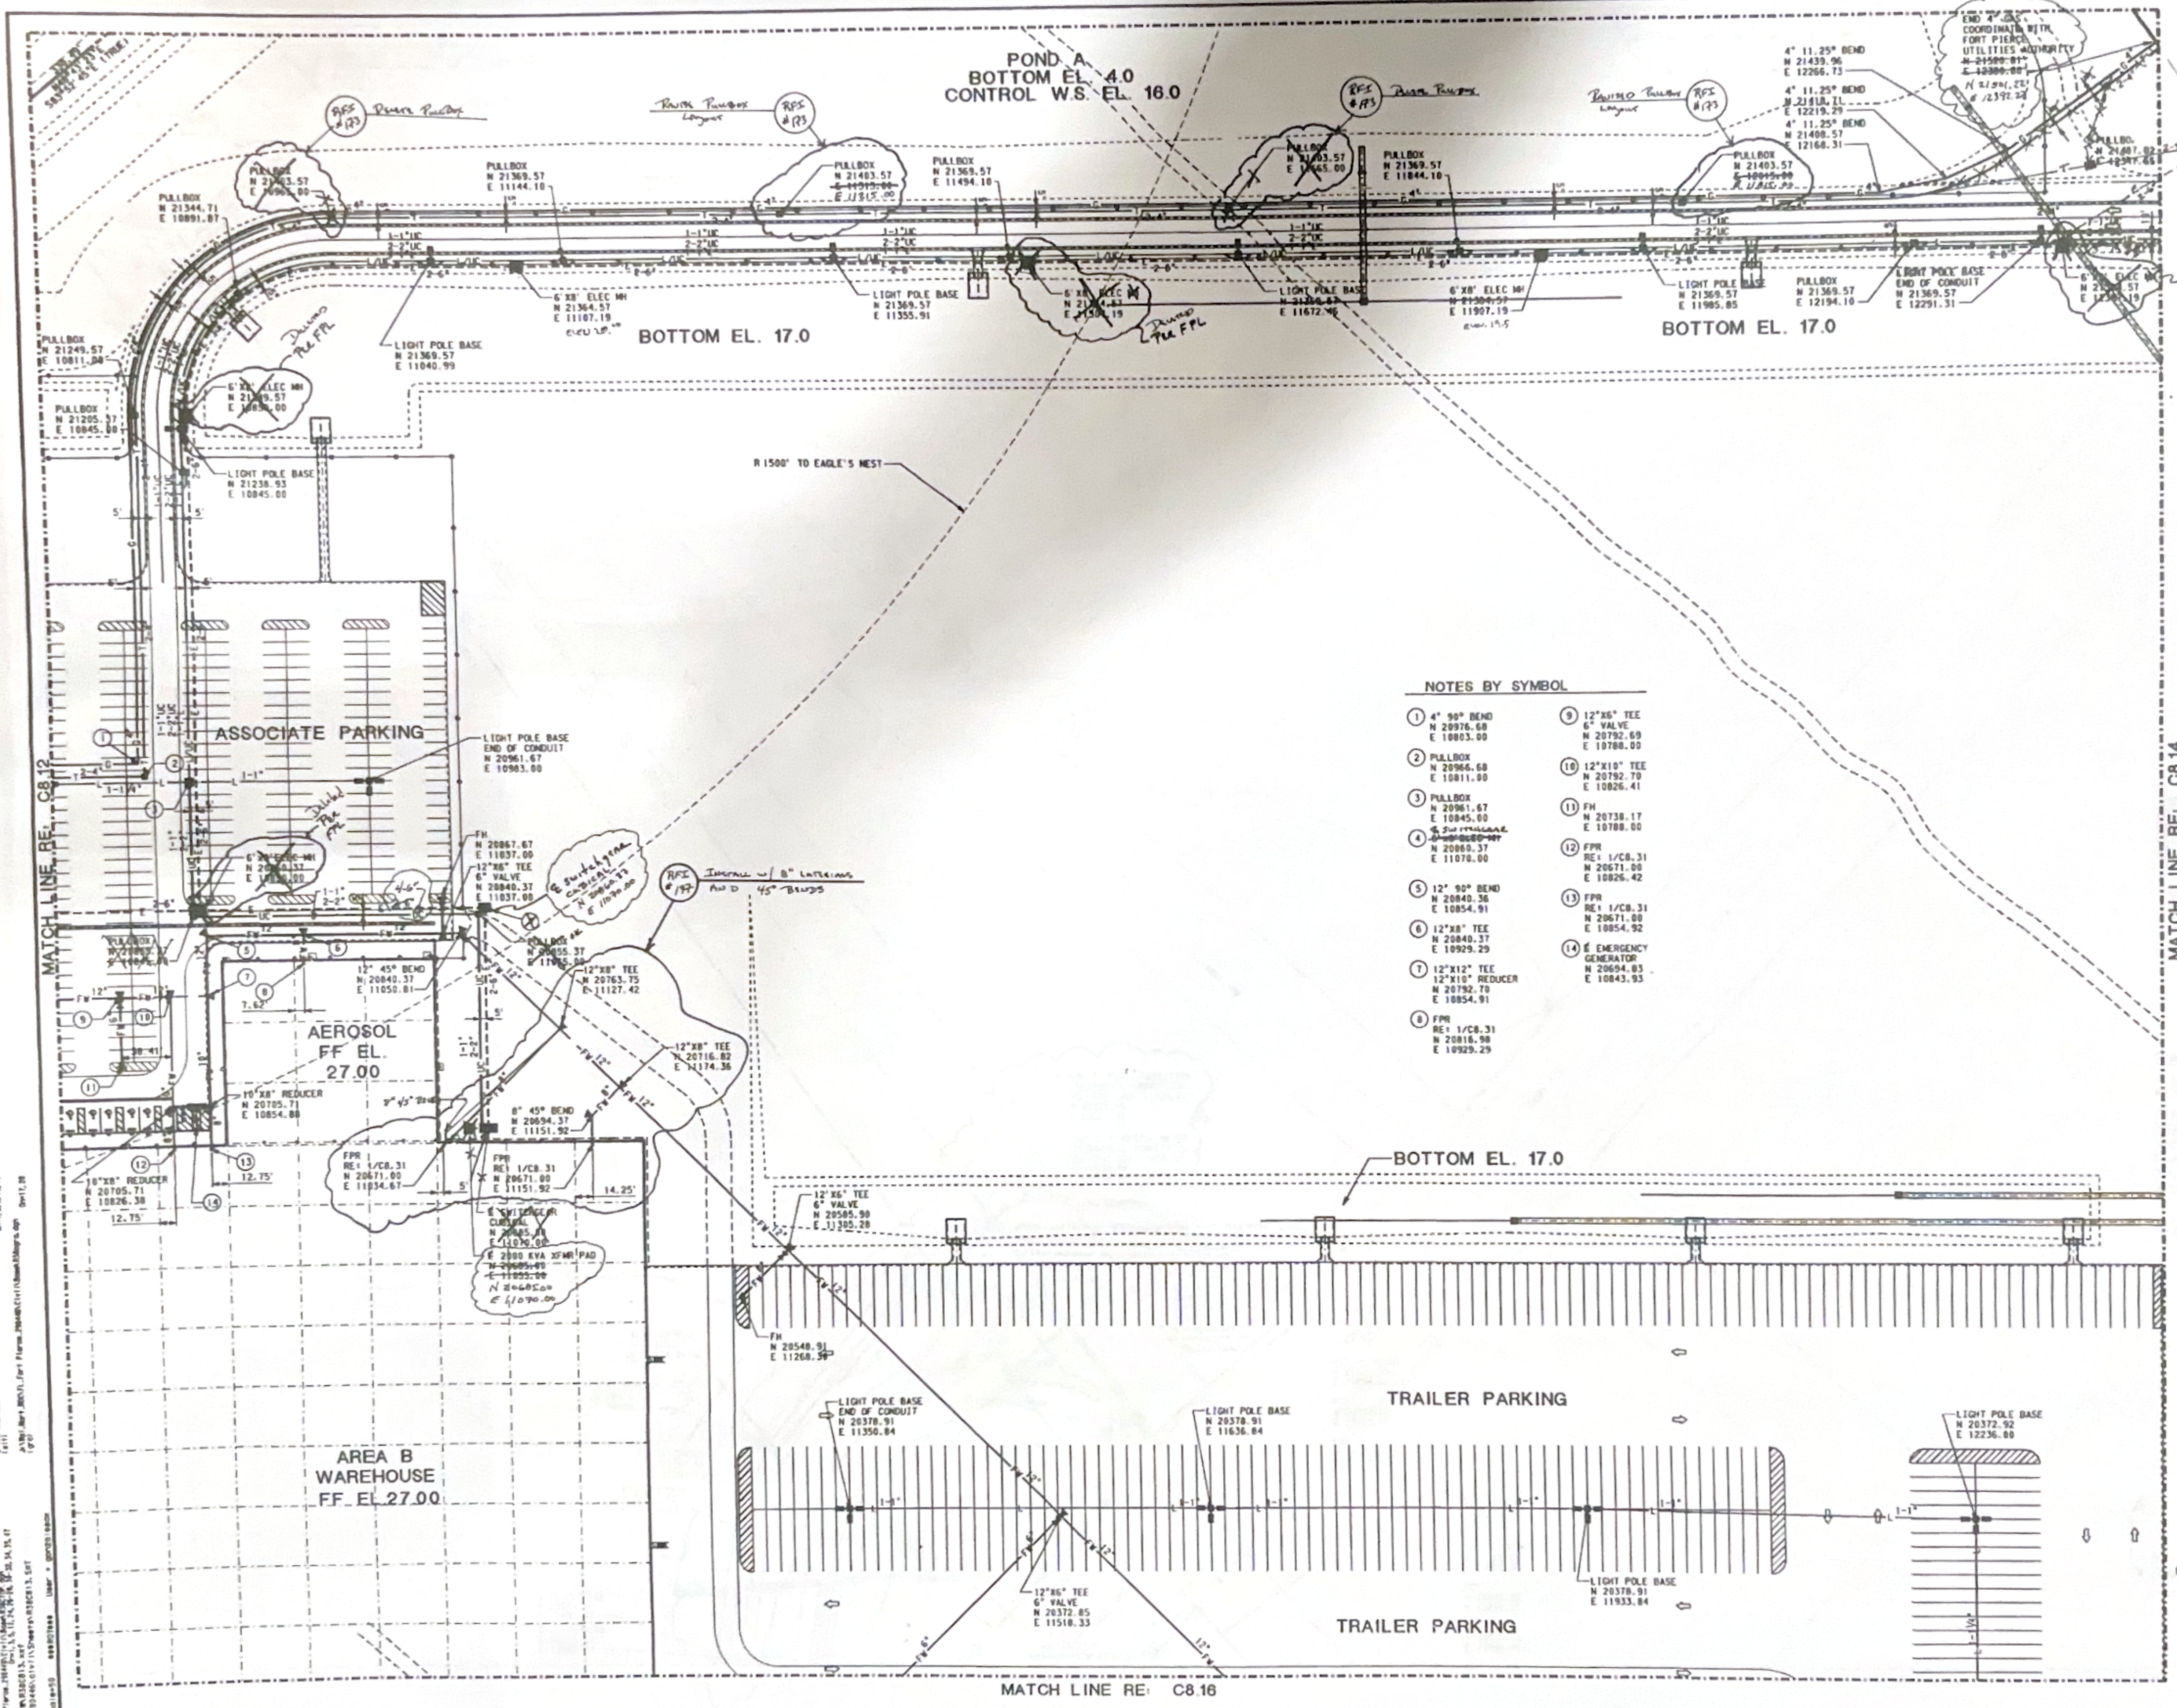

**BENCH MARKS:**

- B.M. #1  
9" I.R. & C., "LB2856"  
ELEV. 15.49  
N 21954.20  
E 11064.83
- B.M. #2  
9" I.R. & C., "LB2856"  
ELEV. 17.45  
N 20769.76  
E 13561.33
- B.M. #3  
DISK IN CONC., 195-Y-13  
ELEV. 46.16  
N 19786.66  
E 9029.68
- B.M. #4  
9" I.R. & C., "LB2856"  
ELEV. 15.20  
N 18715.81  
E 11738.97

NOTE:  
1. ALL ELEVATIONS ON PLANS ARE BASED AND MUST BE CONSTRUCTED ON NAVD 88 DATUM.  
2. MCHD 29 IS 1.48' HIGHER THAN NAVD 88 DATUM.




**NOTES BY SYMBOL**

- |  |  |
|--|--|
| ① 4" 90° BEND<br>N 20976.68<br>E 10803.00                    | ⑨ 12"X6" TEE<br>6" VALVE<br>N 20792.69<br>E 10786.00 |
| ② PULLBOX<br>N 20966.68<br>E 10811.00                        | ⑩ 12"X10" TEE<br>N 20792.78<br>E 10826.41            |
| ③ PULLBOX<br>N 20867.67<br>E 10845.00                        | ⑪ FH<br>N 20738.17<br>E 10788.00                     |
| ④ 6"X12" TEE<br>N 20869.37<br>E 11076.00                     | ⑫ FPR<br>RE: 1/CB.31<br>N 20671.00<br>E 10826.42     |
| ⑤ 12" 90° BEND<br>N 20840.36<br>E 10854.91                   | ⑬ FPR<br>RE: 1/CB.31<br>N 20671.00<br>E 10854.92     |
| ⑥ 12"X8" TEE<br>N 20840.37<br>E 10929.29                     | ⑭ EMERGENCY<br>GENERATOR<br>N 20694.83<br>E 10843.93 |
| ⑦ 12"X12" TEE<br>12"X10" REDUCER<br>N 20792.78<br>E 10854.91 |  |
| ⑧ FH<br>RE: 1/CB.31<br>N 20818.98<br>E 10929.29              |  |

# PROJECT RECORD

Job #670

Date: 6-16-04  
 Regional Distribution Center #7038  
 Ft. Pierce, Florida Job #670  
 Centex Engineering & Construction  
 Telephone: (854) 585-4000  
 7901 SW 8th Court  
 Plantation, Florida 33324  
 This plan, with the as-built notations, accurately reflects the completed work.  
 M. William Rachal, Senior Project Manager

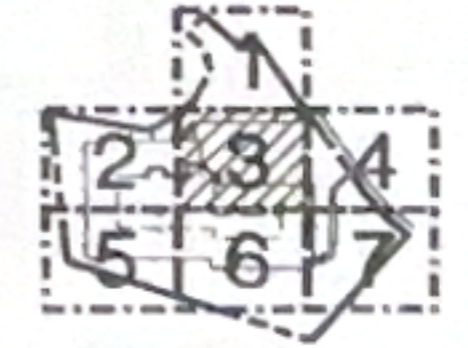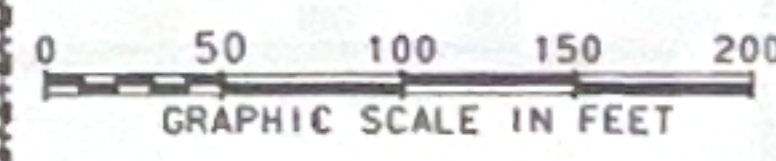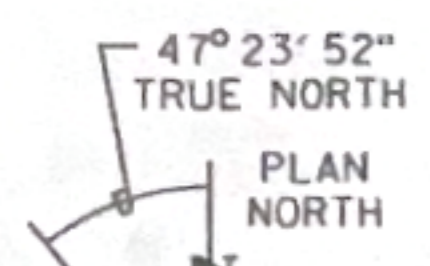

KEY PLAN

**AREA 3 - UTILITY PLAN**

SCALE: 1" = 50'

6/6/03


ISSUE NO.	DATE	DESCRIPTION
1	06/16/04	ISSUE FOR CONSTRUCTION

**WAL-MART**  
 REGIONAL DISTRIBUTION CENTER NO. 7038  
 FORT PIERCE, FLORIDA

AREA 3 - UTILITY PLAN

**Carter & Burgess**  
 Conditions in Planning, Architectural, Engineering, Surveying, and Construction Services  
 Carter & Burgess, Inc.  
 777 West Coast Parkway, Suite 700  
 Fort Pierce, Florida 34946  
 Phone: (888) 233-2333  
 Fax: (888) 233-2333

SHEET  
**C8.13**

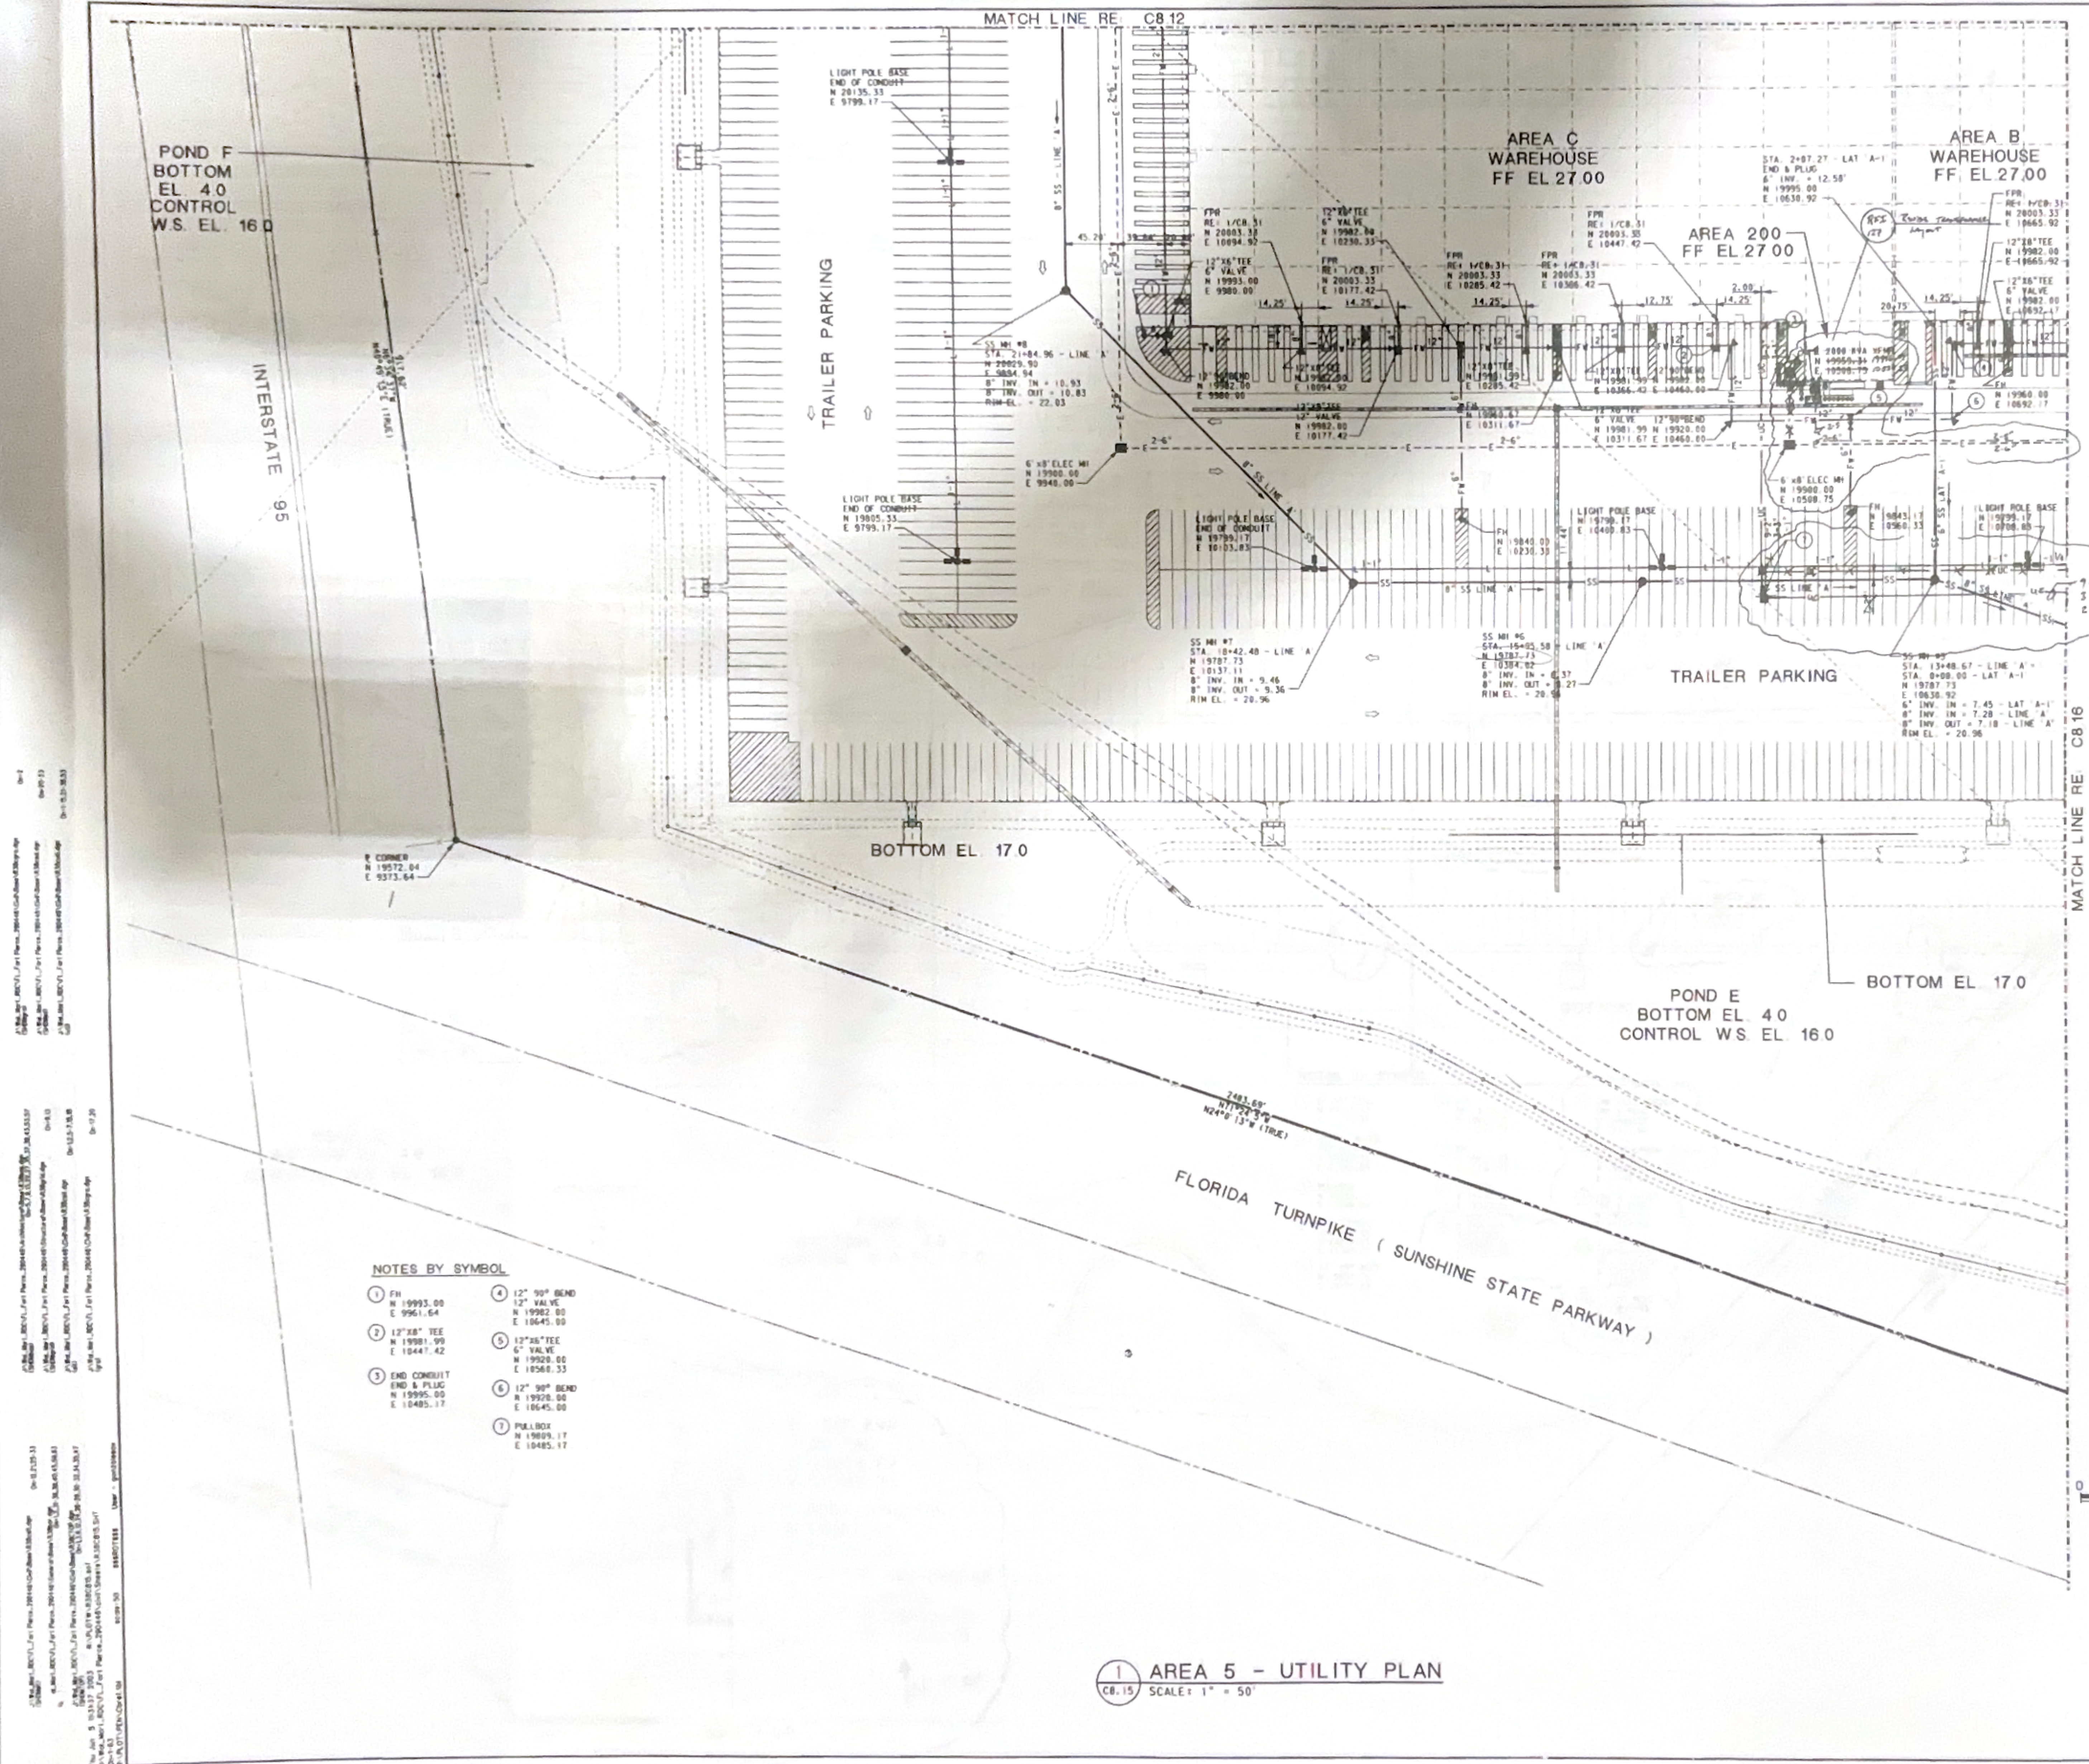

**BENCH MARKS:**

**TBM #1**  
 58" I.R. & C., "LB2856"  
 ELEV. 15.49  
 N 21954.20  
 E 11064.83

**TBM #2**  
 58" I.R. & C., "LB2856"  
 ELEV. 17.45  
 N 20769.76  
 E 13561.33

**B.M. #3**  
 DISK IN CONC., 195-Y-13  
 ELEV. 46.16  
 N 19786.66  
 E 9029.68

**B.M. #4**  
 58" I.R. & C., "LB2856"  
 ELEV. 15.20  
 N 18715.81  
 E 11738.97

**NOTE:**

- ALL ELEVATIONS ON PLANS ARE BASED AND MUST BE CONSTRUCTED ON NAVD 88 DATUM.
- MGVD 29 IS 1' 48" HIGHER THAN NAVD 88 DATUM.

NO.	DATE	ISSUE
1	01/15/03	ISSUE FOR PERMIT
2	02/27/03	ISSUE FOR CONSTRUCTION
3	03/10/03	ISSUE FOR PERMIT
4	03/11/03	ISSUE FOR PERMIT

**WAL-MART**  
 REGIONAL DISTRIBUTION  
 CENTER NO. 7038  
 FORT PIERCE, FLORIDA

# PROJECT RECORD

Job #670




Date: 06-16-04

Regional Distribution Center #7038  
 Ft. Pierce, Florida Job #670

Centex Engineering & Construction  
 Telephone: (954) 585-4000  
 7901 SW 6th Court  
 Plantation, Florida 33324

This plan, with the as-built notations, accurately reflects the completed work.

M. William Rochat, Senior Project Manager

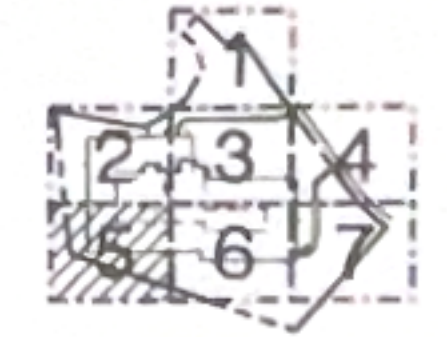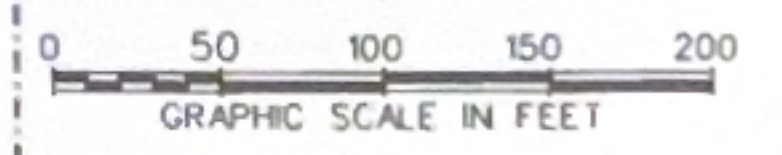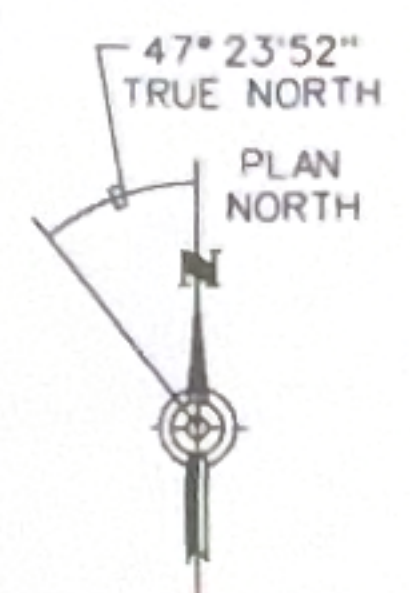

- NOTES BY SYMBOL**
- ① FH  
N 1993.00  
E 9561.64
  - ② 12" x 8" TEE  
N 19981.99  
E 10447.42
  - ③ END CONDUIT  
END & PLUG  
N 19995.00  
E 10485.17
  - ④ 12" 90° BEND  
12" VALVE  
N 19982.00  
E 10645.00
  - ⑤ 12" x 6" TEE  
6" VALVE  
N 19928.00  
E 10568.33
  - ⑥ 12" 90° BEND  
N 19928.00  
E 10645.00
  - ⑦ PULL BOX  
N 19809.17  
E 10485.17

1 AREA 5 - UTILITY PLAN  
 C8.15 SCALE: 1" = 50'


AREA 5 - UTILITY PLAN

**Carter-Burgess**  
 Contributors in Planning, Architecture, Engineering,  
 Construction Management and Related Services  
 Carter & Burgess, Inc.  
 177 West Lake Avenue, Suite 2000  
 Fort Pierce, Florida 34949  
 Certificate of Registration Number AA-00080

SHEET  
 C8.15

04-1  
 04-2  
 04-3  
 04-100

Copyright © 2004 by Carter & Burgess, Inc.

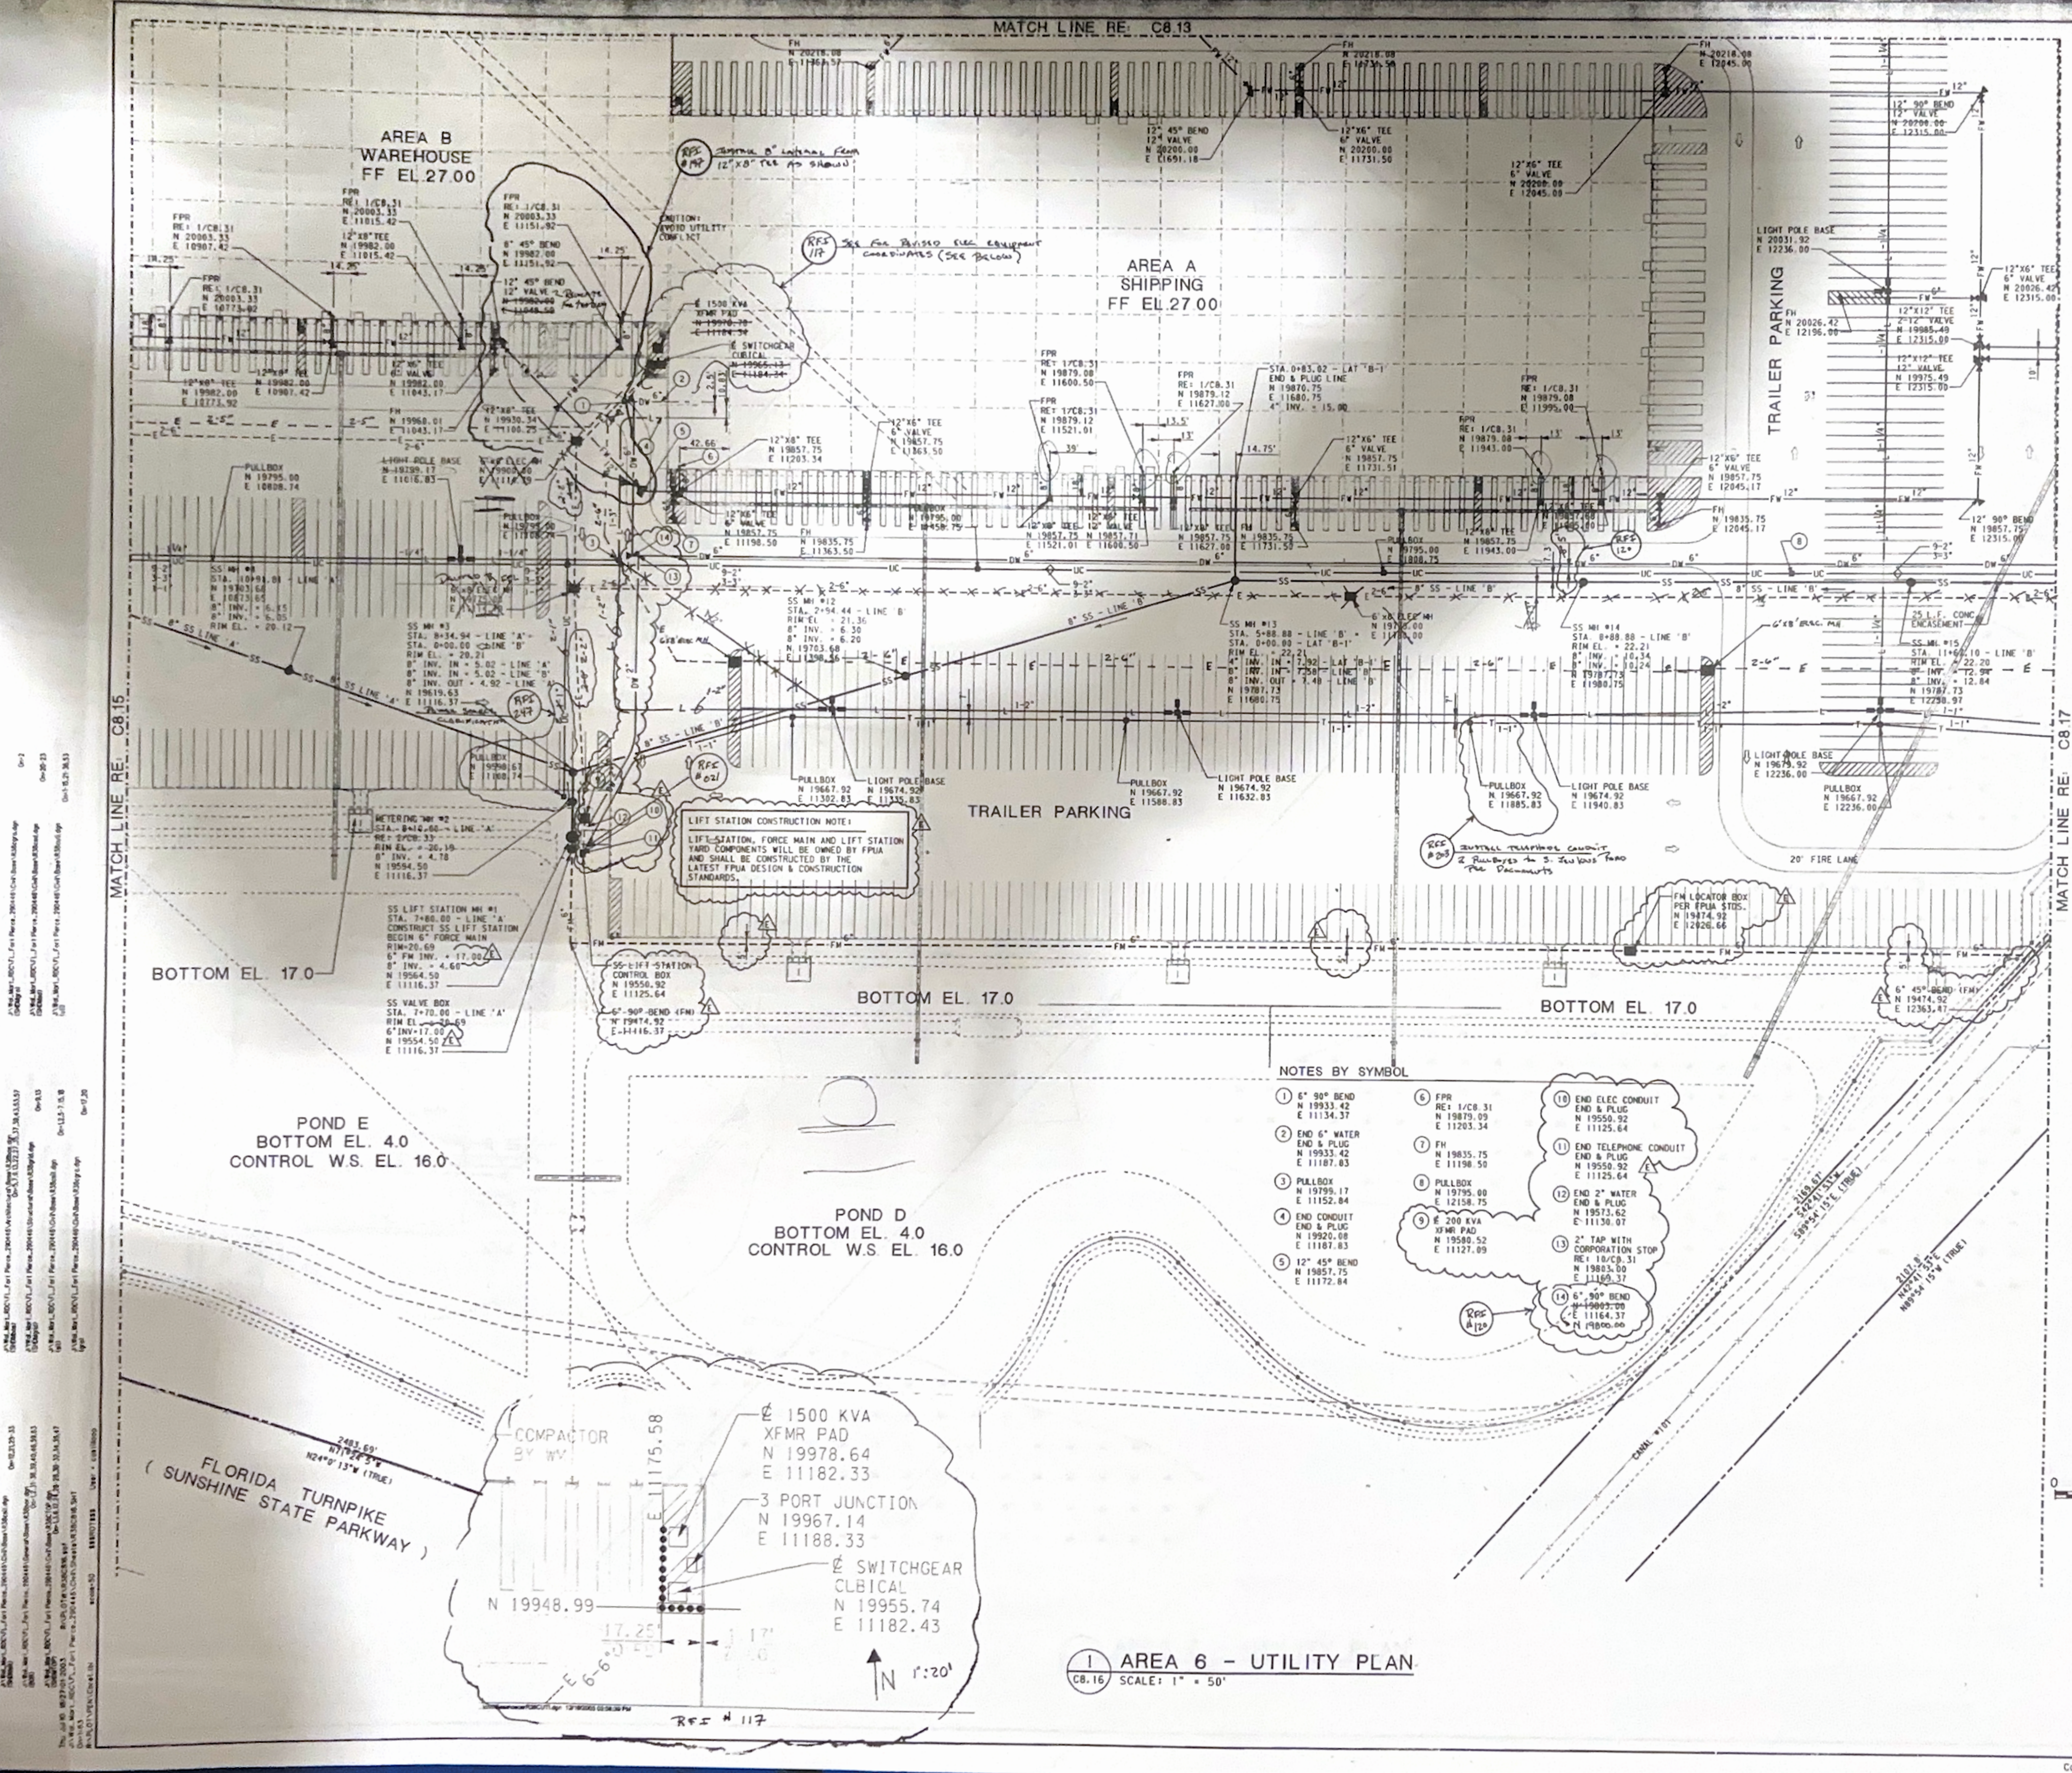

**BENCH MARKS:**

TBM #1  
 3/8" I.R. & C., "LB2856"  
 ELEV. 15.49  
 N 21954.20  
 E 11064.83

TBM #2  
 3/8" I.R. & C., "LB2856"  
 ELEV. 17.45  
 N 20769.76  
 E 13561.33

B.M. #3  
 DISK IN CONC., 195-Y-13  
 ELEV. 46.16  
 N 19786.66  
 E 9029.68

B.M. #4  
 3/8" I.R. & C., "LB2856"  
 ELEV. 15.20  
 N 18715.81  
 E 11738.97

**NOTE:**

- ALL ELEVATIONS ON PLANS ARE BASED AND MUST BE CONSTRUCTED ON NAVD 88 DATUM.
- NOVO 29 IS 1.48" HIGHER THAN NAVD 88 DATUM.




# PROJECT RECORD

Job #670

Date: 06-16-04  
 Regional Distribution Center #7038  
 Ft. Pierce, Florida Job #670  
 Centex Engineering & Construction  
 Telephone: (954) 585-4000  
 7901 SW 6th Court  
 Plantation, Florida 33324  
 This plan, with the as-built notations, accurately reflects the completed work.  
 M. William Rochat, Senior Project Manager

**NOTES BY SYMBOL**

- 1 6" 90° BEND  
N 19933.42  
E 11134.37
- 2 END 6" WATER  
N 19933.42  
E 11187.03
- 3 PULLBOX  
N 19795.17  
E 11152.84
- 4 END CONDUIT  
END & PLUG  
N 19933.42  
E 11187.03
- 5 12" 45° BEND  
N 19857.75  
E 11172.84
- 6 FPR  
RE: 1/CB.31  
N 19879.09  
E 11203.34
- 7 FH  
N 19835.75  
E 11198.50
- 8 PULLBOX  
N 19795.00  
E 12158.75
- 9 200 KVA  
XFMR PAD  
N 19580.52  
E 11127.09
- 10 END ELEC CONDUIT  
END & PLUG  
N 19550.92  
E 11125.64
- 11 END TELEPHONE CONDUIT  
END & PLUG  
N 19550.92  
E 11125.64
- 12 END 2" WATER  
END & PLUG  
N 19513.62  
E 11150.07
- 13 2" TAP WITH  
CORPORATION STOP  
RE: 1/CB.31  
N 19883.00  
E 11160.37
- 14 6" 90° BEND  
N 19903.00  
E 11164.37

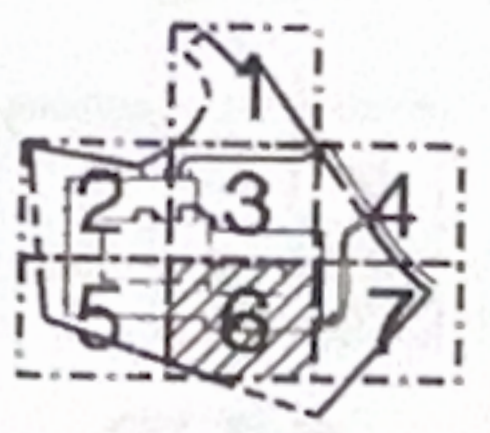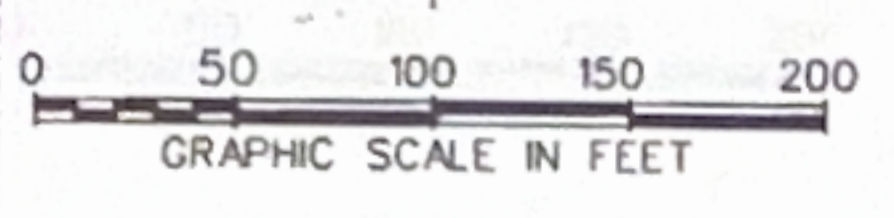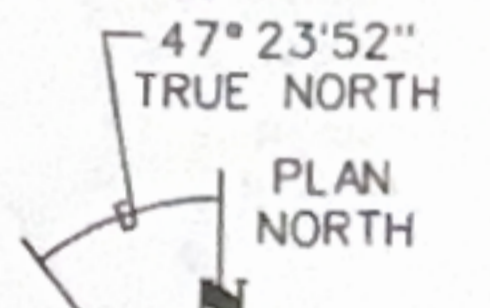

1 AREA 6 - UTILITY PLAN  
 C8.16 SCALE: 1" = 50'



PROJECT NO.	DATE	ISSUE
07038	01/15/03	ISSUE FOR PERMIT
07038	03/15/03	ISSUE FOR R.R. PERMIT
07038	05/15/03	ISSUE FOR CONSTRUCTION
07038	06/15/03	ISSUE FOR SITE PLAN REVIEW
07038	06/15/03	ISSUE

**WAL-MART**  
 REGIONAL DISTRIBUTION  
 CENTER NO. 7038  
 FORT PIERCE, FLORIDA

AREA 6 - UTILITY PLAN

**Carter & Burgess**  
 Consultants in Planning, Architecture, Engineering,  
 and Construction Services  
 Carter & Burgess, Inc.  
 177 Main Street, Fort Worth, Texas 76102  
 (817) 332-6800 Fax (817) 332-6700  
 Website: www.carterburgess.com

SHEET  
**C8.16**

# REGIONAL DISTRIBUTION CENTER NO. 7038

## FORT PIERCE, FLORIDA

# WAL-MART®

STORES EAST, L.P.  
SAM M. WALTON DEVELOPMENT COMPLEX  
2001 SOUTHEAST 10TH STREET, DEPARTMENT 9562  
BENTONVILLE, ARKANSAS 72716-0550

## Carter Burgess

Consultants in Planning, Engineering, Architecture,  
Construction Management, and Related Services

Carter & Burgess, Inc.


Retail & Distribution - Floor 29  
777 Main Street, Fort Worth, Texas 76102  
(817) 222-8500 Fax (817) 222-8550

Architecture Certificate of Authorization Number AA-C001802  
Engineering Certificate of Authorization Number 5300



### DRAWING INDEX

DISCIPLINE CODE	BUILDING AREAS	SITE AREAS
C - CIVIL	1. WAREHOUSE	1. TOPOGRAPHY
A - ARCHITECTURAL	2. TMG/FUEL DISPENSING ISLAND	2. LAYOUT
S - STRUCTURAL	3. GUARDHOUSE	3. GRADING
M - MECHANICAL	4. FIRE PUMP HOUSE	4. DRAINAGE
P - PLUMBING		5. EROSION CONTROL
K - KITCHEN		6. PAVING
E - ELECTRICAL		7. SITE IMPROVEMENTS
MA - ARCHITECTURAL (METAL BUILDING)		8. UTILITIES
ME - ROOF EQUIPMENT (METAL BUILDING)		9. LANDSCAPING
MS - STRUCTURAL (METAL BUILDING)		10. TRAFFIC CONTROL
J - JOIST (METAL BUILDING)		
NR - NATURAL RESOURCES		
T - TRAFFIC CONTROL		

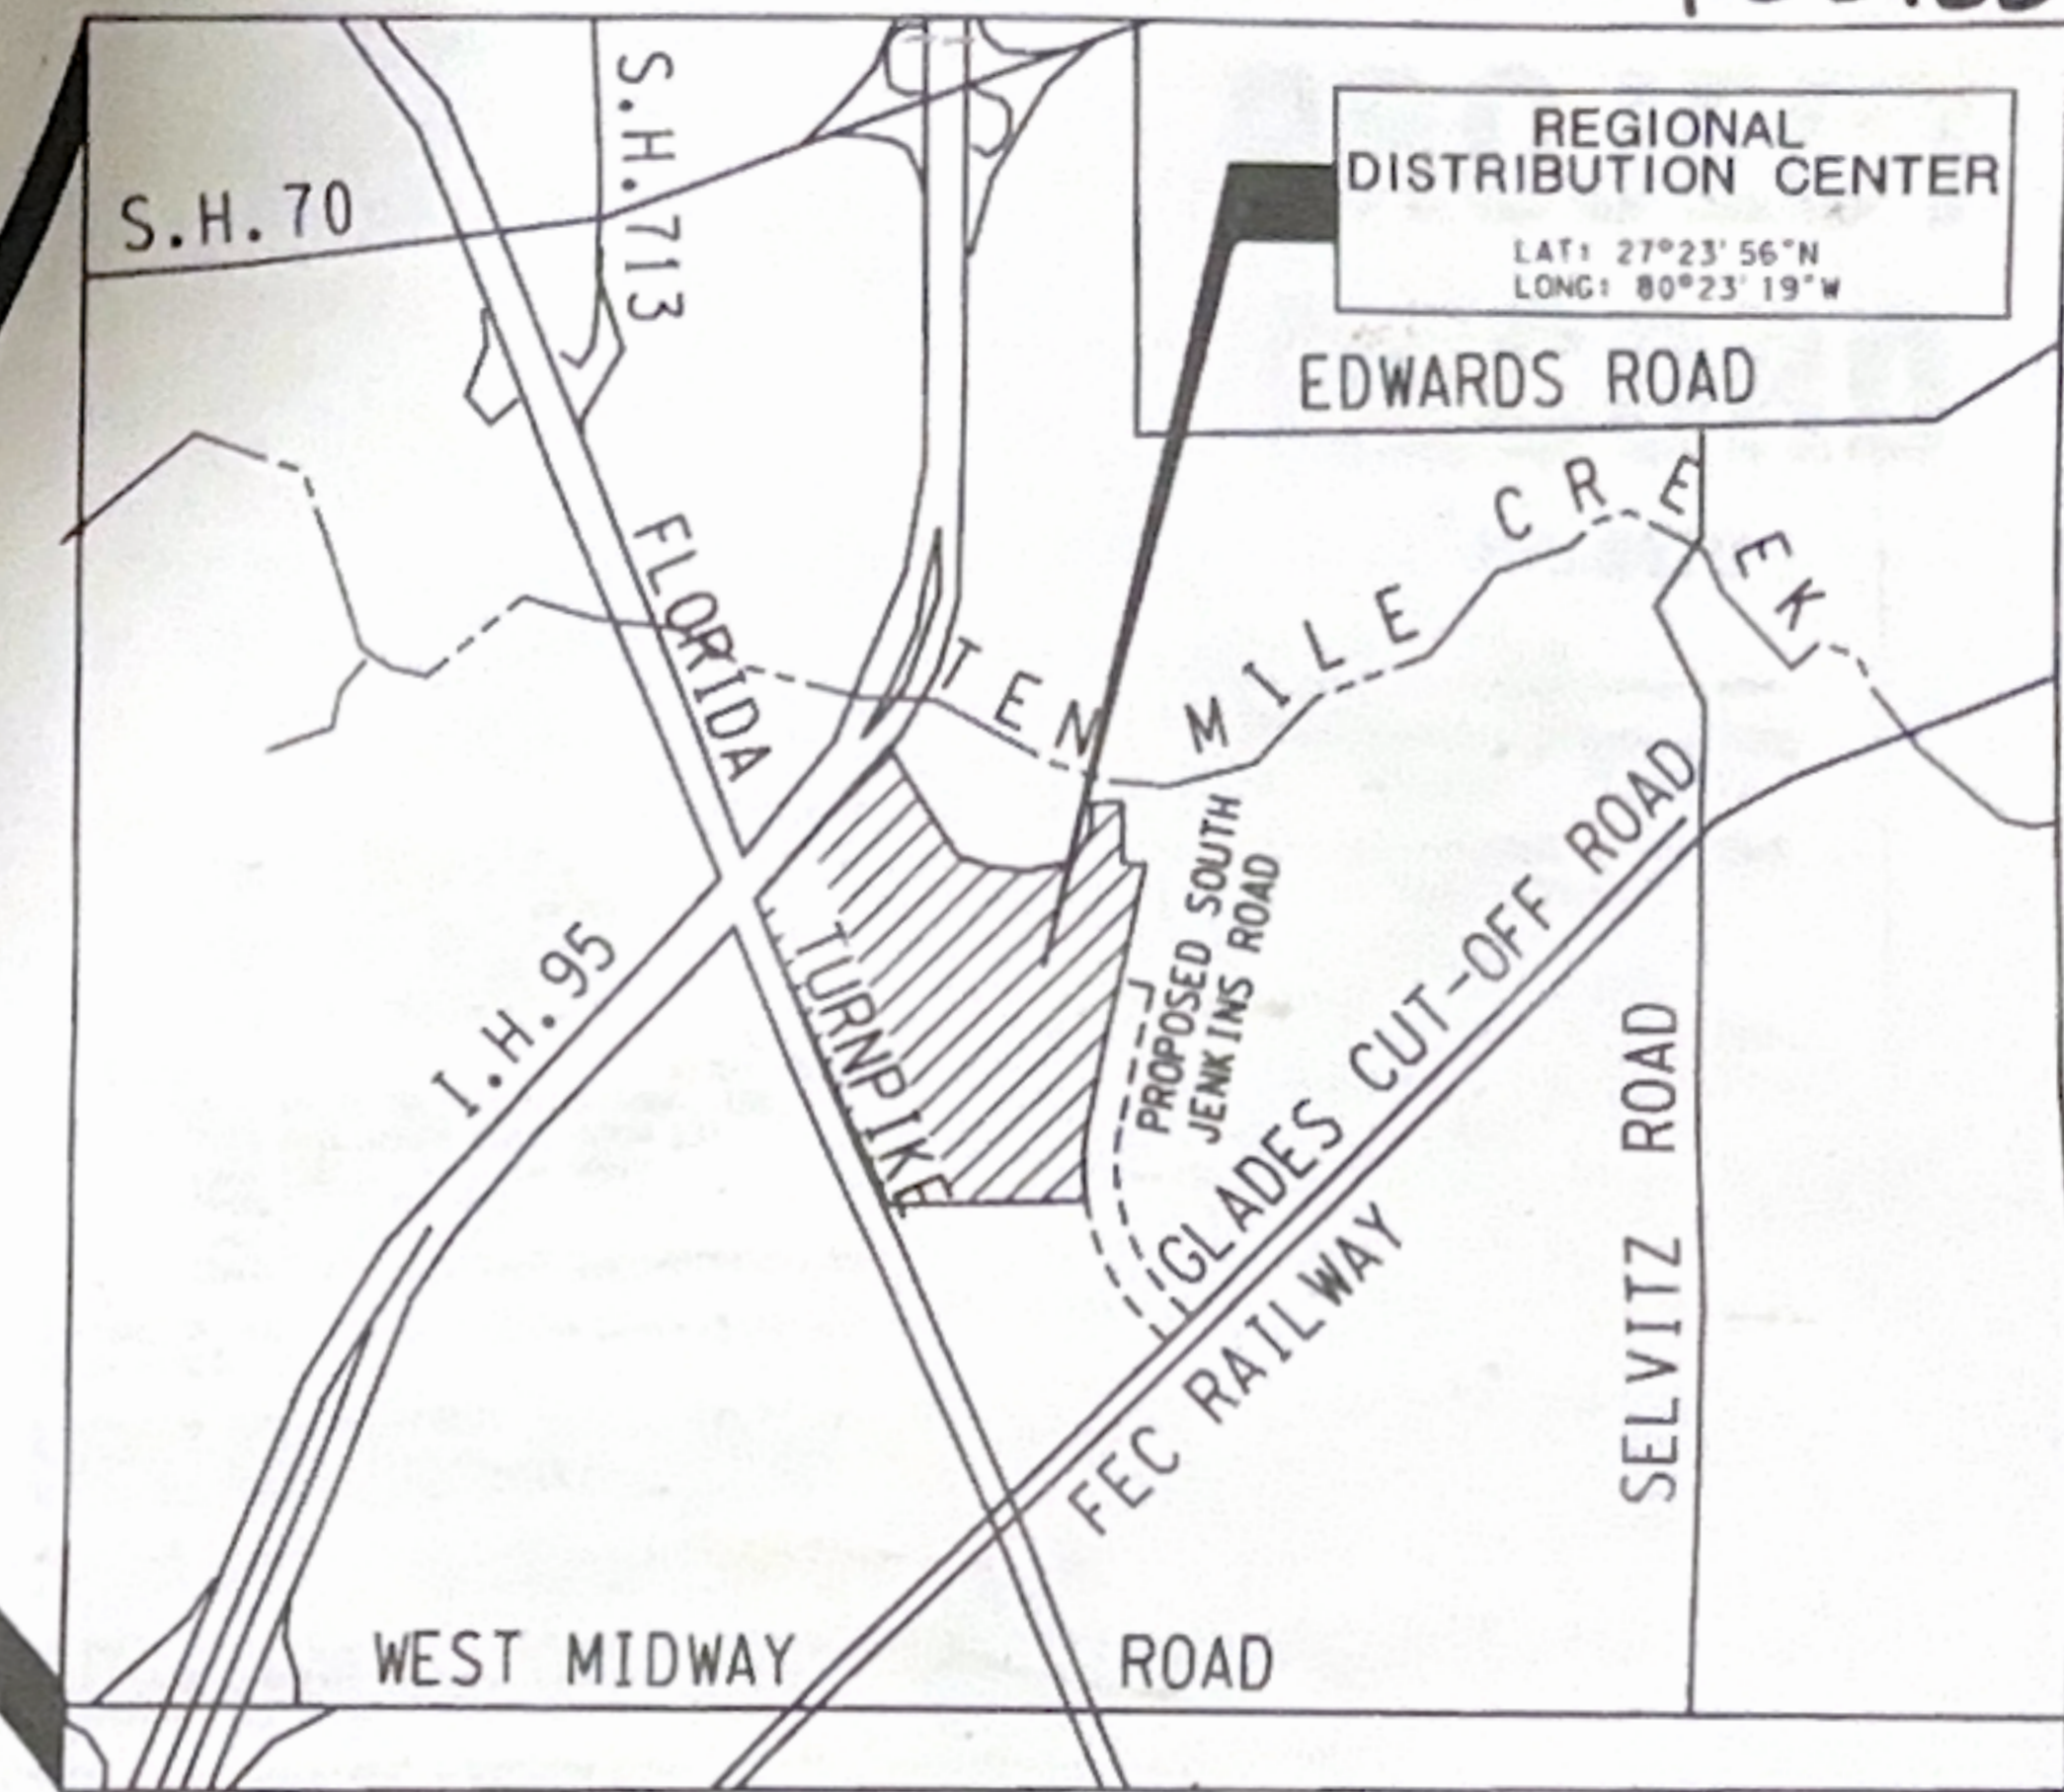

POSTED SET  
7/3/03  
7/11/03

DISCIPLINE CODE	BUILDING AREAS	SITE AREAS
CB.01	CB.01	CB.01
1. TOPOGRAPHY	B. UTILITY	1. WAREHOUSE
1.01 BOUNDARY AND TOPOGRAPHIC SURVEY	CB.01 OVERALL - UTILITY PLAN	1.01 OVERALL - RACK & CONVEYOR PLAN
1.02 BOUNDARY AND TOPOGRAPHIC SURVEY	CB.11 AREA 1 - UTILITY PLAN (NOT USED)	1.02 AREA A - RACK & CONVEYOR PLAN
1.03 BOUNDARY AND TOPOGRAPHIC SURVEY	CB.12 AREA 2 - UTILITY PLAN	1.03 AREA B - RACK & CONVEYOR PLAN
2. LAYOUT	CB.13 AREA 3 - UTILITY PLAN	1.04 WAREHOUSE - LIGHTING DIMENSION PLAN
2.01 PHASE 1 LAYOUT	CB.14 AREA 4 - UTILITY PLAN	1.05 AREA A - LIGHTING PLAN
2.02 AREA 1 - LAYOUT & DIMENSION PLAN	CB.15 AREA 5 - UTILITY PLAN	1.06 AREA B - LIGHTING PLAN
2.03 AREA 2 - LAYOUT & DIMENSION PLAN	CB.16 AREA 6 - UTILITY PLAN	1.07 AREA C - LIGHTING PLAN
2.04 AREA 3 - LAYOUT & DIMENSION PLAN	CB.17 AREA 7 - UTILITY PLAN	1.08 LOWER LEVEL - LIGHTING PLAN
2.05 AREA 4 - LAYOUT & DIMENSION PLAN	CB.21 SANITARY SEWER PROFILES - LINE 'A'	1.09 AREA A - POWER PLAN
2.06 AREA 5 - LAYOUT & DIMENSION PLAN	CB.22 SANITARY SEWER PROFILES - LINE 'B', LATERALS 'A-1', 'A-2', 'A-3', 'B-1' & 'B-2'	1.10 AREA B - POWER PLAN
2.07 AREA 6 - LAYOUT & DIMENSION PLAN	CB.31 UTILITY DETAILS - SHEET 1 OF 5	1.11 AREA C - POWER PLAN
2.08 AREA 7 - LAYOUT & DIMENSION PLAN	CB.32 UTILITY DETAILS - SHEET 2 OF 5	1.12 WAREHOUSE - TMG, FPH, & GUARDHOUSE - CONDUIT PLANS
3. GRADING	CB.33 UTILITY DETAILS - SHEET 3 OF 5	1.13 AREA A - VENTILATION / HEATING POWER PLAN
3.01 OVERALL - GRADING PLAN	CB.34 UTILITY DETAILS - SHEET 4 OF 5	1.14 AREA B - VENTILATION / HEATING POWER PLAN
3.02 AREA 1 - GRADING PLAN	CB.35 UTILITY DETAILS - SHEET 5 OF 5	1.15 AREA C - VENTILATION / HEATING POWER PLAN
3.03 AREA 2 - GRADING PLAN		1.16 AREA 100 - LIGHTING PLAN
3.04 AREA 3 - GRADING PLAN		1.17 AREA 200 & 300A - LIGHTING PLANS
3.05 AREA 4 - GRADING PLAN		1.18 AREA 400 - LIGHTING PLAN
3.06 AREA 5 - GRADING PLAN		1.19 AREA 200 & 300B - POWER PLANS
3.07 AREA 6 - GRADING PLAN		1.20 AREA 400 - POWER PLANS
3.08 AREA 7 - GRADING PLAN		1.21 KITCHEN - ENLARGED POWER PLAN & DETAILS
4. DRAINAGE	9. LANDSCAPING	1.22 DATA PROCESSING ROOM - ENLARGED POWER PLAN & DETAILS
4.01 OVERALL - PRE-DEVELOPED DRAINAGE AREA MAP	NR1 NATURAL RESOURCE STRATEGY PLAN	1.23 KITCHEN - ENLARGED POWER PLAN & DETAILS
4.02 CONCEPTUAL DRAINAGE AREA MAP	NR2 NATURAL RESOURCE ENLARGEMENTS	1.24 KITCHEN - PLUMBING PLAN & DETAILS
4.03 OVERALL - DEVELOPED DRAINAGE AREA MAP	NR3 NATURAL RESOURCE ENLARGEMENTS	1.25 PLUMBING RISER DIAGRAMS
4.04 AREA 1 - STORM DRAIN PLAN (NOT USED)	NR4 NATURAL RESOURCE ENLARGEMENTS	1.26 PLUMBING RISER DIAGRAMS
4.05 AREA 2 - STORM DRAIN PLAN	NR5 NATURAL RESOURCE ENLARGEMENTS	1.27 PLUMBING RISER DIAGRAMS
4.06 AREA 3 - STORM DRAIN PLAN	NR6 NATURAL RESOURCE SOIL MANAGEMENT	1.28 PLUMBING RISER DIAGRAMS
4.07 AREA 4 - STORM DRAIN PLAN	NR7 NATURAL RESOURCE PHASING PLAN	1.29 PLUMBING RISER DIAGRAMS
4.08 AREA 5 - STORM DRAIN PLAN	NR8 NATURAL RESOURCE TRANSPLANT PLAN	1.30 PLUMBING RISER DIAGRAMS
4.09 AREA 6 - STORM DRAIN PLAN	NR9 NATURAL RESOURCE TRANSPLANT ENLARGEMENTS	1.31 PLUMBING RISER DIAGRAMS
4.10 AREA 7 - STORM DRAIN PLAN	NR10 NATURAL RESOURCE TRANSPLANT ENLARGEMENTS	1.32 PLUMBING RISER DIAGRAMS
4.11 STORM DRAIN PROFILES - LINES A-1, A-2, A-3, A-4, DS-A31, AD, DS-B30A, DS-B30B, DS-OUT1 & DS-BB1	NR11 NATURAL RESOURCE TRANSPLANT ENLARGEMENTS	1.33 PLUMBING RISER DIAGRAMS
4.12 STORM DRAIN PROFILES - LINES DB, ED, EF, DS-OUT2, D-1, D-2, D-3 & D-4	NR12 NATURAL RESOURCES PROTECTION/RELOCATION/ENHANCEMENT PLAN	1.34 PLUMBING RISER DIAGRAMS
4.13 STORM DRAIN PROFILES - LINES E-1, E-2, E-3 & E-4	NR13 NATURAL RESOURCES PROTECTION/RELOCATION/ENHANCEMENT PLAN	1.35 PLUMBING RISER DIAGRAMS
4.14 STORM DRAIN DETAILS - SHEET 1 OF 4	NR14 NATURAL RESOURCES PROTECTION/RELOCATION/ENHANCEMENT PLAN	1.36 PLUMBING RISER DIAGRAMS
4.15 STORM DRAIN DETAILS - SHEET 2 OF 4	NR15 NATURAL RESOURCES PROTECTION/RELOCATION/ENHANCEMENT PLAN	1.37 PLUMBING RISER DIAGRAMS
4.16 STORM DRAIN DETAILS - SHEET 3 OF 4	NR16 NATURAL RESOURCES PROTECTION/RELOCATION/ENHANCEMENT PLAN	1.38 PLUMBING RISER DIAGRAMS
4.17 STORM DRAIN DETAILS - SHEET 4 OF 4	NR17 SOIL AND SEED PLAN	1.39 PLUMBING RISER DIAGRAMS
5. EROSION CONTROL	NR18 TYPICAL MASONRY WALL DETAILS & SCHEDULES	1.40 PLUMBING RISER DIAGRAMS
5.01 AREA 1 - EROSION & SEDIMENTATION CONTROL PLAN	NR19 IRRIGATION PLAN	1.41 PLUMBING RISER DIAGRAMS
5.02 AREA 2 - EROSION & SEDIMENTATION CONTROL PLAN	NR20 IRRIGATION PLAN	1.42 PLUMBING RISER DIAGRAMS
5.03 AREA 3 - EROSION & SEDIMENTATION CONTROL PLAN	NR21 IRRIGATION PLAN	1.43 PLUMBING RISER DIAGRAMS
5.04 AREA 4 - EROSION & SEDIMENTATION CONTROL PLAN	NR22 IRRIGATION PLAN	1.44 PLUMBING RISER DIAGRAMS
5.05 AREA 5 - EROSION & SEDIMENTATION CONTROL PLAN	NR23 LANDSCAPE IRRIGATION DETAILS	1.45 PLUMBING RISER DIAGRAMS
5.06 AREA 6 - EROSION & SEDIMENTATION CONTROL PLAN		1.46 PLUMBING RISER DIAGRAMS
5.07 AREA 7 - EROSION & SEDIMENTATION CONTROL PLAN		1.47 PLUMBING RISER DIAGRAMS
5.08 OVERALL - DEWATERING PLAN		1.48 PLUMBING RISER DIAGRAMS
6. PAVING	10. TRAFFIC CONTROL	1.49 PLUMBING RISER DIAGRAMS
6.01 OVERALL - PAVING PLAN	T-1 KEY SHEET	1.50 PLUMBING RISER DIAGRAMS
6.02 OVERALL - ALTERNATE PAVING PLAN	T-2 GENERAL NOTES / TABULATION OF QUANTITIES	1.51 PLUMBING RISER DIAGRAMS
	T-3 SIGNALIZATION PLAN SHEET	1.52 PLUMBING RISER DIAGRAMS
	T-4 MOST SIGN DETAILS (1 OF 2)	1.53 PLUMBING RISER DIAGRAMS
	T-5 MOST SIGN DETAILS (2 OF 2)	1.54 PLUMBING RISER DIAGRAMS
7. SITE IMPROVEMENTS		1.55 PLUMBING RISER DIAGRAMS
7.01 SITE IMPROVEMENT DETAILS - SHEET 1 OF 4		1.56 PLUMBING RISER DIAGRAMS
7.02 SITE IMPROVEMENT DETAILS - SHEET 2 OF 4		1.57 PLUMBING RISER DIAGRAMS
7.03 SITE IMPROVEMENT DETAILS - SHEET 3 OF 4		1.58 PLUMBING RISER DIAGRAMS
7.04 SITE IMPROVEMENT DETAILS - SHEET 4 OF 4		1.59 PLUMBING RISER DIAGRAMS

**PROJECT RECORD**  
Job #670

**ADDENDUM D**  
JULY 03, 2003

Date: 6-16-04  
Regional Distribution Center #7038  
FL Pierce, Florida Job #670  
Centex Engineering & Construction  
Telephone: (954) 585-4000  
7901 SW 6th Court  
Plantation, Florida 33324  
This plan, with its as-built notations, accurately reflects the completed work.  
M. William Roach, Senior Project Manager


AMERICAN ENGINEERING & SURVEYING, INC.  
1000 W. 10TH STREET  
FORT WORTH, TEXAS 76102

CARTER & BURGESS, INC.  
777 MAIN STREET  
FORT WORTH, TEXAS 76102

Professional Engineer  
No. 33111  
7/3/03


# Overall Temp Facility Plan Fort Pierce 7038

1. DEMOLITION INCLUDES BUT IS NOT LIMITED TO: ALL DEMOLITION SHALL BE CARRIED OUT IN STRICT ACCORDANCE WITH REGULATIONS.
2. THE CONTRACTOR SHALL FIELD VERIFY THE TYPE OF DEMOLITION. THE WORK INCLUDES BUT IS NOT LIMITED TO: THE DEMOLITION AND REMOVAL OF WALLS, DOORS, FIXTURES, PLUMBING, PAINT, MECHANICAL AND ELECTRICAL ITEMS INCLUDING CONDUITS AND DUCTWORK AS SHOWN ON OR AS REQUIRED FOR THE INSTALLATION OF NEW WORK FOR A COMPLETE JOB.
3. WHEN UTILITIES ARE REMOVED, CAP AND MINIMUM OF 8" BELOW FINISH FLOOR OR 6" OF 6" ABOVE FINISH CEILING.
4. WHEN REMOVING EXISTING STRUCTURAL THE CONTRACTOR'S RESPONSIBILITY TO PROVIDE ADEQUATE SHORING, BRACING AND SUPPORT SYSTEMS TO KEEP THE EXISTING STRUCTURE AND IN A SAFE CONDITION. REFER TO SECS 02025 AND 02251.
5. NOTES INDICATING DEMOLITION WORK ARE CONFINED SOLELY TO THE DEMOLITION PLAN. GENERAL CONTRACTOR SHALL REVIEW ALL CONSTRUCTION DOCUMENTS, INCLUDING SCHEDULES AND SPECIFICATIONS, TO DETERMINE FULL EXTENT OF DEMOLITION WORK.
6. REFER TO EXTERIOR DEMOLITION ELEVATIONS FOR ADDITIONAL INFORMATION.
7. CONTRACTOR SHALL FIELD VERIFY LOCATE HORIZONTAL GIRTS, TYP.
8. GC IS TO ENSURE THE EXISTING PAVING REMAINS IN OPERATIONAL CONDITION DURING ENTIRE DURATION OF CONSTRUCTION. THE CONTRACTOR SHALL COORDINATE REPAIR / REPLACEMENT OF PAVING OR EQUIPMENT THAT IS DAMAGED BY CONSTRUCTION WITH THE CONTRACTOR AND THE ON-SITE MAINTENANCE MANAGER IMMEDIATELY.

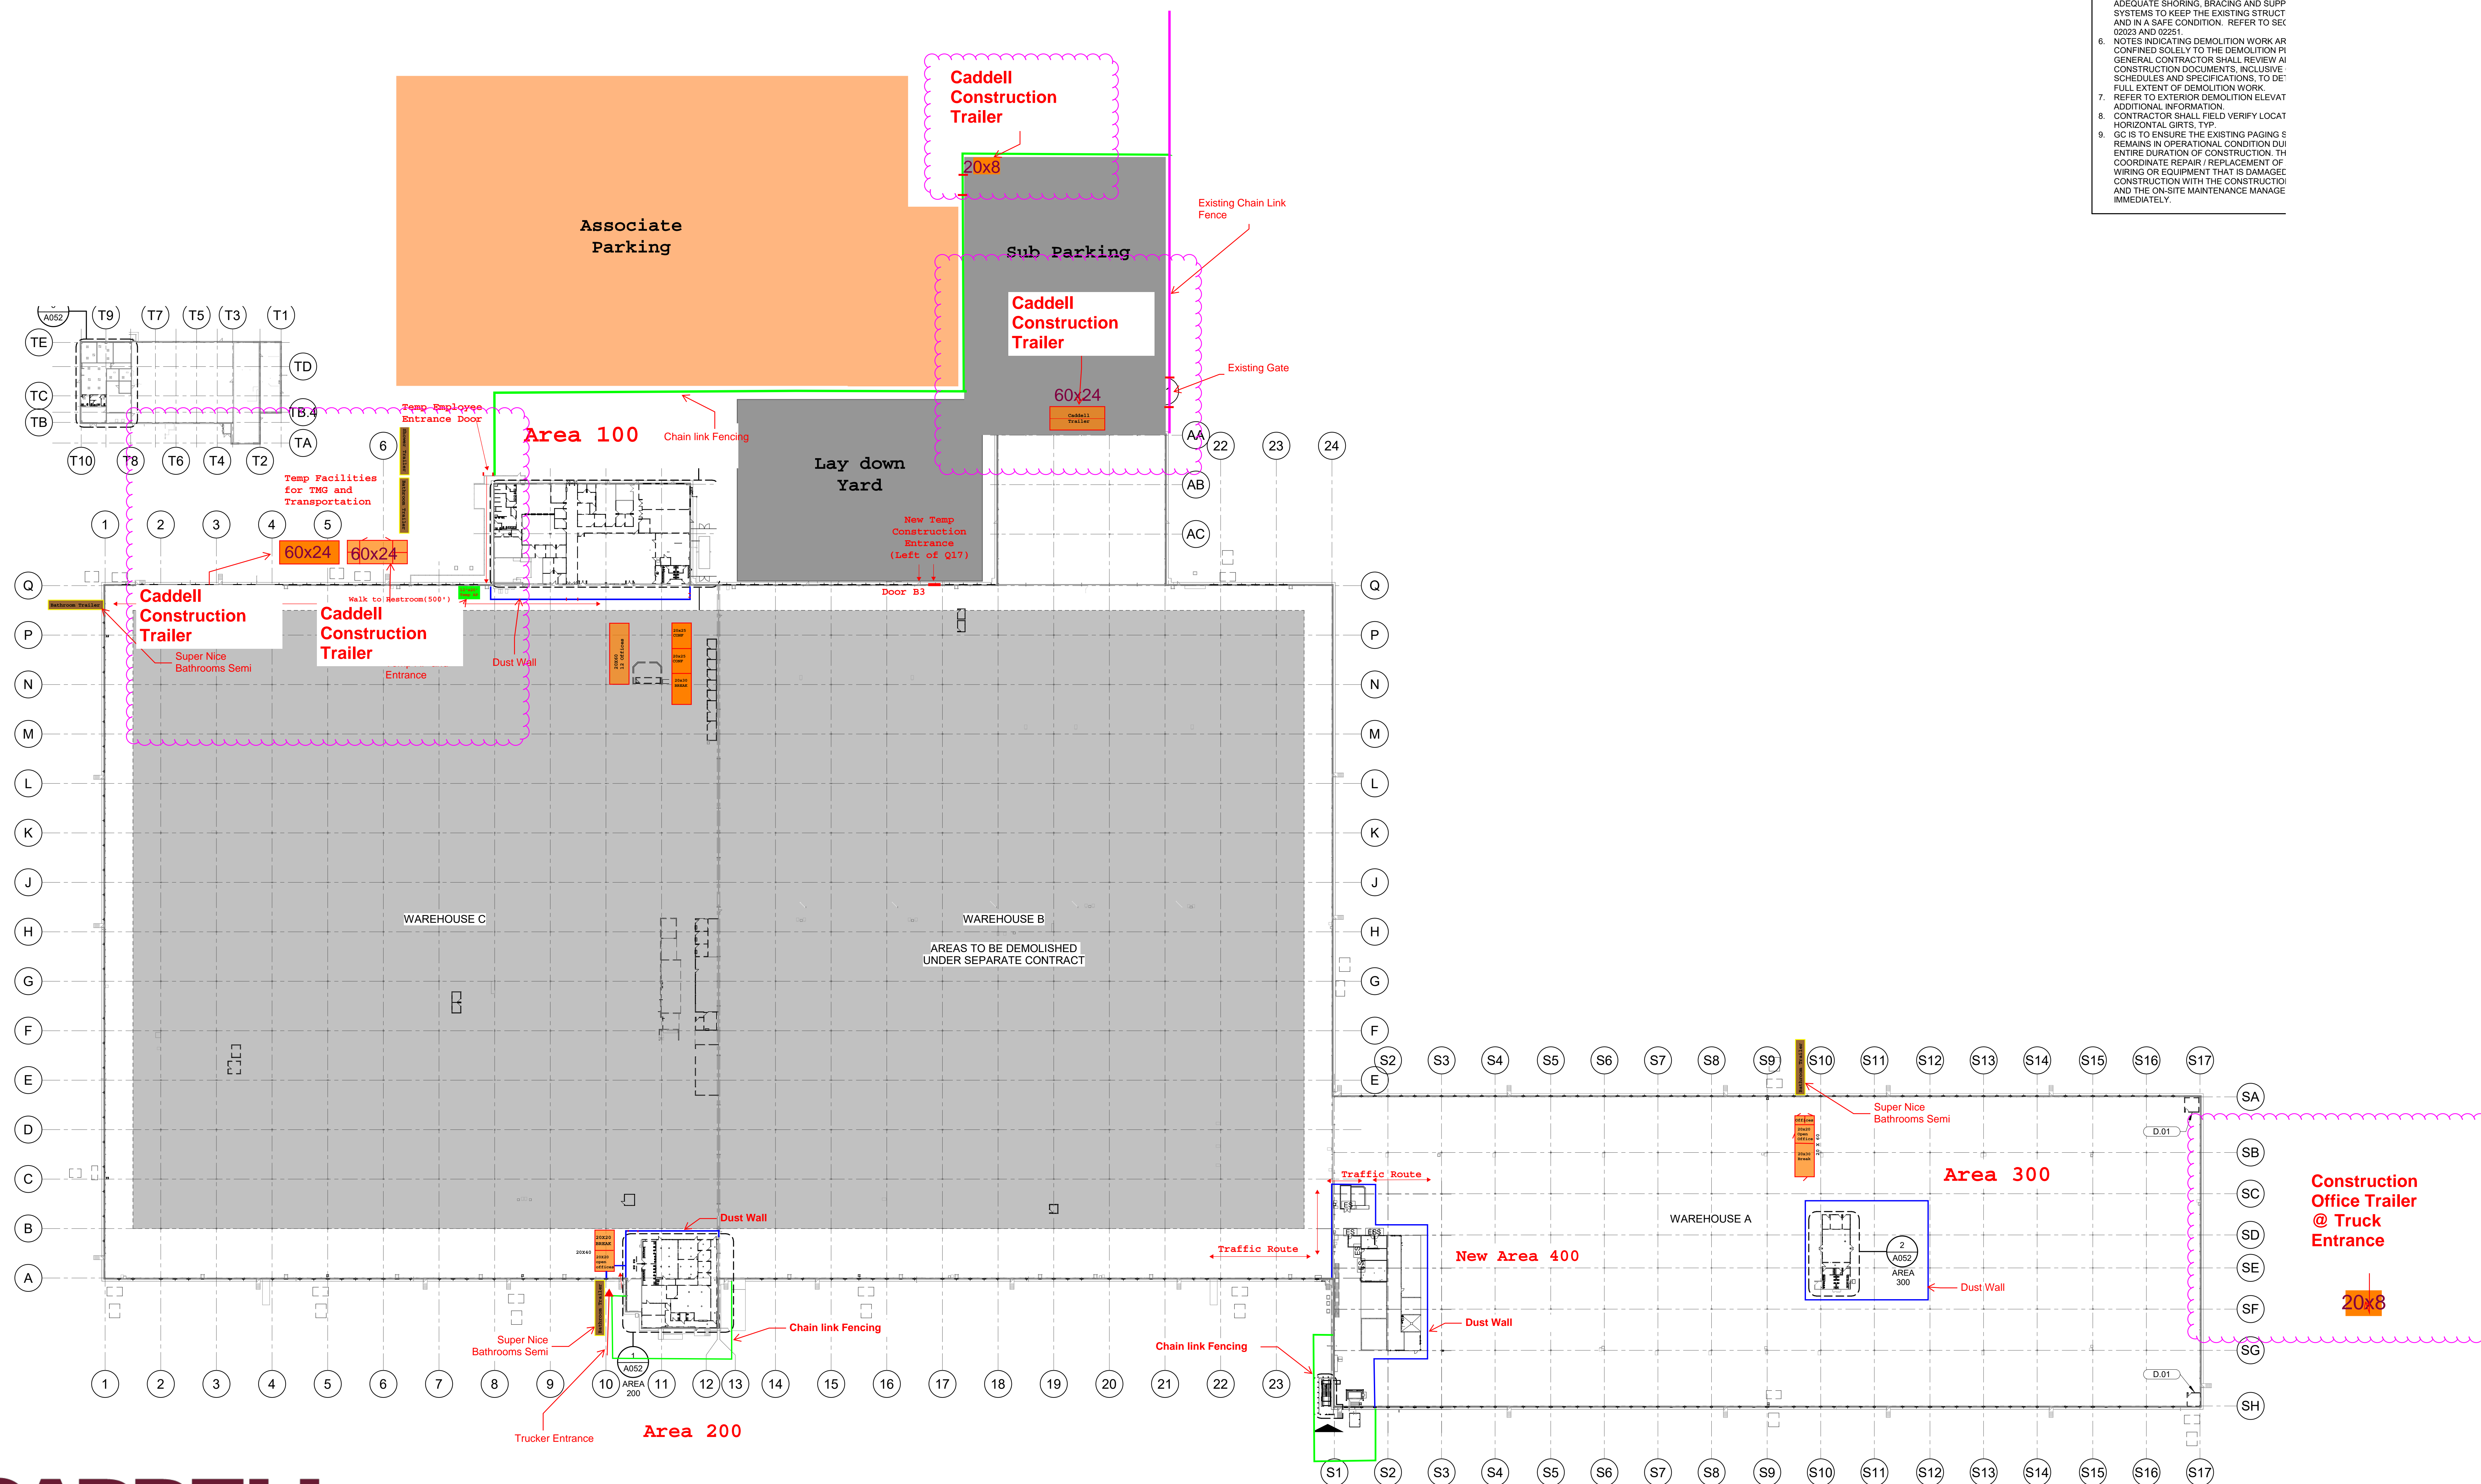






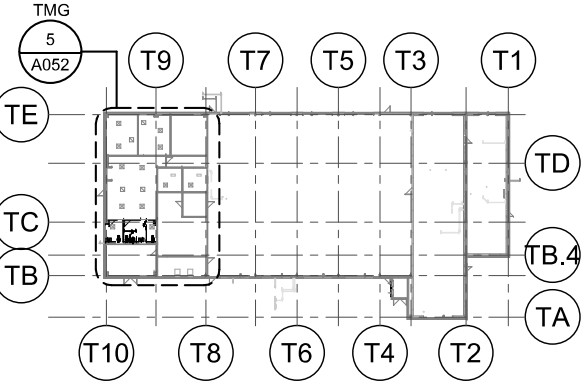

Temp Employee  
Entrance Door

Area 100

Chain link Fencing

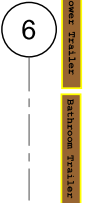

New Temp  
Construction  
Entrance  
(Left of Q17)


Door B3

Walk to Restroom (500')

Super Nice  
Bathrooms Semi

Temp AP and  
Entrance

Dust Wall

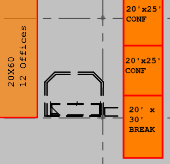

Q

P

N

M

1

2


3

4


5

Bathroom Trailer

# Area 100

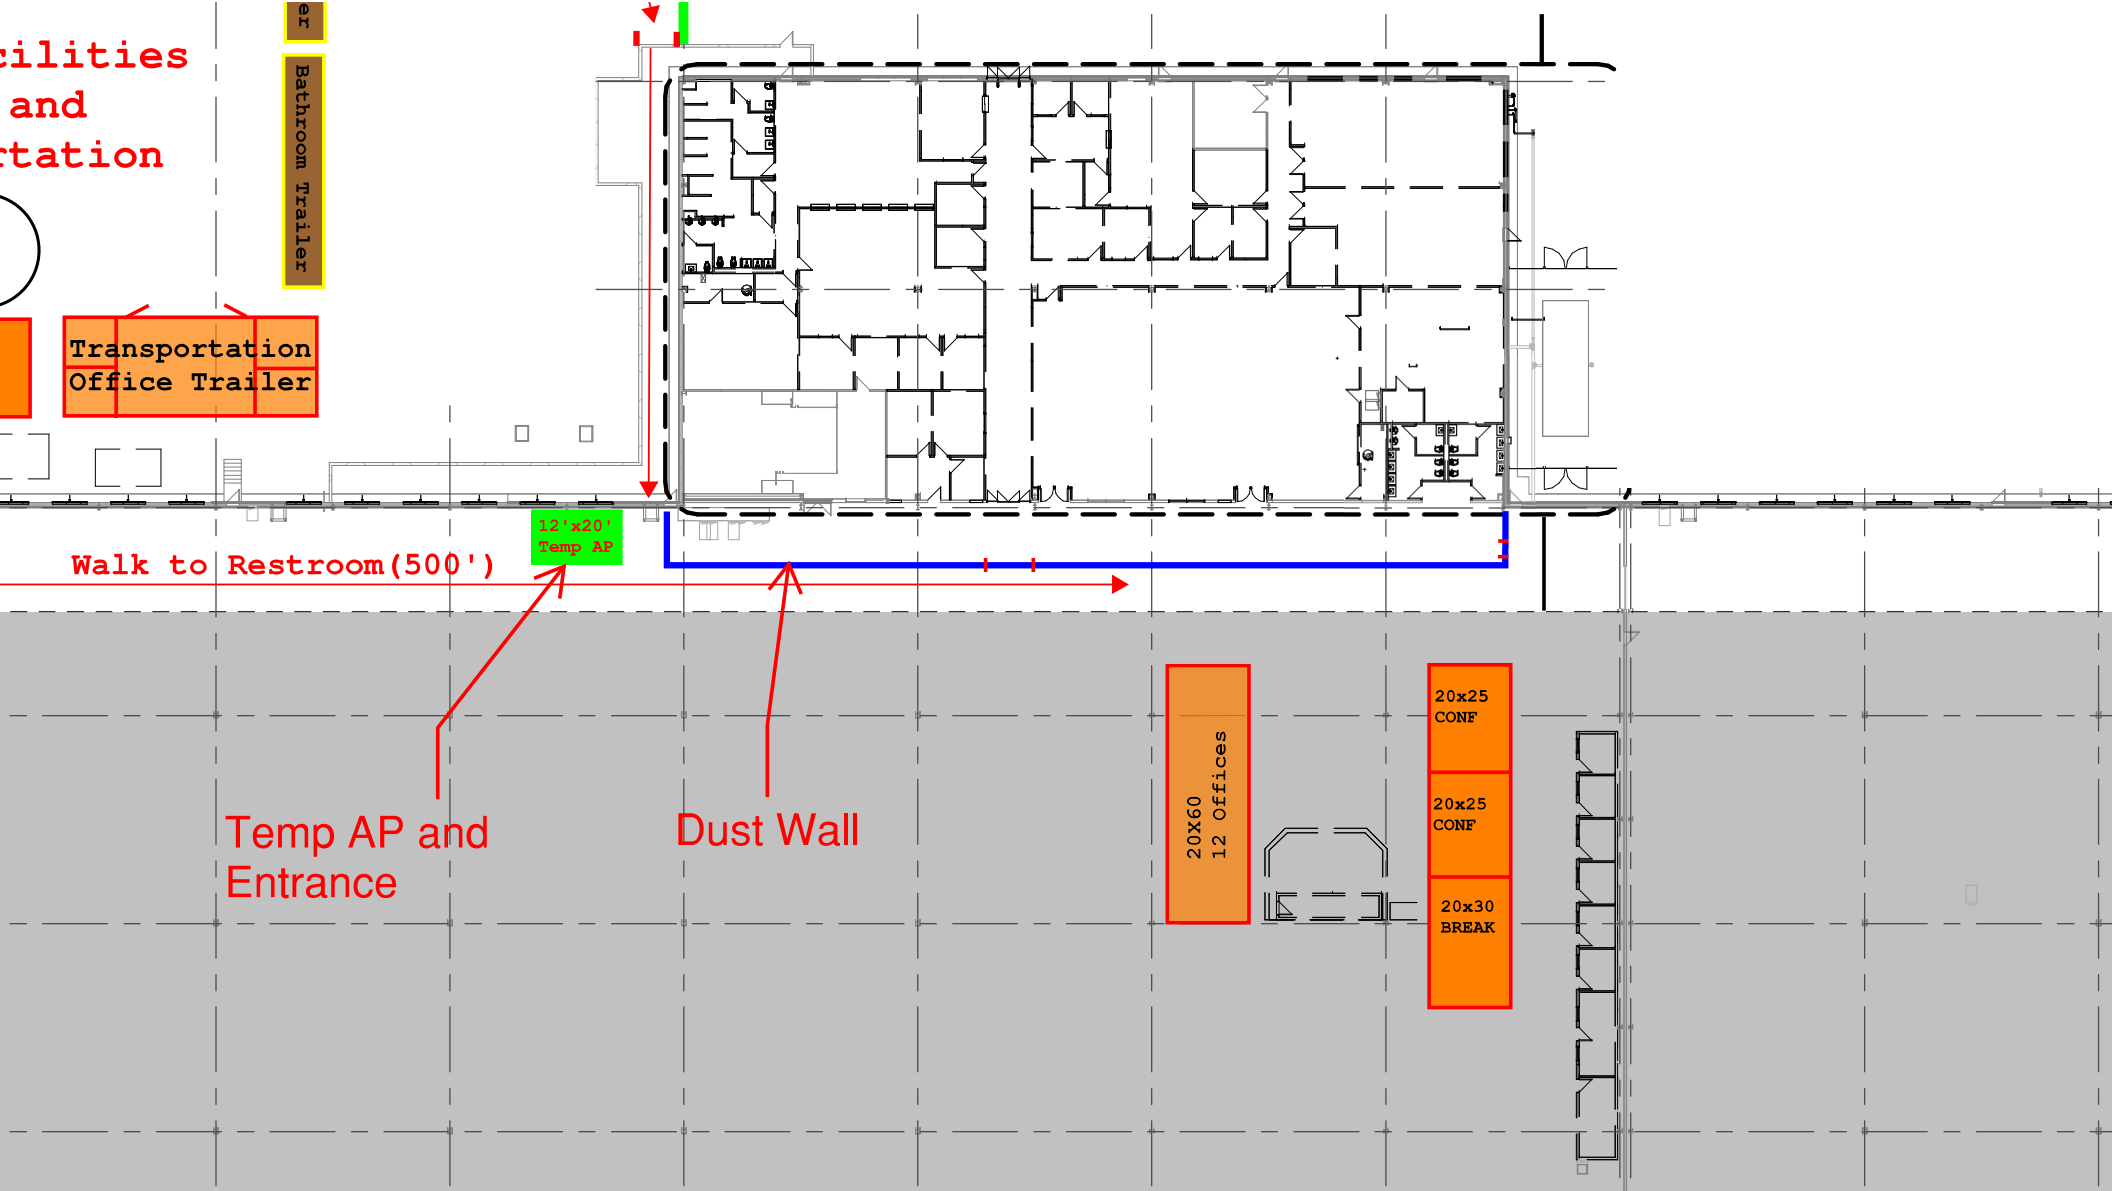

# TMG and Transportation Temp Facilities

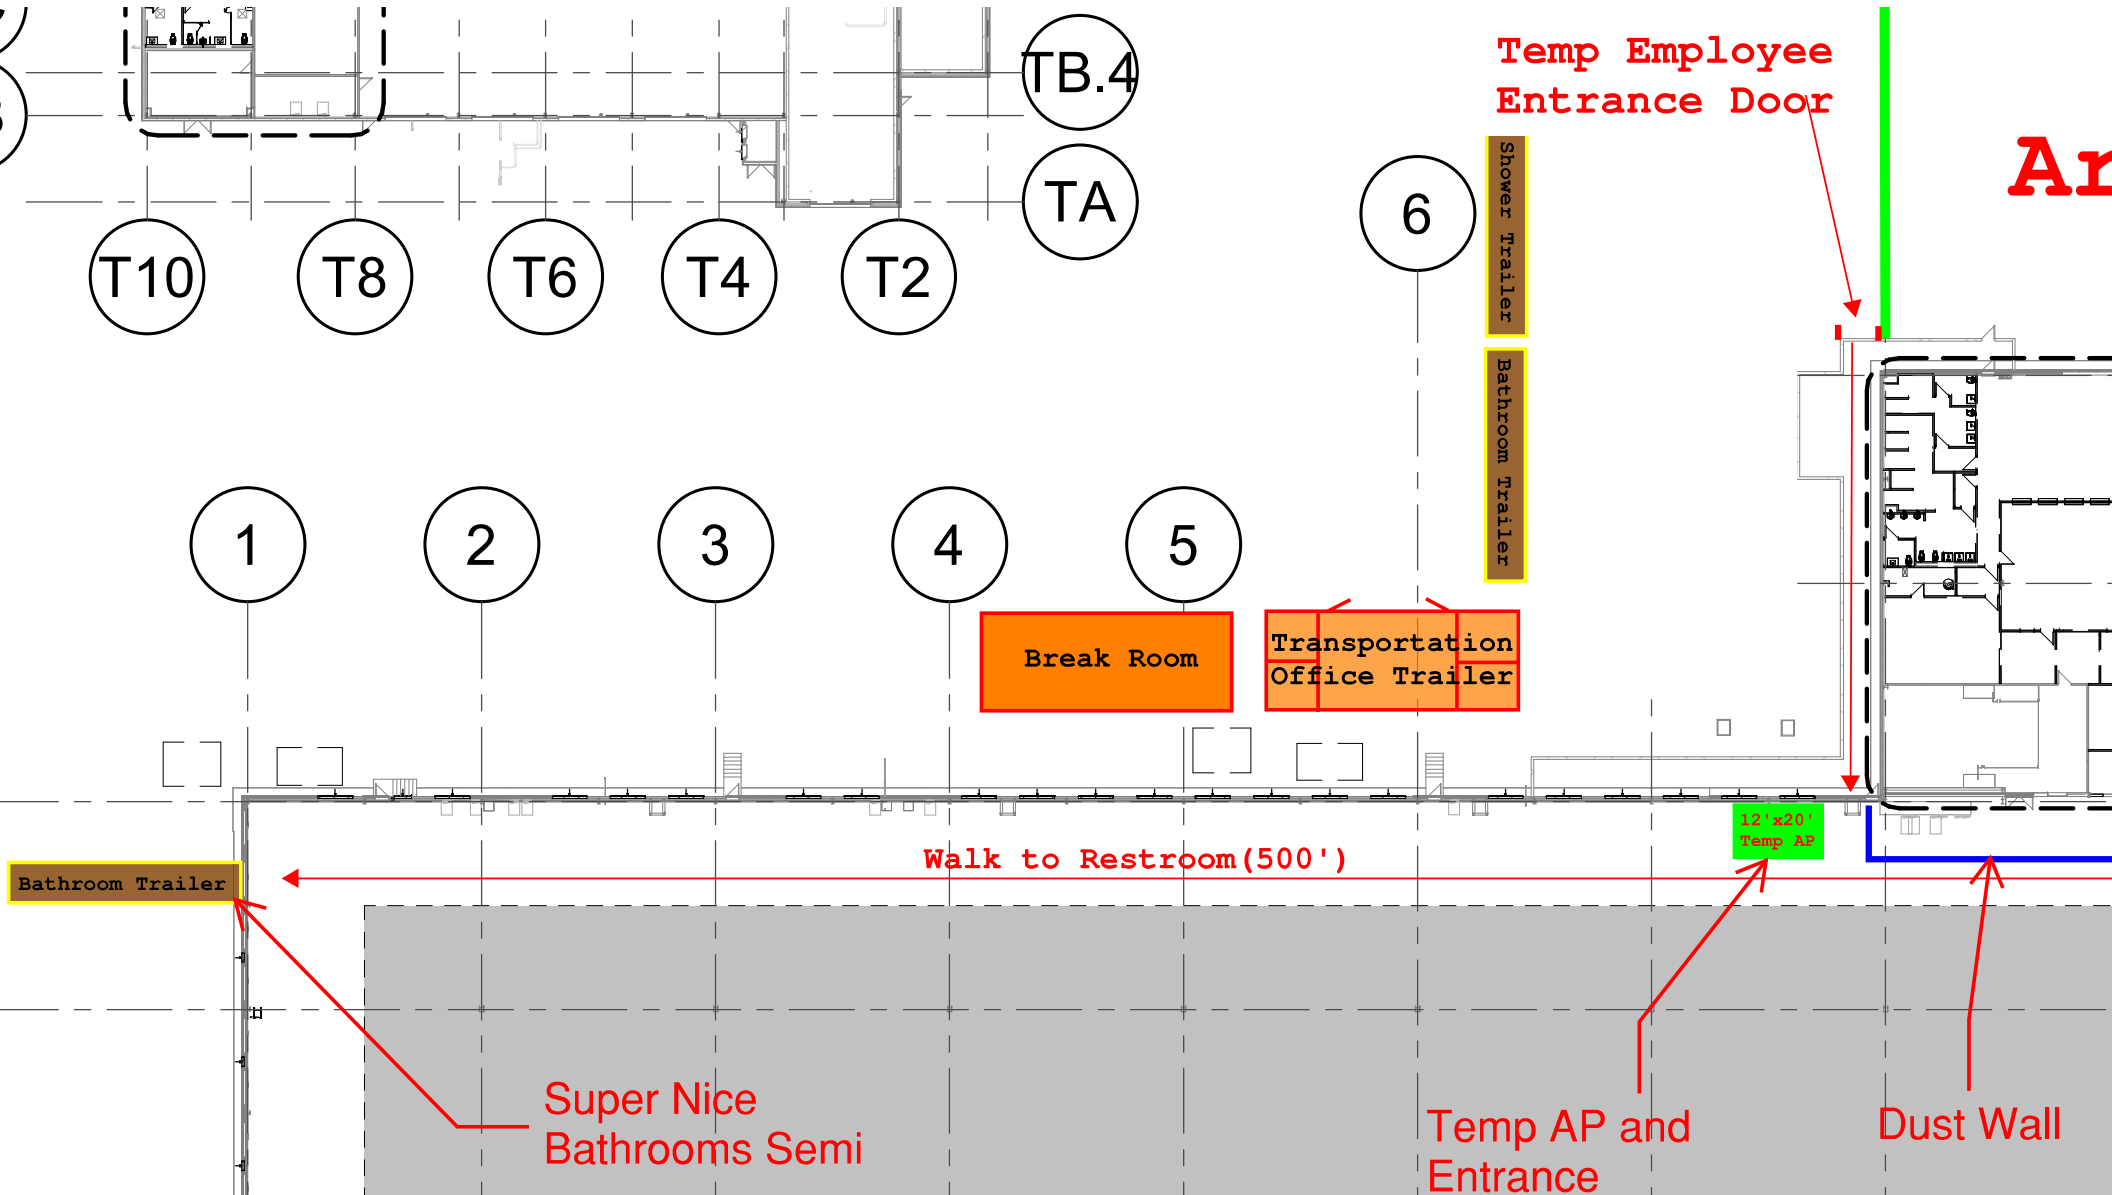

S6 S7 S8 S9 S10 S11 S12 S13 S14 S15 S16

Bathroom Trailer


Super Nice  
Bathrooms Semi

Offices  
20x20  
Open  
Office  
20x30  
Break  
20 X 60


D.01


**Area 300**


WAREHOUSE A

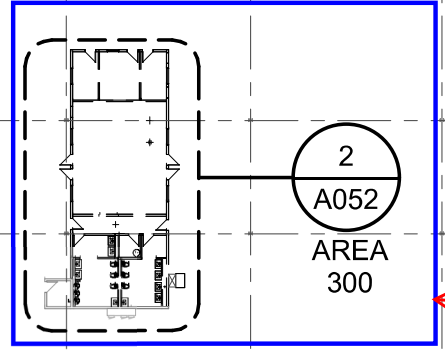

Dust Wall

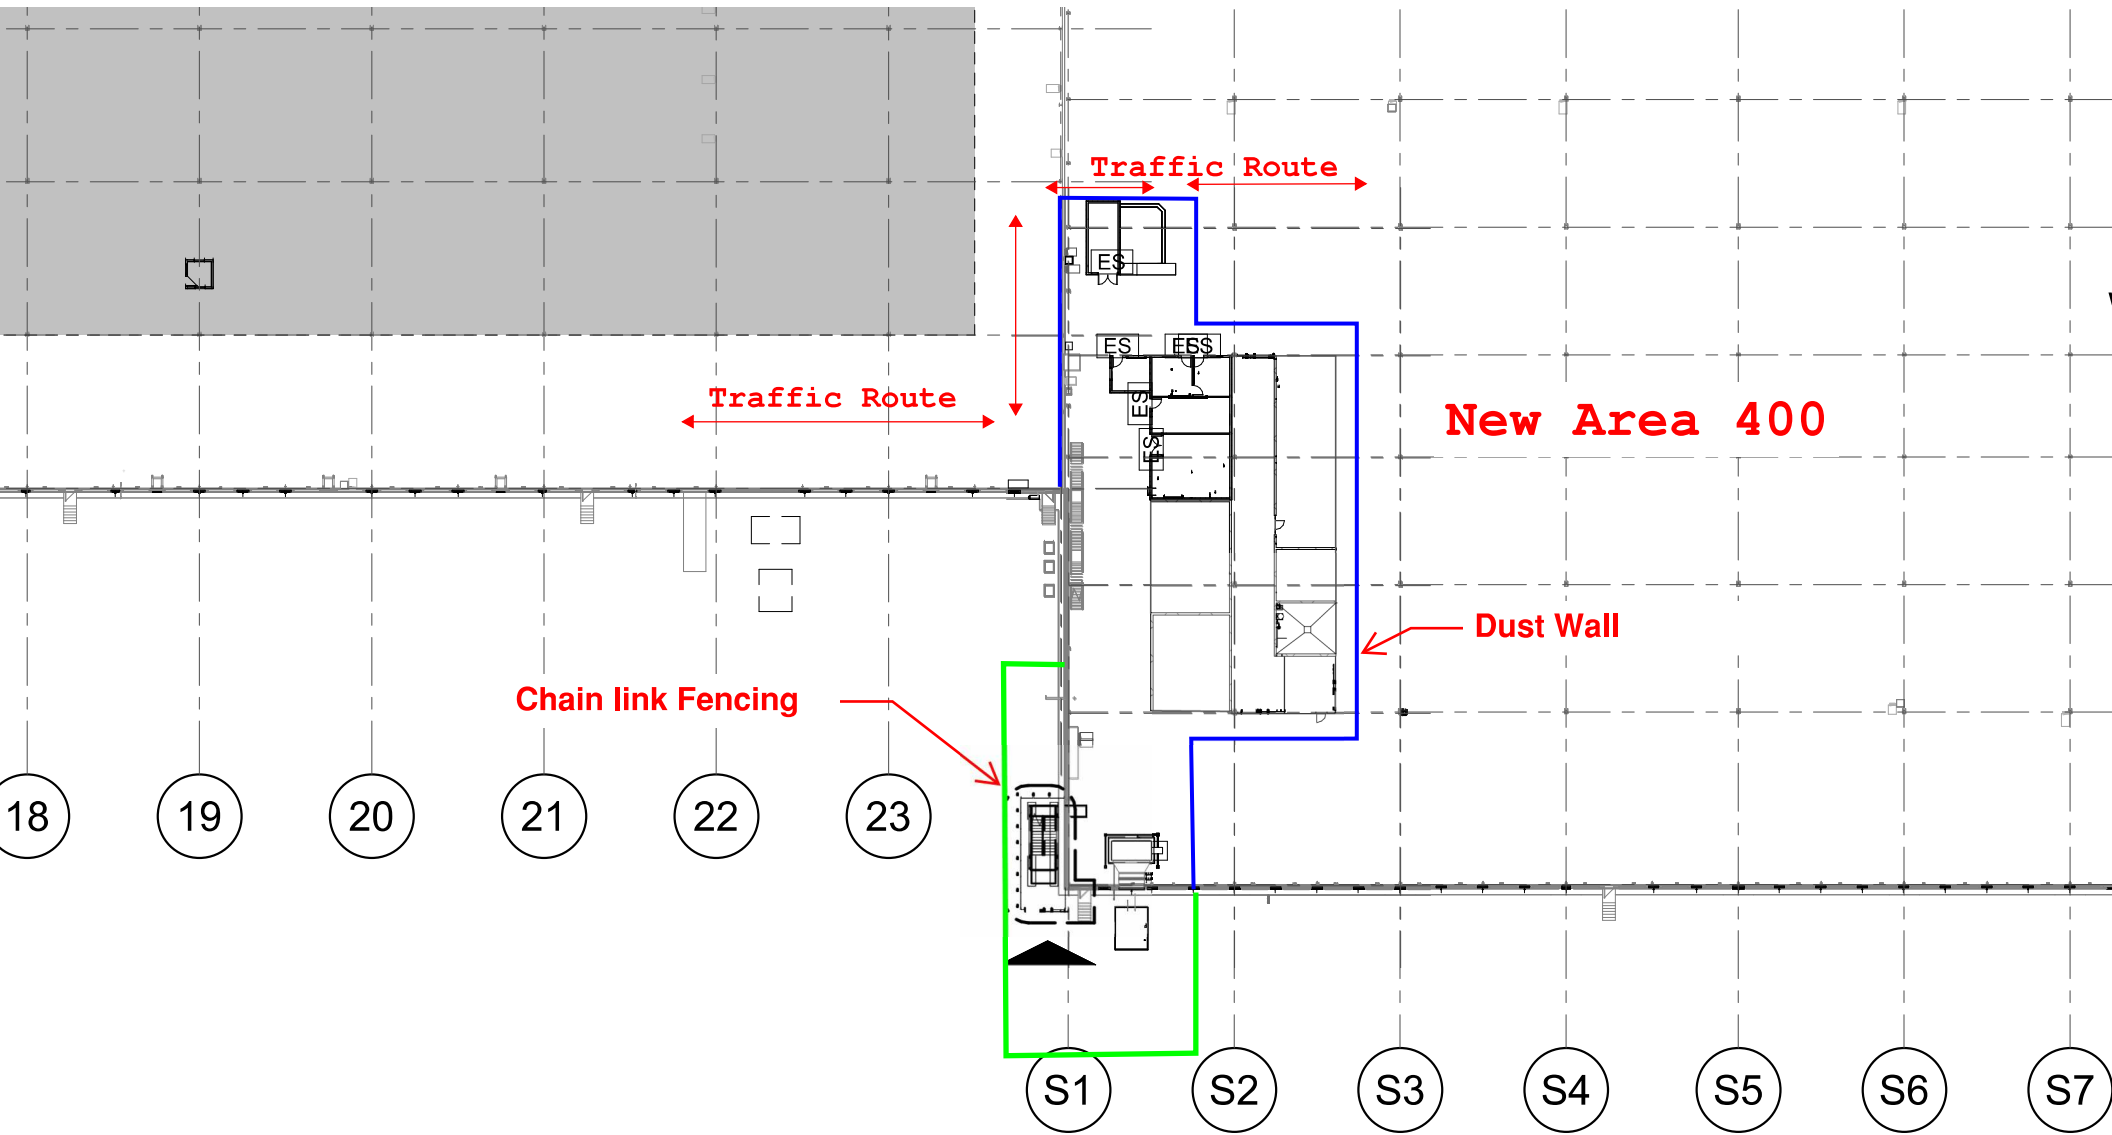


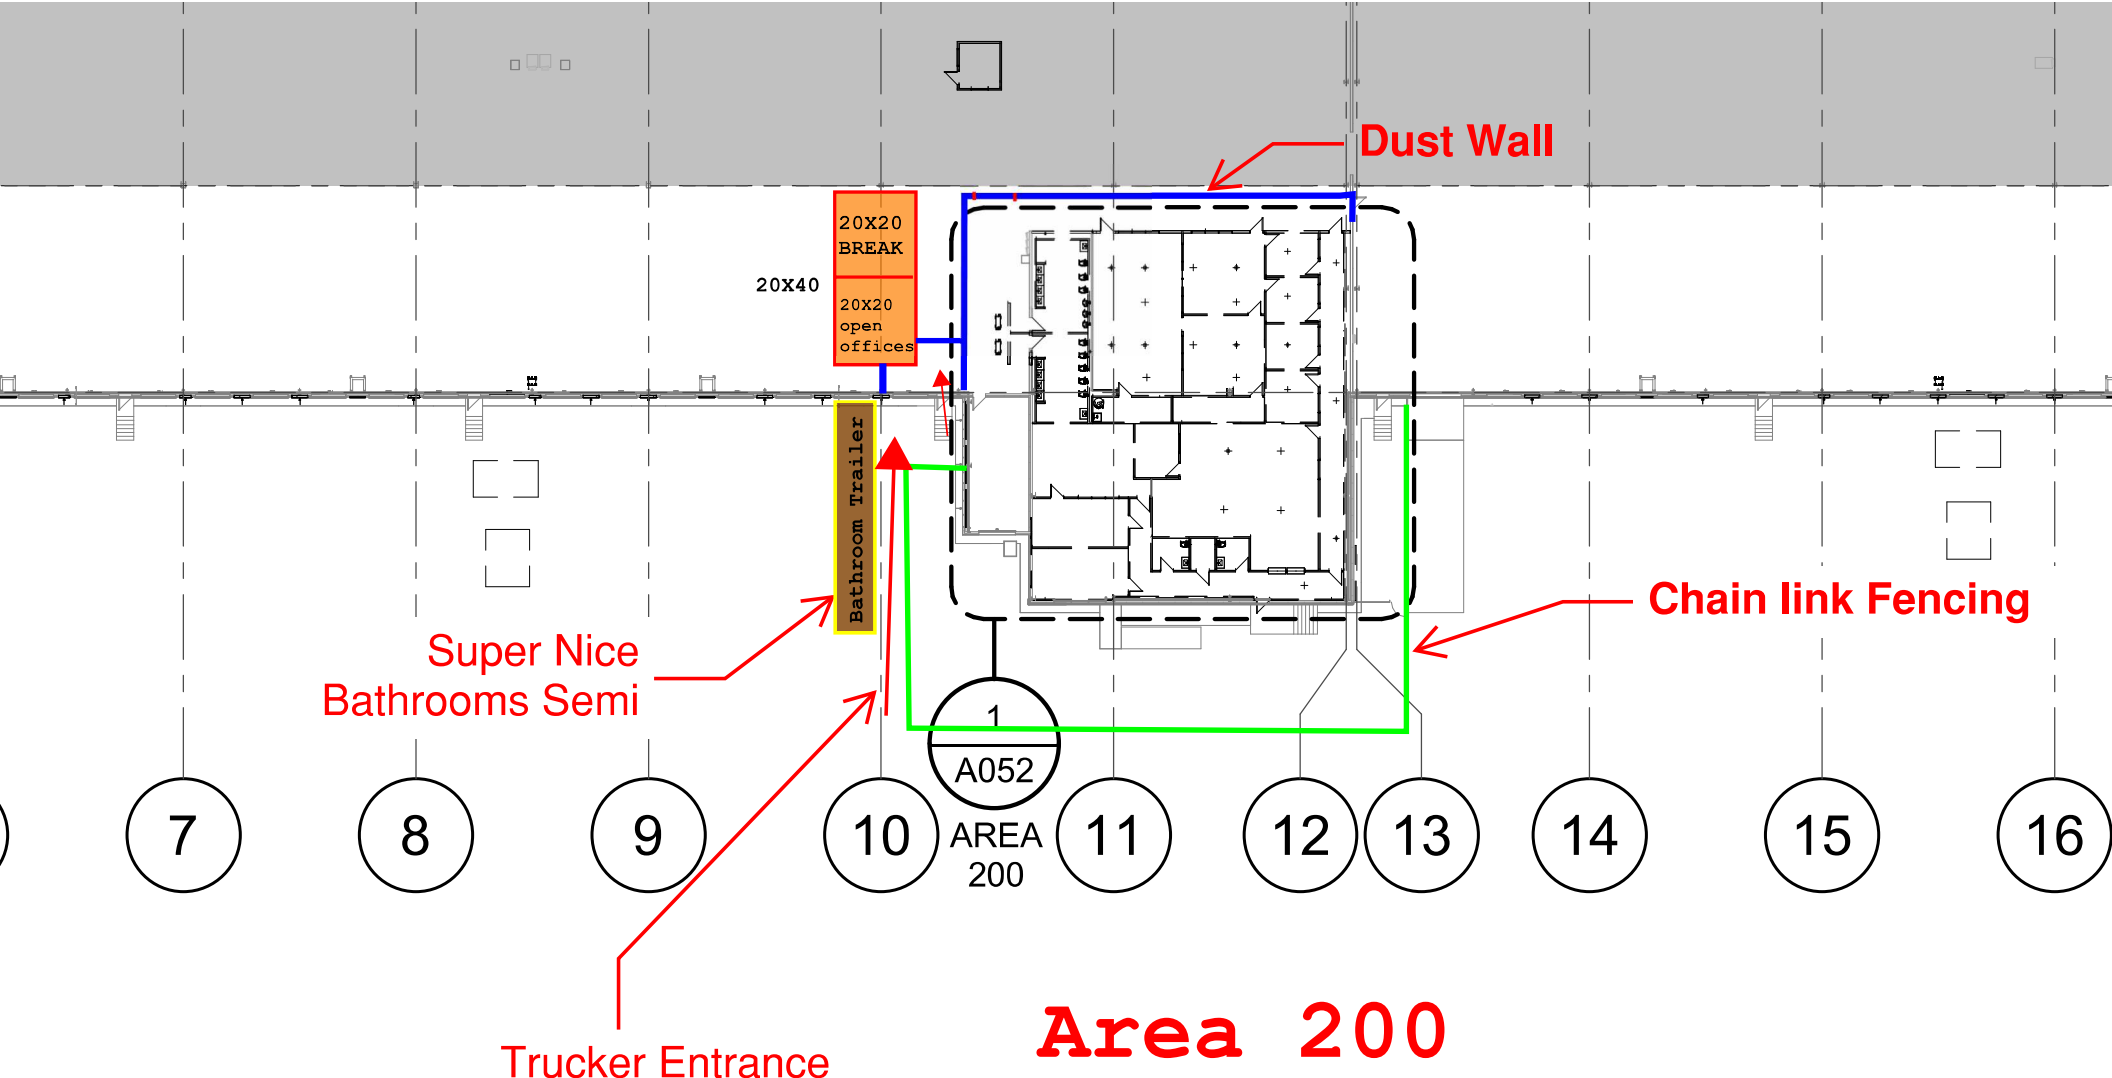

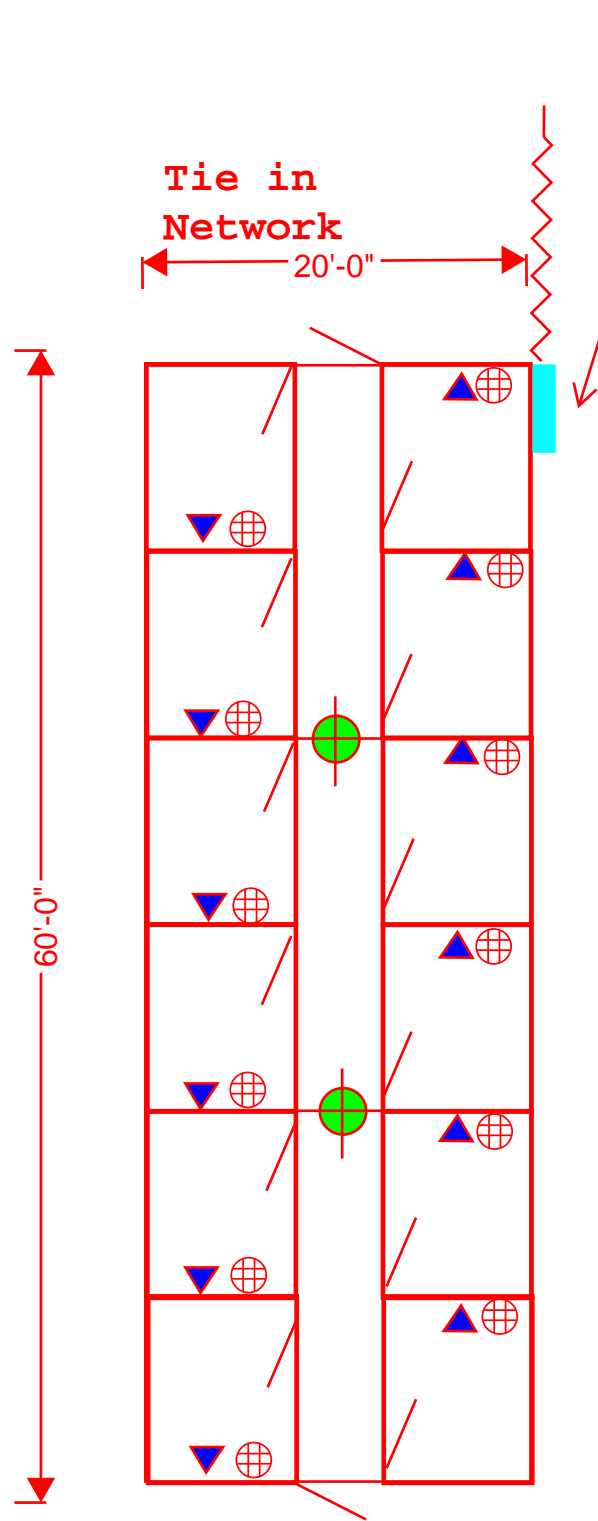


Area 100 Offices


Switch Panel  
(42) Port to  
Service All of  
Temp 100

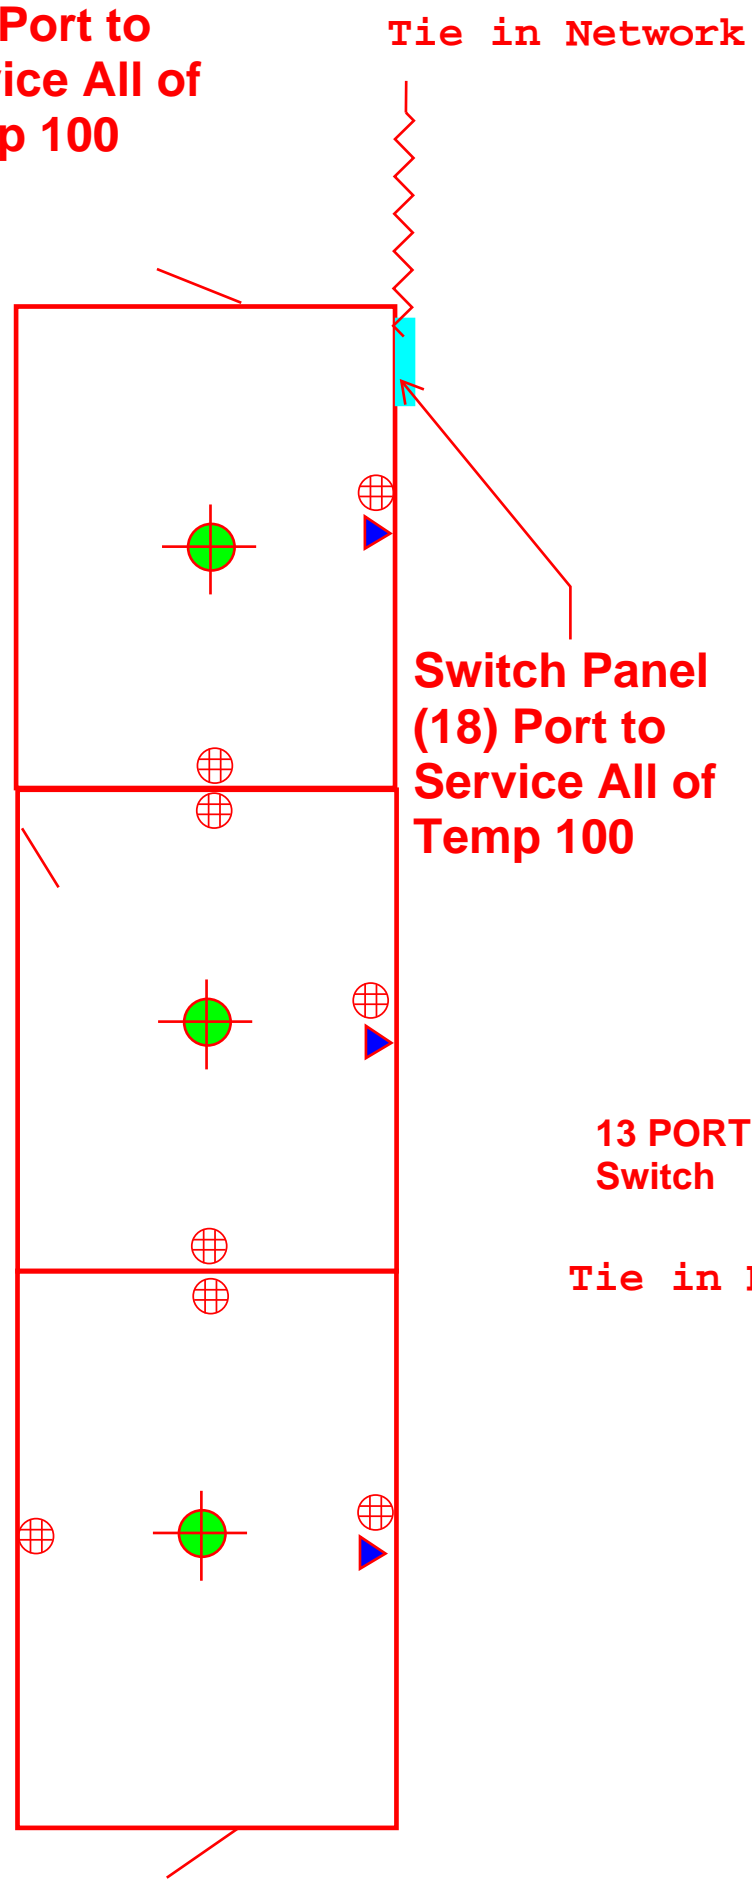

Switch Panel  
(18) Port to  
Service All of  
Temp 100


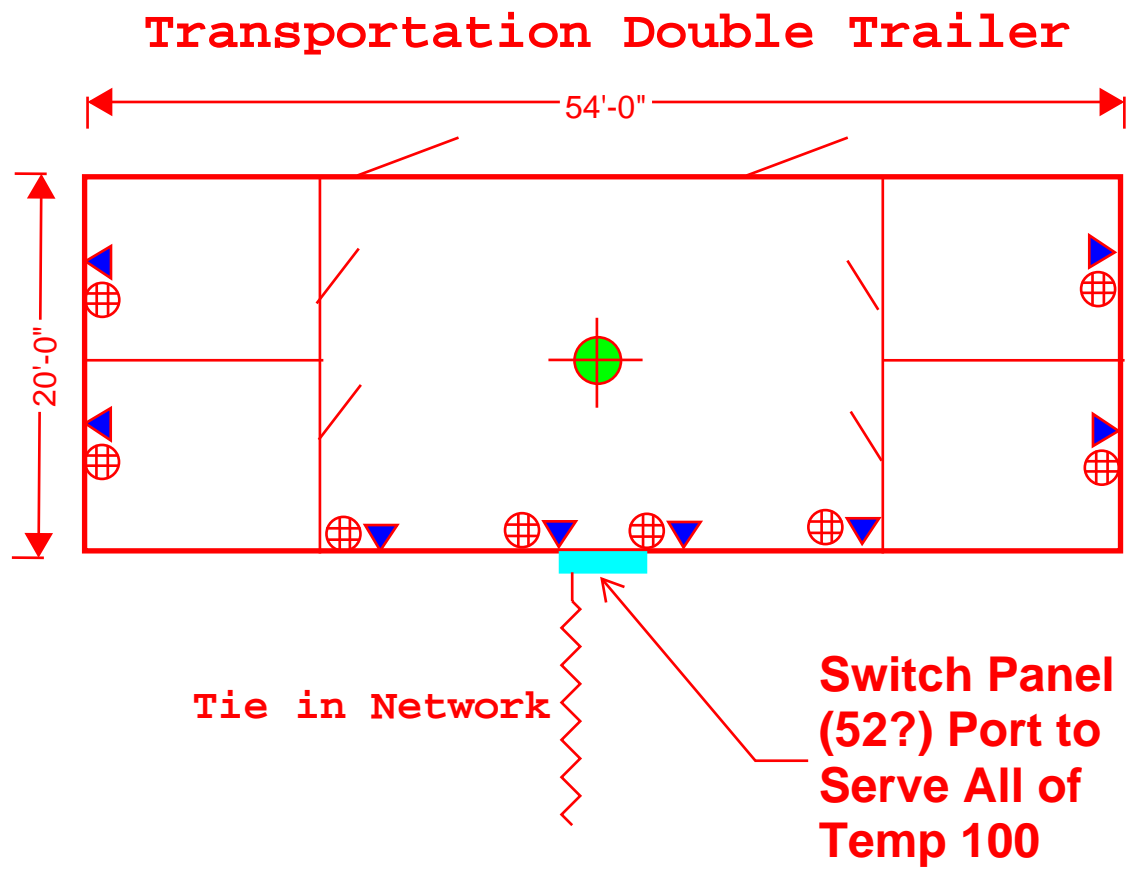


Switch Panel  
(52?) Port to  
Serve All of  
Temp 100

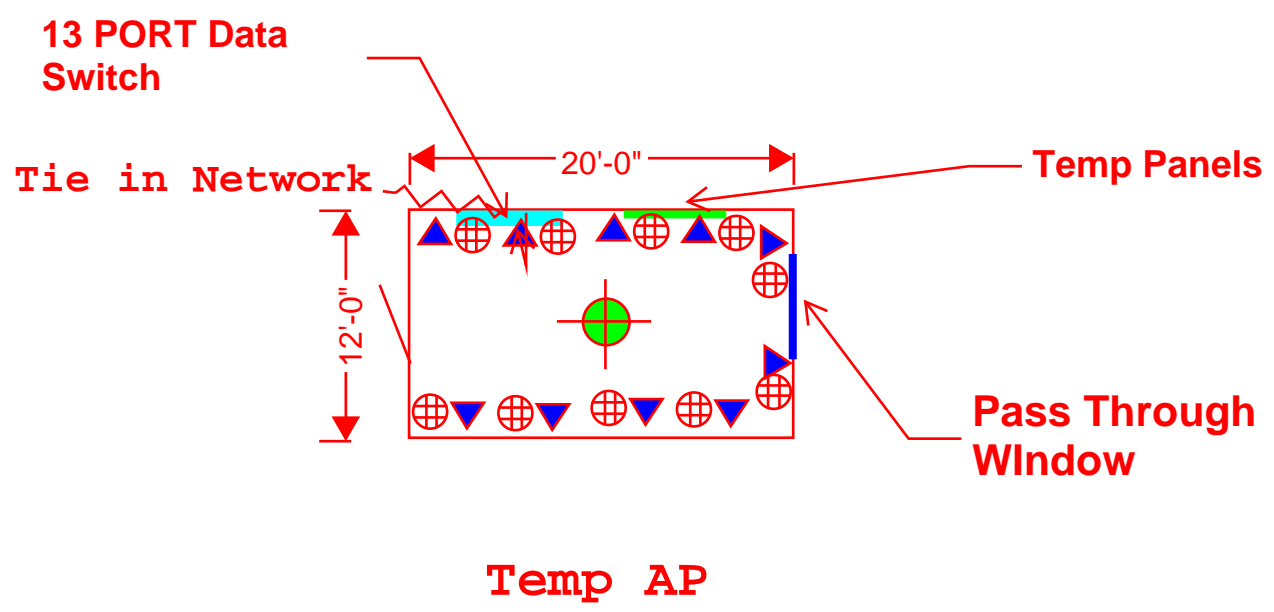

Temp AP



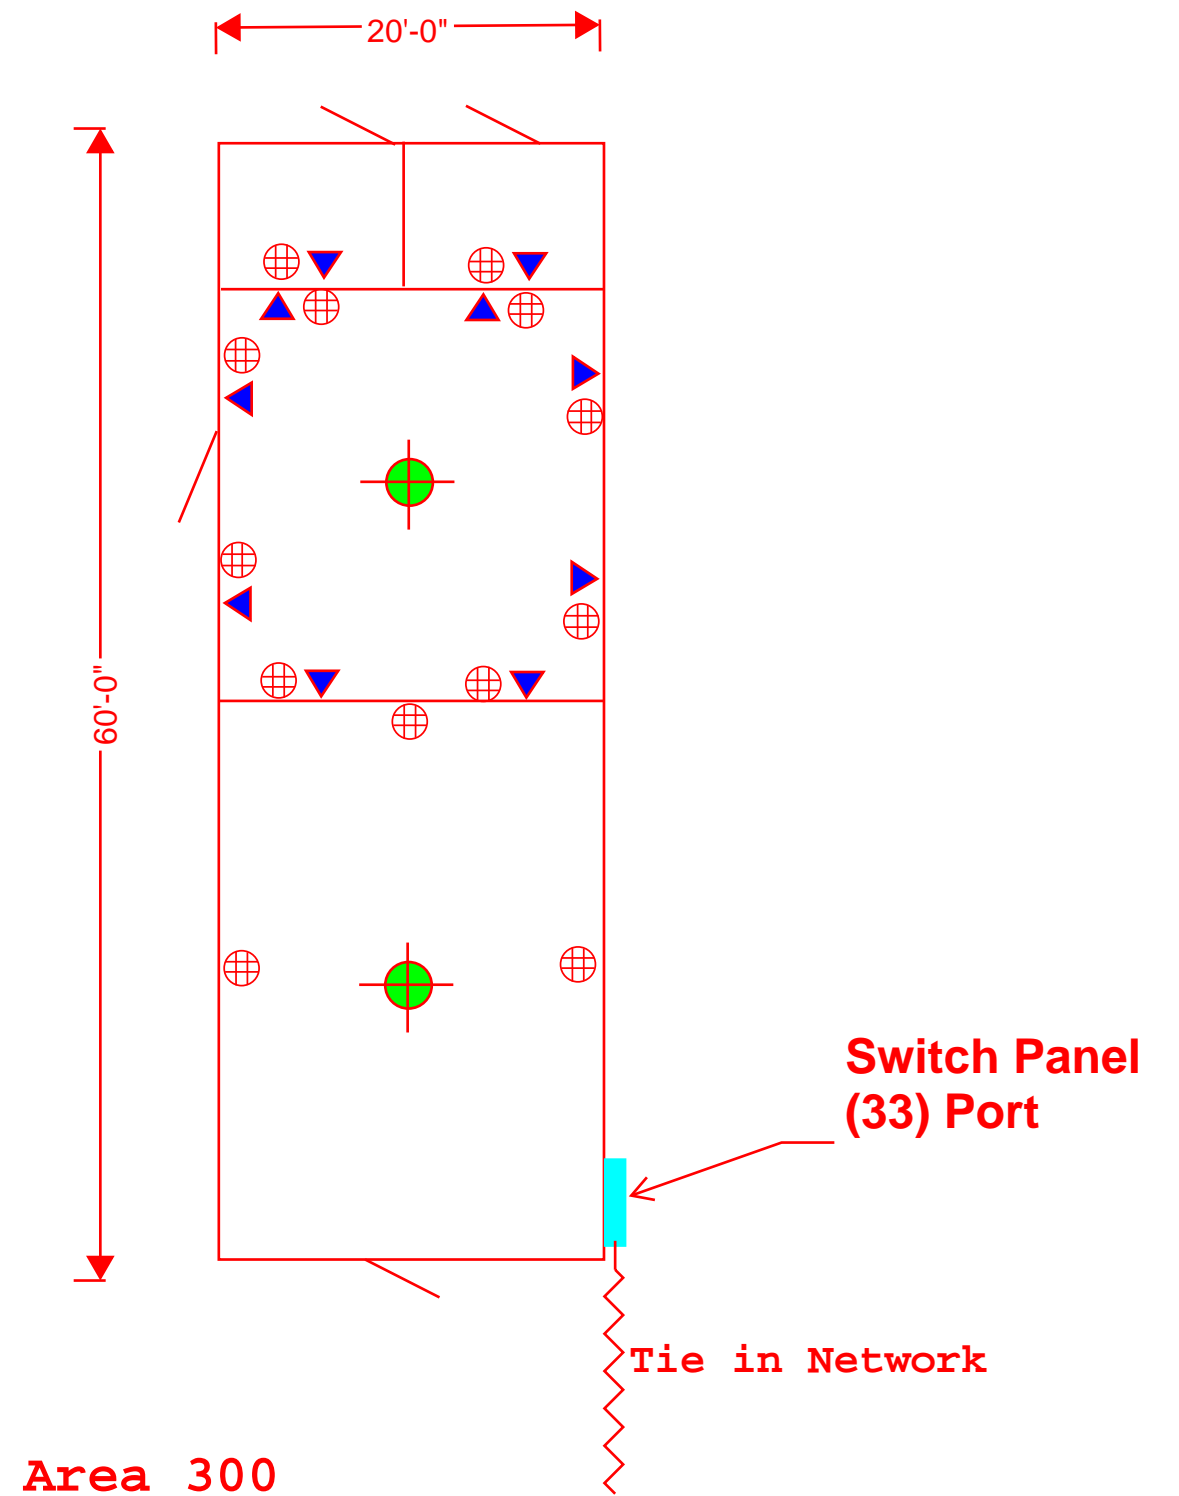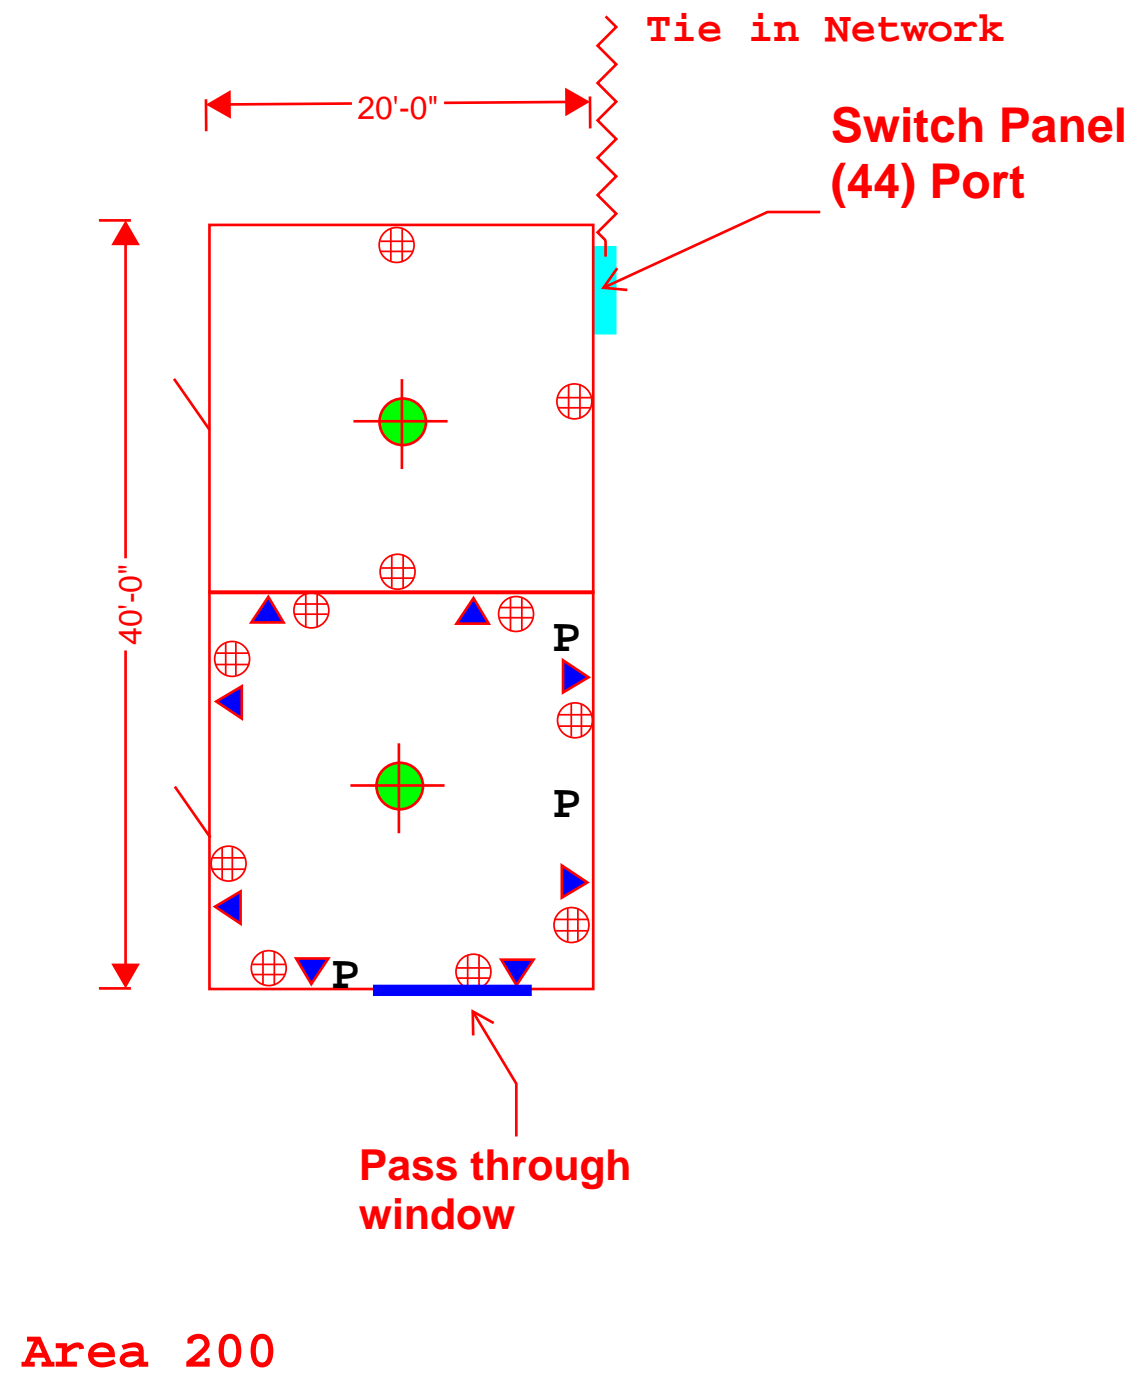

**Temp Equipment Needed:**

**Area 100**

(5) Wireless Hubs  
42-Port Switches  
18-Port Switch

**Area 200**

(2) Wireless Hubs  
44 Port Switch

**Area 300**

(2) Wireless Hubs  
33-Port Switch

**TMG/Transportation**

(1) Wireless Hubs  
52-Port Switches

**Temp AP**

(1) Wireless Hubs  
13-Port Switches

**Critical Dates:**

2/3/25 through 2/7/25 Temp equipment needs to be installed in all areas

2/28/24 through 3/28/25 Overhead rough in needs to be installed in all areas

5/5/25 through 6/18/25 Trim and devices need to be installed in all areas