







BENCH MARKS:

T.M. #1 I.R. & C. "LB2856"  
 N 21438.76  
 E 11064.83  
 ELEV. 15.49  
 N 21954.20  
 E 11064.83  
 ELEV. 15.49  
 T.M. #2 I.R. & C. "LB2856"  
 N 20769.76  
 E 13561.33  
 ELEV. 17.45  
 T.M. #3  
 DISK IN CONC., 195-Y-13  
 N 21368.53  
 E 9223.68  
 ELEV. 16.16  
 T.M. #4 I.R. & C. "LB2856"  
 N 19715.81  
 E 11738.97  
 ELEV. 15.20

NOTE: ALL ELEVATIONS ON PLANS ARE BASED AND MUST BE CONSTRUCTED ON NAVD 88 DATUM.  
 2. MVD 25 IS 1'-4" HIGHER THAN NAVD 88 DATUM.

PROJECT NO. 04-000000  
 SHEET NO. 04-000000  
 DATE 01/17/03  
 DRAWN BY J. BURTON  
 CHECKED BY J. BURTON  
 APPROVED BY J. BURTON

**WAL-MART**  
 REGIONAL DISTRIBUTION CENTER NO. 7038  
 FORT PIERCE, FLORIDA

AREA 3 - UTILITY PLAN





**Carter-Burgess**  
 Civil Engineering & Construction  
 777 West State Street, Suite 2000  
 Fort Pierce, Florida 34949  
 Phone: (888) 565-4000  
 Fax: (888) 565-4001  
 Website: www.carter-burgess.com

SHEET  
**C8.13**

# PROJECT RECORD

Job #070

Date: 6-16-04  
 Regional Distribution Center #7038  
 Ft. Pierce, Florida Job #070  
 Carter Engineering & Construction  
 Telephone: (888) 565-4000  
 7801 SW 8th Court  
 Ft. Pierce, Florida 34974  
 This plan, with the re-built notations, accurately reflects the completed work.  
 M. William Roebuck, Senior Project Manager

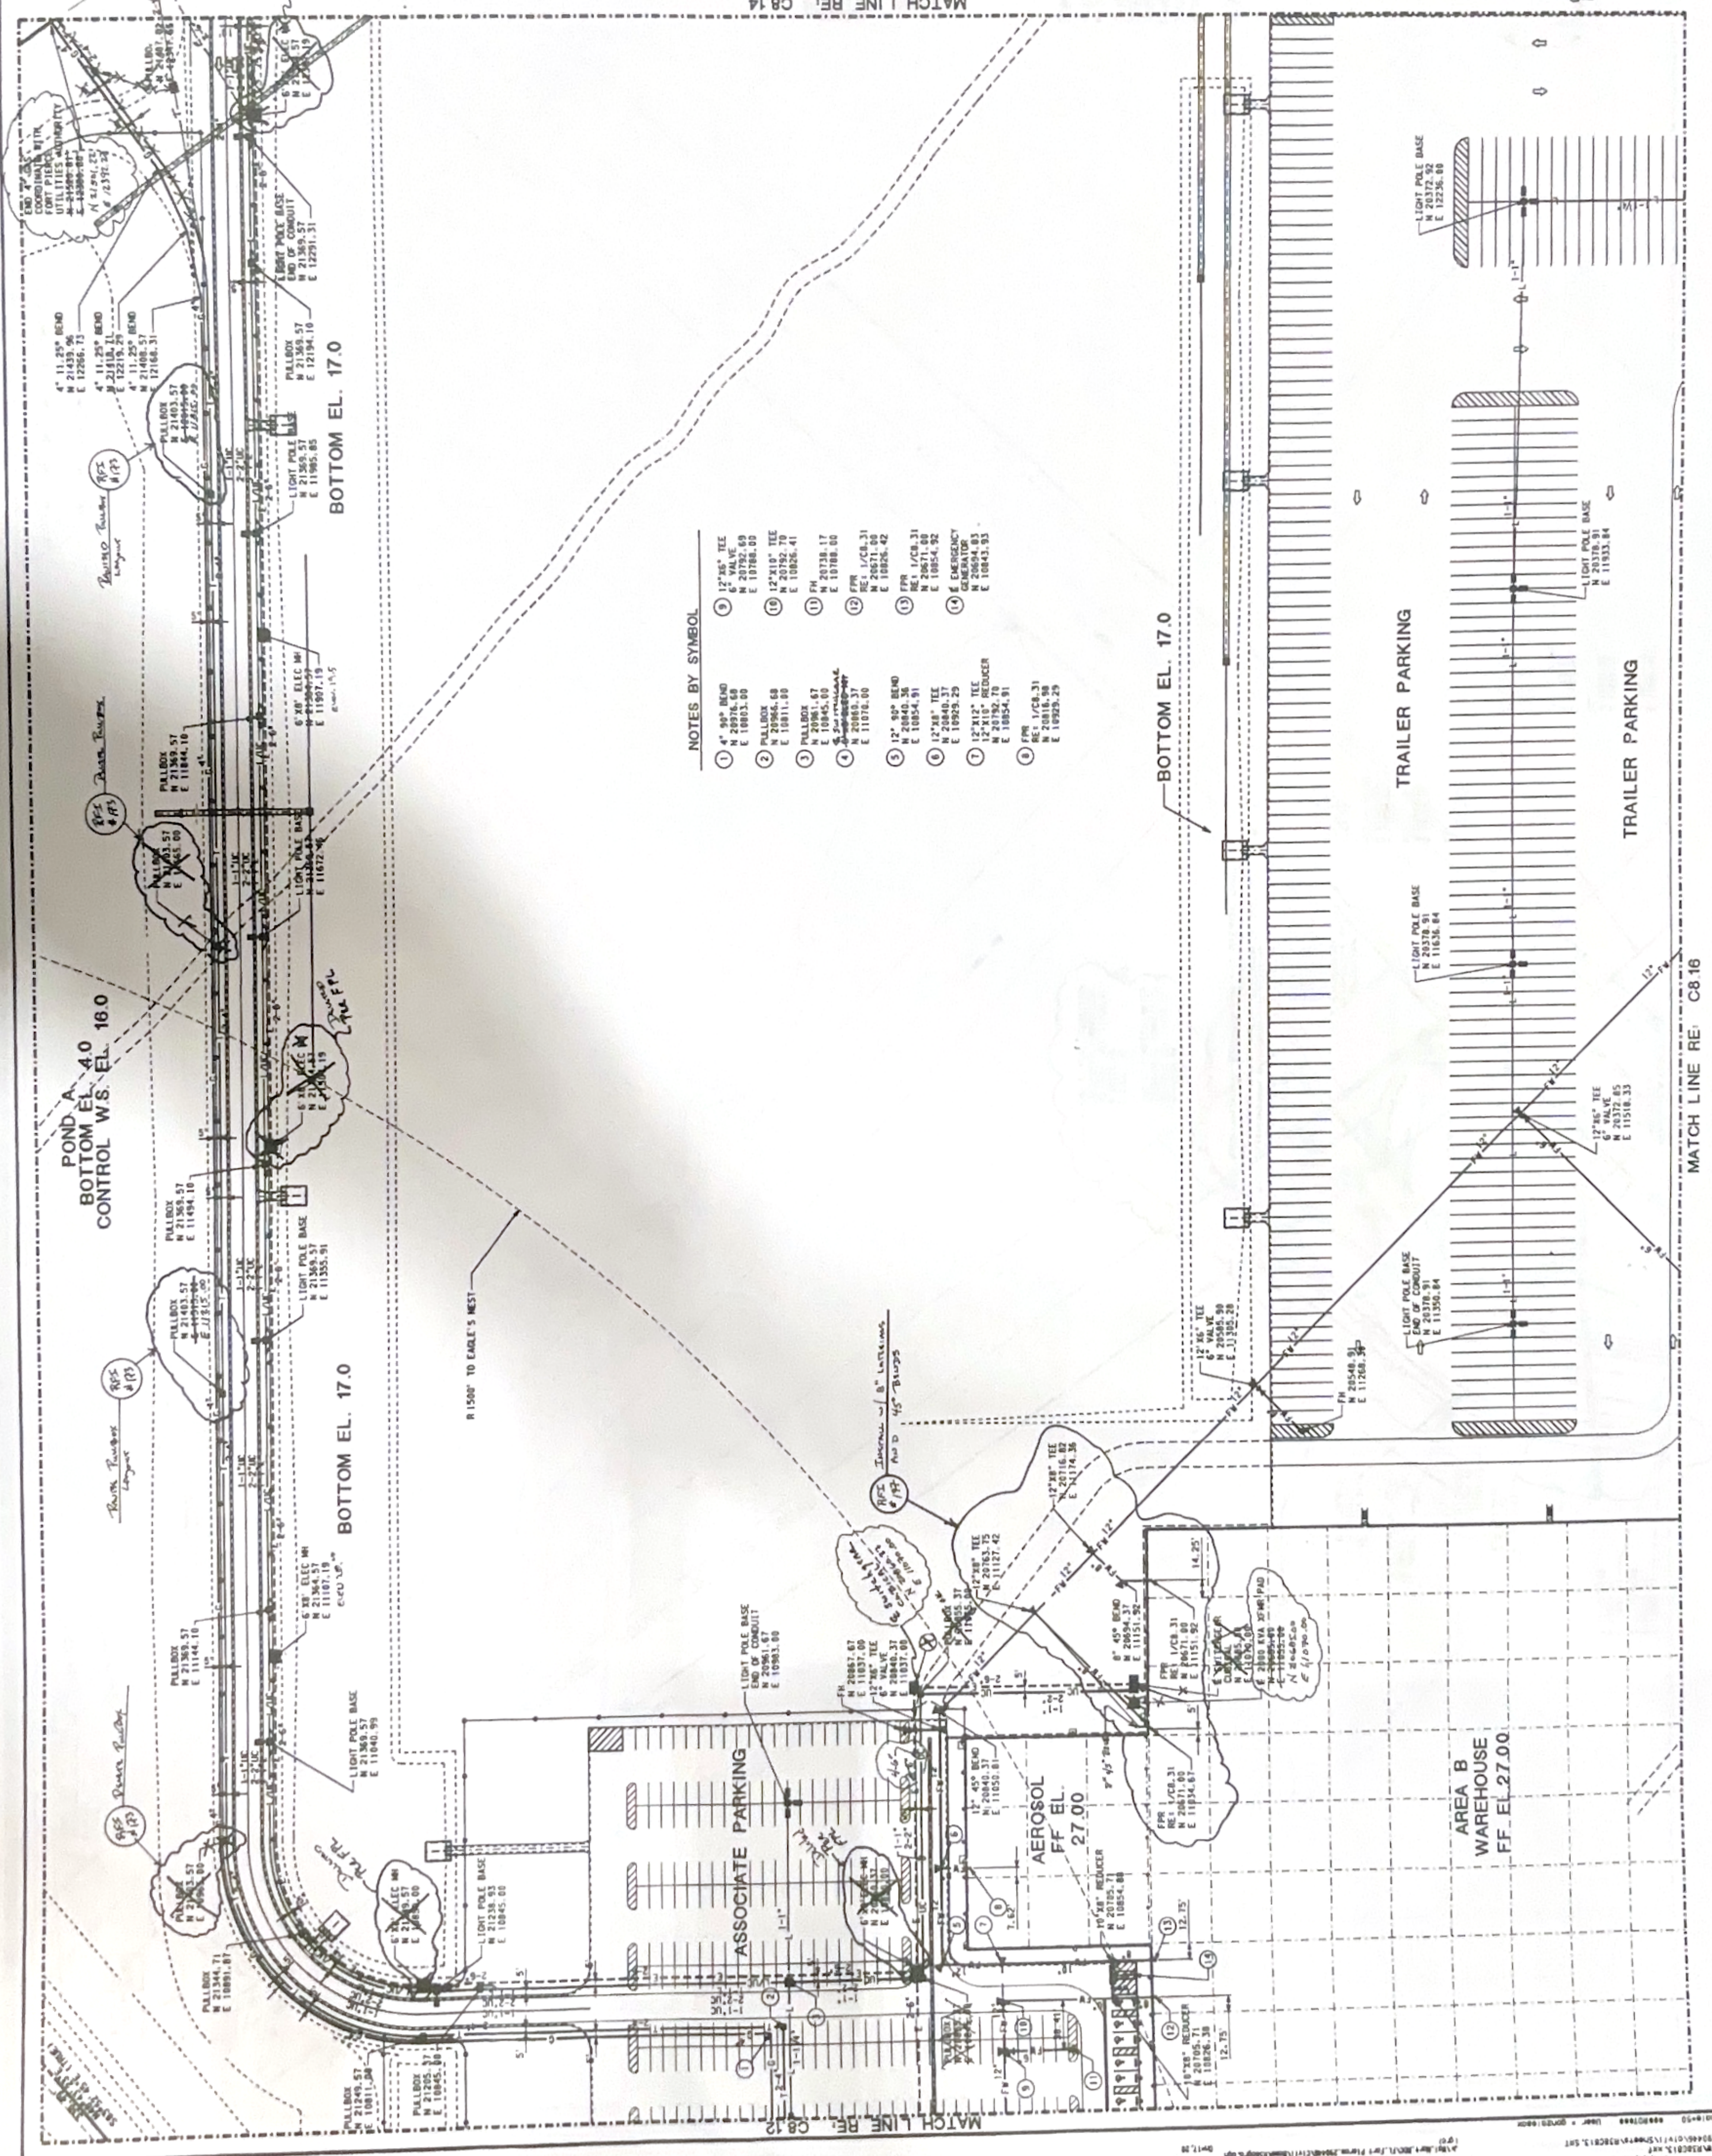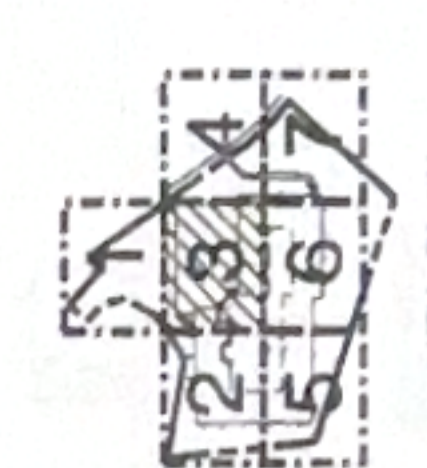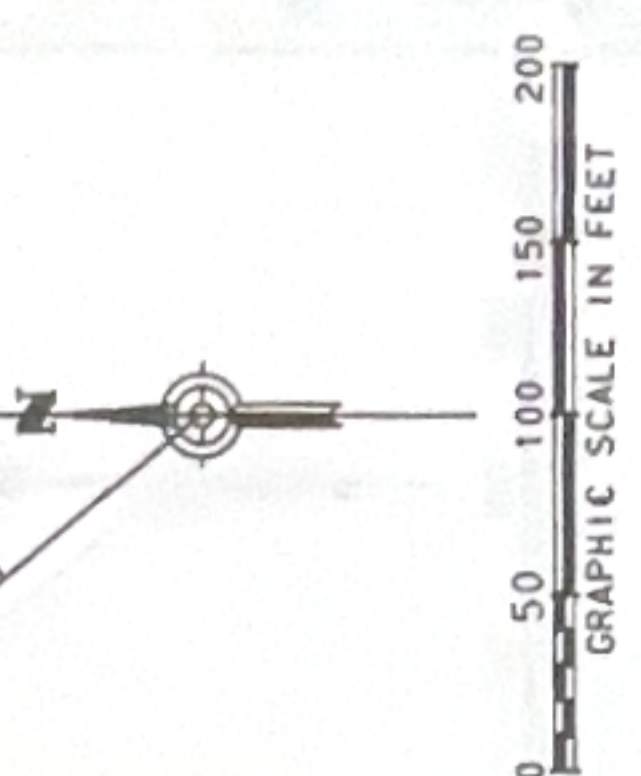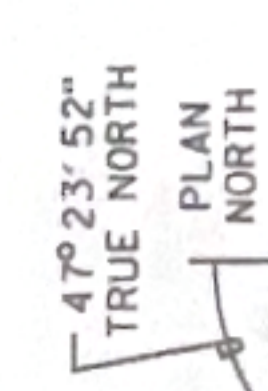

- NOTES BY SYMBOL
- ① 4" 90° BEND  
N 20976.69  
E 10053.00
  - ② PULLBOX  
N 20966.69  
E 10911.00
  - ③ PULLBOX 67  
N 20945.00  
E 10945.00
  - ④ 6" VALVE  
N 20885.37  
E 11076.00
  - ⑤ 12" 90° BEND  
N 20840.37  
E 10854.91
  - ⑥ 12" 45° BEND  
N 20840.37  
E 10854.91
  - ⑦ 12" 45° BEND  
N 20840.37  
E 10854.91
  - ⑧ 12" 45° BEND  
N 20840.37  
E 10854.91
  - ⑨ 12" 45° BEND  
N 20840.37  
E 10854.91
  - ⑩ 12" 45° BEND  
N 20840.37  
E 10854.91
  - ⑪ 12" 45° BEND  
N 20840.37  
E 10854.91
  - ⑫ 12" 45° BEND  
N 20840.37  
E 10854.91
  - ⑬ 12" 45° BEND  
N 20840.37  
E 10854.91
  - ⑭ 12" 45° BEND  
N 20840.37  
E 10854.91
  - ⑮ 12" 45° BEND  
N 20840.37  
E 10854.91
  - ⑯ 12" 45° BEND  
N 20840.37  
E 10854.91
  - ⑰ 12" 45° BEND  
N 20840.37  
E 10854.91
  - ⑱ 12" 45° BEND  
N 20840.37  
E 10854.91
  - ⑲ 12" 45° BEND  
N 20840.37  
E 10854.91
  - ⑳ 12" 45° BEND  
N 20840.37  
E 10854.91
  - ㉑ 12" 45° BEND  
N 20840.37  
E 10854.91
  - ㉒ 12" 45° BEND  
N 20840.37  
E 10854.91
  - ㉓ 12" 45° BEND  
N 20840.37  
E 10854.91
  - ㊷ 12" 45° BEND  
N 20840.37  
E 10854.91
  - ㊸ 12" 45° BEND  
N 20840.37  
E 10854.91
  - ㊹ 12" 45° BEND  
N 20840.37  
E 10854.91
  - ㊺ 12" 45° BEND  
N 20840.37  
E 10854.91
  - ㊻ 12" 45° BEND  
N 20840.37  
E 10854.91
  - ㊼ 12" 45° BEND  
N 20840.37  
E 10854.91
  - ㊽ 12" 45° BEND  
N 20840.37  
E 10854.91
  - ㊾ 12" 45° BEND  
N 20840.37  
E 10854.91
  - ㊿ 12" 45° BEND  
N 20840.37  
E 10854.91

AREA 3 - UTILITY PLAN  
 SCALE 1" = 50'

Copyright © 2003 by Carter & Burgess, Inc.



**BENCH MARKS**

TBM #1  
I.R. & C., "LB2856"  
ELEV. 115.49  
N 21954.20  
E 11064.83

TBM #2  
I.R. & C., "LB2856"  
ELEV. 115.49  
N 20769.76  
E 13561.33

B.M. #3  
DISK IN CONC., 195-Y-13  
ELEV. 116.16  
N 92786.66  
E 9029.68

B.M. #4  
I.R. & C., "LB2856"  
ELEV. 115.20  
N 11738.97  
E 11738.97

NOTE: ALL ELEVATIONS ON PLANS ARE BASED AND MUST BE CONSTRUCTED ON HAYD 88 DATUM.

1. HAYD 88 DATUM IS 1.48' HIGHER THAN NAVD 88 DATUM.

2. HAYD 88 DATUM IS 1.48' HIGHER THAN NAVD 88 DATUM.

PROJECT NO.	ISSUE FOR PERMIT	DATE	NO.	ISSUE
01/17/03	ISSUE FOR PERMIT	01/17/03	1	ISSUE FOR PERMIT
02/21/03	ISSUE FOR COMMENTS	02/21/03	2	ISSUE FOR COMMENTS
03/17/03	ISSUE FOR PERMIT	03/17/03	3	ISSUE FOR PERMIT
04/08/03	ISSUE FOR SITE PLAN APPROVAL	04/08/03	4	ISSUE FOR SITE PLAN APPROVAL

**WAL-MART**  
REGIONAL DISTRIBUTION  
CENTER NO. 7038  
FORT PIERCE, FLORIDA

**Area 6 - UTILITY PLAN**




**Center Burgess**  
Construction Management, and Related Services  
Center & Burgess, Inc.  
777 Main Street, Fort Pierce, Florida 34949  
(887) 232-6500 Fax (887) 232-6700  
Certificate of Authorization Number AA-C00002

SHEET  
**C8.16**

# PROJECT RECORD

Job #570

Date: 06-16-04  
Regional Distribution Center #7038  
Fort Pierce, Florida Job #570  
Center Burgess Engineering & Construction  
Telephone: (887) 395-4000  
7901 SW 8th Court  
Plantation, Florida 33324  
This plan, with the as-built notations, accurately reflects the completed work.  
M. William Roedel, Senior Project Manager

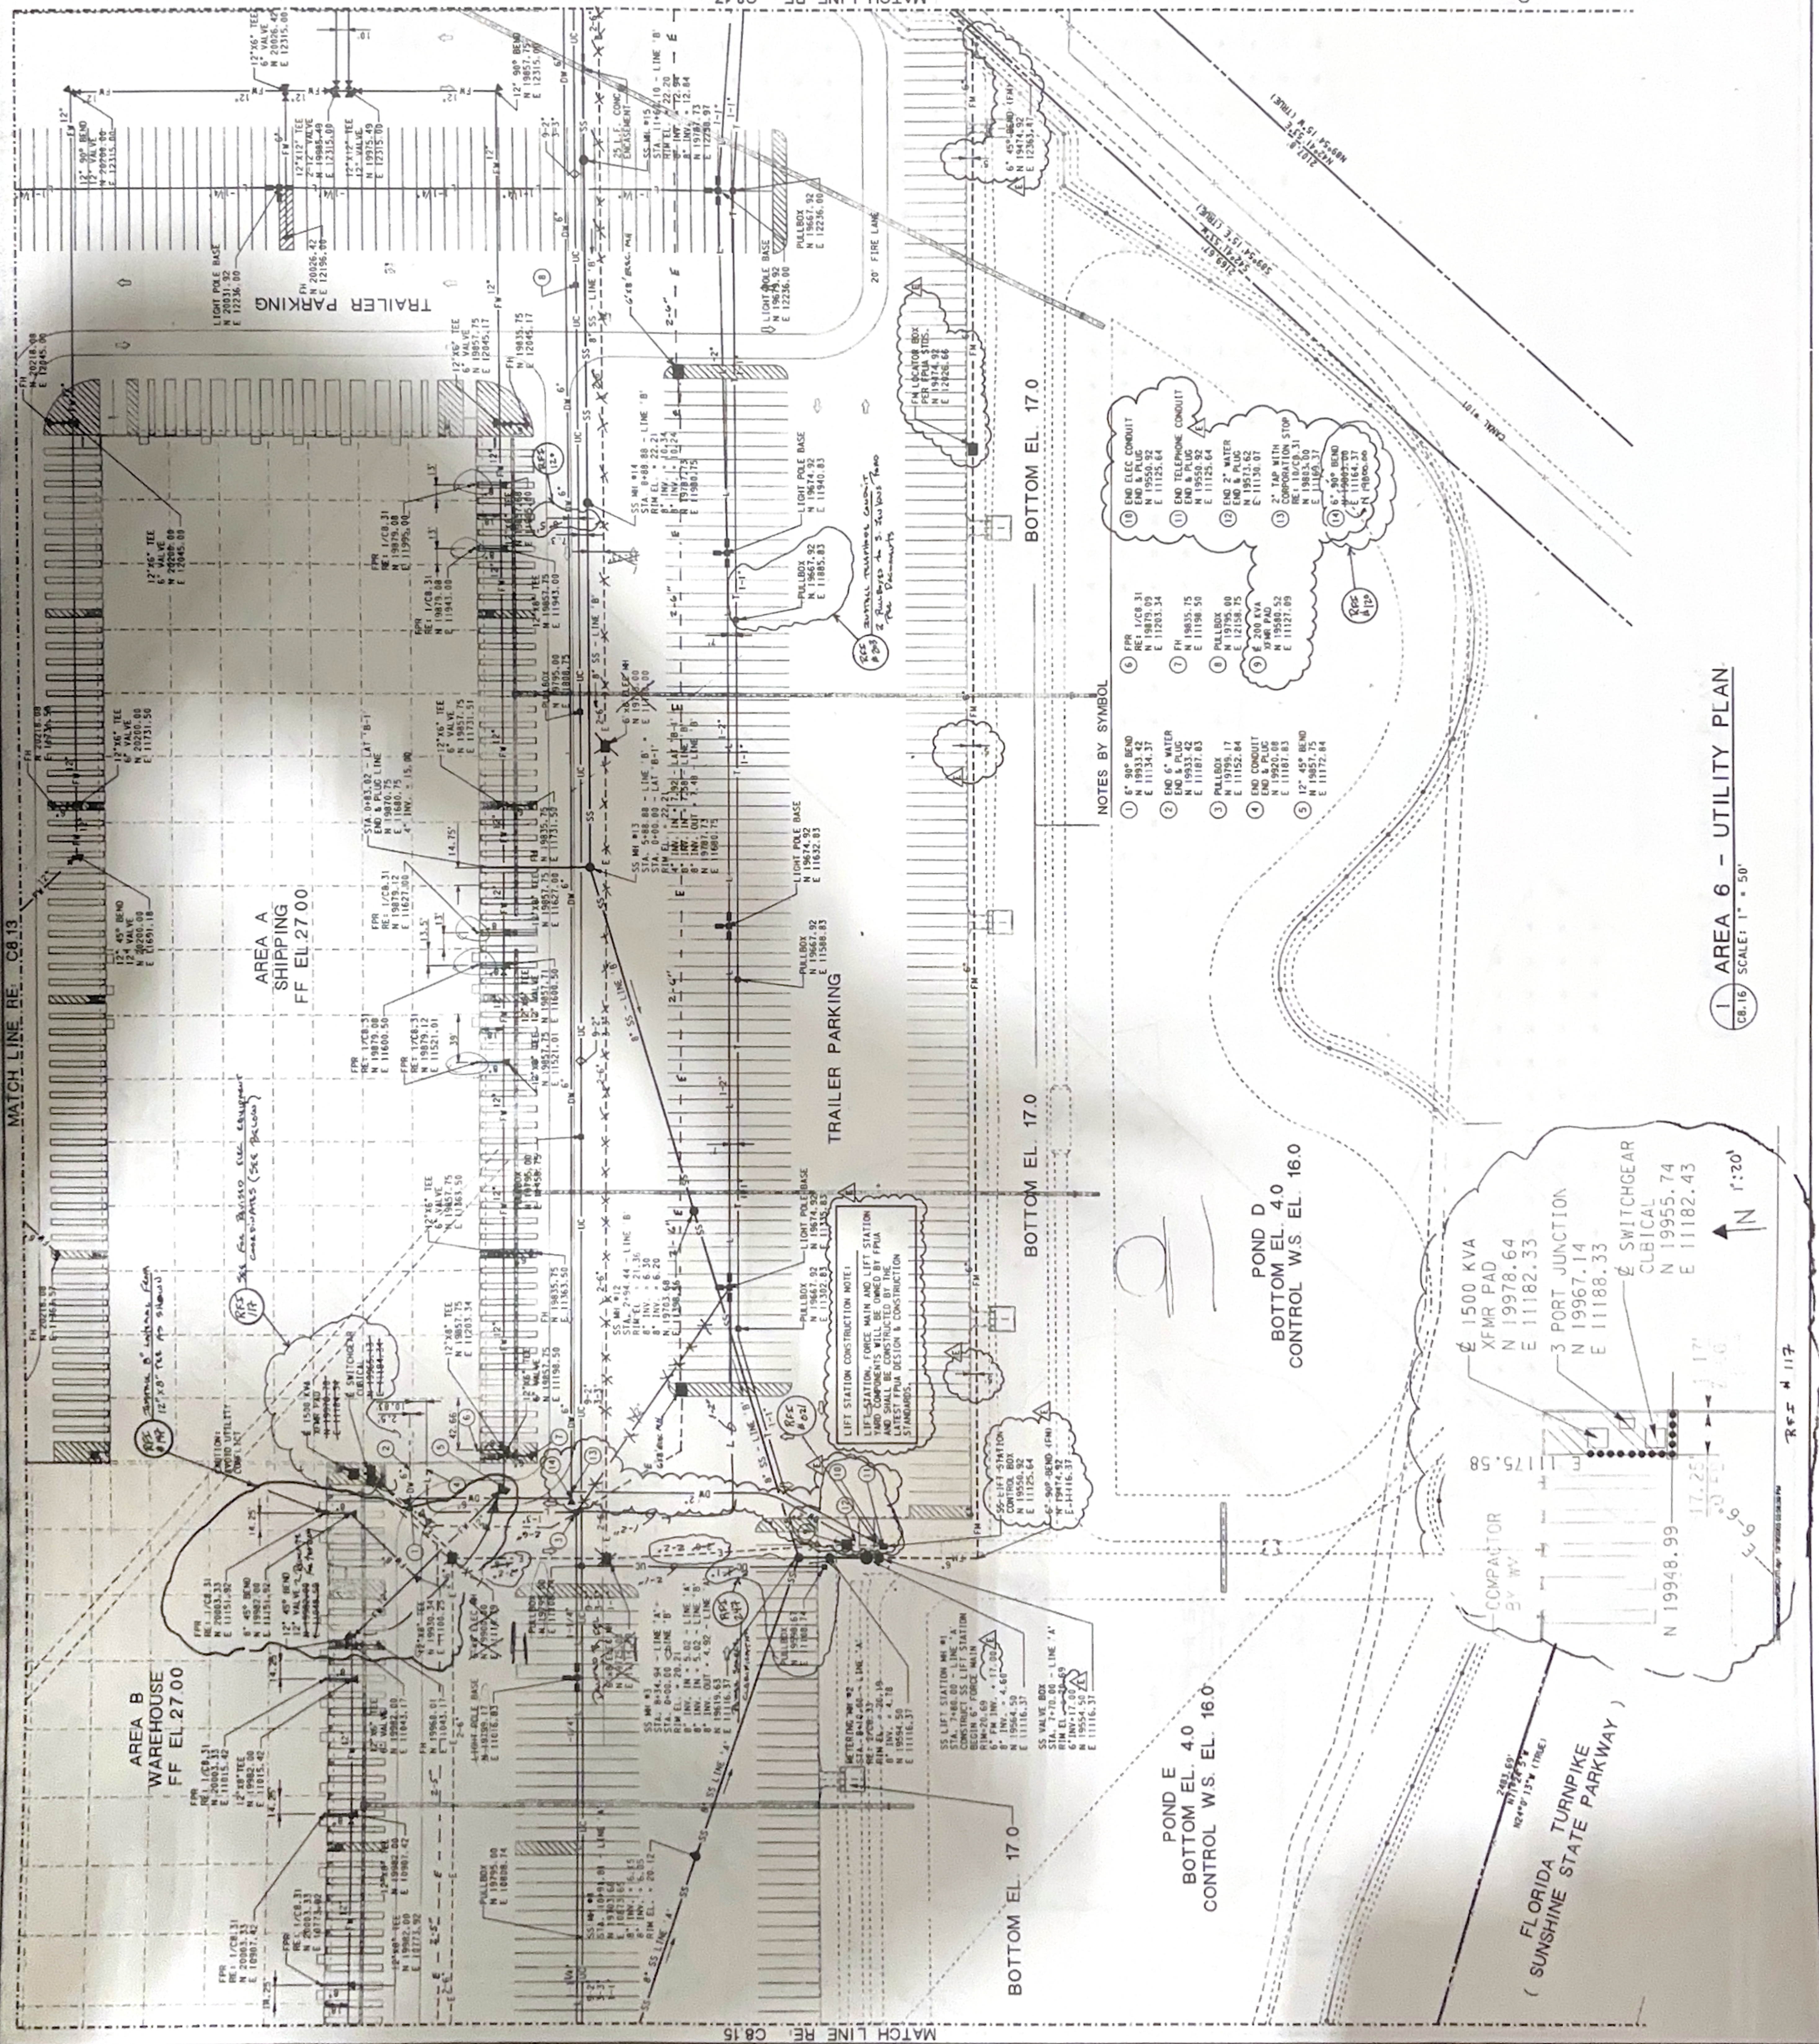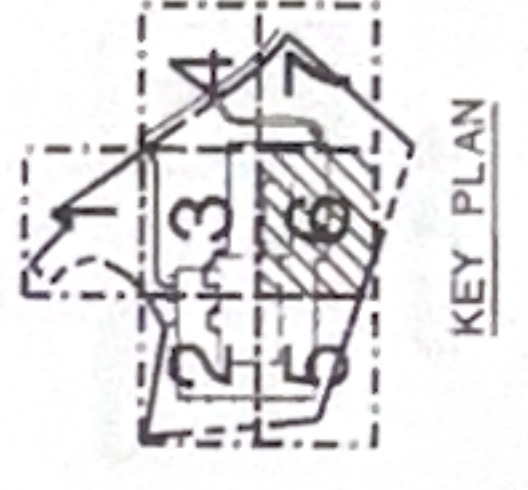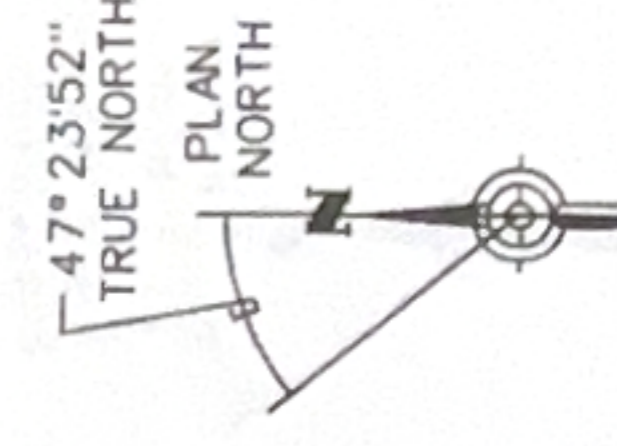

**NOTES BY SYMBOL**

- 1 6" 90° BEND  
N 19933.42  
E 11134.37
- 2 END 6" WATER  
END 6" WATER  
N 19978.64  
E 11182.33
- 3 END 6" WATER  
END 6" WATER  
N 19978.64  
E 11182.33
- 4 END 6" WATER  
END 6" WATER  
N 19978.64  
E 11182.33
- 5 12" 45° BEND  
N 19957.75  
E 11172.84
- 6 FRR  
N 19933.42  
E 11134.37
- 7 FRR  
N 19933.42  
E 11134.37
- 8 PULLBOX  
N 19933.42  
E 11134.37
- 9 END 2" WATER  
END 2" WATER  
N 19978.64  
E 11182.33
- 10 END 2" WATER  
END 2" WATER  
N 19978.64  
E 11182.33
- 11 END TELEPHONE CONDUIT  
END TELEPHONE CONDUIT  
N 19933.42  
E 11134.37
- 12 END 2" WATER  
END 2" WATER  
N 19978.64  
E 11182.33
- 13 2" TAP WITH  
CORPORATION STOP  
N 19933.42  
E 11134.37
- 14 6" 90° BEND  
N 19933.42  
E 11134.37

1 AREA 6 - UTILITY PLAN  
C8.16 SCALE: 1" = 50'

# REGIONAL DISTRIBUTION CENTER NO. 7038

## FORT PIERCE, FLORIDA


# WAL-MART®

STORES EAST, L.P.  
 SAM M. WALTON DEVELOPMENT COMPLEX  
 2001 SOUTHEAST 10TH STREET, DEPARTMENT 9562  
 BENTONVILLE, ARKANSAS 72716-0550

## Carter Burgess

Consultants in Planning, Engineering, Architecture,  
 Construction Management, and Related Services  
 Carter & Burgess, Inc.  
 Retail & Distribution - Floor 29  
 777 Main Street, Fort Worth, Texas 76102  
 (817) 222-8500 Fax (817) 222-8550  
 Architecture Certificate of Authorization Number AA-C001802  
 Engineering Certificate of Authorization Number 5300

Posted Set  
 7/13/03  
 7/11/03

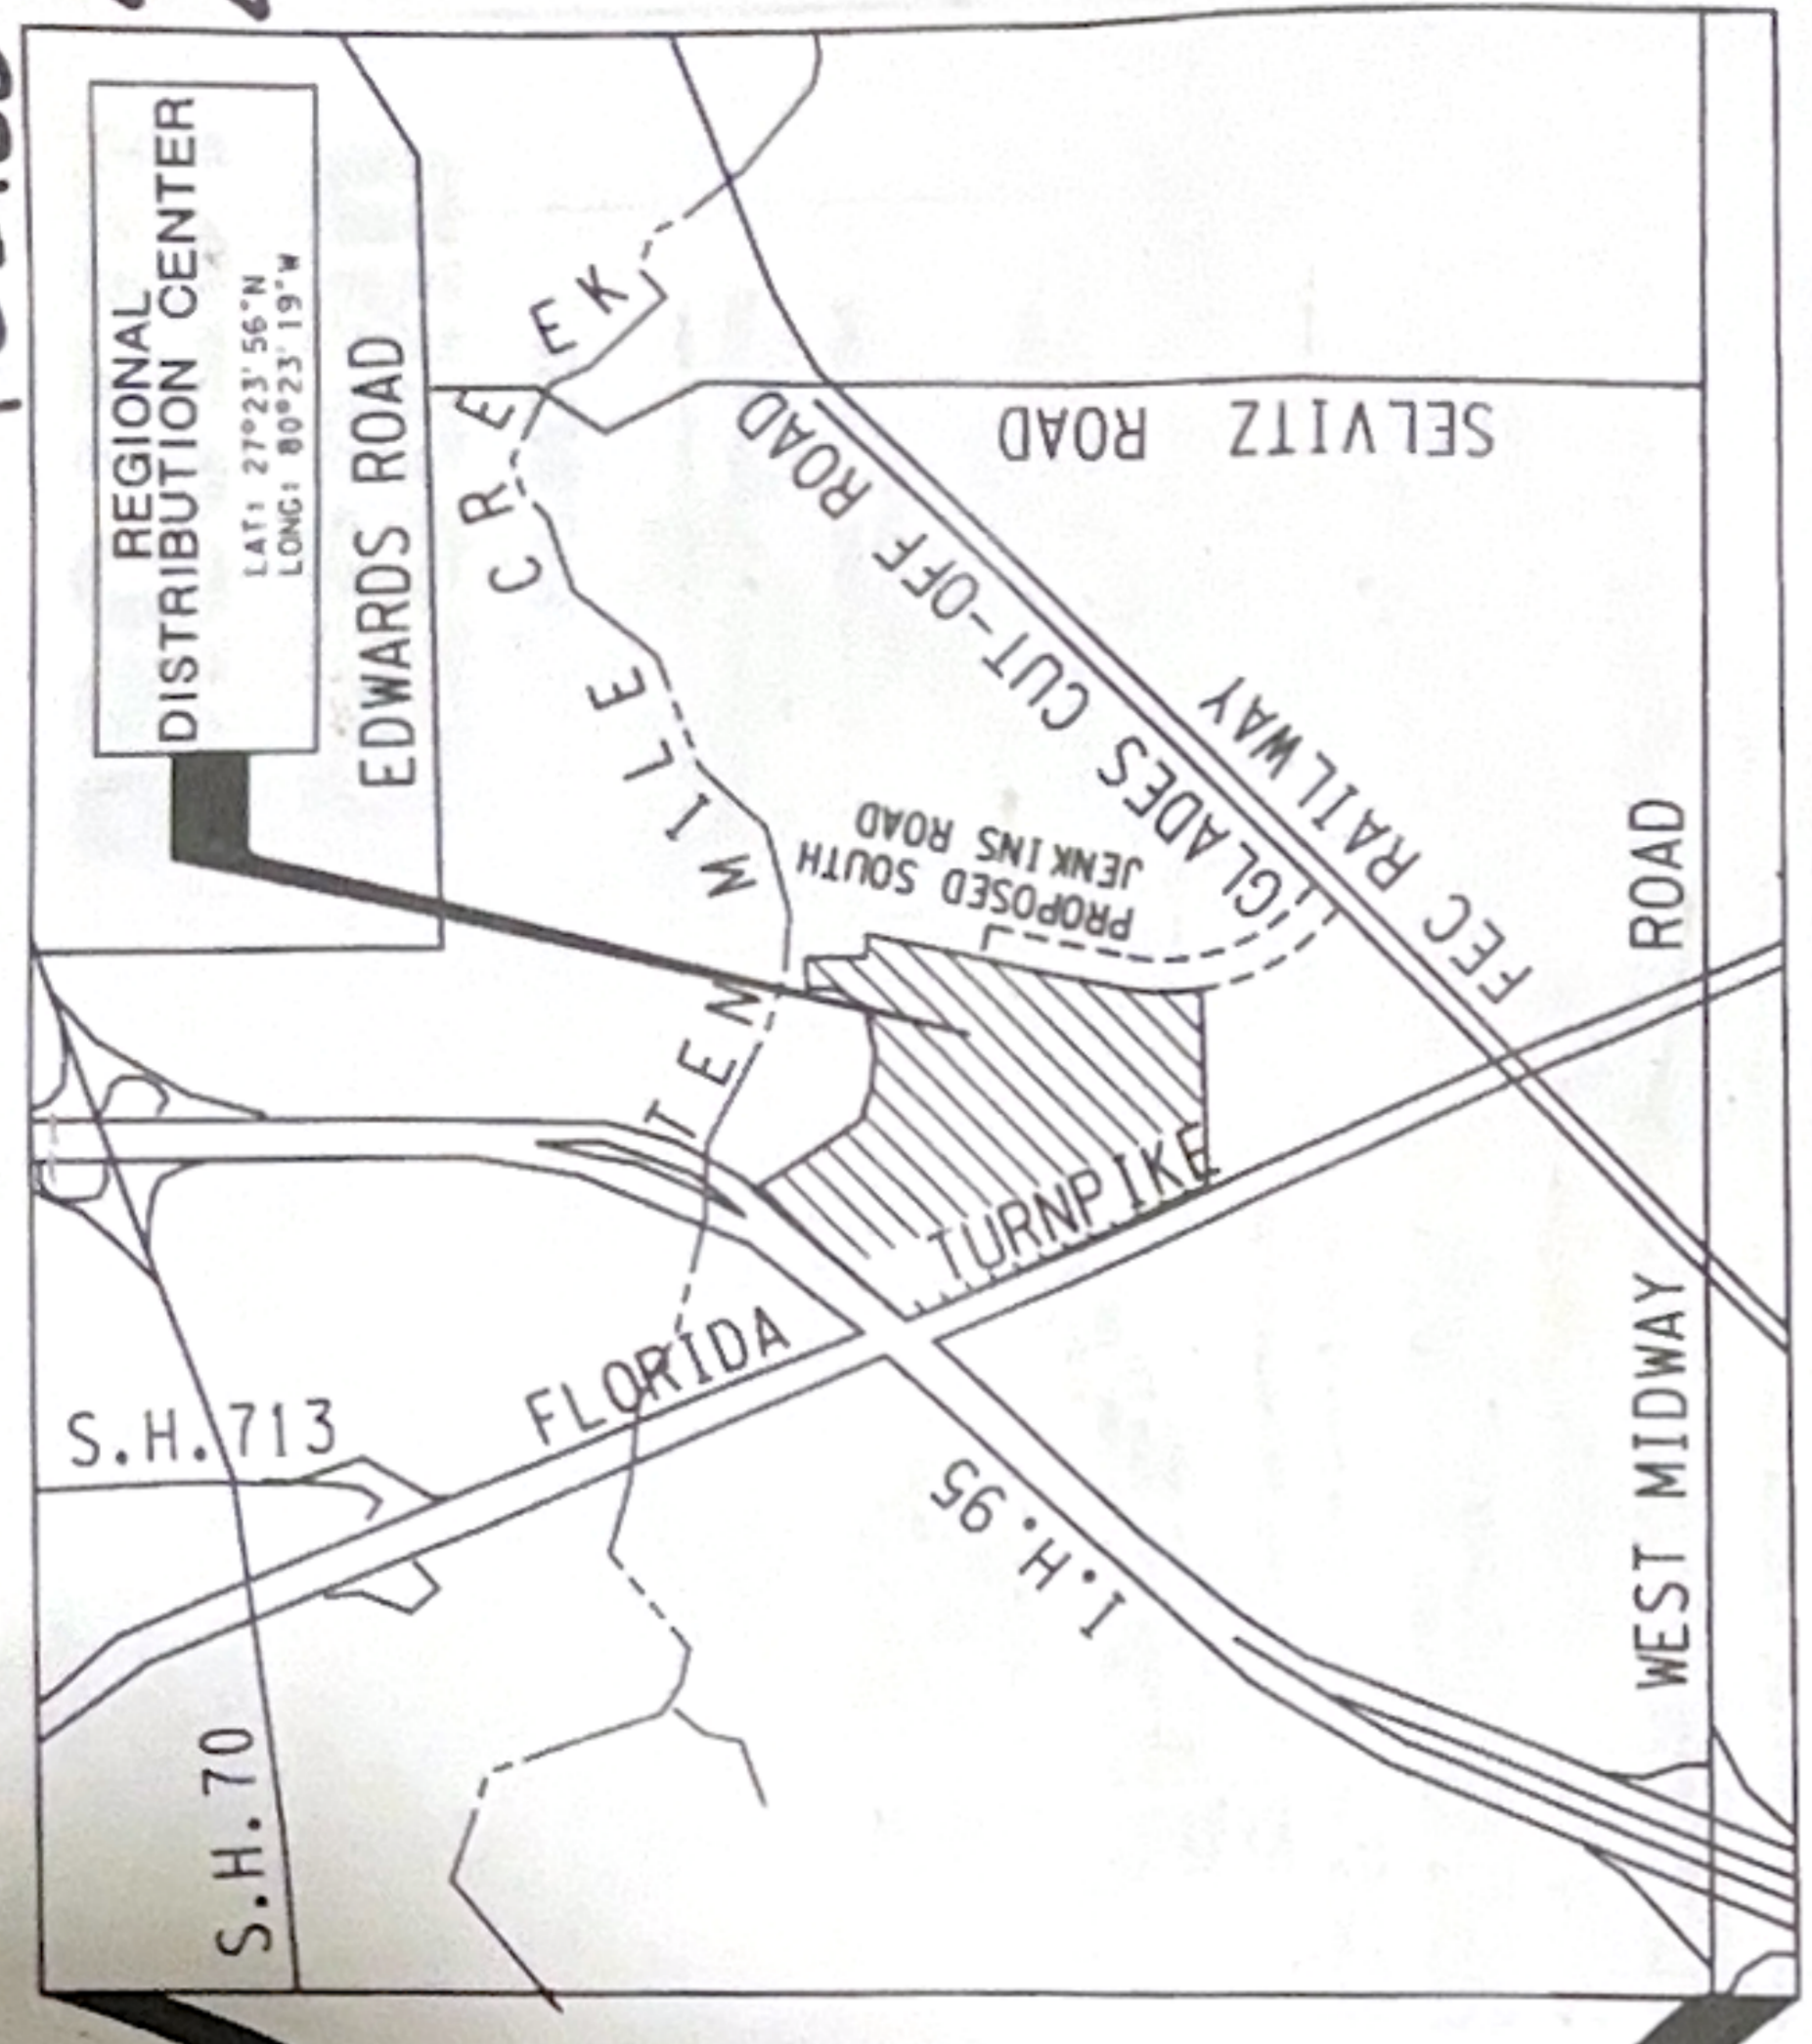

### DRAWING INDEX

DISCIPLINE CODE	BUILDING AREAS	SITE AREAS
C - CIVIL	WAREHOUSE	1. TOPOGRAPHY
A - ARCHITECTURAL	TMG/FUEL DISPENSING ISLAND	2. GRADING
M - MECHANICAL	FIRE PUMP HOUSE	3. FOUNDATION
E - ELECTRICAL		4. PAVING
F - FIRE PROTECTION		5. UTILITY
MA - ARCHITECTURAL (METAL BUILDING)		6. TRAFFIC CONTROL
MS - STRUCTURAL (METAL BUILDING)		
MF - MECHANICAL (METAL BUILDING)		
MP - PAVING		
MT - TRAFFIC CONTROL		

- BUILDING
  - MB.01 ARCHITECTURAL ABREVIATIONS, SYMBOLS & GENERAL NOTES
  - MB.02 ARCHITECTURAL ABREVIATIONS, SYMBOLS & GENERAL NOTES
  - MB.03 ARCHITECTURAL ABREVIATIONS, SYMBOLS & GENERAL NOTES
  - MB.04 ARCHITECTURAL ABREVIATIONS, SYMBOLS & GENERAL NOTES
- MECHANICAL
  - ME.01 ELECTRICAL ABREVIATIONS, SYMBOLS & GENERAL NOTES
  - ME.02 ELECTRICAL ABREVIATIONS, SYMBOLS & GENERAL NOTES
  - ME.03 ELECTRICAL ABREVIATIONS, SYMBOLS & GENERAL NOTES
  - ME.04 ELECTRICAL ABREVIATIONS, SYMBOLS & GENERAL NOTES
- ELECTRICAL
  - EE.01 ELECTRICAL ABREVIATIONS, SYMBOLS & GENERAL NOTES
  - EE.02 ELECTRICAL ABREVIATIONS, SYMBOLS & GENERAL NOTES
  - EE.03 ELECTRICAL ABREVIATIONS, SYMBOLS & GENERAL NOTES
  - EE.04 ELECTRICAL ABREVIATIONS, SYMBOLS & GENERAL NOTES
- FIRE PROTECTION
  - FP.01 FIRE PROTECTION ABREVIATIONS, SYMBOLS & GENERAL NOTES
  - FP.02 FIRE PROTECTION ABREVIATIONS, SYMBOLS & GENERAL NOTES
  - FP.03 FIRE PROTECTION ABREVIATIONS, SYMBOLS & GENERAL NOTES
- METAL BUILDING
  - MB.01 ARCHITECTURAL ABREVIATIONS, SYMBOLS & GENERAL NOTES
  - MB.02 ARCHITECTURAL ABREVIATIONS, SYMBOLS & GENERAL NOTES
  - MB.03 ARCHITECTURAL ABREVIATIONS, SYMBOLS & GENERAL NOTES
  - MB.04 ARCHITECTURAL ABREVIATIONS, SYMBOLS & GENERAL NOTES

NO.	DESCRIPTION	DATE
1.	WAREHOUSE	
1.01	AREA A - BACK & CONVEYOR PLAN	
1.02	AREA B - BACK & CONVEYOR PLAN	
1.03	AREA C - BACK & CONVEYOR PLAN	
1.04	AREA D - BACK & CONVEYOR PLAN	
1.05	AREA E - BACK & CONVEYOR PLAN	
1.06	AREA F - BACK & CONVEYOR PLAN	
1.07	AREA G - BACK & CONVEYOR PLAN	
1.08	AREA H - BACK & CONVEYOR PLAN	
1.09	AREA I - BACK & CONVEYOR PLAN	
1.10	AREA J - BACK & CONVEYOR PLAN	
1.11	AREA K - BACK & CONVEYOR PLAN	
1.12	AREA L - BACK & CONVEYOR PLAN	
1.13	AREA M - BACK & CONVEYOR PLAN	
1.14	AREA N - BACK & CONVEYOR PLAN	
1.15	AREA O - BACK & CONVEYOR PLAN	
1.16	AREA P - BACK & CONVEYOR PLAN	
1.17	AREA Q - BACK & CONVEYOR PLAN	
1.18	AREA R - BACK & CONVEYOR PLAN	
1.19	AREA S - BACK & CONVEYOR PLAN	
1.20	AREA T - BACK & CONVEYOR PLAN	
1.21	AREA U - BACK & CONVEYOR PLAN	
1.22	AREA V - BACK & CONVEYOR PLAN	
1.23	AREA W - BACK & CONVEYOR PLAN	
1.24	AREA X - BACK & CONVEYOR PLAN	
1.25	AREA Y - BACK & CONVEYOR PLAN	
1.26	AREA Z - BACK & CONVEYOR PLAN	
1.27	AREA AA - BACK & CONVEYOR PLAN	
1.28	AREA AB - BACK & CONVEYOR PLAN	
1.249	AREA IO - BACK & CONVEYOR PLAN	
1.250	AREA IP - BACK & CONVEYOR PLAN	
1.251	AREA IQ - BACK & CONVEYOR PLAN	
1.252	AREA IR - BACK & CONVEYOR PLAN	
1.253	AREA IS - BACK & CONVEYOR PLAN	
1.254	AREA IT - BACK & CONVEYOR PLAN	
1.255	AREA IU - BACK & CONVEYOR PLAN	
1.256	AREA IV - BACK & CONVEYOR PLAN	
1.257	AREA IW - BACK & CONVEYOR PLAN	
1.258	AREA IX - BACK & CONVEYOR PLAN	
1.259		

