

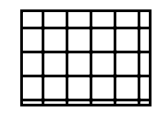


EXHIBIT A

F.H.W.A. REGION	STATE	PROJECT NO.	SHEET NO.	TOTAL SHEETS	RECORD DRAWING
9	AZ	IT0372			

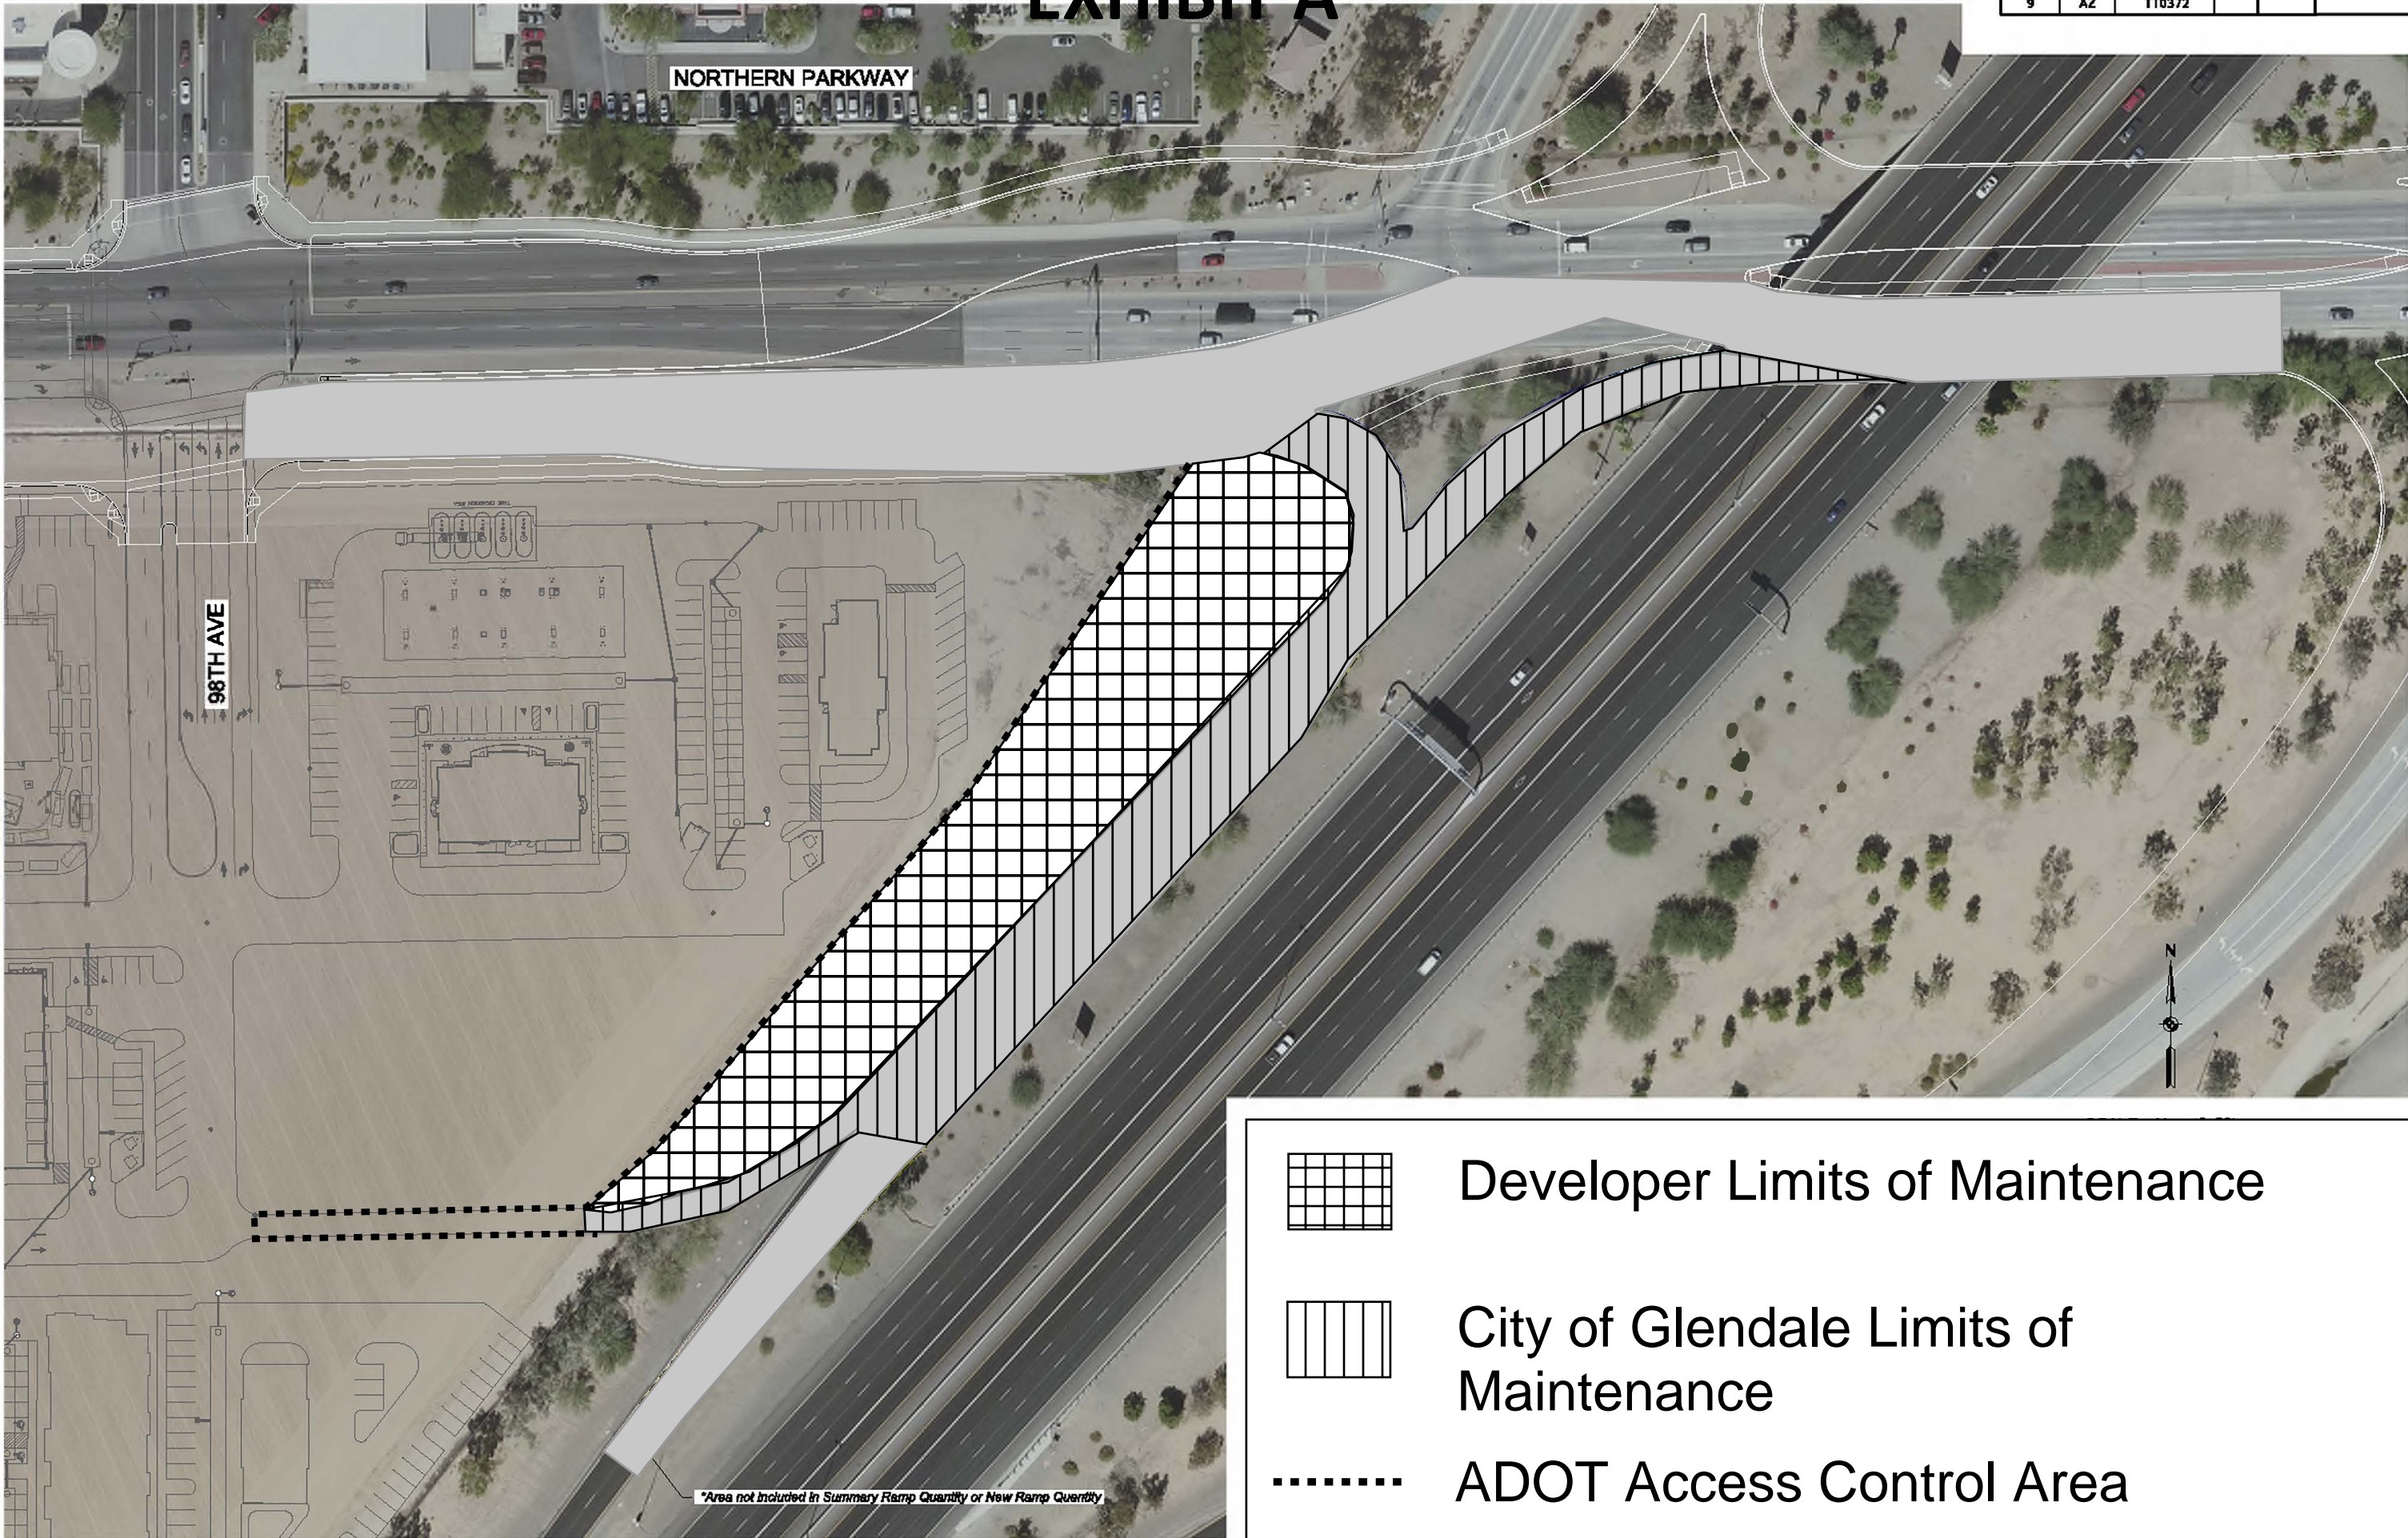

Developer Limits of Maintenance

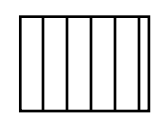

City of Glendale Limits of Maintenance



ADOT Access Control Area

TYAL_GM_half_half.dwg 10/4/2021 1:15:48 PM 10/4/2021 Dennis Ray 10/4/2021 1:15:48 PM 10/4/2021