

SUBDIVISION PLAT OF
EDUARDO'S SUBDIVISION No. 10

AS-BUILT

LEGEND
 • SET 1/2" x 24" IRON ROD WITH PLASTIC CAP STAMPED RPLS 4856 UNLESS OTHERWISE NOTED.



LOCATION MAP

SCALE 1" = 100' FEET


GARDNER & L. PARTNERS, L.L.C. TRACT LOT 70, BLOCK 4, DOC # 1522238, LA ROMA RANCH CITRUS GROVES, UNIT NO. 1, HIDALGO COUNTY, TEXAS, ACCORDING TO THE MAP OR PLAT THEREOF RECORDED IN VOLUME 7, PAGE 59, MAP RECORDS OF HIDALGO COUNTY, TEXAS.

TRACT 2303 P.O. CORRAL STREET, FIDELITY COMPANY, ACCORDING TO THE MAP OR PLAT THEREOF RECORDED IN VOLUME 456, PAGE 314, EASEL BACKS, HIDALGO COUNTY, TEXAS.


GARDNER, FELIX AND TERESITA GUERRA LA ROMA RANCH #1 LOT 69, BLK. 4, LA ROMA RANCH CITRUS GROVES, UNIT NO. 1, HIDALGO COUNTY, TEXAS, ACCORDING TO THE MAP OR PLAT THEREOF RECORDED IN VOLUME 7, PAGE 59, MAP RECORDS OF HIDALGO COUNTY, TEXAS.

GARDNER, ARMANDO AND CLELIA ESPINOZA LA ROMA RANCH #1 LOT 68, BLK. 4, LA ROMA RANCH CITRUS GROVES, UNIT NO. 1, HIDALGO COUNTY, TEXAS, ACCORDING TO THE MAP OR PLAT THEREOF RECORDED IN VOLUME 7, PAGE 59, MAP RECORDS OF HIDALGO COUNTY, TEXAS.

GARDNER, TOMAS SR AND JESUS CARLOS LA ROMA RANCH #1 LOTS 65 AND 67, BLK. 4, LA ROMA RANCH CITRUS GROVES, UNIT NO. 1, HIDALGO COUNTY, TEXAS, ACCORDING TO THE MAP OR PLAT THEREOF RECORDED IN VOLUME 7, PAGE 59, MAP RECORDS OF HIDALGO COUNTY, TEXAS.

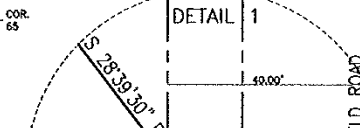

SHEET NO.	INDEX TO SHEET
1	EDUARDO'S 10 PLAT
2	EDUARDO'S 10 PLAT INFORMATION
3	EDUARDO'S 10 MAP OF WATER DISTRIBUTION AND OSSF
4	EDUARDO'S 10 MAP OF WATER DISTRIBUTION AND OSSF INFORMATION
5	EDUARDO'S 10 MAP OF TOPOGRAPHY AND DRAINAGE
6	EDUARDO'S 10 MAP OF TOPOGRAPHY AND DRAINAGE INFORMATION
7	EDUARDO'S 10 EROSION PLAN

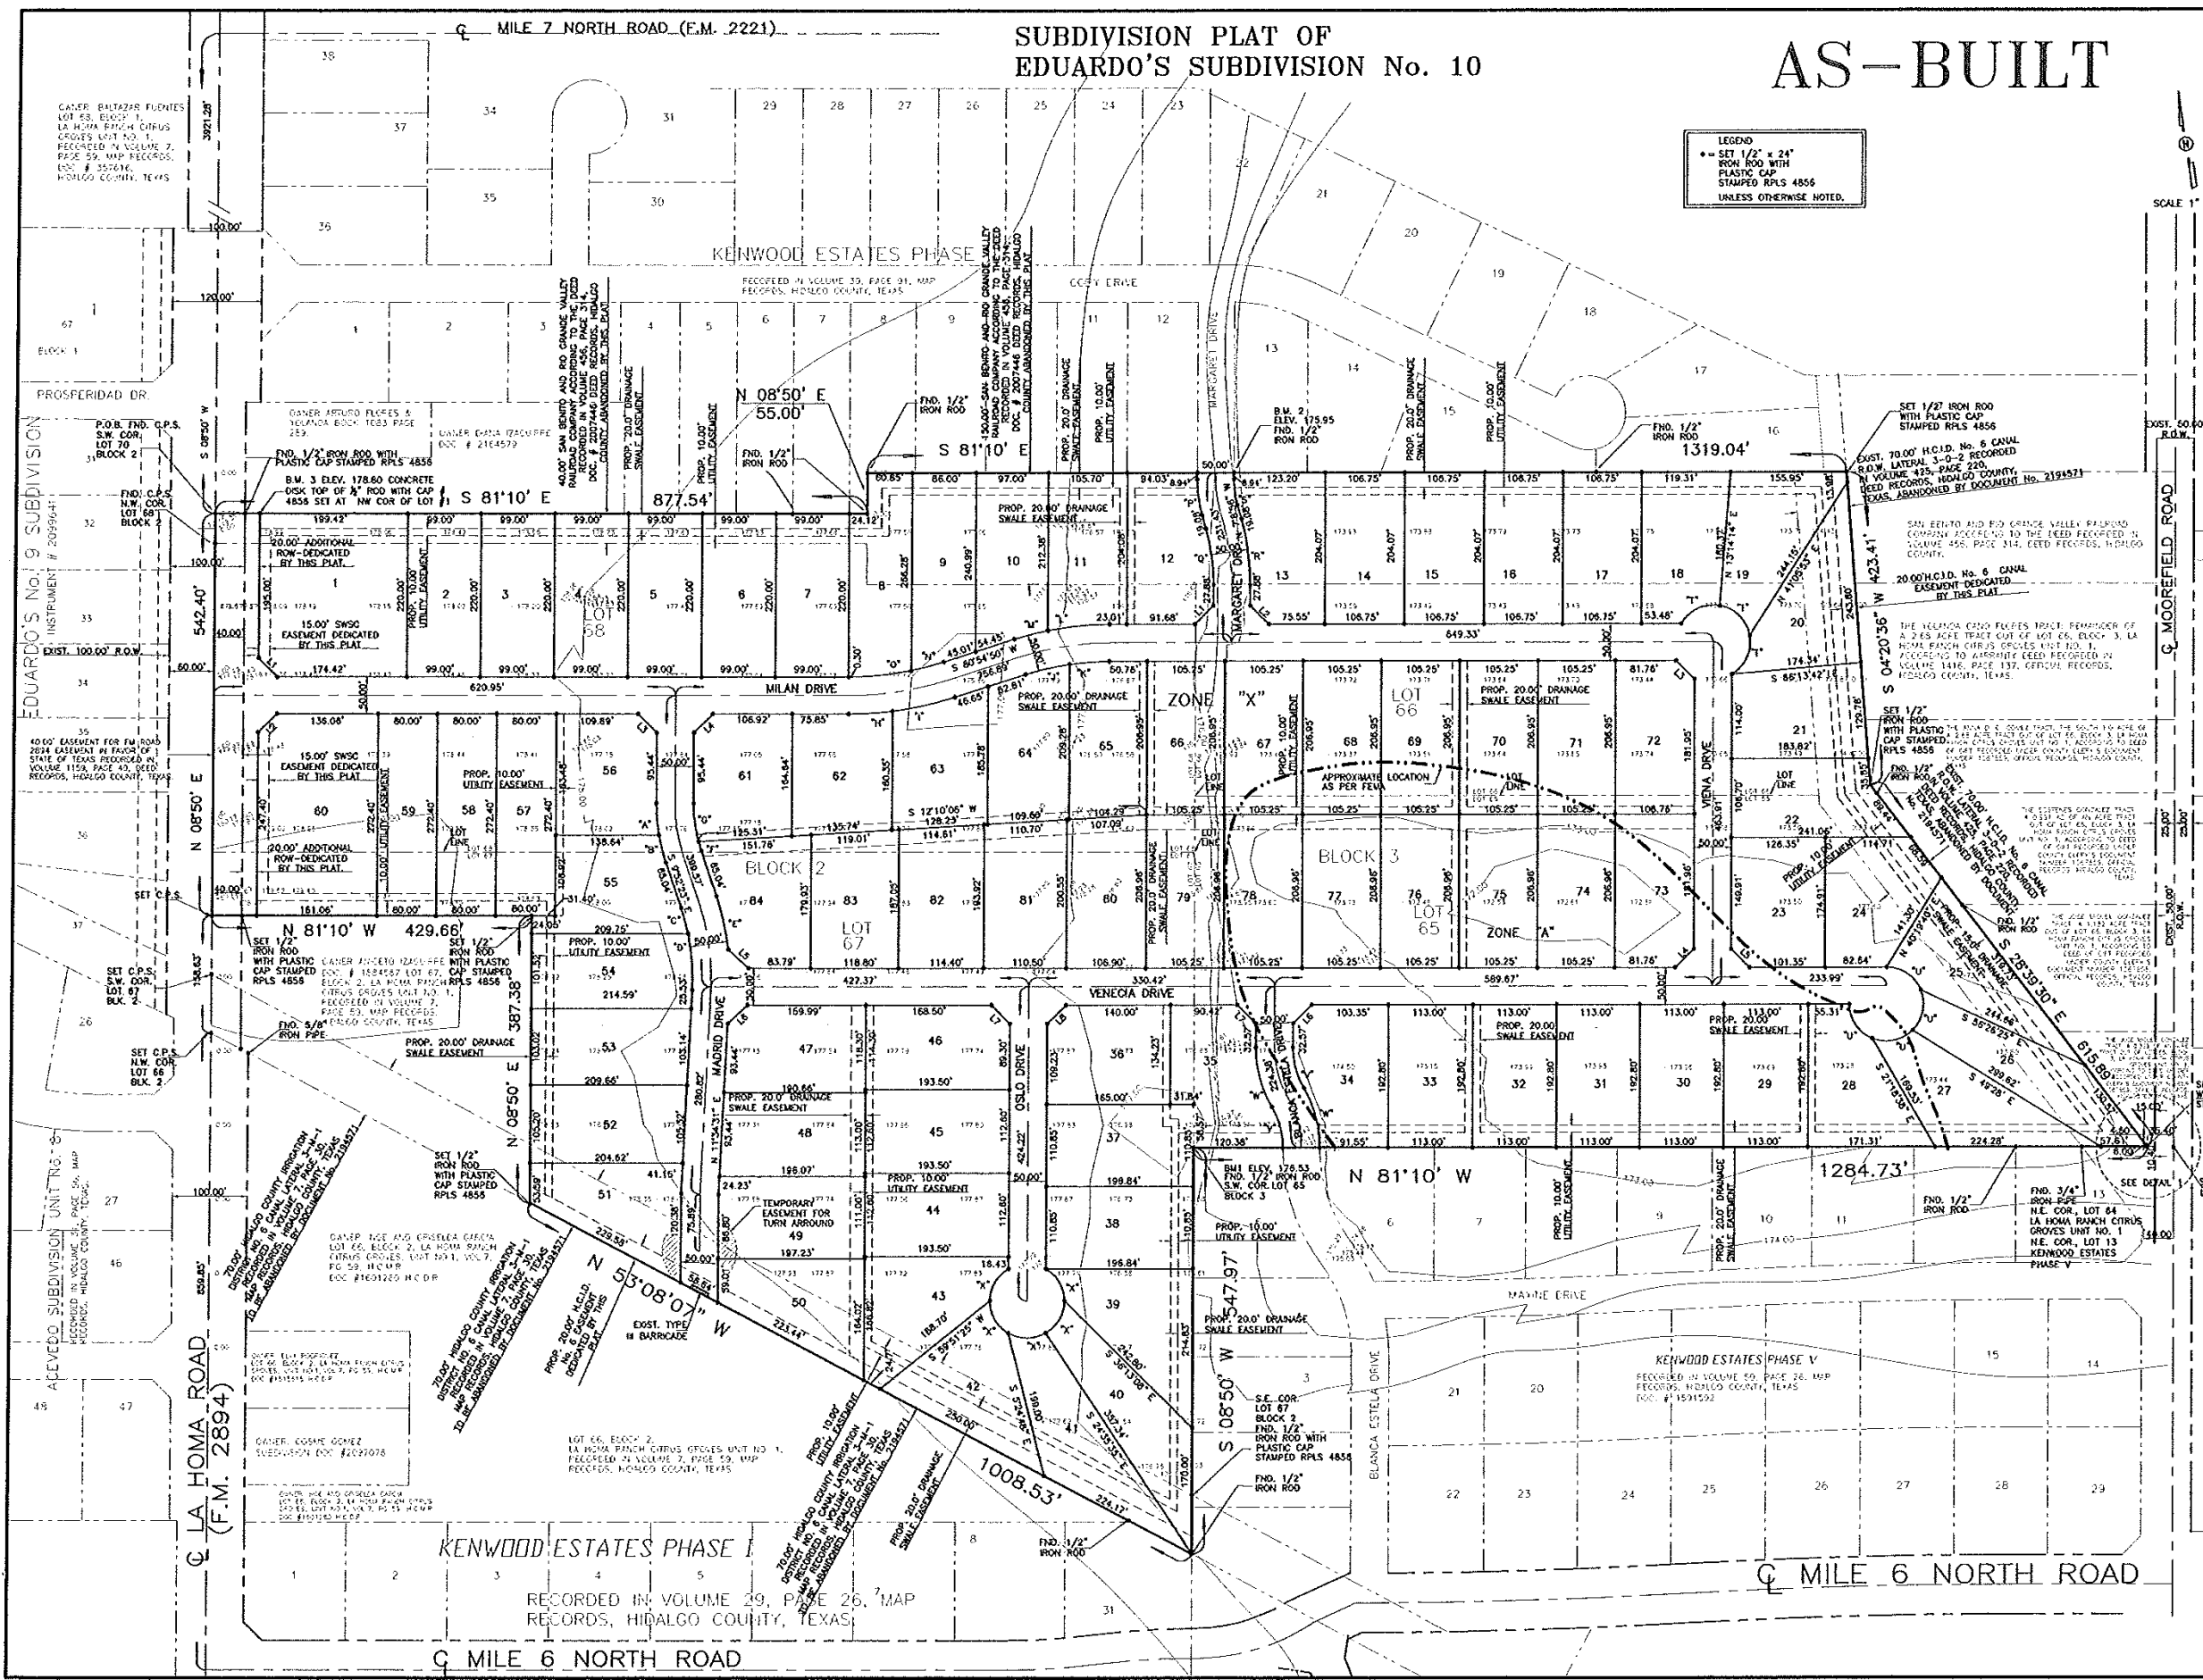

KENWOOD ESTATES PHASE I

RECORDED IN VOLUME 29, PAGE 26, MAP RECORDS, HIDALGO COUNTY, TEXAS

C. MILE 6 NORTH ROAD

C. MILE 6 NORTH ROAD