



HIDALGO COUNTY PLANNING DEPARTMENT

1304 SOUTH 25TH STREET
EDINBURG TEXAS 78539
Tel. 956-318-2840 Fax. 956-318-2844

T.J. Arredondo, CFM
Director of Planning

HIDALGO COUNTY COMMISSIONERS COURT MEETING

DATE: 11-22-2016

PROPOSED DEL REY ESTATES UNIT 1 SUBDIVISION, PRECINCT No. 4.

ENGINEER: KK ENGINEERING DEVELOPER: KYNDEL W. BENNETT

PRELIMINARY APPROVAL FINAL APPROVAL FINAL APPROVAL WITH FINANCIAL GUARANTEE WITH VARIANCE

NUMBER OF LOTS: 44 *SINGLE FAMILY *MULTI-FAMILY 10 COMMERCIAL INSTITUTIONAL

LOCATION DESCRIPTION: NORTHWEST CORNER OF ALAMO ROAD [F.M. 907] AND CANTON ROAD.

SUBDIVISION LIES WITHIN THE: ETJ of EDINBURG and was approved by the P & Z and City Commission of said City

DRAINAGE REPORT WAS APPROVED BY HCDD#1: ON 5-11-2016 PROPERTY LIES WITHIN FLOOD ZONE: "B" AS PER FEMA.

DRAINAGE DESIGN: DRAINAGE WILL BE PROVIDED BY A STORM SEWER PIPE SYSTEM DISCHARGING TO THE EXISTING DRAIN DITCH ABUTTING THE NORTH LOT LINE OF THIS PROPOSED SUBDIVISION. DETENTION WILL BE ACCOMPLISHED BY WIDENING OF THE EXISTING DITCH.

ROAD R.O.W. DEDICATION: 10.00 FEET ON CANTON ROAD AND 20.00 FEET ON ALAMO ROAD (F.M. 907)

H.C.R.O.W. FINAL APPROVAL DATE: 10-08-2016 By, JOSE OCHOA, PCT. 4 R.O.W. AGENT

H.C.H.D. FINAL APPROVAL DATE: 11-08-2016 By, ELIZARDO "CHARDO" RAMOS Environmental Health Division Manager

SEWER SYSTEM: OSSF HAVE BEEN INSTALLED AND INSPECTED BY HCHD.

WATER SERVICE PROVIDER: NAWSC LINE SIZE: 8" LOCATION: NORTH SIDE OF CANTON ROAD AND EAST SIDE OF ALAMO ROAD (F.M. 907).

H.C.O.E.C. FINAL APPROVAL DATE: 11-04-2016 : By MARTIN RAMIREZ Environmental Compliance Coordinator

LARGE CONSTRUCTION

The applicant has submitted the required NOI as per Part II, Section E of the TPDES General Permit for Construction Activities (TXR150000) along with a copy of the Erosion Control Plan for the proposed project.

PRELIMINARY APPROVAL FROM THE
HIDALGO COUNTY COMMISSIONERS COURT ON: JULY 06, 2016

STAFF RECOMMENDS: Preliminary Approval subject to comments and future recommendations by planning, other departments and the approval of the City of EDINBURG.

Final Approval subject to recommendations other departments

This subdivision plat has been reviewed and complies with the Hidalgo County Subdivision Rules,

** Texas Water Development Board Model Subdivision Rules and The Texas Local Government Code.*

PLAT OF DEL REY ESTATES UNIT 1 SUBDIVISION

A 36.06 ACRE TRACT OF LAND OUT OF LOT 14, BLOCK 60, ALAMO LAND AND SUGAR COMPANY'S SUBDIVISION, AS RECORDED IN VOLUME 1, PAGES 24-26, DEED RECORDS, HIDALGO COUNTY, TEXAS.

PREPARED BY: K K ENGINEERING CONSULTANT
DATE: APRIL, 2016

STATE OF TEXAS COUNTY OF HIDALGO
OWNER'S DEDICATION, CERTIFICATION, AND ATTESTATION

DEL REY ESTATES UNIT 1, P. 6
AS OWNER OF THE 36.06 ACRES TRACT OF LAND ENCOMPASSED WITHIN THE PROPOSED DEL REY ESTATES UNIT 1 SUBDIVISION HEREBY SUBDIVIDE THE LAND AS DEPICTED IN THIS SUBDIVISION PLAT AND DEDICATE TO PUBLIC USE OF STREETS, PARKS, AND EASEMENTS SHOWN HEREIN.

I CERTIFY THAT I HAVE COMPLIED WITH THE REQUIREMENTS OF TEXAS LOCAL GOVERNMENT CODE §232.032 AND THAT:

- (A) THE WATER QUALITY AND CONNECTIONS TO THE LOTS MEET, OR WILL MEET, THE MINIMUM STATE STANDARDS;
- (B) SEWER CONNECTIONS TO THE LOTS OR SEPTIC TANKS MEET, OR WILL MEET, THE MINIMUM REQUIREMENTS OF STATE STANDARDS;
- (C) ELECTRICAL CONNECTIONS PROVIDED TO THE LOTS MEET, OR WILL MEET, THE MINIMUM STATE STANDARDS; AND
- (D) GAS CONNECTIONS, IF AVAILABLE, PROVIDED TO THE LOTS MEET, OR WILL MEET, THE MINIMUM STATE STANDARDS.

I ATTEST THAT THE MATTERS ASSERTED IN THIS PLAT ARE TRUE AND COMPLETE.

OWNER: DEL REY ESTATES L.P., a TEXAS LIMITED PARTNERSHIP
BY: KYNDEL W. BENNETT, PRESIDENT
P.O. BOX 365
LA BLANCA, TX 78558

STATE OF TEXAS COUNTY OF HIDALGO

BEFORE ME, THE UNDERSIGNED AUTHORITY ON THIS DAY PERSONALLY APPEARED KYNDEL W. BENNETT known to me to be the person (S) whose name (S) is (ARE) subscribed to the foregoing INSTRUMENT, AND ACKNOWLEDGED TO ME THAT HE (THEY) EXECUTED THE SAME FOR THE PURPOSES AND CONSIDERATIONS THEREIN EXPRESSED AND IN THE CAPACITY THEREIN STATED.

GIVEN UNDER MY HAND AND SEAL OF OFFICE, THIS THE ____ DAY OF _____, 20__.

NOTARY PUBLIC IN AND FOR THE STATE OF TEXAS
MY COMMISSION EXPIRES _____

MAYOR'S CERTIFICATION

I, THE UNDERSIGNED, MAYOR OF THE CITY OF EDINBURG, HEREBY CERTIFY THAT THIS SUBDIVISION PLAT CONFORMS TO ALL REQUIREMENTS OF THE SUBDIVISION REGULATIONS OF THE CITY HEREIN MY APPROVAL IS REQUIRED.

MAYOR'S SIGNATURE _____ DATE _____ ATTEST: _____ CITY SECRETARY _____ DATE _____

PLANNING & ZONING COMMISSION CERTIFICATION

I, THE UNDERSIGNED, CHAIRPERSON OF THE PLANNING AND ZONING COMMISSION OF THE CITY OF EDINBURG, HEREBY CERTIFY THAT THIS SUBDIVISION PLAT KNOWN AS DEL REY ESTATES UNIT 1 CONFORMS TO ALL REQUIREMENTS OF THE SUBDIVISION REGULATIONS OF THIS CITY WHEREIN MY APPROVAL IS REQUIRED AND HAS BEEN APPROVED FOR RECORDING ON THE ____ DAY OF _____, 20__.

HIDALGO COUNTY DRAINAGE DISTRICT NO. 1 HEREBY CERTIFIES THAT THE DRAINAGE PLANS FOR THIS SUBDIVISION COMPLY WITH THE MINIMUM STANDARDS OF THE DISTRICT ADOPTED UNDER TEX. WATER CODE §49.211(C). THE DISTRICT HAS NOT REVIEWED AND DOES NOT CERTIFY THAT THE DRAINAGE STRUCTURES DESCRIBED ARE APPROPRIATE FOR THE SPECIFIC SUBDIVISION, BASED ON GENERALLY ACCEPTED ENGINEERING CRITERIA. IT IS THE RESPONSIBILITY OF THE DEVELOPER OF THE SUBDIVISION AND ITS ENGINEER TO MAKE THESE DETERMINATIONS.

HIDALGO COUNTY DRAINAGE DISTRICT NO. 1
RAUL SESIN, P.E., C.F.M. GENERAL MANAGER
DATE _____ ATTEST: _____ SECRETARY _____

STATE OF TEXAS COUNTY OF HIDALGO
I, THE UNDERSIGNED, A REGISTERED PROFESSIONAL ENGINEER IN THE STATE OF TEXAS, HEREBY CERTIFY THAT PROPER ENGINEERING CONSIDERATION HAS BEEN GIVEN TO THIS PLAT.

I CERTIFY THAT THE WATER AND SEWER SERVICE FACILITIES FOR LOTS INTENDED FOR RESIDENTIAL PURPOSES DESCRIBED ABOVE ARE IN COMPLIANCE WITH THE MODEL RULES ADOPTED UNDER SECTION 16.343, WATER CODE. THE ESTIMATED COST TO INSTALL UNCONSTRUCTED WATER AND SEWAGE FACILITIES DESCRIBED ABOVE ARE AS FOLLOWS: WATER FACILITIES: THESE FACILITIES WILL BE CONSTRUCTED.

SEWER FACILITIES: (SEWER SERVICE CONNECTION/INSTALLATION OF SEPTIC SYSTEMS) ARE ESTIMATED TO COST \$1,500.00 PER LOT (ALL INCLUSIVE), FOR A TOTAL OF 44 LOTS FOR THIS SUBDIVISION. THE SUBDIVIDER HAS PAID A TOTAL OF \$66,000.00 TO CONTRACTOR (ALREADY INSTALLED) TO COVER THE COST OF (SEWER SERVICE CONNECTIONS/INSTALLATION OF SEPTIC SYSTEMS).

DATED THIS THE ____ DAY OF _____, 201__.

REGISTERED PROFESSIONAL ENGINEER
No. 52762 STATE OF TEXAS
KAMBIZ S. KHADEMI
57767
REGISTERED PROFESSIONAL ENGINEER

STATE OF TEXAS COUNTY OF HIDALGO
I, JOSE MARIO GONZALEZ, REGISTERED PROFESSIONAL LAND SURVEYOR IN THE STATE OF TEXAS, DO HEREBY CERTIFY THAT THIS PLAT IS TRUE AND CORRECTLY MADE FROM AN ACTUAL SURVEY MADE ON THE GROUND OF THE PROPERTY LEGALLY DESCRIBED HEREON, AND THAT THERE ARE NO APPARENT DISCREPANCIES, CONFLICTS, OR OVERLAPPING OF IMPROVEMENTS, VISIBLE UTILITY LINES OR READS IN PLACE, EXCEPT AS SHOWN ON THE ACCOMPANYING PLAT AND THAT THE CORNER MONUMENTS SHOWN THEREON WERE PROPERLY PLACED UNDER MY SUPERVISION IN ACCORDANCE WITH THE SUBDIVISION REGULATION OF THE CITY OF EDINBURG, TEXAS.

DATED THIS THE ____ DAY OF _____, 201__.

REGISTERED PROFESSIONAL SURVEYOR
No. 5521 STATE OF TEXAS
JOSE MARIO GONZALEZ
5571
REGISTERED PROFESSIONAL SURVEYOR

GENERAL SUBDIVISION PLAT NOTES

- MINIMUM FINISH FLOOR ELEVATION SHALL BE AT 24" ABOVE THE TOP OF THE STREET CURB WHEN MEASURED AT THE CENTER FRONT OF ALL LOTS. ELEVATION CERTIFICATE MAY BE REQUIRED FOR LOTS LOCATED OUTSIDE A DESIGNATED FLOOD ZONE AT THE TIME FOR APPLICATION FOR CONSTRUCTION TO VERIFY PRE AND POST CONSTRUCTION FINISH FLOOR ELEVATIONS. AN ELEVATION CERTIFICATE SHALL BE REQUIRED ALL LOTS WITHIN A DESIGNATED FLOOD ZONE AT THE TIME FOR A DEVELOPMENT PERMIT APPLICATION.
- THIS SUBDIVISION IS LOCATED IN: ZONE "B" (MEDIUM SHADED) FEMA FIRM COMMUNITY PANEL No. 480334 0425 C REVISED NOVEMBER 16, 1982.

AREAS BETWEEN LIMITS OF THE 100-YEAR FLOOD AND 500-YEAR FLOOD; OR CERTAIN AREAS SUBJECT TO 100-YEAR FLOODING WITH AVERAGE DEPTHS LESS THAN ONE (1) FOOT OR WHERE THE CONTRIBUTING DRAINAGE AREA IS LESS THAN ONE SQUARE MILE, OR AREAS PROTECTED BY LEVEES FROM THE BASE FLOOD.

- CONSTRUCTION OF RESIDENTIAL HOUSING WITHIN ANY AREA OF THE SUBDIVISION THAT IS IN THE 100-YEAR FLOOD PLAIN IS PROHIBITED UNLESS THE HOUSING QUALIFIES FOR INSURANCE UNDER THE NATIONAL FLOOD INSURANCE ACT OF 1968 (42 U.S.C. SECTIONS 4001 THROUGH 4127).
- SETBACKS:
FRONT: 25.00 FEET
FRONT ALAMO RD. 60.00 FEET (FM 907)
FRONT CANTON ROAD. 40.00 FEET FOR LOT 1 ONLY
REAR: 15.00 FEET OR EASEMENT WHICHEVER IS GREATER
CORNER SIDE: 15.00 FEET
CORNER SIDE ALAMO RD: 10.00 FEET
GARAGE FRONT: 18.00 FEET
SIDE: 6.00 FEET OR EASEMENT WHICHEVER IS GREATER

4. GENERAL NOTE FOR SINGLE FAMILY RESIDENCES:
NO MORE THAN ONE SINGLE-FAMILY DETACHED DWELLING SHALL BE LOCATED ON EACH LOT. THIS MUST BE STIPULATED ON ALL DEEDS AND CONTRACTS FOR DEEDS APPLICATIONS FOR CONSTRUCTION ARE REQUIRED PRIOR TO OCCUPANCY OF THE LOT. NO COMMERCIAL SHALL BE ALLOWED FOR LOTS 11-54.

5. LOTS 1 THROUGH 10 SHALL BE FOR COMMERCIAL USE ONLY. THERE SHALL BE NO OTHER USE OTHER THAN COMMERCIAL. LOTS 1 THROUGH 10 ARE FOR NON RESIDENTIAL USE. THIS MUST BE STIPULATED ON ALL DEEDS AND CONTRACTS FOR DEEDS. A BUFFER FENCE IS REQUIRED TO BE INSTALLED BY DEVELOPER ALONG ALL ADJUTING RESIDENTIAL LOTS. APPLICATION FOR CONSTRUCTION IS REQUIRED BY PLANNING, HEALTH, AND FIRE MARSHALL DEPARTMENTS PRIOR TO OCCUPANCY OF THE LOT.

6. NO INDIVIDUAL LOT DRIVEWAY ACCESS WILL BE ALLOWED FROM ALAMO ROAD (FM 907) ON TO LOTS 1 THROUGH 10. A 40 FOOT SHARED DRIVEWAY ENTRANCE SHALL BE CONSTRUCTED BY DEVELOPER BETWEEN LOTS 1 & 2 AND IN FRONT OF LOT 6. A 30 FOOT INGRESS AND EGRESS EASEMENT WILL BE DEDICATED BY THIS PLAT TO PROVIDE INGRESS AND EGRESS FOR LOTS 1 & 2 AND LOTS 3 THROUGH 10. THE 30 FOOT ACCESS EASEMENT SHALL BE MAINTAINED BY OWNERS OF LOTS 1 & 2 AND LOTS 3 THROUGH 10.

7. CORNER MARKERS, CONSISTING OF A ONE-HALF (1/2) INCH STEEL ROD 18 INCHES IN LENGTH, WITH PLASTIC CAP STAMPED "RIO DELTA SURVEYING", HAVE BEEN DRIVEN FLUSH WITH THE GROUND SURFACE TO MARK THE CORNERS OF ALL LOTS.

8. THE FOLLOWING BENCHMARKS ARE IDENTIFIED ON THE FACE OF THE PLAT AND ON THE ATTACHED ENGINEERING PLANS.

- SBM NO. 1--ELEV. 89.60 ON TOP OF A STORM DRAINAGE TYPE "A" INLET SOUTH EAST CORNER OF LOT 47 (NAVD 1988)
- SBM NO. 2--ELEV. 92.018 SQUARE CUT AT S.W. CORNER OF BRIDGE CONC BARRIER. (NAVD 1988)

9. IN ACCORDANCE WITH THE HIDALGO COUNTY DRAINAGE DISTRICT NO. 1 AND HIDALGO COUNTY REQUIREMENTS, THIS DEVELOPMENT WILL BE REQUIRED TO OBTAIN A TOTAL OF \$5,202.00 CUBIC-FEET (1.50 ACRE-FEET) OF STORM WATER RUNOFF, DRAINAGE RETENTION IN ACCORDANCE WITH THE LOCAL REQUIREMENTS WILL BE ACCOMPLISHED AS FOLLOWS: (SEE SHEET NO.3 FOR STORM SEWER IMPROVEMENTS.)

10. NO STRUCTURE SHALL BE PERMITTED UNDER ANY EASEMENT. EASEMENTS SHALL BE KEPT CLEAR OF BUILDINGS, SHEDS, SHRUBS TREES, AND OTHER PLANTINGS (EXCEPT LUSH, LESS THAN 18 INCHES MATURE HEIGHT, GROUND COVER, GRASS, OR FLOWERS) AND OTHER OBSTRUCTIONS THAT WOULD INTERFERE WITH THE OPERATIONS AND MAINTENANCE OF THE EASEMENT.

11. EACH PURCHASED CONTRACT MADE BETWEEN A SUBDIVIDER AND PURCHASER OF A LOT IN THIS SUBDIVISION SHALL CONTAIN A STATEMENT DESCRIBING HOW AND WHEN WATER, SEWER, ELECTRICITY, AND GAS SERVICES WILL BE MADE AVAILABLE TO THE SUBDIVISION.

12. ALL PUBLIC UTILITIES EASEMENTS DEDICATED BY THIS PLAT SHALL BE A MINIMUM WIDTH OF 15.00 FEET AS PER THE HIDALGO COUNTY MODEL SUBDIVISION RULES. BY SIGNING THIS PLAT, DEVELOPER AND ENGINEER CERTIFY THAT ALL OTHER EASEMENTS SHOWN COMPLY WITH THE SIZE REQUIRED BY EACH UTILITY PROVIDER OCCUPANCY AN EASEMENT.

13. AN OFF-STREET PARKING LOT SITE PLAN & DRAINAGE PLAN APPROVED BY THE HIDALGO COUNTY PLANNING DEPARTMENT AND THE OFFICE OF ENVIRONMENTAL COMPLIANCE SHALL BE REQUIRED FOR COMMERCIAL USE AT THE TIME OF APPLICATION FOR CONSTRUCTION PRIOR TO THE ISSUANCE OF A BUILDING AND/OR DEVELOPMENT PERMIT. NO WATER OR LIGHT CLEARANCES SHALL BE ISSUED UNTIL THE SITE PLAN, DRAINAGE PLAN AND OSSF PLAN ARE APPROVED AND PROPOSED IMPROVEMENTS ARE CONSTRUCTED IN ACCORDANCE WITH COUNTY AND STATE STANDARDS.

14. ON-SITE SEWAGE FACILITIES (OSSF) NOTE: THIS SUBDIVISION SHALL USE ON-SITE SEWAGE FACILITIES IN ACCORDANCE WITH TCEQ AND HIDALGO COUNTY REGULATIONS FOR SEWAGE DISPOSAL. THE SUBDIVIDER IS RESPONSIBLE FOR PROVIDING AN OSSF ON ALL LOTS.

A. OSSF SYSTEM IS BEING DESIGNED FOR DISPOSAL OF DOMESTIC SEWAGE ONLY. A SEPARATE DESIGN SHALL BE SUBMITTED FOR COMMERCIAL USE. (EXCEPT COMMERCIAL ONLY LOTS 1 THROUGH 10)

B. EACH LOT ON THIS PLAT COMPLIES WITH THE MINIMUM 21,780 SQUARE FEET LOT AREA WITH POTABLE WATER SUPPLY.

C. OSSF SYSTEM SHALL REQUIRE INSPECTION AND APPROVAL BY HIDALGO COUNTY AUTHORIZED DEPARTMENT

D. SOIL ANALYSIS HAVE BEEN SUBMITTED TO THE AUTHORIZED HIDALGO COUNTY DEPARTMENT AND EXPERTS MAY BE ALSO SEEN ON THE UTILITY LAYOUT FOR THIS SUBDIVISION AS SUBMITTED TO THE HIDALGO COUNTY PLANNING DEPARTMENT. THE ENGINEER HAS DETERMINED THAT THE SOIL IS SUITABLE FOR A STANDARD SEPTIC TANK AND ABSORPTIVE DRAINFIELD SYSTEM.

E. APPROVED "OSSF" PERMIT APPLICATION IS REQUIRED INCLUDING INDIVIDUAL LOT PLANNING MATERIALS PRIOR TO OCCUPANCY A LOT.

15. THERE ARE NO WATER WELLS WITHIN 150 FEET FROM THE BOUNDARIES ON THIS SUBDIVISION

16. KYNDEL W. BENNETT, THE OWNER & SUBDIVIDER OF DEL REY ESTATES UNIT 1 SUBDIVISION, RETAINS A BLANKET EASEMENT UPON EACH LOT FOR THE PURPOSE OF INSTALLING AN APPROVED OSSF ON THE LOT AS DESCRIBED ON SHEET NO.2 OF THIS PLAT.

17. ALL CONSTRUCTION SHALL COMPLY WITH STORM WATER POLLUTION PREVENTION PLAN (SW3P) REQUIREMENTS.

18. NO ACCESS SHALL BE ALLOWED FROM CANTON ROAD ONTO LOTS 11, 36, 37 & 54.

19. STREET & STOP SIGNS WILL BE INSTALLED BY THE DEVELOPER.

20. A 4.0 FT SIDEWALK IS REQUIRED AT BUILDING PERMIT STAGE, AS PER CITY OF EDINBURG, ALONG ALL INTERNAL STREETS.

21. A 5.0 FT SIDEWALK IS REQUIRED AT BUILDING PERMIT STAGE, AS PER CITY OF EDINBURG, ALONG ALAMO ROAD AND CANTON ROAD.

22. FIRE HYDRANTS WILL BE INSTALLED & PAINTED BLACK BY THE DEVELOPER.

23. STREET LIGHT WILL BE INSTALLED BY THE COUNTY.

24. ALL LOTS SHALL HAVE A POST DEVELOPMENT FINISHED GRADE FROM THE REAR OF THE LOT TO THE CURB AND/OR ROADSIDE DITCH AT A 0.5 % SLOPE TO ACCOMPLISH POSITIVE DRAINAGE. THIS IS IN ACCORDANCE WITH HIDALGO COUNTY APPENDIX 5: COUNTY CONSTRUCTION SPECIFICATIONS 3.1.4.

METES AND BOUNDS

A 36.06 ACRE TRACT OF LAND OUT OF LOT 14, BLOCK 60, ALAMO LAND AND SUGAR COMPANY'S SUBDIVISION, AS RECORDED IN VOLUME 1, PAGES 24-26, DEED RECORDS, HIDALGO COUNTY, TEXAS AND SAID 36.06 ACRE TRACT IS BEING MORE PARTICULARLY DESCRIBED BY METES AND BOUNDS AS FOLLOWS:
COMMENCING ON THE NORTHWEST CORNER OF SAID LOT 14, BEING WITHIN A DRAINAGE DITCH, THENCE: S 08°31'51" W, WITH THE WEST LINE OF SAID LOT 14, A DISTANCE OF 1320.00' TO A 5" IRON ROD SET ON THE SOUTH LINE OF SAID DRAINAGE DITCH, FOR THE NORTHWEST CORNER OF THIS TRACT OF LAND; AND THE POINT OF BEGINNING;

THENCE S 81°28'09" E, WITH THE SOUTH LINE OF SAID DRAINAGE DITCH, AT A DISTANCE OF 1280.00' PASS A 1/2" IRON ROD W/ A RED CAP STAMPED "RIO DELTA SURVEYING" SET ON THE WEST RIGHT OF WAY LINE OF ALAMO ROAD, AS RECORDED IN VOLUME 861, PAGE 478, DEED RECORDS, HIDALGO COUNTY, TEXAS, CONTINUING A TOTAL DISTANCE OF 1320.00' TO A NAIL SET AT THE NORTHEAST CORNER OF SAID LOT 14, FOR THE NORTHEAST CORNER OF THIS TRACT OF LAND;

THENCE S 08°31'51" W, WITH THE EAST LINE OF SAID LOT 14 AND WITHIN THE RIGHT OF WAY OF SAID ALAMO ROAD, A DISTANCE OF 1190.00' TO A NAIL SET AT THE SOUTHWEST CORNER OF SAID LOT 14 IN THE INTERSECTION OF SAID ALAMO ROAD AND CANTON ROAD AS RECORDED IN VOLUME 1, PAGE 24, DEED RECORDS, HIDALGO COUNTY, TEXAS, FOR THE SOUTHWEST CORNER OF THIS TRACT OF LAND;

THENCE N 81°28'09" W, WITH THE SOUTH LINE OF SAID LOT 14 WITHIN THE RIGHT OF WAY OF SAID CANTON ROAD, A DISTANCE OF 1320.00' TO A NAIL SET AT THE SOUTHWEST CORNER OF SAID LOT 14 AND THE SOUTHEAST CORNER OF RINCON DE ENCINO SUBDIVISION NO. 2, AS RECORDED IN VOLUME 30, PAGE 167, MAP RECORDS, HIDALGO COUNTY, TEXAS, FOR THE SOUTHWEST CORNER OF THIS TRACT OF LAND;

THENCE N 08°31'51" E, WITH THE COMMON LINE OF SAID LOT 14 AND SAID RINCON DE ENCINO SUBDIVISION NO. 2, AT A DISTANCE OF 30.00' PASS A 1/2" IRON ROD W/ A RED CAP STAMPED "RIO DELTA SURVEYING" SET ON THE NORTH RIGHT OF WAY LINE OF SAID CANTON ROAD, CONTINUING A TOTAL DISTANCE OF 1190.00' TO THE POINT OF BEGINNING, CONTAINING 36.06 ACRES OF LAND, LESS 1.97 ACRES OF ROAD, LEAVING 34.09 ACRES MORE OR LESS.

RIGHT OF WAY EASEMENT

KNOW ALL MEN BY THESE PRESENTS, THAT the undersigned, owners of the property shown on this plat, their successors, assigns, and transferees (hereinafter called "Grantor" whether one or more persons are named), in consideration of one dollar (\$1.00) and other good and valuable consideration paid by North Alamo Water Supply Corporation, (hereinafter called "Grantee"), the receipt and sufficiency of which is hereby acknowledged, does hereby grant, bargain, sell, transfer, and convey to said Grantee, its successors, and assigns, an exclusive perpetual easement with the right to erect, construct, install and lay thereafter use, operate, inspect, repair, maintain, replace, improve, substitute water distribution lines and appurtenances over and across the lands shown on this plat, together with the right of ingress and egress over Grantor's adjacent lands for the purpose for which the above mentioned rights are granted. The easement hereby granted shall not exceed 15' in width, and Grantee is hereby authorized to designate the course of the easement herein conveyed except that when the pipeline(s) is installed, the easement herein granted shall be limited to a strip of land 15' in width, the center line thereof being the pipeline installed.

In the event the easement hereby granted abuts on a public road and the city, county or state hereafter widens or relocates the public road so as to require the relocation of this water line as installed, Grantor further grants to Grantee an additional easement over and across the land shown on this plat for the purpose of laterally relocating said water line as may be necessary to clear the road improvements, which easement hereby granted shall be limited to a strip of land 15' in width, the center line thereof being the pipeline as relocated.

The consideration recited herein shall constitute payment in full for all damages sustained by Grantor by reason of the installation, maintenance, repair, replacement and relocation of the structures referred to herein. This agreement together with other provisions of this grant shall constitute an easement for the benefit of the Grantee, its successors, and assigns. The Grantor covenants that it is the owner of the above-described lands and that said lands are free and clear of all encumbrances and liens except the following:

The easement conveyed herein was obtained or improved through Federal financial assistance. This easement is subject to the provisions of Title VI of the Civil Rights Act of 1964 and the regulations issued pursuant thereto for so long as the easement continues to be used for the same or similar purpose for which financial assistance was extended or for so long as the Grantee owns it, whichever is longer.

IN WITNESS WHEREOF the said Grantor executed this instrument this ____ day of _____, 20__.

KYNDEL W. BENNETT, PRESIDENT
P.O. BOX 365
LA BLANCA ROAD, TX 78558

HIDALGO COUNTY CERTIFICATE OF PLAT APPROVAL

I THE UNDERSIGNED CERTIFY THAT THIS PLAT OF DEL REY ESTATES UNIT 1 SUBDIVISION WAS REVIEWED AND APPROVED BY THE HIDALGO COUNTY HEALTH DEPARTMENT ON _____.

HIDALGO COUNTY ENVIRONMENTAL HEALTH DIVISION MANAGER _____ DATE _____

THIS PLAT IS HEREBY APPROVED BY THE HIDALGO COUNTY IRRIGATION DISTRICT NO. 2 ON THIS, THE ____ DAY OF _____, 201__.

NO IMPROVEMENTS OF ANY KIND (INCLUDING WITHOUT LIMITATION, TREES, FENCES, AND BUILDINGS) SHALL BE PLACED UPON HIDALGO COUNTY IRRIGATION DISTRICT #2 RIGHT-OF-WAYS OR EASEMENTS.

HIDALGO COUNTY JUDGE _____ DATE _____

ATTEST: HIDALGO COUNTY CLERK _____ DATE _____

STATE OF TEXAS COUNTY OF HIDALGO

UNDER LOCAL GOVERNMENT CODE § 232.028(a)
WE THE UNDERSIGNED CERTIFY THAT THIS PLAT OF THE DEL REY ESTATES UNIT 1 SUBDIVISION WAS REVIEWED AND APPROVED BY THE HIDALGO COUNTY COMMISSIONERS COURT ON _____.

HIDALGO COUNTY JUDGE _____ DATE _____

ATTEST: HIDALGO COUNTY CLERK _____ DATE _____



FILED FOR RECORD IN HIDALGO COUNTY
ARTURO GUJARDO, JR.
HIDALGO COUNTY CLERK


ON: _____ AT _____ AM/PM

INSTRUMENT NUMBER _____ OF THE MAP RECORDS OF HIDALGO COUNTY, TEXAS


BY: _____ DEPUTY

REVISION _____ DATE _____ BY _____

SHEET 1 OF 3

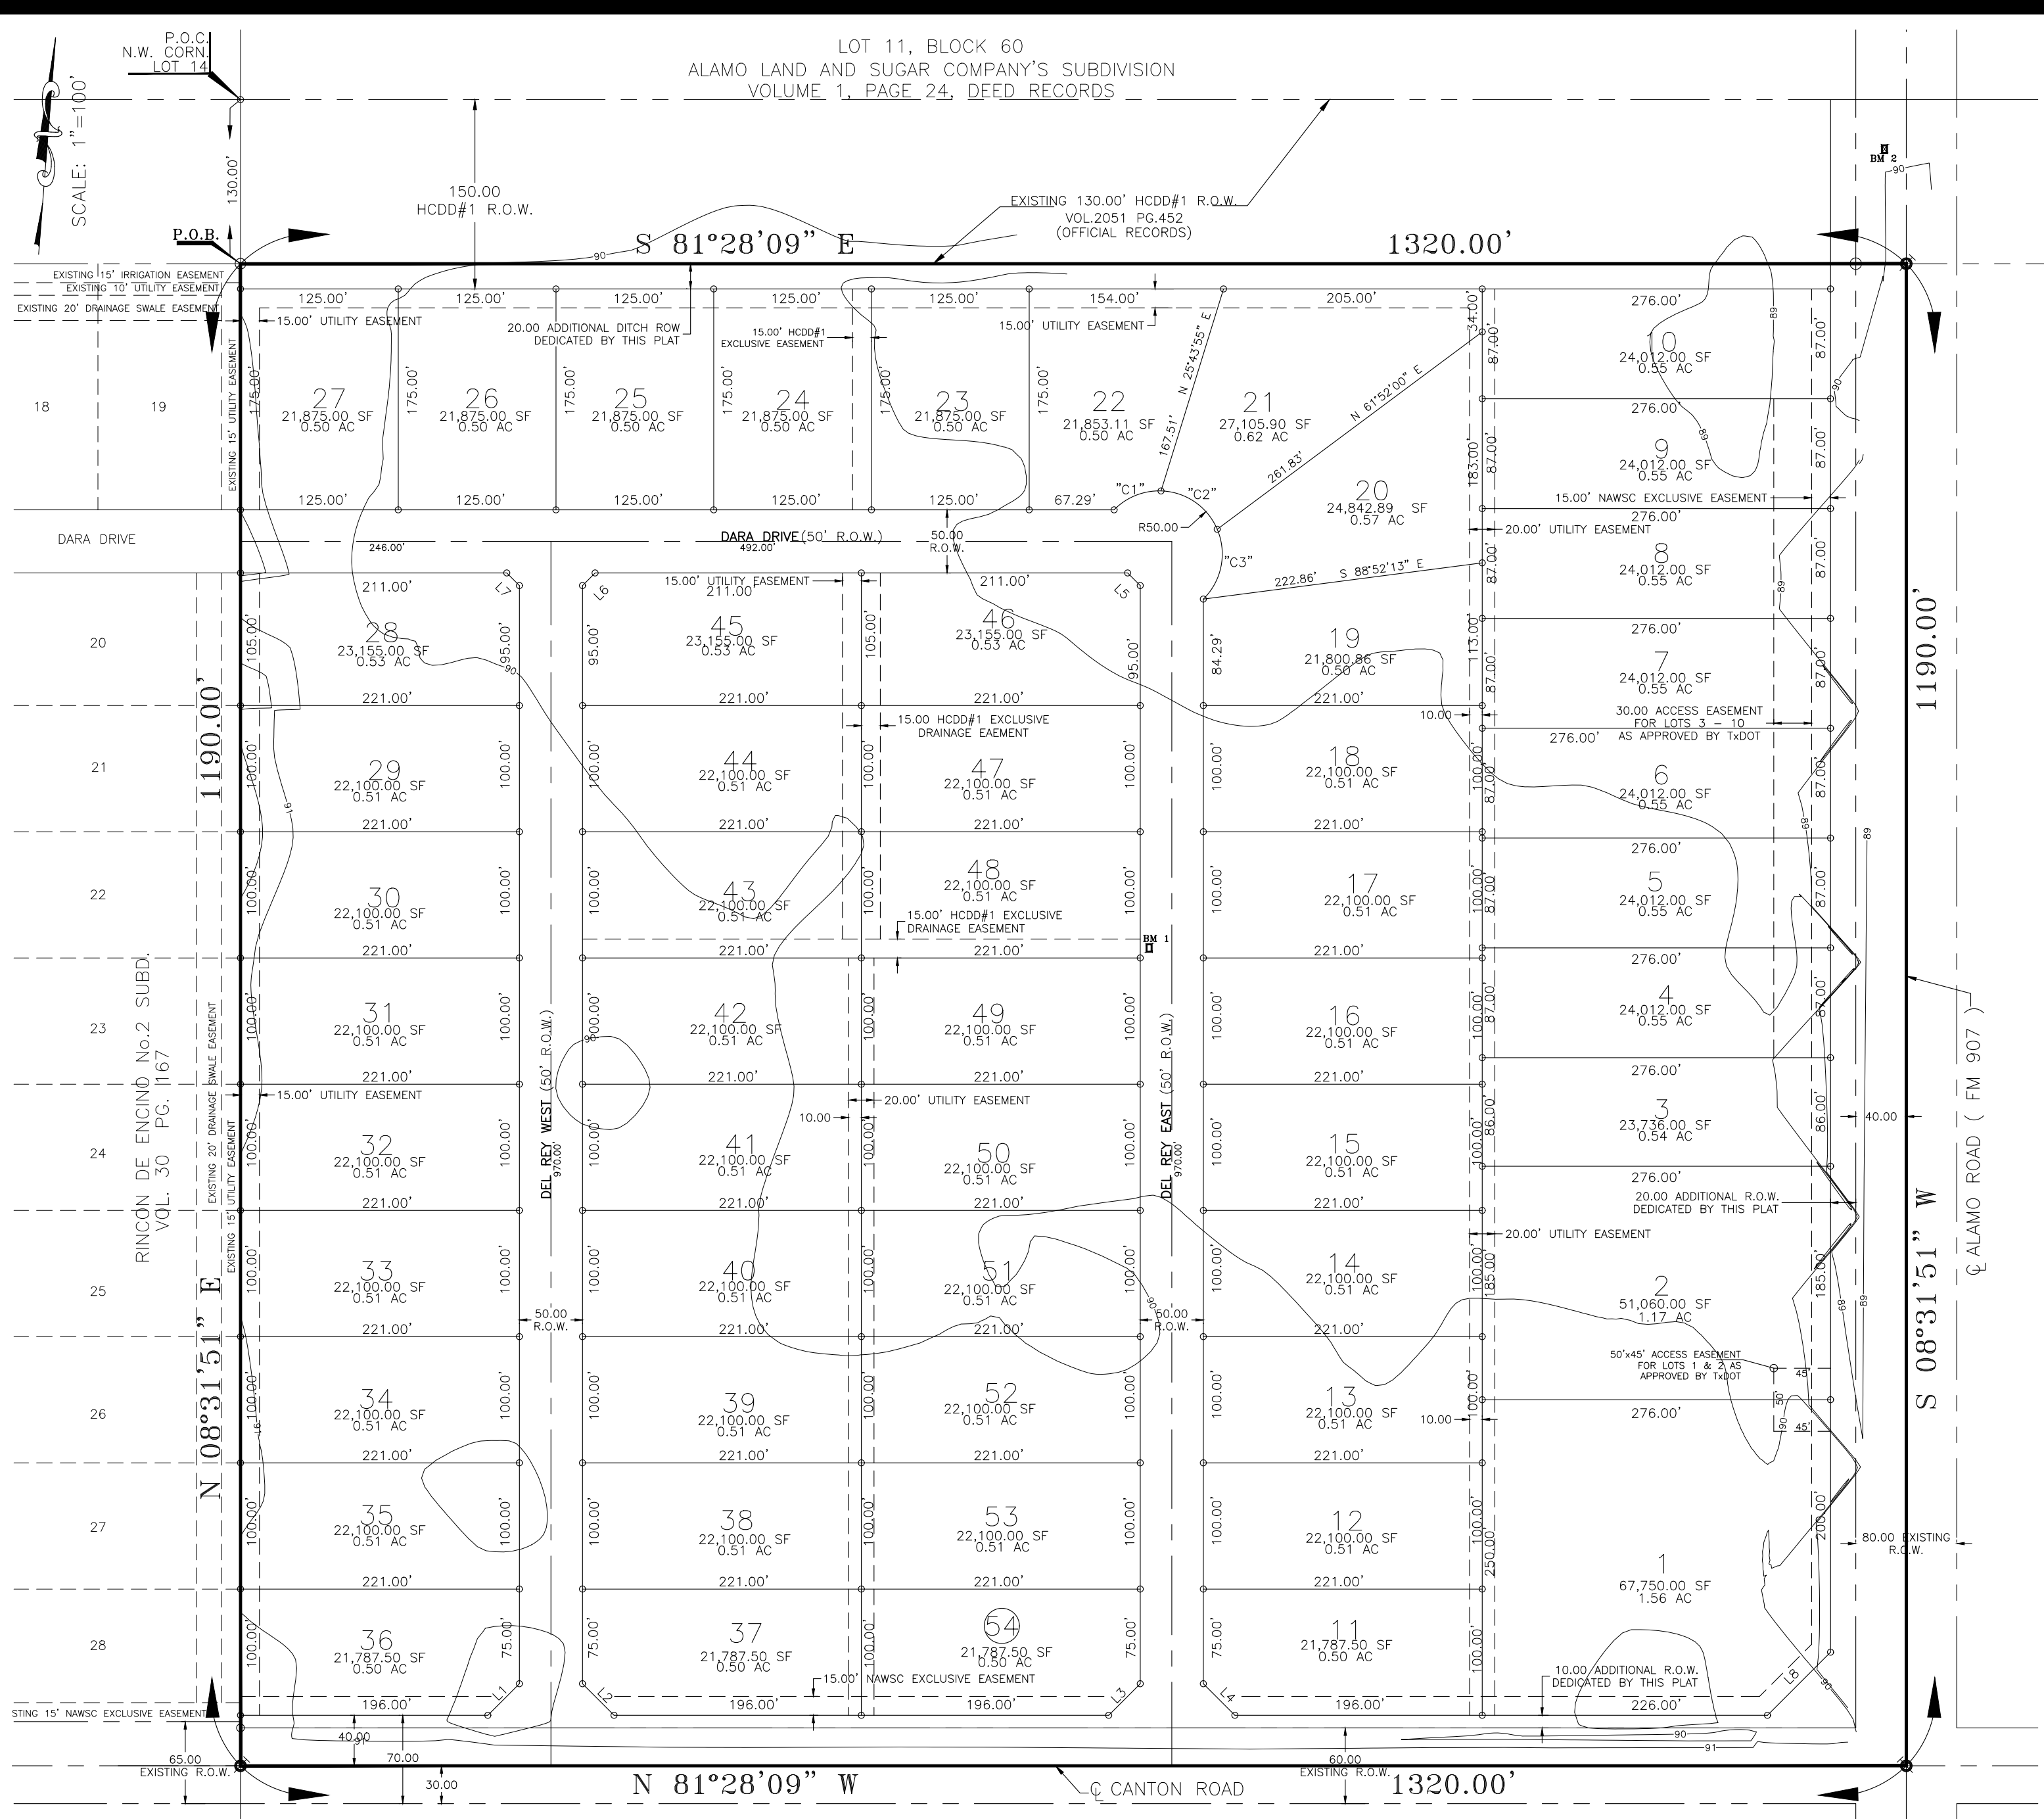

LOCATION MAP

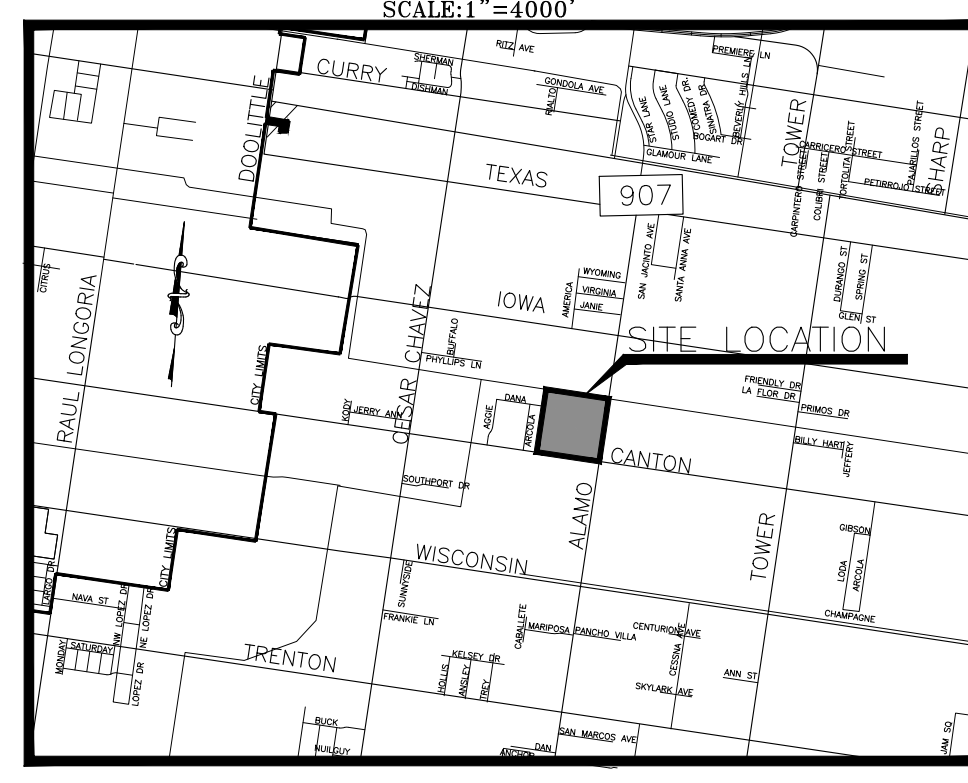

LOCATION OF SUBDIVISION WITH RESPECT TO THE EXTRATERRITORIAL JURISDICTION OF A MUNICIPALITY:
DEL REY ESTATES UNIT 1 LOCATED NORTH WEST CORNER OF ALAMO ROAD AND CANTON ROAD, THE ONLY NEARBY MUNICIPALITY IS THE CITY OF EDINBURG, ACCORDING TO THE OFFICIAL MAP IN THE OFFICES OF THE SECRETARY OF THE CITY OF EDINBURG (POPULATION 72,100 - 2010 CENSUS), AND HIDALGO COUNTY PLANNING DEPARTMENT. THIS SUBDIVISION LIES IN A 2 MILE EXTRATERRITORIAL JURISDICTION (ETJ) OF THE CITY OF EDINBURG. LOCAL GOVERNMENT CODE 212.001 PRECINCT. NO. 4.

K K Engineering Consultant
GENERAL PROFESSIONAL CIVIL ENGINEERING SERVICES
410 E. DOVE (FIRM REGISTRATION #1334)
P.O. BOX 3422 McALLEN, TEXAS 78502
(956) 630-2125 FAX (956) 630-2219

CURVE TABLE

CURVE	ARC LENGTH	RADIUS	DELTA	CHORD BEARING	CHORD LENGTH
C1	41.23'	50.00	47°14'54"	S 76°34'55" W	40.07'
C2	56.88'	50.00	65°10'36"	N 47°12'20" W	53.86'
C3	59.97'	50.00	68°43'16"	N 19°44'36" E	56.44'

LINE DATA TABLE






LINE	LENGTH	DELTA
L1	35.36'	S 53°31'51" W
L2	35.36'	N 36°28'09" W
L3	35.36'	N 53°31'51" E
L4	35.36'	S 36°28'09" E
L5	14.14'	N 36°28'09" W
L6	14.14'	S 53°31'51" W
L7	14.14'	N 36°28'09" W
L8	70.71'	S 53°31'51" W

LEGEND
 NAIL SET
 1/2" IRON ROD SET

INDEX TO SHEETS OF DEL REY ESTATES UNIT 1 SUBDIVISION

SHEET	DESCRIPTION
SHEET 1	HEADING; INDEX; LOCATION MAP; AND ETJ; PRINCIPAL CONTACTS; PLAT WITH LOT, STREETS, AND EASEMENT DESIGNATIONS; LEGAL DESCRIPTION (METES AND BOUNDS); SURVEYOR'S AND ENGINEER'S CERTIFICATION; PLAT NOTES AND RESTRICTIONS; OWNER'S DEDICATION, CERTIFICATION, AND ATTESTATION; CITY APPROVAL CERTIFICATE; COUNTY CLERK'S RECORDING CERTIFICATE; HIDALGO COUNTY JUDGE CERTIFICATE OF PLAT APPROVAL; DESCRIPTION OF LOCATION OF SUBDIVISION WITH RESPECT TO THE ETJ OF A MUNICIPALITY AND DESIGNATE THE PRECINCT THE PROJECT IS SITUATED; H.C.D.D. NO. 1 CERTIFICATION; H.C.IRRIGATION DISTRICT 2, AND H.C.H.D. REVISION NOTES.
SHEET 2	WATER DISTRIBUTION AND SANITARY SEWER MAP; TYPICAL WATER SERVICE CONNECTION; REVISION NOTES; ENGINEERING REPORT (ENGLISH AND SPANISH VERSION), INCLUDING DESCRIPTION OF WATER AND WASTE WATER AND ENGINEER'S CERTIFICATION (ENGLISH AND SPANISH VERSION); OWNER'S DEDICATION, CERTIFICATION, AND ATTESTATION; WATER DISTRIBUTION AND OSSF MAP; TYPICAL WATER SERVICE CONNECTION
SHEET 3	DRAINAGE REPORT INCLUDING DESCRIPTION OF DRAINAGE AND HOW IT WILL SERVE THIS DEVELOPMENT; MAP OF TOPOGRAPHY AND DRAINAGE, AND ENGINEER'S CERTIFICATION; REVISION NOTES; & CONSTRUCTION DETAILS.

PRINCIPAL CONTACTS:
 Name Address City & Zip Phone Fax
 OWNER: KYNDEL W. BENNETT, BENNETT-FLORES INVESTMENTS, LLC P.O. BOX 365 LA BLANCA TEXAS 78558 (956) 464-4431 (956) 464-2597
 ENGINEER: KAMBIZ S. KHADEMI P.E. 410 E. DOVE AVE. McALLEN 78504 (956) 630-2125 (956) 630-2219
 SURVEYOR: JOSE MARIO GONZALEZ R.P.L.S. 24593 FM88 MONTE ALTO TEXAS 78538 (956) 380-5154 (956) 380-5156

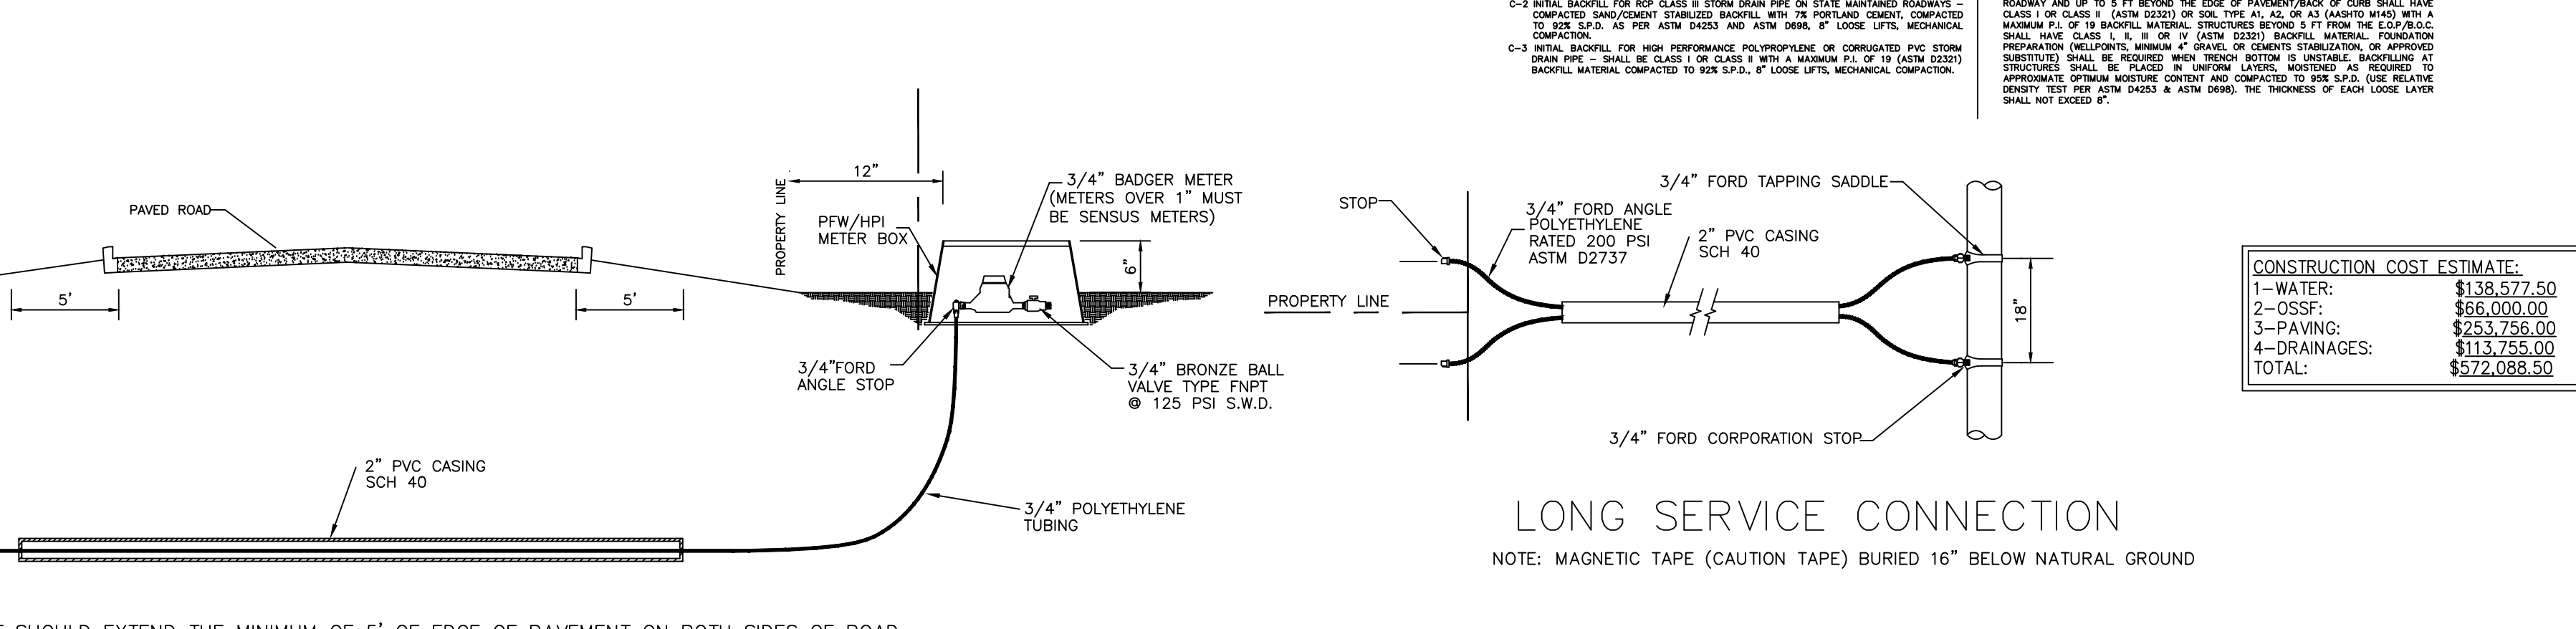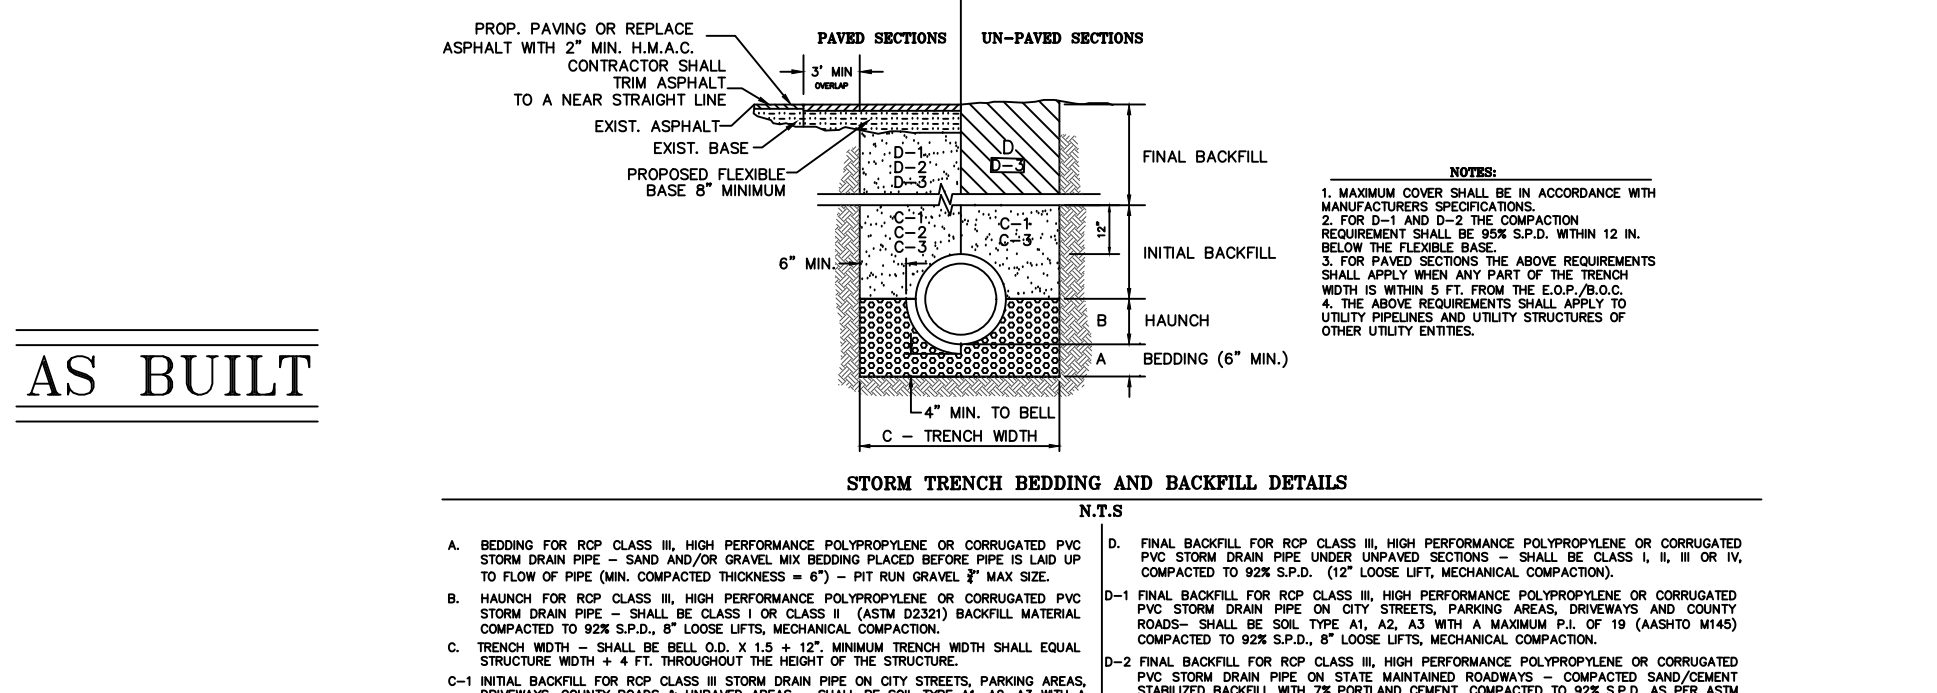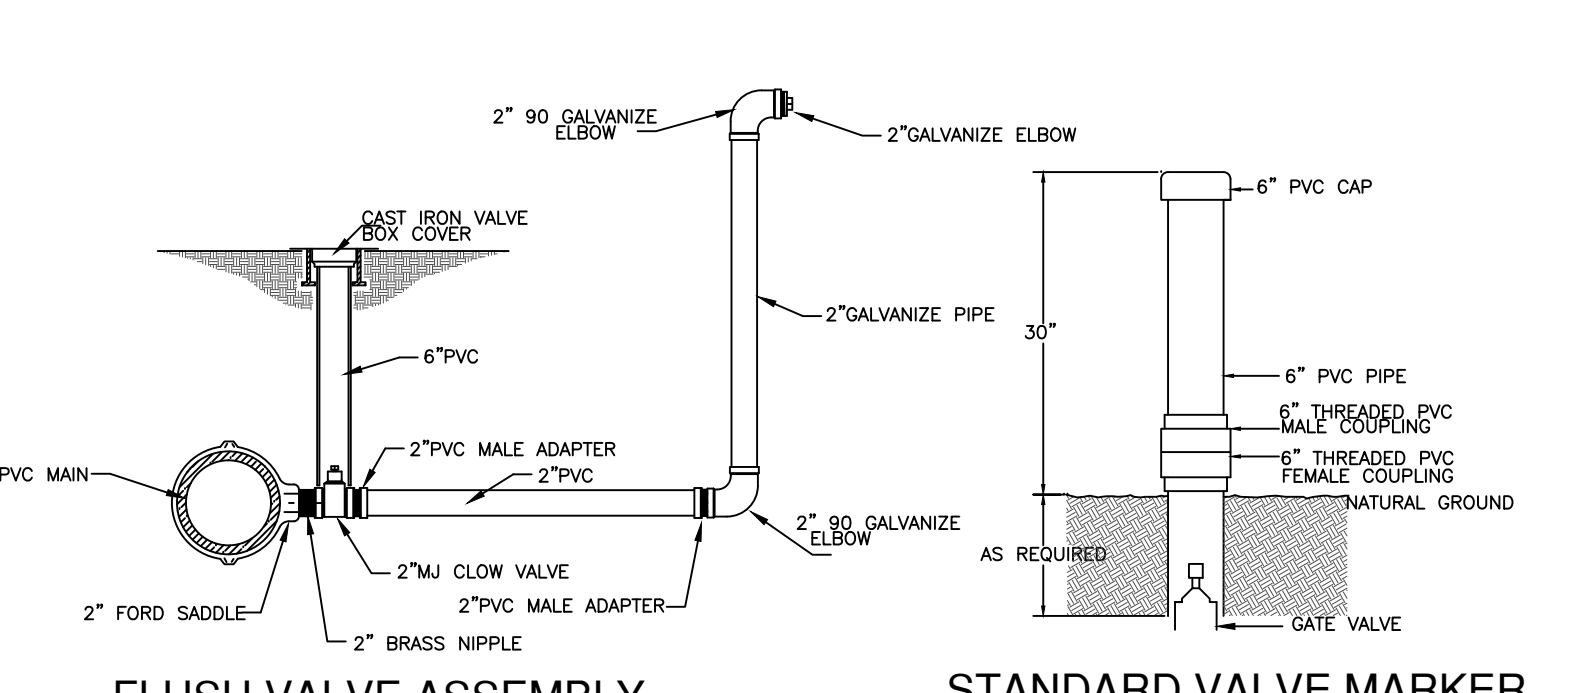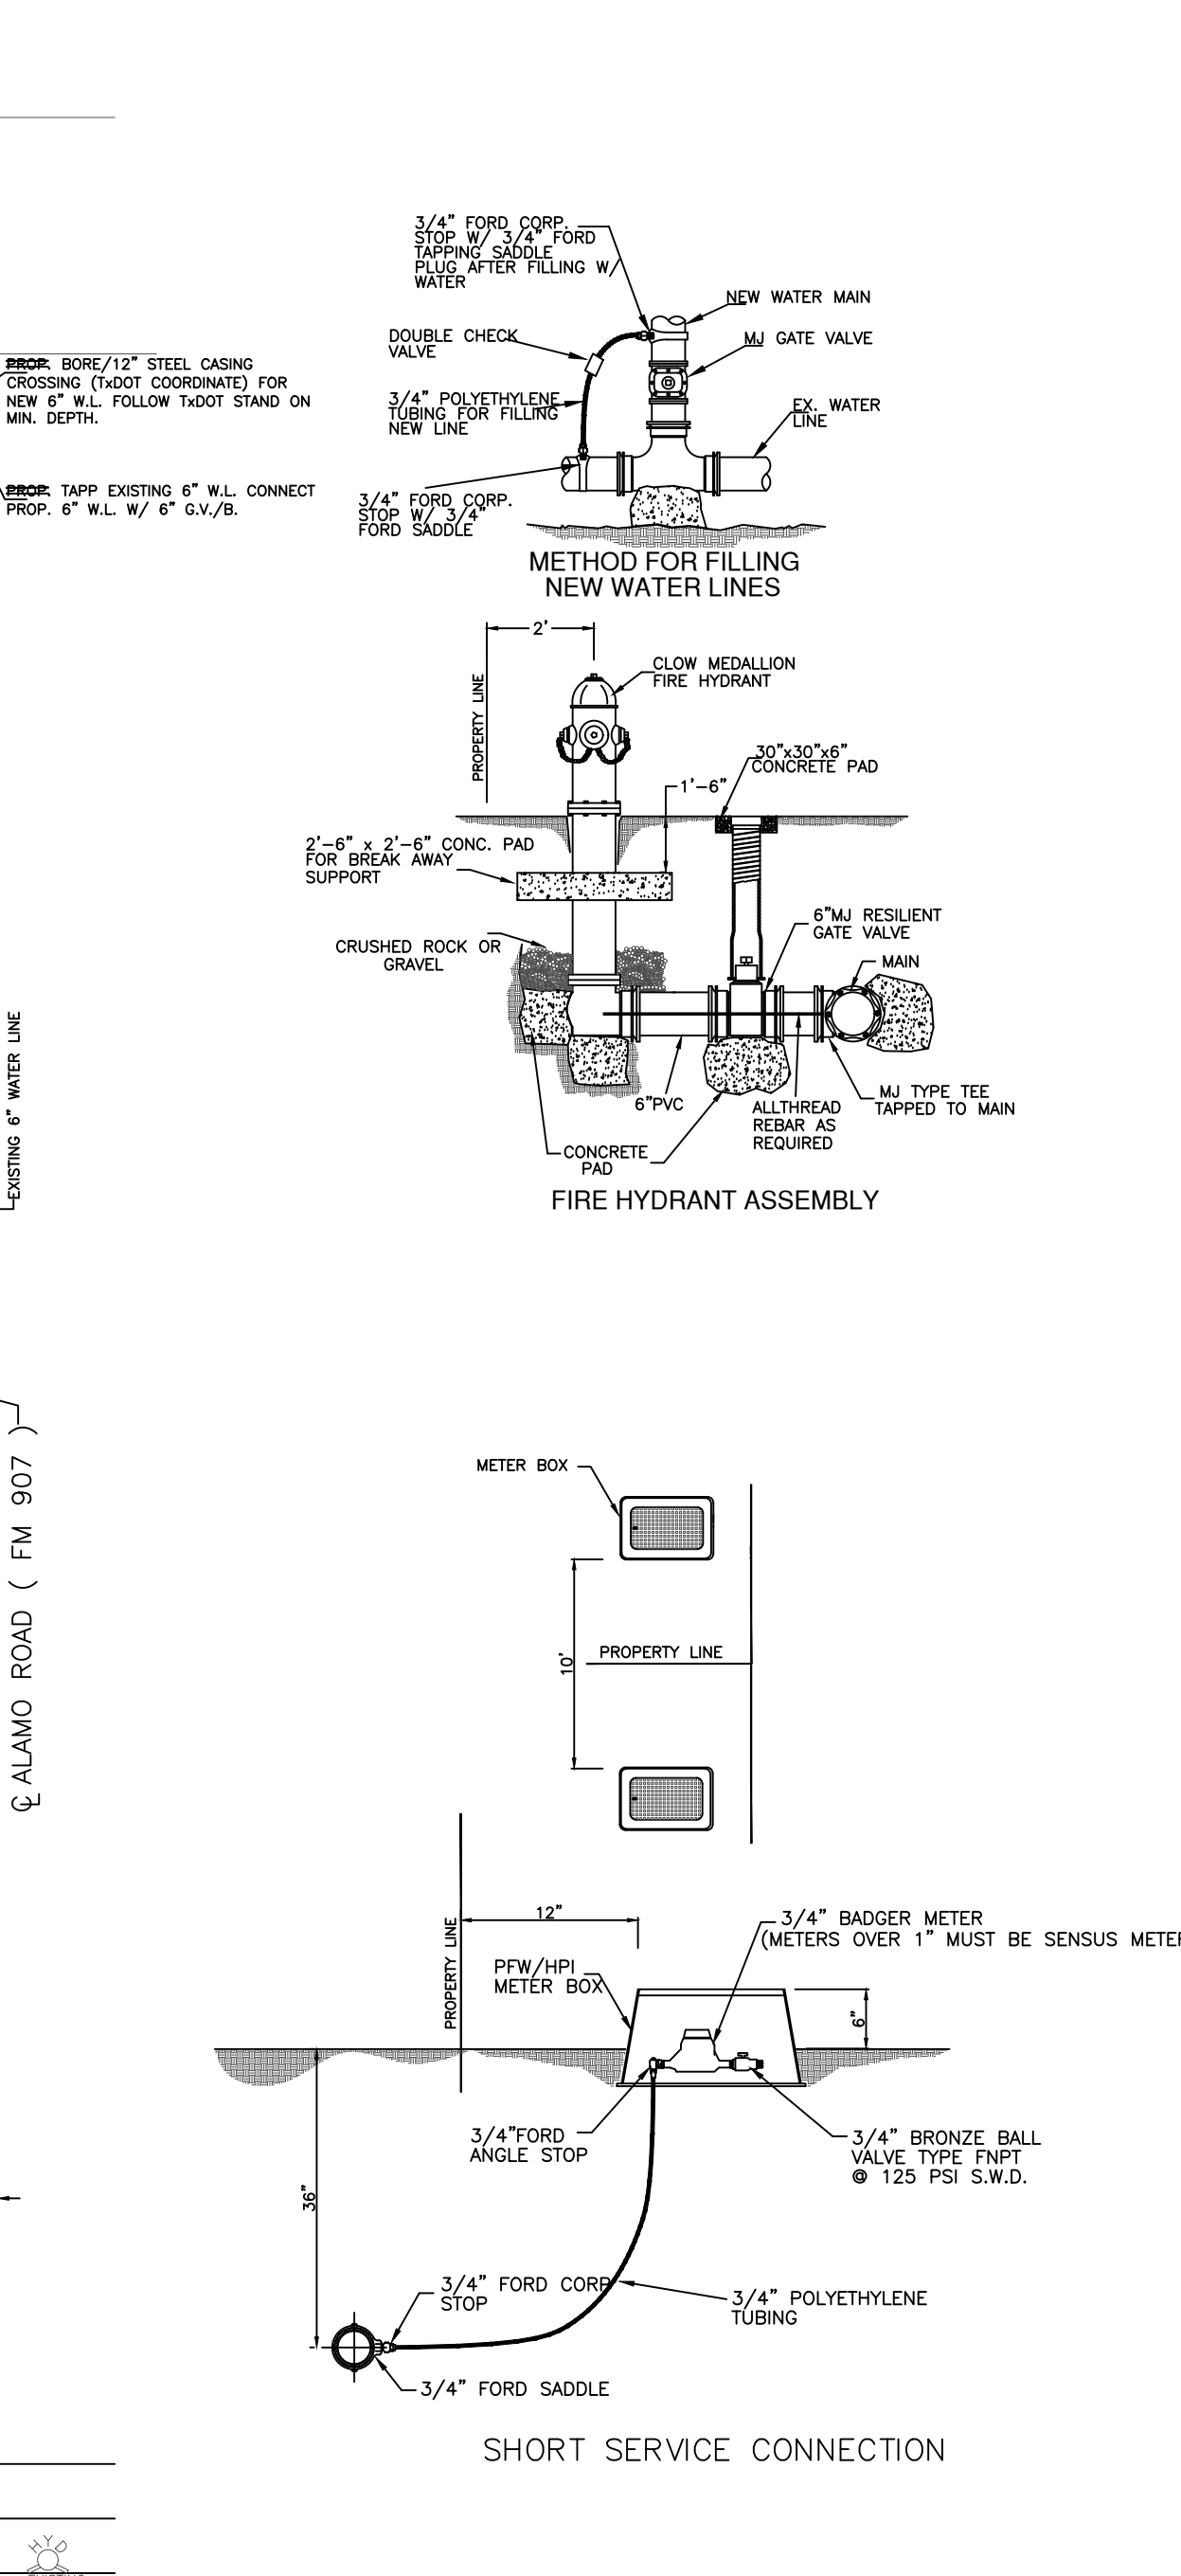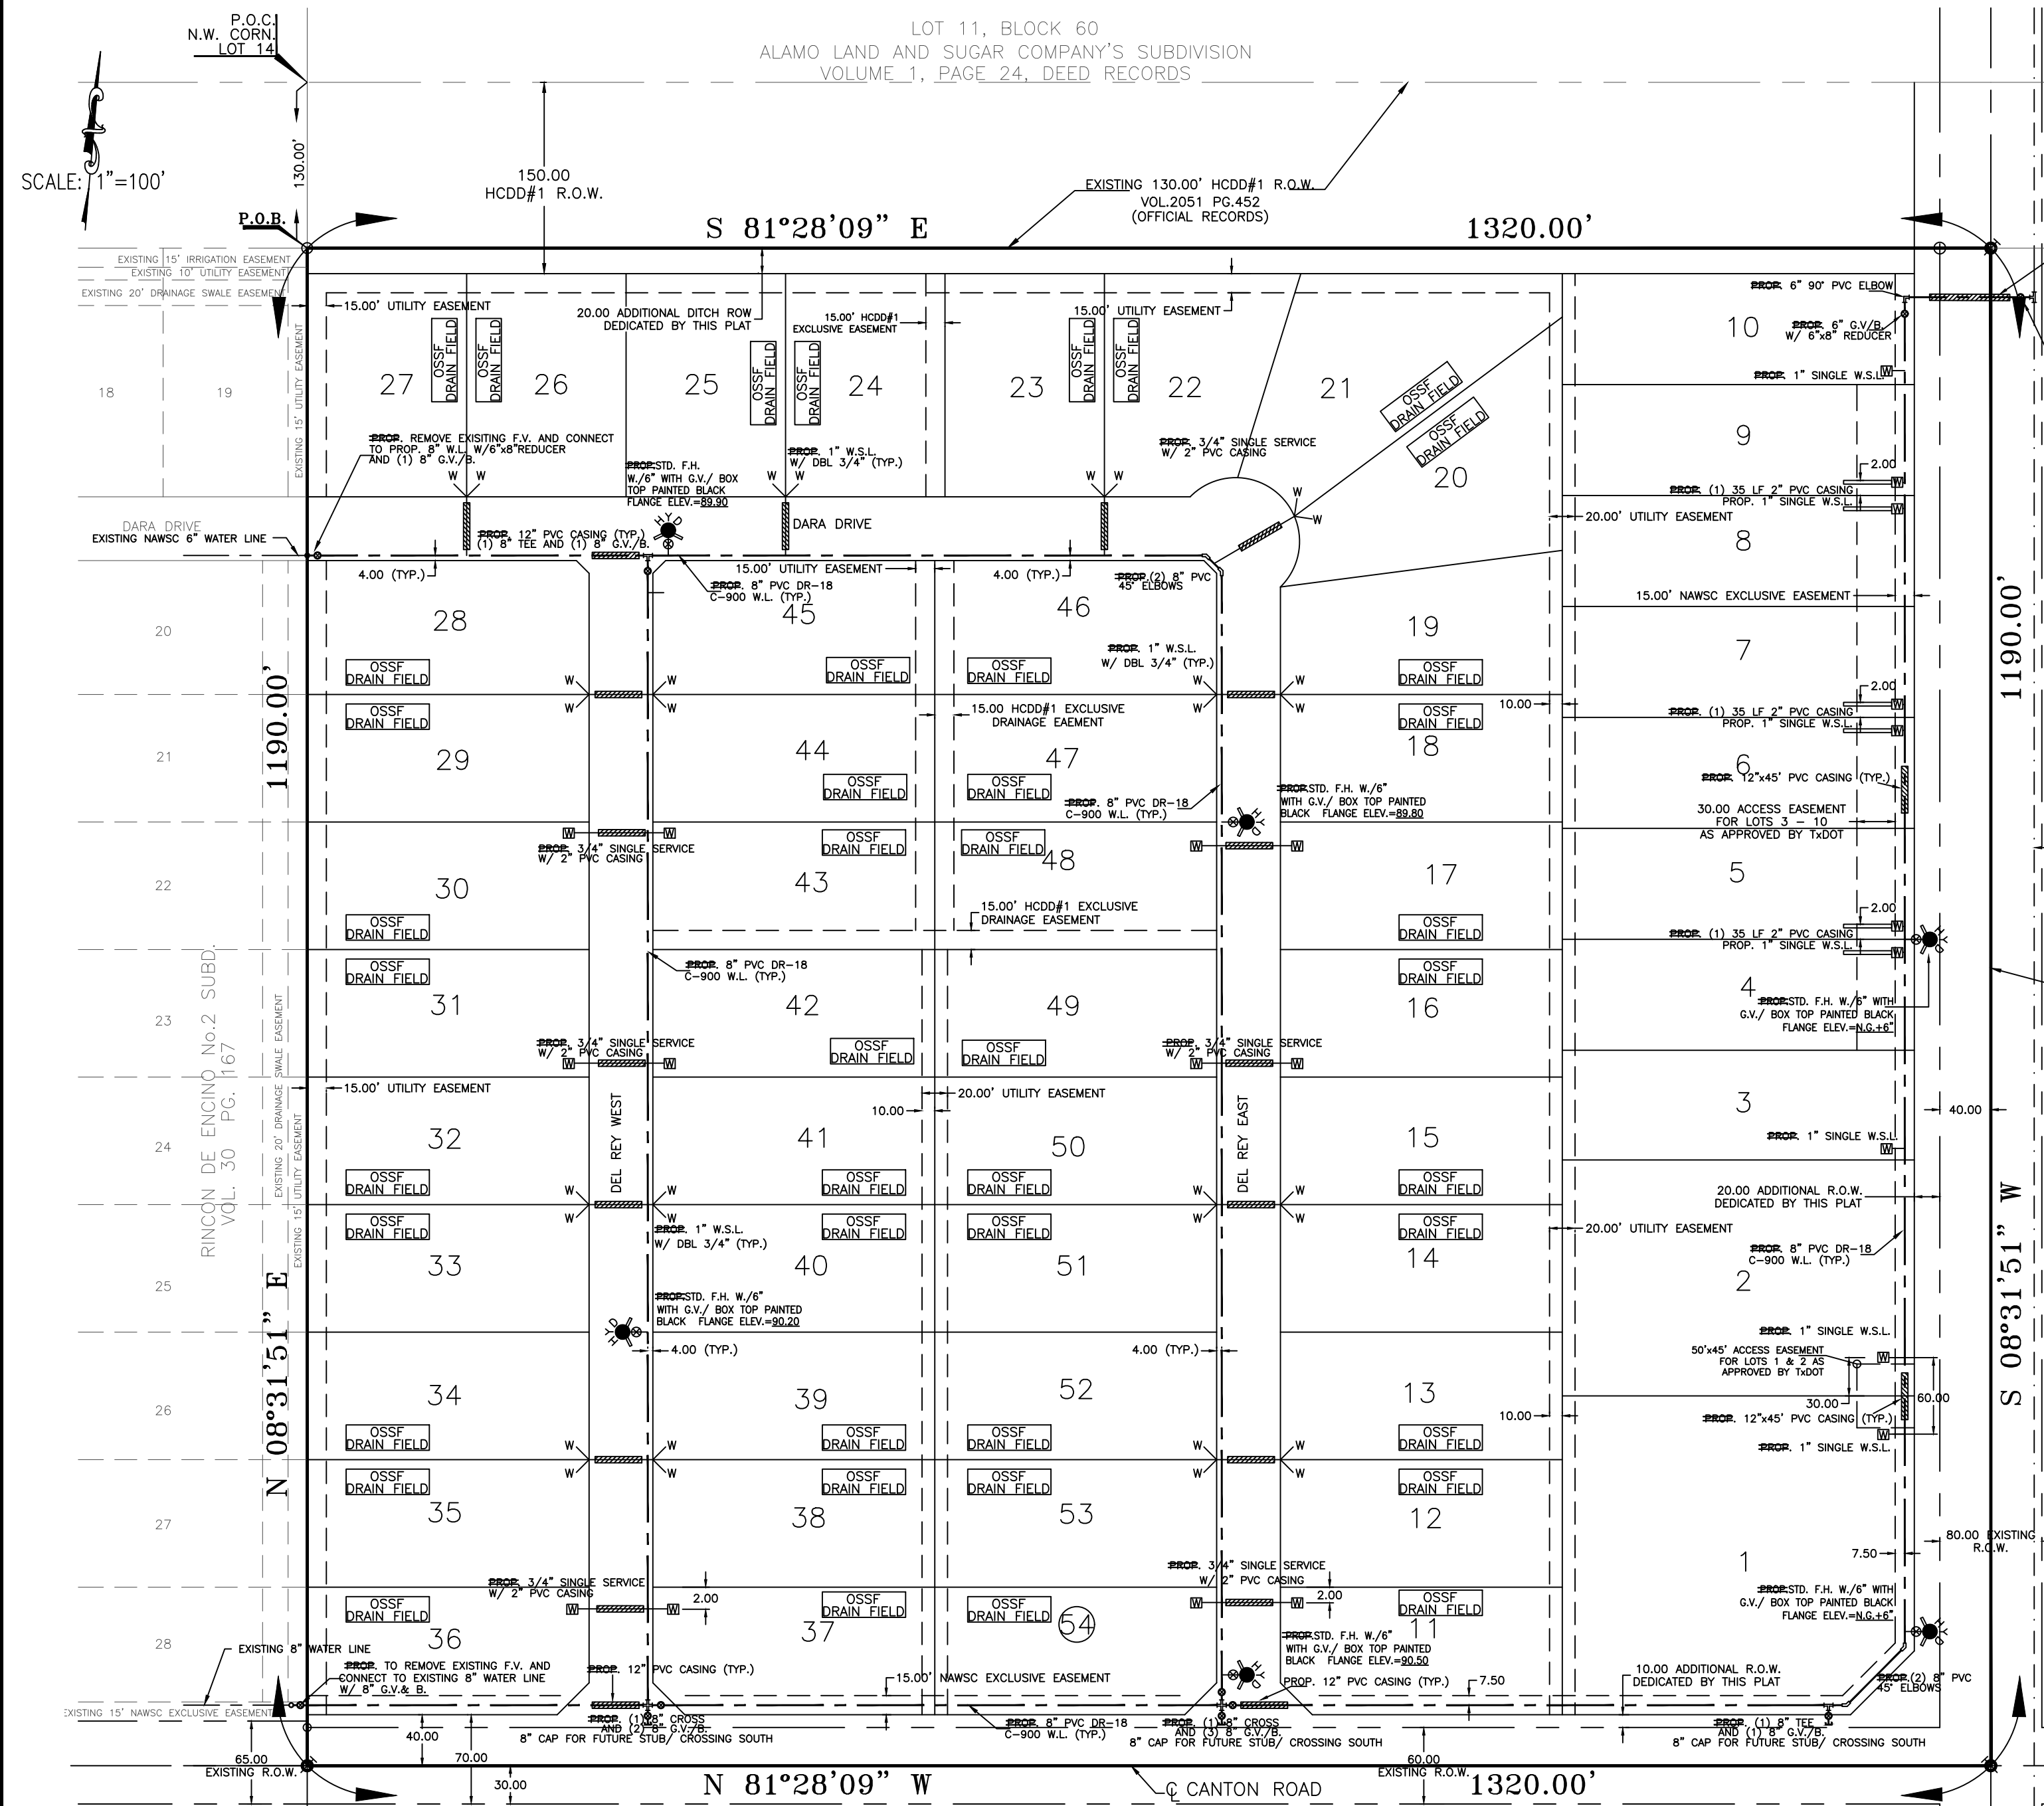

CONSTRUCTION COST ESTIMATE:

1-WATER:	\$138,577.50
2-OSSF:	\$66,000.00
3-PAVING:	\$283,756.00
4-DRAINAGES:	\$113,255.00
TOTAL:	\$572,088.50

FINAL WATER AND SEWER ENGINEERING REPORT

WATER SUPPLY DESCRIPTION, COST, AND OPERABILITY DATE:
 DEL REY ESTATES UNIT 1 SUBDIVISION HAS BEEN PROVIDED WITH POTABLE WATER BY NORTH ALAMO WATER SUPPLY CORPORATION (N.A.W.S.C.). THE SUBDIVIDER AND N.A.W.S.C. HAVE ENTERED INTO A CONTRACT IN WHICH N.A.W.S.C. HAS PROMISED TO PROVIDE SUFFICIENT WATER TO THE SUBDIVISION FOR AT LEAST 30 YEARS AND N.A.W.S.C. HAS PROVIDED DOCUMENTATION TO SUFFICIENTLY ESTABLISH THE LONG TERM QUANTITY AND QUALITY OF THE AVAILABLE WATER SUPPLIES TO SERVE THE FULL DEVELOPMENT OF THIS SUBDIVISION. N.A.W.S.C. HAS ONE EXISTING 8" WATER LINE ALONG THE NORTH SIDE OF CANTON ROAD WITHIN AN EXISTING 15 FOOT N.A.W.S.C. EASEMENT ENDING ON THE SOUTHWEST CORNER OF THIS PROPOSED SUBDIVISION AS WELL AS AN EXISTING 6" WATER LINE ON THE SOUTH SIDE OF DARA DRIVE. FROM THIS PREVIOUS MENTIONED LINE, ONE PROPOSED 8" WATER LINE WILL INSTALL RUNNING EAST WITHIN A 15 FOOT NAWSC EASEMENT. THREE MORE 8" WATER LINES WILL BE INSTALLED ALONG THE PROPOSED ROAD ROWS OF (DEL REY WEST, DANA DR. AND DEL REY EAST).

WATER DISTRIBUTION FOR THE DEL REY ESTATES UNIT 1 SUBDIVISION CONSISTS OF THIRTY TWO (32)-1" DIAMETER DUAL SERVICE LINES, TWELFTH (12) 3/4" SINGLE SERVICE LINES AND TEN (10) 1" SINGLE SERVICE LINES. THE 6" WATERLINES, THE DUAL SERVICE LINES, THE METER BOXES & LOCKS HAVE ALREADY BEEN INSTALLED, AT A TOTAL COST OF \$113,227.50 OR \$2,086.81 PER LOT. IN ADDITION, THE SUBDIVIDER HAS PAID N.A.W.S.C. THE SUM OF \$34,800.00, WHICH COVERS THE \$644.44 COST PER LOT AS STATED IN THE 30 YEAR WATER SERVICE AGREEMENT WHICH SUM REPRESENTS THE TOTAL COST OF WATER METER, RIGHTS ACQUISITION FEES, AND ALL MEMBERSHIP OR OTHER FEES ASSOCIATED WITH CONNECTING THE INDIVIDUAL LOTS IN THE SUBDIVISION TO N.A.W.S.C. UPON REQUEST BY THE LOT OWNER, N.A.W.S.C. WILL PROMPTLY INSTALL AT NO CHARGE THE WATER METER FOR THAT LOT. THE SUBDIVIDER HAS INSTALLED 6" FIRE HYDRANTS AT A UNIT COST OF \$4,225.00 FOR A TOTAL COST OF \$25,350.00. THE ENTIRE WATER FACILITIES HAVE BEEN APPROVED AND ACCEPTED BY N.A.W.S.C. AND SAID DISTRIBUTION SYSTEM IS OPERABLE AS OF THE DATE OF THE RECORDING OF THE PLAT.

SEWAGE FACILITIES DESCRIPTION: COST AND OPERABILITY DATES
 SEWAGE FROM DEL REY ESTATES UNIT 1 SUBDIVISION WILL BE TREATED BY INDIVIDUAL ON-SITE SEWAGE FACILITIES (OSSF) CONSISTING OF A STANDARD DESIGN DUAL COMPARTMENTS SEPTIC TANK AND A DRAIN FIELD ON EACH LOT. JOSE A. GONZALEZ SITE EVALUATOR REC# 122758, HAS EVALUATED THE SUITABILITY OF THE SUBDIVISION SITE FOR OSSF AND SUBMITTED A REPORT CONCLUDING THAT THE SITE IS SUITABLE FOR OSSF. THE REPORT WAS REVIEWED AND APPROVED BY THE HIDALGO COUNTY HEALTH DEPARTMENT. EACH LOT HAS ADEQUATE AREA FOR A REPLACEMENTS DRAIN FIELD.

EACH LOT IN THE PROPOSED SUBDIVISION IS AT LEAST 1/2 ACRE IN SIZE. THE NATURAL RESOURCE CONSERVATION SERVICE SOIL SURVEY BOOK INDICATED A SANDY LOAM SOIL FOR THE AREA. TOTAL OF 6 BORES WERE DONE (ADDITIONAL BORINGS WERE UNNECESSARY BECAUSE THE SOILS ARE VERY UNIFORM WITHIN THIS LIMIT AREA). THE SOIL IS A UNIFORM SANDY, LOAM CLASS III, EXTENDING UP TO (LOAD CLASS III) EXCEEDING ANY PROPOSED EXCAVATIONS. THERE IS NO INDICATION OF GROUNDWATER OR A RESTRICTIVE LAYER WITHIN 24' OF BOTTOM OF THE PROPOSED EXCAVATIONS. THE SUBDIVISION DRAINS WELL.

THE COST OF THE INSTALLATION OF THE SEPTIC SYSTEM ON AN INDIVIDUAL LOT WAS \$1,500.00 INCLUDING THE COST FOR THE REQUIRED PERMIT AND LICENSE. ALL OSSF'S HAVE BEEN INSTALLED AND FINALIZED AT THIS TIME AT A TOTAL COST OF \$66,000.00 THE HIDALGO COUNTY HEALTH DEPARTMENT HAS INSPECTED AND APPROVED THE INSTALLATION OF ALL OSSF'S.

ENGINEER CERTIFICATION:
 BY MY SIGNATURE BELOW, I CERTIFY THAT THE WATER AND SEWAGE SERVICE FACILITIES DESCRIBED ABOVE ARE IN COMPLIANCE WITH THE MODEL RULES ADOPTED UNDER SECTION 16.343, WATER CODE. I CERTIFY THAT THE COST TO INSTALL THE WATER DISTRIBUTION SYSTEM AND ONSITE SEWAGE FACILITIES, DISCUSSED ABOVE, ARE AS FOLLOWS:

WATER FACILITIES - THESE FACILITIES FULLY CONSTRUCTED, WITH THE INSTALLATION OF WATER METERS, WILL COST A GRAND TOTAL OF \$173,377.50 WHICH EQUALS TO \$3,210.62 PER LOT.

SEWAGE FACILITIES - SEPTIC SYSTEM HAS BEEN INSTALLED AT A TOTAL COST OF \$1,500.00 PER LOT (ALL INCLUSIVE), FOR A TOTAL OF \$66,000.00 FOR THE ENTIRE SUBDIVISION.

AS BUILT

KAMBIZ S. KHADEMI, PE
 P.E. # 57767

DATE _____

PROVISIÓN DE AGUA: DESCRIPCIÓN, GASTOS Y FECHAS DE INICIO
 DEL REY ESTATES UNIT 1 SUBDIVISION HA SIDO PROVEÍDA DE AGUA POTABLE POR NORTH ALAMO WATER SUPPLY CORP. (N.A.W.S.C.). EL DUEÑO Y N.A.W.S.C. HAN HECHO UN CONTRATO EN CUAL N.A.W.S.C. HA PROMETIDO PROPORCIONAR SUFICIENTE AGUA A LA SUBDIVISIÓN DURANTE AL MENOS 30 AÑOS Y N.A.W.S.C. HA PROPORCIONADO LA DOCUMENTACIÓN PARA ESTABLECER SUFICIENTEMENTE LA CANTIDAD Y LA CALIDAD DE LOS ABASTECIMIENTOS DE AGUA DISPONIBLES PARA SERVIR EL DESARROLLO LLENO DE ESTA SUBDIVISIÓN. N.A.W.S.C. TIENE UNA LÍNEA DE AGUA DE 8 PULGADAS DE DIÁMETRO A LADO NORTE DE LA CALLE CANTON RD CUAL TERMINA EN LA ESQUINA SUR ESTE DE ESTE FRACCIONAMIENTO AL IGUAL QUE UNA LÍNEA DE 6 PULGADAS A LADO SUR DE LA CALLE DARA. DE ESTA LÍNEA PREVIAMENTE MENCIONADA SE CONECTARÁ UNA LÍNEA NUEVA DE PVC DE 8 PULGADAS EN DIÁMETRO CUAL SERÁ INSTALADA A LO LARGO DE UN DERECHO DE PASO DE 15 PIES DEDICADOS A NAWSC. TRES LÍNEAS MAS DE 8 PULGADAS SE INSTALARÁN PARA DARLE SERVICIO AL DESARROLLO COMPLETO DE ESTE FRACCIONAMIENTO.

DISTRIBUCIÓN DE AGUA PARA DEL REY ESTATES UNIT 1 SUBDIVISIÓN CONSISTE EN TREINTA Y DOS (32) LÍNEAS DE 1" DIÁMETRO DE SERVICIO SENCILLO, DOCE (12) LÍNEAS DE 3/4" DIÁMETRO DE SERVICIO SENCILLO Y DIEZ (10) LÍNEAS DE 1" SENILLAS CUALES TERMINAN EN LAS CAJA DEL MEDIDOR CON CADAUNO DE CADA SOLAR. LAS LÍNEAS DE SERVICIO DUALES Y SENILLAS DE 3/4" Y LAS CAJAS DEL MEDIDOR HAN SIDO INSTALADAS A UN COSTO TOTAL DE \$113,227.50 O \$2,086.81 POR LOTE. EL DUEÑO DE LA SUBDIVISIÓN TAMBIÉN LE HA PAGADO A LA COMPAÑÍA N.E.W.S.C. \$34,800.00 DE ACUERDO AL CONTRATO DE LA CARTA DE 30 AÑOS LA CUAL CUBRE EL COSTO DEL MEDIDOR MECÁNICO DE AGUA PARA CADA LOTE, \$644.44. ESTE PRECIO INCLUYE EL COSTO DE LA INSTALACIÓN DE CADA MEDIDOR Y LOS GASTOS DE CONEXIÓN. CUANDO EL DUEÑO DE CADA LOTE SOLICITE UN MEDIDOR DE AGUA, LA COMPAÑÍA N.E.W.S.C. LO INSTALARÁ SIN ALGUN GASTO AL DUEÑO. EL DUEÑO DE LA SUBDIVISIÓN TAMBIÉN HA INSTALADO 6 BOCAS DE REGO (FIRE HYDRANT) A UN COSTO INDIVIDUAL DE \$4,225.00 A UN COSTO TOTAL DE \$25,350.00. EL SISTEMA DE AGUA ESTARÁ EN FUNCIONAMIENTO COMPLETO ANTES O EN LA FECHA, EN LA CUAL LA SUBDIVISIÓN SEA REGISTRADA EN EL CONDADO DE HIDALGO.

DRENAJE: DESCRIPCIÓN, GASTOS Y FECHA DE INICIO PARA FACILITAR EL DRENAJE PARA LA SUBDIVISIÓN
 SE INSTALARÁ UNA FOSA SÉPTICA EN CADA SOLAR. ESTA FOSA SÉPTICA CONSISTE DE UN TANQUE SÉPTICO DE MODELO DUAL Y DE UN CAMPO DE DRENAJE PARA EL SOLAR. JOSE A. GONZALEZ EVALUADOR DE SUELOS REC# 12258 EH AUTOR DE ESTE DOCUMENTO HA EVALUADO EL ÁREA DONDE SE ENCUENTRA LA SUBDIVISIÓN Y HA PREPARADO UN REPORTE QUE CONCLUYE QUE ESTE TERRENO ES ADECUADO PARA ESAS FOSAS SÉPTICAS (OSSF). EL REPORTE FUE APROBADO POR EL DEPARTAMENTO DE SALUBRIDAD DEL CONDADO DE HIDALGO (HIDALGO COUNTY HEALTH DEPARTMENT) SEGUN EL REPORTE.

CADA LOTE EN LA SUBDIVISIÓN MIDE MEDIO ACRE. SE HICIERON 6 EXCAVACIONES DE EVALUACIÓN DE SUELO EN LUGARES OPUESTOS EN LA SUBDIVISIÓN (EXCAVACIONES ADICIONALES NO FUERON NECESARIAS PORQUE EL TERRENO EN ESTA ÁREA ES SIGNIFICANTEMENTE UNIFORME). EL TERRENO ES UNIFORME (TERRENO ARCILLOSO Y SUELO FRANCO) Y SE EXTIENDE A 36 PULGADAS BAJO TODAS LAS EXCAVACIONES PROPUESTAS. NO EXISTE EVIDENCIA DE AGUA 24 PULGADAS MAS ARRIBA DE LO MAS BAJO DE LAS EXCAVACIONES PROPUESTAS. EL AGUA EN ESTA ÁREA FLUYE BIEN.

EL COSTO TOTAL PARA LA INSTALACIÓN DE UN SISTEMA INDIVIDUAL DE FOSAS SÉPTICAS POR SOLAR SON \$1,500.00 DÓLARES, INCLUYENDO EL COSTO DEL PERMISO REQUERIDO Y LICENCIA. EN ESTOS MOMENTOS TODAS LAS FOSAS SÉPTICAS HAN SIDO INSTALADAS. EN EL PROCESO DE LA APROBACIÓN FINAL A UN COSTO TOTAL DE \$66,000.00. EL DEPARTAMENTO DE SALUBRIDAD DEL CONDADO DE HIDALGO HA INSPECCIONADO TODOS LAS FOSAS SÉPTICAS Y AH APROBADO LA INSTALACIÓN DEL SISTEMA DE FOSAS SÉPTICAS.

CERTIFICACIÓN:
 CON MI FIRMA, CERTIFICO QUE LOS SERVICIOS Y SISTEMAS DE AGUA Y DE DRENAJE, DESCRITOS EN ESTE DOCUMENTO CUMPLEN CON LAS MODEL SUBDIVISION RULES (LAS REGLAS GOBERNANDO A LAS SUBDIVISIONES), ADOPTADAS EN LA SECCIÓN 16.343 DEL TEXAS WATER CODE (CÓDIGO DE AGUA DE TEXAS). CERTIFICO QUE LOS GASTOS PARA INSTALAR LOS SISTEMAS DE AGUA Y DE DRENAJE SON:

AGUA: EL SISTEMA/SERVICIO DE AGUA SERÁ INSTALADO Y COMPLETAMENTE CONSTRUÍDO MENOS EL MEDIDOR MECÁNICO DE AGUA QUE COSTARÁ UN TOTAL DE \$173,377.50 O \$3,210.62 POR LOTE

DRENAJE: SE ESTIMA QUE LA FOSA SÉPTICA COSTARÁ \$1,500.00 POR SISTEMA A UN COSTO TOTAL DE \$66,000.00 TODA LA SUBDIVISIÓN.

AS BUILT

KAMBIZ S. KHADEMI, PE
 P.E. # 57767

DATE _____

SUBDIVIDER CERTIFICATION:
 1.-BY COMPLETING THE IMPROVEMENTS DESCRIBED ON THE PLAT, SUBDIVIDER WILL COMPLY WITH MINIMUM STATE STANDARDS AND THAT (a)WATER QUALITY AND CONNECTIONS INCLUDING WATER METERS TO THE LOTS MEET SUCH STANDARDS AND (b)SEWER CONNECTIONS TO THE LOTS OR SEPTIC TANKS MEET OR WILL MEET SUCH STANDARDS AND WILL BE CONSTRUCTED IN ACCORDANCE WITH STATE AND COUNTY REGULATIONS.

SUBDIVIDER STATEMENT:
 1-1 KYNDEL W. BENNETT, SUBDIVIDER OF DEL REY ESTATES UNIT 1 SUBDIVISION HEREBY CERTIFY SEWER PERMITS HAVE BEEN PAID AND ARE ON FILE WITH HIDALGO COUNTY HEALTH DEPARTMENT AND THAT AN ADEQUATE DRINKING WATER SOURCE IS IMMEDIATELY AVAILABLE TO EACH LOT OF THE TYPE, QUALITY AND QUANTITY TO ENABLE EACH PERSON PURCHASING A LOT TO HAVE ADEQUATE WATER TO COMPLY WITH THE REGULATIONS AND THE LAWS OF THE STATE REQUIRED BY STATE AND COUNTY REGULATIONS.

OWNER:
 DEL REY ESTATES L.P., a TEXAS LIMITED PARTNERSHIP
 CAYETANO ROV, L.L.C., a TEXAS LIMITED LIABILITY COMPANY
 GENERAL PARTNER
 KYNDEL W. BENNETT, PRESIDENT
 BOX 365
 LA BLANCA, TX 78558

STATE OF TEXAS
 COUNTY OF HIDALGO

BEFORE ME, THE UNDERSIGNED AUTHORITY, ON THIS DAY PERSONALLY APPEARED KYNDEL W. BENNETT, KNOWN TO ME BY THE PERSON WHOSE NAME IS SUBSCRIBED TO THE FOREGOING INSTRUMENT AND ACKNOWLEDGED TO ME THAT HE EXECUTED THE SAME FOR PURPOSED AND CONSIDERATION THEREIN STATED, GIVEN UNDER MY HAND AND SEAL OF OFFICE THIS _____ DAY OF _____, 20____.

NOTARY PUBLIC
 MY COMSTUART EXPIRES _____

DEL REY ESTATES UNIT 1 SUBDIVISION
 HIDALGO COUNTY
 ETJ EDINBURG


EXISTING TOPO AND PROPOSED WATER IMPROVEMENTS (NAWSC) AND SEPTIC TANKS
 DEL REY ESTATES UNIT 1, LLC

BY: _____ DATE: _____

REVISION: _____

DRAWING DATE: APRIL, 2016
 RELEASE DATE: _____
 DESIGNED BY: K.K.
 DRAWN BY: F.D.
 CHECKED BY: K.K.
 UPDATED DWG. BY: _____
 SCALE: 1" = 100'

© Copyright 2016 KK Engineering Consultant
 All Rights Reserved.
 File Name: SEPTIC & WATER
 SHEET 2 OF 3

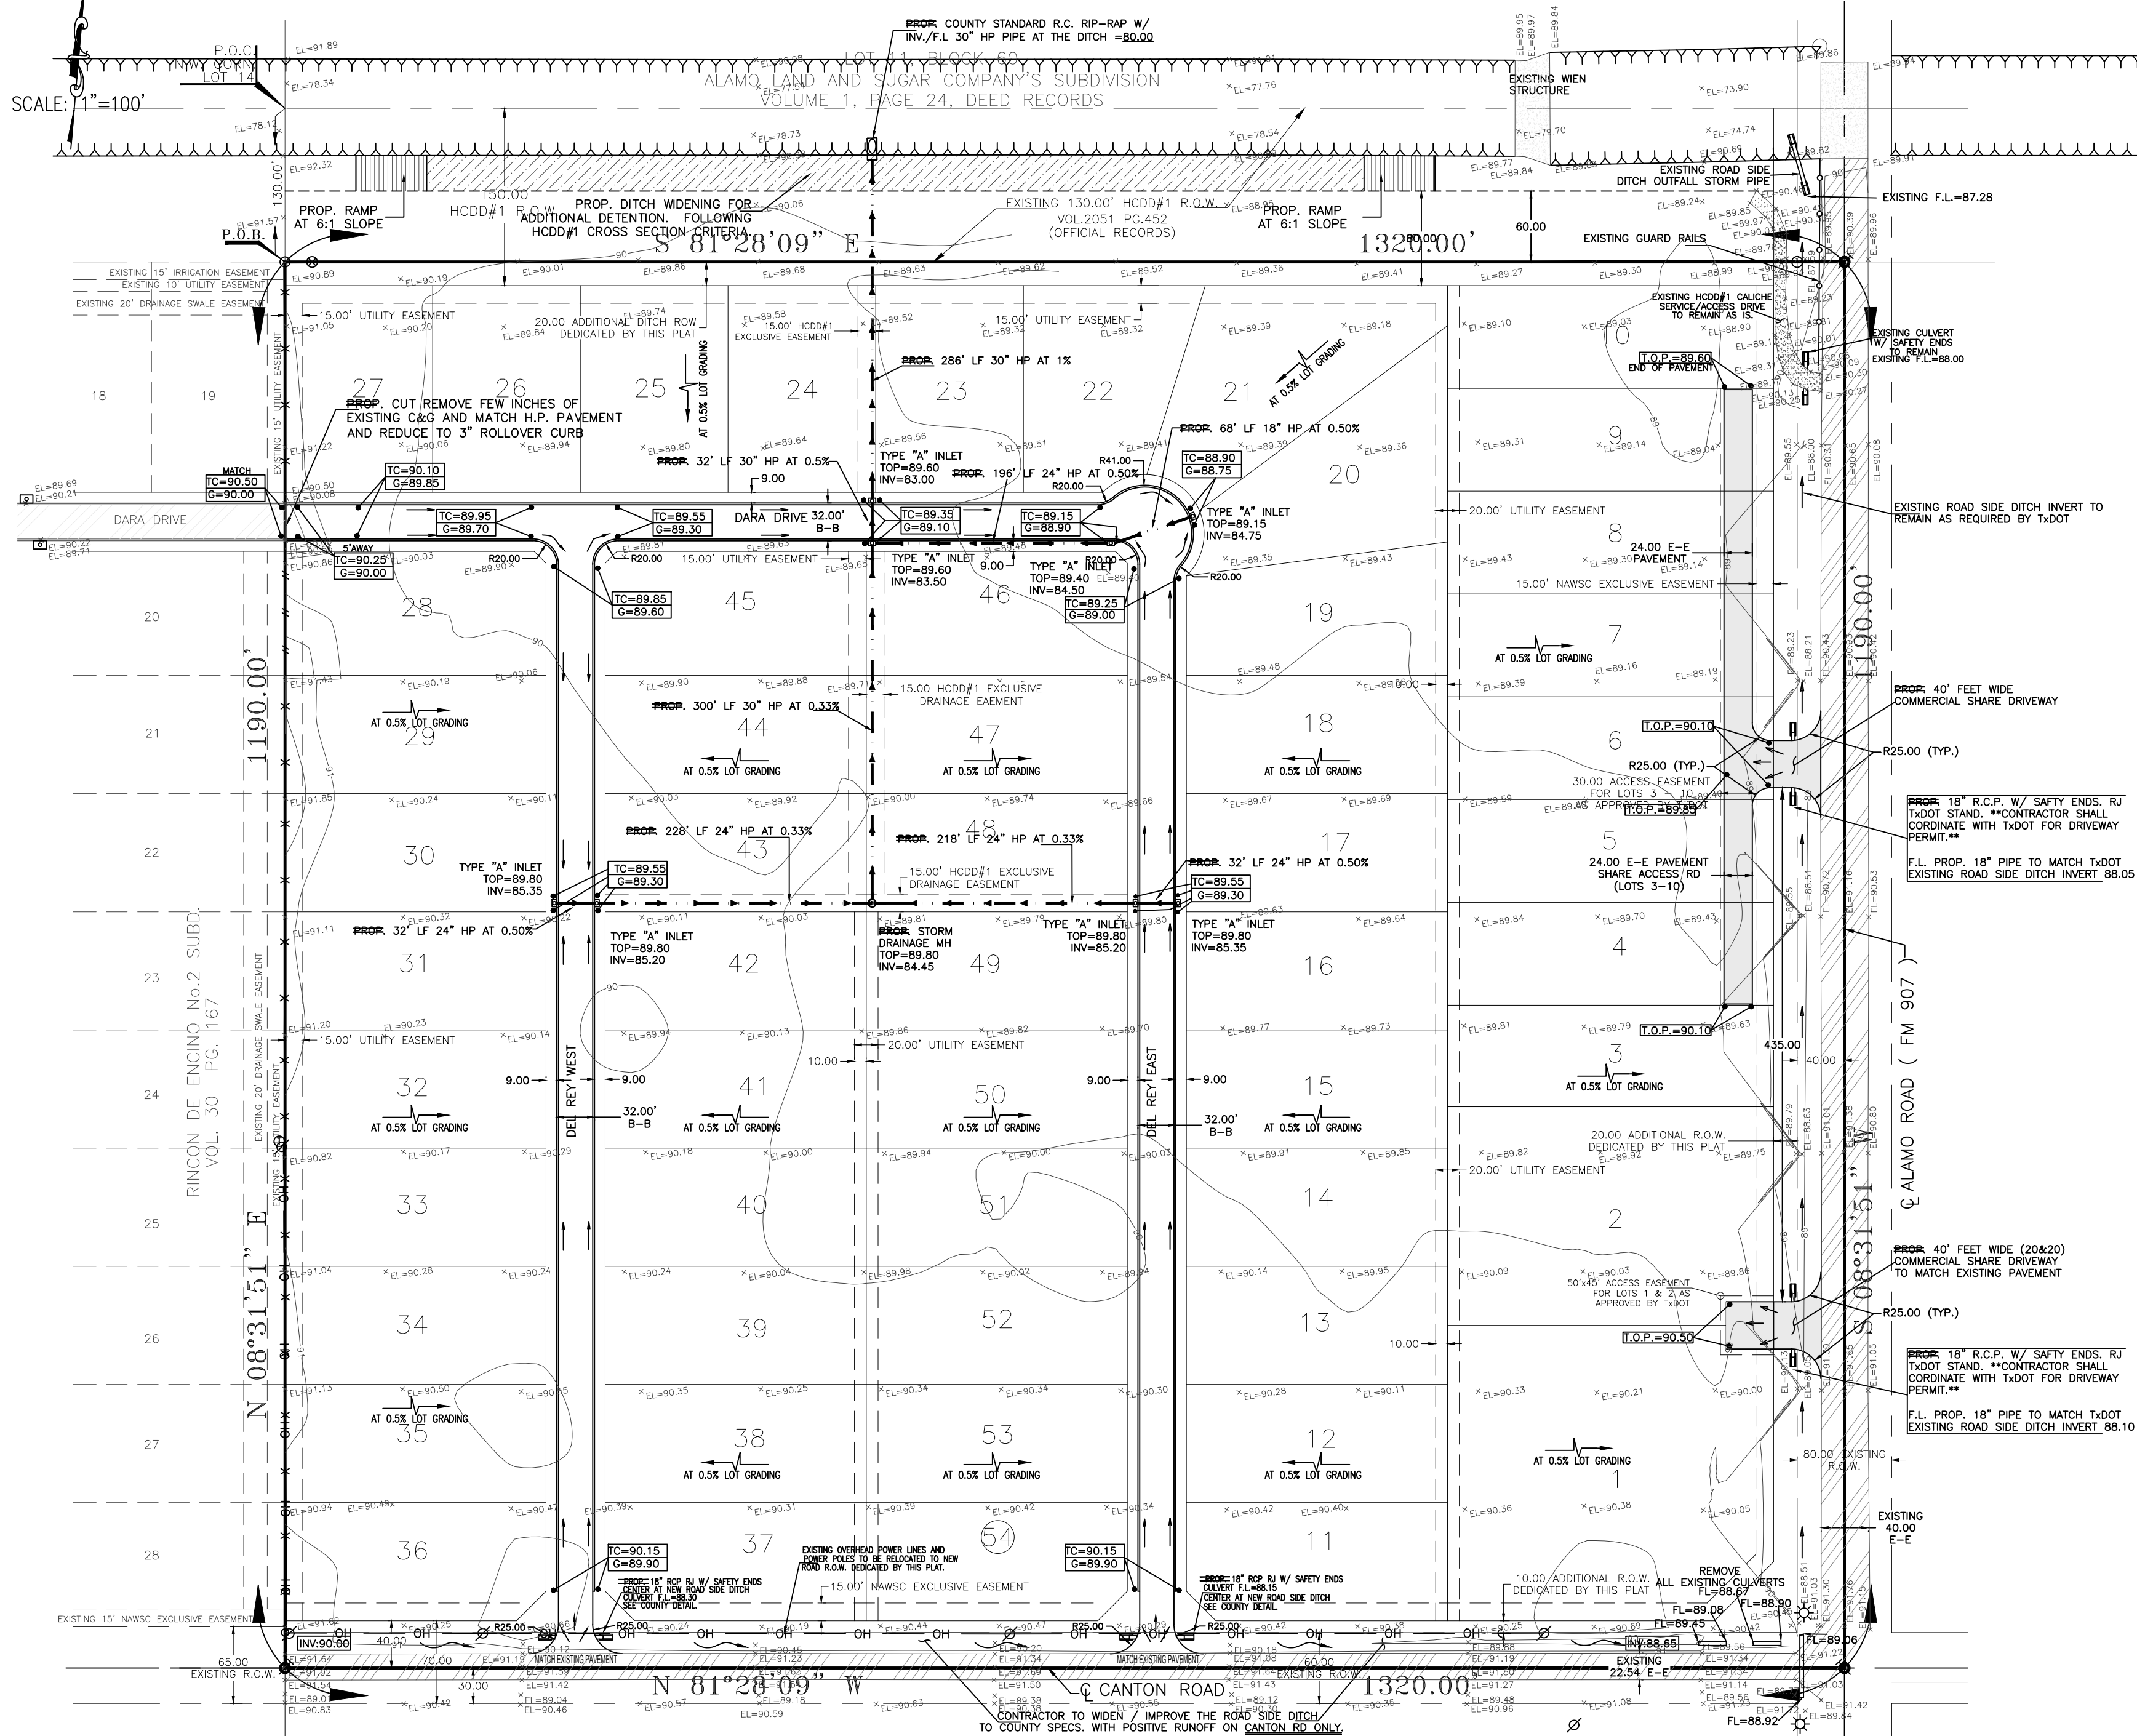

DRAINAGE REPORT


THE REFERENCED SUBDIVISION IS A 33.25-AC. NET TRACT OF LAND LOCATED ON THE NORTH WEST CORNER OF CANTON AND ALAMO ROADS. THIS AREA IS IN 2 MILE ETJ OF CITY OF EDINBURG.

THE PROPOSED USE IS MOSTLY FOR SINGLE-FAMILY RESIDENTIAL LOTS (44) AND FEW COMMERCIAL LOTS (10). THE NATURAL DRAINAGE IN THE GENERAL AREA IS TO THE NORTH OUT FALLING INTO THE EXISTING HCDD#1 DRAINAGE DITCH. THE EXISTING RUNOFFS FROM THE SITE FOR A 10-YEAR STORM ARE 14.03 CUBIC FEET PER SECOND (SEE TABLES 1, IA, AND II).

THE PROPOSED DEVELOPMENT (DUE TO LARGE LOTS & SMALL HOMES) WILL VERY SLIGHTLY INCREASE RUNOFF WITHOUT DETENTION TO 17.29 CUBIC FEET PER SECOND BASED ON A 10-YEAR STORM. BASED ON THE COUNTY'S POLICY THAT THERE BE NO ADDITIONAL RUNOFF FROM A 10-YEAR STORM, A 50,207 CUBIC FEET (1.15 ACRE-FEET) OF DETENTION IS REQUIRED, AND THIS SHALL BE ACCOMPLISHED BY HCDD#1'S EXISTING DRAINAGE DITCH WIDENING.


ADDITIONAL DRAINAGE IMPROVEMENTS ARE PROVIDED VIA STREET/GUTTER POSITIVE FLOW WITH CURB INLETS AND 24"/30" DRAINAGE PIPES OUT-FALLING INTO THE EXISTING HCDD#1 DRAINAGE DITCHES.

FLOOR ELEV. (SEE PLAT NOTE) WILL BE SET ABOVE THE 100 YR. FLOOD. THIS SUBD. IS IN ZONE "B" C.P.N. 480334 0425 C REVISED NOV. 16, 1982

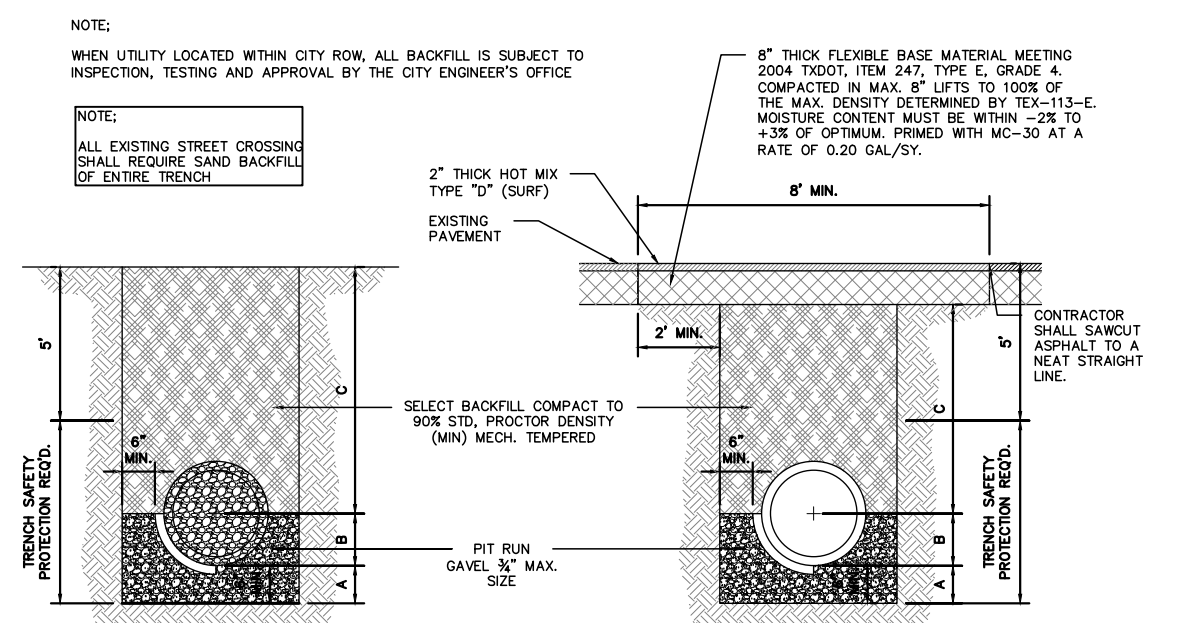


- STANDARD PIPE BEDDING**
- UNDER EXISTING PAVEMENT OR PAVED PRESENT
- GRAVEL (3/4" MAX. SIZE) BEDDING PLACED BEFORE PIPE IS LAD UP TO FLOW LINE OF PIPE. (MIN. THICKNESS = 6")
 - GRAVEL BACK FILL PLACED AFTER PIPE IS LAD FROM BOTTOM OF PIPE TO SPRING LINE OF PIPE. (4" LIFTS, EACH TAMPED)
 - FILL TRENCH WITH SELECT BACKFILL (P-20) 1/2" LIFTS COMPACT TO 95% STD. PROCTOR
 - FILL TRENCH WITH SELECT BACKFILL (P-20) 1/2" LIFTS COMPACT TO 95% STD. PROCTOR
- STANDARD PIPE BEDDING**
- UNDER EXISTING PAVEMENT OR PAVED PRESENT
- GRAVEL (3/4" MAX. SIZE) BEDDING PLACED BEFORE PIPE IS LAD UP TO FLOW LINE OF PIPE. (MIN. THICKNESS = 6")
 - GRAVEL BACK FILL PLACED AFTER PIPE IS LAD FROM BOTTOM OF PIPE TO SPRING LINE OF PIPE. (4" LIFTS, EACH TAMPED)
 - FILL TRENCH WITH SELECT BACKFILL (P-20) 1/2" LIFTS COMPACT TO 95% STD. PROCTOR
 - FILL TRENCH WITH SELECT BACKFILL (P-20) 1/2" LIFTS COMPACT TO 95% STD. PROCTOR


STANDARD PIPE BEDDING DETAILS

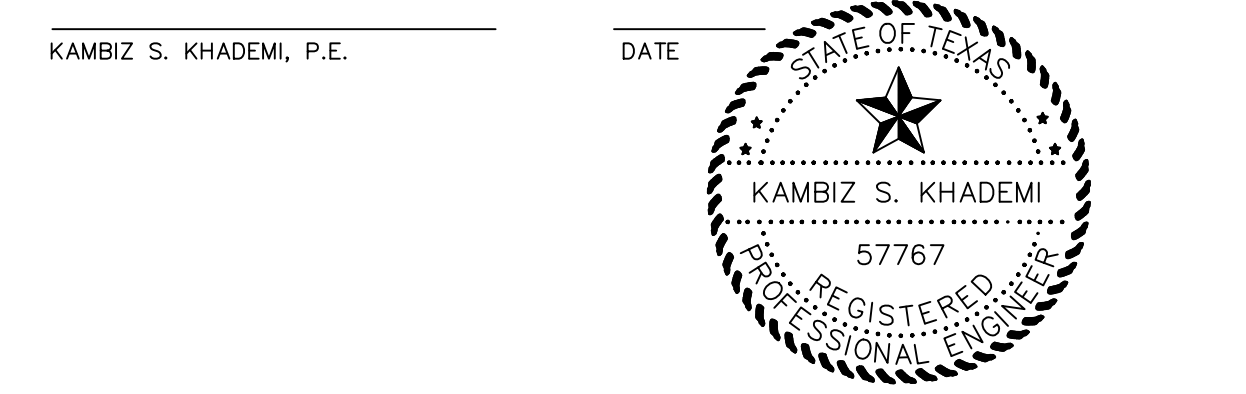

RECONSTRUCTION OF ROAD SIDE DITCH WITH SIDEWALK TO BE LOCATED WHEN REQUIRED.

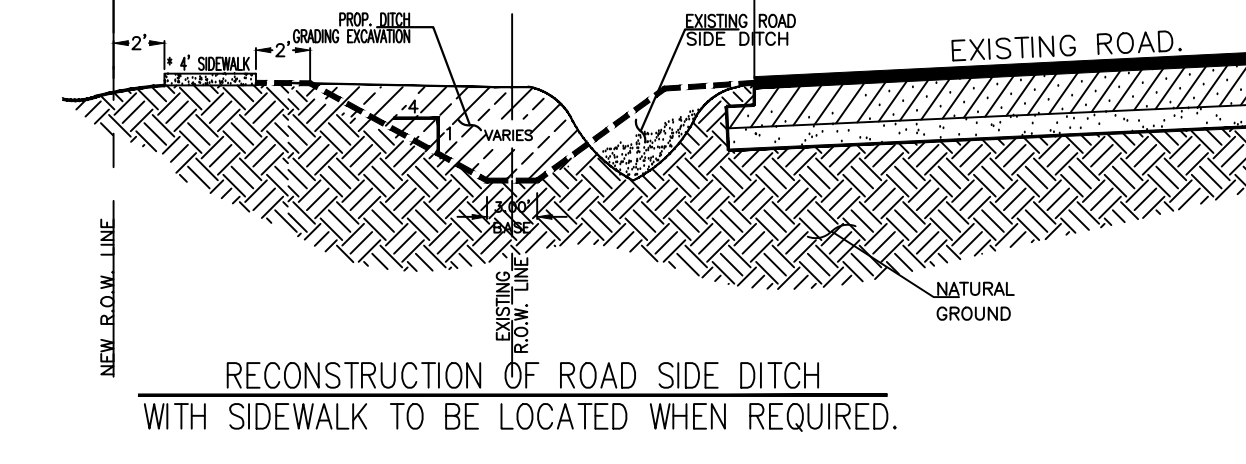


MINOR RESIDENTIAL STREET SECTION

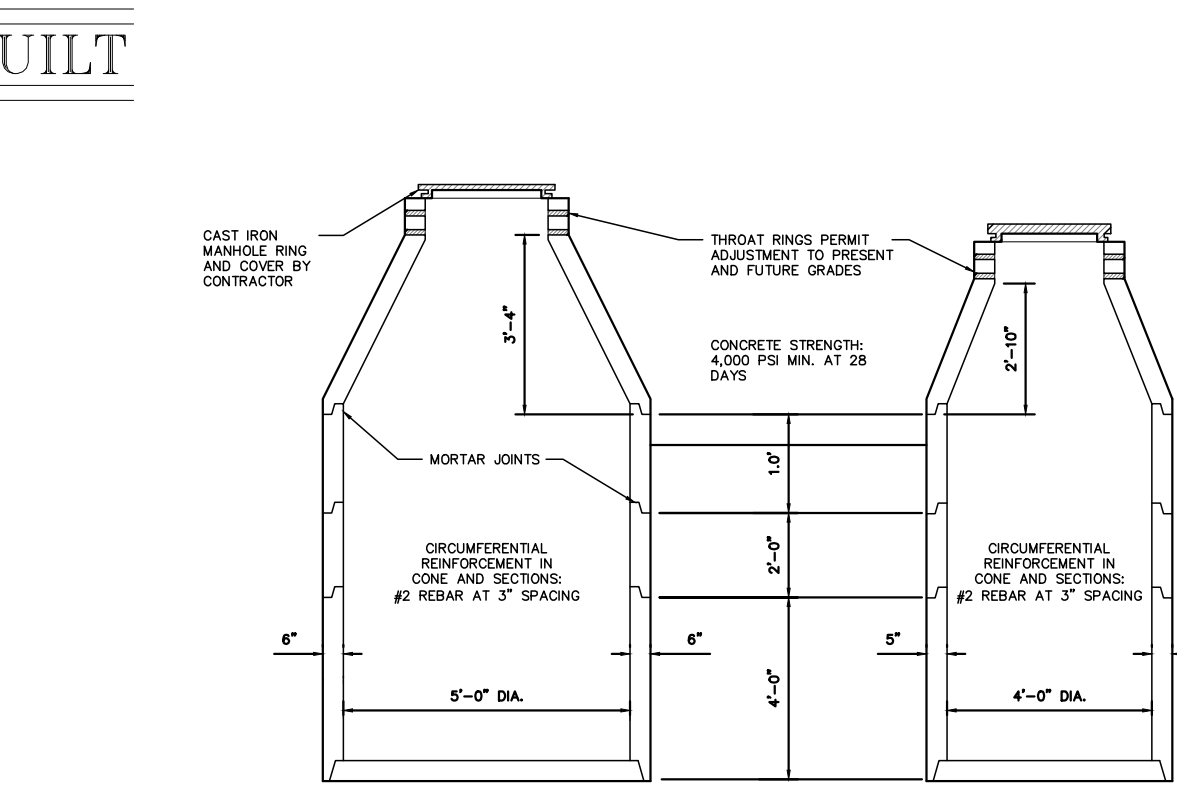

PRECAST CONCRETE MANHOLE DETAILS


WEIGHTS OF 3'-0" DIA. MANHOLE	MANHOLE SECTIONS	WEIGHTS OF 4'-0" DIA. MANHOLE
THROAT RING ONE SECTION	THROAT RING ONE SECTION	THROAT RING ONE SECTION
1'-0" SECTION	1'-0" SECTION	1'-0" SECTION
2'-0" SECTION	2'-0" SECTION	2'-0" SECTION
3'-0" SECTION	3'-0" SECTION	3'-0" SECTION
4'-0" SECTION	4'-0" SECTION	4'-0" SECTION

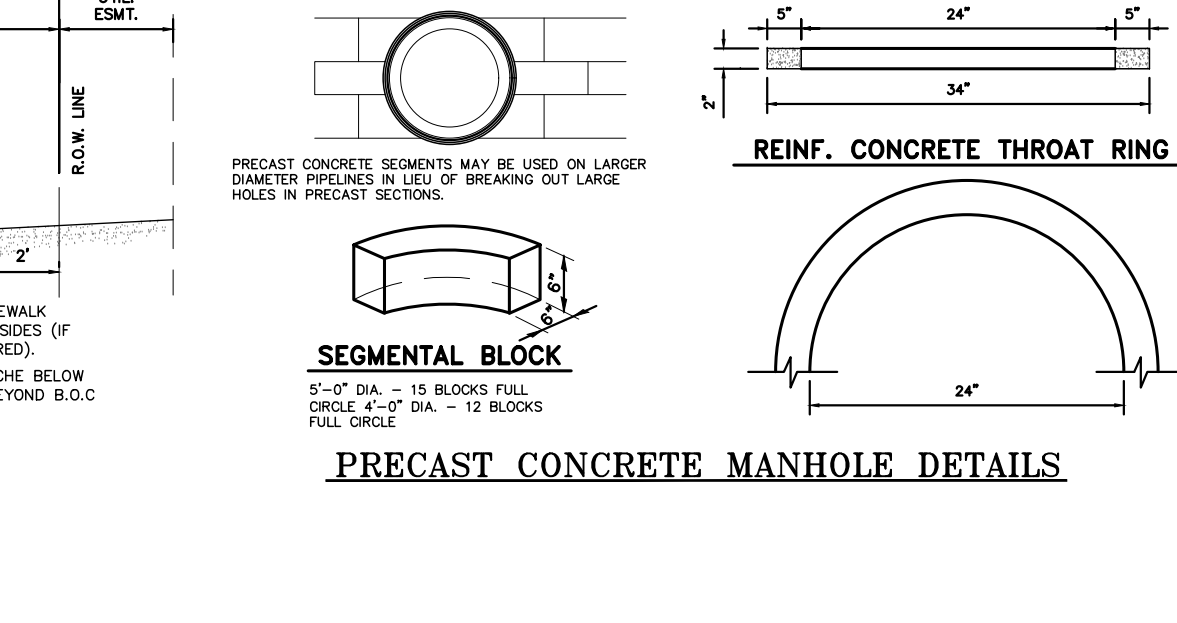


REINFORCED CONCRETE THROAT RING

SEGMENTAL BLOCK

PRECAST TYPE "A" INLET

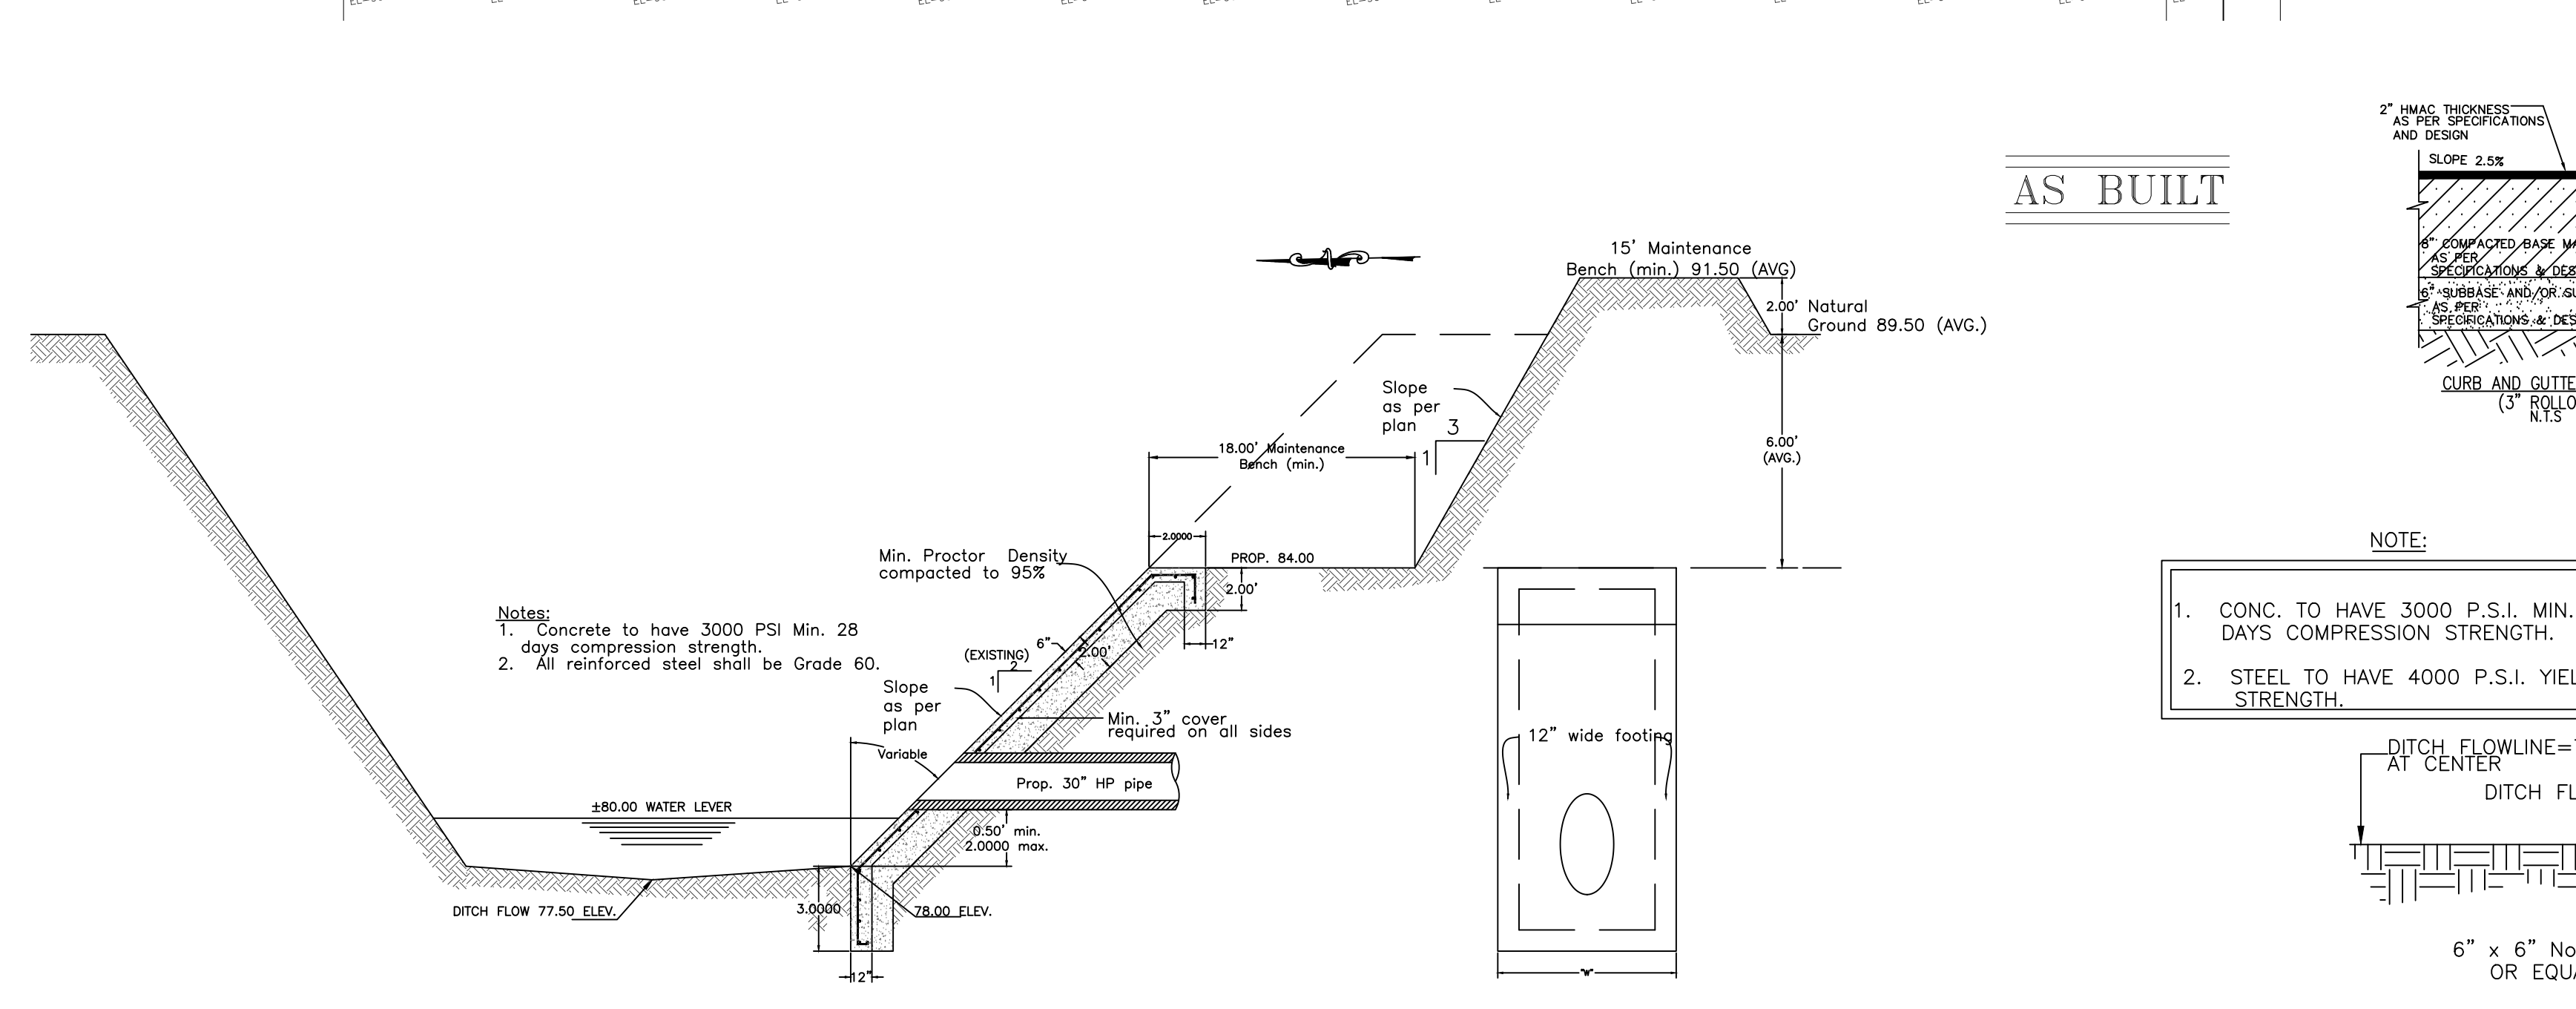

HCDD#1 DITCH SECTION DETAIL.

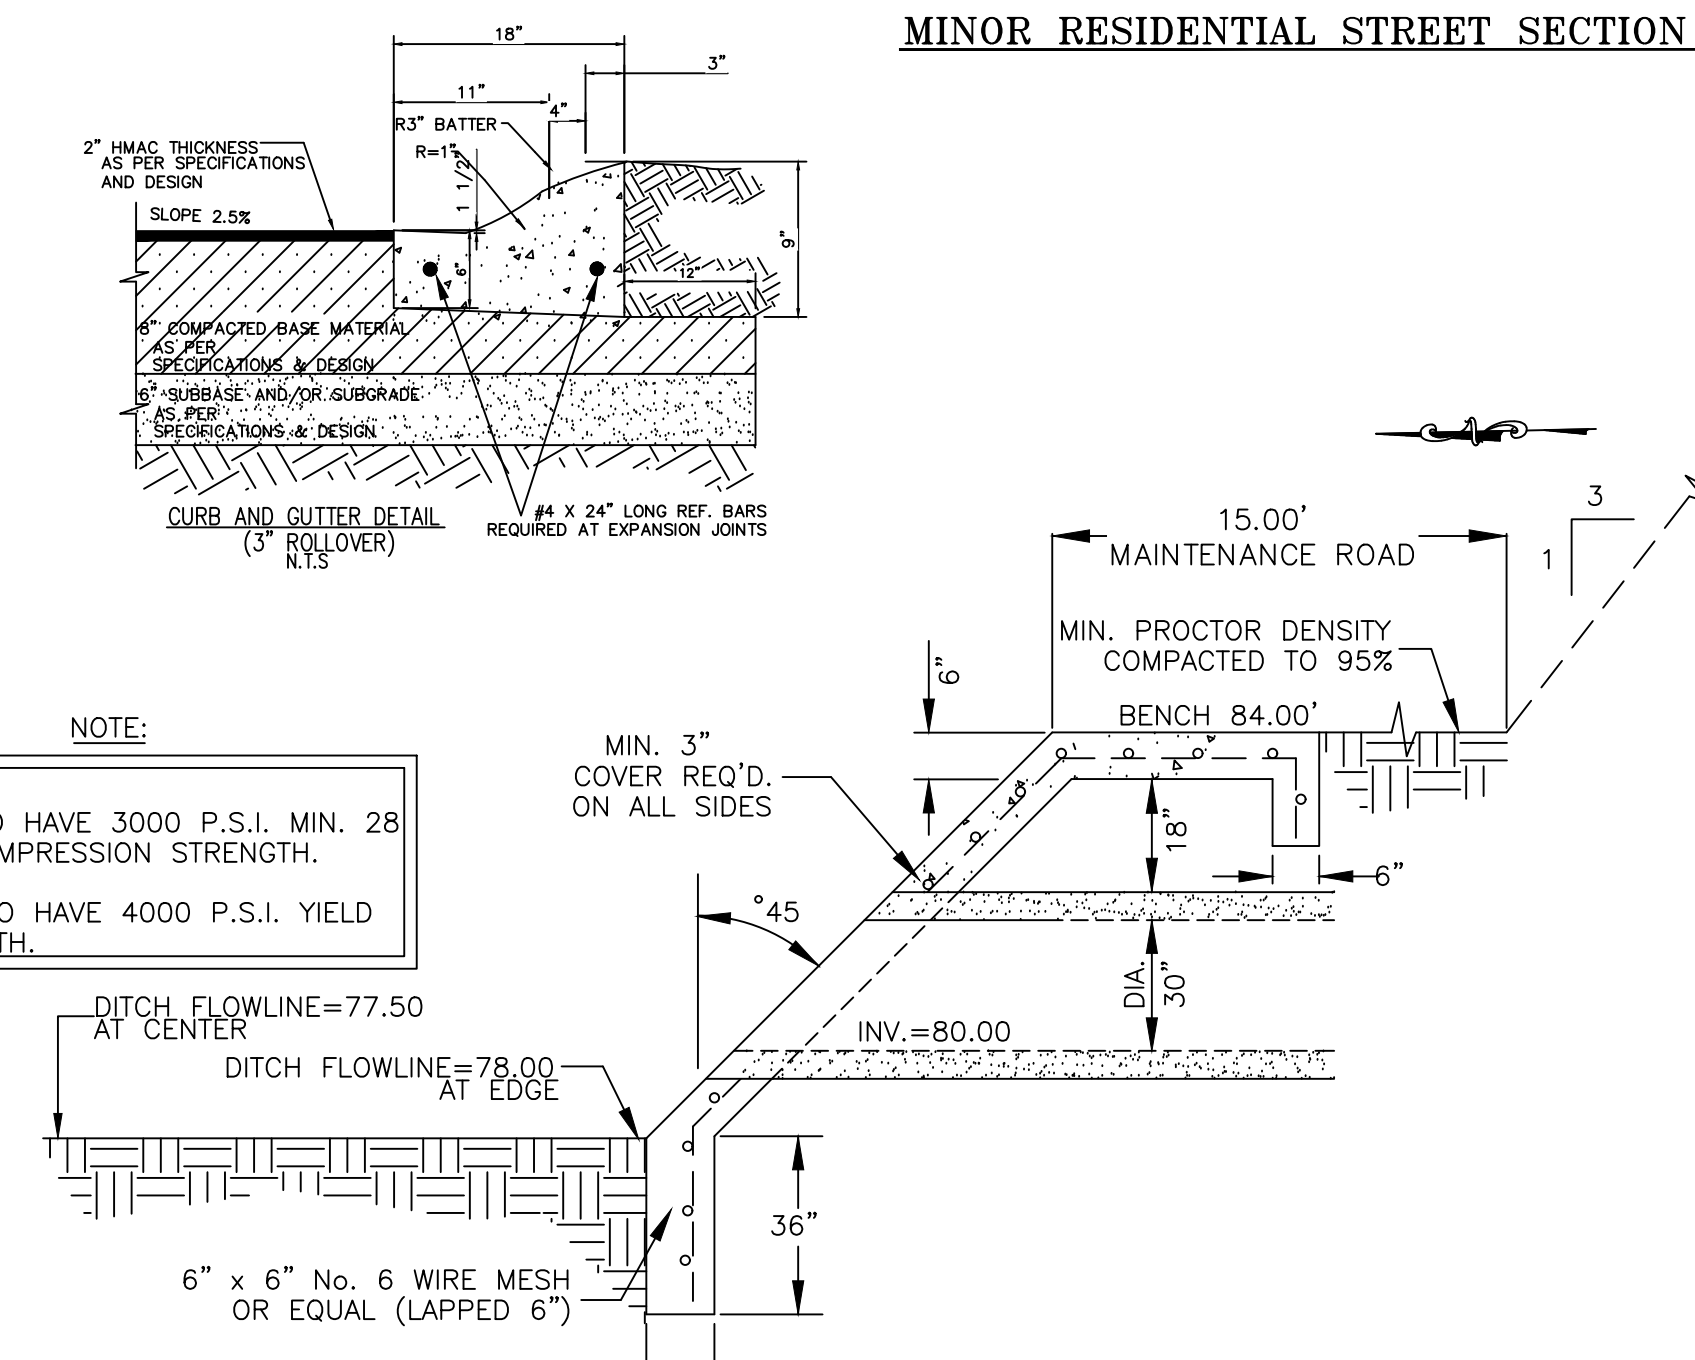

DEL REY ESTATES RIP-RAP DETAIL

BY _____ DATE _____

REVISION _____

K K Engineering Consultant
GENERAL PROFESSIONAL CIVIL ENGINEERING SERVICES
(FIRM REGISTRATION # 1334)

410 E. DOWE AVE.
MCKENNA, TEXAS 75802
(936) 630-2320
FAX (936) 630-2919

DRAWING DATE: APRIL, 2016
RELEASED BY: K.K.
DESIGNED BY: K.K.
DRAWN BY: F.D.
CHECKED BY: K.K.
PREPARED BY: K.K.
SCALE: 1" = 100'

STATE OF TEXAS
REGISTERED PROFESSIONAL ENGINEER
KAMBIZ S. KHADEMI
57767

THE SEAL APPEARING ON THIS DOCUMENT WAS AUTHORIZED BY KAMBIZ S. KHADEMI, P.E. 57767 APRIL 2016 ALTERATION OF A SEALED DOCUMENT WITHOUT PROPER NOTIFICATION TO THE RESPONSIBLE ENGINEER IS AN OFFENSE UNDER THE TEXAS ENGINEERING PRACTICE LAW

DEL REY ESTATES UNIT 1
SUBDIVISION
HIDALGO COUNTY
ETJ EDINBURG

EXISTING TOPO AND PROPOSED PAVING, STORM DRAINAGE AND DETENTION POND

DEL REY ESTATES UNIT 1, L.P.

©Copyright 2016 KK Engineering Consultant All Rights Reserved.
File Name: PAVING & DRAINAGE

SHEET 3 OF 3