

**CHANGE ORDER NUMBER ONE(6)**

Project: Pct. 2 Yuma Avenue Extension Project

DATE OF ISSUANCE: 10/27/2017 EFFECTIVE DATE: 10/27/2017

OWNER: Hidalgo County  
 OWNER'S CONTRACT NO: C-16-281-11-15

CONTRACTOR: Texas Cordia Construction, LLC ENGINEER: L&G Consulting Engineers, Inc.  
3149-A Center Pointe Drive ATTN: Christopher Rodriguez, P.E.  
Edinburg, Texas 78539 900 S. Steward Road, Suite 3  
Mission, Texas 78572

You are directed to make the following changes in the Contract Documents.


- Description:
1. Additional 666-6315 RE W/RET REQ TY 1 (Y)4"(SLD)(100MIL) 360 LF @ \$1.00 = \$360.00
  2. Additional 668-6019 PREFAB PAV MARK TY B (W)(ARROW) 2 EA @ \$295.00 = \$590.00
  3. Additional REFL PAV MARKR TY II-A-A 5 EA @ \$4.00 = \$20.00
  - 4.

- Reason for Change Order:
1. Requested by Owner.
  2. Requested by Owner.
  3. Requested by Owner.
  - 4.

Attachments: Exhibit A

CHANGE IN CONTRACT PRICE:		CHANGE IN CONTRACT TIME:	
Original Contract Price		Original Contract Time for	
\$	713,333.15		
Substantial Completion:		80	
		working days or dates	
Net Changes from previous Change Order		Net Change from previous Change Orders	
\$	5,386.00	10	
		working days	
Contract Price prior to this Change Order		Contract Time prior to this Change Order	
\$	718,719.15	Substantial Completion:	
		90	
		working days or dates	
Net Increase(decrease) of this Change Order		Net Increase(decrease) of this Change Order	
\$	970.00	5	
		working days	
Contract Price with all approved Change Orders	Net % increase(decrease) from original contract price.	Contract Time with all approved Change Orders	
\$	0.89 %	Substantial Completion:	
		95	
		working days or dates	


**RECOMMENDED:**  
 By: \_\_\_\_\_  
 Engineer (Authorized Signature)  
 Date: \_\_\_\_\_

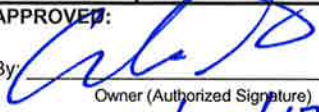**APPROVED:**  
  
 By: \_\_\_\_\_  
 Owner (Authorized Signature)  
 Date: 10/31/17

**ACCEPTED:**  
  
 By: \_\_\_\_\_  
 Contractor (Authorized Signature)  
 Date: 10/27/2017

**CITY OF McALLEN ENGINEERING**

- NO EXCEPTIONS TAKEN
- CONDITIONAL TO REMARKS
- REVISE AND RESUBMIT
- REJECTED

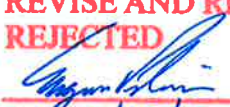By:   
 Date: 10/31/2017

**Exhibit E-B**



RCVDA 2:06 10/30/17

**SHEET SUMMARY**

STATION LIMITS	REFLECTORIZED PAVEMENT MARKINGS								PREFAB PAV MRKS		RAISED PAV MRKS		DELINEATORS
	ITEM 666								ITEM 668		ITEM 672		ITEM 658
	TY 1(W) 4" (BRK) (100 MIL)	TY 1(W) 4" (SLD) (100 MIL)	TY 1(W) 8" (SLD) (100 MIL)	TY 1(W) 12" (SLD) (100 MIL)	TY 1(W) 24" (SLD) (100 MIL)	TY 1(Y) 4" (BRK) (100 MIL)	TY 1(Y) 4" (SLD) (100 MIL)	TY 1(Y) 12" (SLD) (100 MIL)	TY B (W) (ARROW)	TY B (W) (WORD)	REFL PAV MRK TY I-C	REFL PAV MRK TY II-A-A	INSTL DEL ASSN
12+64 - 17+00	174		145	138	33		840	2	2	18	21		
17+00 - 21+00	145						938	2		7	19	9	
<b>SHEET TOTAL</b>	<b>319</b>		<b>145</b>	<b>138</b>	<b>33</b>		<b>1778</b>	<b>4</b>	<b>2</b>	<b>23</b>	<b>40</b>	<b>9</b>	

**PAVEMENT MARKINGS LEGEND:**

- TYPE I-THERMOPLASTIC W/  
RETROREFLECTIVITY  
REQUIREMENTS (ITEM 666)**
- A** 4" WHITE SOLID
  - B** 4" WHITE BROKEN
  - F** 4" YELLOW SOLID
  - G** 4" YELLOW BROKEN
- TYPE I-THERMOPLASTIC (ITEM 666)**
- C** 8" WHITE SOLID
  - D** 12" WHITE SOLID
  - E** 24" WHITE SOLID
  - F** 12" YELLOW SOLID
- PREFAB. PAVEMENT MARKERS  
TYPE B (ITEM 668)**
- H** SINGLE ARROW WHITE
  - I** WORD "ONLY" WHITE
- REFLECTIVE PAVEMENT MARKERS  
(ITEM 672)**
- J** TYPE I-C REFLECTIVE CL B
  - K** TYPE II-AA REFLECTIVE CL B
- ← TRAFFIC FLOW

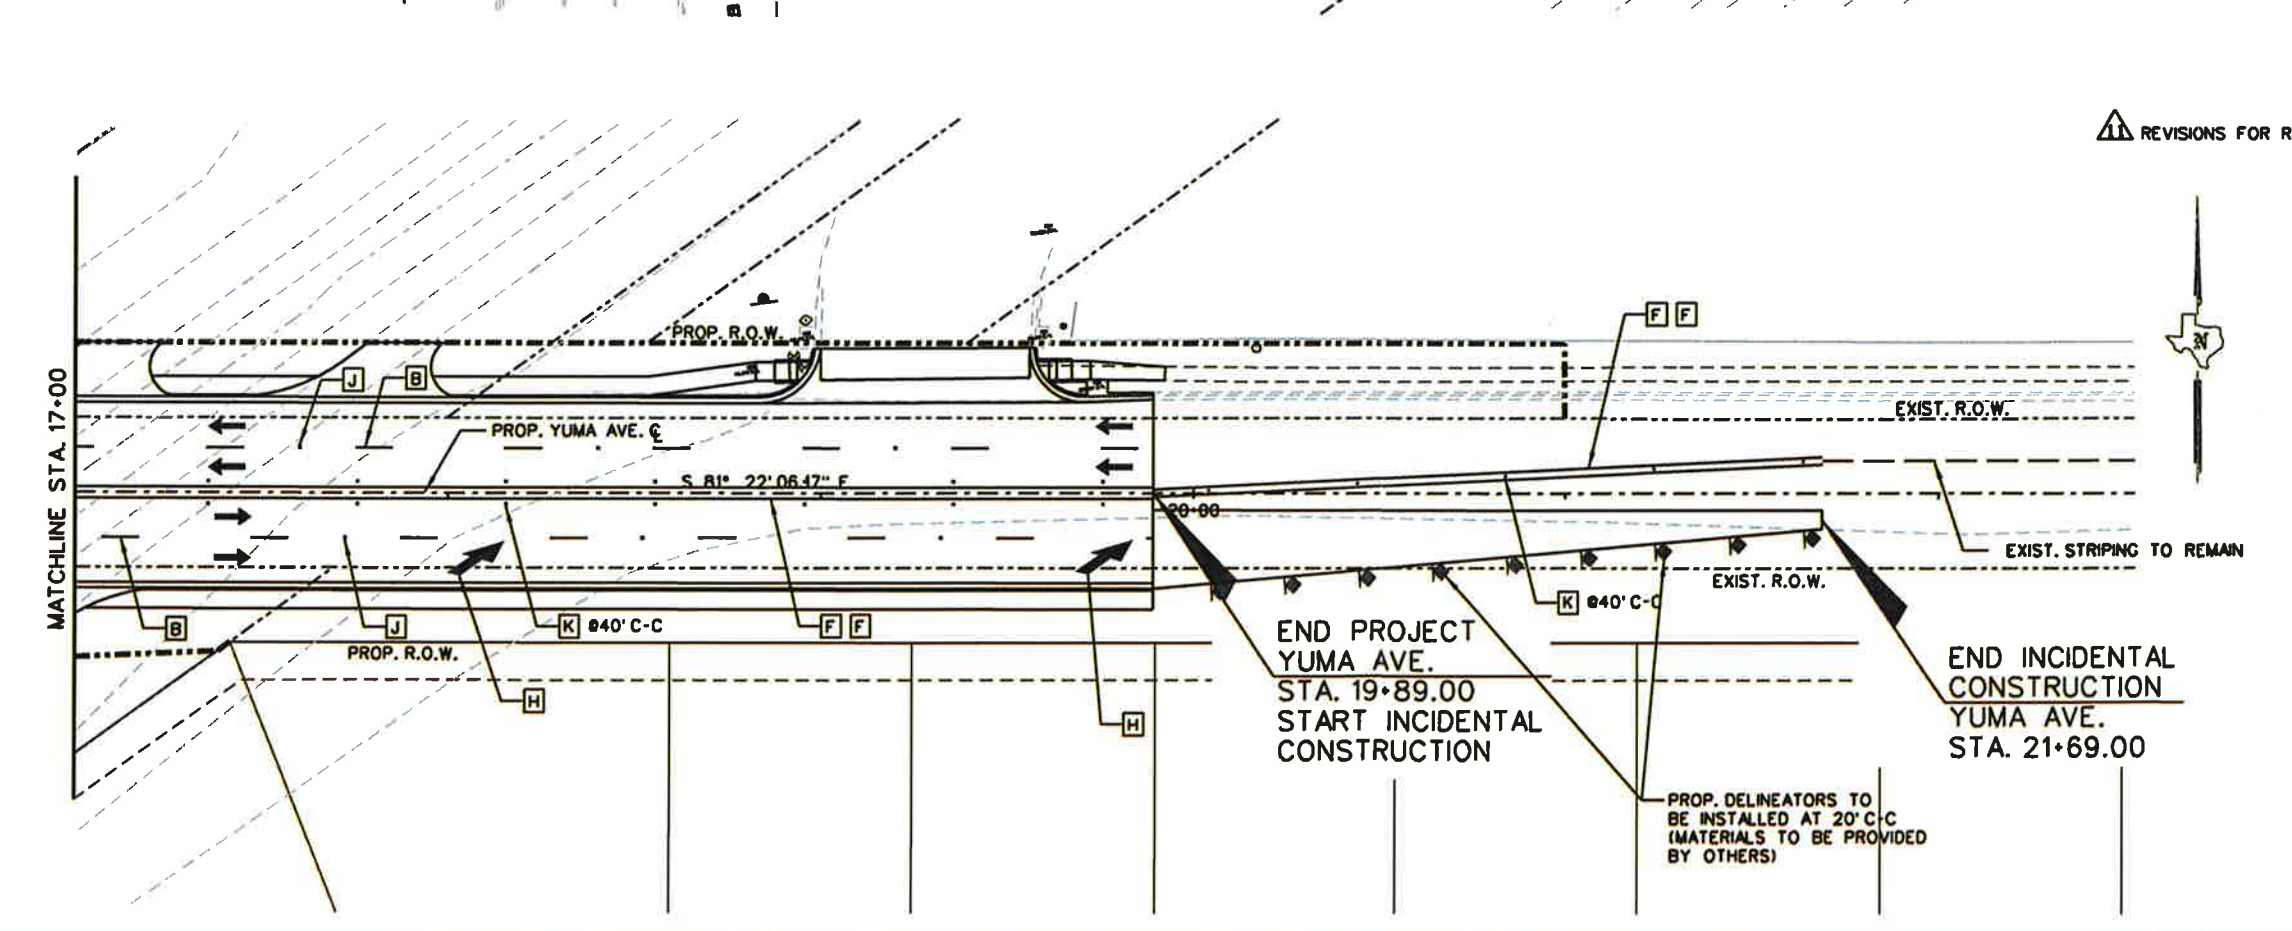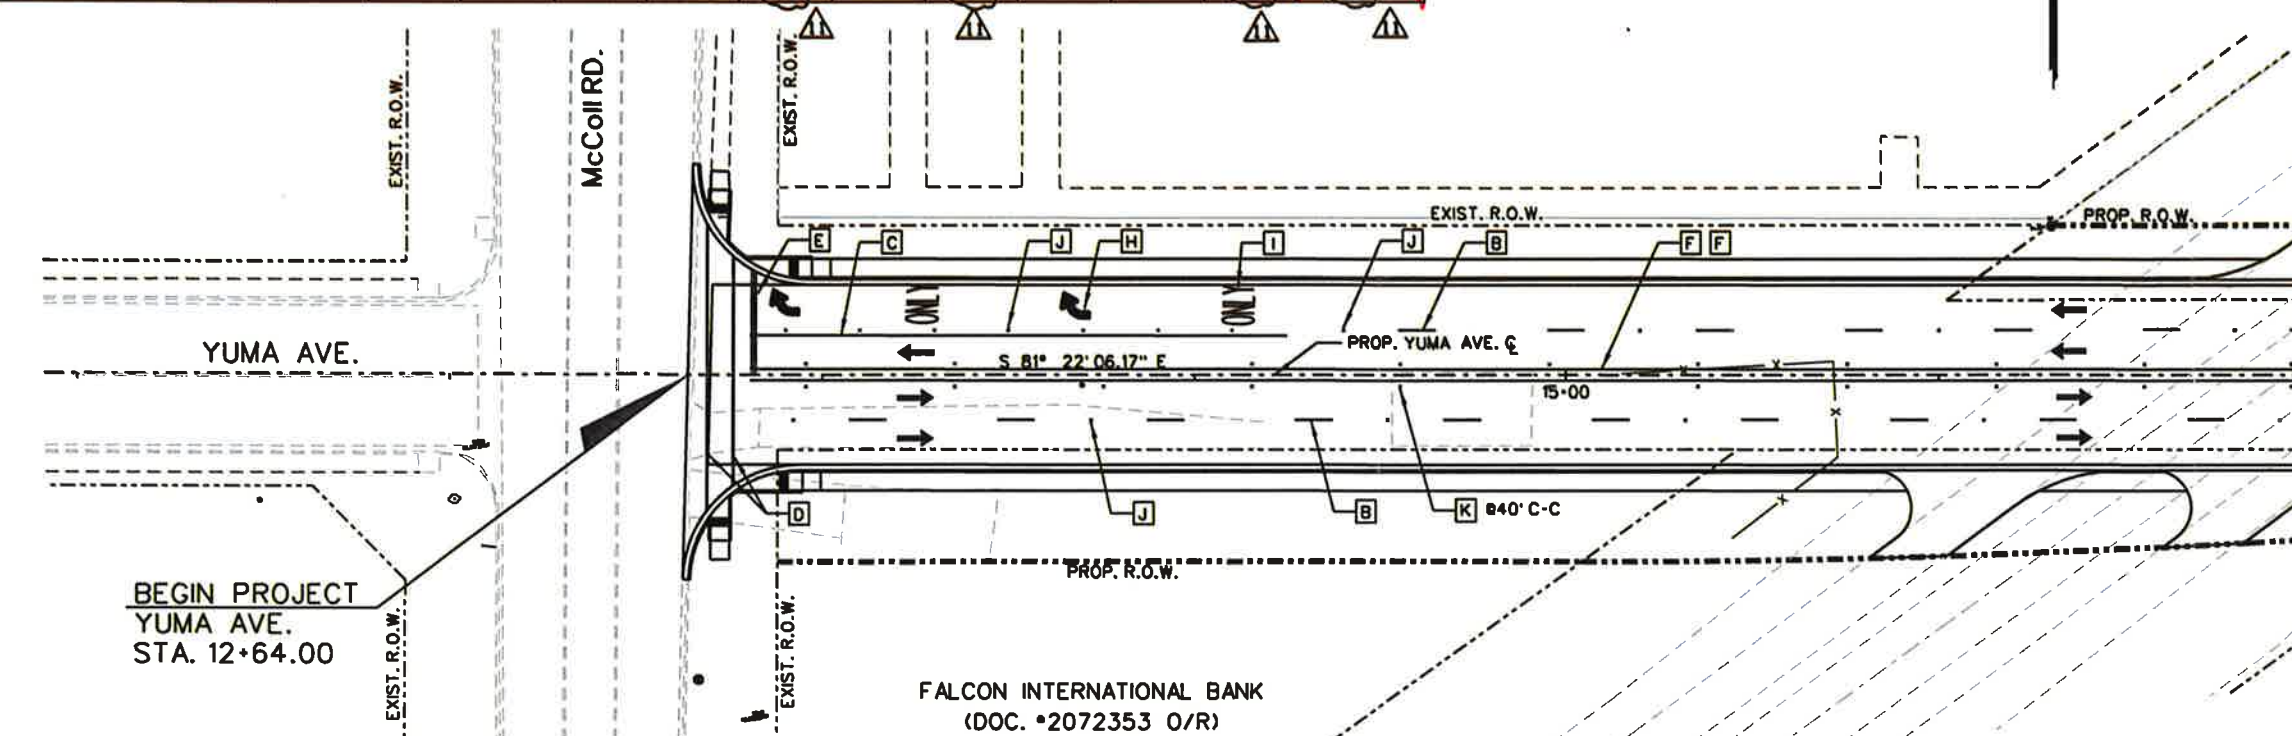

- NOTES:**
1. THE PAVEMENT SURFACE SHALL BE FREE OF DELETERIOUS MATERIAL BEFORE APPLICATION OF PERMANENT STRIPING AND PAVEMENT MARKERS. IF THE SURFACE NEEDS TO BE CLEANED, AS DETERMINED BY THE ENGINEER, THE CONTRACTOR SHALL PREPARE SURFACE IN ACCORDANCE WITH ITEM 678, "PAVEMENT SURFACE PREPARATION FOR MARKINGS", EXCEPT FOR "MEASUREMENT" AND "PAYMENT". THE PREPARATION OF PAVEMENT SURFACE SHALL BE SUBSIDIARY TO ITEM 666, 668 AND 672.
  2. ALL PERMANENT PAVEMENT MARKINGS SHALL BE THERMOPLASTIC 100 MIL.



REVISIONS FOR RFI NO. 11



**L&G Engineering** 2100 W. Expressway 83  
Mercedes, TX, 78570  
Phone : (956) 585-9813  
Fax : (956) 585-9018

Highway / Civil  
Structural / Bridge  
Environmental  
Firm No. : F-4105

900 S. Stewart Rd. Ste. 10  
Mission, TX, 78572  
Phone : (956) 585-1909  
Fax : (956) 585-1927

**YUMA AVE.  
PAVEMENT MARKINGS  
STA. 12+64 TO STA. 21+00**

SCALE: 1" = 50' SHEET 1 OF 1

DRAWN	DATE	STATE	PROJECT NO.	SHEET NO.
CD	8/23/17	TEXAS		YUMA
DESIGNED		COUNTY		
CHKD		PHR	HIDALGO	64

K:\Counties\HDP\Project 2\YUMA RD\07 TRAFFIC\04 Pavement Markings\YUMA\_PMD1.dgn 10/23/2017

## Lydia Rodriguez

---

**From:** Eugene Palacios <epalacios@mcallen.net>  
**Sent:** Tuesday, October 24, 2017 8:14 AM  
**To:** Lydia Rodriguez  
**Cc:** Marlen Garza; David Del Rio; armando.garzajr@co.hidalgo.tx.us; 'Robert Macheska'; 'Arnold Cortez'; 'Yara M. Corbitt'; isaac@texascordia.com; 'Ruben'; 'Roy Chapa'; 'Jose Castro'; 'Rodolfo Trevino'; 'Isabel Martinez'; 'Arturo Garcia'; 'Ricardo Gallaga'; Yvette Barrera  
**Subject:** RE: Yuma Avenue Extension Project  
**Attachments:** YUMA\_PM01.pdf

Lydia,

Please see attached PDF for revised pavement markings layout. After completed, please notify David or myself so we can meet for a walk through, then open roadway to traffic I am available anytime today and tomorrow.

Thank you,

Eugene Palacios, PE, CFM  
Transportation Engineer

---

### City of McAllen

Engineering Department  
311 N. 15<sup>th</sup> Street  
McAllen, Texas 78501  
O [956.681.1151](tel:956.681.1151) C [956.648.9535](tel:956.648.9535)

**From:** Lydia Rodriguez [mailto:lydia@texascordia.com]  
**Sent:** Tuesday, October 24, 2017 6:54 AM  
**To:** Eugene Palacios <epalacios@mcallen.net>  
**Cc:** Marlen Garza <marlen.garza@mcallen.net>; David Del Rio <ddelrio@mcallen.net>; armando.garzajr@co.hidalgo.tx.us; 'Robert Macheska' <rmacheska@lengineers.com>; 'Arnold Cortez' <acortez@lengineers.com>; 'Yara M. Corbitt' <yara@texascordia.com>; isaac@texascordia.com; 'Ruben' <ruben@texascordia.com>; 'Roy Chapa' <roy@texascordia.com>; 'Jose Castro' <jose@texascordia.com>; 'Rodolfo Trevino' <rodolfo@texascordia.com>; 'Isabel Martinez' <isabel@texascordia.com>; 'Arturo Garcia' <agarcia@arcgeotx.com>; 'Ricardo Gallaga' <ricardo@lengineers.com>; Yvette Barrera <ybarrera@mcallen.net>  
**Subject:** RE: Yuma Avenue Extension Project  
**Importance:** High

Good Morning Mr. Palacios:

Will there be additional pavement markings? Roadway is ready for public use. We request a walk-thru. Your help is greatly appreciated.

Sincerely,  
Lydia Rodriguez

**From:** Lydia Rodriguez [<mailto:lydia@texascordia.com>]

**Sent:** Monday, October 23, 2017 8:07 AM

**To:** 'Eugene Palacios' <[epalacios@mcallen.net](mailto:epalacios@mcallen.net)>

**Cc:** 'Marlen Garza' <[marlen.garza@mcallen.net](mailto:marlen.garza@mcallen.net)>; 'David Del Rio' <[ddelrio@mcallen.net](mailto:ddelrio@mcallen.net)>; 'armando.garzajr@co.hidalgo.tx.us' <[armando.garzajr@co.hidalgo.tx.us](mailto:armando.garzajr@co.hidalgo.tx.us)>; 'Robert Macheska' <[rmacheska@lgengineers.com](mailto:rmacheska@lgengineers.com)>; 'Arnold Cortez' <[acortez@lgengineers.com](mailto:acortez@lgengineers.com)>; 'Yara M. Corbitt' <[yara@texascordia.com](mailto:yara@texascordia.com)>; 'isaac@texascordia.com' <[isaac@texascordia.com](mailto:isaac@texascordia.com)>; 'Ruben' <[ruben@texascordia.com](mailto:ruben@texascordia.com)>; 'Roy Chapa' <[roy@texascordia.com](mailto:roy@texascordia.com)>; 'Jose Castro' <[jose@texascordia.com](mailto:jose@texascordia.com)>; 'Rodolfo Trevino' <[rodolfo@texascordia.com](mailto:rodolfo@texascordia.com)>; 'Isabel Martinez' <[isabel@texascordia.com](mailto:isabel@texascordia.com)>; 'Arturo Garcia' <[agarcia@arcgeotx.com](mailto:agarcia@arcgeotx.com)>; 'Ricardo Gallaga' <[ricardo@lgengineers.com](mailto:ricardo@lgengineers.com)>

**Subject:** RE: Yuma Avenue Extension Project

**Importance:** High

Good Morning Mr. Palacios:

Please provide status on additional pavement markings for the east bound traveling lane. Road is ready for public use.

Sincerely,

Lydia Rodriguez

**From:** Lydia Rodriguez [<mailto:lydia@texascordia.com>]

**Sent:** Wednesday, October 18, 2017 11:06 AM

**To:** 'Eugene Palacios' <[epalacios@mcallen.net](mailto:epalacios@mcallen.net)>

**Cc:** 'Marlen Garza' <[marlen.garza@mcallen.net](mailto:marlen.garza@mcallen.net)>; 'David Del Rio' <[ddelrio@mcallen.net](mailto:ddelrio@mcallen.net)>; 'armando.garzajr@co.hidalgo.tx.us' <[armando.garzajr@co.hidalgo.tx.us](mailto:armando.garzajr@co.hidalgo.tx.us)>; 'Robert Macheska' <[rmacheska@lgengineers.com](mailto:rmacheska@lgengineers.com)>; 'Arnold Cortez' <[acortez@lgengineers.com](mailto:acortez@lgengineers.com)>; 'Yara M. Corbitt' <[yara@texascordia.com](mailto:yara@texascordia.com)>; 'isaac@texascordia.com' <[isaac@texascordia.com](mailto:isaac@texascordia.com)>; 'Ruben' <[ruben@texascordia.com](mailto:ruben@texascordia.com)>; 'Roy Chapa' <[roy@texascordia.com](mailto:roy@texascordia.com)>; 'Jose Castro' <[jose@texascordia.com](mailto:jose@texascordia.com)>; 'Rodolfo Trevino' <[rodolfo@texascordia.com](mailto:rodolfo@texascordia.com)>; 'Isabel Martinez' <[isabel@texascordia.com](mailto:isabel@texascordia.com)>; 'Arturo Garcia' <[agarcia@arcgeotx.com](mailto:agarcia@arcgeotx.com)>; 'Ricardo Gallaga' <[ricardo@lgengineers.com](mailto:ricardo@lgengineers.com)>

**Subject:** RE: Yuma Avenue Extension Project

Good Morning Mr. Palacios:

Per our conversation, L&G Engineering is looking into the east bound traveling lane pavement markings. Your help expediting this matter is appreciated.

Sincerely,

Lydia Rodriguez

**From:** Lydia Rodriguez [<mailto:lydia@texascordia.com>]

**Sent:** Tuesday, October 17, 2017 1:03 PM

**To:** 'Eugene Palacios' <[epalacios@mcallen.net](mailto:epalacios@mcallen.net)>

**Cc:** 'Marlen Garza' <[marlen.garza@mcallen.net](mailto:marlen.garza@mcallen.net)>; 'David Del Rio' <[ddelrio@mcallen.net](mailto:ddelrio@mcallen.net)>; 'armando.garzajr@co.hidalgo.tx.us' <[armando.garzajr@co.hidalgo.tx.us](mailto:armando.garzajr@co.hidalgo.tx.us)>; 'Robert Macheska' <[rmacheska@lgengineers.com](mailto:rmacheska@lgengineers.com)>; 'Arnold Cortez' <[acortez@lgengineers.com](mailto:acortez@lgengineers.com)>; 'Yara M. Corbitt' <[yara@texascordia.com](mailto:yara@texascordia.com)>; 'isaac@texascordia.com' <[isaac@texascordia.com](mailto:isaac@texascordia.com)>; 'Ruben' <[ruben@texascordia.com](mailto:ruben@texascordia.com)>; 'Roy Chapa' <[roy@texascordia.com](mailto:roy@texascordia.com)>; 'Jose Castro' <[jose@texascordia.com](mailto:jose@texascordia.com)>; 'Rodolfo Trevino' <[rodolfo@texascordia.com](mailto:rodolfo@texascordia.com)>; 'Isabel Martinez' <[isabel@texascordia.com](mailto:isabel@texascordia.com)>; 'Arturo Garcia' <[agarcia@arcgeotx.com](mailto:agarcia@arcgeotx.com)>; 'Ricardo Gallaga' <[ricardo@lgengineers.com](mailto:ricardo@lgengineers.com)>

**Subject:** RE: Yuma Avenue Extension Project

Thank you Mr. Palacios.

**From:** Eugene Palacios [<mailto:epalacios@mcallen.net>]

**Sent:** Tuesday, October 17, 2017 11:39 AM

**To:** Lydia Rodriguez <[lydia@texascordia.com](mailto:lydia@texascordia.com)>

**Cc:** Marlen Garza <[marlen.garza@mcallen.net](mailto:marlen.garza@mcallen.net)>; David Del Rio <[ddelrio@mcallen.net](mailto:ddelrio@mcallen.net)>; [armando.garzajr@co.hidalgo.tx.us](mailto:armando.garzajr@co.hidalgo.tx.us); 'Robert Macheska' <[rmacheska@lgengineers.com](mailto:rmacheska@lgengineers.com)>; 'Arnold Cortez' <[acortez@lgengineers.com](mailto:acortez@lgengineers.com)>; 'Yara M. Corbitt' <[yara@texascordia.com](mailto:yara@texascordia.com)>; [isaac@texascordia.com](mailto:isaac@texascordia.com); 'Ruben' <[ruben@texascordia.com](mailto:ruben@texascordia.com)>; 'Roy Chapa' <[roy@texascordia.com](mailto:roy@texascordia.com)>; 'Jose Castro' <[jose@texascordia.com](mailto:jose@texascordia.com)>; 'Rodolfo Trevino' <[rodolfo@texascordia.com](mailto:rodolfo@texascordia.com)>; 'Isabel Martinez' <[isabel@texascordia.com](mailto:isabel@texascordia.com)>; 'Arturo Garcia' <[agarcia@arcgeotx.com](mailto:agarcia@arcgeotx.com)>; 'Ricardo Gallaga' <[ricardo@lgengineers.com](mailto:ricardo@lgengineers.com)>

**Subject:** RE: Yuma Avenue Extension Project

Ms. Rodriguez,

The pavement markings layout along with the tie into existing Yuma is being reviewed by our traffic section. I should have a response by the end of the day. There is concern for merge and shift condition, specifically at night, for East bound travelers of Yuma. Once everything checks out, we will respond accordingly.

Thank you,

Eugene Palacios, PE, CFM  
Transportation Engineer

---

## City of McAllen

Engineering Department  
311 N. 15<sup>th</sup> Street  
McAllen, Texas 78501  
O [956.681.1151](tel:956.681.1151) C [956.648.9535](tel:956.648.9535)

**From:** Lydia Rodriguez [<mailto:lydia@texascordia.com>]

**Sent:** Tuesday, October 17, 2017 8:31 AM

**To:** Eugene Palacios <[epalacios@mcallen.net](mailto:epalacios@mcallen.net)>

**Cc:** Marlen Garza <[marlen.garza@mcallen.net](mailto:marlen.garza@mcallen.net)>; David Del Rio <[ddelrio@mcallen.net](mailto:ddelrio@mcallen.net)>; [armando.garzajr@co.hidalgo.tx.us](mailto:armando.garzajr@co.hidalgo.tx.us); 'Robert Macheska' <[rmacheska@lgengineers.com](mailto:rmacheska@lgengineers.com)>; 'Arnold Cortez' <[acortez@lgengineers.com](mailto:acortez@lgengineers.com)>; 'Yara M. Corbitt' <[yara@texascordia.com](mailto:yara@texascordia.com)>; [isaac@texascordia.com](mailto:isaac@texascordia.com); 'Ruben' <[ruben@texascordia.com](mailto:ruben@texascordia.com)>; 'Roy Chapa' <[roy@texascordia.com](mailto:roy@texascordia.com)>; 'Jose Castro' <[jose@texascordia.com](mailto:jose@texascordia.com)>; 'Rodolfo Trevino' <[rodolfo@texascordia.com](mailto:rodolfo@texascordia.com)>; 'Isabel Martinez' <[isabel@texascordia.com](mailto:isabel@texascordia.com)>; 'Arturo Garcia' <[agarcia@arcgeotx.com](mailto:agarcia@arcgeotx.com)>; 'Ricardo Gallaga' <[ricardo@lgengineers.com](mailto:ricardo@lgengineers.com)>

**Subject:** RE: Yuma Avenue Extension Project

Mr. Palacios:

I spoke with David Del Rio and he advised he is requesting additional pavement markings. Once again, Yuma Ave. is ready to be opened. Barricades are being removed by traveling public and road is being used. Your help is greatly appreciated.

Sincerely,  
Lydia Rodriguez

**From:** Lydia Rodriguez [<mailto:lydia@texascordia.com>]

**Sent:** Monday, October 16, 2017 7:52 AM

**To:** 'Eugene Palacios' <[epalacios@mcallen.net](mailto:epalacios@mcallen.net)>

**Cc:** 'Marlen Garza' <[marlen.garza@mcallen.net](mailto:marlen.garza@mcallen.net)>; 'David Del Rio' <[ddelrio@mcallen.net](mailto:ddelrio@mcallen.net)>;

'armando.garzajr@co.hidalgo.tx.us' <[armando.garzajr@co.hidalgo.tx.us](mailto:armando.garzajr@co.hidalgo.tx.us)>; 'Robert Macheska'

<[rmacheska@lgengineers.com](mailto:rmacheska@lgengineers.com)>; 'Arnold Cortez' <[acortez@lgengineers.com](mailto:acortez@lgengineers.com)>; 'Yara M. Corbitt'

<[yara@texascordia.com](mailto:yara@texascordia.com)>; 'isaac@texascordia.com' <[isaac@texascordia.com](mailto:isaac@texascordia.com)>; 'Ruben' <[ruben@texascordia.com](mailto:ruben@texascordia.com)>; 'Roy

Chapa' <[roy@texascordia.com](mailto:roy@texascordia.com)>; 'Jose Castro' <[jose@texascordia.com](mailto:jose@texascordia.com)>; 'Rodolfo Trevino' <[rodolfo@texascordia.com](mailto:rodolfo@texascordia.com)>;

'Isabel Martinez' <[isabel@texascordia.com](mailto:isabel@texascordia.com)>; 'Arturo Garcia' <[agarcia@arcgeotx.com](mailto:agarcia@arcgeotx.com)>

**Subject:** Yuma Avenue Extension Project

Good Morning Mr. Palacios:

Pavement markings was completed this weekend and street is ready to be opened to the public, but Mr. David Del Rio, Inspector, has requested additional signage. Please advise on how to proceed.

Sincerely,

**Lydia Rodriguez**

**Project Controls**



---

3149-A Center Pointe Dr., Edinburg, TX 78539

956.627.6181 Office

956.445.7651 Cell

956.386.0289 Fax

*Trust in the LORD with all your heart  
and lean not on your own understanding;  
in all your ways acknowledge him,  
and he will direct your paths. Proverbs 3, 5-6*

*Disclaimer: If you are not the intended recipient or have received this e-mail in error, please notify me via return e-mail and telephone at 956-681-1000, and permanently delete and purge the original and any copy thereof. This e-mail, with attachments hereto, if any, is intended only for receipt and use by the addressee(s) named herein, and may contain legally privileged and/or confidential information. Regardless of address or routing, if you are not the intended recipient, then you are hereby notified that any use, copying, reproduction, dissemination, distribution, or transmission of this e-mail, and any attachments hereto, is strictly prohibited. Whereas all reasonable steps have been taken to ensure the accuracy and confidentiality of the information and data submitted herein, the City of McAllen and its employees are not liable if information or data is corrupted or does not reach its intended destination.*

*Disclaimer: If you are not the intended recipient or have received this e-mail in error, please notify me via return e-mail and telephone at 956-681-1000, and permanently delete and purge the original and any copy thereof. This e-mail, with attachments hereto, if any, is intended only for receipt and use by the addressee(s) named herein, and may contain legally privileged and/or confidential information. Regardless of address or routing, if you are not the intended recipient, then you are hereby notified that any use, copying, reproduction, dissemination, distribution, or transmission of this e-mail, and any attachments hereto, is strictly prohibited. Whereas all reasonable steps have been taken to ensure the accuracy and confidentiality of the information and data submitted herein, the City of McAllen and its employees are not liable if information or data is corrupted or does not reach its intended destination.*



**CITY OF  
McALLEN**

ENGINEERING DEPARTMENT

**TRANSMITTAL**

<b>TO:</b>	Hidalgo County Precinct No 2
<b>ATTN:</b>	Mr. Armando Garza
<b>FROM:</b>	Mr. Eugene Palacios, PE <i>EP</i>

<b>DATE:</b>	10/31/2017
<b>RE:</b>	Yuma Ave Ext Project

- WE ARE SENDING YOU:**
- Attached
  - Under separate cover via
  - Shop Drawings
  - Copy of Letter
  - Invoices
  - Prints
  - Change Order
  - Specifications
  - Test Reports
  - Other:

QUANTITY	DESCRIPTION
1	Change Order Request from Texas Cordia Construction, LLC
1	Pay Application from Texas Cordia Construction, LLC

**TRANSMITTED ARE AS CHECKED BELOW:**

- For Approval
- For Correction
- Approved
- For Your Use
- For Payment
- As Requested
- Please forward

**Remarks:**

The City of McAllen has no exceptions to these requests. If we can provide any additional information, please don't hesitate to ask. Thank you

\_\_\_\_\_  
 \_\_\_\_\_  
 \_\_\_\_\_  
 \_\_\_\_\_

**PRINT:** \_\_\_\_\_

**SIGNED:** *Man*  
**RECEIVED BY:** \_\_\_\_\_

2017 OCT 31 PM 3 28  
 HIDALGO COUNTY  
 PRECINCT NO. 2

DATE & TIME RECEIVED: