

Please send signed agreement to:
American Electric Power
Attn: CIAC Admin Pharr North SC
5700 N Cage Blvd
Pharr, TX 78577-7921

Company No: 211

Bill To:
Urban County Program

Contract No: DWMS00000566368

Date: 3/29/2023

PRO FORMA

Customer No:
Purchase Order: 84517778

Description	Quantity	UOM	Init Amt	Net Amount
CYVEN HERNANDEZ-DESIGNER-INSTALL 38 194W-LED STREEYLIGHTS WITH 14FT BRACKETS,10 SECONDARY AND 4 PRIMARY POLES @Pino St, Arboledas Dr, La Fuente Dr, La plaza Dr, La Plaza Cir, Rodriguez St and Salinas St	1.0	EA	24,954.36	24,954.36

Amount Due: 24,954.36

Agreement instructions:

Step 1: A signed agreement is required regardless of how payment will be made. Email your signed agreement to your AEP Representative.

Step 2: Once the agreement has been processed, your AEP Representative will provide you with an invoice (**this may take 3-5 business days**).

Step 3: Follow payment instructions on bottom of invoice or customer payment option handout provided by your AEP representative.

AEP Texas

Contribution-In-Aid-Of-Construction Agreement
For Electric Distribution Service

Urban County Program
Service: N TOM GILL RD
PENITAS, TX

Contract #: DWMS00000566368 Work Request #: 84517778

Date: 3/29/2023

You, Urban County Program (Customer) have requested AEP Texas (Company) to install/construct certain electric distribution facilities (hereinafter referred to as "Facilities") as follows:CYVEN HERNANDEZ-DESIGNER-INSTALL 38 194W-LED STREYLIGHTS WITH 14FT BRACKETS,10 SECONDARY AND 4 PRIMARY POLES @Pino St, Arboledas Dr, La Fuente Dr, La plaza Dr, La Plaza Cir, Rodriguez St and Salinas St

The cost for construction/installation of the requested Facilities will be in excess of what would normally be provided by Company at no additional cost to the Customer to initiate service. In accordance with the Company's approved Tariff, as filed with the Public Utilities Commission of Texas, the Customer agrees to pay Company a one-time, non-refundable, Contribution-In-Aid-Of-Construction (CIAC) in the amount of 24,954.36. The Customer understands that he/she receives no ownership or control of the Facilities by virtue of the payment of the CIAC. The Facilities installed by the Company will remain the property of the Company. The Company expressly retains the right to use said Facilities for any purpose which Company deems appropriate under good utility practices, including the distribution of electric service to other customers.

Company agrees to INSTALL ALL AEP FACILITIES, and the Customer agrees to provide PAYMENT OF \$24,954.36 and to be ready to take electric service on or before 03/29/2023.

It is understood and agreed that the Company will not begin construction/installation of the Facilities until full payment of the CIAC has been received by the Company; therefore, Customer understands and agrees that he/she needs to make full payment of the CIAC in sufficient time to allow for the construction/installation to be completed by the In Service Date.

The pricing of the CIAC quoted herein is based on the specifics of the Customer's request, including the Customer's stated In Service Date, and must be accepted by the Customer by executing and returning to the Company this Agreement by 6/27/2023 to remain valid. Should Customer alter the request for facilities, or request a delay in (or is otherwise unable to take service by) the stated In Service Date, the Company reserves the right to update the pricing and require an additional CIAC payment to reflect any increases in cost due to the alteration in requested facilities or the delay in taking service, or both.


Nothing contained herein shall be construed as a waiver or relinquishment by Company of any right it has or may hereafter have to discontinue service for default in the payment of any bill owing or to become owing hereunder or for any reason or cause allowed by law.

By signing and returning this Agreement, Customer understands and accepts the above described terms and conditions.

Customer
By _____
Signature: _____
Title: _____
Date: _____

Company
By _____
Signature: _____
Title: _____
Date: _____

WR:84517778
Easement #:N/A

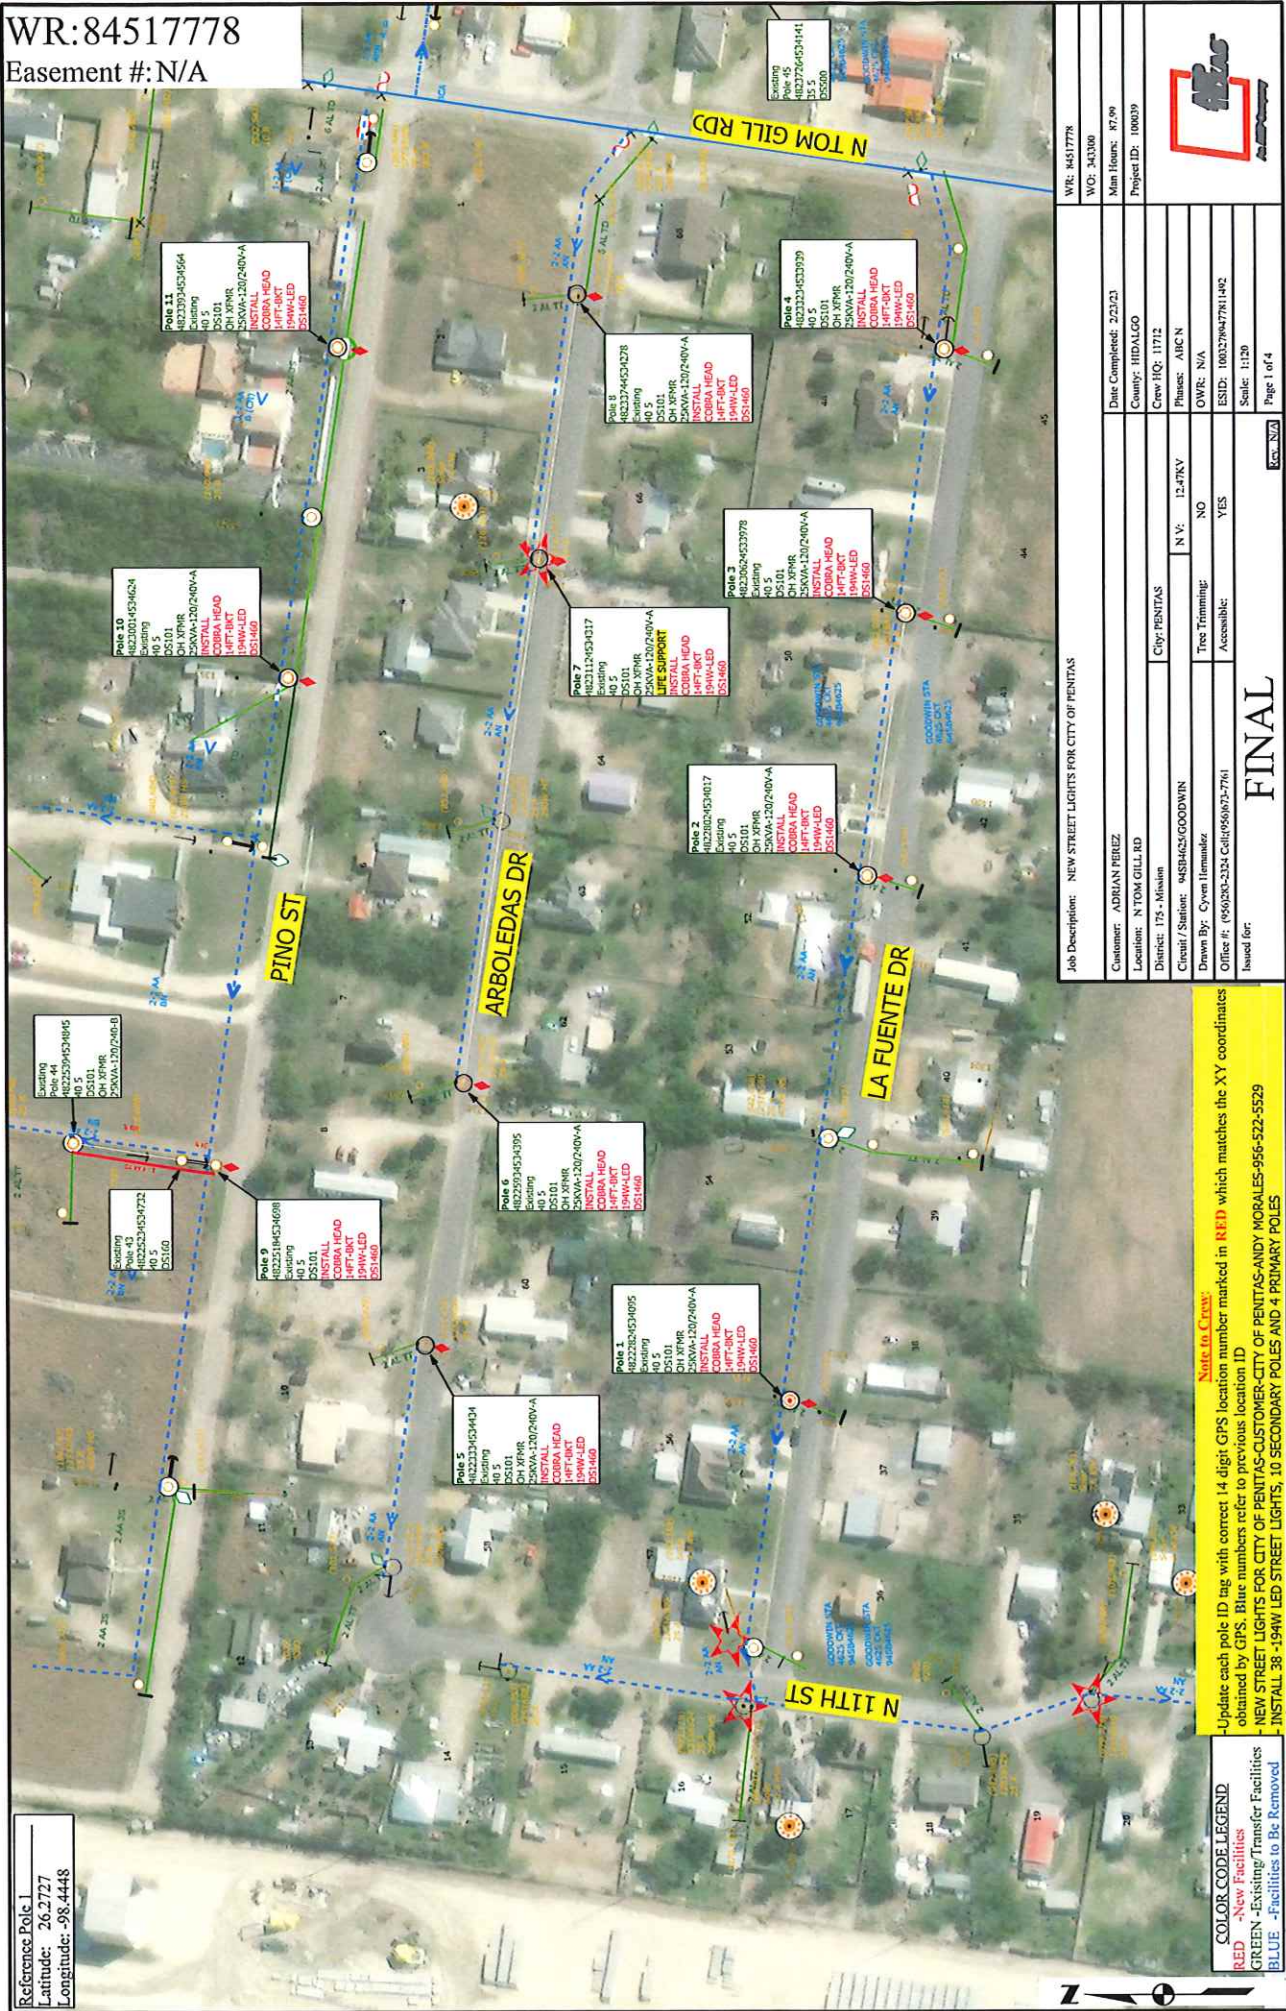


Reference Pole 1
Latitude: 26.2727
Longitude: -98.4448

Note to Crew:
Update each pole ID tag with correct 14 digit GPS location number marked in RED which matches the XY coordinates obtained by GPS. Blue numbers refer to previous location ID.
NEW STREET LIGHTS FOR CITY OF PENTITAS-CUSTOMER-CITY OF PENTITAS-ANDY MORALES-956-522-5529
INSTALL 38 - 194W LED STREET LIGHTS, 10 SECONDARY POLES AND 4 PRIMARY POLES

COLOR CODE LEGEND
RED - New Facilities
GREEN - Existing/Transfer Facilities
BLUE - Facilities to Be Removed


Job Description: NEW STREET LIGHTS FOR CITY OF PENTITAS	
Customer: ADRIAN PEREZ	Date Completed: 2/2/21
Location: N TOM GILL RD	County: HIDALGO
District: 175 - Mission	Crew: HQ: 11712
Circuit / Station: 04SRH425-GOODWIN	City: PENTITAS
Drawn By: Cyron Hernandez	N.V. 12.4KV
Office #: 1953503-333-Cent956927-7761	Tree Trimming: NO
Issued for:	Assessable: YES
	Phase: AIBC N
	OWR: N/A
	ESUD: 100329647781492
	Scale: 1:120
	Page 1 of 4

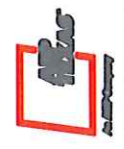

FINAL

WR:84517778
Easement #: N/A

Reference Pole 22
Latitude: 26.2736
Longitude: -98.4403

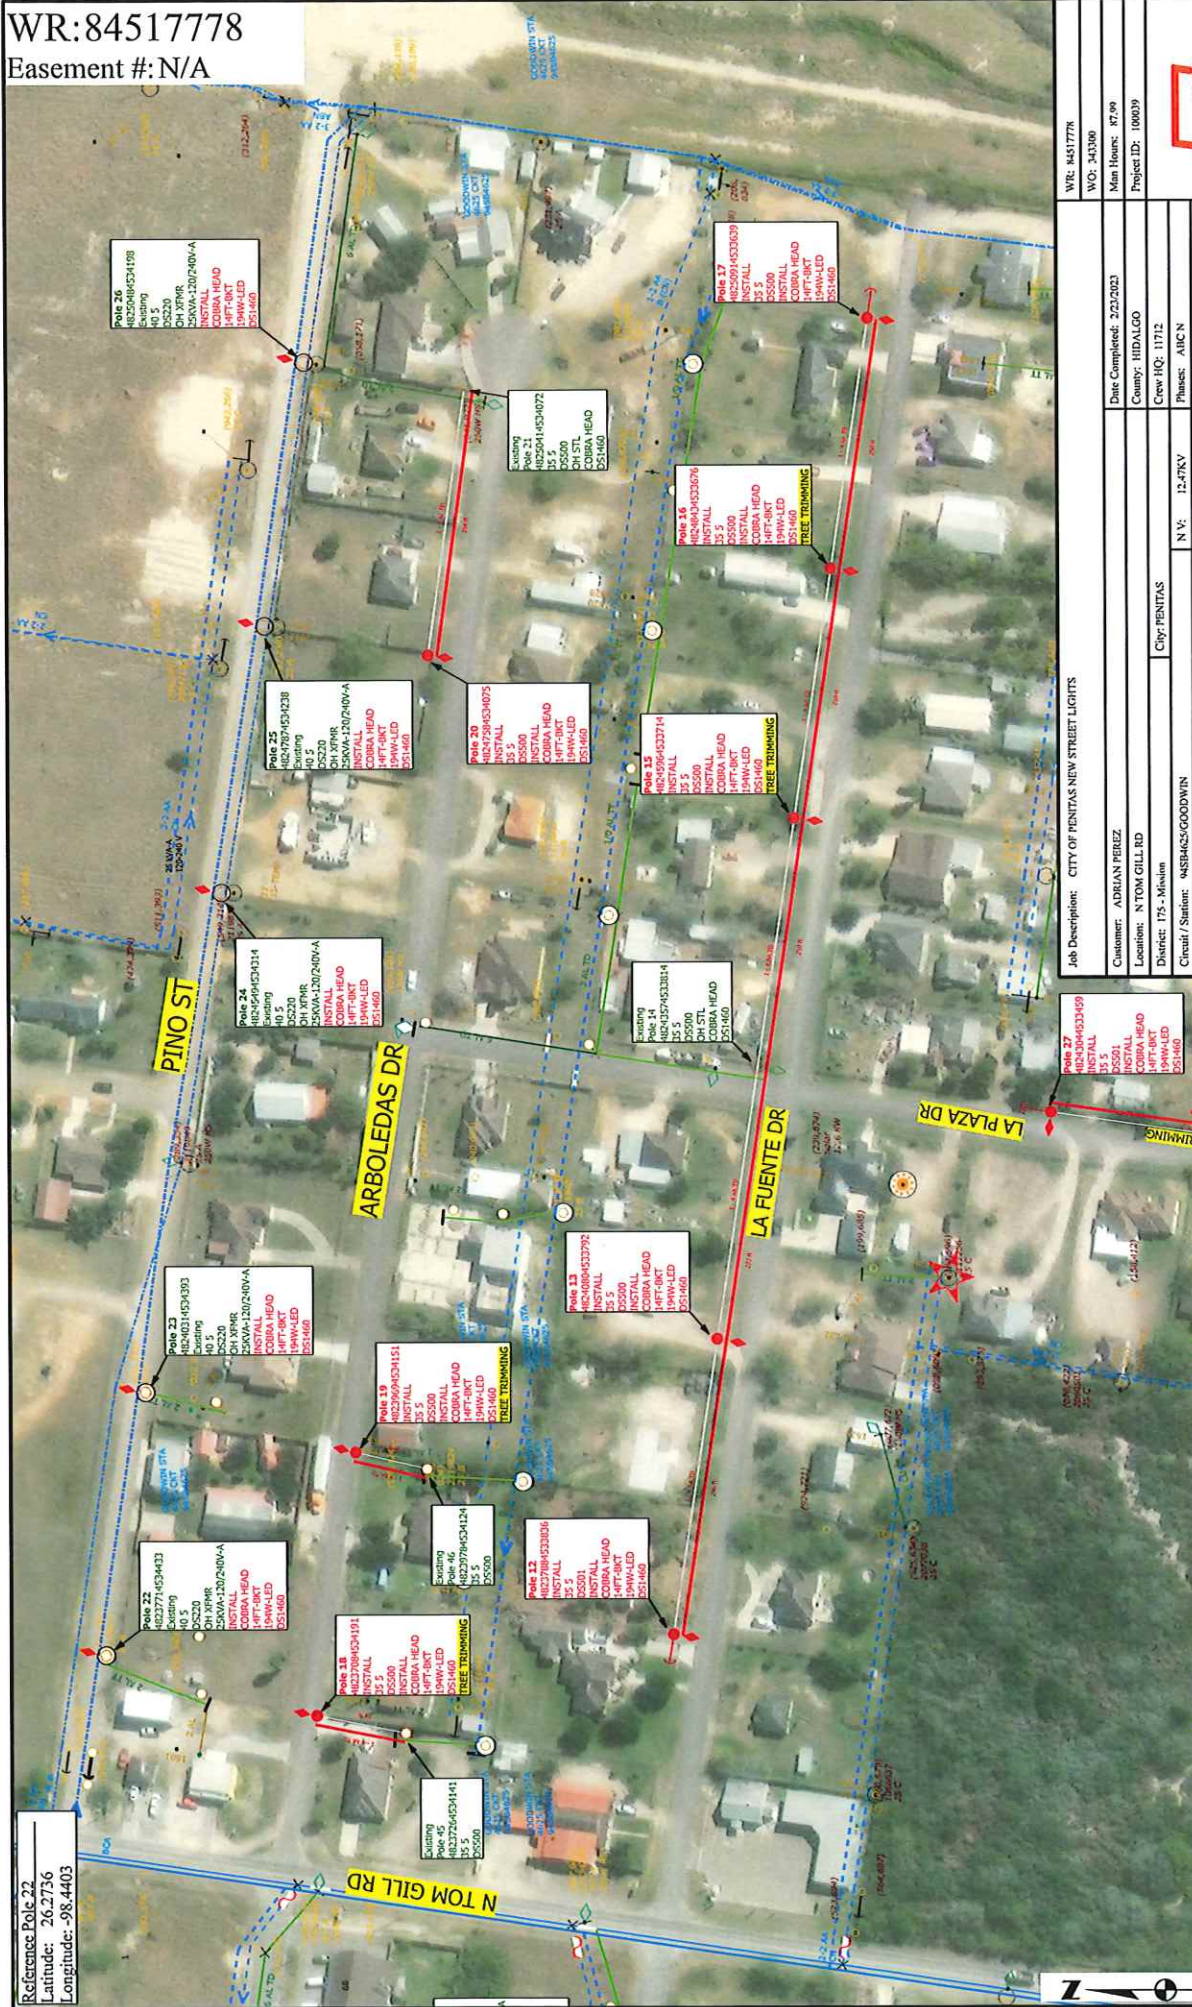

Note to Crew:
- Update each pole ID tag with correct 14 digit GPS location number marked in RED which matches the XY coordinates obtained by GPS. Pole numbers refer to previous location ID
- NEW STREET LIGHTS FOR CITY OF PENTAS-CUSTOMER-CITY OF PENTAS-ANDY MORALES-956-522-5529
- INSTALL 38-194H LED STREET LIGHTS, 10 SECONDARY POLES AND 4 PRIMARY POLES

COLOR CODE LEGEND
RED - New Facilities
GREEN - Existing/Transfer Facilities
BLUE - Facilities to Be Removed

Job Description: CITY OF PENTAS NEW STREET LIGHTS	
Customer: ADRIAN PEREZ	Date Completed: 2/23/2023
Location: N TOM GILL RD	County: HIDALGO
District: ITS - Mission	City: PENTAS
Circuit / Station: MSB465-GOODWIN	N.Y.: 12-PRV
Drawn By: Cyym Hernandez	Tree Trimming: YES
Office #: (950)293-2334 Cell:(956)72-7761	Accessible: YES
Issued for:	Scale: 1:120
	Page 2 of 4




FINAL

WR: 84517778
WC: 343300
Main Hours: 87.69
Project ID: 100839

Reference Pole 28
 Latitude: 26.2702
 Longitude: -98.4388

WR: 84517778
 Easement #: N/A

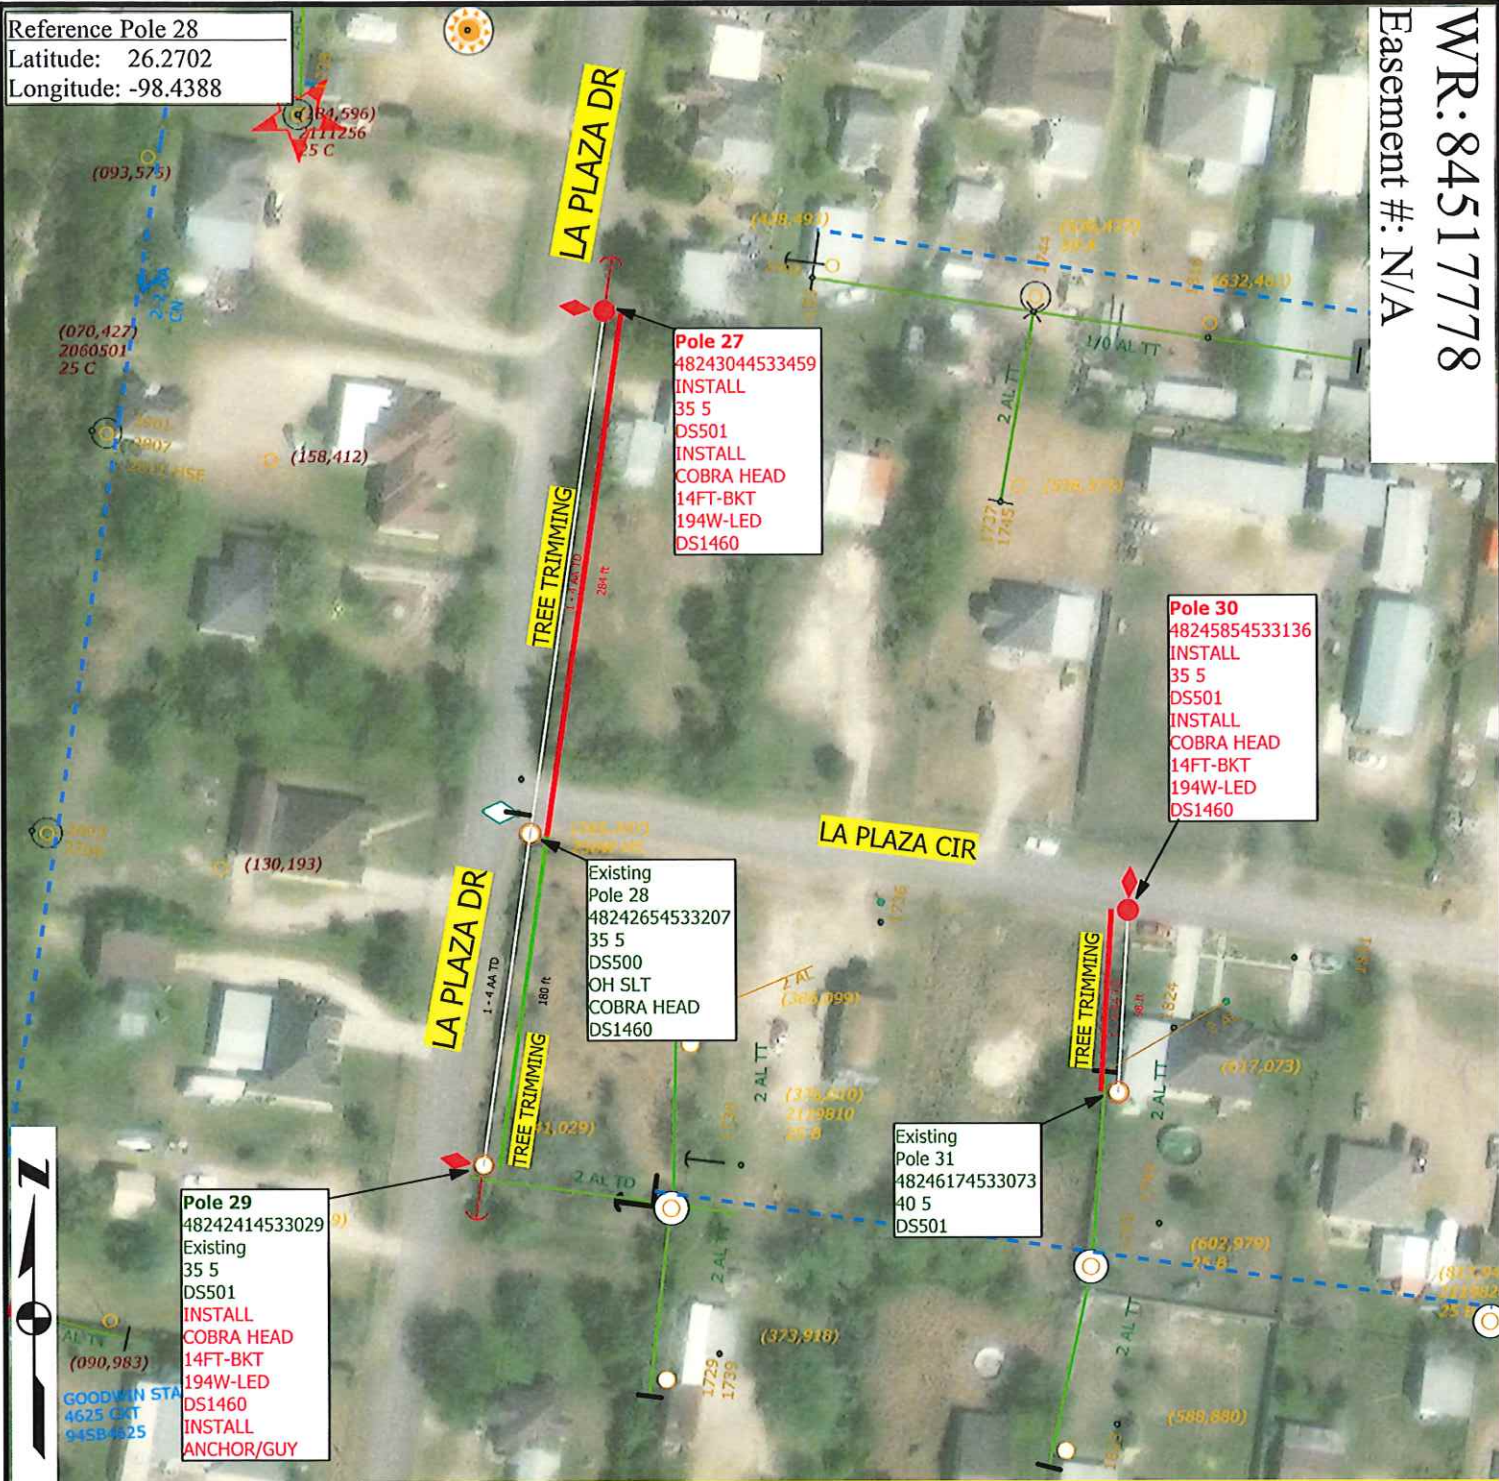

Pole 29
 48242414533029
 Existing
 35 5
 DS501
 INSTALL
 COBRA HEAD
 14FT-BKT
 194W-LED
 DS1460
 INSTALL
 ANCHOR/GUY

Existing
 Pole 28
 48242654533207
 35 5
 DS500
 OH SLT
 COBRA HEAD
 DS1460

Pole 27
 48243044533459
 INSTALL
 35 5
 DS501
 INSTALL
 COBRA HEAD
 14FT-BKT
 194W-LED
 DS1460

Pole 30
 48245854533136
 INSTALL
 35 5
 DS501
 INSTALL
 COBRA HEAD
 14FT-BKT
 194W-LED
 DS1460

Existing
 Pole 31
 48246174533073
 40 5
 DS501

Note to Crew:


-Update each pole ID tag with correct 14 digit GPS location number marked in **RED** which matches the XY coordinates obtained by GPS. **Blue** numbers refer to previous location ID
 - NEW STREET LIGHTS FOR CITY OF PENITAS-CUSTOMER-CITY OF PENITAS-ANDY MORALES-956-522-5529
 - INSTALL 38-194W LEDSTREET LIGHTS, 10 SECONDARY POLES AND 4 PRIMARY POLES

COLOR CODE LEGEND
RED -New Facilities
GREEN -Existing/Transfer Facilities
BLUE -Facilities to Be Removed

Job Description: CITY OF PENITAS NEW STREET LIGHTS		WR: 84517778
		WO: 343300
Customer: ADRIAN PEREZ	Date Completed: 2/23/2023	Man Hours: 87.99
Location: N TOM GILL RD	County: HIDALGO	Project ID: 100039
District: 175 - Mission	City: PENITAS	Crew HQ: 11712
Circuit / Station: 94SB4625/GOODWIN	N V: 12.47KV	Phases: B N
Drawn By: Cyven Hernandez	Tree Trimming: YES	OWR: 84292403
Office #: (956)283-2324 Cell:(956)673-7761	Accessible: YES	ESID: 10032789477811492
Issued for:	Scale: 1:100	
FINAL		Page 3 of 4
		Rev. N/A



WR:84517778
Easement #: N/A

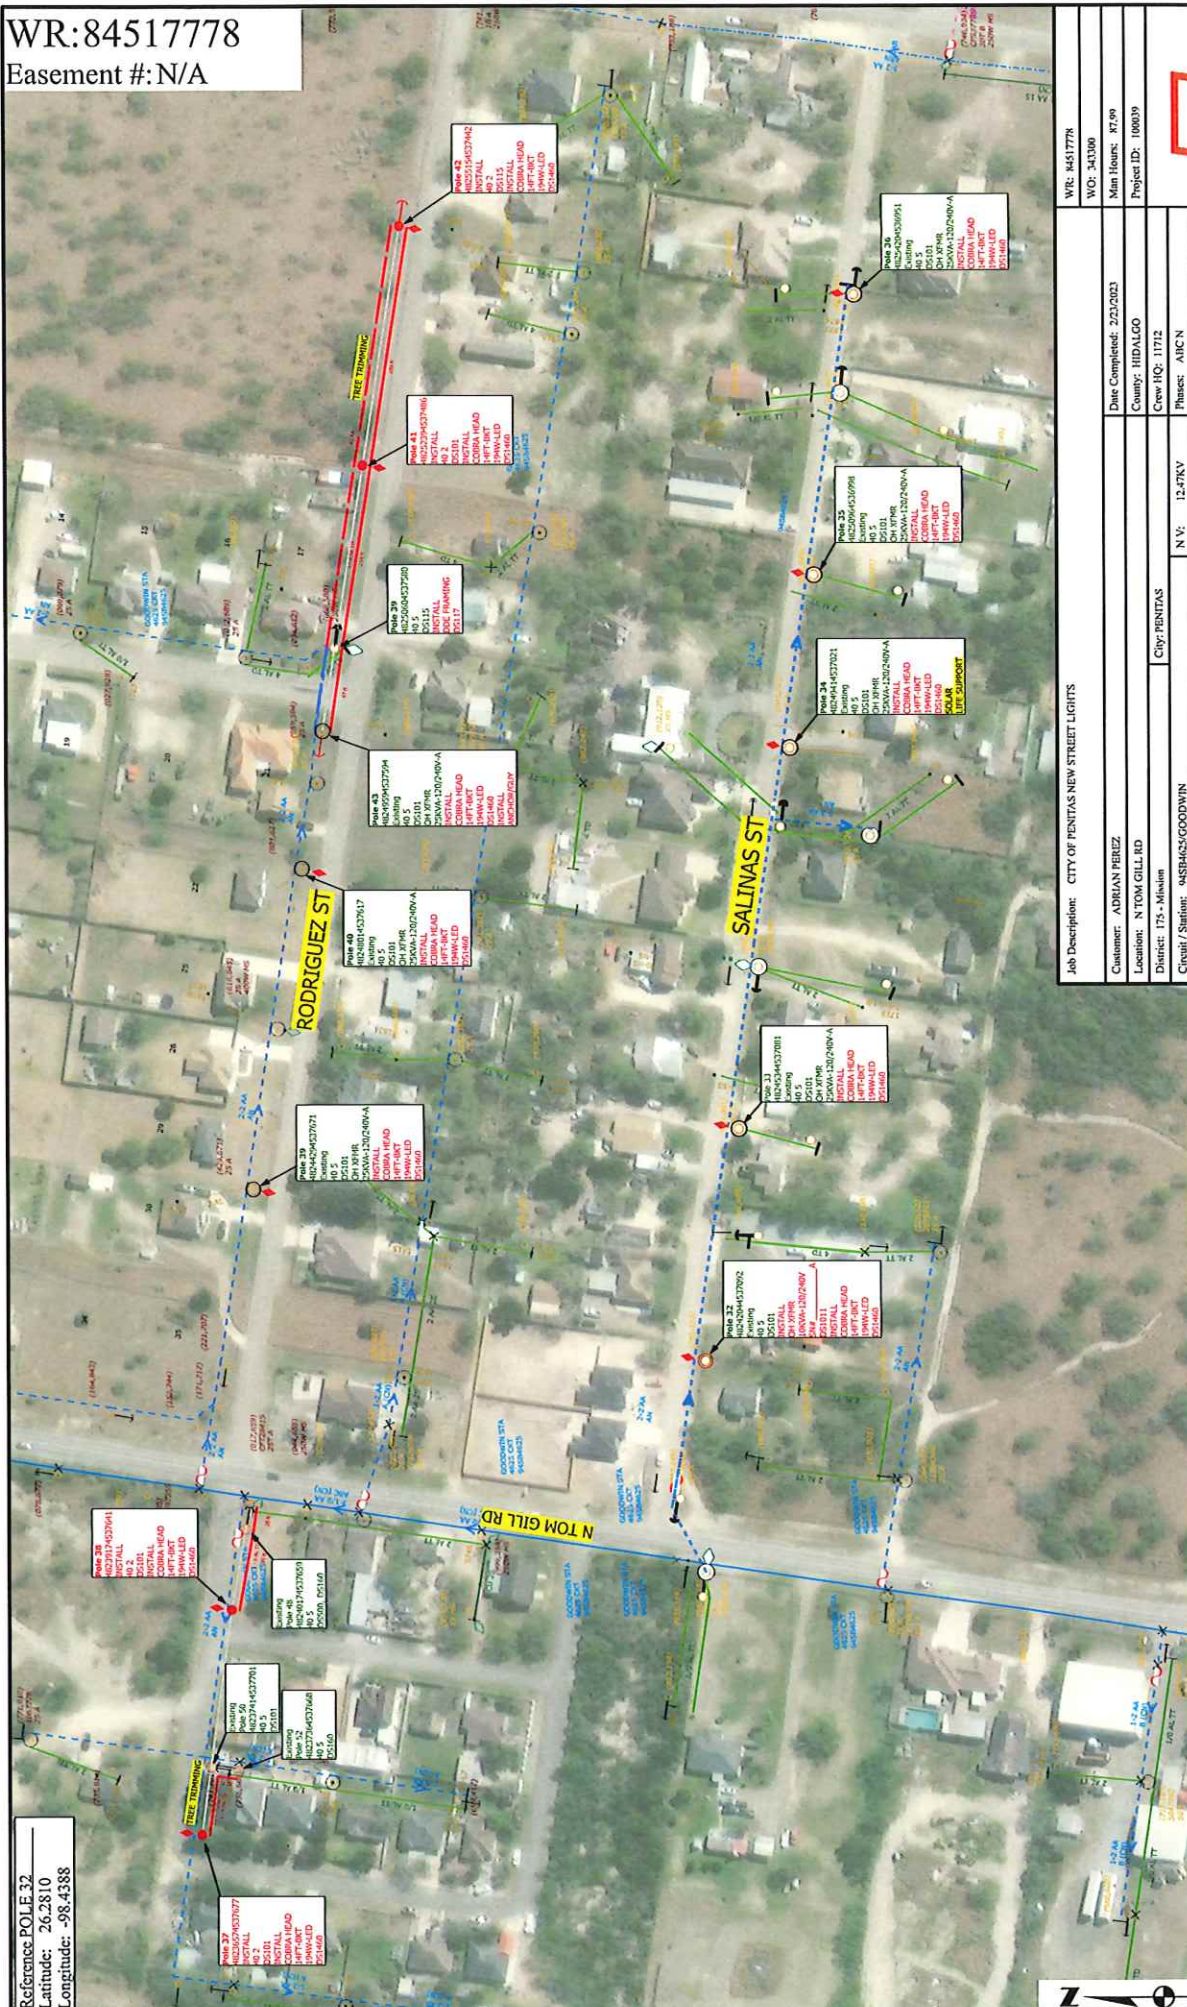

Reference POLE 32
Latitude: 26.2810
Longitude: -98.4388

Note to Crew:
Update each pole ID tag with correct 14 digit GPS location number marked in RED which matches the XY coordinates obtained by GPS. Blue numbers refer to previous location ID.
- NEW STREET LIGHTS FOR CITY OF PENITAS-CUSTOMER-CITY OF PENITAS-ANDY MORALES-956-522-5529
- INSTALL 38-194W LEDSTREET LIGHTS, 10 SECONDARY POLES AND 4 PRIMARY POLES

COLOR CODE LEGEND
RED - New Facilities
GREEN - Existing Transfer Facilities
BLUE - Facilities to Be Removed

Job Description: CITY OF PENITAS NEW STREET LIGHTS	
Customer: ADRIAN PEREZ	WR: 84517778
Location: N TOM GILL RD	WO: 341300
Date Completed: 2/21/2023	Main Hours: 8:00
County: HIDALGO	Project ID: 100039
City: PENITAS	Crew HQ: 11712
Phases: AMCN	N.V.: 12.4KV
Tree Trimming: YES	Access: YES
Drawn By: Cyren Hernandez	Scale: 1:140
Officer #: 060303-2321 Cell:9569672-7161	Page: 4 of 4
Issued for:	Sheet: 103



FINAL