




**1 TURNING EXHIBIT**  
1" = 30'-0"  
15'-0" 30'-0"

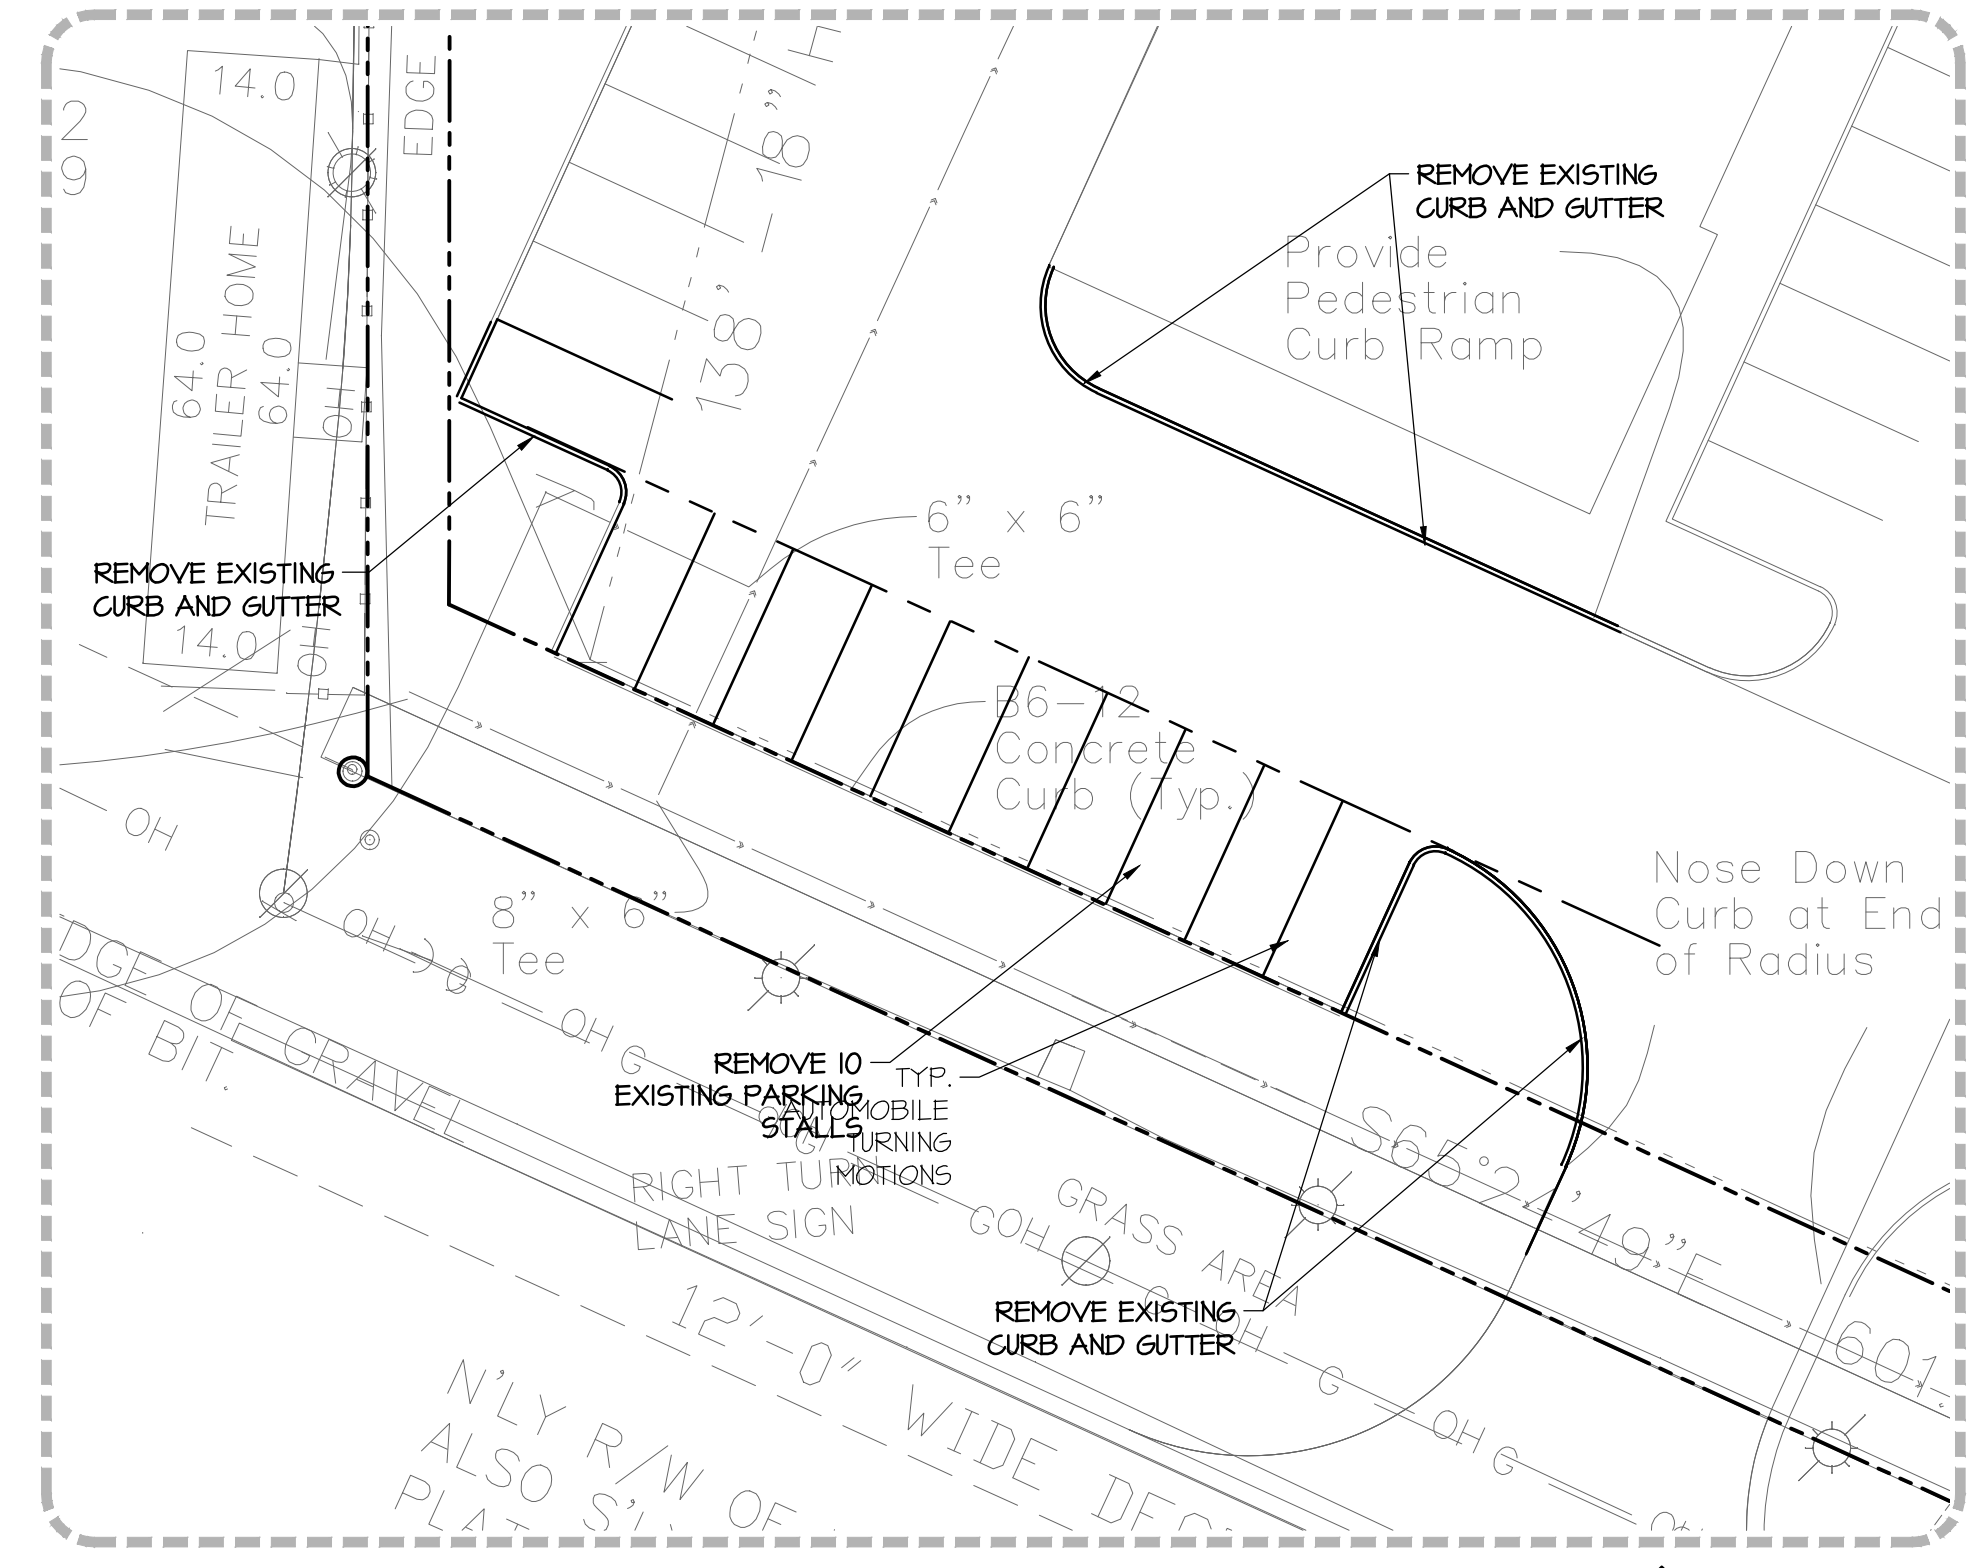


**2 REMOVALS PLAN**  
1" = 20'-0"  
10'-0" 20'-0"

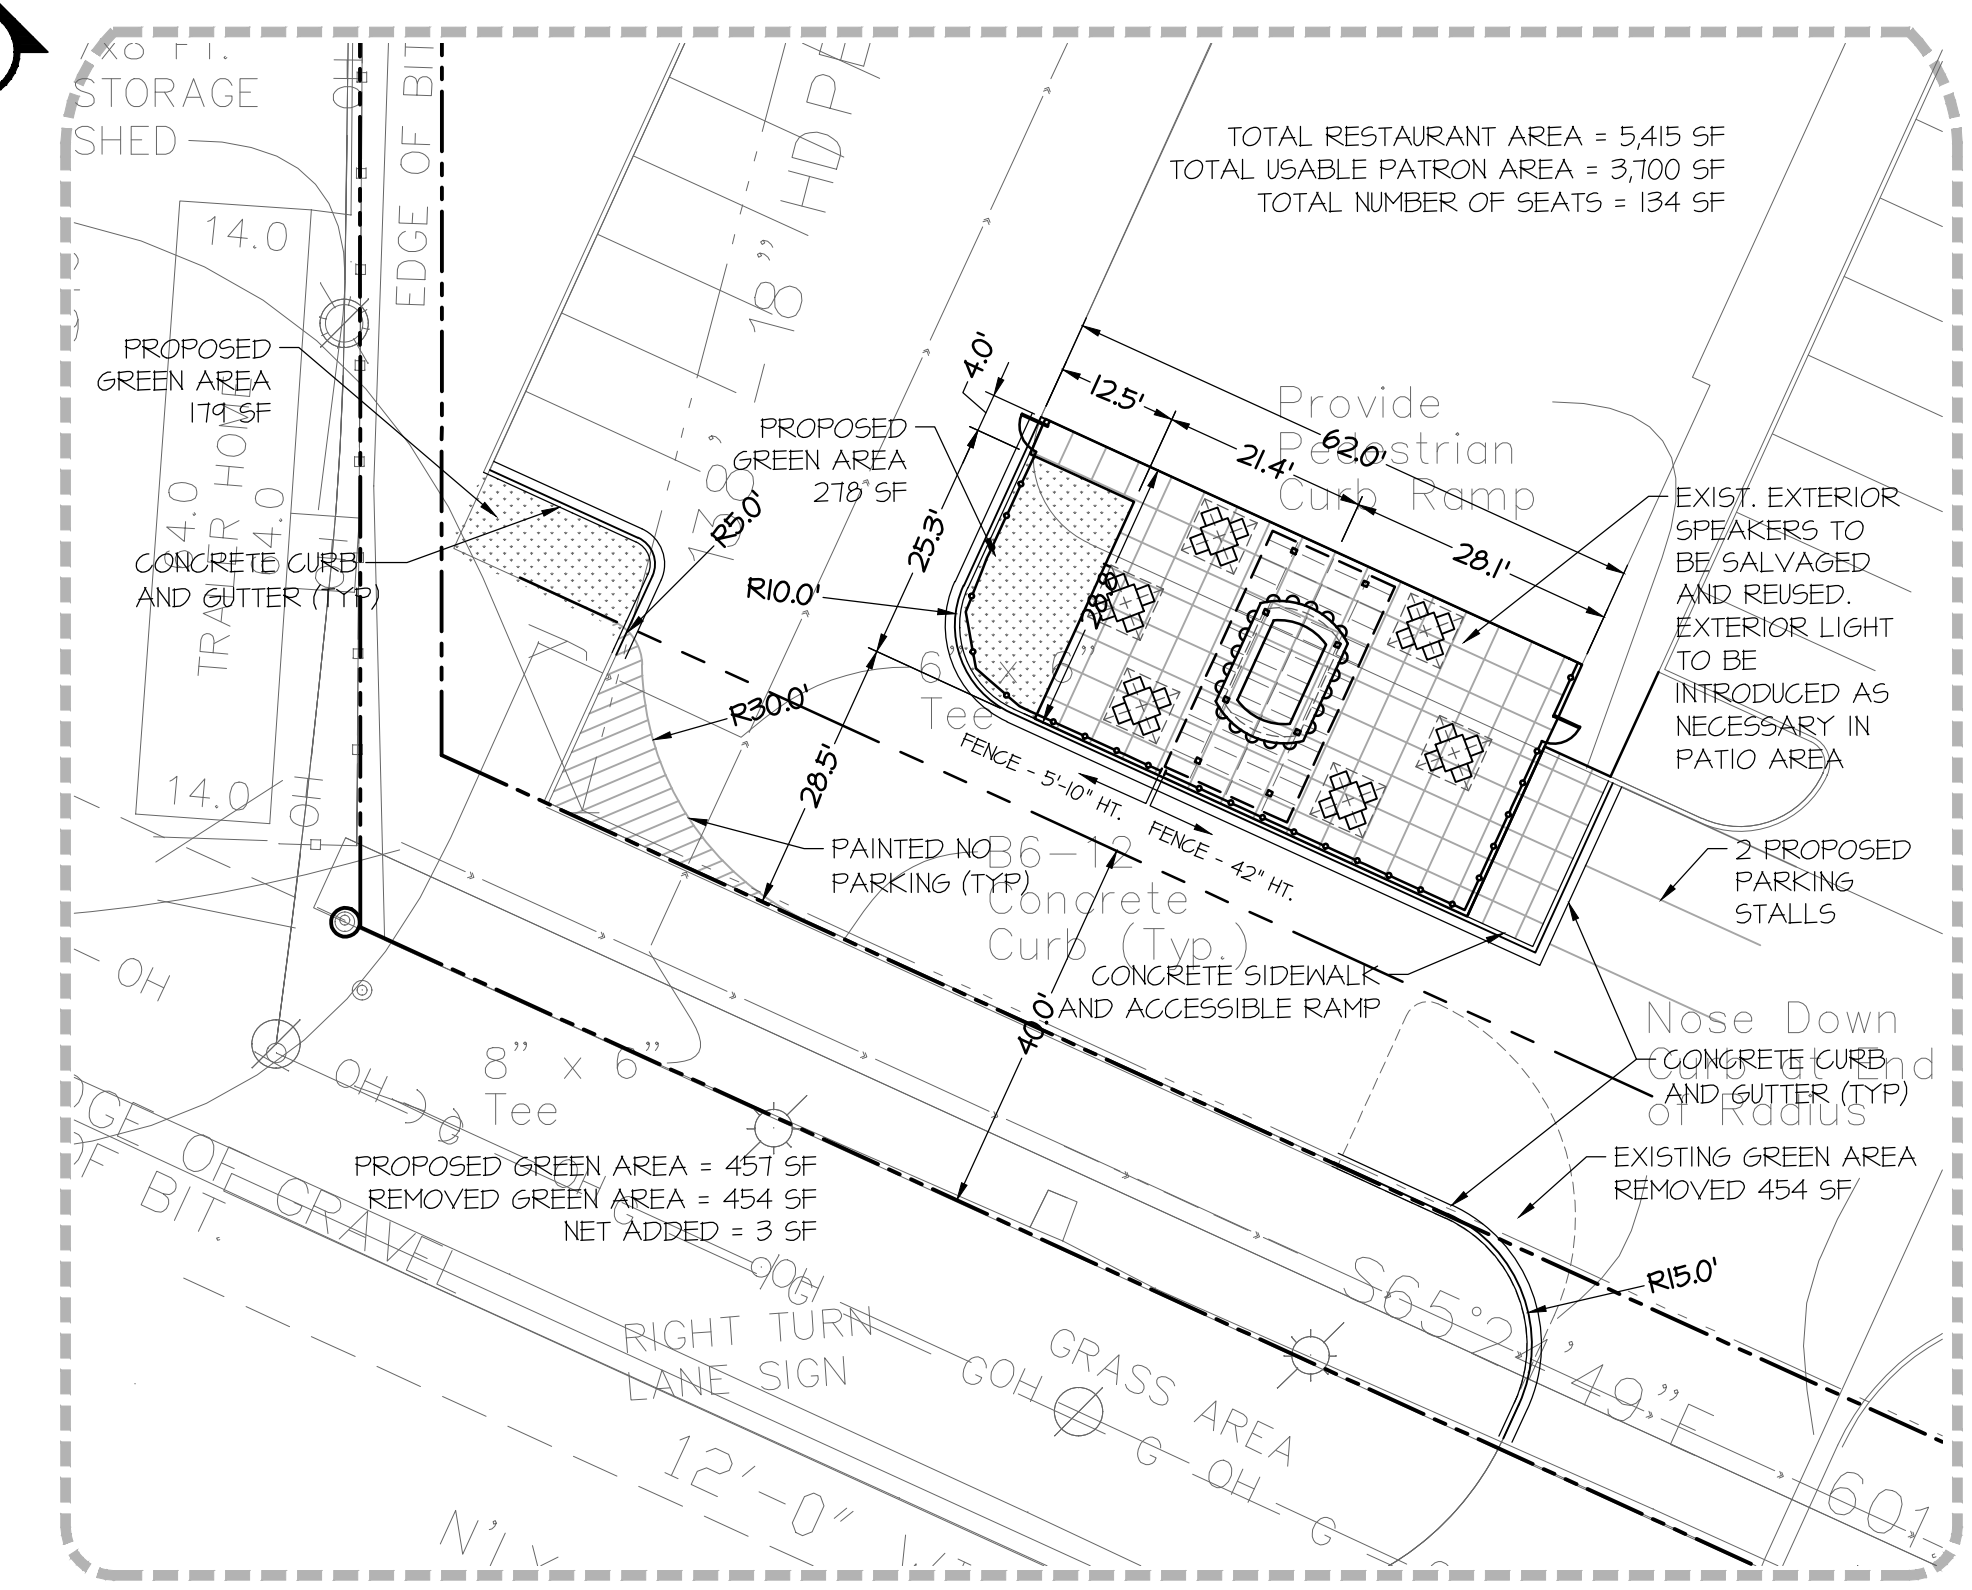


**3 SITE PLAN**  
1" = 20'-0"  
10'-0" 20'-0"

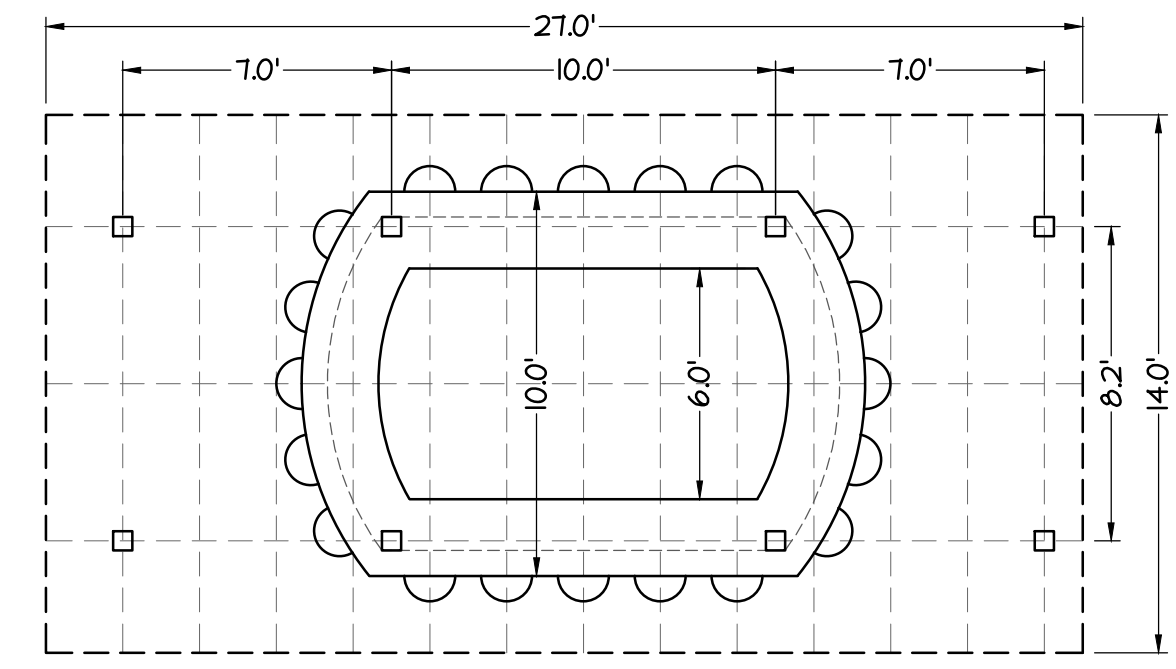

**4 BAR LAYOUT & STRUCTURE SCHEMATIC**  
1" = 5'-0"  
2'-6" 5'-0"

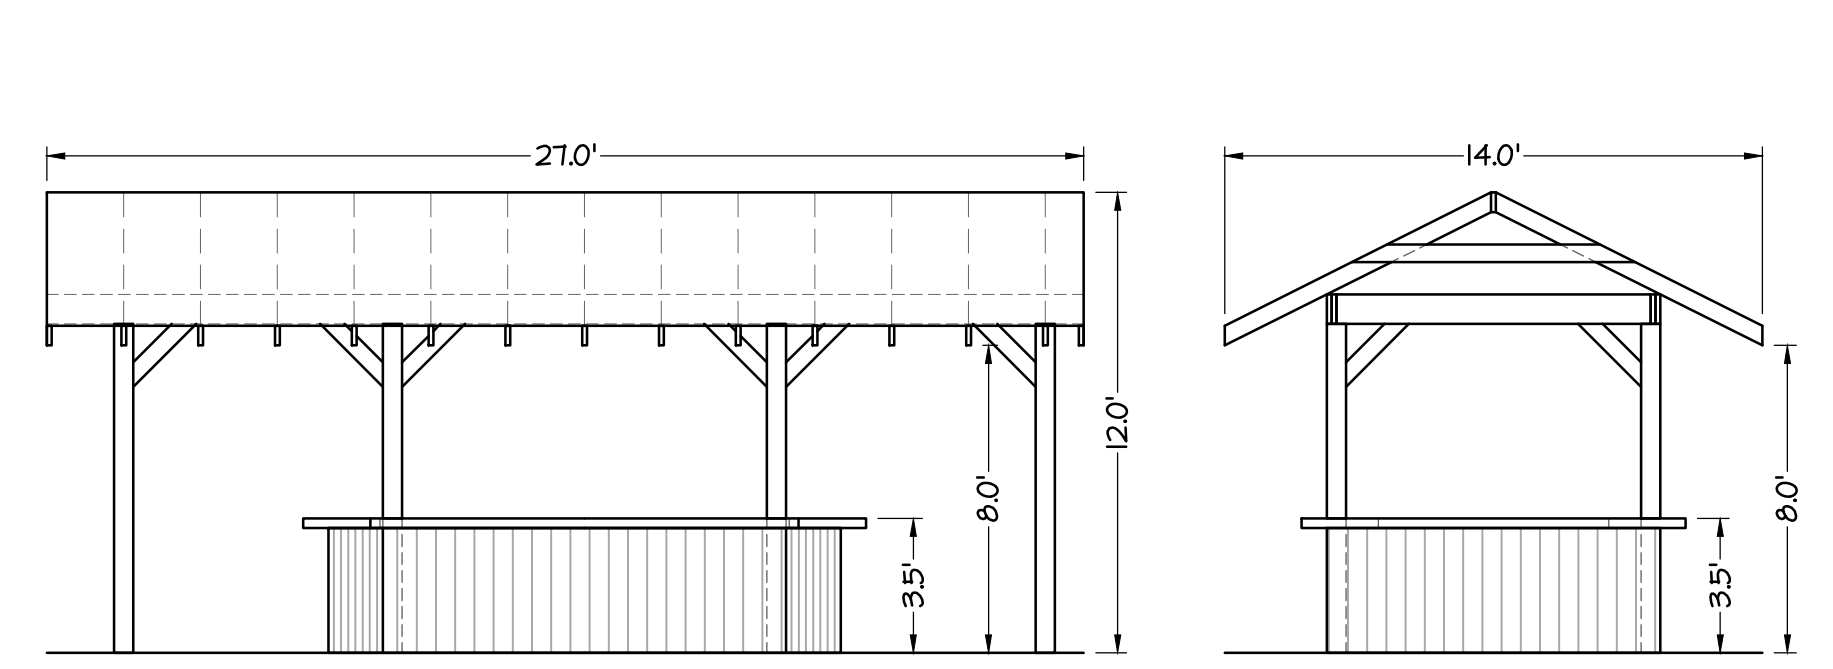

**5 BAR COLOR ELEVATIONS**  
1" = 5'-0"  
2'-6" 5'-0"

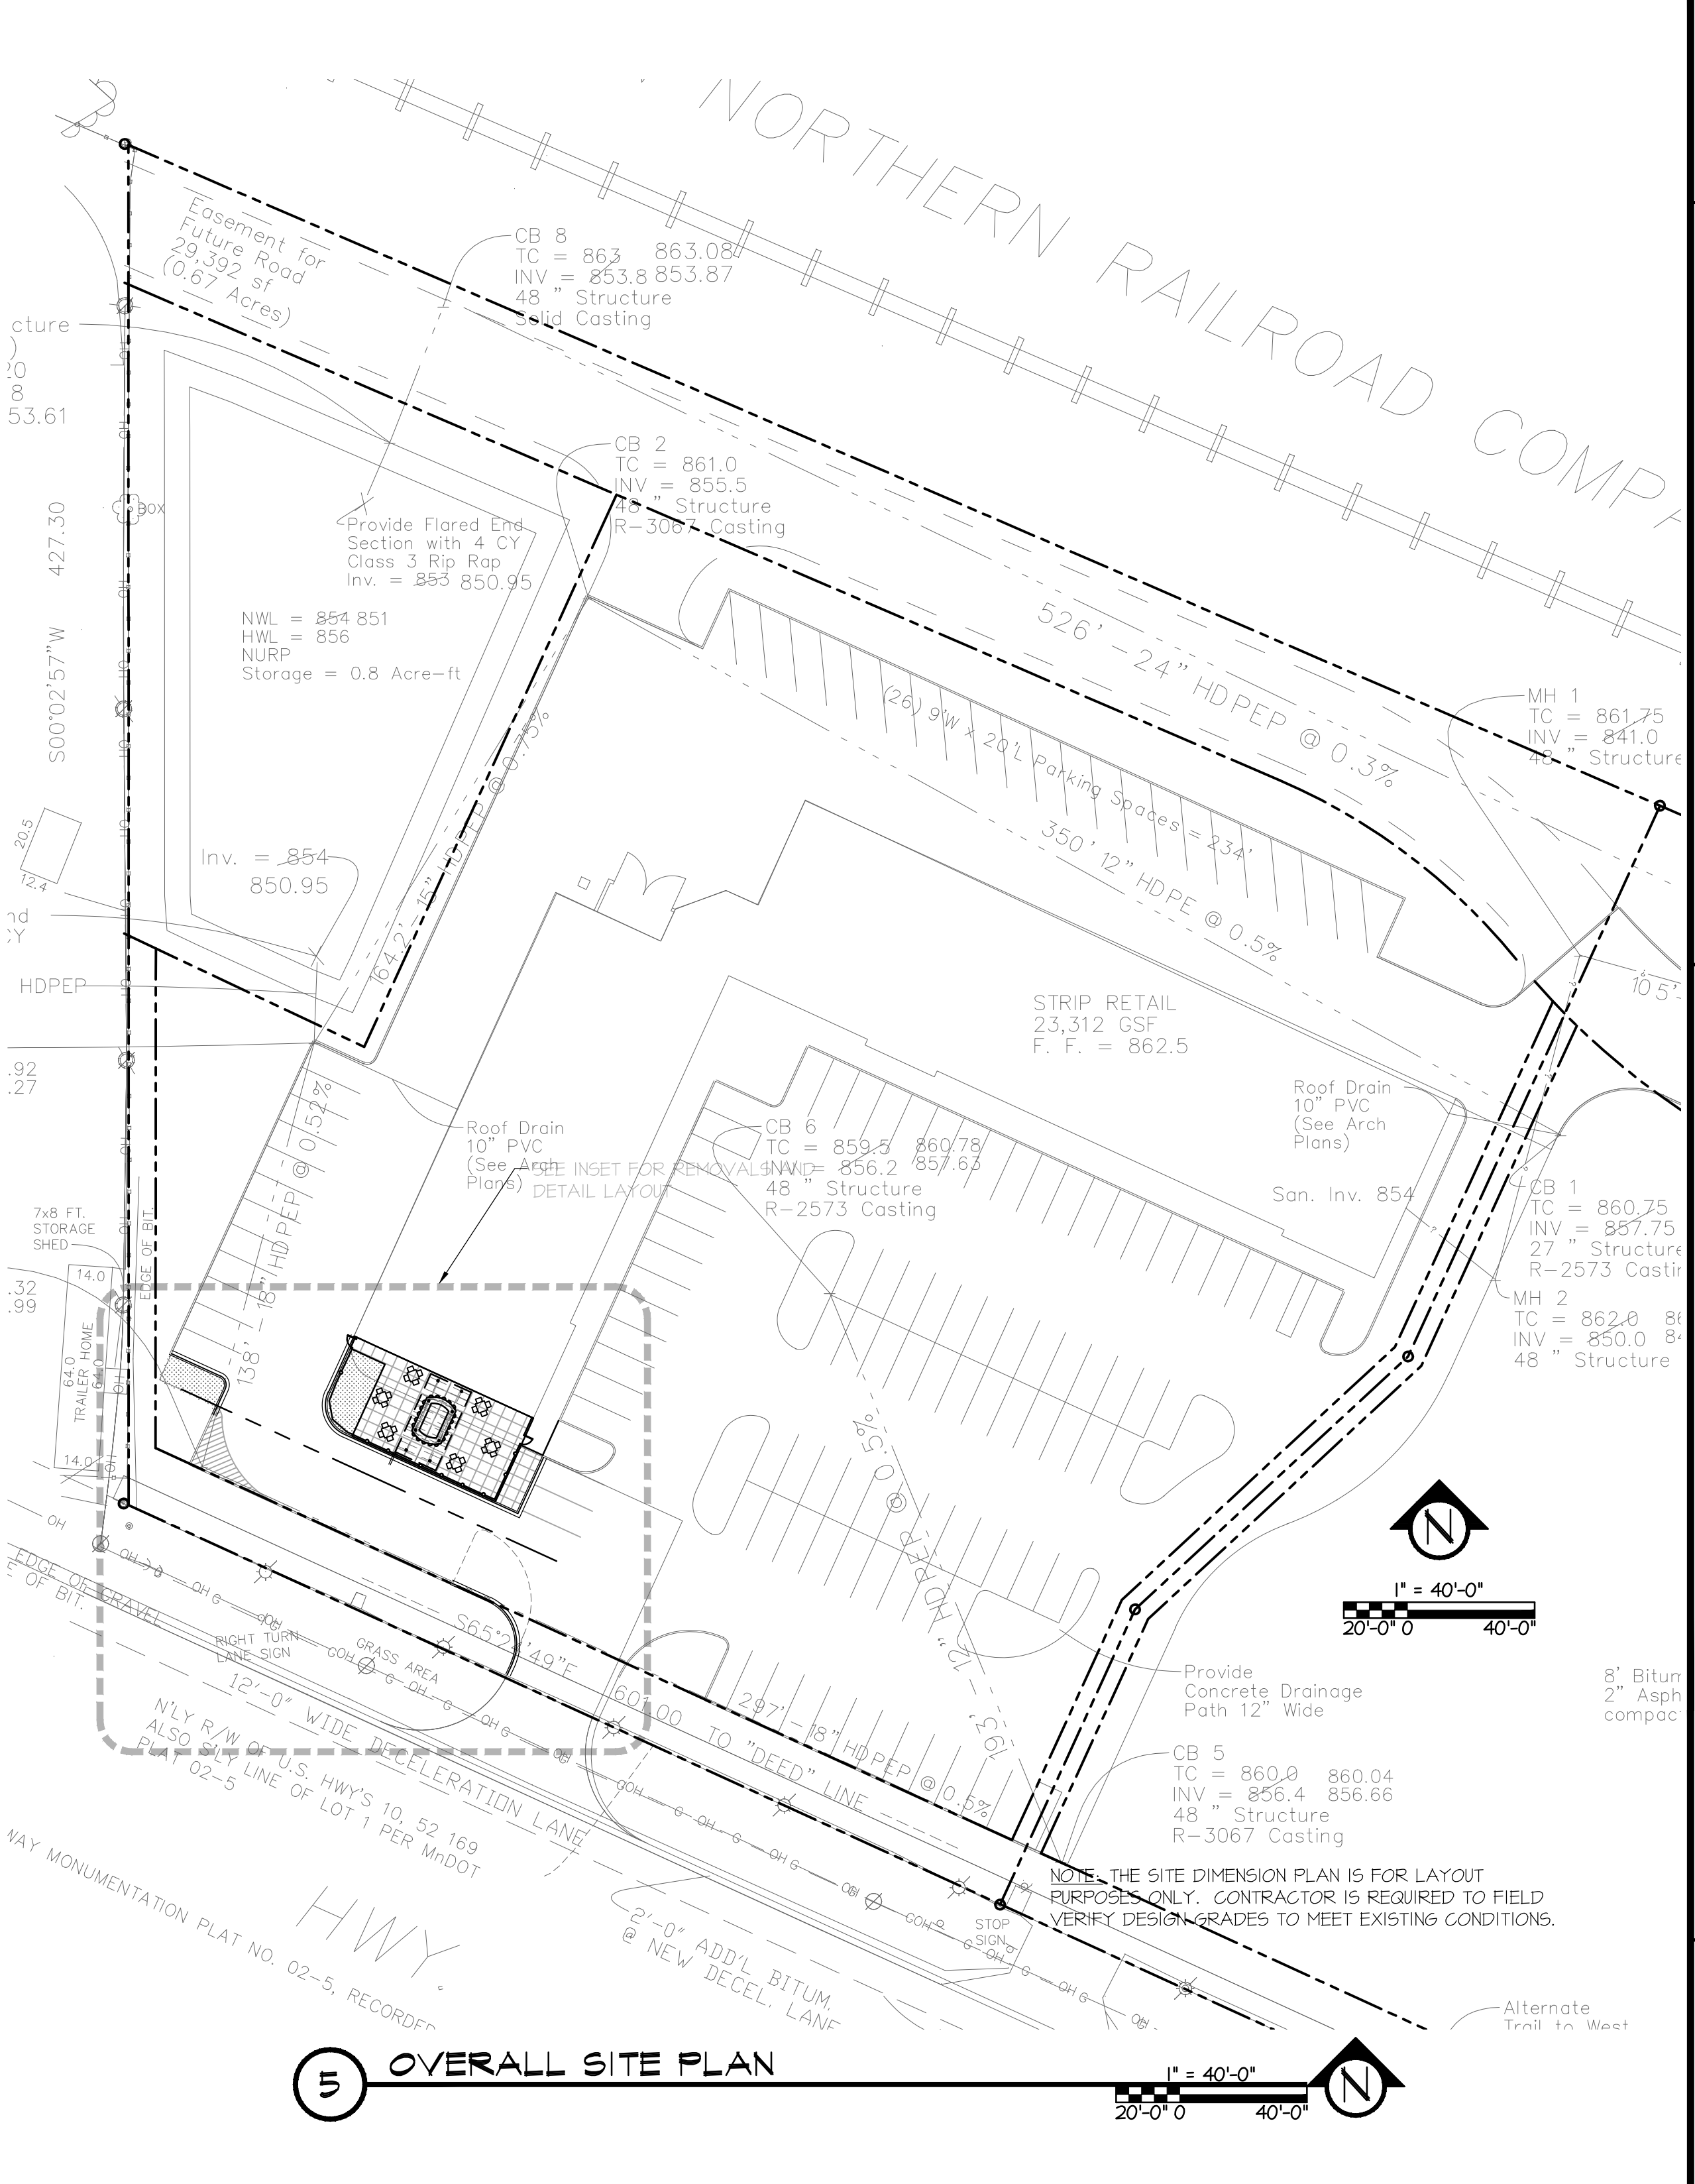

**6 OVERALL SITE PLAN**  
1" = 40'-0"  
20'-0" 40'-0"

**PATIO AND SITE PLAN**  
**HWY 10 AND SUNFISH LAKE BLVD.**  
SUNFISH COMMONS, RAMSEY, MN  
**WILLY MCCOYS**  
RAMSEY, MN - PH: 612-770-5444

ISSUE/SUBMITTAL SUMMARY	
DATE	DESCRIPTION
03/25/13	CITY SITE PLAN REVIEW
04/08/13	CITY SITE PLAN REVISION
REVISION SUMMARY	
DATE	DESCRIPTION

SITE PLAN, REMOVALS PLAN AND DETAILS  
**C1.0**  
© COPYRIGHT 2013 CIVIL SITE GROUP INC.