



# Certificate of Survey for

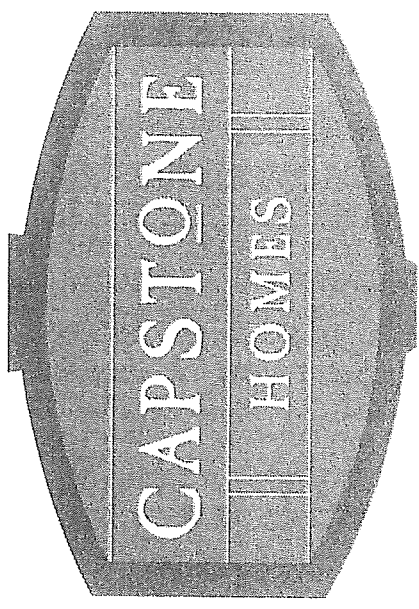

**NOTES:**

- Contractor to verify all building dimensions and elevations.
- In providing this boundary survey no attempt has been made to obtain or show data concerning existence, size, depth, condition, capacity or location of any utility existing on the site, whether private, municipal or public owned.
- The professional surveyor has made no investigation or independent search for easements of record, encumbrance, restrictive covenants, ownership title evidence, or any other facts that an accurate and current title search may disclose.
- Square footage of lot is 19,120 sq.ft. or 0.44 acres
- This lot is in Section 16 Township 32 Range 25
- Builder/Owner place retaining walls as needed.
- House pad needs to be cleared - YES  NO
- A document should be prepared to encumber a portion of this lot with a trail easement.

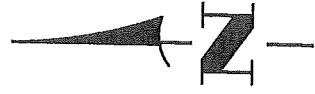


1 INCH = 30 FEET

PROPOSED ELEVATIONS

- Lowest Floor Elevation: 893.2
- Top of Block Elevation: 901.2
- Garage Slab Elevation: 899.5
- Drop garage two (2) courses

ASBUILT ELEVATIONS

- Lowest Floor Elevation: \_\_\_\_\_
- Top of Block Elevation: \_\_\_\_\_
- Garage Slab Elevation: \_\_\_\_\_
- Walkout Elevation: \_\_\_\_\_

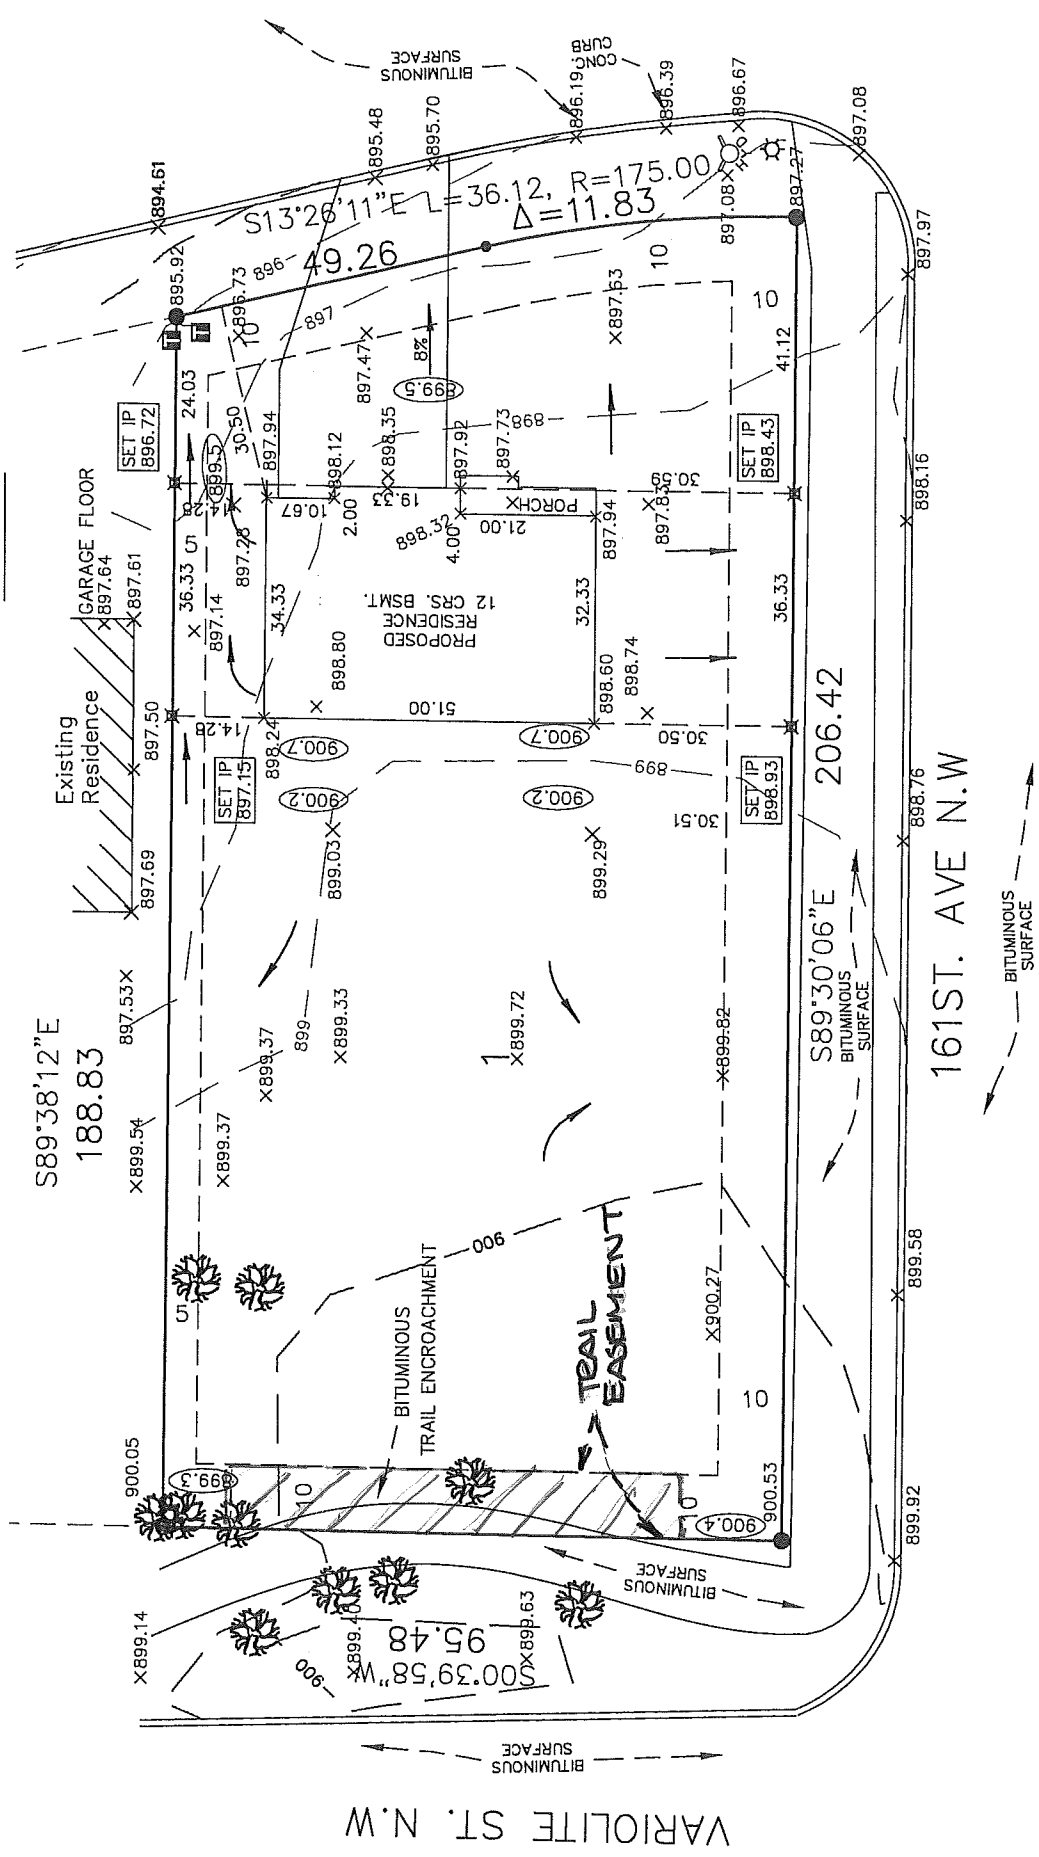

**LEGEND**

- = Iron monument found
- = Iron monument set and marked with license No. 18420.
- x 800.0 = Denotes existing elevation
- (800.0) = Denotes proposed elevation from grade or development plan
- (800.0) = Denotes drainage & utility easement
- (800.0) = Denotes drainage arrow
- = Denotes offset iron
- (800.0) = Bearings shown are assumed
- (800.0) = Denotes proposed contour from development or grading plan
- (800.0) = Denotes as-built elevation
- SF— = Denotes proposed silt fence

## Lot 1, Block 2 SWEETBAY RIDGE

ANOKA COUNTY, MINNESOTA

Subject to easements of record, if any.

I hereby certify that this survey, plan or report was prepared by me or under my direct supervision and that I am a duly Licensed Professional Land Surveyor under the laws of the State of Minnesota.

*Charles R. Christopherson*

Charles R. Christopherson, MN License No. 18420  
REV. 6/24/13 house position and setback elevations

04/24/13

Date



Job No.: 3660.203  
Jun 24, 2013 - 9:52am RyanS  
K:\cad\_surv\Land Desktop 2008\3660.203\dwg\3660.203.dwg  
© 2013 HAKANSON ANDERSON ASSOCIATES, INC.