

Community Water System
City of Ramsey, Minnesota
Emergency Response Plan

CWS and ERP Information

PWSID	MN1020035
Street Address	7550 Sunwood Drive NW
City, State Zip Code	Ramsey, MN 55303
Phone number	(763) 433-9861
Population Served	15,000
Prepared by	Leonard Linton, City of Ramsey
Reviewed by	Bruce Westby, City of Ramsey
Date completed	December 9, 2021

TABLE OF CONTENTS

UTILITY INFORMATION	1
i Utility Overview	1
ii Personnel Information	2
iii Primary Utility Components	3
iv Industry Chemical Handling and Storage Facilities	4
v Safety	5
vi Response Resources	6
vii Key Local Services	6
1 RESILIENCE STRATEGIES	7
1.1 Emergency Response Roles	7
1.2 Incident Command System (ICS) Roles	7
1.3 Communication	7
1.3.1 Internal Communication	7
1.3.2 External Response Partner Communication	7
1.3.3 Critical Customer Communication	8
1.3.4 Communication Equipment Inventory	9
1.4 Media Outreach	10
1.5 Public Notification Templates	10
2.1 Core Response Procedures	11
2.2 Incident-Specific Response Procedures	12
3 MITIGATION ACTIONS	13
3.1 Alternative Source Water Options and Interconnected Utilities	13
3.2 Other Mitigation Actions	14
4 DETECTION STRATEGIES	15
APPENDIX A	23
APPENDIX B	27
APPENDIX C	32
APPENDIX D	34

UTILITY INFORMATION

During an incident, you need to have system information about your water utility readily available for your personnel, first responders, repair contractors/vendors, the media, and other response partner agencies.

i Utility Overview

Provide basic information about your utility.

Utility Information	
PWSID	1985-6005
Utility name and address	City of Ramsey, 7550 Sunwood Drive NW Ramsey, MN 55303
Owner	City of Ramsey
Directions to utility from major roadway, include lat./long. coordinates	US Hwy 10 west to Ramsey Blvd, North to Sunwood Drive, West 0.5 miles to Municipal Center on Left
Total population served and total service connections	15,000 served 5,300 connectionse
Name, title, phone number of primary contact (e.g., ERP Lead)	John Nelson (763) 433-9861
Alternate contact	Matt Graf 763-458-5406
Location of treatment, distribution, collection schematics and operation manuals	Public Works 14100 Jaspar Street Alt. Location Municipal Center 7550 Sunwood Drive

Use this checklist to ensure the following additional utility information (as applicable) is included as a part of your ERP.

These documents are in Appendices at the end of the report

- Map of distribution system
- Site plans and “as built” drawings for the following components of your system (as applicable):
 - Pumping and storage facilities
 - Water treatment facilities
- Distribution system diagrams and instrumentation information
- Equipment specifications and operation instructions
- Emergency power and light generation operation specifications
- Supervisory Control and Data Acquisition (SCADA) system operation instructions
- Communications systems operation instructions

iii Primary Utility Components

List all the components necessary to maintain effective operation of your utility. Simply add more rows to the tables below if you have additional components. Text in italics represents examples – be sure to delete italicized text as necessary as you fill out the tables below and throughout this template.

Wells			
Well Name	Depth/Location	Available Yield	Treatment Requirements/Associated Treatment Plant
Well 1	320 feet	700 gpm	Pump House 1
Well 2	320 feet	220 gpm	Pump House 1
Well 3	345 feet	1450 gpm	Pump House 2
Well 4	321 feet	850 gpm	Pump House 2
Well 5	316 feet	850 gpm	Pump House 3
Well 6	390 feet	900 gpm	Pump House 3
Well 7	332 feet	850 gpm	Pump House 4
Well 8	354 feet	1400 gpm	Pump House 4

Intakes			
Intake Name	Depth/Location	Capacity	Treatment Requirements/Associated Treatment Plant
No Surface Water Intakes			

Treatment Plants			
Plant name	Location	Capacity	Treatment Train
Water Treatment Plant is in planning stages	70XX 143 rd Ave	10 MGD	Gravity Filtration Process

Storage and Distribution System – Tanks, Primary Mains and Pumping Stations

Location	Area Served	Comments
Nowthen Blvd and Dysprosium Street	Entire City	
Sunwood Drive East of Jasper Street	Entire City	
Quicksilver Street South of 167 th Avenue	Entire City	

Treatment Chemical Storage Facilities

Location	Chemical(s)	Comments
Pump House #1	Chlorine	This is in liquid form and there is both an eye wash and shower station in the pump house.
Pump House #2	Chlorine	This is in liquid form and there is both an eye wash and shower station in the pump house.
Pump House #3	Chlorine	This is in liquid form and there is both an eye wash and shower station in the pump house.
Pump House #4	Chlorine	This is in liquid form and there is both an eye wash and shower station in the pump house.
***		Note: Chemicals will be removed from the pump houses when the water treatment plant comes on line.

Other Key Facilities

Location	Function	Comments

iv Industry Chemical Handling and Storage Facilities

List surrounding chemical production, handling or storage industries that could impact your utility during incidents such as accidental releases, hurricanes or earthquakes.

Industry Chemical Handling Facilities

Facility Name	Location	Distance	Chemical and Exposure Pathway
No facilities present in City			

Chemical Storage Tanks

Facility Name	Location	Distance	Chemical and Exposure Pathway
Speedway Station Store	14000 St Francis Blvd	0.21 Miles from Wellfield	(1) 12,000, (2) 10,000 - gallon underground storage tanks (UST) holding gasoline. (1) 10,000 – gallon underground storage tank for diesel fuel.
Holiday Station Store	14350 Xkimo St NW	0.22 Miles from Wellfield	(1) 20,000-gallon underground storage tanks (UST) holding gasoline. (1) 20,000-gallon underground storage tank (UST) holding E-85 Fuel. (1) 20,000-gallon underground storage tank (UST) holding diesel.
Holiday Station Store	14075 Ramsey Blvd	0.84 Miles from Wellfield	(1) 20,000-gallon underground storage tanks (UST) holding gasoline. (1) 20,000-gallon underground storage tank (UST) holding E-85 Fuel. (1) 20,000-gallon underground storage tank (UST) holding diesel.
Casey's General Store	7222 Sunwood Drive NW	0.40 Miles from Wellfield	(1) 20,000, (1) 8,000-gallon underground storage tanks (UST) holding gasoline. (1) 12,000-gallon underground storage tank (UST) holding Diesel.
Ramsey Market	14911 Ramsey Blvd	0.31 Miles from Wellfield	10,000-gallon underground storage tank (UST) holding gasoline.
Little Dukes	7900 Sunwood Drive NW	0.05 Miles from Wellfield	(1) 15,000, (1) 10,000 and (2) 6,000-gallon underground storage tank (UST) holding gasoline.

v Safety

List safety materials and important safety information to help protect utility personnel during an incident. You may also reference your utility Health and Safety Plan, if available.

Safety Materials

Type	Location
<i>Toxic material detection and testing supplies</i>	Public Works has a four gas monitor and the fire department has many of them.
<i>Emergency PPE (note what PPE are present at each location)</i>	Utilities has rubber gloves, N95 masks and Tyvek suits stored at public works.

vi Response Resources

Provide an inventory of available resources (e.g., equipment, supplies) either maintained on site or readily available off site (e.g., neighboring water system) in the table below, or insert an existing inventory sheet.

Resources			
Kind	Type	Quantity	Location
Generator	Portable Generator	1	Public Works
Generator	Static	1	Pump House 2
Generator	Static	1	Pump House 3
Fuel	Gasoline Diesel	1 Tank Each	Public Works
Pump			

vii Key Local Services

Note the closest locations of key logistical and medical services that you or mutual aid and assistance providers may need during an incident. Include a map if available.

Essential Services	
Facility	Location/Description
Hospital	Mercy Hospital 4050 Coon Rapids Blvd Coon Rapids MN 55433 Emergency Dept., Surgery, Cardiac Unit, Cancer Center, Birthing Center
Gas station	Little Duke's 7900 Sunwood Dr. NW Ramsey, MN 55303 Casey's 7222 Sunwood Dr. NW Ramsey, MN 55303 Holiday Station Store 14075 Ramsey Blvd. Ramsey, MN 55303
Pharmacy	Coborn's Pharmacy 7900 Sunwood Dr. NW Ramsey, MN 55303
ATM	Little Duke's 7900 Sunwood Dr. NW Ramsey, MN 55303 Casey's 7222 Sunwood Dr. NW Ramsey, MN 55303 Holiday Station Store 14075 Ramsey Blvd. Ramsey, MN 55303
Grocery store	Coborn's Grocery 7900 Sunwood Dr. NW Ramsey, MN 55303

1 RESILIENCE STRATEGIES

This section contains strategies and resources to improve the resilience of the system, including the physical security and cybersecurity of the system.

1.1 Emergency Response Roles

Describe the roles and responsibilities for key utility and external response partner personnel in the table below. You can add, edit or delete rows as necessary. **The City has an Emergency Management Plan.**

Water Utility and Partner Roles		
Name/Title	Emergency Response Role	Responsibilities
Matt Kohner	Fire Chief/ Emergency Management Coordinator	Responsible for all incident response activities, including developing strategies and tactics and ordering and releasing resources.
Carey Schiferli	Alternate Emergency Response Lead	Perform duties as assigned by ER Lead; assumes duties listed above when ER Lead is not available.
Jeff Katers	Chief of Police /Security	Will provide incident security as needed once notified by ER Lead.

1.2 Incident Command System (ICS) Roles

The City has an Emergency Management Plan which outlines all of these roles.

1.3 Communication

Communication during an incident is critical to relay information to employees, response partners and critical customers about potential risks to health, infrastructure, and the environment.

1.3.1 Internal Communication

List all utility emergency response team members, their response role, title and contact information.

See Appendix A

1.3.2 External Response Partner Communication

List all external response partners, their response role or position as well as contact information.

See Appendix A

1.3.3 Critical Customer Communication

List critical customers below who should be given priority notification due to their reliance on the water supply either for medical reasons, based on usage, public health mission or because they may serve customers considered to be sensitive sub-populations.

Critical Customer Contact List

Organization or Department	Point Person Name or Position	Contact Instructions	Phone	Alternate Phone	Email or Website
Stoney River Assisted Living & Memory Care	Kelsey Nyline Exec Director	Call or email	763-999-5067	763-999-5080	knyline@stoneyriverramsey.com
Suite Living Senior Care	Karen Binsfeld Housing Dir.	Call or email	763-402-7091		Karen@suitelivingsenior.com
Veterans Affairs Outpatient Clinic	Shannah Brent Manager of Clinic	Call or email	763-422-7641	763-354-9302	Shannah.brent@va.gov
Allina Medical Clinic	Office Number		763-236-0000		
Midwest Medical Examiner's Office	Angie Chalmers Office Manager	Call or Email	763-324-4400		angie.Chalmers@co.anoka.mn.us
Comfort Suites	Victoria Clawson, Manager	Email	763-323-4800		Gm.mno54@choicehotels.com
Ramsey Elementary	Dr. Amy Reed, Principle	Call or Email	763-506-4001	Diane Jones LSN 763-506-4004	Amy.reed@ahschools.us
Brookside Elementary	Dr. Anissa Cravens, Principle	Call or Email	763-433-5201	Rick Maas 763-433-5210	Anissa.cravens@ahschools.us
PACT Charter School	Matthew Nelson Facilities Dir.	Call or email	763-712-4200 ext 225	651-357-4790	m.nelson@pactcharter.org

1.3.4 Communication Equipment Inventory

Inventory your utility's communication equipment below.

Communication Equipment

Type	Assigned to	Location	Number/Frequency/Channel
Handhelds	Public Works	Public Works Facility 14199 Jasper St NW, Ramsey, MN 55303	800MHZ

1.4 Media Outreach

List contact information for all media outlets that your utility may coordinate with during notification efforts. Additionally, include existing risk communication procedures, such as composing and delivering messages (e.g. message mapping), or reference an existing Risk Communication Plan.

Contact List

Organization or Department	Point Person Name & Position	Phone	Alternate phone	Email or Website
Utility social media coordinator	Megan Thorstad, Communications & Events Coordinator	763-433-9831		mthorstad@cityoframsey.com
Newspaper - Local	Emilee Wentland, Anoka/Coon Rapids Union Herald	763-712-3509		emilee.wentland@apgecm.com
Newspaper – Regional/State	Tim Harlow, Minneapolis Star Tribune	612-868-7734		Tim.Harlow@startribune.com
Radio station	Kate Schweningen, BOB FM	763-450-7777 ext. 4633		kate@mybobcountry.com
TV station	QCTV, Katherine Lenaberg	763-427-1411		Katherine.lenaberg@qctv.org
Advertising agency	Scott Robinson, Universal Apparel	763-443-2243		scott@universalapparelmn.com
Other				
Other				

1.5 Public Notification Templates

Insert your templates for public notifications here, or reference where they may be found. Ensure that your templates are consistent with the regulatory requirements for public notification contained in the Public Notification Rule (see 40 CFR 141, Subpart Q) and all relevant state regulations.

2 EMERGENCY PLANS AND PROCEDURES

This section contains plans and procedures that can be implemented in the event of a malevolent act or natural hazard that threatens your utility’s ability to deliver safe drinking water.

2.1 Core Response Procedures

Core procedures are the “building blocks” for incident specific response procedures, as they are typically implemented across a broad variety of incidents (e.g., hurricane, earthquake, flood). List all your core procedures here.

Access

Item	Description
Debris clearing	The City of Ramsey has equipment and trained workers for debris clearing. The equipment includes loaders, dump trucks, a brush chipper, chainsaws and personal protective gear for debris clearing.
Alternate routes	The City does not have any critical bridges that would require a long detour if they become impassable.
Identification badges	City Employees have picture ID badges.

Physical Security

Item	Description
Access control procedures	The Public Works Campus requires a Key Card for access. The well houses and water towers require physical keys for access. Distribution of Key Cards and physical keys is limited to those with a need for access.
Restricted areas	List or reference any restricted areas of your facilities here, such as chemical rooms and electrical closets. Also list who may access those areas.

Cybersecurity

Item	Description
Disconnect procedure	IT will if possible, disconnect compromised computers from the network to isolate breached components and prevent further damage, such as the spreading of malware.
Notification	In the Event of a Cyber Security attack or breach, notify the IT Manager, IT Staff or Logis Helpdesk (763.543.2662) if the IT Manager is unreachable. (Department of Homeland Security National Cybersecurity and Communications Integration Center (NCCIC) (888-282-0870 or NCCIC@hq.dhs.gov).
Assess procedure	Assess any damage to utility systems and equipment, along with disruptions to utility operations. IT will use logs to identify damage – consider rebuild or restore for PCs.
Implementation processes	IT will work with Utilities and Scada vendor to determine action needed and work to implement the plan to restore the system to a healthy state. Implement actions to restore operations of mission critical processes (e.g., switch to manual operation if necessary) and provide public notification (if required).

Power Loss

Item	Description
Backup power systems	We have several backup generators set to come on when power goes out. Pump house #2 has stand by generator for entire site and well #3 Pump house #3 has stand by generator for well #5 and entire building We have a towable generator that is used for lift stations.
Power utility	We will coordinate with Connexus Energy for expected restoration priorities and timing. Power utility contact information is listed in Section 3.2 above.
Fuel plan	Pump house #2 has a diesel generator we can utilize fuel from our onsite fuel station at Public works, we also have a pickup that can deliver 75 gallons immediately. Dehn Oil delivers to the Public Works site. Pump house #3 utilizes a Natural gas supply Our towable unit is Diesel
Maintenance plan	Some in house maintenance is possible we contract with Kodiak power for most maintenance
Other	

Emergency Alternate Drinking Water Supplies

* Interconnections are listed and described in Section 3.1

Sampling and Analysis

Item	Description
Sampling procedures	The Minnesota department of health establishes all sampling procedures.

Local Contract/State/Federal Laboratory Contact List

Name	Address	Analytes/Methods	Phone	Email or Website
MDH Brian Noma			651-201-4683	

2.2 Incident-Specific Response Procedures

Refer to the City Emergency Management Plan.

3 MITIGATION ACTIONS

This section contains actions, procedures, and equipment which can obviate or significantly lessen the impact of a malevolent act or natural hazard on the public health and the safety and supply of drinking water provided to your community and individuals, including the development of alternative source water options, relocation of water intakes, and construction of flood protection barriers.

3.1 Alternative Source Water Options and Interconnected Utilities

List information on alternative source water options and interconnected utilities to mitigate impacts during incidents.

Alternative Source Water Options

Type	Location	Comments
Mississippi River	South Edge of City near a large watermain	National Guard would need to treat the water before distribution

Interconnected Utilities

Utility Name	Location	Contact Information	Comments
City of Anoka	Highway 10 Connection (Anoka Technical College Campus) County Road 116/ Thurston Avenue	City of Anoka	

3.2 Other Mitigation Actions

List any mitigation procedures or projects implemented at your utility, such as raising facilities and controls or constructing berms to protect against flood damage.

Mitigation Actions		
Type	Location	Comments
Flood mitigation not required		
Ramsey Facilities are above 100 year flood elevation of Rum or Mississippi Rivers		

4 DETECTION STRATEGIES

This section contains strategies that can be used to aid in the detection of malevolent acts or natural hazards that threaten the security or resilience of the system.

List the detection strategies and methods your utility uses to aid in the detection of malevolent acts or natural hazards. Also list the corresponding procedure to be used if the threat is detected.

Detection Strategies		
Threat	Detection Method	Procedure
<i>Unauthorized entry</i>	<ul style="list-style-type: none"> • Alarm from intrusion detection system • SCADA system 	<i>On call person response Call 911</i>
<i>Source water contamination</i>	<ul style="list-style-type: none"> • National Response Center notifications • Notification from 911 for releases resulting from transportation accidents 	<i>Source Water Contamination Incident Response Plan</i>
<i>Distribution system contamination</i>	<ul style="list-style-type: none"> • Customer complaint surveillance • Public health surveillance 	<i>Distribution System Contamination Response Procedure</i>
<i>Cyber intrusion</i>	<ul style="list-style-type: none"> • Notification of malware/intrusion from scheduled antivirus scans • Notification from utility staff 	<i>Cyber Incident Action Checklist</i>
<i>Hazardous chemical release</i>	<ul style="list-style-type: none"> • Chlorine gas in air monitors • SCADA call out 	<i>On call person call out, Call Fire Department</i>
<i>Power outage</i>	<ul style="list-style-type: none"> • Notification from energy provider • Alarm from line power sensor • SCADA call out 	<i>Generator Start-up Checklist</i>
<i>Other</i>		
<i>Other</i>		

Ramsey Emergency Telephone List

Emergency Response Team	Name	Work Telephone	Alternate Telephone
Emergency Response Lead	Matt Kohner	763 433-9859	
Alternate Emergency Response Lead	Jeff Katers	763 433-9882	
Water Operator	John Nelson	763 286-0296	
Public Works Superintendent	Grant Riemer	763 286-0282	
City Engineer	Bruce Westby	763 433-9825	
City Administrator/ Public Communications	Kurt Ulrich	763 433-9845	

State and Local Emergency Response Contacts	Name	Work Telephone	Alternate Telephone
State Incident Duty Officer	Minnesota Duty Officer	651 649-5451 Metro	800 422-0798 Out State
County Emergency Director	Terry Stoltzman	763 421-4760	
National Guard	Minnesota Duty Officer	651 649-5451 Metro	800 422-0798 Out State
Mayor	Mark Kuzma		
Fire Chief	Matt Kohner	763 433-9859	
Sherriff	Anoka County Sheriff	763 427-1212	
Central Communications	Anoka County Sheriff	763 427-1212	
Ambulance	Allina	763 576-9593	
Hospital	Mercy Medical Center	763 236-7144	
Doctor or Medical Facility	Allina Clinic Ramsey	763 236-0000	

State and Local Agencies	Name	Work Telephone	Alternate Telephone
MDH District Engineer			
MDH	Drinking Water Protection	651 201-4700	
State Testing Laboratory	Minnesota Duty Officer	651 649-5451 Metro	800 422-0798 Out State
MPCA	St. Paul Regional Office	651 296-6300	800 657-3864
DNR Area Hydrologist	John Gleason	651 259-5753	
Anoka County Environmental Services	Abby Shea	763 324-4207	
MNWARN	Minnesota Duty Officer	651 649-5451 Metro	800 422-0798 Out State

Utilities	Name	Work Telephone	Alternate Telephone
Electric Company	Connexus Energy	763 323-2660	763 323-2600
Gas Company	CenterPoint Energy	612 372-5050	612 372-4727
Telephone Company	Century Link	763 712-5020	763 712-5002
Utility Locations	Gopher State One Call	800 252-1166	651 454-0002
County Highway Department	Anoka County	763 862-4201	
State Highway Department	MNDOT	651 296-3000	911

Mutual Aid Agreements	Name	Work Telephone	Alternate Telephone
Neighboring Water System	City of Anoka	763 576-2980	763 576-2860
Emergency Water Connection	City of Anoka	763 573-2980	
Materials	HD Supply	952 937-9666	

Technical/ Contracted Services/ Supplies	Name	Work Telephone	Alternate Telephone
MRWA Technical Services	MN Rural Water Association	800 367-6792	
Well Driller/ Repair	E, H. Renner	763 427-6100	
Electrician	3 Way Electric	612 865-3262	
Water Main Repair	Dave Perkins Contracting	763 427-0109	612 363-6459
Chemical Feed	Hawkins Chemical	612 331-9100	
Meter Repair	City of Ramsey	763 433-9861	
SCADA System	Total Control	763 286-7365	
Valves, Pipes and Fittings	Ferguson Water Works	763 560-5200	
Laboratory	Twin Cities Water Clinic	953 935-3556	

Communications	Name	Work Telephone	Alternate Telephone
Newspaper	Star Tribune	612 673-4000	
	Pioneer Press	651 222-1111	
School Superintendent	David Law	763 506-1001	
Property and Casualty Insurance	League of MN Cities	651 281-1200	

APPENDIX A
Emergency Operations Resource Lists

City of Ramsey

Emergency Operations Resource Manual

Governmental Agencies

Agency	Contact	Address	Phone	Fax
Alcohol Tobacco Firearms		300 E 5th Street, St Paul, MN	651-290-3092	24 Hr 651-290-5120
Anoka County Emerg Mgmt.		325 E Main Street, Anoka, MN 55303	763-323-5828	
Anoka County Hwy Dept		1440 Bunker Lk Blvd, Andover, MN 55303	763-862-4200	
Anoka County Sheriff		325 E Main Street, Anoka, MN 55303	763-323-5000	
Anoka County - Genl Info		2100 3rd Avenue, Anoka, MN 55303	763-421-4760	
Anoka County Attorney		2100 3rd Avenue, Anoka, MN 55303	763-323-5550	
Anoka County Sheriff Dispatch		325 E Main Street, Anoka, MN 55303	763-427-1212	
Anoka County Sheriff Patrol		1530 Bunker Lake Blvd, Andover, MN 55304	763-754-4545	
Anoka Police Dept		275 Harrison Street, Anoka, MN 55303	763-576-2800	
BCA Forensic Sc Lab		1430 Maryland Avenue E, St Paul, MN 55106	651-793-2900	
Bureau of Crim Apprehension		1430 Maryland Avenue E, St Paul, MN 55106	651-793-1000	
Dept Natural Resources	Tony Salzel	Cell: 612-559-8771		Dispatch 651-582-1509
Dept of Transportation		395 John Ireland Blvd, St Paul MN	800-867-3774	Dispatch 651-582-1550
Elk River Police Department		13077 Orono Parkway, Elk River, MN 55330	763-635-1200	
Fed Bureau of Investigation		Minneapolis Office	612-376-3200	
Fed Emerg Mgmt. Agency		444 Cedar Street, St Paul, MN	800-427-2354	
Fire Marshall		444 Cedar Street, St Paul, MN	651-215-0500	
Fire Prevention Bureau		2660 Civic Center Drive, Roseville, MN 55113	651-792-7342	651-792-7300
Immigration Department		St Paul, MN	952-853-2940	612-313-9045
MN Animal Health Board		90 W Plato Blvd, St Paul, MN	651-296-2942	651-296-7417
MN Department of Health		717 SE Delaware Street, Minneapolis, MN	651-215-5800	
MN Duty Officer		N/A	651-649-5451	
MN Governor's Office		State Capital	651-296-3391	
MN National Guard		Activated Through Anoka County Sheriff		
MN Pollution Control Agency		620 Lafayette Road, St Paul, MN 55155	651-296-6300	24 Hr Emergency 651-649-5451
MN State Patrol		2005 N Lilac Drive, Golden Valley, MN	763-591-4680	St Paul 651-282-6871
North Metro Chem Assess Team		Activated Through Anoka County Sheriff		
State Emergency Response Comm		444 Cedar Street, St Paul, MN		
US Dept of Agriculture		3 E 4th Street, Ste 500, St Paul, MN	800-453-7502	651-296-3192
US Postal Inspector		N/A	651-293-3200	

City of Ramsey**Emergency Operations Resource Manual**

Private Agencies/ Businesses/ Individuals

Entity	Name	Address	Phone	Fax
Clinic	Allina Medical Clinic	7231 Sunwood Drive NW, Ramsey, MN 55303	763-427-7180	
Funeral Director	MN Funeral Dir Assn	10800 Co Rd 15, Plymouth, MN 55441	763-398-0118	769-398-0115
Gas Station	Speedway	14000 St Francis Blvd NW, Ramsey, MN 55303	763-576-9444	
Gas Station	Holiday	14075 Ramsey Blvd NW, Ramsey, MN 55303	763-421-3075	
Gas Station	Holiday	14350 Xkimo St NW, Ramsey, MN 55303	763-422-9397	
Gas Station	Ramsey Market	14911 Ramsey Blvd NW. Ramsey, MN 55303	763-427-7560	
Gas Station	Little Dukes	7900 Sunwood Drive NW, Ramsey, MN 55303	763-323-1004	
Gas Station	Bill's Superette	15299 Ramsey Blvd NW, Ramsey, MN 55303	763-422-8383	
Grocery	Coborn's	7900 Sunwood Drive NW, Ramsey, MN 55303	763-323-1004	
Hospital	Mercy	4050 Coon Rapids Blvd, Coon Rapids, MN 55433	763-236-6000	
Hospital	North Memorial	3300 Oakdale Ave N, Robbinsdale, MN 55422	763 520-5200	
Hospital	North Memorial	9875 Hospital Drive, Maple Grove, MN 55369	763-581-1000	
Hospital	Unity	550 Osborne Road, Fridley, MN 55432	763-236-5000	
Pharmacy	Coborn's Pharmacy	7900 Sunwood Drive NW, Ramsey, MN 55303	763-576-6821	
Radio Station	KNOW 9101	45 E 7 th Street, St Paul, MN	651-290-1500	
Radio Station	KOOL 108 FM	60 S 6 th Street #930, Minneapolis, MN 55402	612-338-8118	
Radio Station	KQRS 92.5 FM	2000 Elm Street, Minneapolis, MN 55414	612-617-4000	
Radio Station	KSJN 99.5	45 E 7 th Street, St Paul, MN	651-290-1500	
Radio Station	WCCO Radio 830 AM	625 2 nd Avenue S #200, Minneapolis, MN 55402	612-370-0611	
Radio Station	WLOL 98.5 FM	60 S 6 th Street #930, Minneapolis, MN 55402	612-330-0100	
Radio Station	KTCN 1130 AM	1600 Utica Ave S, St Louis Park, MN 55416	952-417-3000	

APPENDIX B

State of MN Emergency Planning and Community Right to Know

State of Minnesota

Department of Public Safety

Emergency Planning and Community Right-to-Know Act (EPCRA) Program

City of RAMSEY

Facility Name and Address
 ACE SOLID WASTE INC
 6601 MCKINLEY ST NW
 RAMSEY, MN 55303

Chemicals On-Site
 DIESEL FUEL

Storage Cont. Type
 B

Pressure
 1

Temp
 4

Location
 40' WEST OF MAIN BUILDING

Contact
 Subreports within table/matrix cells are ignored.

Status: ACTIVE **312: 2005**

Max Actual Max AVG DAYS
 64320 04 03 003

ERCID **020950024**
 302 No

Facility Name and Address
 AIRGAS NORTH CENTRAL, INC.
 6191 MCKINLEY ST
 RAMSEY, MN 55303

Chemicals On-Site
 ARGON

Storage Cont. Type
 A

Pressure
 2

Temp
 7

Location
 OUTSIDE ON NORTH SIDE OF BLDG

Contact
 Subreports within table/matrix cells are ignored.

Status: ACTIVE **312: 2005**

Max Actual Max AVG DAYS
 91000 04 04 365

ERCID **020950022**
 302 No

Chemicals On-Site
 CARBON DIOXIDE

Storage Cont. Type
 A

Pressure
 2

Temp
 6

Location
 OUTSIDE ON NORTH SIDE OF BLDG

Contact
 Subreports within table/matrix cells are ignored.

Status: ACTIVE **312: 2005**

Max Actual Max AVG DAYS
 88100 04 04 365

ERCID **302**
 No

Chemicals On-Site
 NITROUS OXIDE

Storage Cont. Type
 A

Pressure
 2

Temp
 6

Location
 OUTSIDE ON NORTH SIDE OF BLDG

Contact
 Subreports within table/matrix cells are ignored.

Status: ACTIVE **312: 2005**

Max Actual Max AVG DAYS
 14500 04 04 365

ERCID **302**
 No

Chemicals On-Site
 NITROGEN

Storage Cont. Type
 A

Pressure
 2

Temp
 6

Location
 OUTSIDE ON NORTH SIDE OF BLDG

Contact
 Subreports within table/matrix cells are ignored.

Status: ACTIVE **312: 2005**

Max Actual Max AVG DAYS
 78000 04 04 365

ERCID **302**
 No

State of Minnesota

Department of Public Safety

Emergency Planning and Community Right-to-Know Act (EPCRA) Program

Storage Cont. Type	Pressure	Temp	Location	Max Actual	AVG	DAYS	302
A	2	7	OUTSIDE ON NORTH SIDE OF BLDG	199100	05	365	No
Storage Cont. Type	Pressure	Temp	Location	Max Actual	AVG <th>DAYS</th> <th>302</th>	DAYS	302
A	2	7	OUTSIDE ON NORTH SIDE OF BLDG	270	02	365	Yes
Chemicals On-Site HYDROGEN FLUORIDE, ANHYDROUS	Pressure	Temp	Location	Max Actual	AVG <th>DAYS</th> <th>302</th>	DAYS	302
L	2	4	INSIDE CAGE IN NW CORNER OF LOT				

Facility Name and Address

AMERIGAS EAGLE LP #3900

7411 W HWY 10

RAMSEY, MN 55303

Chemicals On-Site

PROPANE (LIQUIFIED PETROLEUM GAS)

Storage Cont. Type

A

Contact

Subreports within table/matrix cells are ignored.

Status: ACTIVE 312: 2005

Max Actual 480684

Temp 05

Location

4 3 MILES WEST OF ANOKA ON NORTH SIDE OF HWY 10 NEXT

ERCID

020950002

Facility Name and Address

COMMERCIAL ASPHALT CO. - PLANT 6

14100 BASALT ST

RAMSEY, MN 55303

Chemicals On-Site

ASPHALT CEMENT

Storage Cont. Type

A

Contact

Subreports within table/matrix cells are ignored.

Status: ACTIVE 312: 2005

Max Actual 810000

Temp 05

Location

5 TANK 20-601-30000 GALLON AGST LOCATED WITHIN

ERCID

020950005

State of Minnesota

Department of Public Safety

Emergency Planning and Community Right-to-Know Act (EPCRA) Program

<u>Chemicals On-Site</u>	<u>Max Actual</u>	<u>Max</u>	<u>AVG</u>	<u>DAYS</u>	<u>302</u>
OIL, USED	160000	05	04	240	No
<u>Storage Cont. Type</u>	<u>Pressure</u>	<u>Location</u>			
A	1				
<u>Chemicals On-Site</u>	<u>Max Actual</u> <th><u>Max</u></th> <th><u>AVG</u></th> <th><u>DAYS</u></th> <th><u>302</u></th>	<u>Max</u>	<u>AVG</u>	<u>DAYS</u>	<u>302</u>
PETROLEUM NAPHTHA	440	02	02	240	No
<u>Storage Cont. Type</u>	<u>Pressure</u>	<u>Location</u>			
A	1				
<u>Chemicals On-Site</u>	<u>Max Actual</u> <th><u>Max</u></th> <th><u>AVG</u></th> <th><u>DAYS</u></th> <th><u>302</u></th>	<u>Max</u>	<u>AVG</u>	<u>DAYS</u>	<u>302</u>
DIVERSLIP	440	02	02	240	No
<u>Storage Cont. Type</u>	<u>Pressure</u>	<u>Location</u>			
E	1				
<u>Chemicals On-Site</u>	<u>Max Actual</u> <th><u>Max</u></th> <th><u>AVG</u></th> <th><u>DAYS</u></th> <th><u>302</u></th>	<u>Max</u>	<u>AVG</u>	<u>DAYS</u>	<u>302</u>
DIESEL FUEL #2	8000	03	03	240	No
<u>Storage Cont. Type</u>	<u>Pressure</u>	<u>Location</u>			
A	1				
<u>Facility Name and Address</u>	<u>Contact</u>	<u>ERCID</u>			
CONNEXUS ENERGY	Subreports within table/matrix cells are ignored.	020950017			
14601 RAMSEY BLVD RAMSEY, MN 55303	Status: ACTIVE	312: 2005			
<u>Chemicals On-Site</u>	<u>Max Actual</u> <th><u>Max</u></th> <th><u>AVG</u></th> <th><u>DAYS</u></th> <th><u>302</u></th>	<u>Max</u>	<u>AVG</u>	<u>DAYS</u>	<u>302</u>
DIESEL FUEL	74000	04	04	365	No
<u>Storage Cont. Type</u>	<u>Pressure</u>	<u>Location</u>			
B	1				
<u>Chemicals On-Site</u>	<u>Max Actual</u> <th><u>Max</u></th> <th><u>AVG</u></th> <th><u>DAYS</u></th> <th><u>302</u></th>	<u>Max</u>	<u>AVG</u>	<u>DAYS</u>	<u>302</u>
GASOLINE	62000	04	04	365	No
<u>Storage Cont. Type</u>	<u>Pressure</u>	<u>Location</u>			
B	1				

State of Minnesota

Department of Public Safety

Emergency Planning and Community Right-to-Know Act (EPCRA) Program

Facility Name and Address

DEHN OIL CO.

6735 141st Ave NW
RAMSEY, MN 55303

Chemicals On-Site
GASOLINE

Storage Cont. Type
A

Pressure
1

Temp
4

Max Actual 3000
Location 03

AVG 03

DAYS 365

302
No

ERCID

020050012

Subreports within table/matrix cells are ignored.

Status: ACTIVE 312: 2005

Chemicals On-Site
FUEL OIL

Storage Cont. Type
A

Pressure
1

Temp
4

Max Actual 7000
Location 03

AVG 03

DAYS 365

302
No

Facility Name and Address

LIFE FITNESS - A DIVISION OF BRUNSWICK CORP.

14150 SUNFISH LAKE BLVD
RAMSEY, MN 55303

Chemicals On-Site
ARGON

Storage Cont. Type
A

Pressure
2

Temp
7

Max Actual 22565
Location 04

AVG 04

DAYS 365

302
No

ERCID

020950023

Subreports within table/matrix cells are ignored.

Status: ACTIVE 312: 2005

Chemicals On-Site
CARBON DIOXIDE

Storage Cont. Type
A

Pressure
2

Temp
7

Max Actual 12100
Location 04

AVG 03

DAYS 365

302
No

Chemicals On-Site
OXYGEN

Storage Cont. Type
A

Pressure
2

Temp
7

Max Actual 14700
Location 04

AVG 03




DAYS 365

302
No

APPENDIX C

Ramsey Water System Map

2021 Water System Map

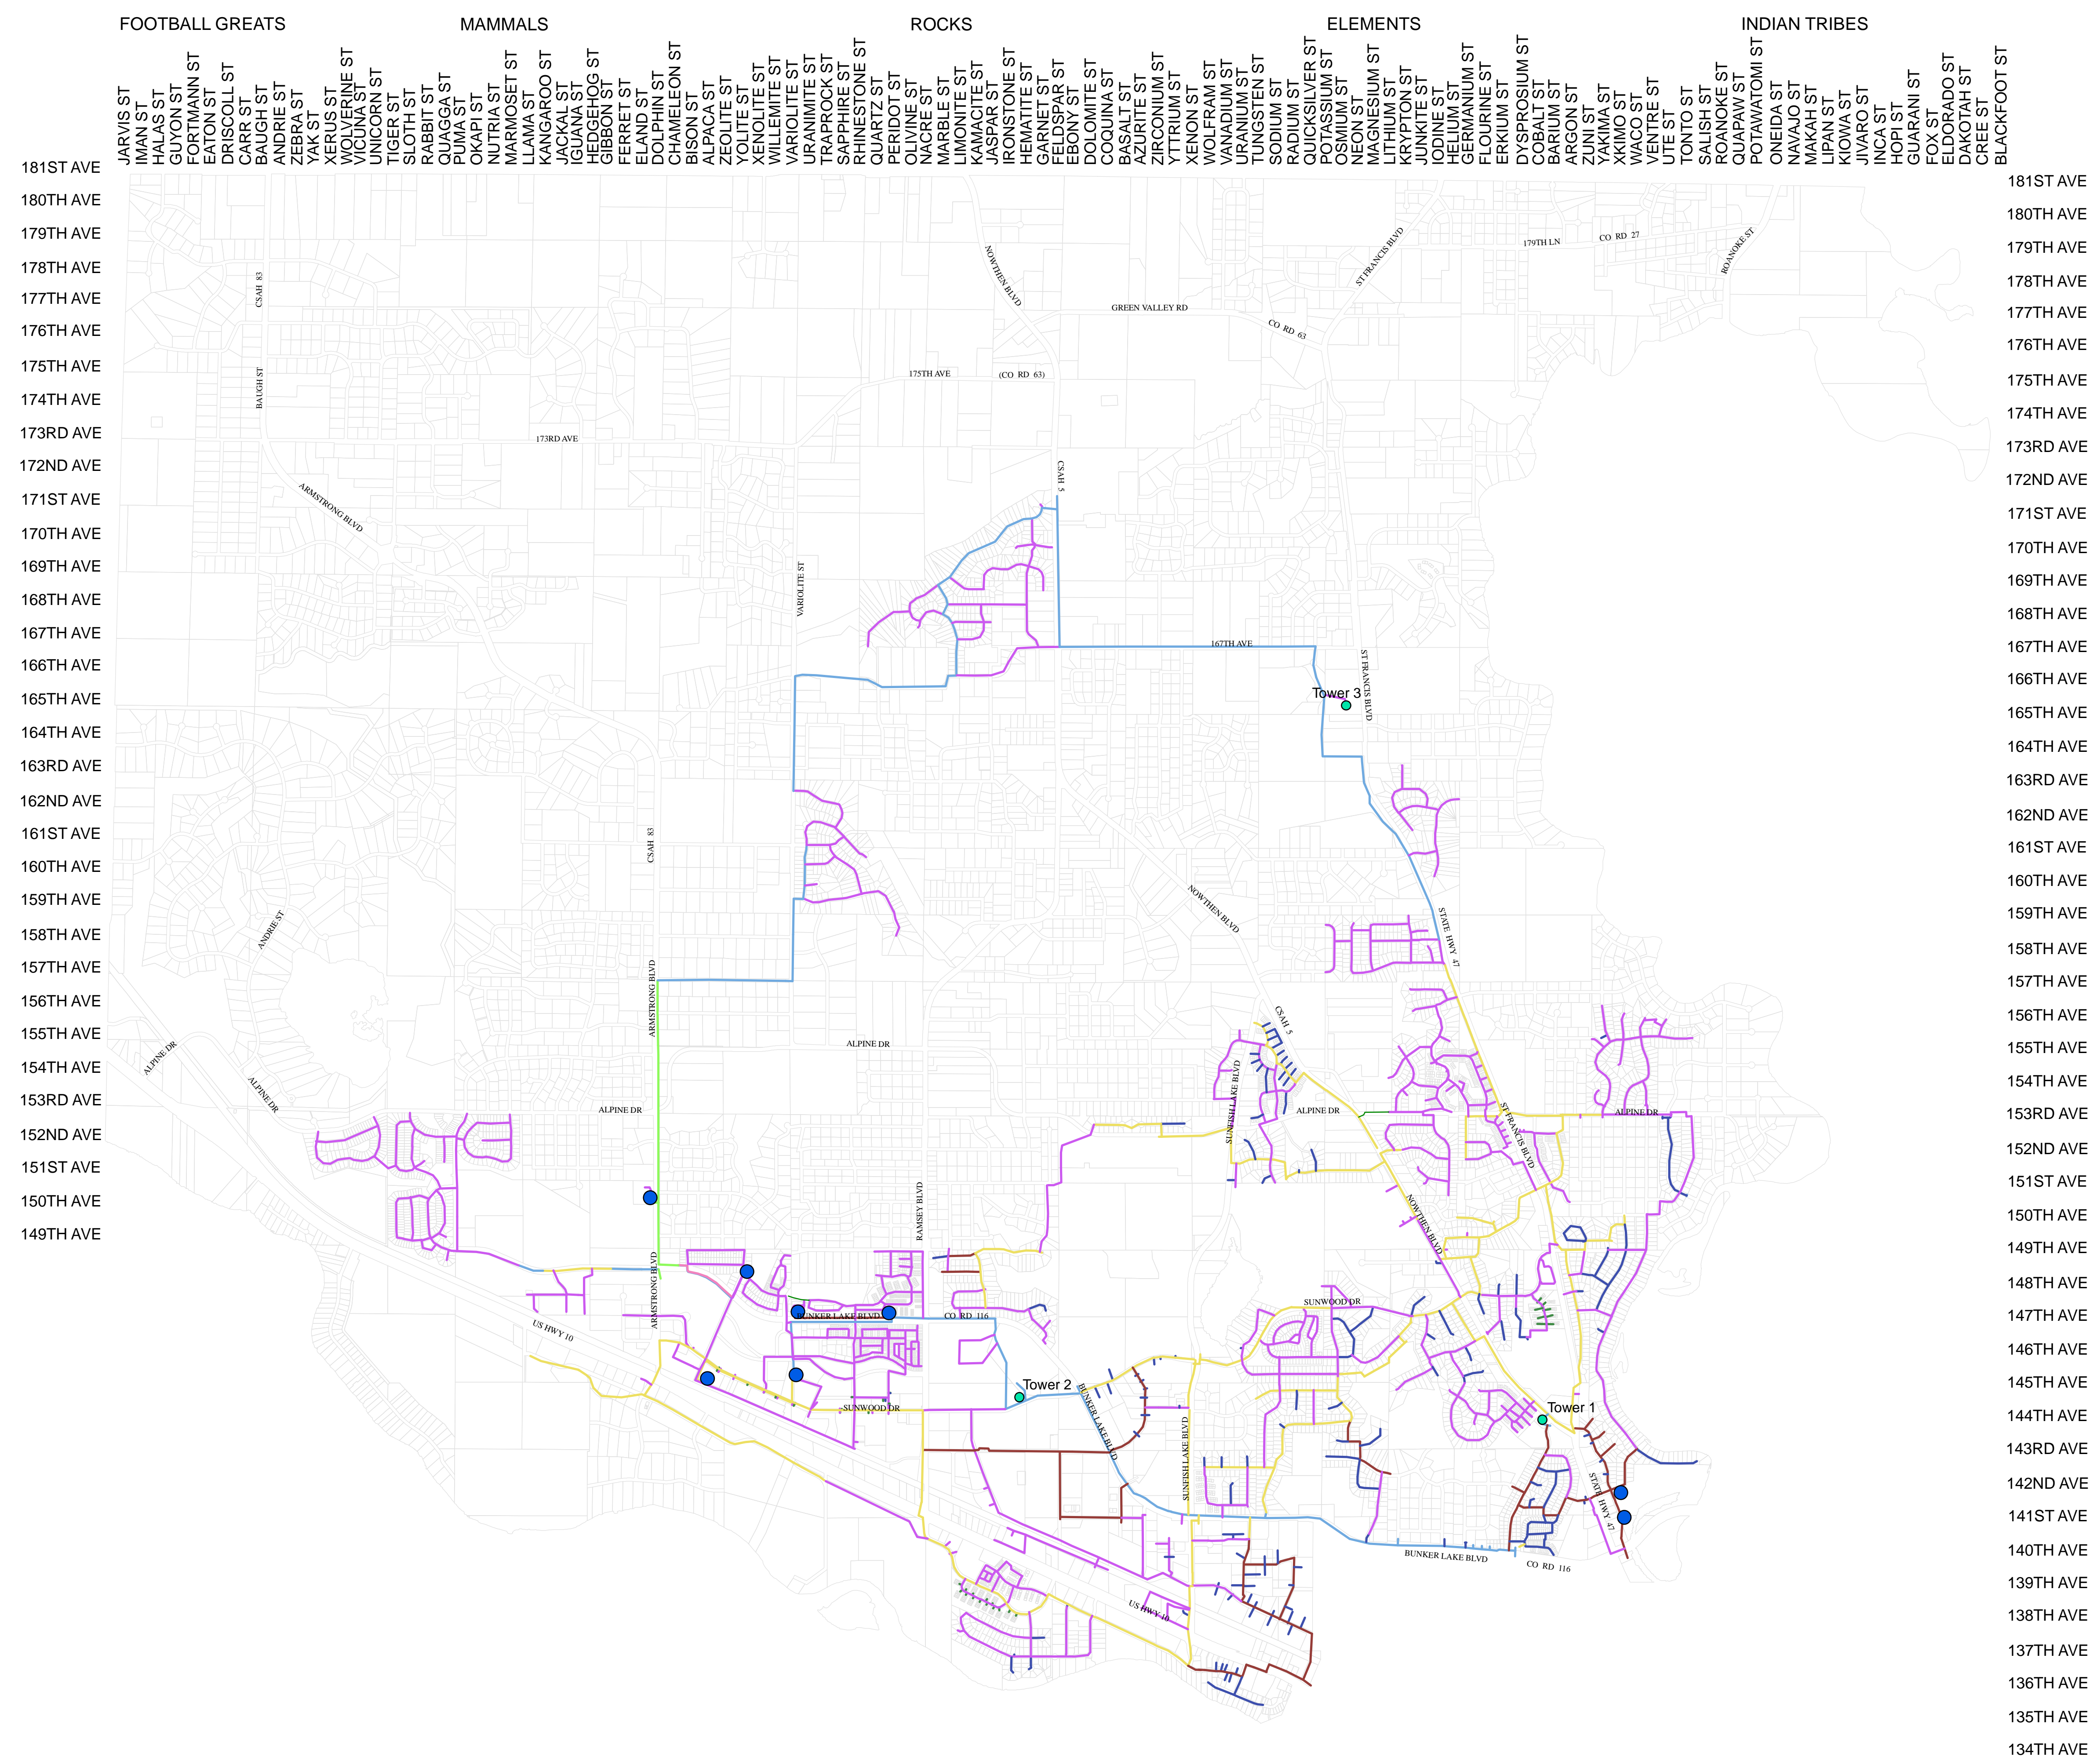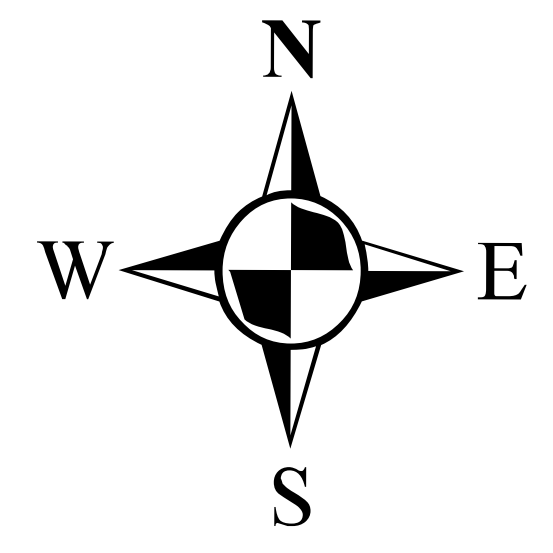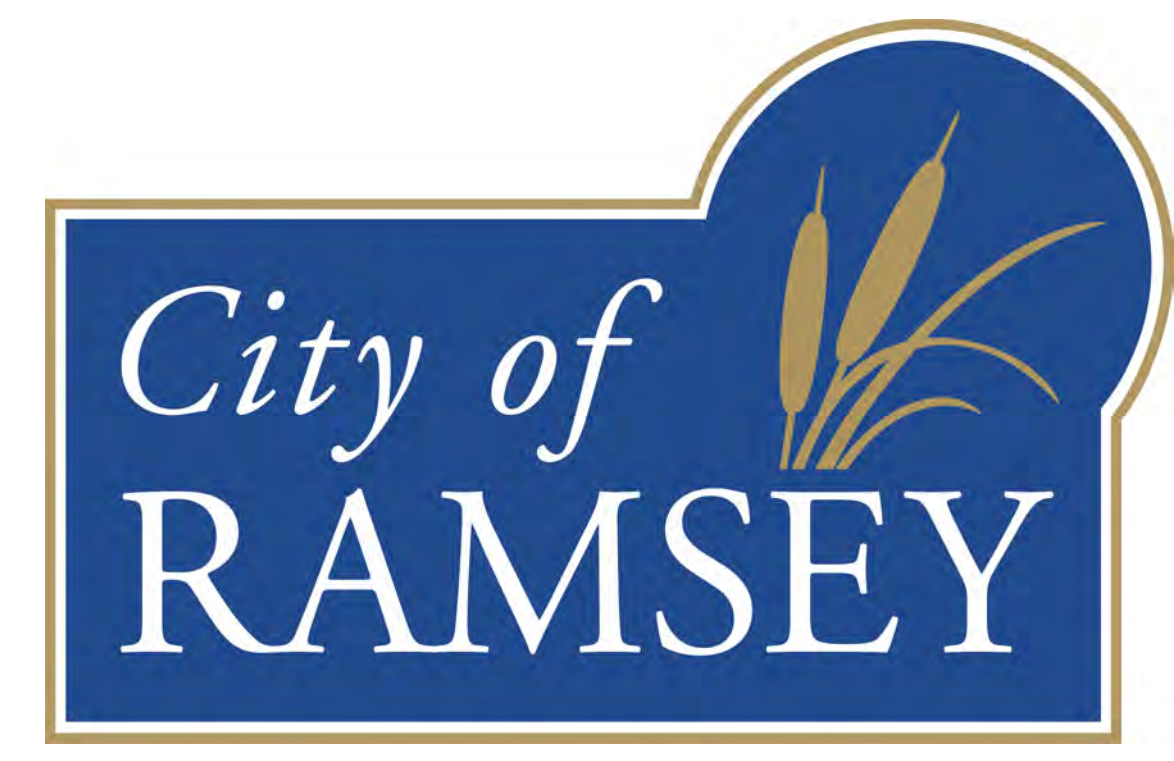


Legend

- Towers
- Water_lines_2020**
 - <all other values>
- Layer**
 - 4" watermain
 - 6" watermain
 - 8" watermain
 - 10" watermain
 - 12" watermain
 - 16" watermain
 - 20" watermain
 - 24" watermain
- Wells
- Northfork Meadow Addressing



APPENDIX D

Ramsey Water System Plans

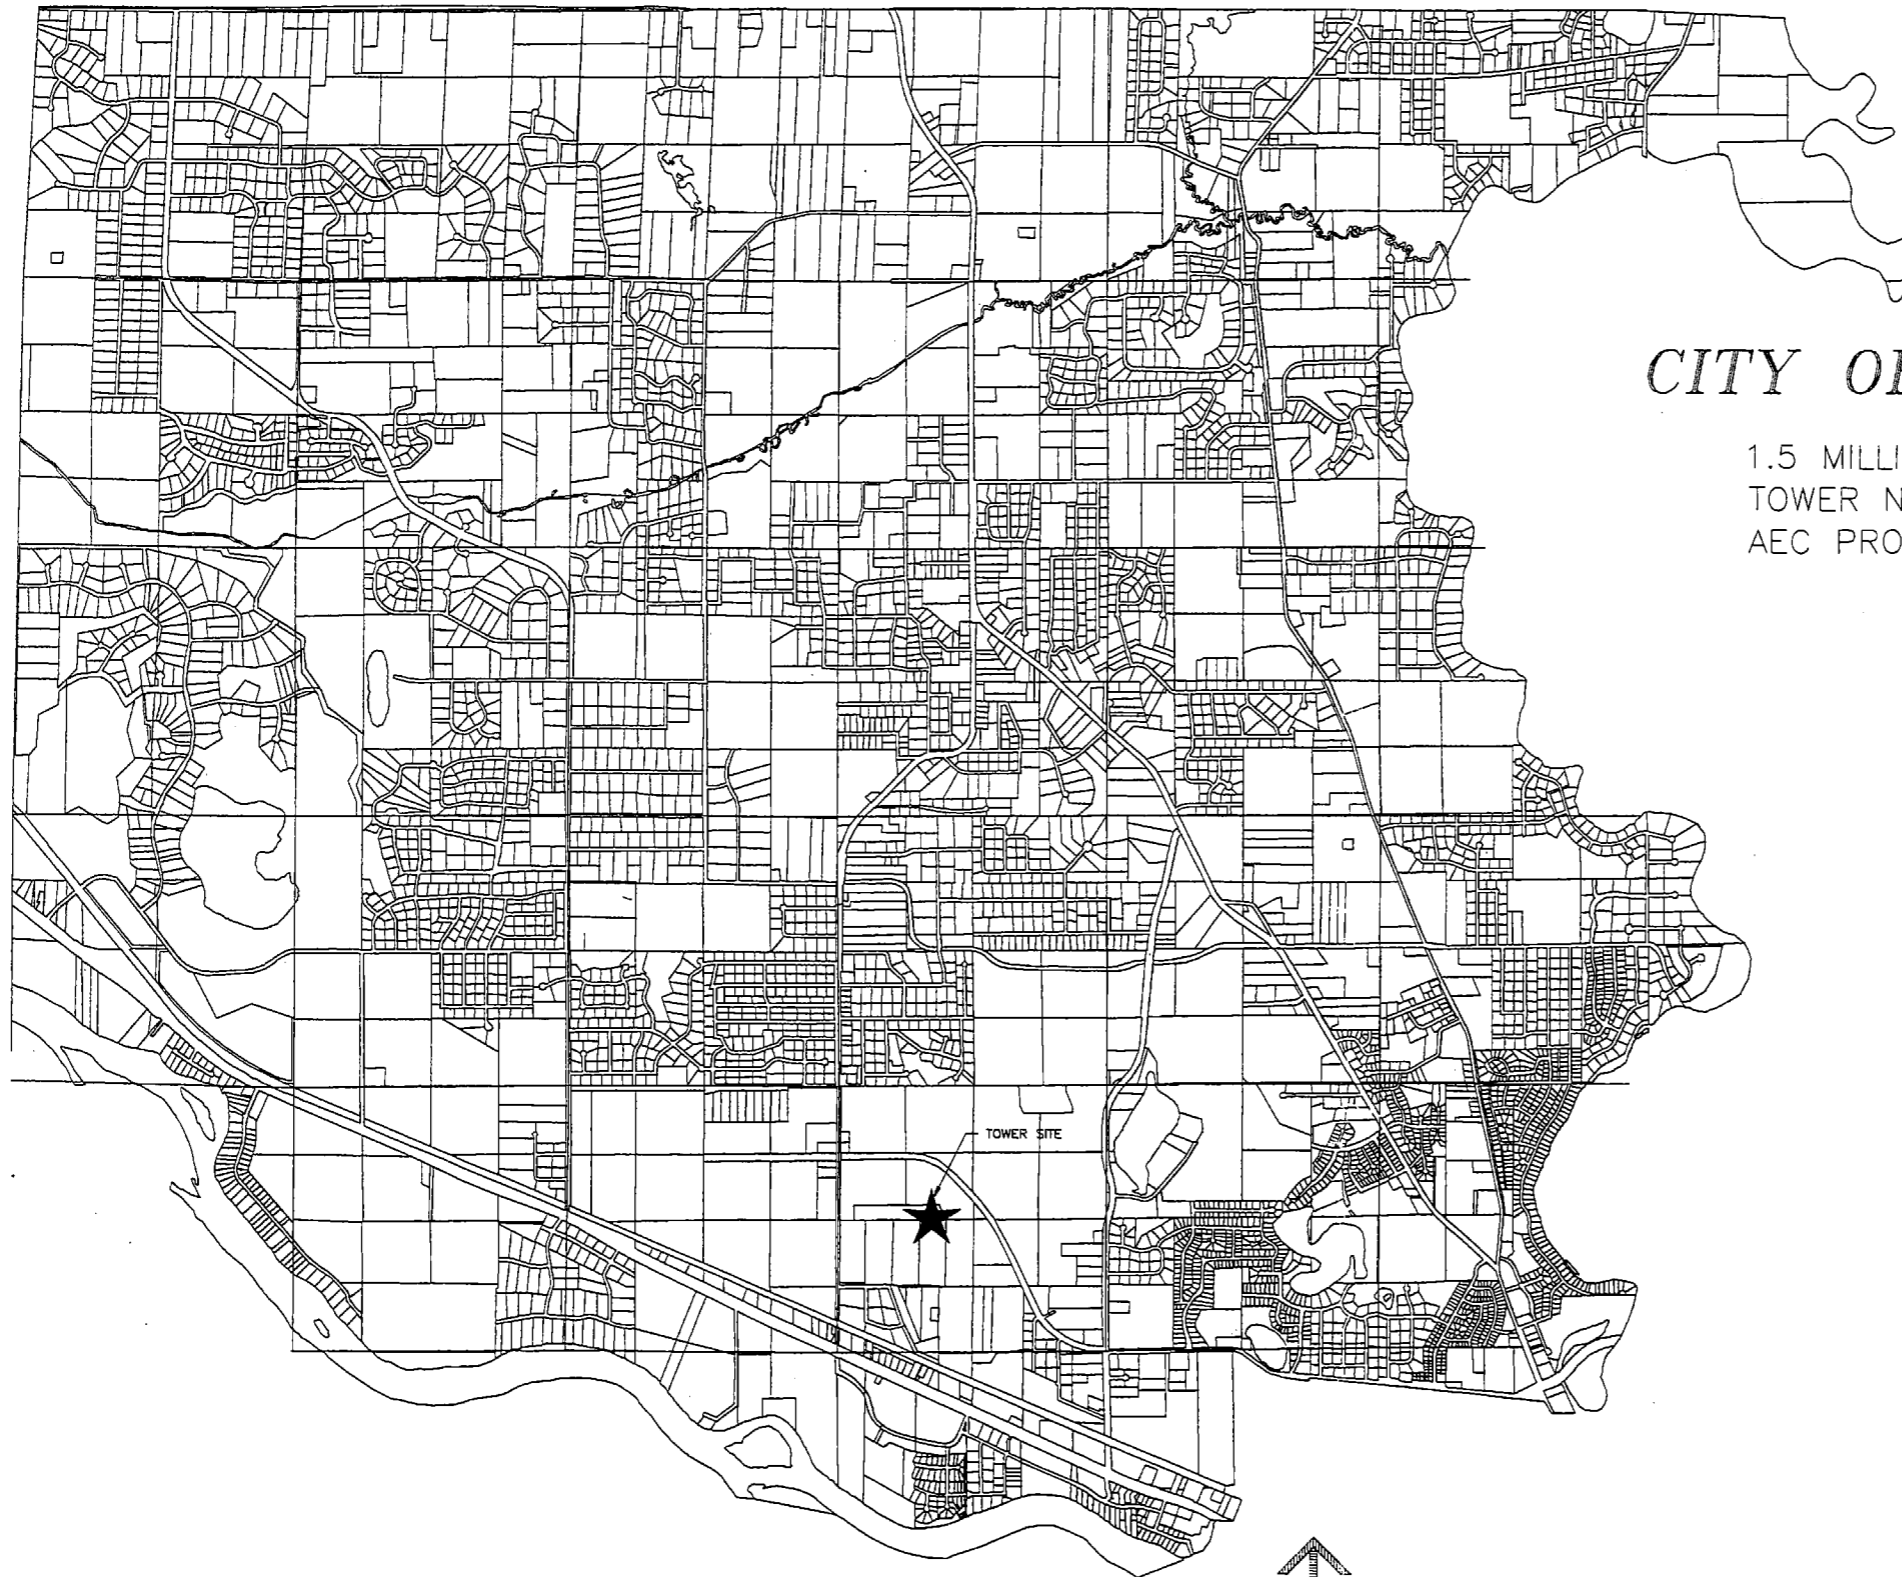

VICINITY MAP

CITY OF RAMSEY, MINNESOTA


1.5 MILLION GALLON WATER TOWER
 TOWER NO. 2 - IMPROVMENT PROJECT #99-64
 AEC PROJECT # 200502-2701

INDEX OF SHEETS


- T01 COVER SHEET
- T02 SITE LAYOUT
- S01 TANK STYLES
- S02 TANK STYLES
- S03 COMPOSITE TANK SECTIONS
- S04 DETAILS & SECTIONS
- S05 DETAILS, SECTIONS, & ELEVATIONS
- S06 TANK LOGO
- E01 ELECTRICAL DETAILS

753


004

01/4/25/00 LMC ORIGINAL ISSUE PROJ. NO. 200502-2701	THIS DRAWING IS THE PROPERTY OF AEC ENGINEERING AND TO BE USED ONLY IN CONNECTION WITH WORK PERFORMED BY AEC ENGINEERING. THE DRAWING IS NOT TO BE COPIED IN WHOLE OR IN PART AND MUST BE RETURNED UPON REQUEST.	SCALE AS NOTED DR. LMC CR. APP AS NOTED	DATE 4/25/00 DATE DATE	I HEREBY CERTIFY THAT THIS PLAN, SPECIFICATION, OR REPORT WAS PREPARED BY ME OR UNDER MY DIRECT SUPERVISION AND THAT I AM A DULY LICENSED PROFESSIONAL ENGINEER UNDER THE LAWS OF THE STATE OF MINNESOTA. <i>Ming McHenry</i> LICENSE NO. 26048	 Minneapolis, Minnesota Richmond, Virginia AEC ENGINEERING	CITY OF RAMSEY 1.5 MILLION GALLON WATER TOWER	CAD FILE NAME DWG \RAMSEY\200502\2701\M2701-T01 SHEET OF AEC PROJECT NO. 200502-2701 DRAWING NO. M2701-T01 REV 0
--	---	--	------------------------------	---	---	---	---

SITE LAYOUT

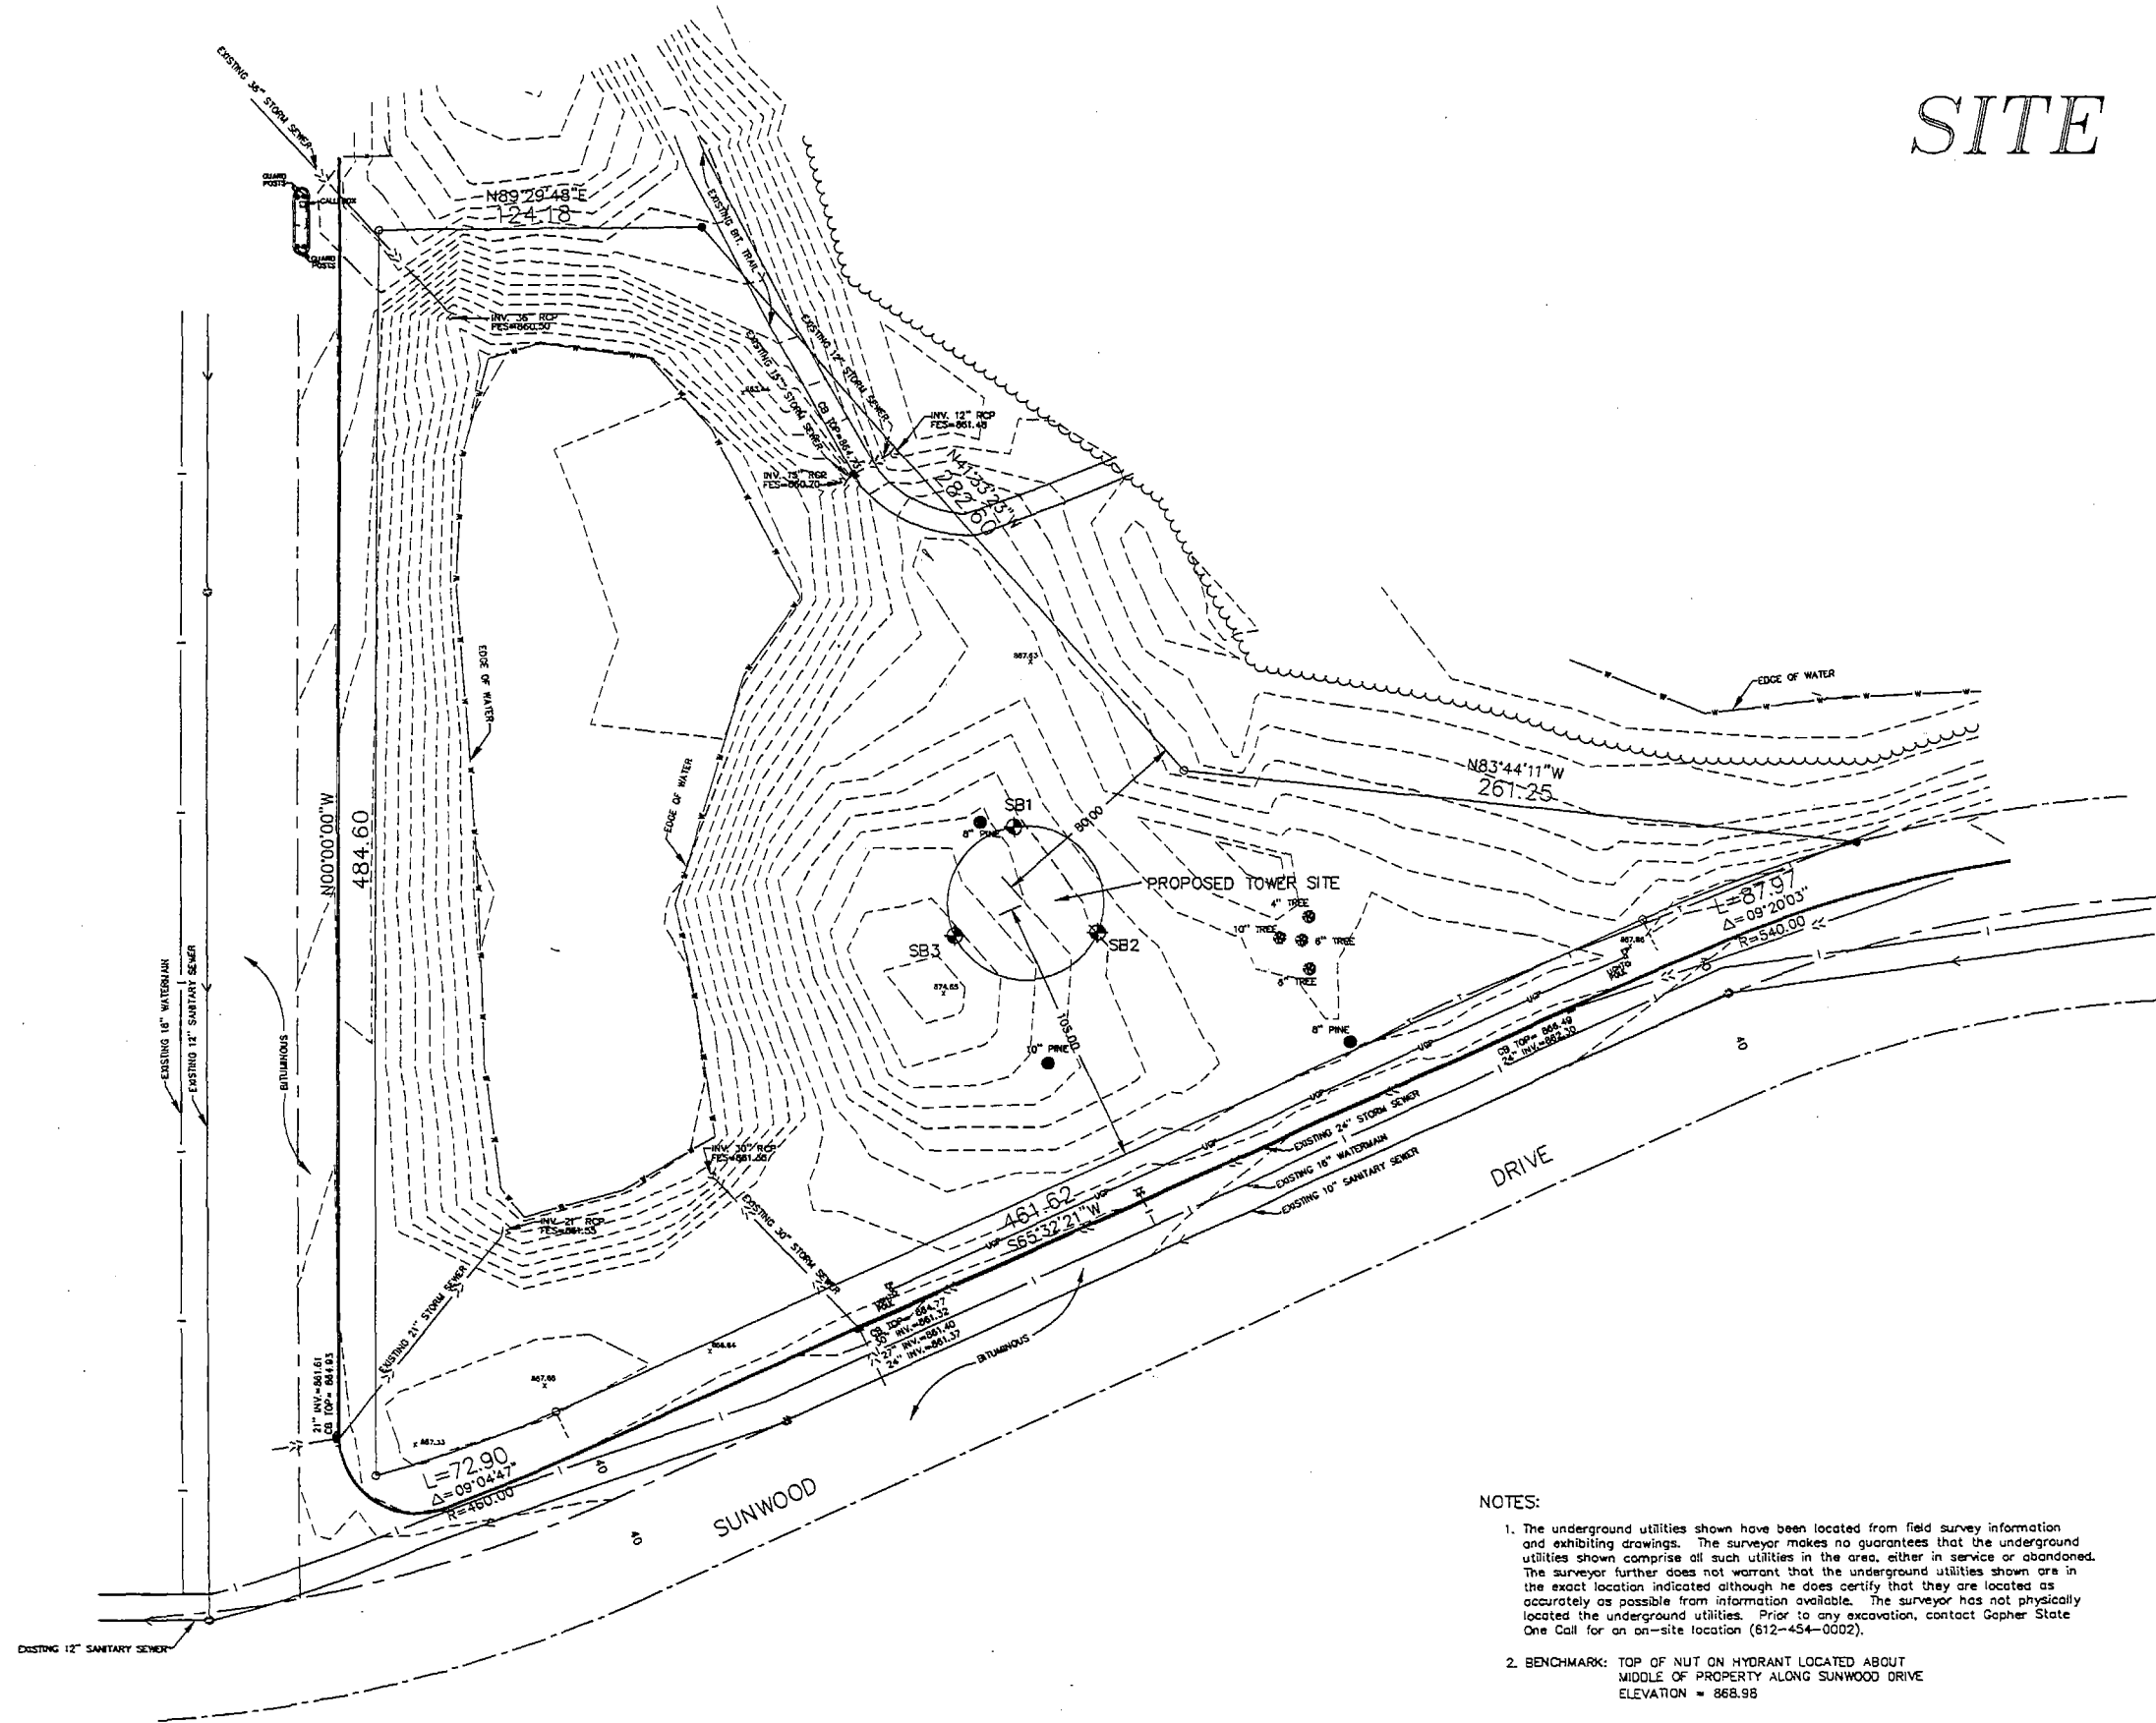

PROPERTY DESCRIPTION:
 OUTLOT B
 A.E.C. ENERGY PARK
 ANOKA COUNTY, MINNESOTA

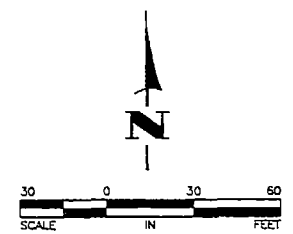

- NOTES:
- The underground utilities shown have been located from field survey information and exhibiting drawings. The surveyor makes no guarantees that the underground utilities shown comprise all such utilities in the area, either in service or abandoned. The surveyor further does not warrant that the underground utilities shown are in the exact location indicated although he does certify that they are located as accurately as possible from information available. The surveyor has not physically located the underground utilities. Prior to any excavation, contact Gopher State One Call for an on-site location (612-454-0002).
 - BENCHMARK: TOP OF NUT ON HYDRANT LOCATED ABOUT MIDDLE OF PROPERTY ALONG SUNWOOD DRIVE
 ELEVATION = 868.98

I hereby certify that this survey, plan or report was prepared by me or under my direct supervision and that I am a duly Registered Land Surveyor under the laws of the State of Minnesota.

Charles R. Christopherson 18420 2/16/00
 Reg. No. Date

754

04/25/00	LMC	ORIGINAL ISSUE	PROJ. NO. 200502-2701
----------	-----	----------------	-----------------------

THIS DRAWING IS THE PROPERTY OF AEC ENGINEERING AND TO BE USED ONLY IN CONNECTION WITH WORK PERFORMED BY AEC ENGINEERING.
 THE DRAWING IS NOT TO BE COPIED IN WHOLE OR IN PART AND MUST BE RETURNED UPON REQUEST.





SCALE AS NOTED	DATE
J.R. LMC	4/25/00
C.K.	DATE
APP AS NOTED	DATE

I HEREBY CERTIFY THAT THIS PLAN, SPECIFICATION, OR REPORT WAS PREPARED BY ME OR UNDER MY DIRECT SUPERVISION AND THAT I AM A DULY LICENSED PROFESSIONAL ENGINEER UNDER THE LAWS OF THE STATE OF MINNESOTA.




SITE LAYOUT
 CITY OF RAMSEY
 1.5 MILLION GALLON
 WATER TOWER

CADD FILE NAME D:\WG\RAMSEY\200502\2701\M2701-T02	REV
SHEET OF AEC PROJECT NO. 200502-2701	0
DRAWING NO. M2701-T02	

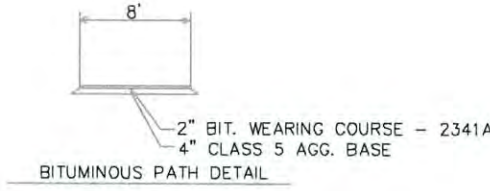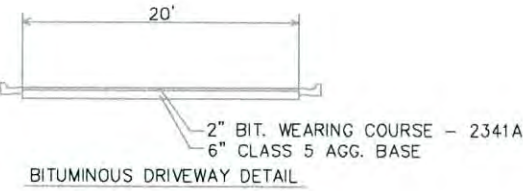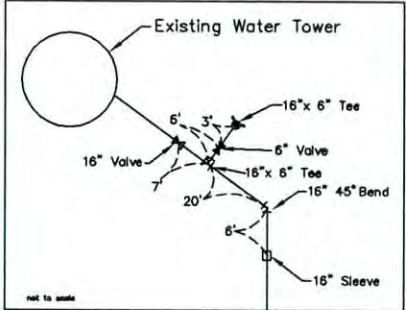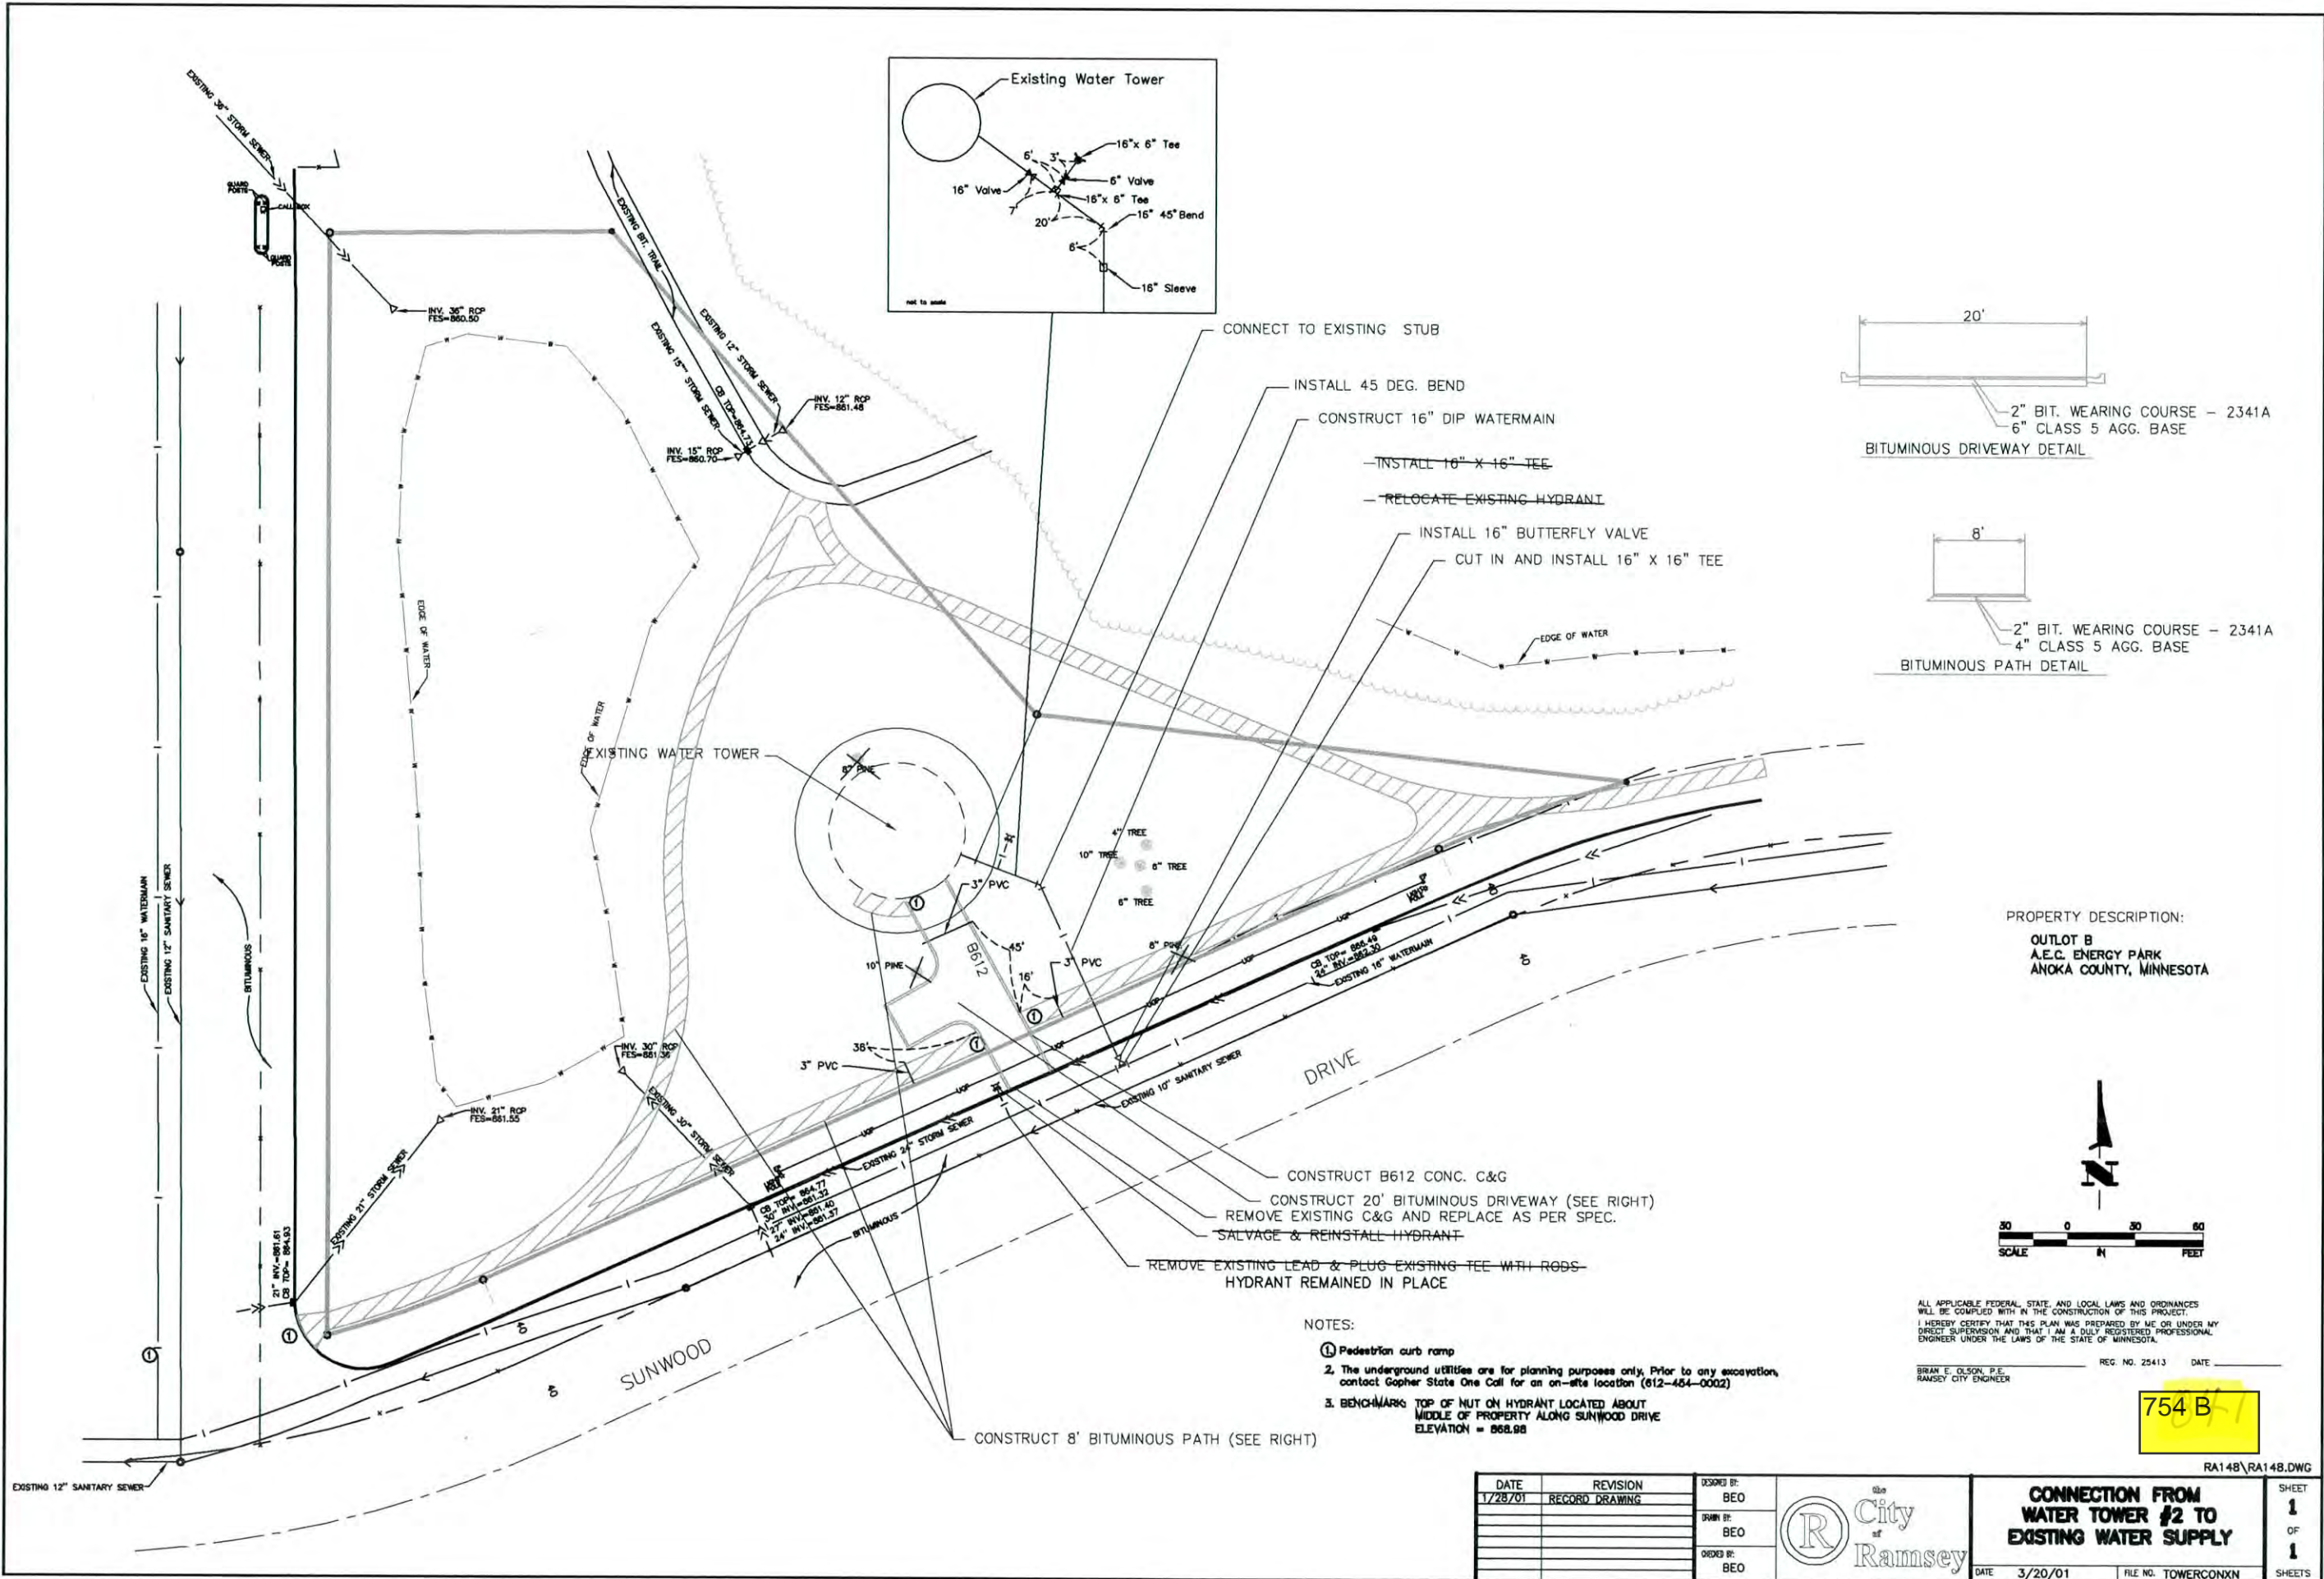

PROPERTY DESCRIPTION:
 OUTLOT B
 A.E.C. ENERGY PARK
 ANOKA COUNTY, MINNESOTA

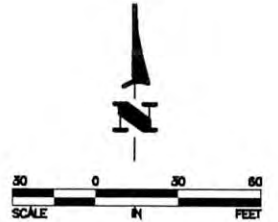

- NOTES:
1. Pedestrian curb ramp
 2. The underground utilities are for planning purposes only. Prior to any excavation, contact Gopher State One Call for an on-site location (612-484-0002)
 3. BENCHMARK: TOP OF NUT ON HYDRANT LOCATED ABOUT MIDDLE OF PROPERTY ALONG SUNWOOD DRIVE ELEVATION = 868.88


ALL APPLICABLE FEDERAL, STATE, AND LOCAL LAWS AND ORDINANCES WILL BE COMPLIED WITH IN THE CONSTRUCTION OF THIS PROJECT. I HEREBY CERTIFY THAT THIS PLAN WAS PREPARED BY ME OR UNDER MY DIRECT SUPERVISION AND THAT I AM A DULY REGISTERED PROFESSIONAL ENGINEER UNDER THE LAWS OF THE STATE OF MINNESOTA.

REG. NO. 25413 DATE _____
 BRIAN E. OLSON, P.E.
 RAMSEY CITY ENGINEER

754 B


DATE 1/28/01	REVISION RECORD DRAWING	DESIGNED BY: BEO		CONNECTION FROM WATER TOWER #2 TO EXISTING WATER SUPPLY	SHEET 1 OF 1 SHEETS
		DRAWN BY: BEO			
		CHECKED BY: BEO			
			DATE 3/20/01	FILE NO. TOWERCONXN	

RA148\RA148.DWG

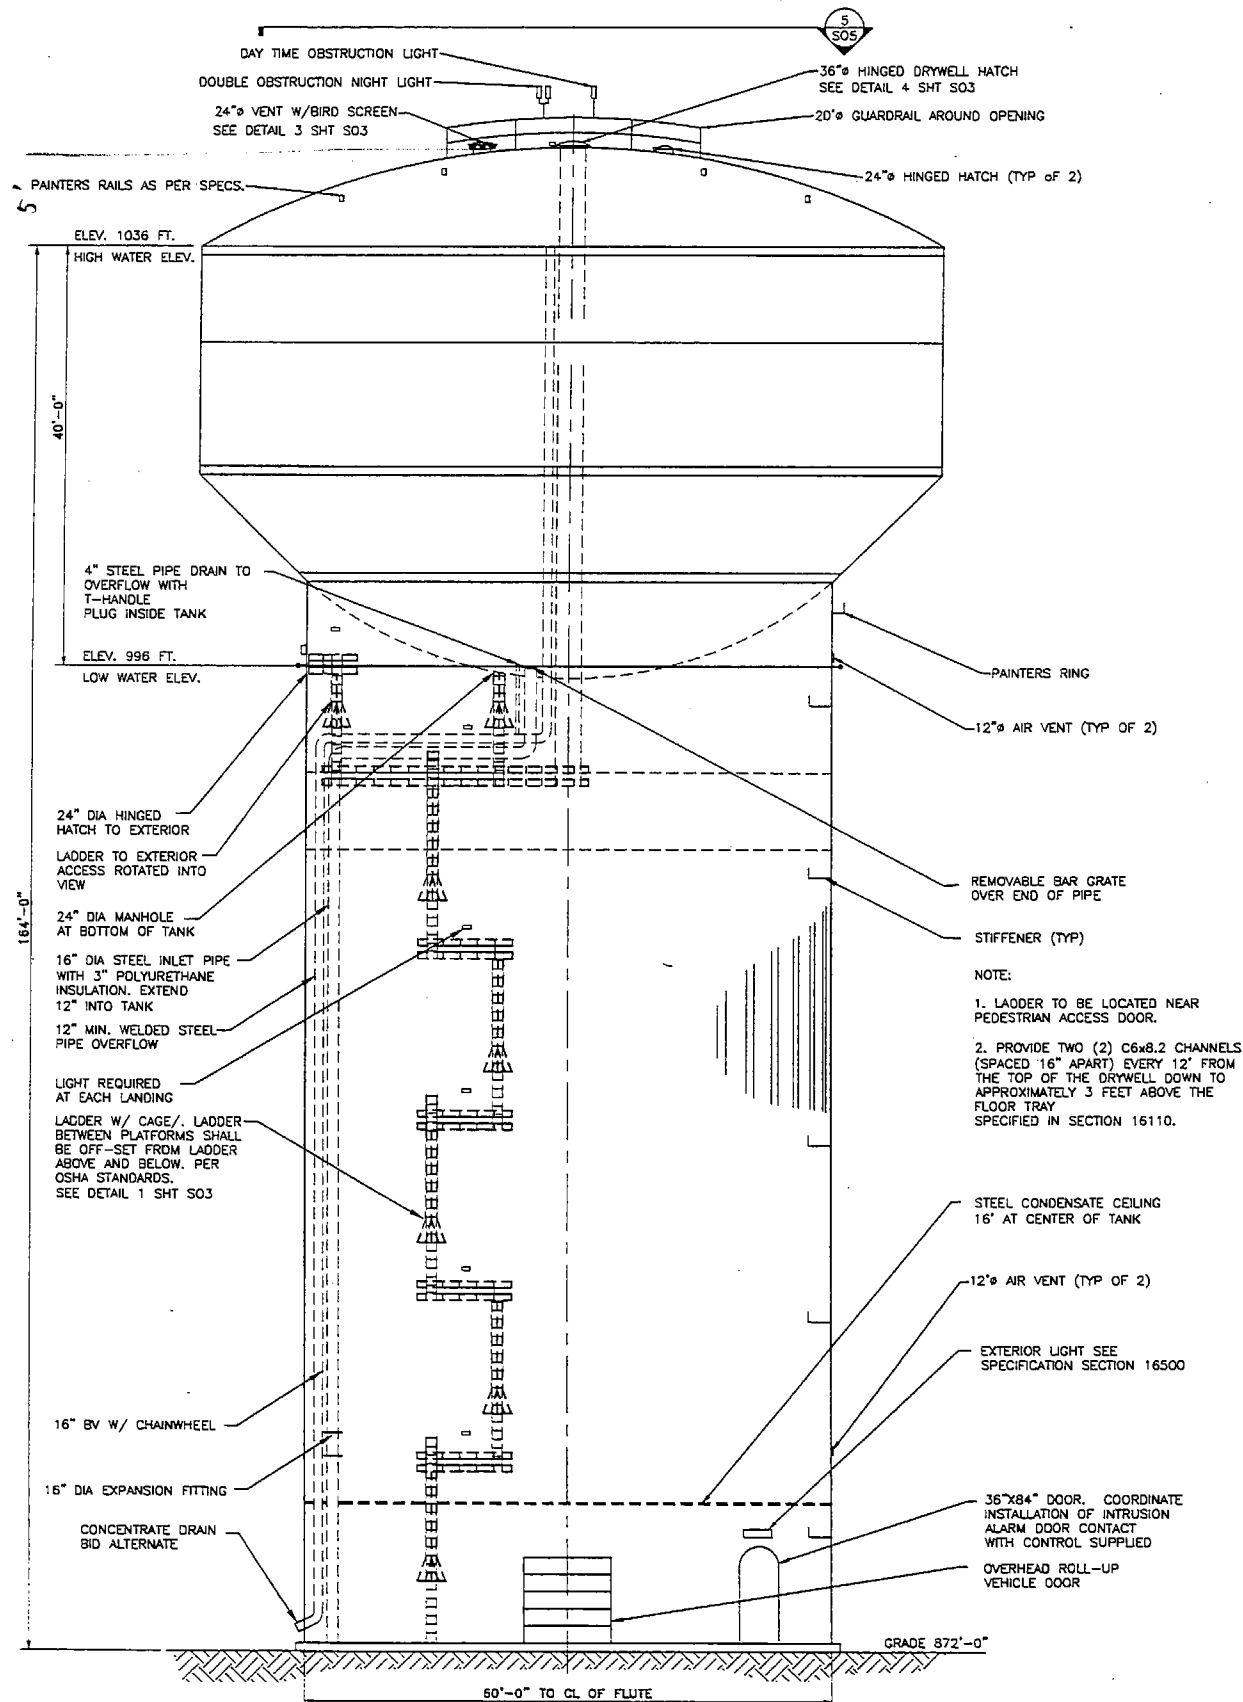

1 S01 FLUTED COLUMN ELEVATION

SCALE: 3/32" = 1'-0"

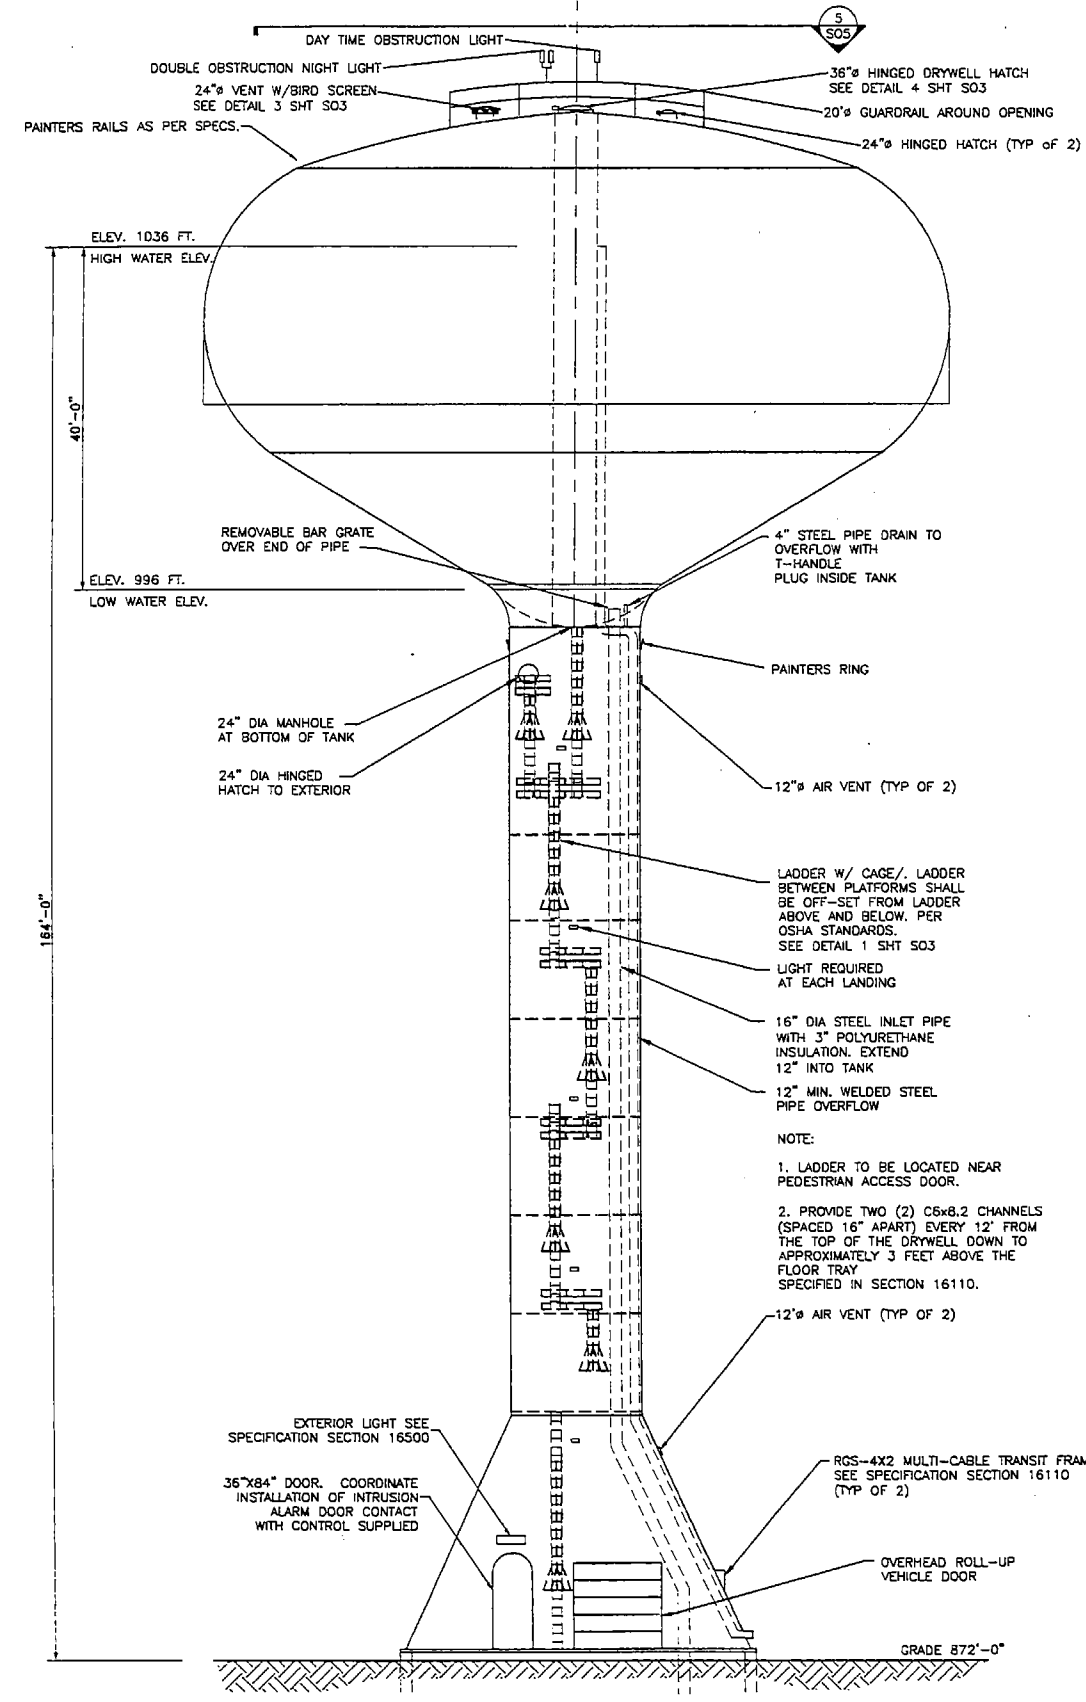

2 S01 PEDESTAL SPHEROID ELEVATION

SCALE 3/32" = 1'-0"

755

4/25/00	LMC	ORIGINAL ISSUE	PROJ. NO. 200502-2701
---------	-----	----------------	-----------------------

THIS DRAWING IS THE PROPERTY OF AEC ENGINEERING AND IS TO BE USED ONLY IN CONNECTION WITH WORK PERFORMED BY AEC ENGINEERING.

THE DRAWING IS NOT TO BE COPIED IN WHOLE OR IN PART AND MUST BE RETURNED UPON REQUEST.

SCALE	AS NOTED
DR.	LMC
DATE	4/25/00
CK.	
DATE	
APP.	
DATE	
AS NOTED	


I HEREBY CERTIFY THAT THIS PLAN, SPECIFICATION OR REPORT WAS PREPARED BY ME OR UNDER MY DIRECT SUPERVISION AND THAT I AM A DULY LICENSED PROFESSIONAL ENGINEER UNDER THE LAWS OF THE STATE OF MINNESOTA.

Shirley M. McElroy
 DATE: 4/25/00



TANK STYLES
 CITY OF RAMSEY
 1.5 MILLION GALLON
 WATER TOWER

CADD FILE NAME	DWG\RAMSEY\200502\2701\M2701-S01
SHEET	OF AEC PROJECT NO. 200502-2701
DRAWING NO.	M2701-S01
REV	0

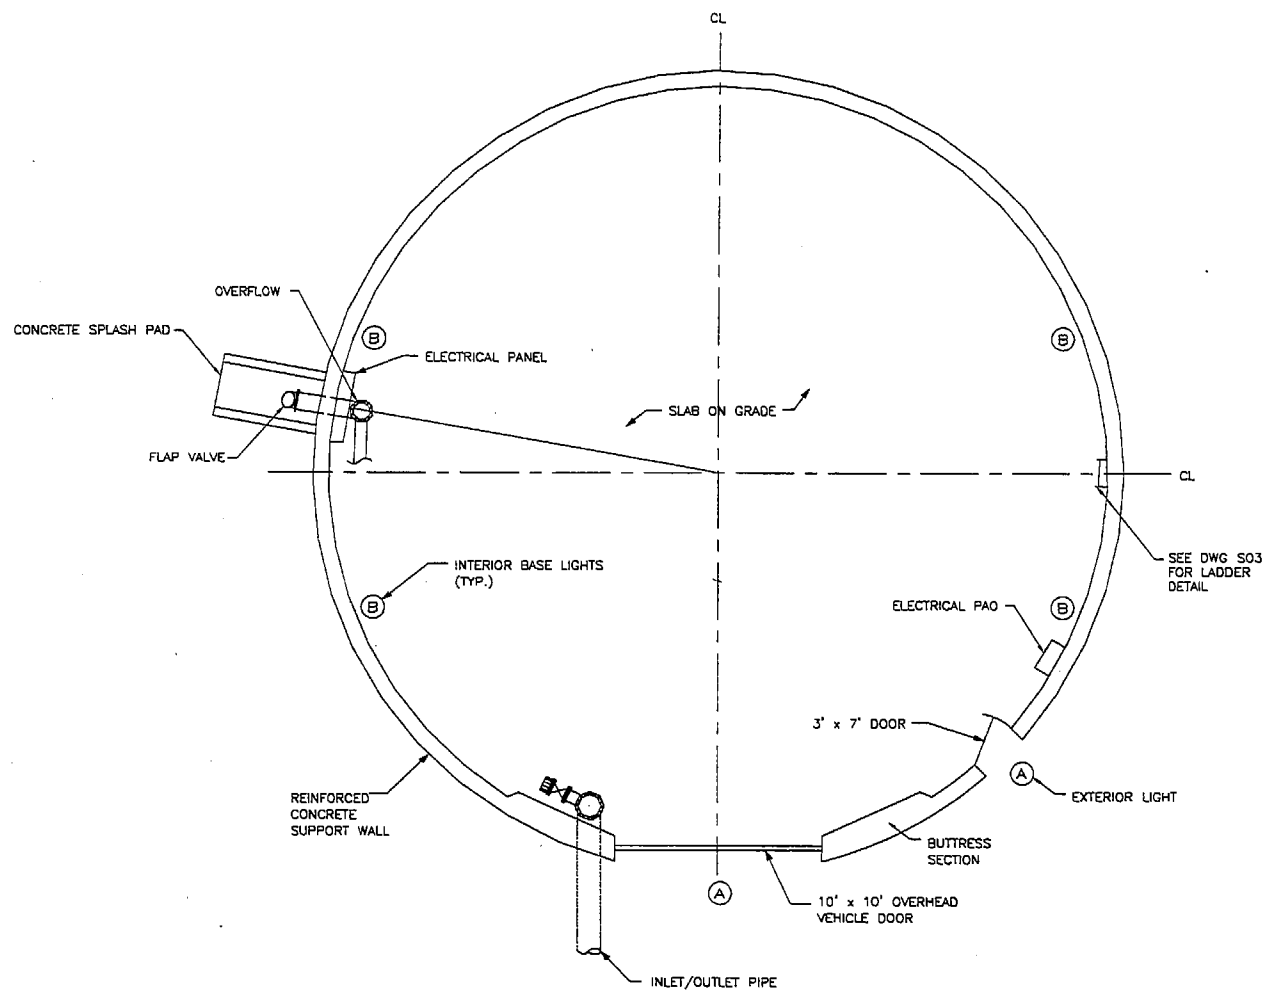

↑
N
1
S03
PLAN VIEW
SCALE: NONE

NOTES:

GENERAL:

- 1 -MANDOOR - 3'x7' 18 GA. HOLLOW METAL DOOR WITH 16 GA. FRAME AND HEAVY DUTY CLOSURE.
- 2 -PEDESTAL TRUCK DOOR - 10' WIDE x 10' HIGH ROLLING STEEL WITH 22 GA. GALVANIZED SLATS AND MANUAL CHAIN OPERATOR.
- 3 -PROVIDE MONOLITHIC REINFORCED CONCRETE INTERNAL BUTTRESS SECTION ON EACH SIDE OF VEHICLE DOOR. BUTTRESS TO BE MINIMUM 4' - 0" WIDE AND 6" THICKER THAN NOMINAL WALL DIMENSION.

SLAB ON GRADE:

- 1 -FLOOR SLAB - 6" THICK 3500 PSI CONCRETE ON COMPACTED GRANULAR REINFORCED WITH #5 REBAR AT 12" E.W.
- 2 -PROVIDE 1/2" ISOLATION JOINT BETWEEN FLOOR AND WALL AND AT PIPES/SUPPORTS THROUGH FLOOR. CAP W/ SELF LEVELING SEALANT.
- 3 -SAWCUT 1-1/2" DEEP AT 20 FEET MAXIMUM CENTERS.
- 4 -SLOPE SLAB .5% FOR DRAIN TO TRUCK DOOR.

MECHANICAL:

- 1 -PROVIDE EXPANSION JOINT ON INLET OUTLET RISER TO ACCOMMODATE MAXIMUM POTENTIAL DIFFERENTIAL MOVEMENT.
- 2 -CONNECT RISER AND OVERFLOW WITH A VALVED LATERAL TO ACCOMMODATE TANK DRAINING.
- 3 -PROVIDE THRUST RESTRAINT AND SUPPORT AS REQUIRED.
- 4 -INSTALL 3 PC. 3/4" COUPLINGS WITH BRONZE GATE VALVE AND PLUG ON INLET / OUTLET.
- 5 -INLET / OUTLET RISER PIPE TO BE INSULATED, AND CLAD WITH ALUMINUM JACKET

ELECTRICAL:

- 1 -MOUNT EXTERIOR DOOR LIGHTS 10' ABOVE SLAB ON GRADE.
- 2 -MOUNT INTERIOR PEDESTAL BASE LIGHTS 10' ABOVE SLAB ON GRADE.

756

01/4/25/00	LMC ORIGINAL ISSUE	PROJ. NO. 200502-2701

THIS DRAWING IS THE PROPERTY OF AEC ENGINEERING AND TO BE USED ONLY IN CONNECTION WITH WORK PERFORMED BY AEC ENGINEERING.	
SCALE AS NOTED	DATE 4/25/00
DR. LMC	DATE
CHK.	DATE
APP. AS NOTED	DATE


I HEREBY CERTIFY THAT THIS PLAN, SPECIFICATION, OR REPORT WAS PREPARED BY ME OR UNDER MY DIRECT SUPERVISION AND THAT I AM A DULY LICENSED PROFESSIONAL ENGINEER UNDER THE LAWS OF THE STATE OF MINNESOTA.

[Signature]
DATE: 4/25/00


Minneapolis, Minnesota
Richmond, Virginia
AEC ENGINEERING

COMPOSITE TANK SECTION
CITY OF RAMSEY
1.5 MILLION GALLON
WATER TOWER

CADD FILE NAME	DWG\RAMSEY\200502\2701\M2701-S03
SHEET OF	AEC PROJECT NO. 200502-2701
DRAWING NO.	REV
M2701-S03	0

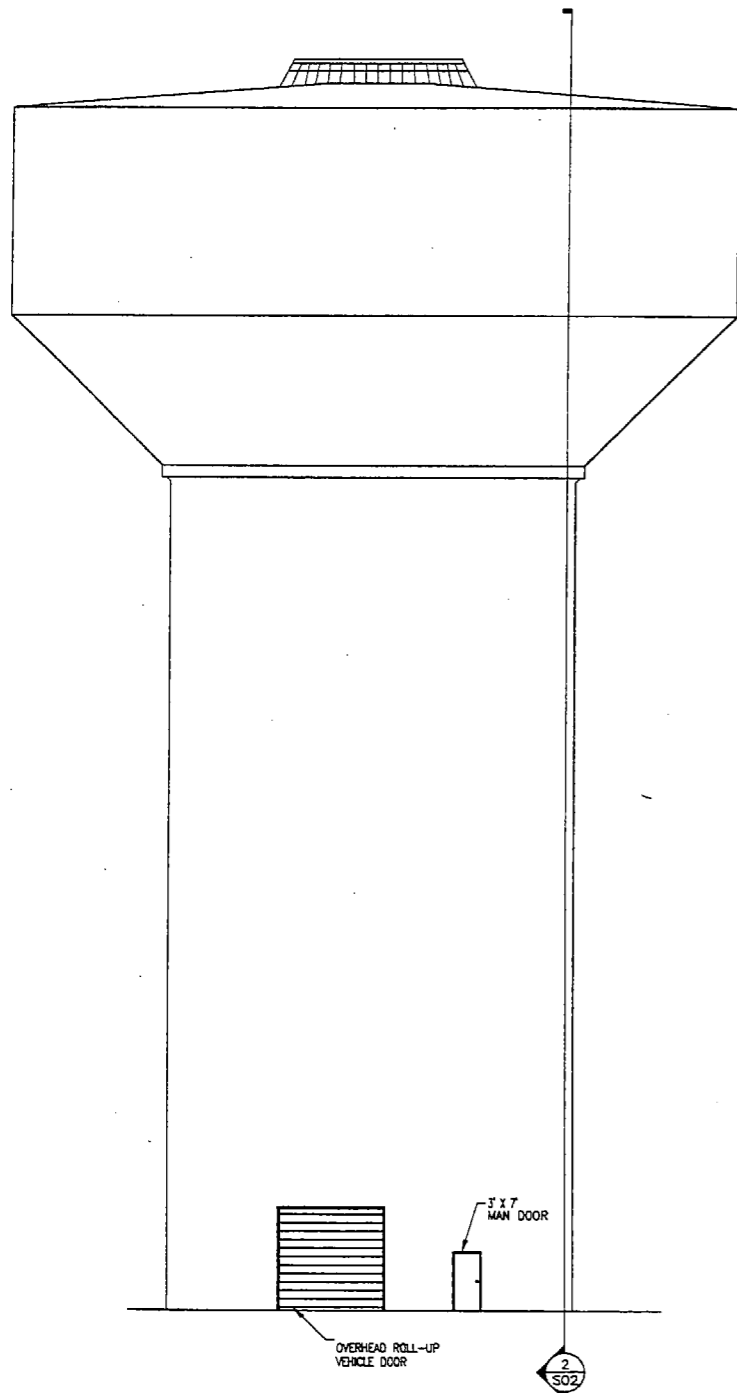

1
S02
COMPOSITE TANK ELEVATION
SCALE: NTS

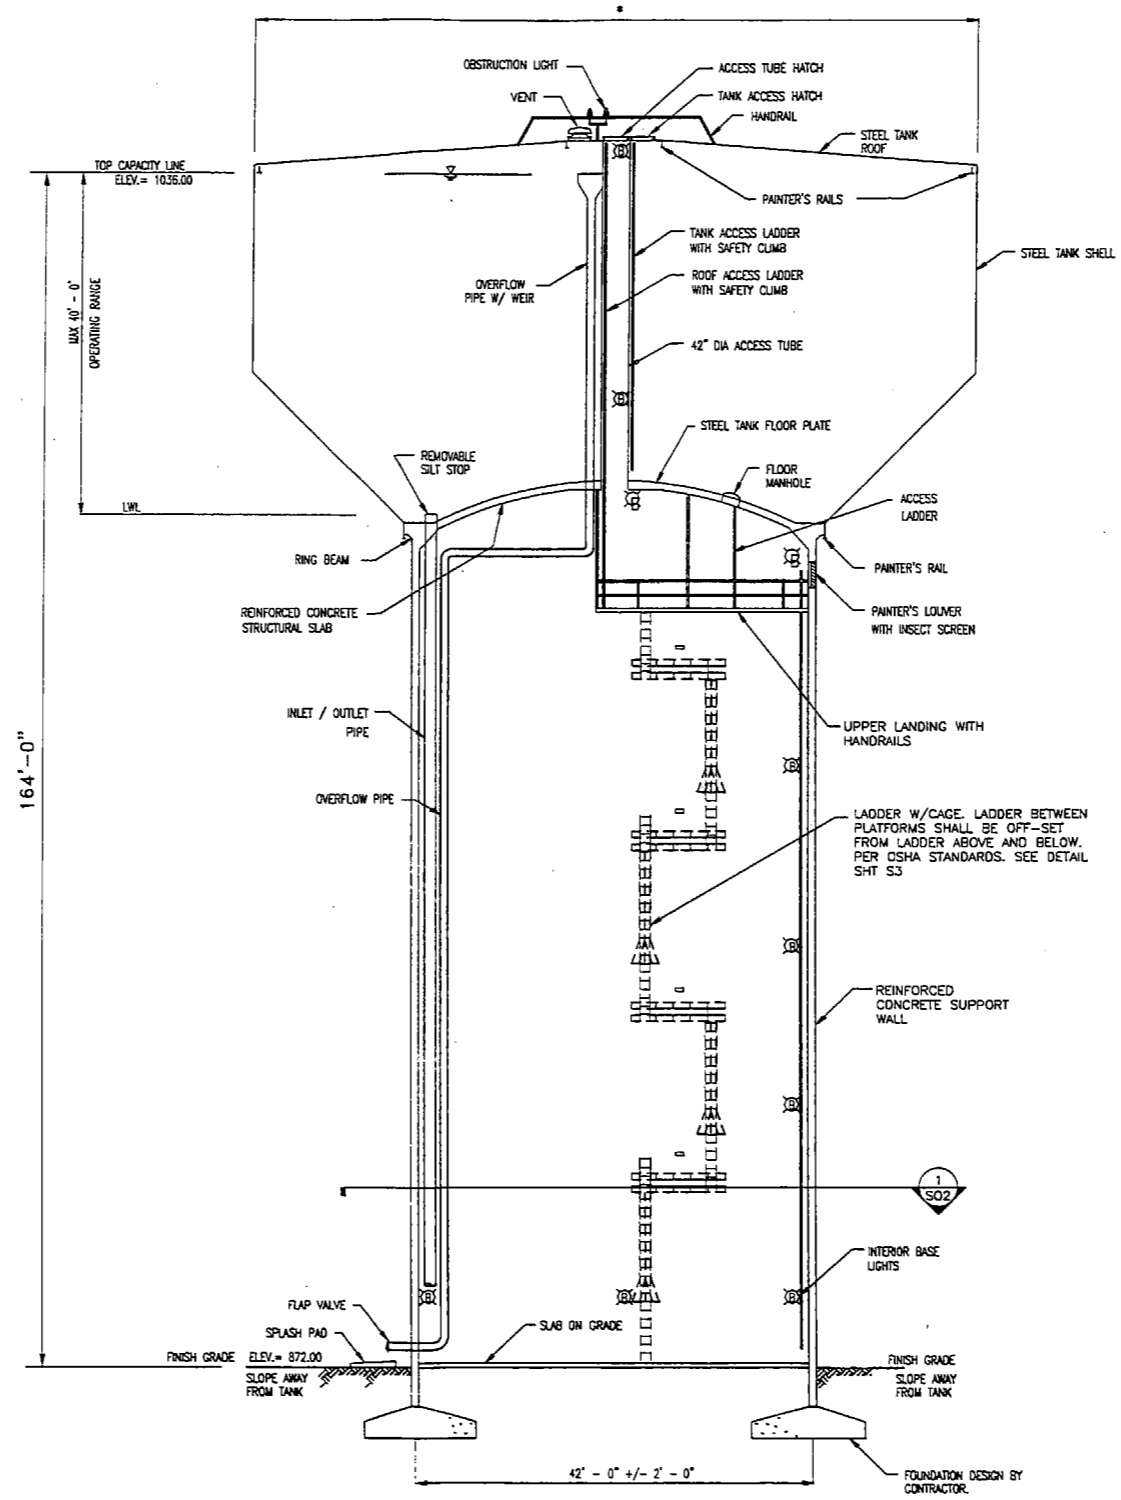

2
S02
SECTION
SCALE: NTS

NOTES:

GENERAL:

- 1 - SEE CONTRACT SPECIFICATIONS FOR DESIGN CRITERIA AND DETAILS. APPLICABLE ELEVATED TANK SPECIFICATIONS ARE AWWA D100-96 AND ACI 318-95.
- 2 - STEEL TANK FLOOR WITHIN THE PERIMETER OF THE CONCRETE SUPPORT PEDESTAL SHALL BE SUPPORTED BY A DOMED STRUCTURAL CONCRETE SLAB.
- 3 - PROVIDE ADEQUATE FREEBOARD TO INSURE ROOF PROJECTIONS AND PAINTER'S RAIL REMAIN ABOVE THE HIGH WATER LEVEL.
- 4 - CONCRETE PEDESTAL EXTERIOR SHALL INCORPORATE HORIZONTAL AND VERTICAL RUSTICATION STRIPS TO CREATE A SYMMETRICAL ARCHITECTURAL PATTERN
- 5 - TANK APPURTENANCES ARE ROTATED FOR CLARITY.

FOUNDATION:

- 1 - REFER TO THE GEOTECHNICAL REPORT FOR RECOMMENDATIONS REGARDING ALLOWABLE BEARING CAPACITY.
- 2 - DESIGN FOUNDATION SYSTEM PER GEOTECHNICAL REPORT RECOMMENDATIONS AND MAXIMUM APPLICABLE DESIGN LOADS IN ACCORDANCE WITH AWWA D100-96.
- 3 - CONCRETE FOUNDATION DESIGN IN ACCORDANCE WITH ACI 318-95

MECHANICAL:

- 1 - INLET / OUTLET AND OVERFLOW PIPING WITHIN THE PEDESTAL SHALL BE TYPE 304L STAINLESS STEEL.
- 2 - PROVIDE HANGERS, BRACKETS, AND THRUST RESTRAINT AS REQUIRED.
- 3 - OVERFLOW SYSTEM SHALL BE DESIGNED TO ACCOMMODATE MAXIMUM FILL RATE. SEE CONTRACT SPECIFICATION.
- 4 - REMOVABLE SILT STOP SHALL BE MINIMUM 6 INCHES ABOVE TANK FLOOR.


MISCELLANEOUS IRON:


- 1 - ALL LADDERS AND LANDINGS SHALL BE GALVANIZED.
- 2 - PROVIDE ALUMINUM SAFETY RAILS ON ALL LADDERS.
- 3 - ROOF AND TANK ACCESS SHALL BE 30" DIA.
- 4 - A REMOVABLE ALUMINUM PAINTER'S LOUVER SHALL BE INSTALLED AT THE UPPER LANDING FOR ACCESS TO THE EXTERIOR PAINTER'S RAIL.

ELECTRICAL:

- 1 - MOUNT BASE LIGHTS 10 FEET ABOVE SLAB ON GRADE.
- 2 - LADDER LIGHTS SHALL BE AT 25 FEET MAXIMUM SPACING.


757

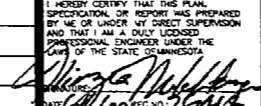0	4/25/00	LMC ORIGINAL ISSUE	PROJ. NO. 200502-2701	THIS DRAWING IS THE PROPERTY OF AEC ENGINEERING AND IS TO BE USED ONLY IN CONNECTION WITH WORK PERFORMED BY AEC ENGINEERING.	SCALE AS NOTED	DATE 4/25/00	I HEREBY CERTIFY THAT THIS PLAN, SPECIFICATION OR REPORT WAS PREPARED BY ME OR UNDER MY DIRECT SUPERVISION AND THAT I AM A DULY LICENSED PROFESSIONAL ENGINEER UNDER THE LAWS OF THE STATE OF MINNESOTA.  Virginia M. Kelly Minneapolis, Minnesota Richmond, Virginia AEC ENGINEERING	TANK STYLES CITY OF RAMSEY 1.5 MILLION GALLON WATER TOWER	CADR FILE NAME	200502\2701\M2701-S02	
				DATE		SHEET			OF	AEC PROJECT NO.	200502-2701
				DATE		DRAWING NO.				REV	0

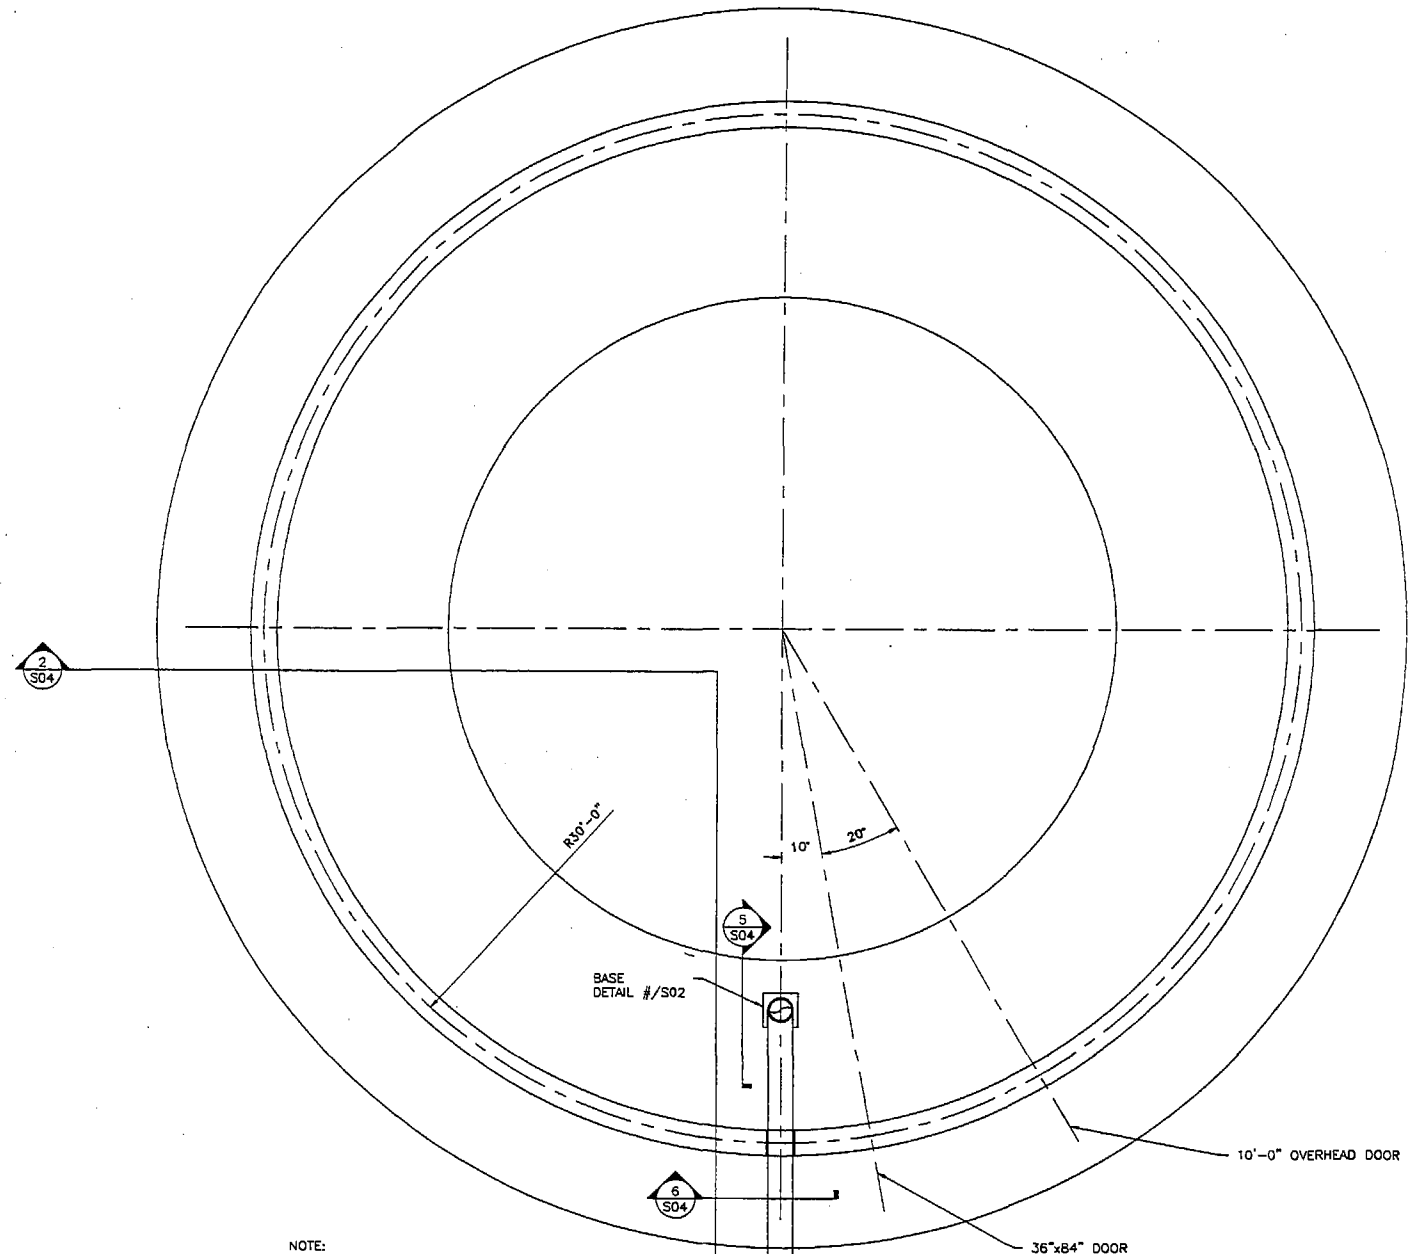


NOTE:
1. DIAMETER PER MANUFACTURER'S SPECIFICATIONS.


1 FOUNDATION PLAN
3/16" = 1'-0"

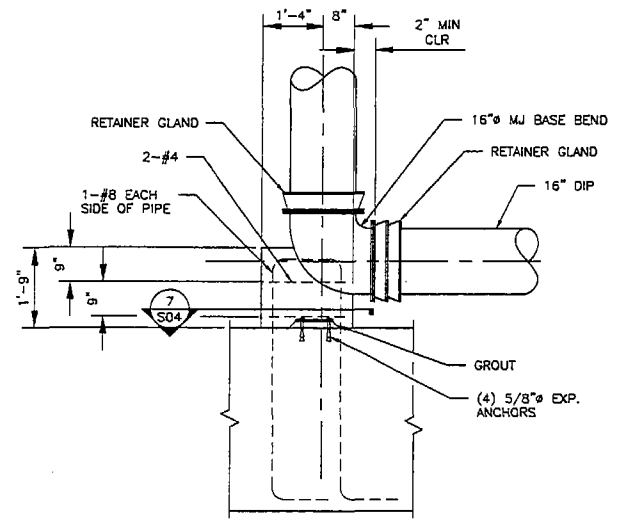


5 DETAIL
1/2" = 1'-0"

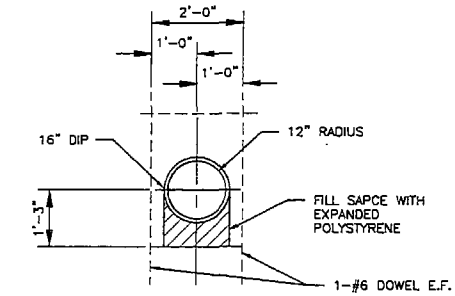


6 DETAIL
1/2" = 1'-0"

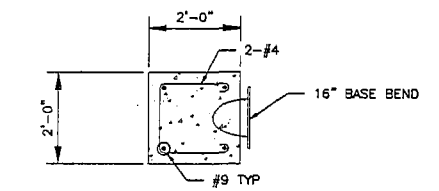


7 DETAIL
1/2" = 1'-0"

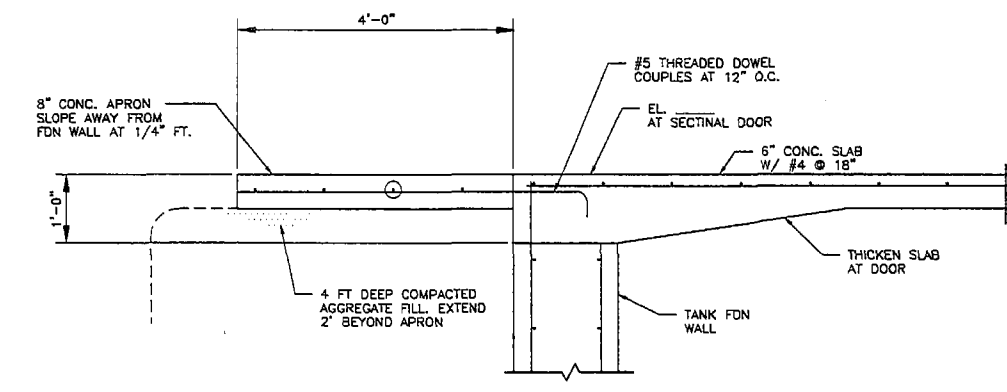

3 8" CONCRETE APRON FOR O.H. DOOR
3/4" = 1'-0"

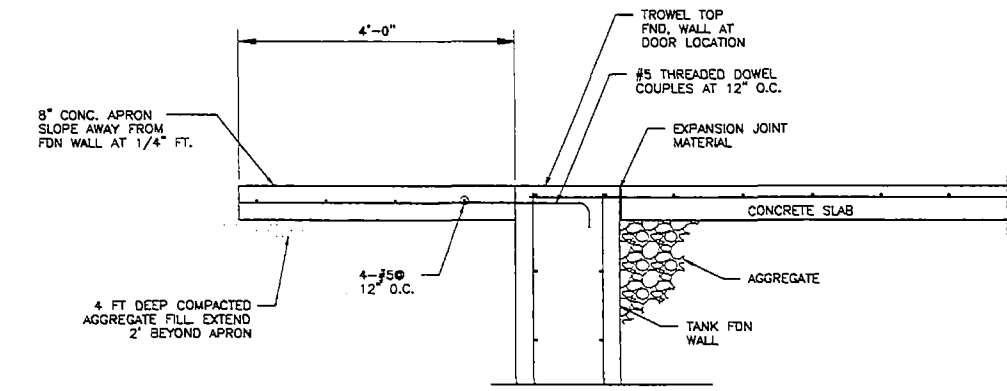


4 4" CONCRETE APRON FOR PED DOOR
3/4" = 1'-0"

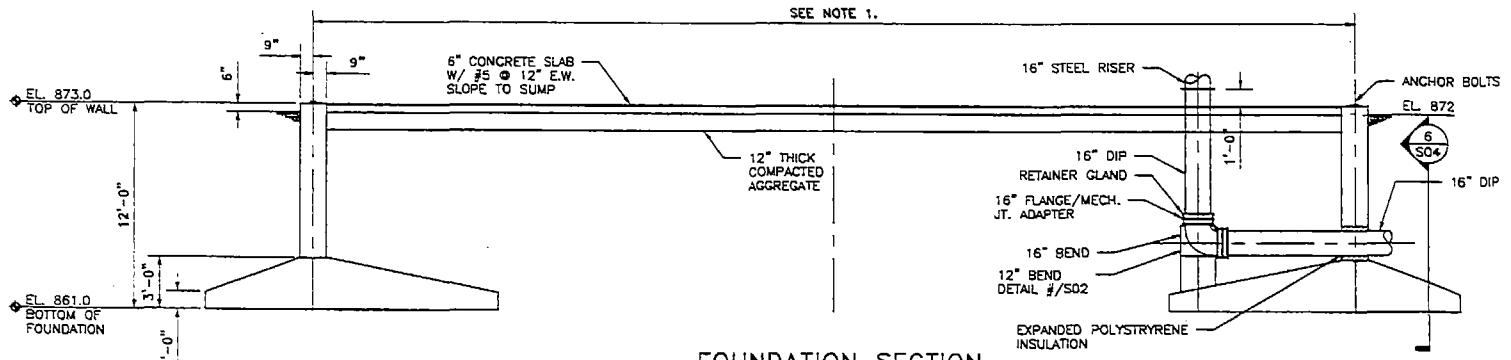


NOTE:
FOUNDATION DESIGN BY PITT-DESMOINES


2 FOUNDATION SECTION
3/16" = 1'-0"

758

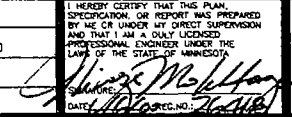
04/25/00	LMC	ORIGINAL ISSUE	PROJ. NO. 200502-2701	SCALE AS NOTED	DATE 4/25/00	I HEREBY CERTIFY THAT THIS PLAN, SPECIFICATION, OR REPORT WAS PREPARED BY ME OR UNDER MY DIRECT SUPERVISION AND THAT I AM A DULY LICENSED PROFESSIONAL ENGINEER UNDER THE LAWS OF THE STATE OF MINNESOTA.  AEC ENGINEERING Minneapolis, Minnesota Richmond, Virginia	DWG. FILE NAME: 200502\2701\M2701-S04 SHEET OF AEC PROJECT NO. 200502-2701 DRAWING NO. M2701-S04 REV 0
				DR. LMC	DATE 4/25/00		
				CK. LMC	DATE		
				APP. AS NOTED	DATE		

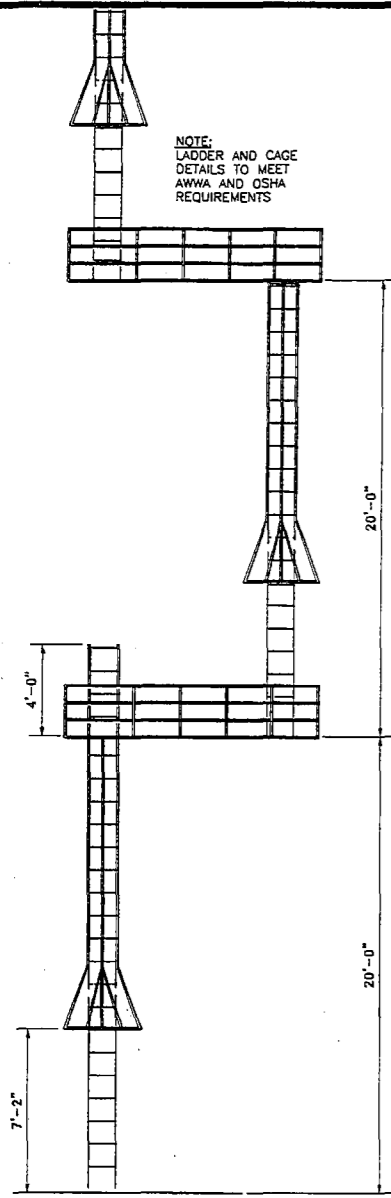


1
S05
LADDER AND CAGE
1/4" = 1'-0"

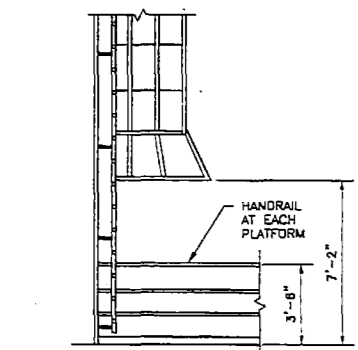


2
S05
CAGE DETAIL
1/4" = 1'-0"

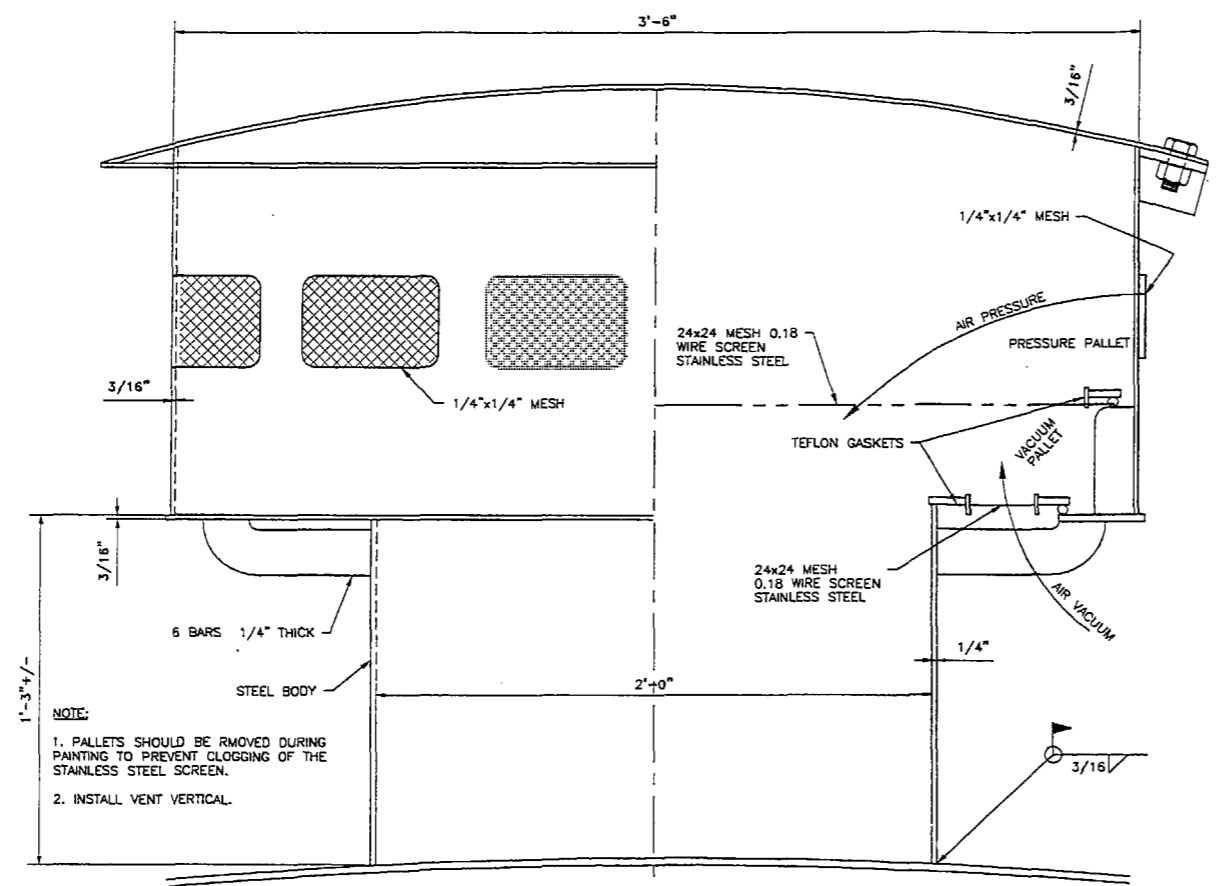



3
S05
VENT DETAIL
3" = 1'-0"

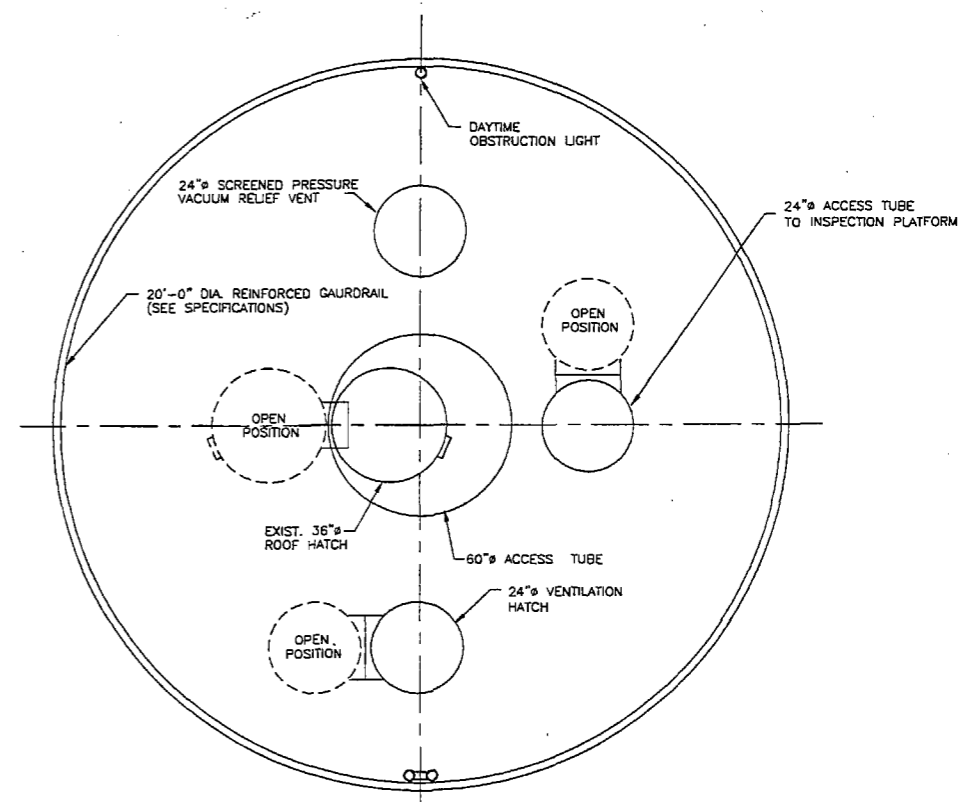

5
S05
PLAN @ ROOF
1/2" = 1'-0"
NORTH

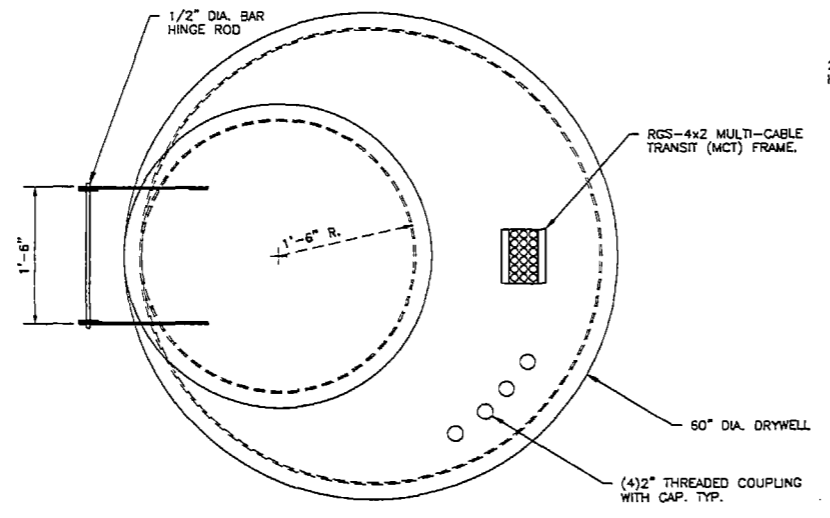





4
S05
ROOF HATCH DETAIL
1" = 1'-0"

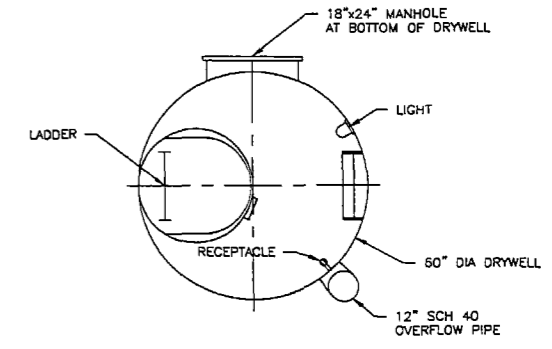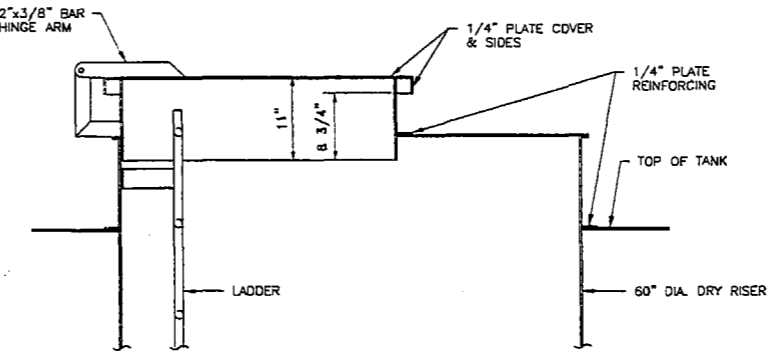

6
S05
DRY RISER SECTION
1/2" = 1'-0"

759

014/25/00	LMC	ORIGINAL ISSUE	PROJ. NO. 200502-2701	SCALE AS NOTED	DATE 4/25/00	I HEREBY CERTIFY THAT THIS PLAN, SPECIFICATION, OR REPORT WAS PREPARED BY ME OR UNDER MY DIRECT SUPERVISION AND THAT I AM A DULY LICENSED PROFESSIONAL ENGINEER UNDER THE LAWS OF THE STATE OF MINNESOTA. SIGNATURE: <i>[Signature]</i> DATE: 4/25/00	Minneapolis, Minnesota Richmond, Virginia	DETAILS, SECTIONS & ELEVATIONS CITY OF RAMSEY 1.5 MILLION GALLON WATER TOWER	CADD FILE NAME DWG\RAMSEY\200502\2701\M2701-S05	
				DR. LMC	DATE 4/25/00				SHEET OF	AEC PROJECT NO. 200502-2701
				CK. LMC	DATE				DRAWING NO. M2701-S05	REV 0
				APP. AS NOTED	DATE					

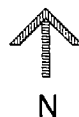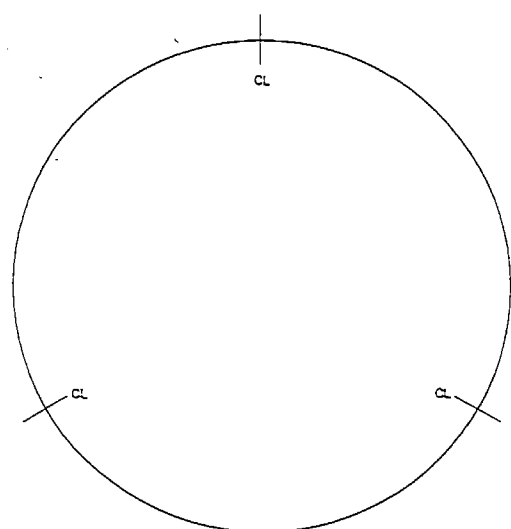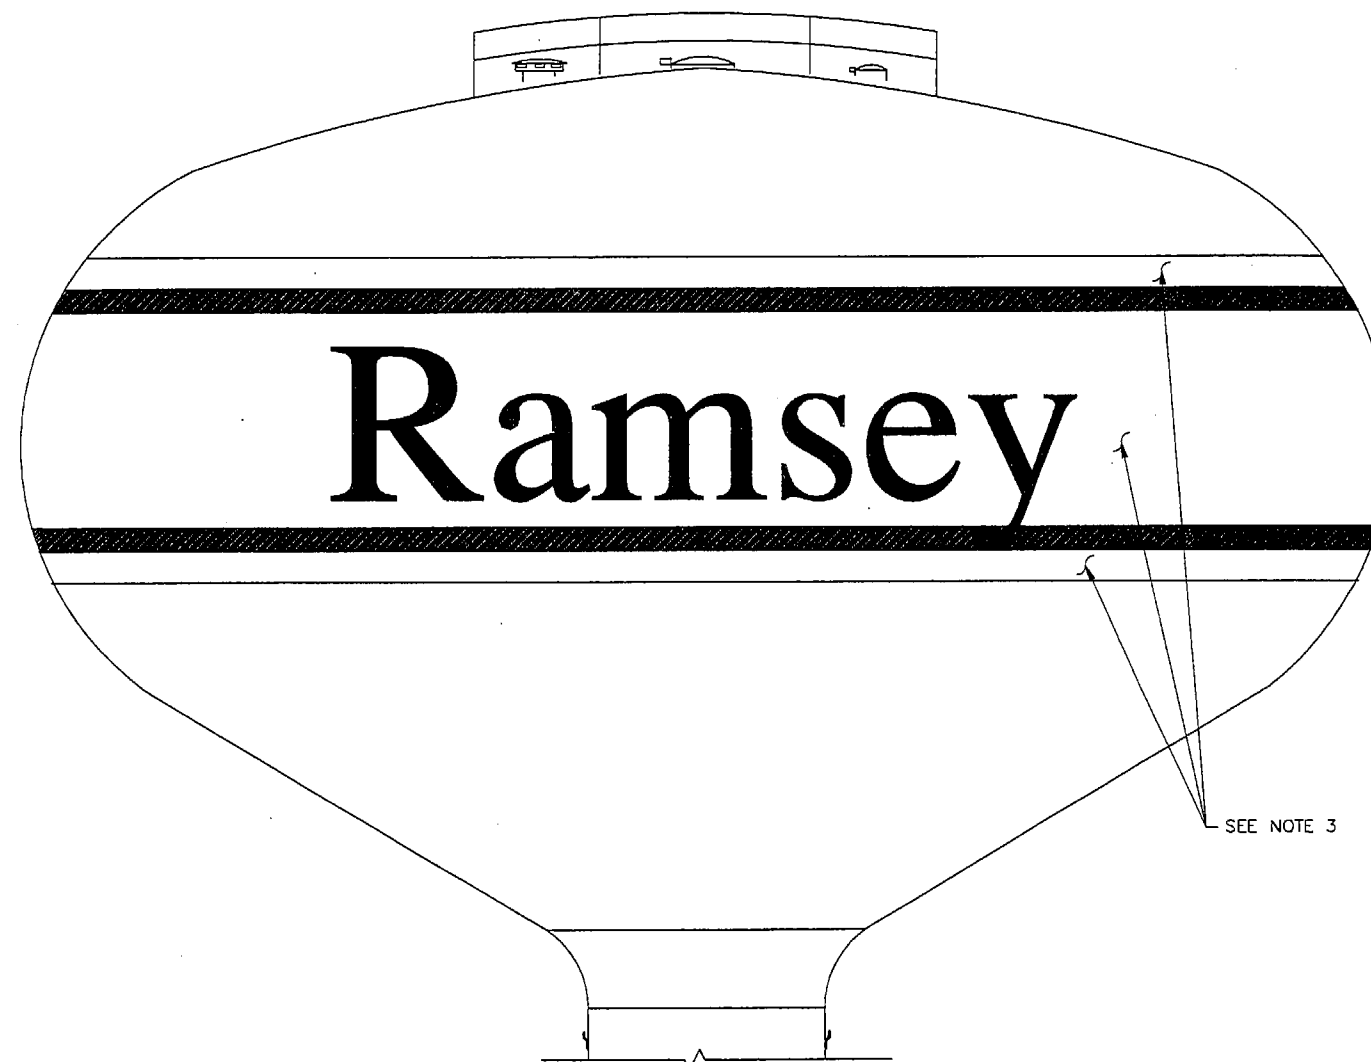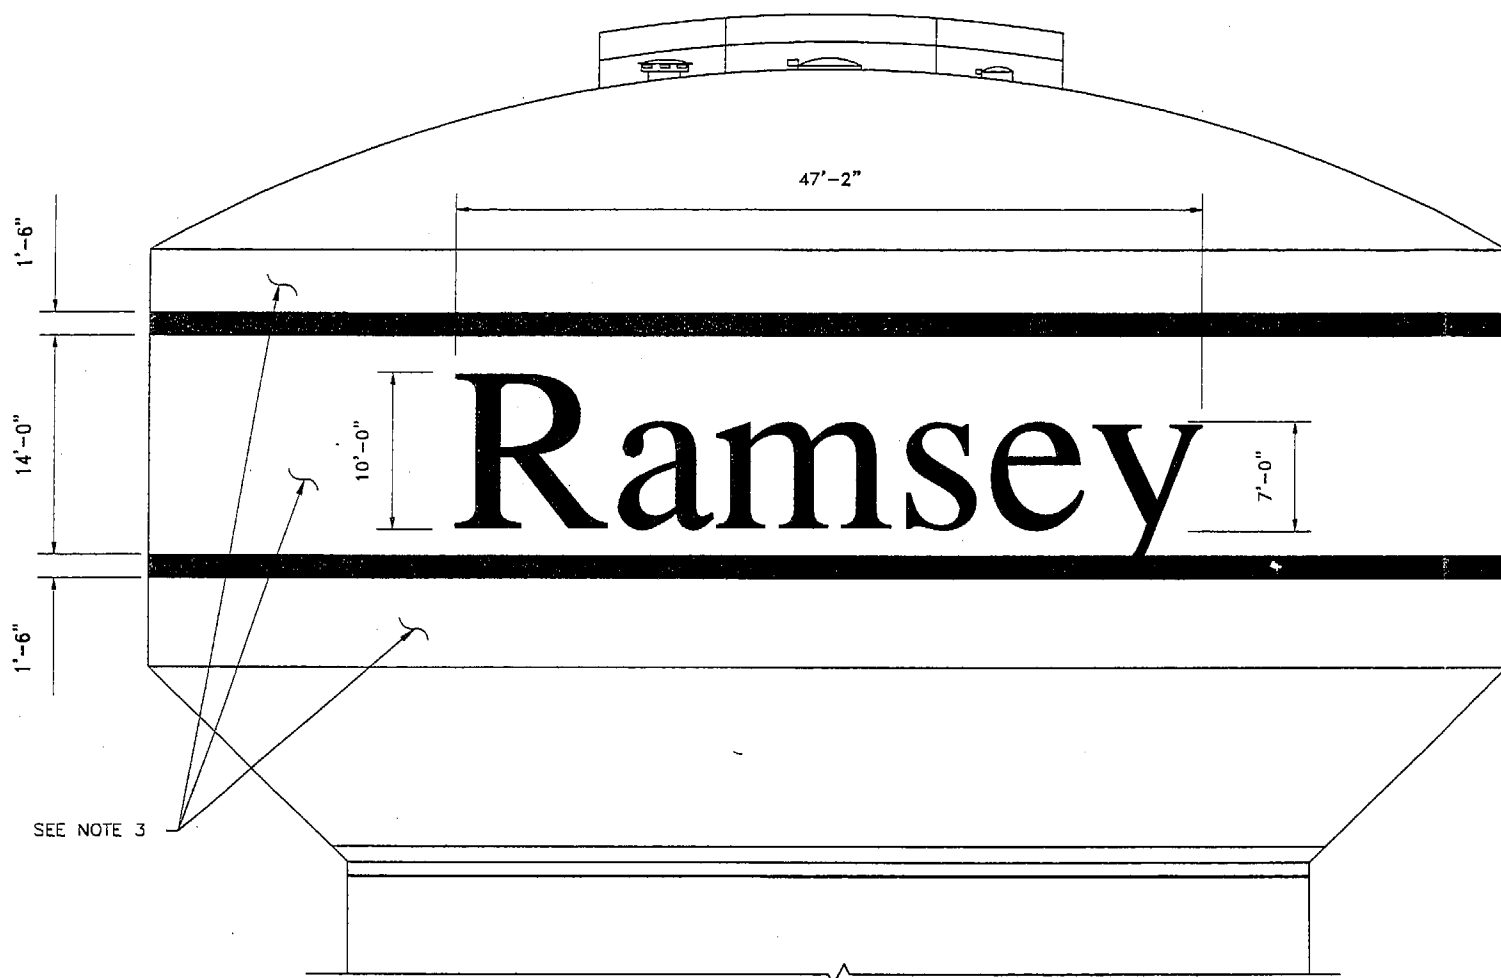

NOTES:

1. EXTERIOR COLOR OF WATER TOWER, MATCH TNEMEC SERIES 73 "TANK WHITE" WHO 2.
2. LETTERING AND STRIP COLOR SHALL MATCH TNEMEC SERIES 73 "TANK WHITE" WHO 2.
3. BAND COLOR TO MATCH TNEMEC SERIES 73 "ULTRA BLUE" PL12.
4. LETTERING TO BE IN 3 LOCATIONS AS DIRECTED BY THE ENGINEER.

760

04/25/00	LMC	ORIGINAL ISSUE	PROJ. NO. 200502-2701

THIS DRAWING IS THE PROPERTY OF AEC ENGINEERING AND TO BE USED ONLY IN CONNECTION WITH WORK PERFORMED BY AEC ENGINEERING.
THIS DRAWING IS NOT TO BE COPIED IN WHOLE OR IN PART AND MUST BE RETURNED UPON REQUEST.



SCALE	AS NOTED
DR:	LMC
DATE	4/25/00
CK:	
DATE	
APP:	
DATE	
	AS NOTED

I HEREBY CERTIFY THAT THIS PLAN, SPECIFICATION OR REPORT WAS PREPARED BY ME OR UNDER MY DIRECT SUPERVISION AND THAT I AM A DULY LICENSED PROFESSIONAL ENGINEER UNDER THE LAWS OF THE STATE OF MINNESOTA.
DATE: 4/25/00 REG. NO. 10112



TANK LOGO
CITY OF RAMSEY
1.5 MILLION GALLON
WATER TOWER

CADD FILE NAME	DWG\RAMSEY\200502\2701\M2701-S06
SHEET	OF AEC PROJECT NO. 200502-2701
DRAWING NO.	M2701-S06
REV	0

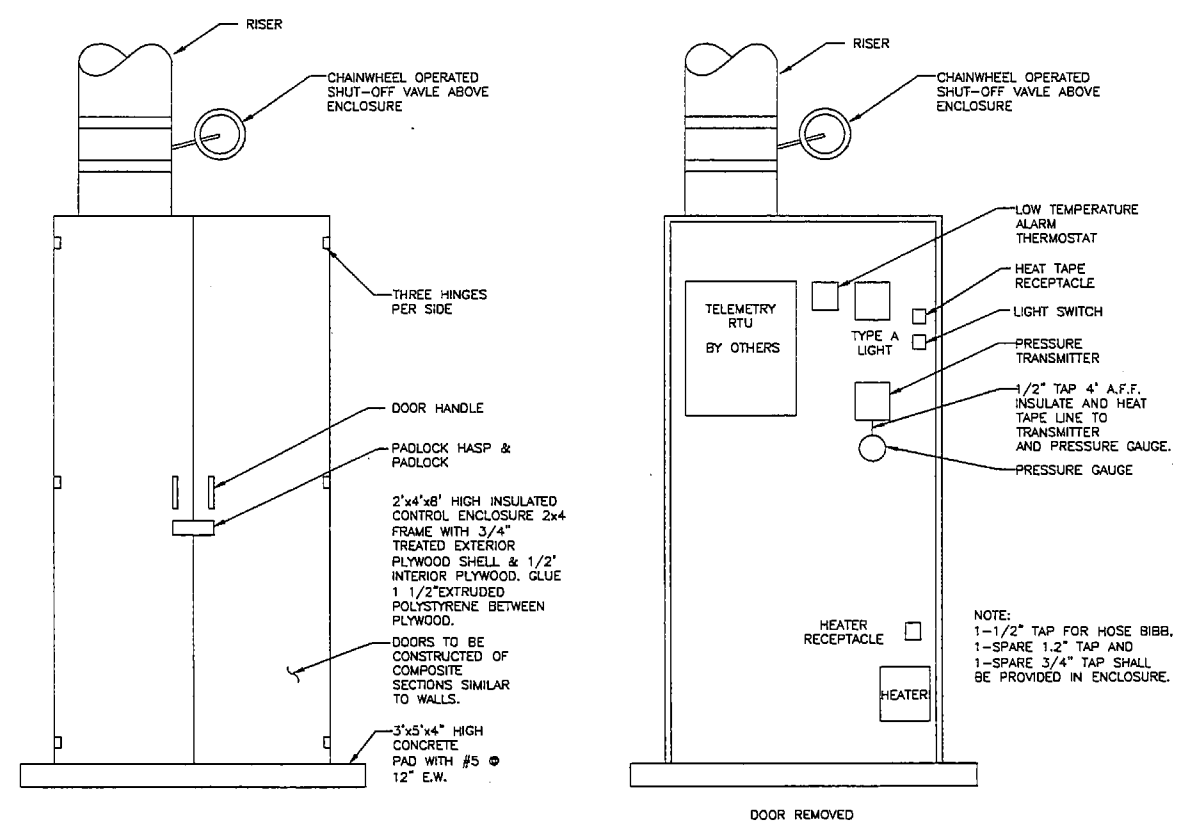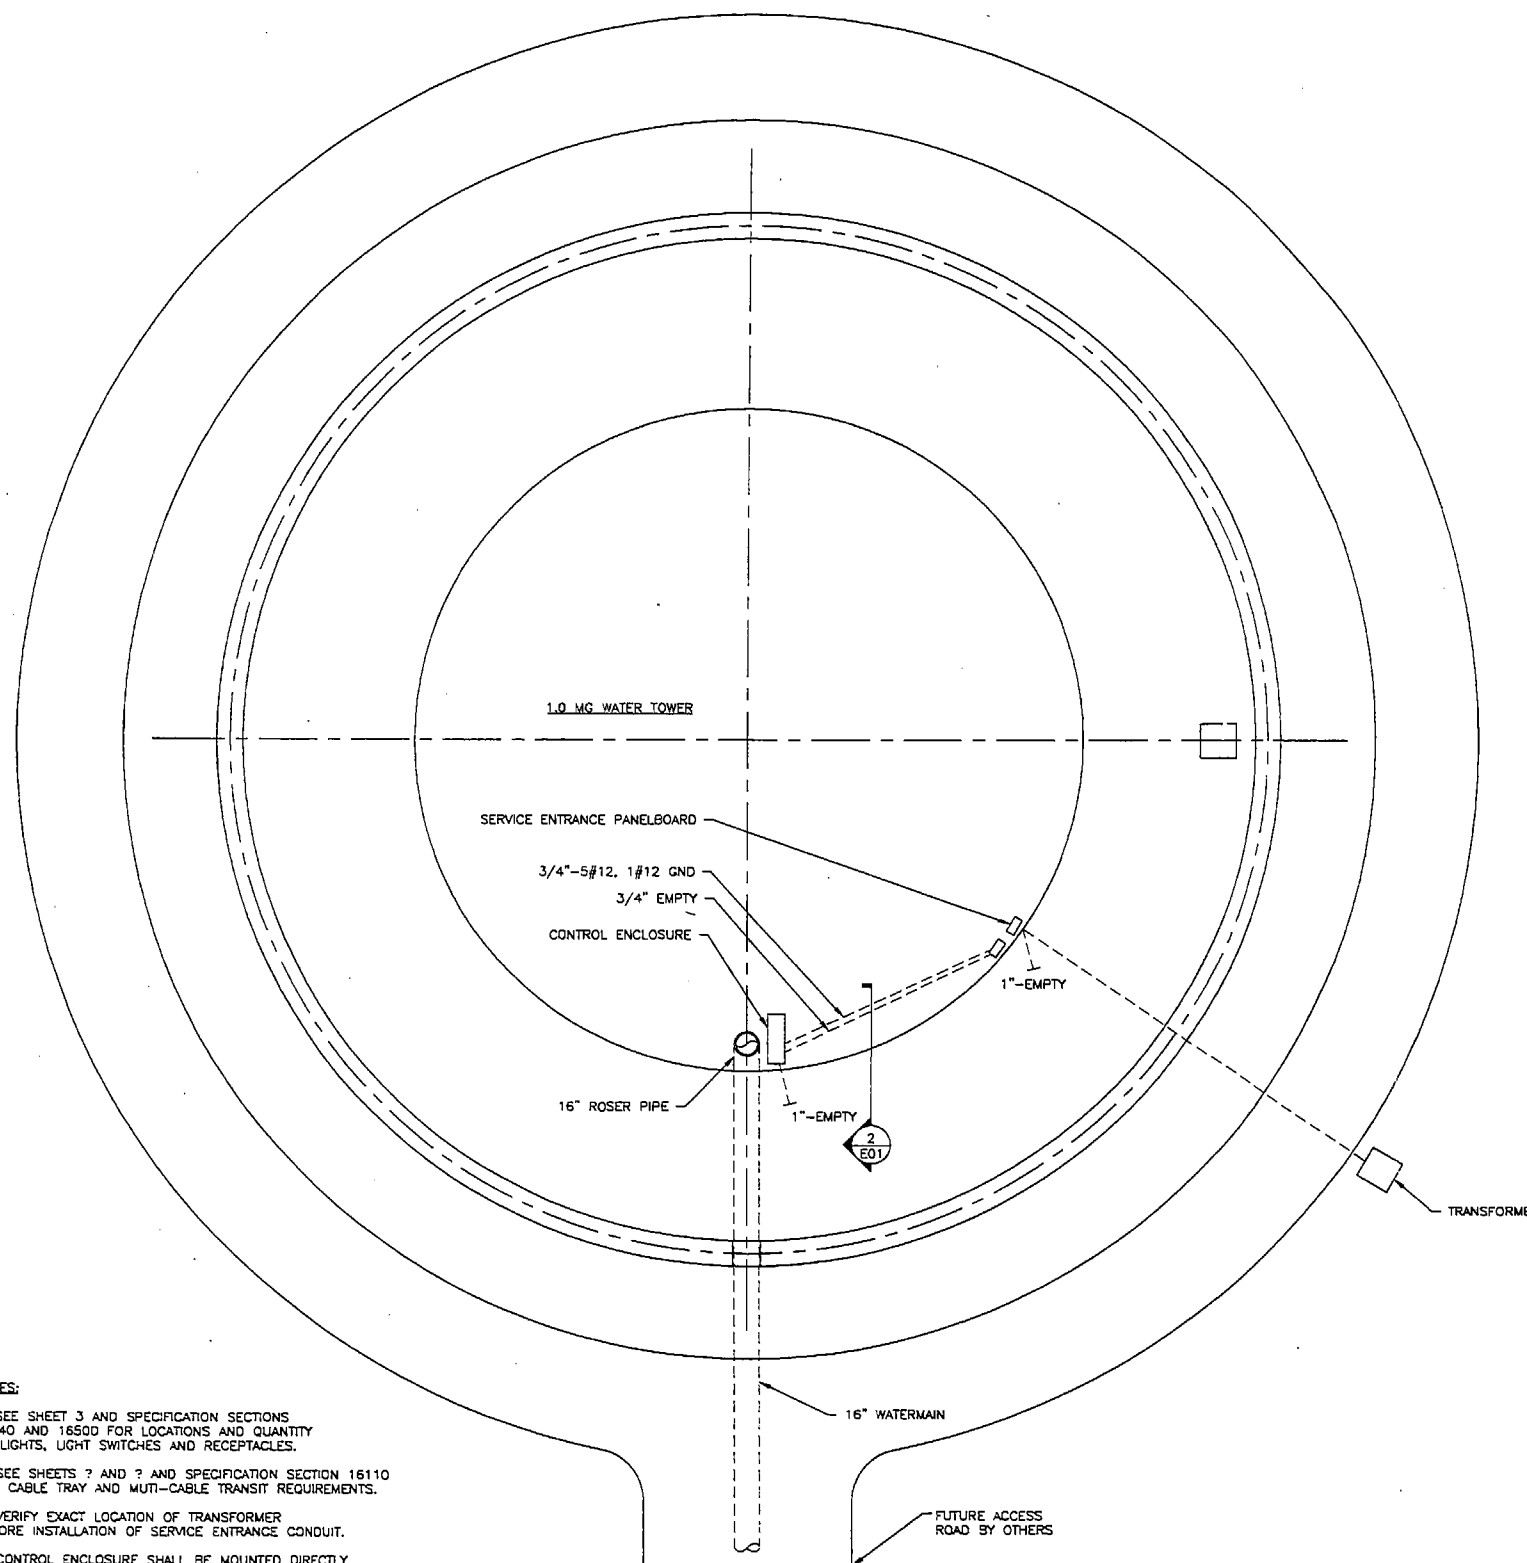


2
E01
CONTROL ENCLOSURE
3/4" = 1'-0"

- NOTES:**
- SEE SHEET 3 AND SPECIFICATION SECTIONS 16140 AND 16500 FOR LOCATIONS AND QUANTITY OF LIGHTS, LIGHT SWITCHES AND RECEPTACLES.
 - SEE SHEETS 7 AND 8 AND SPECIFICATION SECTION 16110 FOR CABLE TRAY AND MULTI-CABLE TRANSIT REQUIREMENTS.
 - VERIFY EXACT LOCATION OF TRANSFORMER BEFORE INSTALLATION OF SERVICE ENTRANCE CONDUIT.
 - CONTROL ENCLOSURE SHALL BE MOUNTED DIRECTLY ADJACENT TO THE RISER. RISER LOCATION WILL VARY DEPENDING ON WHICH TOWER STYLE IS SELECTED.
 - COORDINATE LOCATION AND INSTALLATION OF CONTROL ENCLOSURE SECURITY SYSTEM DOOR CONTACTS, SECURITY SYSTEM KEY SWITCH, AND BASIS ANTENNAE WITH SUPERVISORY CONTROL SYSTEM SUPPLIER.



1
E01
ELECTRICAL PLAN
3/16" = 1'-0"

761

04/25/00	LMC ORIGINAL ISSUE	PROJ. NO. 200502-2701	THIS DRAWING IS THE PROPERTY OF AEC ENGINEERING AND TO BE USED ONLY IN CONNECTION WITH WORK PERFORMED BY AEC ENGINEERING.	SCALE AS NOTED	DATE 4/25/00	I HEREBY CERTIFY THAT THIS PLAN, SPECIFICATION OR REPORT WAS PREPARED BY ME OR UNDER MY DIRECT SUPERVISION AND THAT I AM A FULLY LICENSED PROFESSIONAL ENGINEER UNDER THE LAWS OF THE STATE OF MINNESOTA. DATE 4/25/00	 Minneapolis, Minnesota Richmond, Virginia AEC ENGINEERING	ELECTRICAL DETAILS CITY OF RAMSEY 1.5 MILLION GALLON WATER TOWER	CADD FILE NAME DWG: RAMSEY\200502\2701\M2701-E01
			THE DRAWING IS NOT TO BE COPIED IN WHOLE OR IN PART AND MUST BE RETURNED UPON REQUEST.	DR. LMC CK. LMC APP. AS NOTED	DATE 4/25/00 DATE				SHEET OF AEC PROJECT NO. 200502-2701 DRAWING NO. M2701-E01 REV 0

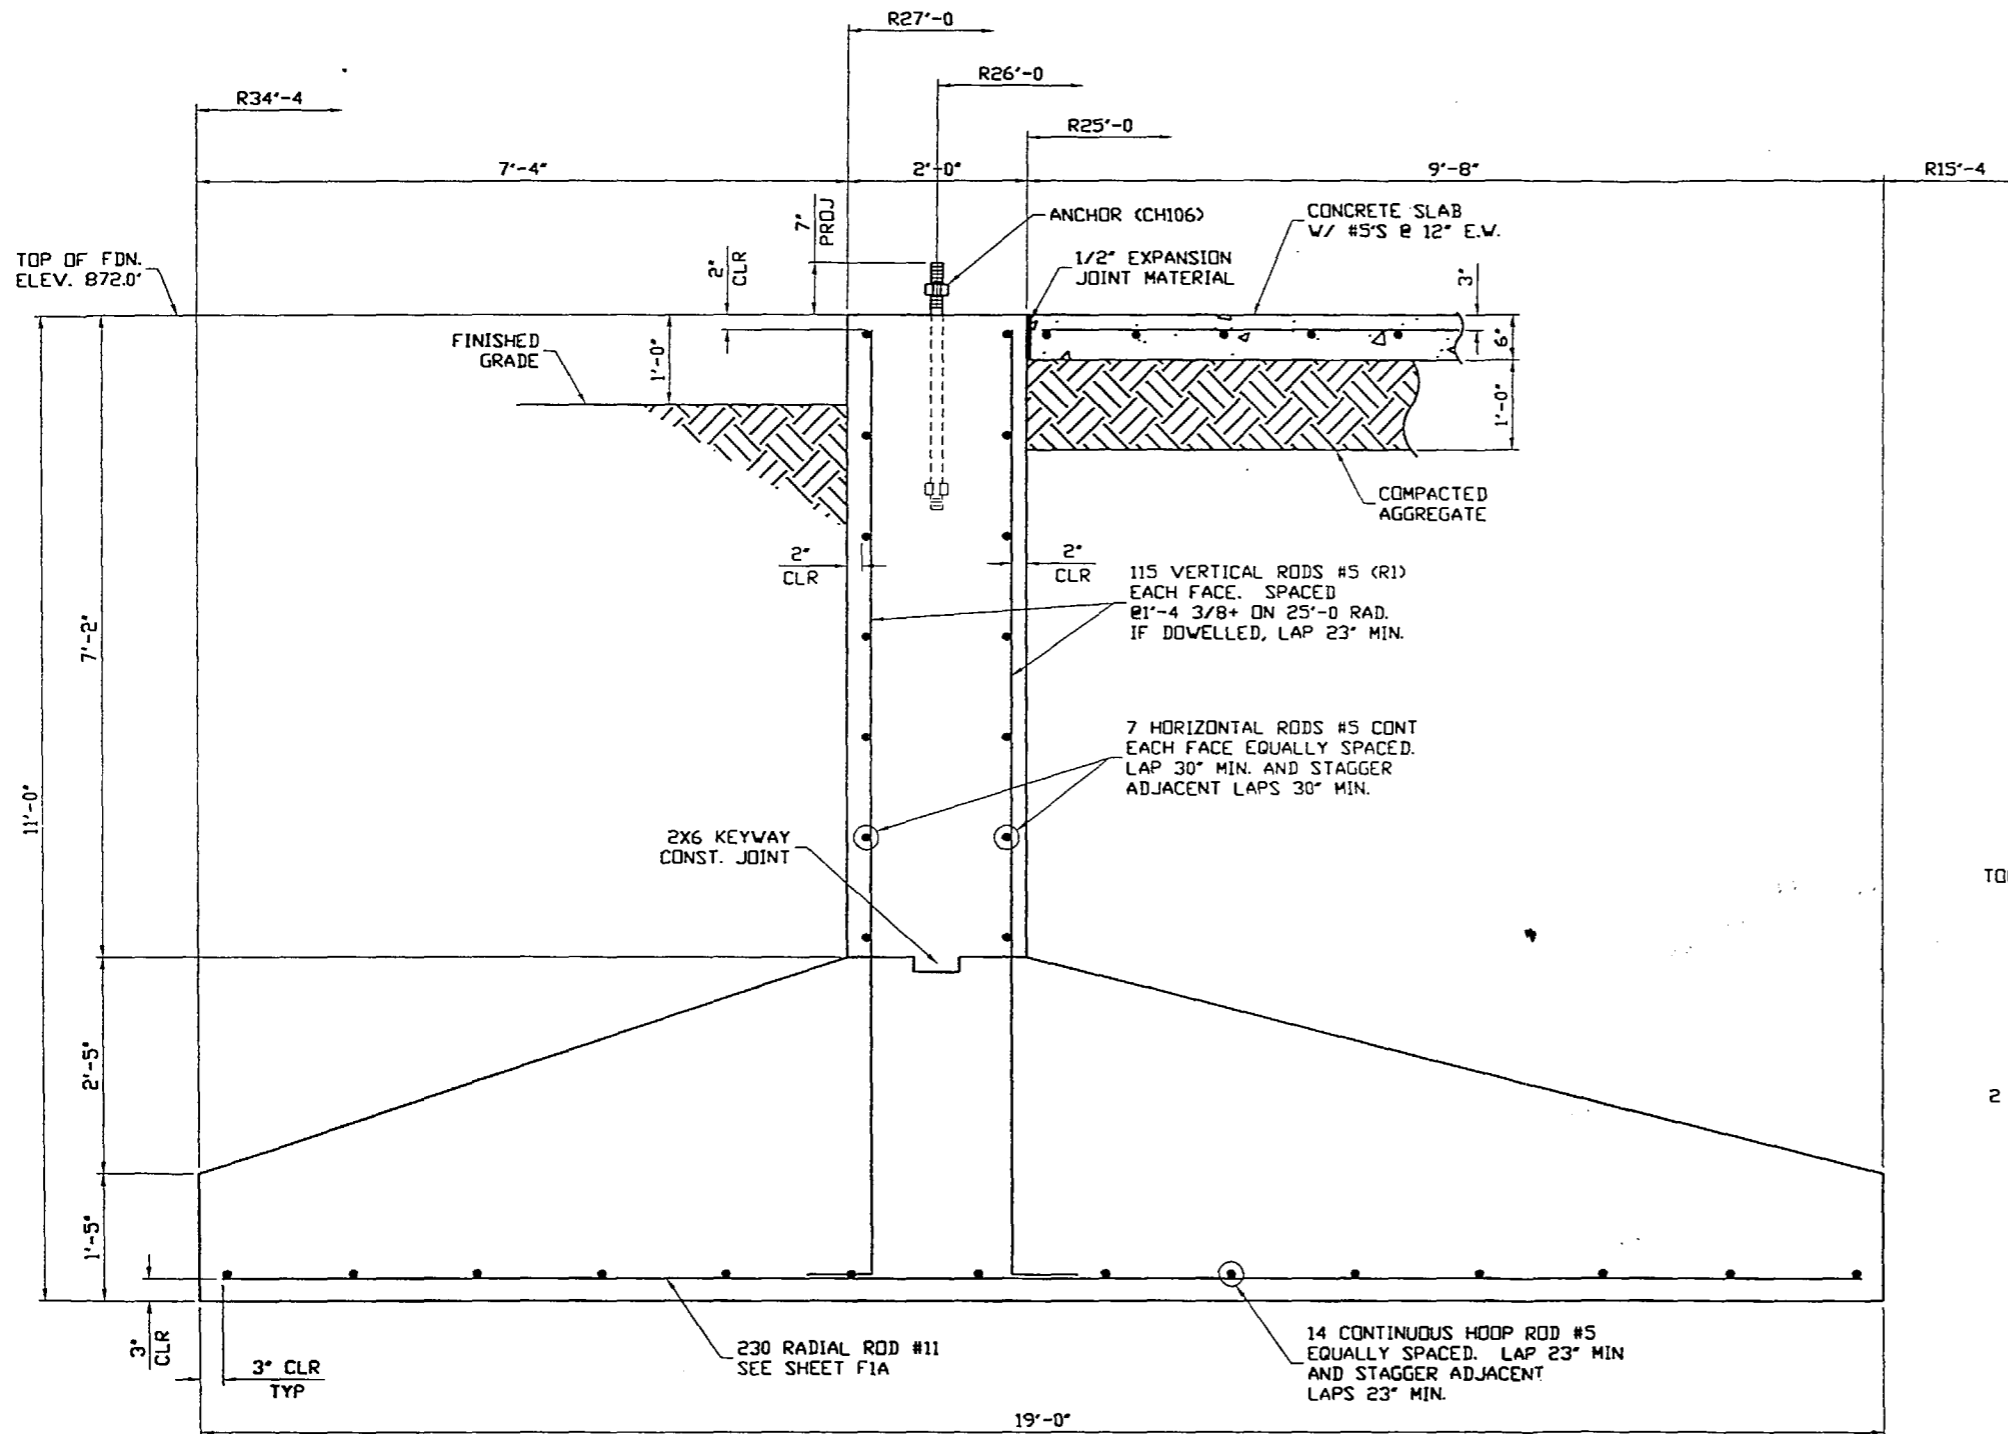

SECTION A-A

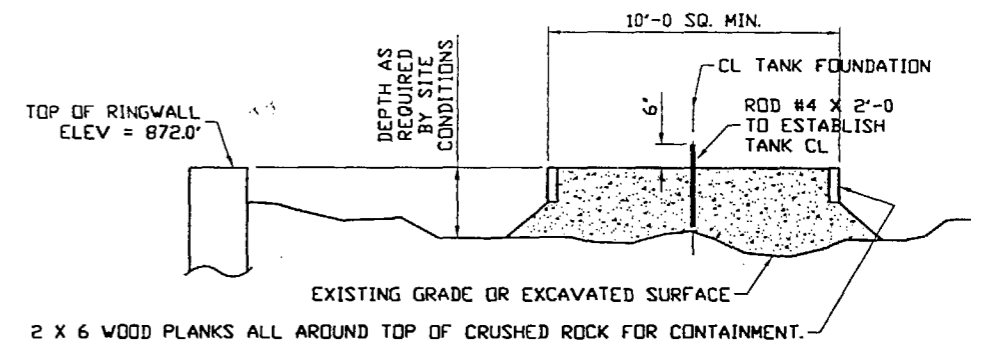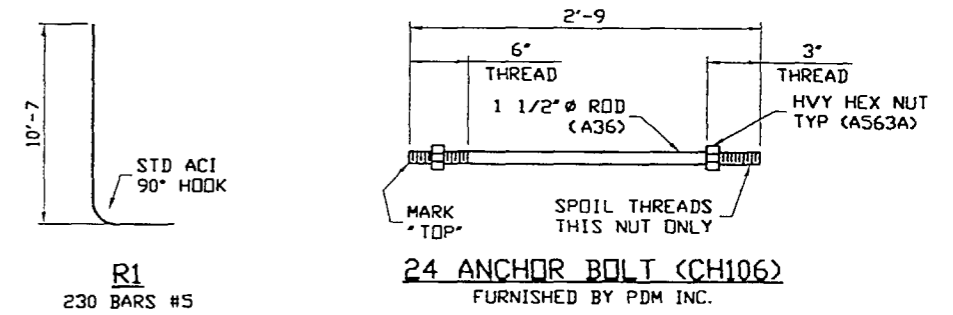

SECTION D-D

NOTE:

1. SUPPORT BASE TO BE 3/4 INCH CRUSHED ROAD ROCK.
2. PLACE ROCK IN MAXIMUM 18" LIFTS.
3. COMPACT EACH LIFT WITH VIBRATOR, BACKHOE, TRUCK WHEEL LOADS, ETC. TO MINIMIZE FUTURE CONSOLIDATION.
4. ACTUAL DEPTH OF SUPPORT BASE WILL DEPEND ON SITE TOPOGRAPHY AND CONSTRUCTION PROCEDURES.
5. MINIMUM DEPTH OF SUPPORT BASE TO BE 6".
6. STRIKE TOP OF SUPPORT BASE LEVEL WITH TOP OF TOWER FOUNDATION. THE BEARING SURFACE SHALL BE LEVEL TO 1/4" ACROSS 10'-0" WIDTH.

I hereby certify that this plan, specification or report was prepared by me or under my direct personal supervision and that I am a duly registered Professional Engineer under the laws of the State of Minnesota.

Dennis B. Guessford, P.E.






Date 5/2/00 Reg. No. 10299

OPEN HOLES N/A							
ERECTION REF. N/A							
WELD SPECS. AWWA D100-96							
EIS-							
CERTIFIED FOR CONFORMANCE TO PLANS AND SPECIFICATIONS							
BY: <i>[Signature]</i>							
DATE: 7/26/00	NO	REVISION DESCRIPTION	BY	DATE	CHK	DATE	





PITT-DES MOINES, INC. ENGINEERS - FABRICATORS - CONTRACTORS			
CITY OF RAMSEY			
1500 MG HP 90" DIA X 40' HR X 52' TWR			
RAMSEY, MN			
FOUNDATION DETAILS			
DWG. PREPARED AT:	CLIVE	FABRICATED AT:	CLIVE
BY:	DATE	DRAWING:	F1B
DRAWN: SEG	21JUL00	CHECKED:	JMS
CHECKED: JMS	25JUL00	CONTRACT:	50557

762

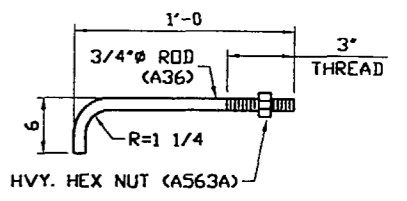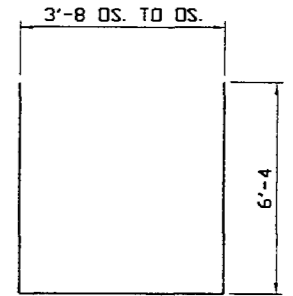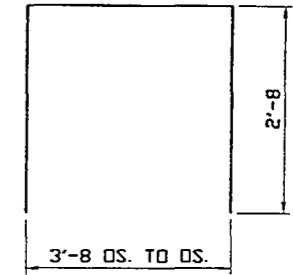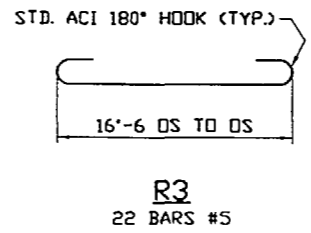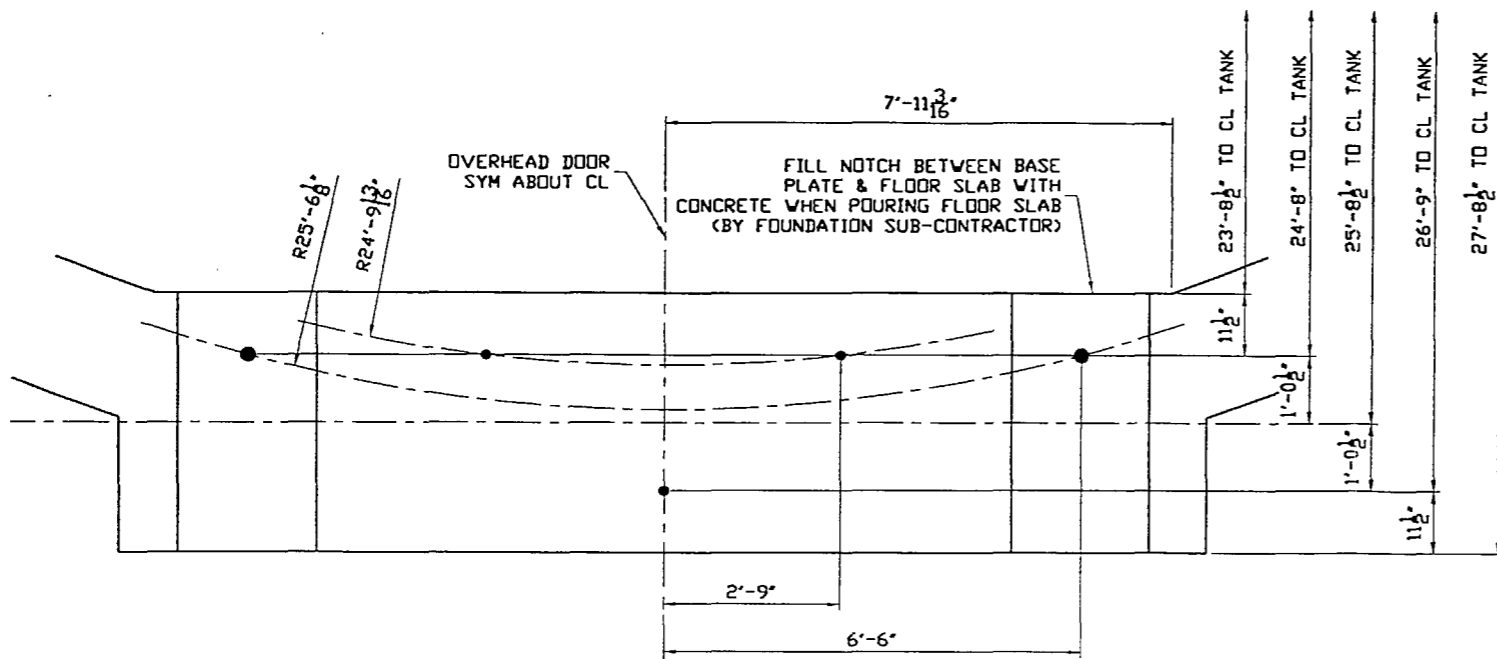

3 ANCHOR (CH100)
FURNISHED BY PDM INC.

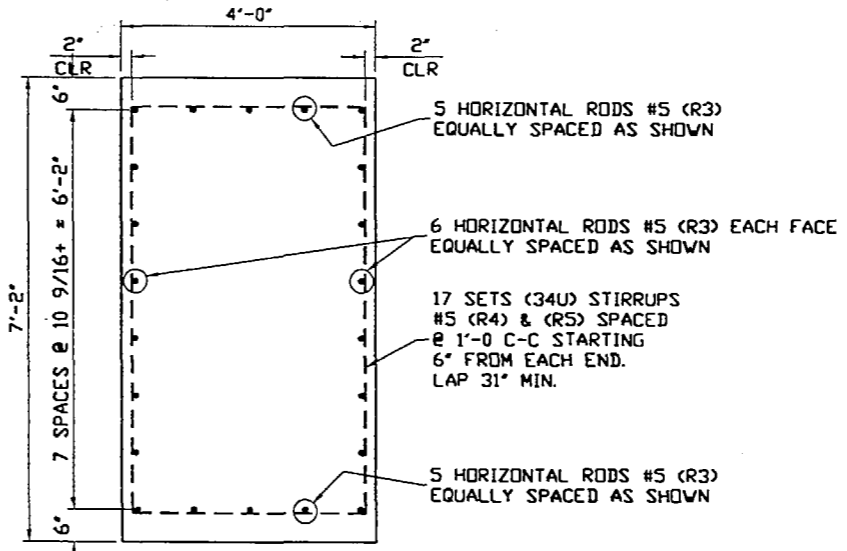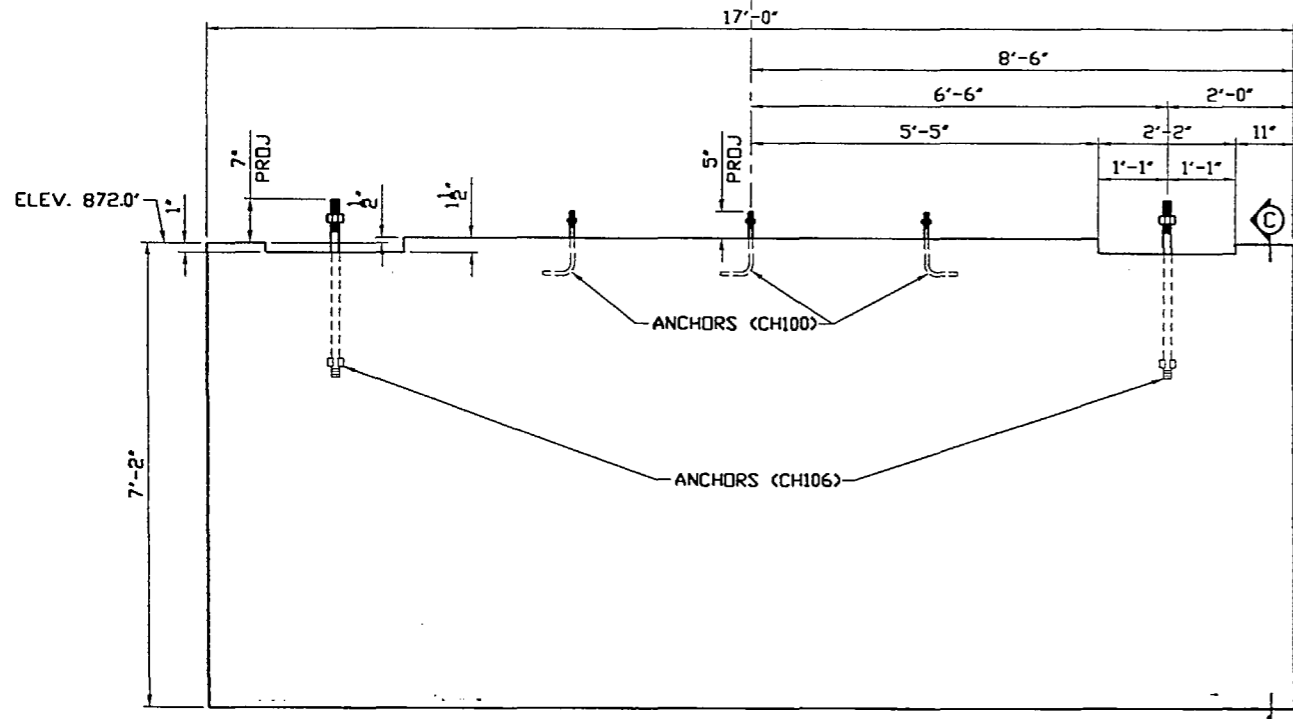

NOTE:
CONTINUE RINGWALL REINFORCING
(NOT SHOWN) THRU OVERHEAD DOOR
FOUNDATION

SECTION C-C

VIEW B-B


I hereby certify that this plan, specification or report was prepared by me or under my direct personal supervision and that I am a duly registered Professional Engineer under the laws of the State of Minnesota.
Dennis B. Guessford
Dennis B. Guessford, P.E.
Date 8/2/00 Reg. No. 10279

OPEN HOLES	N/A						
ERECTION REF.	N/A						
WELD SPECS.	AWWA D100-96						
EIS							
CERTIFIED FOR CONFORMANCE TO PLANS AND SPECIFICATIONS							
BY:	<i>Dennis B. Guessford</i>						
DATE:	<u>7/26/00</u>						
NO	REVISION DESCRIPTION	BY	DATE	CHK	DATE		




PITT-DES MOINES, INC. ENGINEERS - FABRICATORS - CONTRACTORS			
CITY OF RAMSEY			
1500 MG HP 90' DIA X 40' HR X 52' TWR			
RAMSEY, MN			
DOOR BEAM DETAILS			
DWG. PREPARED AT:	CLIVE	FABRICATED AT:	CLIVE
BY:	DATE	DRAWING:	F1C
DRAWN: SEG	21 JUL 00	CHECKED:	JMS
DATE:	25 JUL 00	CONTRACT:	50557


763

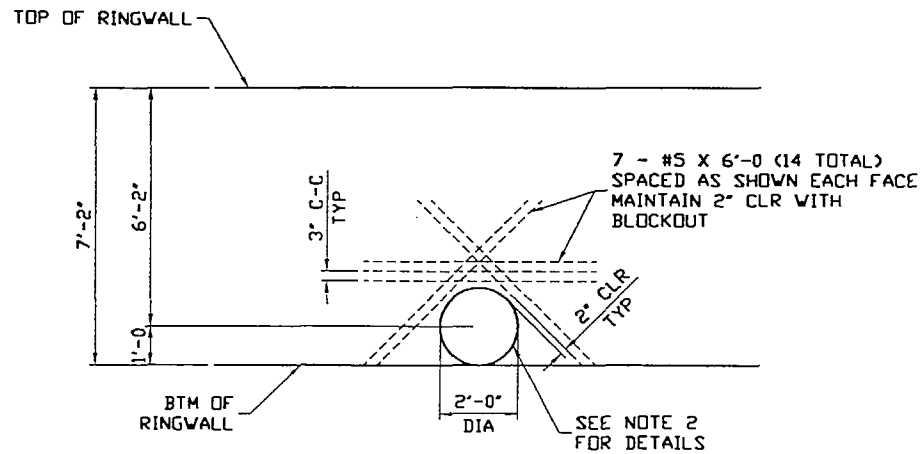

SECTION G-G
PIPE NOT SHOWN

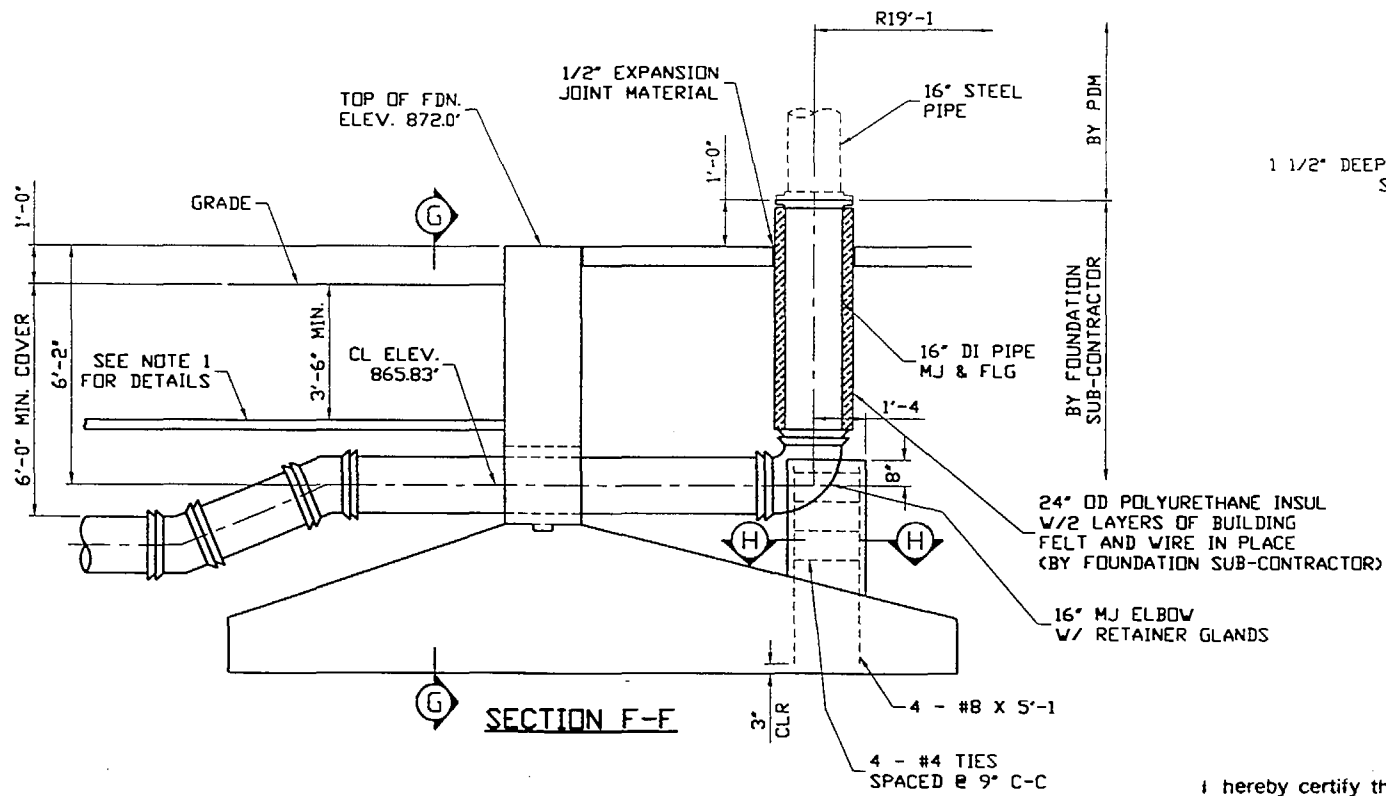

SECTION F-F


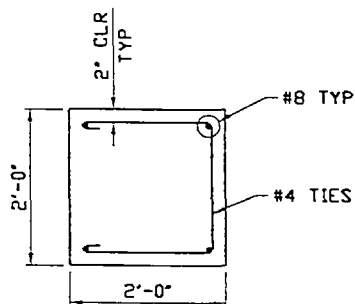


SECTION H-H

NOTES:

1. PROVIDE 3" THICK X 6'-0" WIDE DOW STYROFOAM (OR EQUIVALENT) SLAB INSULATION OVER 16" DIA. INLET/OUTLET PIPING TO A DISTANCE WHERE 6'-0" PIPE COVER IS ATTAINED. INSTALL SLAB INSULATION PER MANUFACTURER'S RECOMMENDATIONS
2. INTERRUPT MAXIMUM OF 4 - #5 VERTICAL BARS AND 4 - #5 HORIZONTAL BARS. TRIM INTERRUPTED BARS FOR 2" CLEARANCE WITH PIPE BLOCKOUT. FILL VOID BETWEEN PIPE AND PIPE BLOCKOUT WITH EXPANDED POLYSTYRENE INSULATION.

AEC COMMENT

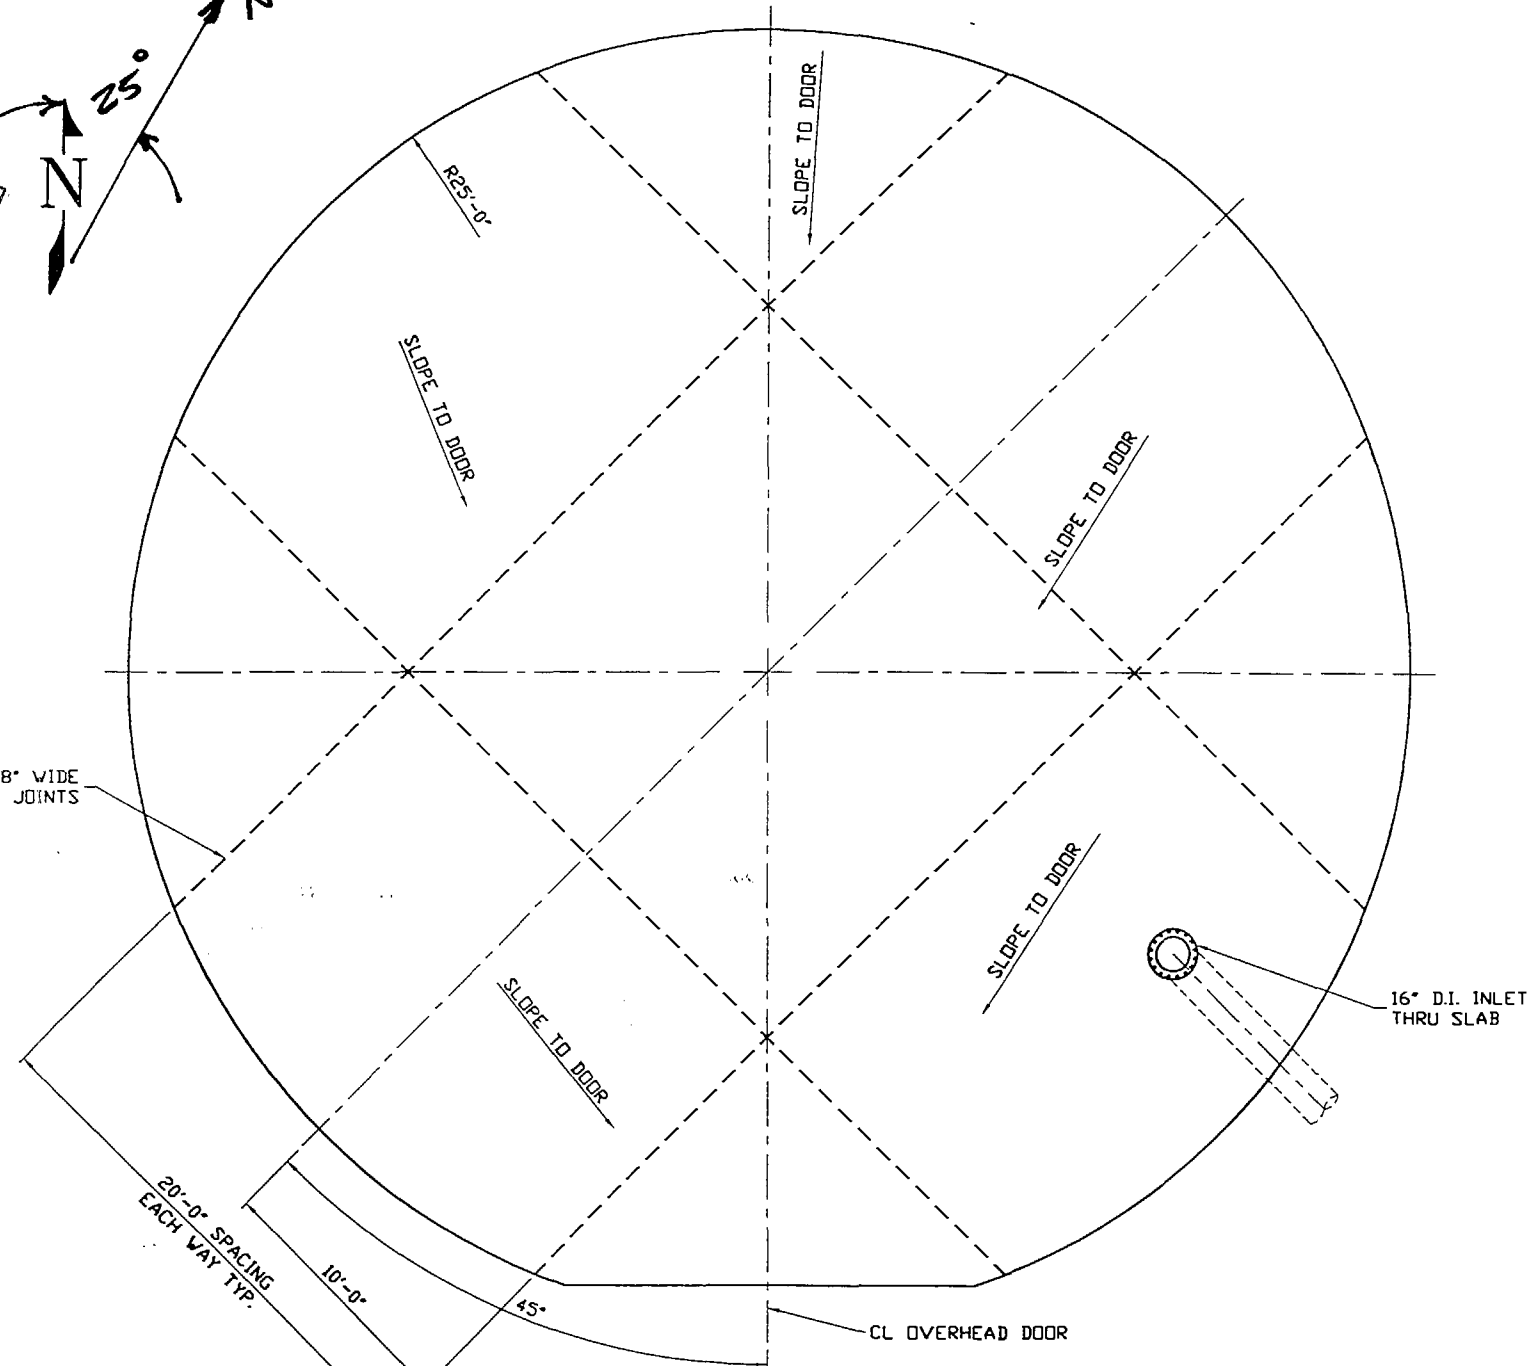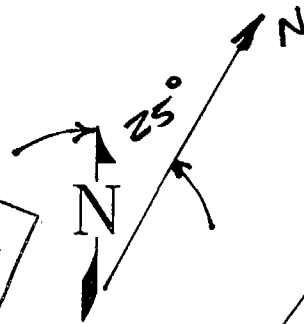

FLOOR SLAB

I hereby certify that this plan, specification or report was prepared by me or under my direct personal supervision and that I am a duly registered Professional Engineer under the laws of the State of Minnesota.

Dennis B. Guessford
Dennis B. Guessford, P.E.
Date 8/2/00 Reg. No. 10279

OPEN HOLES	N/A						
ERECTION REF.	N/A						
WELD SPECS.	AWWA D100-96						
EIS-							
CERTIFIED FOR CONFORMANCE TO PLANS AND SPECIFICATIONS							
BY: <i>Gregg A. Schmidt</i>							
DATE: <u>8/2/00</u>							
NO	REVISION DESCRIPTION	BY	DATE	CHK	DATE		



PITT-DES MOINES, INC. ENGINEERS - FABRICATORS - CONTRACTORS			
CITY OF RAMSEY			
1500 MG HP 90" DIA X 40' HR X 52' TWR			
RAMSEY, MN			
PIPING DETAILS & SLAB PLAN			
DWG. PREPARED AT: CLIVE		FABRICATED AT: CLIVE	
BY: SEG	DATE: 25JUL00	DRAWING: F1D	
CHECKED: JMS	DATE: 25JUL00	CONTRACT: 50557	

764

FOUNDATION NOTES

- DO NOT SCALE THIS DRAWING.
- SUBSTANTIAL LOCATION AND ELEVATION MARKERS SHALL BE SET BY OWNER OR HIS REPRESENTATIVE.
- CHECK DIMENSIONS. IF ANY DIMENSIONS DO NOT CHECK, DO NOT PROCEED UNTIL THEY ARE VERIFIED OR CORRECTED.
- ALL CONCRETE WORK AND DETAILS NOT SHOWN ARE TO BE IN ACCORDANCE WITH PROJECT PLANS AND SPECIFICATIONS AND ACI 301.
- ALL CONCRETE WORK SHALL BE PLACED WITHOUT CONSTRUCTION JOINTS EXCEPT WHERE SHOWN.
- ALL CONCRETE SHALL ATTAIN A MINIMUM COMPRESSIVE STRENGTH OF 4000 PSI AT 28 DAYS. MAXIMUM AGGREGATE SIZE TO BE 3/4". REFER TO PROJECT SPECIFICATIONS FOR ADDITIONAL REQUIREMENTS.
- REINFORCING BARS SHALL CONFORM TO ASTM A615 DEFORMED GRADE 60. WELDED WIRE FABRIC SHALL CONFORM TO ASTM A185.
- THESE FOUNDATIONS ARE DESIGNED FOR BEARING ON SOIL HAVING A NET ALLOWABLE BEARING CAPACITY OF 5000 PSF AND 7500 PSF WITH WIND. REFER TO PROJECT PLANS AND SPECIFICATIONS AND GEOTECHNICAL REPORT. IF EXPOSED BEARING SURFACE DOES NOT CONFORM TO THE ABOVE REQUIREMENTS, NOTIFY PITT-DES MOINES, INC BEFORE PROCEEDING.
- CHAMFER ALL EXPOSED EDGES 1".
- THE TOP OF THE RINGWALL IS TO BE FINISHED SMOOTH AND LEVEL. NO POINT IN THE CIRCUMFERENCE OF THE WALL SHALL VARY MORE THAN ± 1/4" FROM THE ESTABLISHED ELEVATION. PLAN DIMENSIONS OF CONCRETE FOUNDATIONS SHALL NOT VARY MORE THAN ± 1/2".
- SECURE ANCHORS TO PREVENT MOVEMENT WHILE POURING CONCRETE.
- ANCHOR TOLERANCE ± 3/16" FROM TRUE LOCATION IN PLAN AND ± 1/8" IN VERTICAL PLUMB FOR PROJECTION ABOVE TOP OF FOUNDATION.
- WHEN FOUNDATIONS ARE COMPLETE, PUT TWO ANCHOR BOLT NUTS ON ALTERNATE ANCHOR BOLTS AND TIGHTEN THEM TOGETHER SO THAT THEY CANNOT BE REMOVED BY HAND. CAUTION DO NOT EXERT ANY FORCE OR PRESSURE ON THE CONCRETE.
- FOUNDATION SUB-CONTRACTOR TO MARK NORTH-SOUTH AND EAST-WEST CENTERLINES ON TOP OUTSIDE EDGE OF RINGWALL WITH WATERPROOF MARKER.
- COMPACT BACKFILL AND GRADE SITE TO CONTRACT SPECIFICATIONS.

**ANCHOR LAYOUT TABLE
R26'-0"**

ANCHOR #	DIM "A"
WP "A" TO 1	3'-4 13/16"
TO 2	10'-1 3/4"
TO 3	16'-8 9/16"
TO 4	23'-0"
TO 5	28'-10 11/16"
TO 6	31'-5 5/16"
TO 7	40'-9 5/8"
TO 18	39'-1 1/8"
TO 19	34'-3 7/16"
TO 20	28'-10 11/16"
TO 21	23'-0"
TO 22	16'-8 9/16"
TO 23	10'-1 3/4"
TO 24	3'-4 13/16"

**ANCHOR LAYOUT TABLE
R26'-0"**

ANCHOR #	DIM "B"
WP "B" TO 6	40'-9 5/8"
TO 7	31'-5 5/16"
TO 8	28'-10 11/16"
TO 9	23'-1 1/4"
TO 10	16'-8 9/16"
TO 11	10'-1 3/4"
TO 12	3'-4 13/16"
TO 13	3'-4 13/16"
TO 14	10'-1 3/4"
TO 15	16'-8 9/16"
TO 16	23'-0"
TO 17	28'-10 11/16"
TO 18	34'-3 7/16"
TO 19	39'-1 1/8"

FOUNDATION DESIGN LOADS

H20	13,081,346#
S.L. (40PSF)	259,441#
D.L.	977,600#
W.S. (100MPH)	182,282#
W.M.	17,038,626#


CONCRETE QUANTITIES

RINGWALL & DOOR BEAM	96 CY
SPREAD FOOTING	304 CY

NOTE: THE ABOVE QUANTITIES DO NOT INCLUDE MISCELLANEOUS CONCRETE ITEMS SUCH AS SLABS, VAULTS, SPLASH PADS, THRUST BLOCKS, ETC.

765

AEC COMMENT

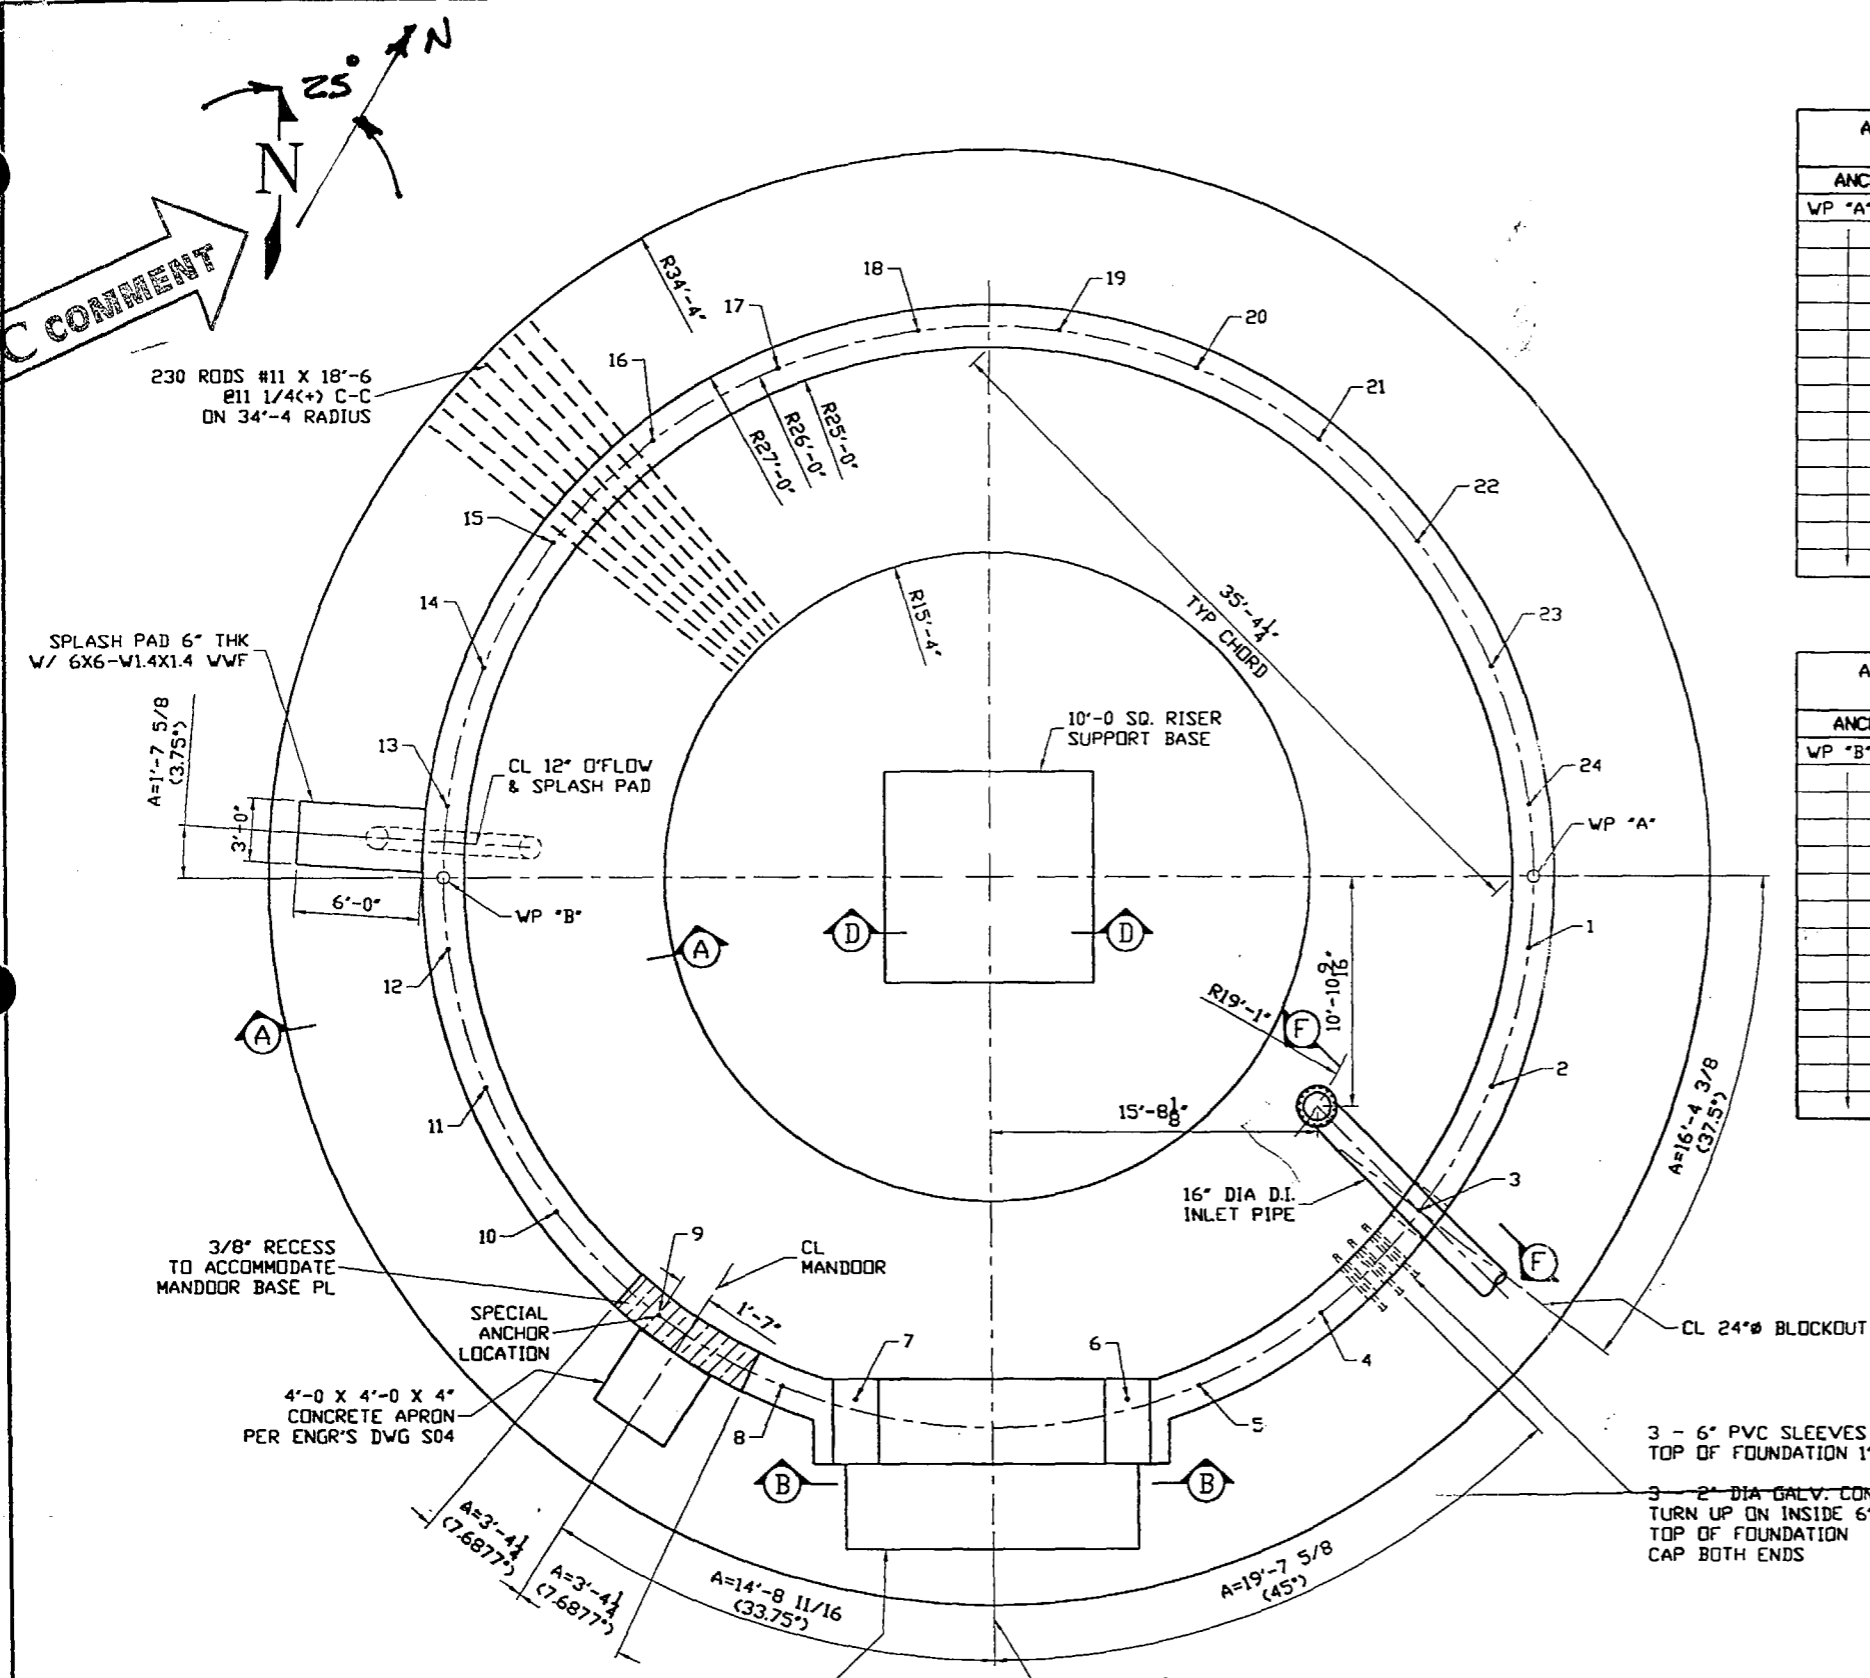

FOUNDATION PLAN
ARCS ON 25'-0 RAD U.N.

I hereby certify that this plan, specification or detail was prepared by me or under my direct personal supervision and that I am a duly registered Professional Engineer under the laws of the State of Minnesota.

Dennis B. Guessford
Dennis B. Guessford, P.E.
Date: 8/2/00 Reg. No. 10279

OPEN HOLES	N/A				
ERECTION REF.	N/A				
WELD SPECS.	AWWA D100-96				
EIS	-				
CERTIFIED FOR CONFORMANCE TO PLANS AND SPECIFICATIONS	BY: <i>[Signature]</i>				
DATE	7/26/00				
NO	REVISION DESCRIPTION	BY	DATE	CHK	DATE



PITT-DES MOINES, INC.
ENGINEERS - FABRICATORS - CONTRACTORS

CITY OF RAMSEY
1500 MG HP 90" DIA X 40" HR X 52" TWR
RAMSEY, MN
FOUNDATION PLAN

DWG. PREPARED AT: CLIVE FABRICATED AT: CLIVE

BY: SEG DATE: 24 JUL 00 DRAWING: F1A
CHECKED: JMS DATE: 25 JUL 00 CONTRACT: 50557


PDM
Pitt-Des Moines, Inc.

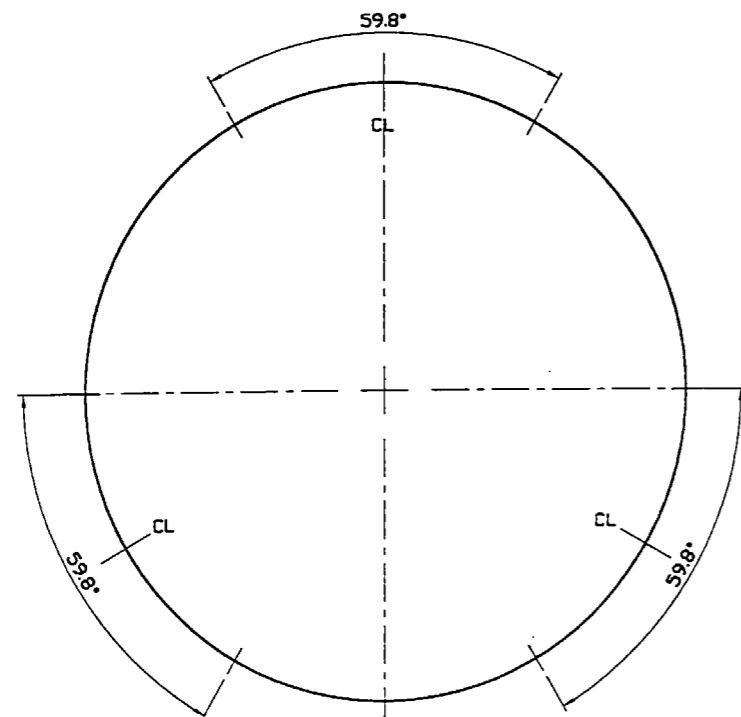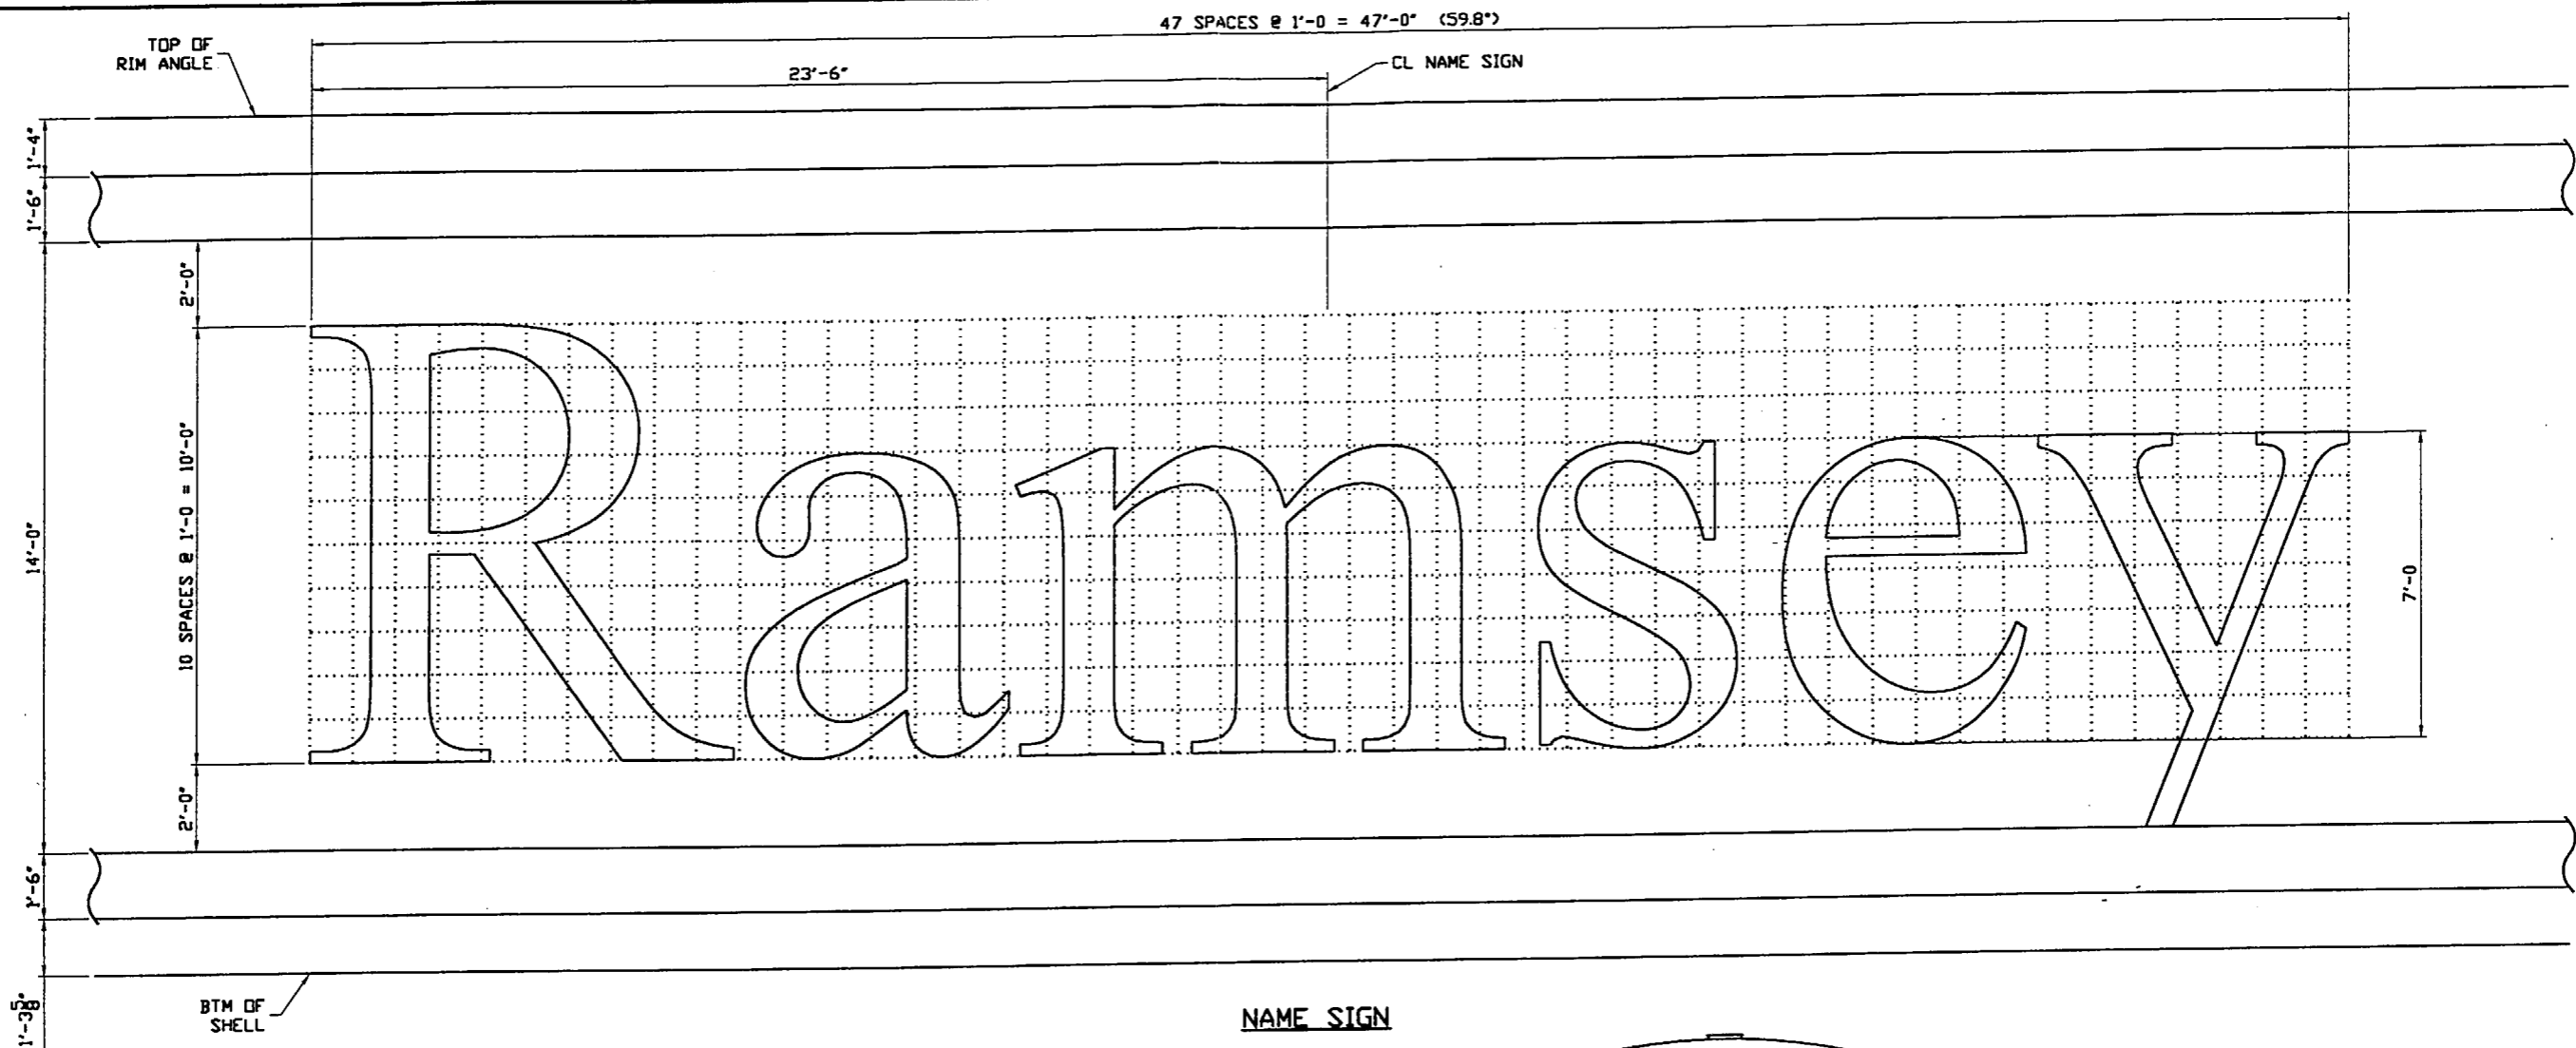

ORIENTATION
LOCATE NAME SIGNS @ 120° C-C

NAME SIGN

NOTE:
COLOR OF NAME SIGN
& STRIPES TO BE SELECTED
BY OWNER.

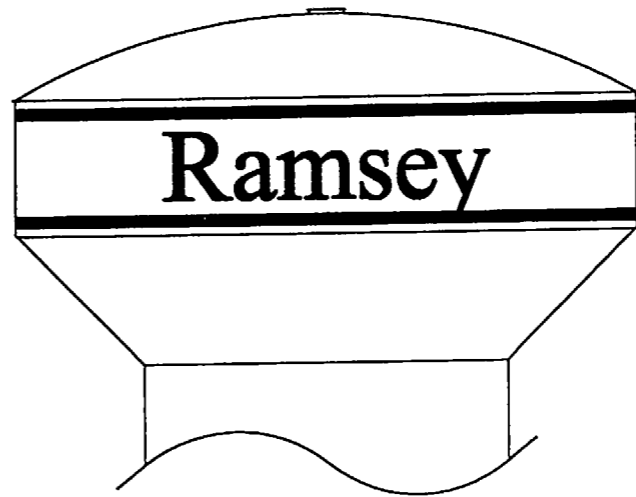

ELEVATION



766

OPEN HOLES	N/A
ERECTION REF.	N/A
WELD SPECS.	AWWA D100-96
EIS	N/A

NO	REVISION DESCRIPTION	BY	DATE	CHK	DATE



PITT-DES MOINES, INC. ENGINEERS - FABRICATORS - CONTRACTORS			
CITY OF RAMSEY			
1500 MG HP 90' DIA X 40' HR X 52' TWR			
RAMSEY, MN			
NAME SIGN			
DWG. PREPARED AT:	CLIVE	FABRICATED AT:	CLIVE
BY	DATE	DRAWING:	P2
DRAWN: SEG	18AUG00	CHECKED:	JMS
21AUG00	CONTRACT:	50557	

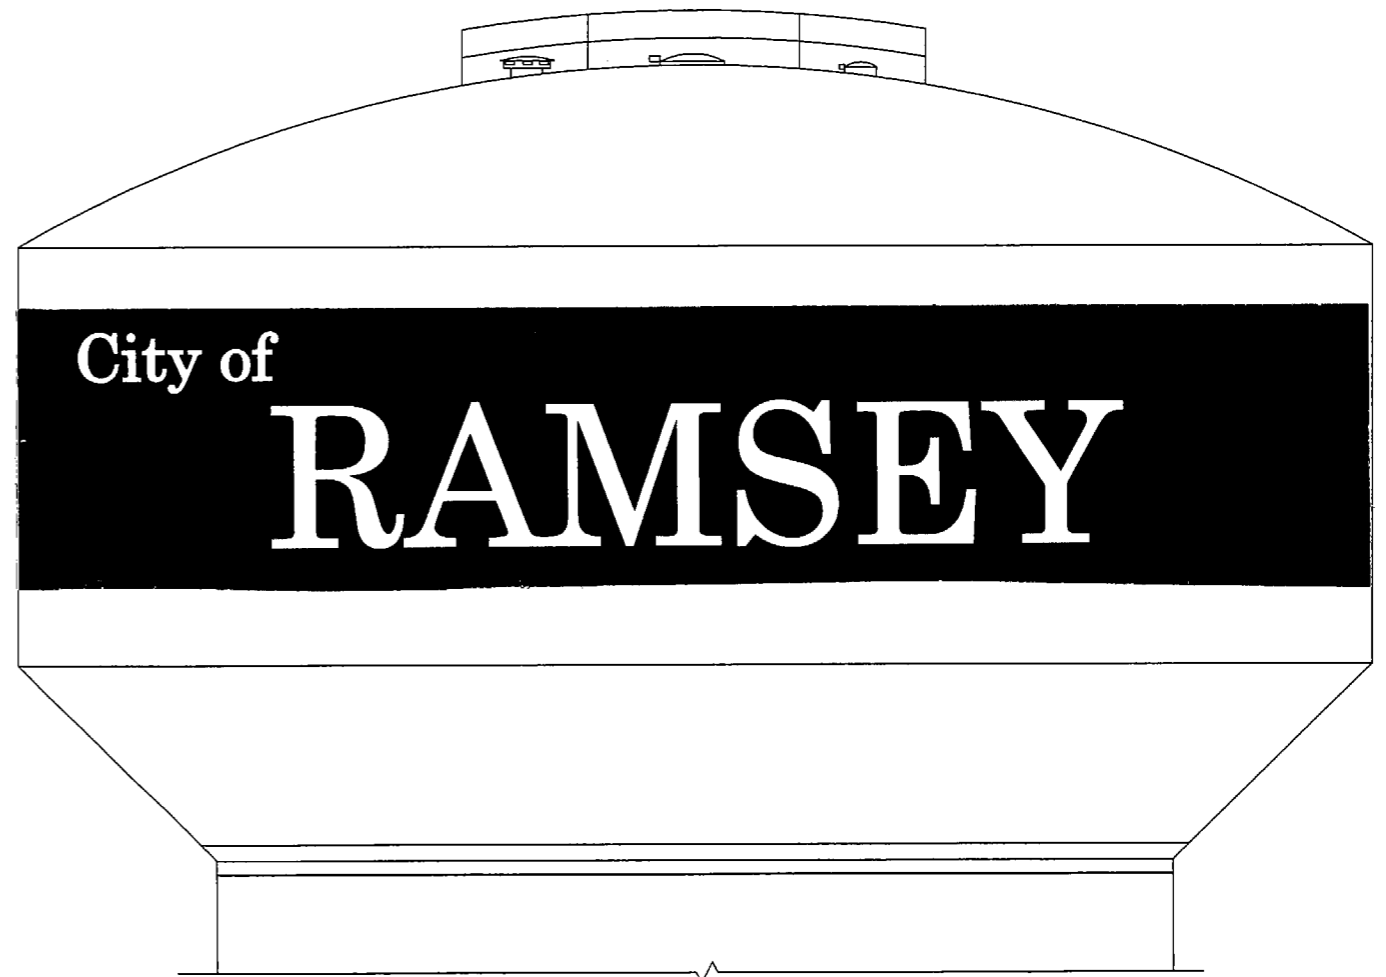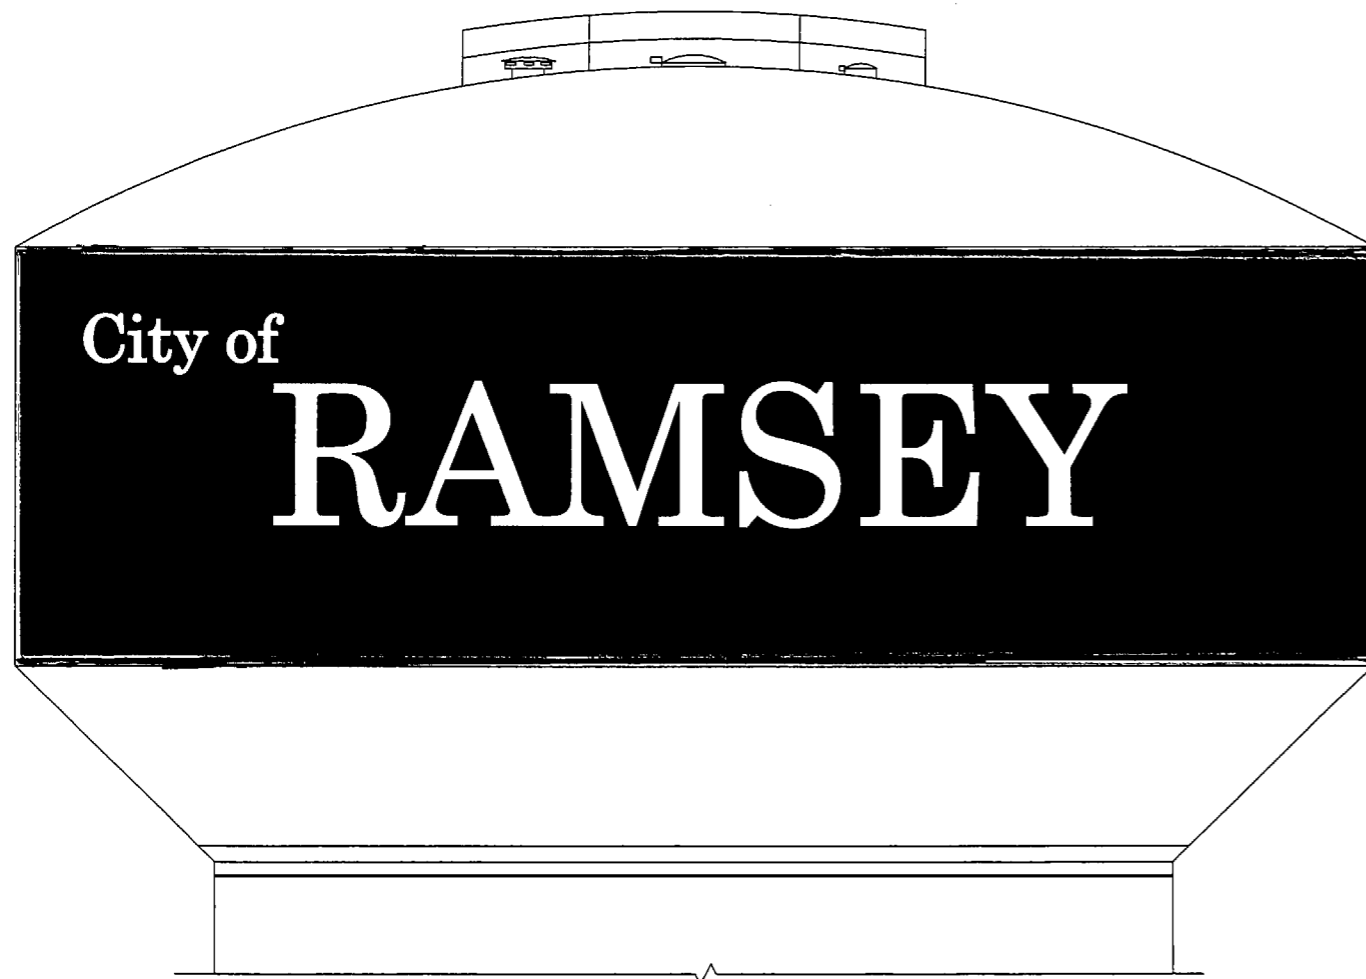

767

0	4/25/00	LMC	ORIGINAL ISSUE	PROJ. NO. 200502-2701

<small>THIS DRAWING IS THE PROPERTY OF AEC ENGINEERING AND TO BE USED ONLY IN CONNECTION WITH WORK PERFORMED BY AEC ENGINEERING.</small> <small>THE DRAWING IS NOT TO BE COPIED IN WHOLE OR IN PART AND MUST BE RETURNED UPON REQUEST.</small>	
SCALE	AS NOTED
DR.	LMC
DATE	4/25/00
CK.	
DATE	
APP.	
DATE	
	AS NOTED



I HEREBY CERTIFY THAT THIS PLAN, SPECIFICATION, OR REPORT WAS PREPARED BY ME OR UNDER MY DIRECT SUPERVISION AND THAT I AM A DULY REGISTERED PROFESSIONAL ENGINEER UNDER THE LAWS OF THE STATE OF MINNESOTA.

SIGNATURE: _____
 DATE: _____ REC. NO.: _____




TOWER ELEVATIONS
 CITY OF RAMSEY
 1.5 MILLION GALLON
 WATER TOWER

CADD FILE NAME		DWG\RAMSEY\200502\2701\M2701-S07	
SHEET	OF	AEC PROJECT NO.	200502-2701
DRAWING NO.	M2701-S07	REV	0

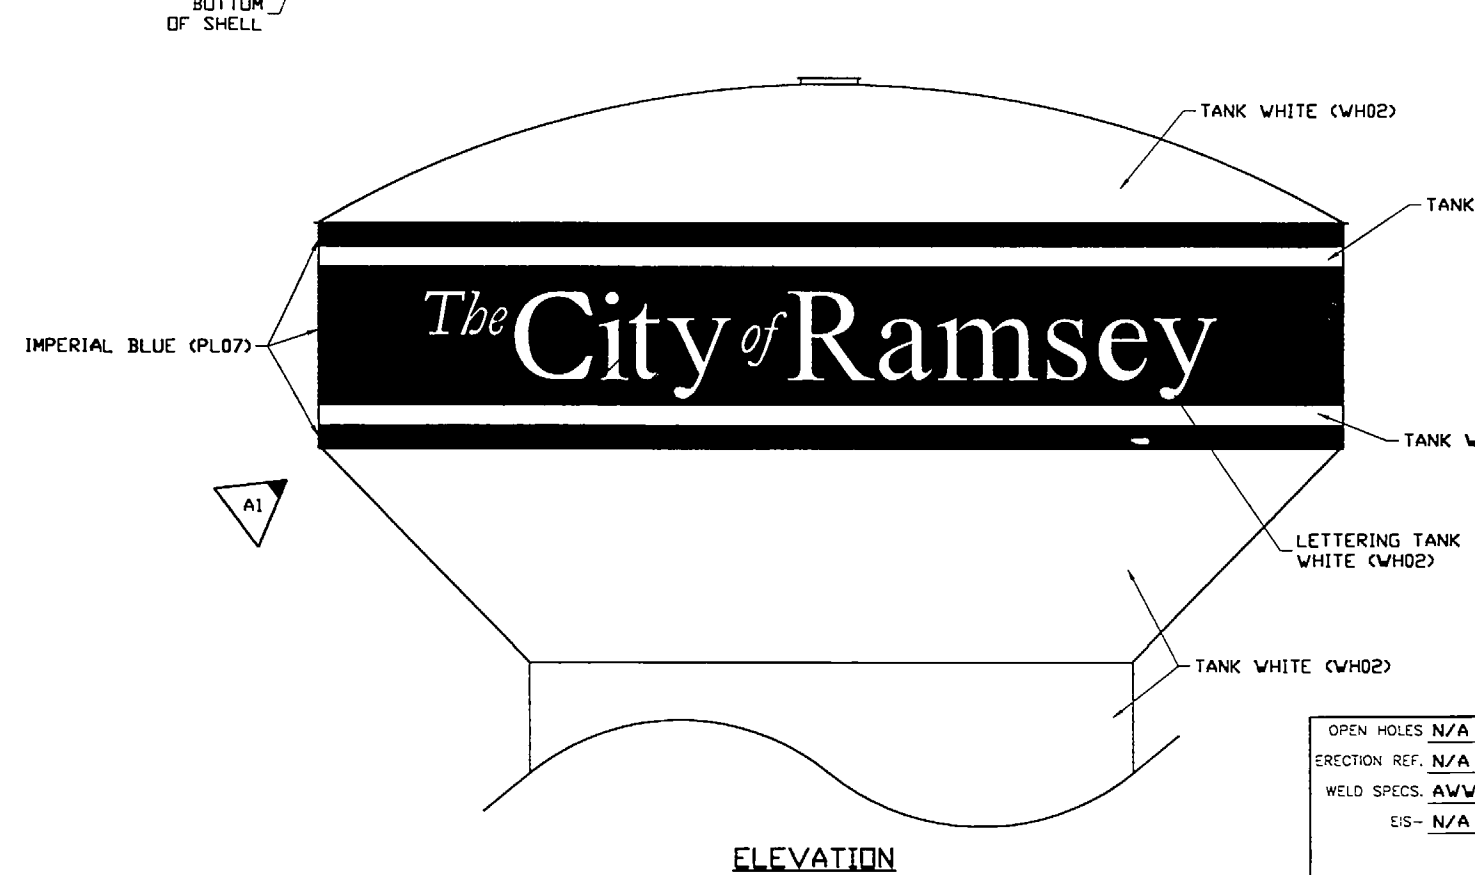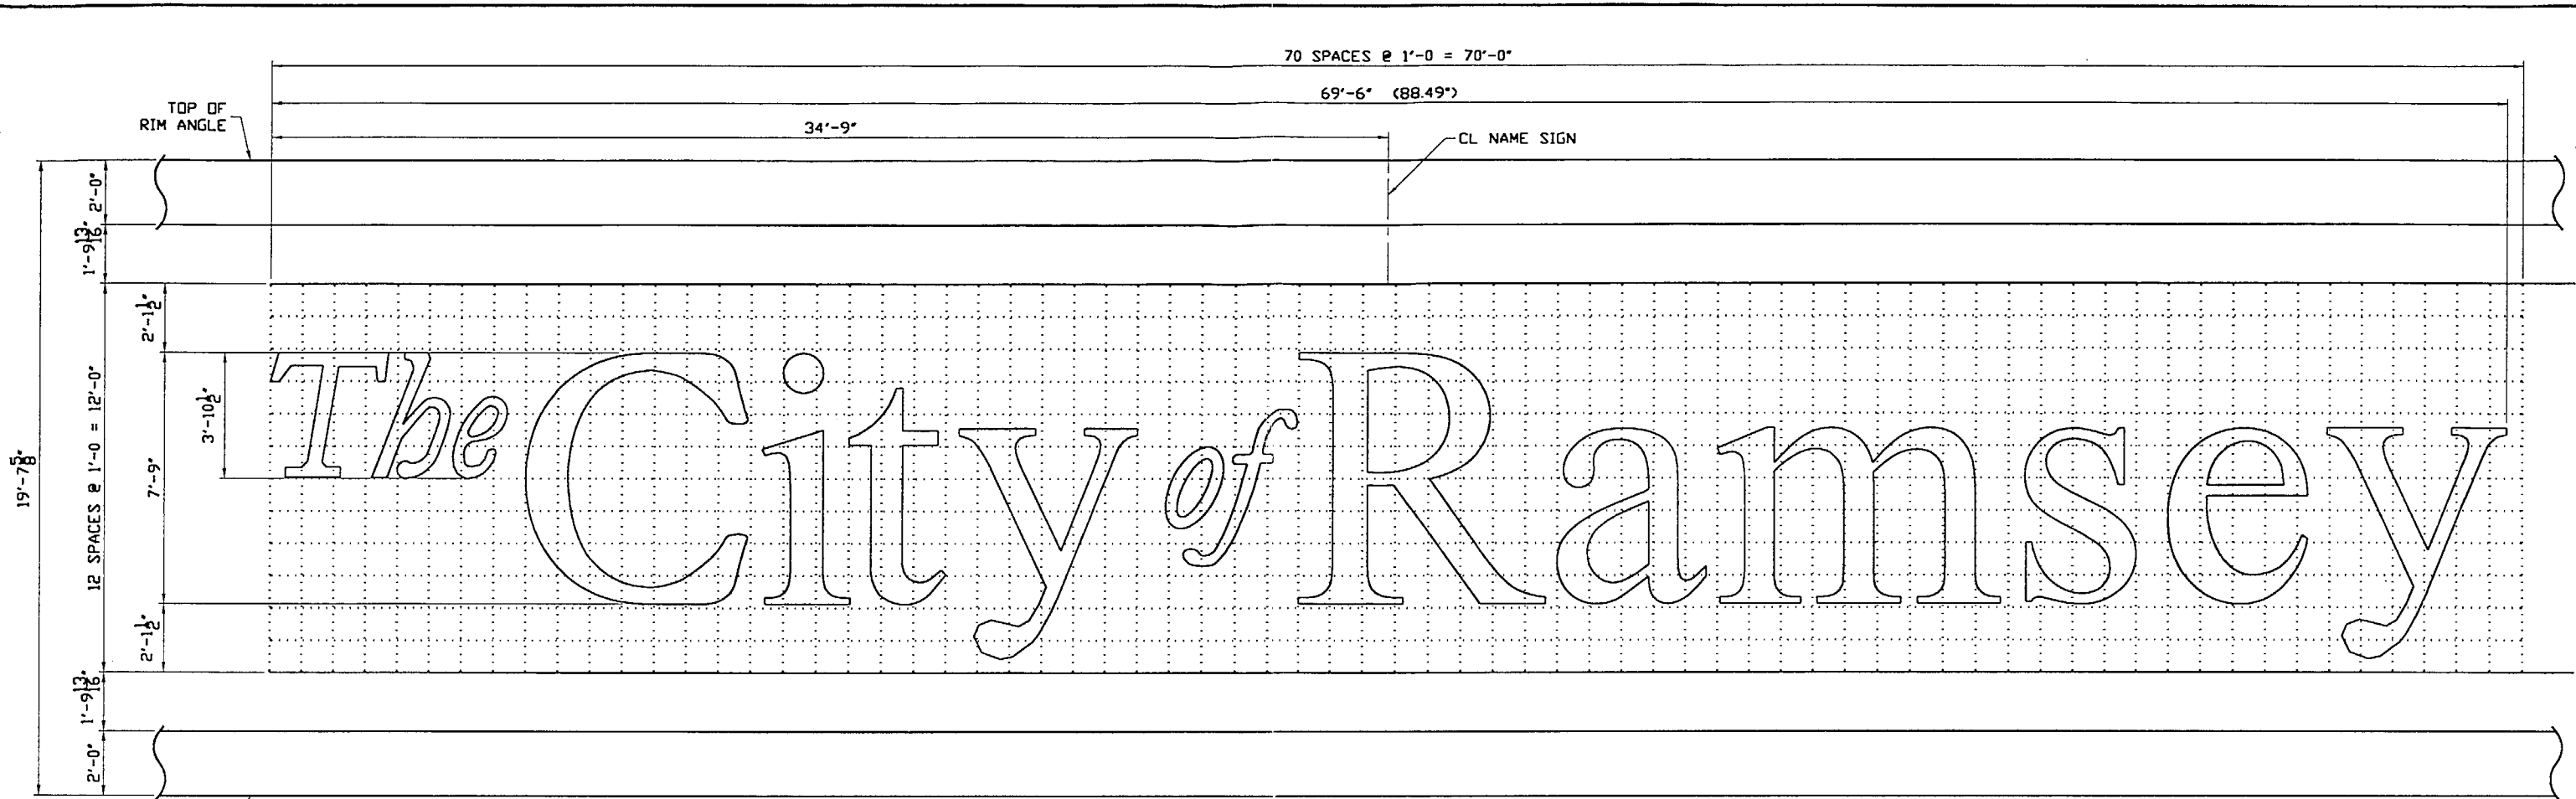

NAME SIGN

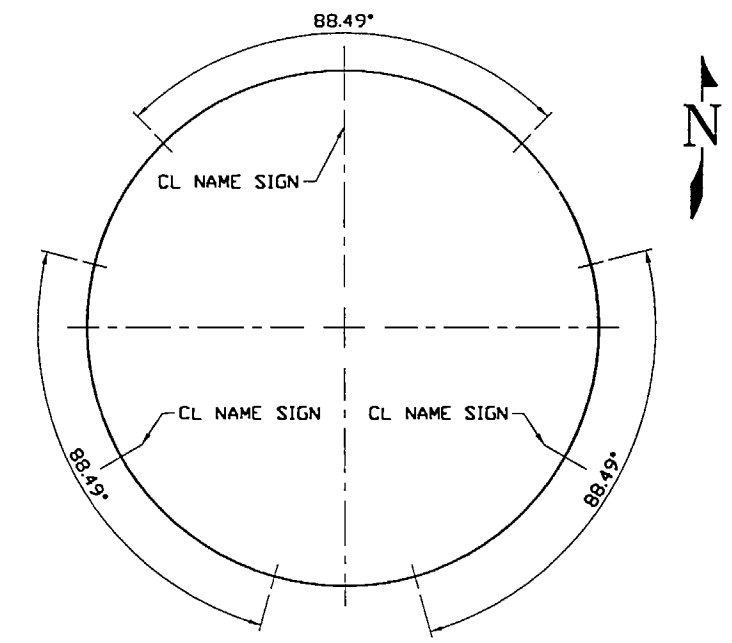

ORIENTATION
LOCATE NAME SIGNS @ 120° C-C

768


OPEN HOLES	N/A
ERECTION REF.	N/A
WELD SPECS.	AWWA D100-96
EIS	N/A

NO	REVISION DESCRIPTION	BY	DATE	CHK	DATE
A1	CHANGED NAME SIGN PER OWNER	SEG	22MAY01	JMS	22MAY01



PITT-DES MOINES, INC. ENGINEERS - FABRICATORS - CONTRACTORS			
CITY OF RAMSEY			
1500 MG HP 90" DIA X 40' HR X 52' TWR			
RAMSEY, MN			
NAME SIGN			
DWG. PREPARED AT: CLIVE		FABRICATED AT: CLIVE	
BY	DATE	DRAWING:	P2
DRAWN: SEG	18AUG00	CHECKED:	JMS
21AUG00		CONTRACT: 50557	

DRAWINGS FOR
CONSTRUCTION OF 2MG WATER TOWER NO. 3
CITY OF RAMSEY, MINNESOTA
CITY PROJECT NO. 08-21

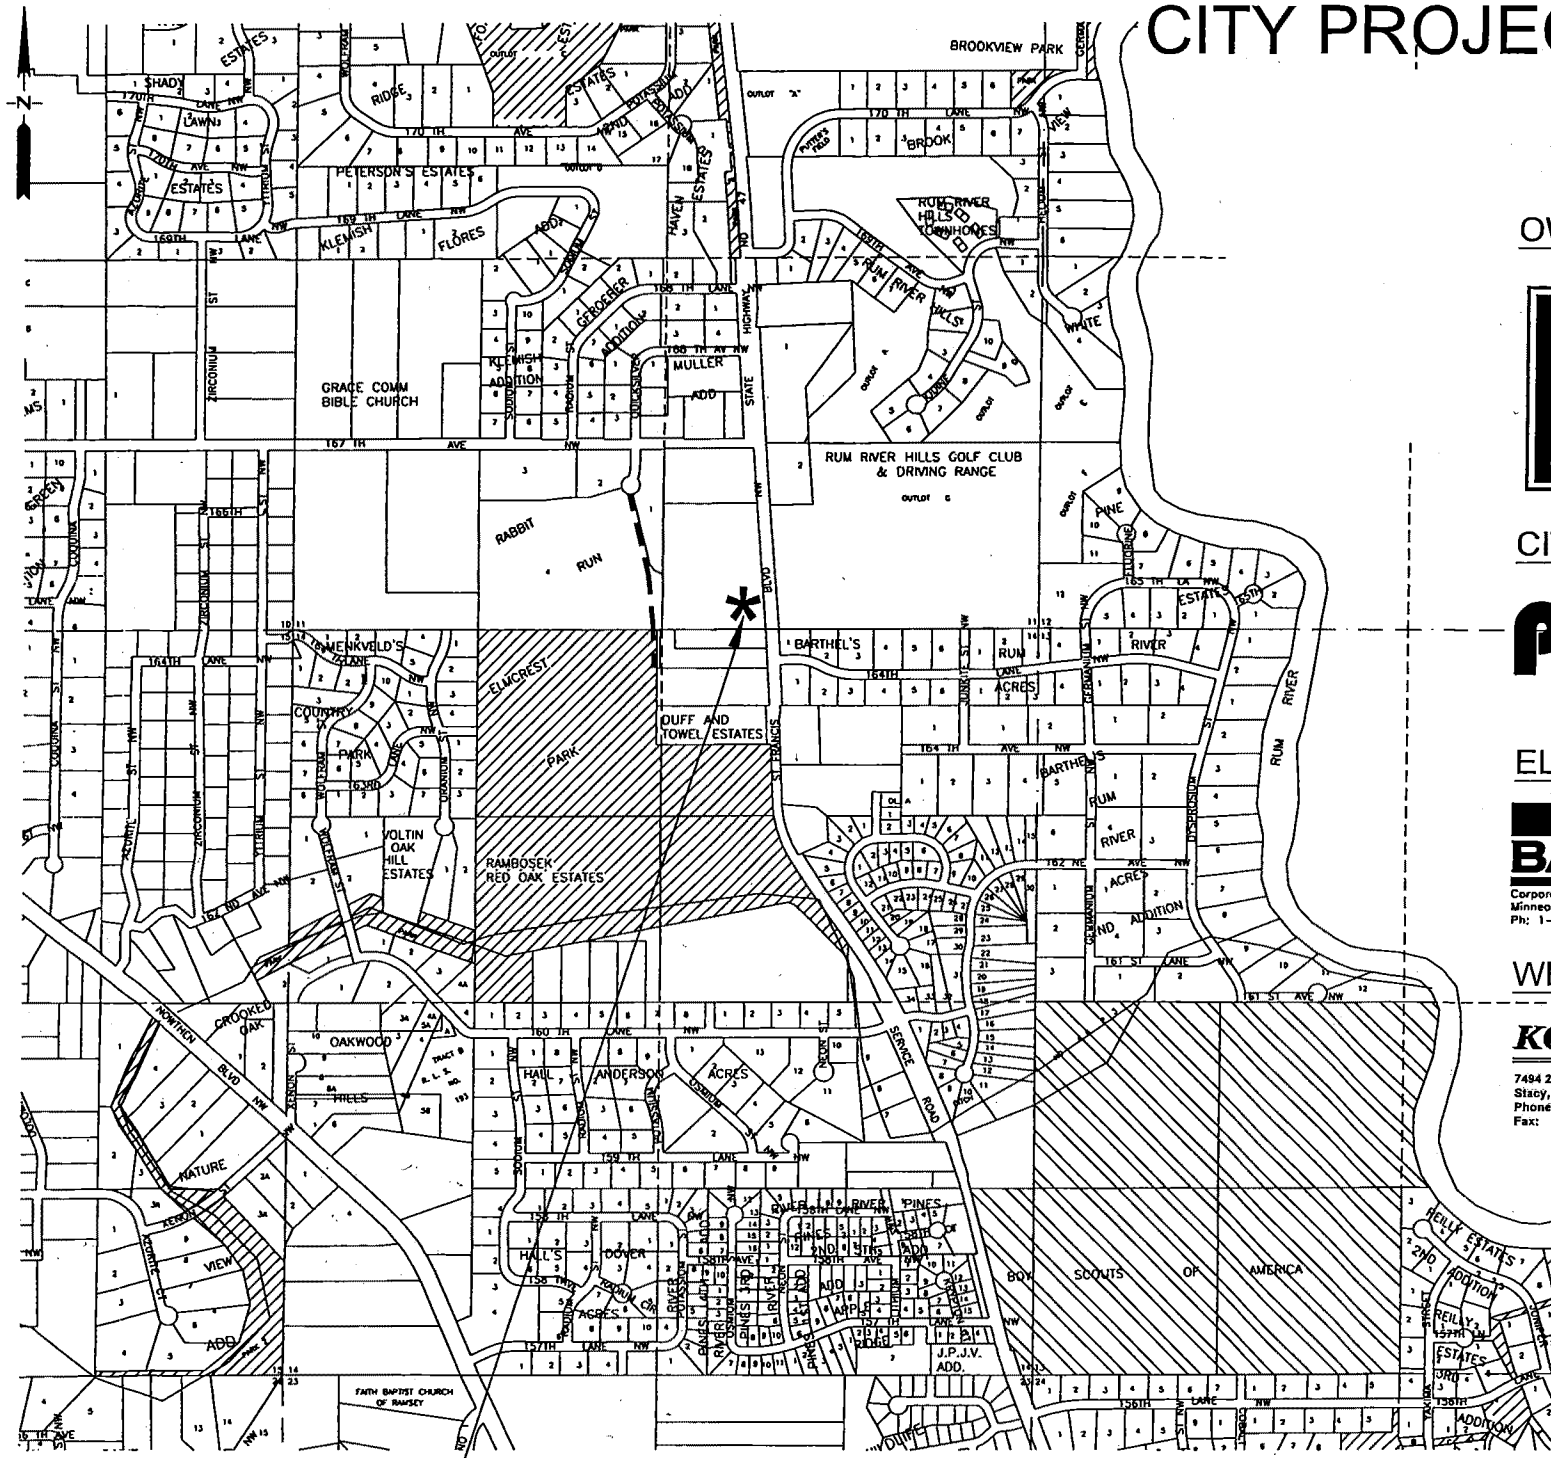


WATER TOWER NO. 3

PROJECT LOCATION MAP
NO SCALE

INDEX

DWG NO.	TITLE
G1	GENERAL
G2	PROJECT LOCATION & DRAWING INDEX
	TOPOGRAPHIC SURVEY
C1	CIVIL/ SITE
C2	SITE PLAN
C3	ACCESS ROAD PAVING PLAN
C4	CIVIL DETAILS
	CIVIL DETAILS
L1	LANDSCAPING
	LANDSCAPING PLAN
P1	PROCESS
P2	TOWER PLAN
	TOWER DETAILS
E1	ELECTRICAL
E2	TOWER ELECTRICAL SECTION AND SITE PLAN
E3	TOWER ELECTRICAL PLANS
E4	ELECTRICAL DETAILS AND SCHEDULES
E5	WATER TOWER SCADA PANEL SCHEMATIC
	MASTER SCADA PANEL SCHEMATIC

OWNER

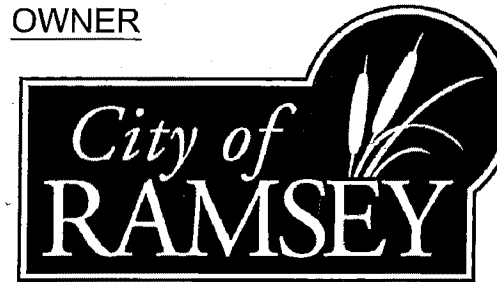

CIVIL / PROCESS

pce PROGRESSIVE CONSULTING ENGINEERS INC. (763)560-9133 FAX: (763)560-0333 6120 EARLE BROWN DR. MINNEAPOLIS, MN. 55430

ELECTRICAL

BARR Project Office: BARR ENGINEERING CO. 4700 WEST 77TH STREET MINNEAPOLIS, MN. 55435-4803 Ph: 1-800-632-2277 Fax: (952) 832-2601 www.barr.com

WELDING/COATINGS INSPECTOR

KCI Kollmer Consultants, Inc. Engineering, Coatings & Inspection Services 7484 253rd Avenue NE, Stacy, MN 55079 Phone: (651) 462-7286 Fax: (651) 462-3249

NOTES:

- NO SITE ACCESS ALLOWED FROM ST. FRANCIS BLVD. ACCESS SITE FROM PARK ACCESS ROAD AT QUICKSILVER ST. AND 167TH AVE. NW.
- STATE LAW: 48 HOURS BEFORE EXCAVATING OR DEMOLISHING BUILDINGS, CALL GOPHER STATE ONE CALL AT 800-252-1166 FOR FIELD LOCATION OF UNDERGROUND UTILITY LINES.

C:\dwg\Project Files\08015 - City of Ramsey 2MG Tower\CAD Drawings\Bid Documents\05/27/09 - 10:30am

pce PROGRESSIVE CONSULTING ENGINEERS INC. (763)560-9133 FAX: (763)560-0333 6120 EARLE BROWN DR. MINNEAPOLIS, MN. 55430

ISSUE	DESCRIPTION	DATE
B	BID DOCUMENTS	5/22/09
A	MDH REVIEW SET	2/27/09


I HEREBY CERTIFY THAT THIS PLAN, SPECIFICATION, OR REPORT WAS PREPARED BY ME OR UNDER MY DIRECT SUPERVISION AND THAT I AM A DULY LICENSED PROFESSIONAL ENGINEER UNDER THE LAWS OF THE STATE OF MINNESOTA.
 SIGNATURE: *Naem Qureshi*
 NAME: NAEEM QURESHI DATE: 5/22/09 REG No: 11262

DESIGNED:	BZ
DRAWN:	BD
CHECKED:	NQ
DATE:	5/22/09


Water Tower No. 3
 City of Ramsey, MN
PROJECT LOCATION AND DRAWING INDEX

JOB NO.	ISSUE
08015	B
DRAWING NO.	G1

G2.dwg
 P:\2008 Project Files\08015 - City of Ramsey 2MG Tower\CAD Drawings\Bid Documents\05/27/09 - 10:34am

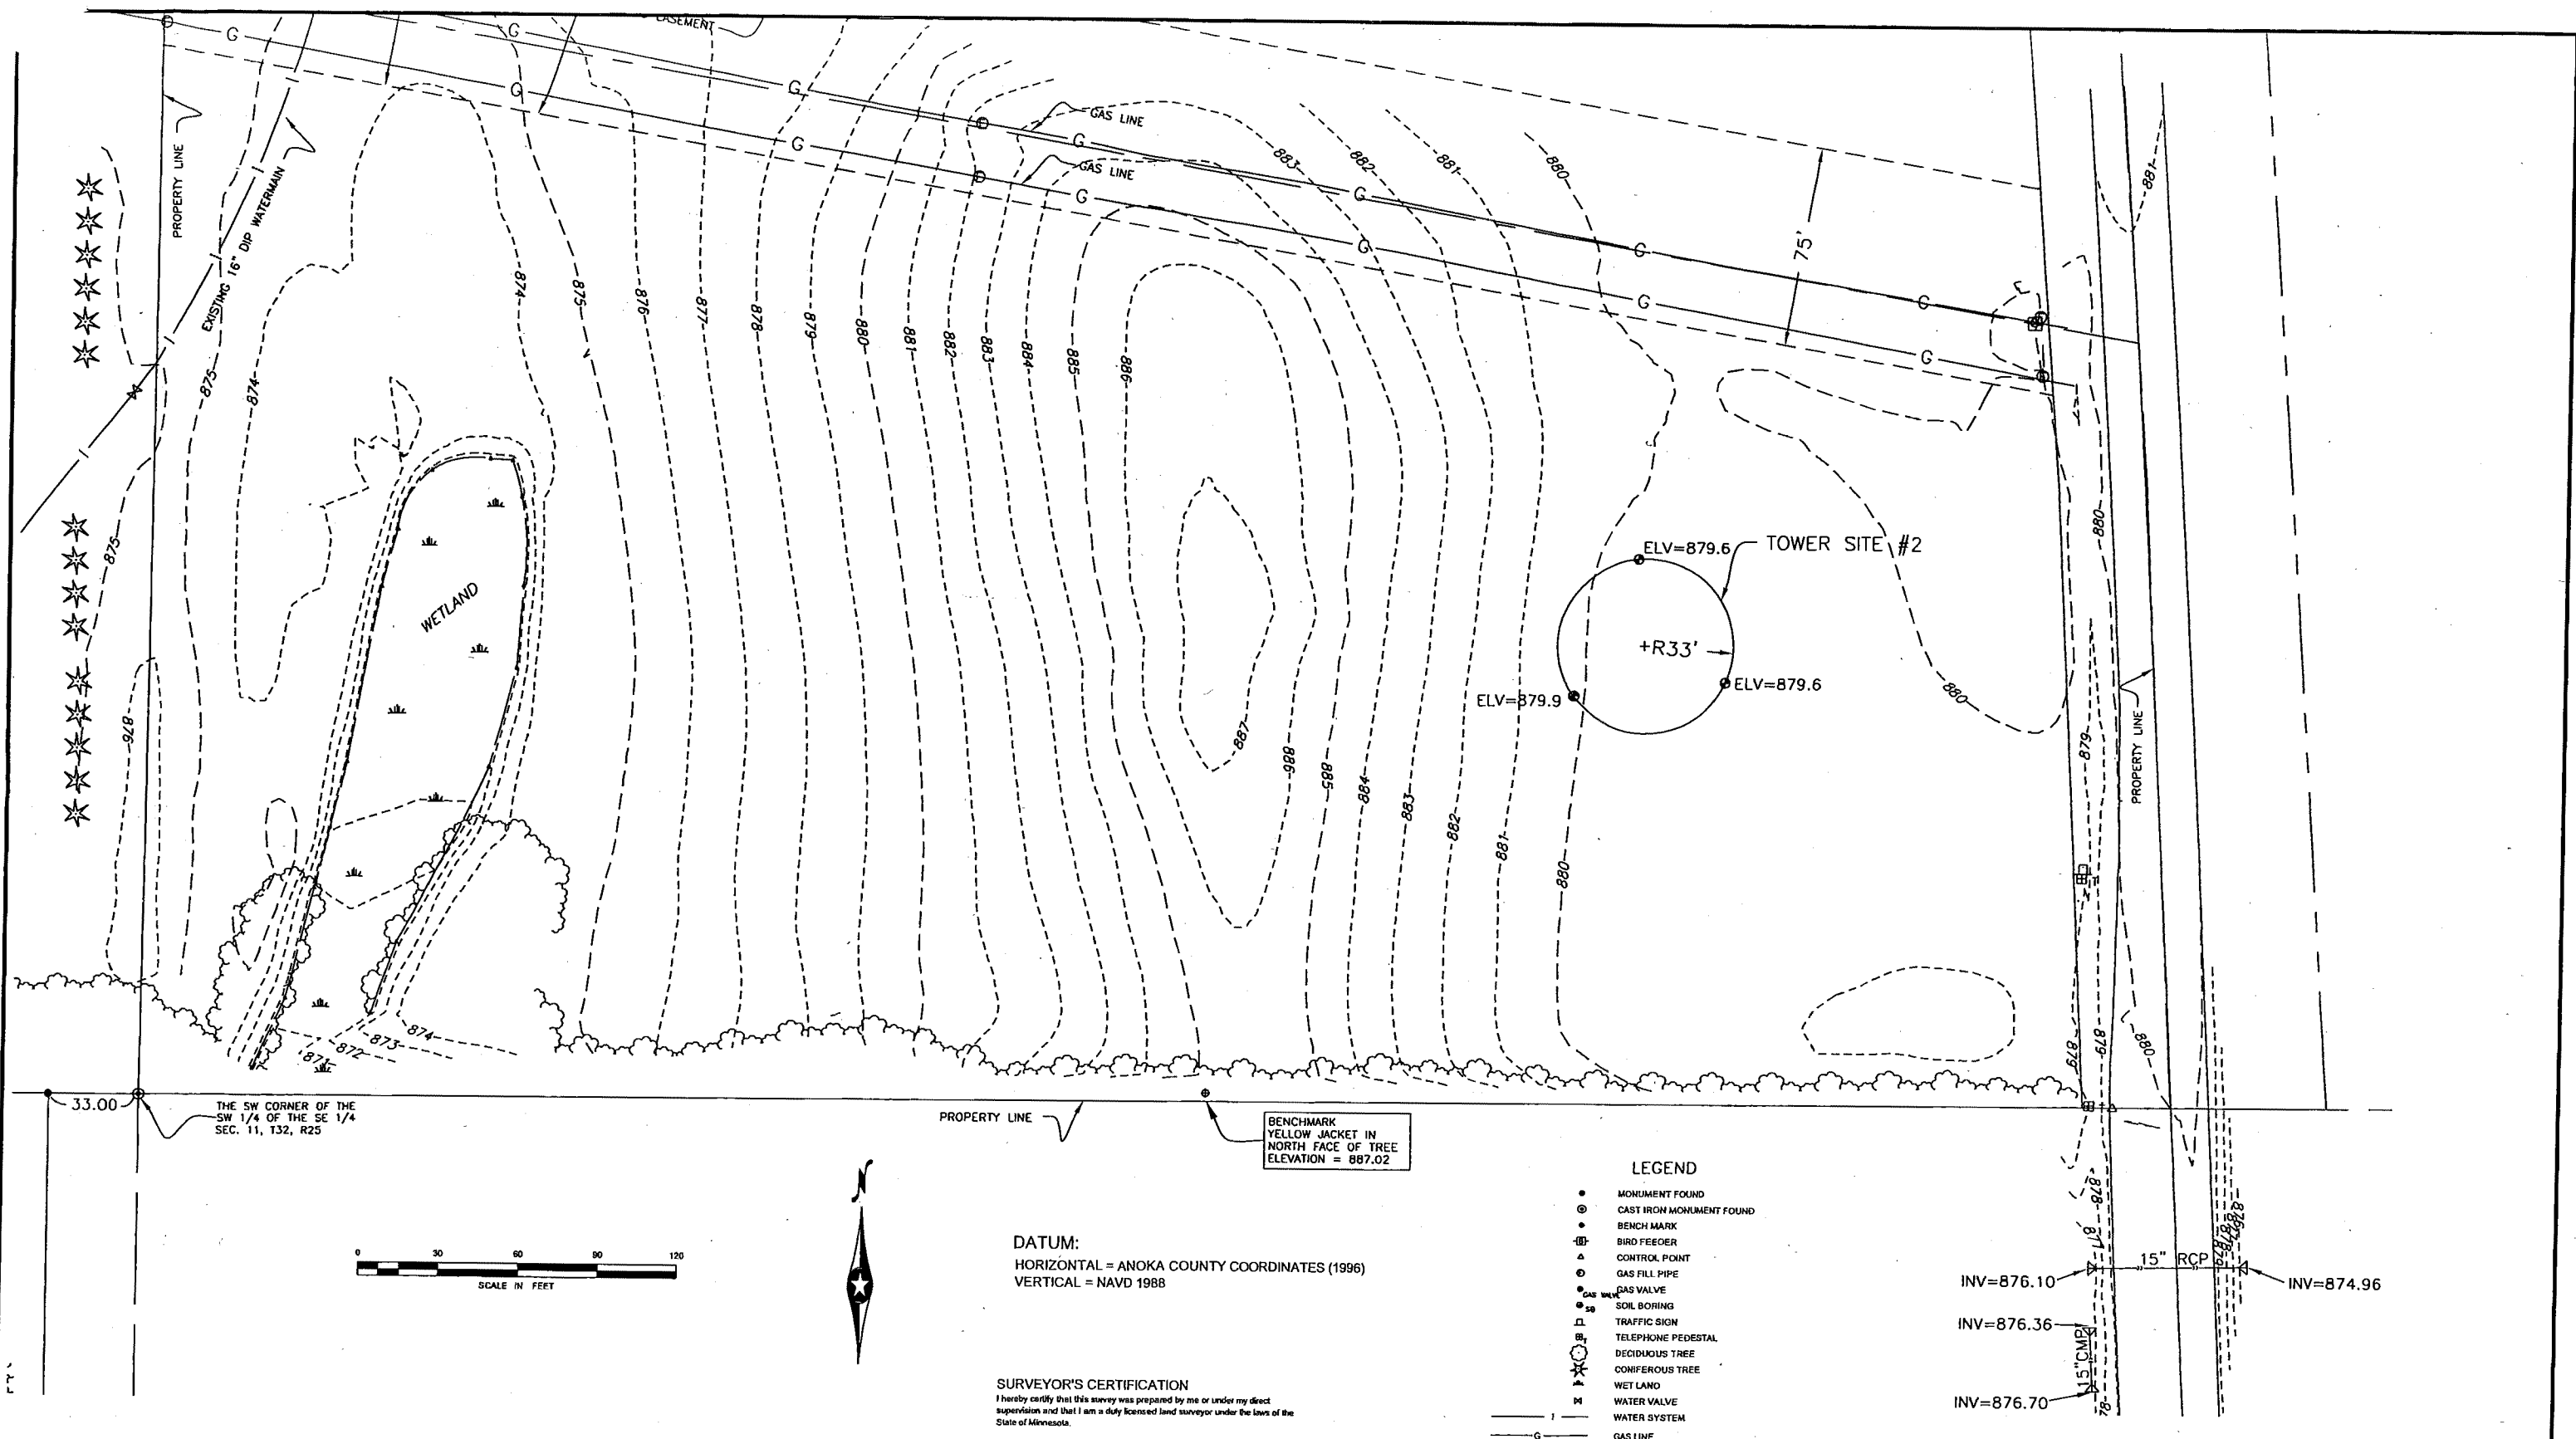

33.00
 THE SW CORNER OF THE SW 1/4 OF THE SE 1/4 SEC. 11, T32, R25

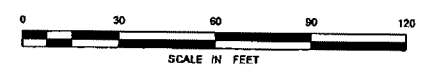

DATUM:
 HORIZONTAL = ANOKA COUNTY COORDINATES (1996)
 VERTICAL = NAVD 1988

SURVEYOR'S CERTIFICATION
 I hereby certify that this survey was prepared by me or under my direct supervision and that I am a duly licensed land surveyor under the laws of the State of Minnesota.

Craig E. Johnson
 License Number 44530
 Date: 02/10/09

LEGEND

- MONUMENT FOUND
- ⊙ CAST IRON MONUMENT FOUND
- ⊙ BENCH MARK
- ⊙ BIRD FEEDER
- ⊙ CONTROL POINT
- ⊙ GAS FILL PIPE
- ⊙ GAS VALVE
- ⊙ SOIL BORING
- ⊙ TRAFFIC SIGN
- ⊙ TELEPHONE PEDESTAL
- ⊙ DECIDUOUS TREE
- ⊙ CONIFEROUS TREE
- ⊙ WET LAND
- ⊙ WATER VALVE
- ⊙ WATER SYSTEM
- GAS LINE
- INTERMEDIATE CONTOURS
- INDEX CONTOURS

INV=876.10
 INV=876.36
 INV=876.70
 15" RCP
 INV=874.96

TOPOGRAPHIC SURVEY PROPOSED WATER TOWER SITES		PART OF THE SW1/4 OF THE SE1/4 SECTION 11, TOWNSHIP 32, RANGE 25 ANOKA COUNTY
BOLTON & MENK, INC. Consulting Engineers & Surveyors 7533 SUNWOOD DRIVE, RAMSEY, MN 55303 (763) 433-2851 MANKATO, MN FAIRMONT, MN SLEEPY EYE, MN BURNSVILLE, MN WILMAR, MN CHASKA, MN RAMSEY, MN AMES, IA		FOR: CITY OF RAMSEY
Water Tower No. 3	City of Ramsey	JOB NO. 08015 ISSUE B

pce PROGRESSIVE CONSULTING ENGINEERS INC.
 (763) 560-9133 FAX: (763) 560-0333
 6120 EARLE BROWN DR. MINNEAPOLIS, MN 55430

ISSUE	DESCRIPTION	DATE
B	BID DOCUMENTS	5/22/09
A	MDH REVIEW SET	2/27/09

(FOR INFORMATION ONLY)

DESIGNED: BZ
 DRAWN: BD
 CHECKED: NQ
 DATE: 5/22/09

TOPOGRAPHIC SURVEY

DRAWING NO. G2


C:\dwg\Project Files\08015 - City of Ramsey 2MG Tower\CAD Drawings\Bid Documents\05/27/09 - 10:25am

KEY NOTES

- 1 CONSTRUCTION LIMITS AT GAS EASEMENT LINE. EDGE OF NEW PAVEMENT 2 FEET FROM GAS EASEMENT LINE.
- 2 PROVIDE 24" WIDE BY 10" LONG CONCRETE PAD. PROVIDE BOLLARD ON BOTH SIDES OF TOWER OVERHEAD DOOR.
- 3 PROVIDE 6" WIDE CONCRETE SIDEWALK TO TOWER ACCESS DOOR.

GENERAL NOTES

1. MATCH EXISTING ELEVATION AT CONSTRUCTION LIMITS UNLESS SHOWN OTHERWISE.
2. CONTRACTOR(S) MUST FIELD VERIFY LOCATION AND ELEVATION OF ALL EXISTING UTILITIES WHETHER SHOWN ON THE DRAWING OR NOT. LOCATIONS MUST BE ESTABLISHED IMMEDIATELY PRIOR TO CONSTRUCTION.
3. STATE LAW: 48 HOURS BEFORE EXCAVATING OR DEMOLISHING BUILDINGS, CALL GOPHER STATE ONE CALL AT 800-252-1166 FOR FIELD LOCATION OF UNDERGROUND UTILITY LINES.
4. ALL UTILITY WORK TO BE INSPECTED BY CITY OF RAMSEY. CONTACT PUBLIC WORKS DEPARTMENT BEFORE BEGINNING WORK.
5. PROTECT EXISTING BITUMINOUS UNLESS NOTED FOR REMOVAL. REPLACE DAMAGED AREAS WITH NEW BITUMINOUS.
6. KEEP ALL EQUIPMENT, MATERIALS, ETC. INSIDE FENCED CONSTRUCTION AREA. CONTRACTOR TO DETERMINE SIZE AND LOCATION OF GATES. PROVIDE LOCKS AT ALL GATES. PROVIDE KEYS FOR OWNER AND ENGINEER.
7. PROVIDE TRAFFIC CONTROL PER THE MINNESOTA MANUAL ON UNIFORM TRAFFIC CONTROL DEVICES FOR ALL WORK WITHIN CITY RIGHT OF WAY. MAINTAIN ACCESS TO EXISTING HOMES AND PARK AT ALL TIMES.
8. SEED AND MULCH ALL DISTURBED AREAS. SEE SPECIFICATIONS.
9. PROVIDE SILT FENCE AT CONSTRUCTION LIMITS FOR ENTIRE SITE EAST OF NEW INTERSECTION WITH EXISTING ACCESS ROAD.
10. SLOPE FINISHED GRADE MINIMUM OF 1% AWAY FROM TOWER FOR THE FIRST 10'.
11. EXACT TOWER DIMENSIONS TO BE DETERMINED BY MANUFACTURER. ADJUST GRADING AS NECESSARY.

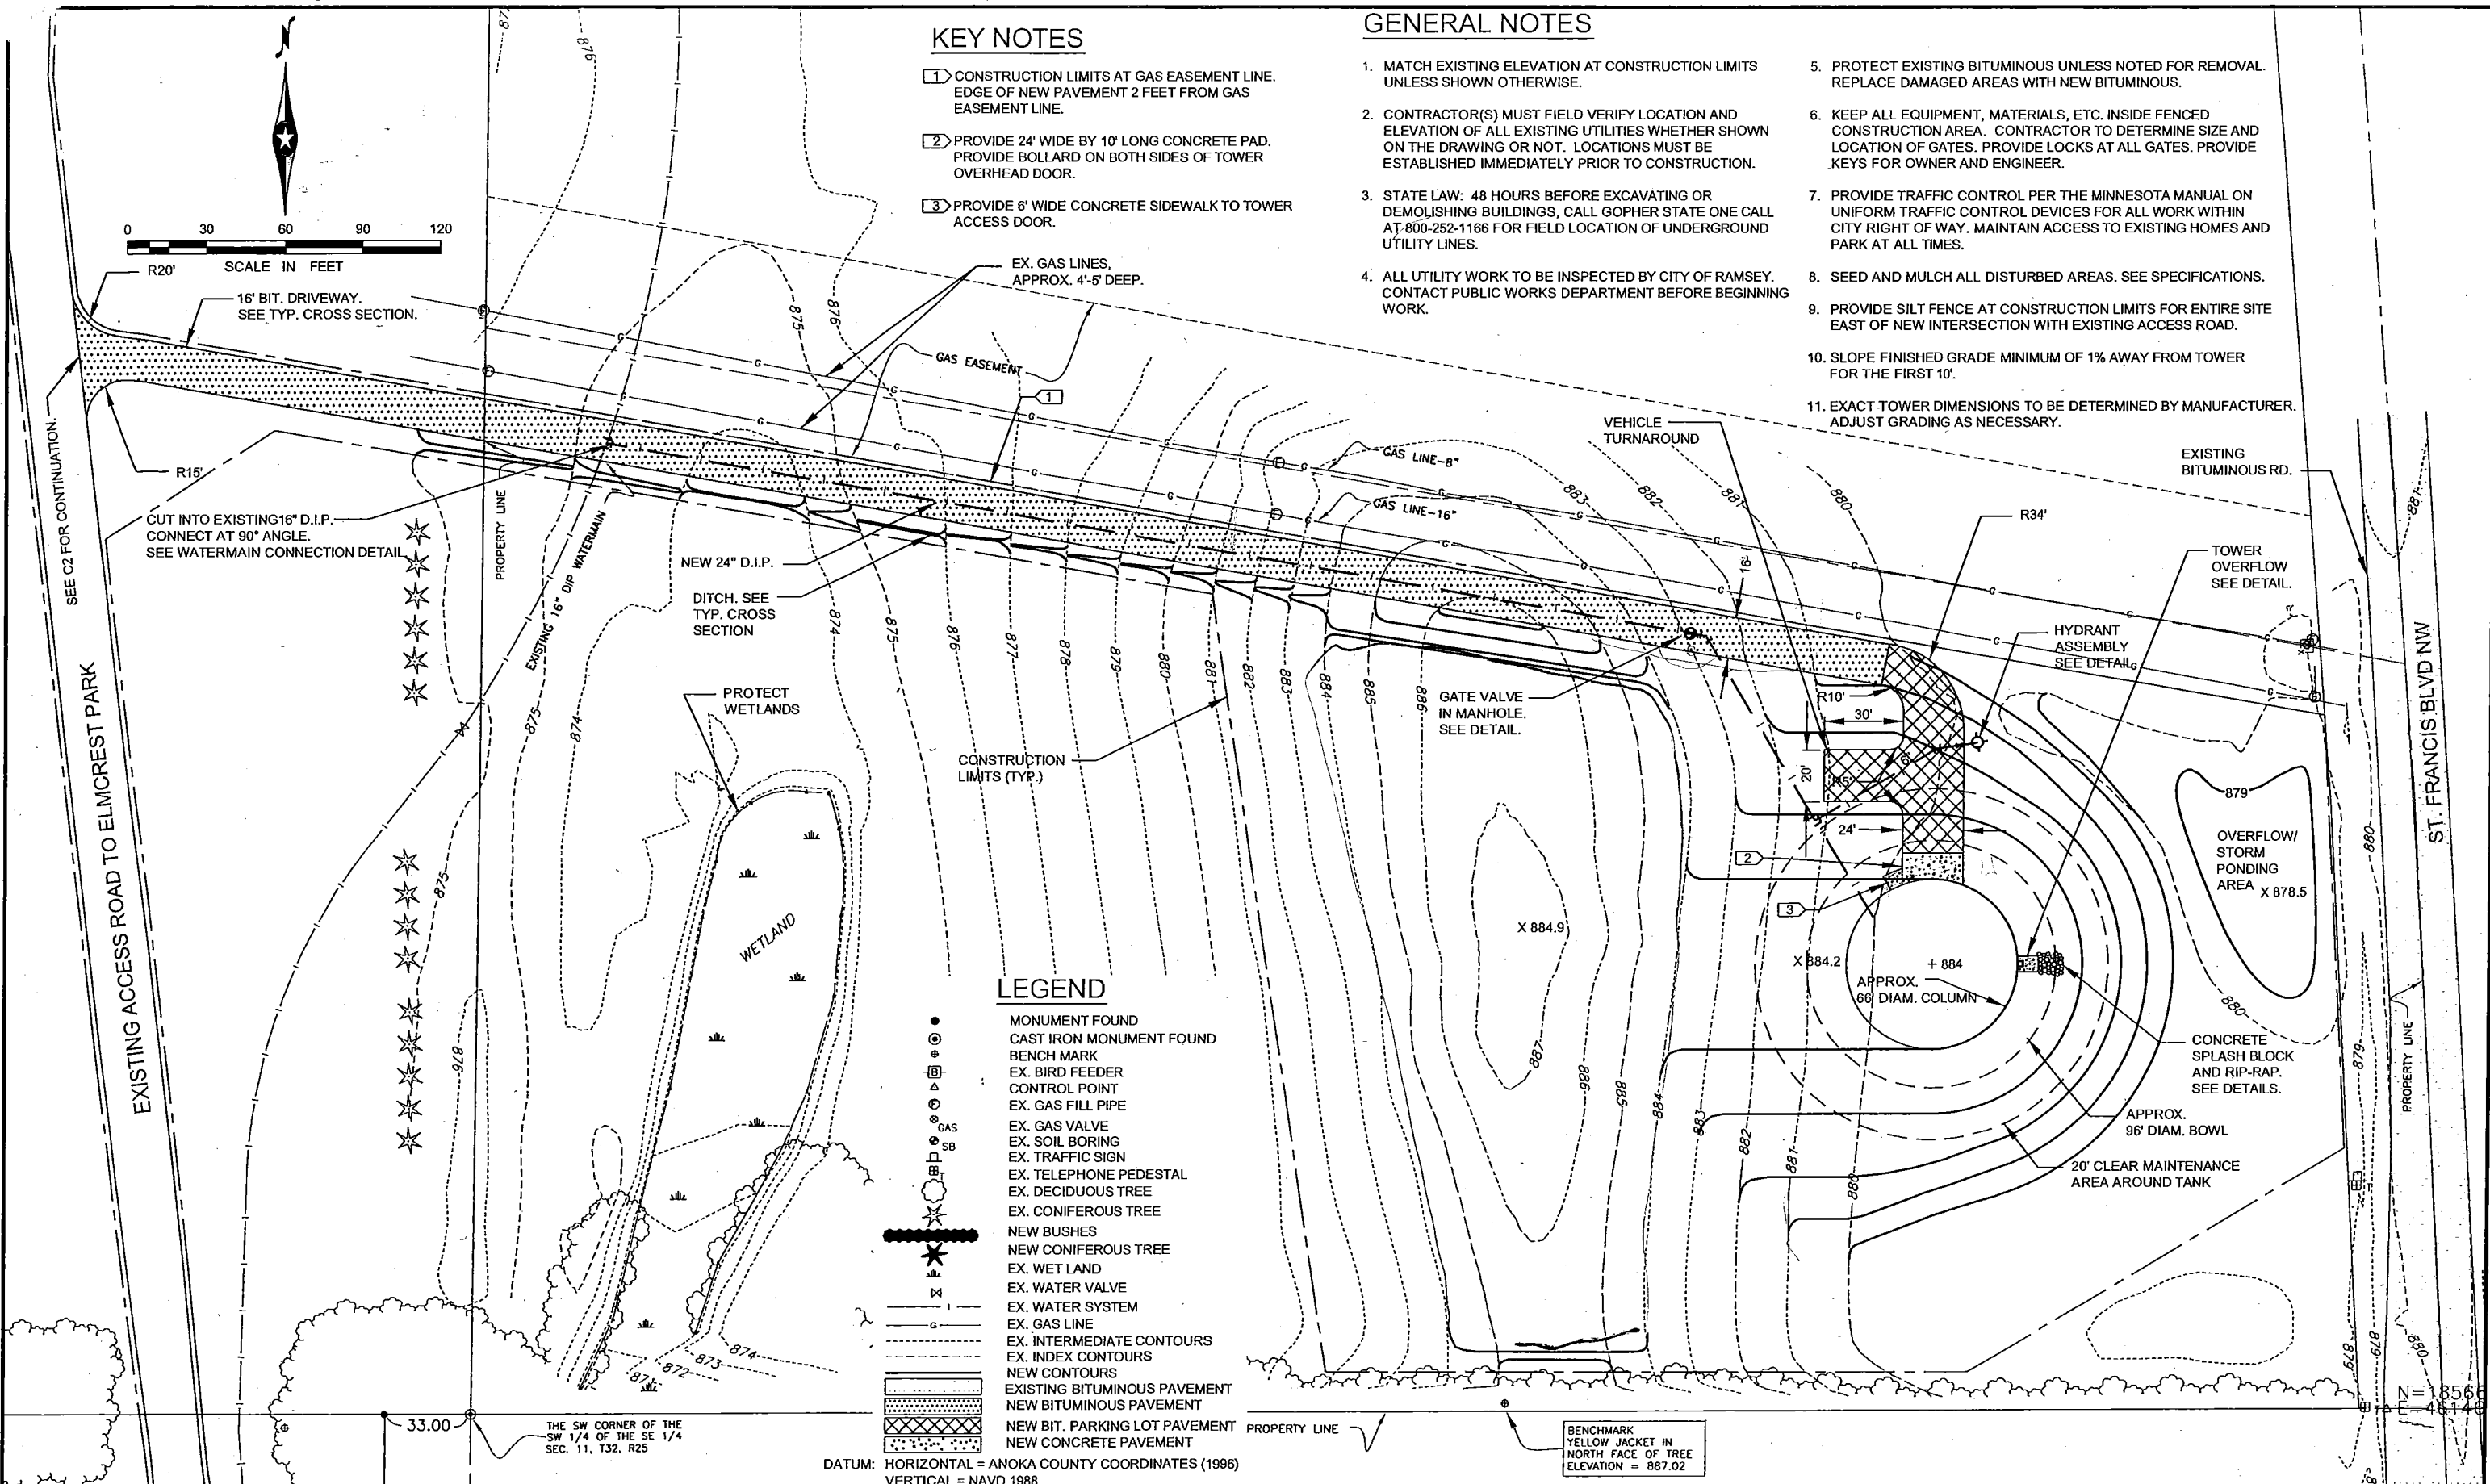

LEGEND

- MONUMENT FOUND
- CAST IRON MONUMENT FOUND
- BENCH MARK
- EX. BIRD FEEDER
- CONTROL POINT
- EX. GAS FILL PIPE
- EX. GAS VALVE
- EX. SOIL BORING
- EX. TRAFFIC SIGN
- EX. TELEPHONE PEDESTAL
- EX. DECIDUOUS TREE
- EX. CONIFEROUS TREE
- NEW BUSHES
- NEW CONIFEROUS TREE
- EX. WET LAND
- EX. WATER VALVE
- EX. WATER SYSTEM
- EX. GAS LINE
- EX. INTERMEDIATE CONTOURS
- EX. INDEX CONTOURS
- NEW CONTOURS
- EXISTING BITUMINOUS PAVEMENT
- NEW BITUMINOUS PAVEMENT
- NEW BIT. PARKING LOT PAVEMENT
- NEW CONCRETE PAVEMENT

DATUM: HORIZONTAL = ANOKA COUNTY COORDINATES (1996)
 VERTICAL = NAVD 1988

I HEREBY CERTIFY THAT THIS PLAN, SPECIFICATION, OR REPORT WAS PREPARED BY ME OR UNDER MY DIRECT SUPERVISION AND THAT I AM A DULY LICENSED PROFESSIONAL ENGINEER UNDER THE LAWS OF THE STATE OF MINNESOTA.

Signature: *Naeem Qureshi*

NAME: NAEEM QURESHI DATE: 5/22/09 REG No: 11262

DESIGNED: BZ
 DRAWN: BD
 CHECKED: NQ
 DATE: 5/22/09


Water Tower No. 3 City of Ramsey

SITE PLAN

JOB NO. 08015 ISSUE B
 DRAWING NO. C1

pce PROGRESSIVE ENGINEERS INC.
 (763)560-9133 FAX: (763)560-0333
 6120 EARLE BROWN DR. MINNEAPOLIS, MN. 55430



ISSUE	DESCRIPTION	DATE
B	BID DOCUMENTS	5/22/09
A	MDH REVIEW SET	2/27/09

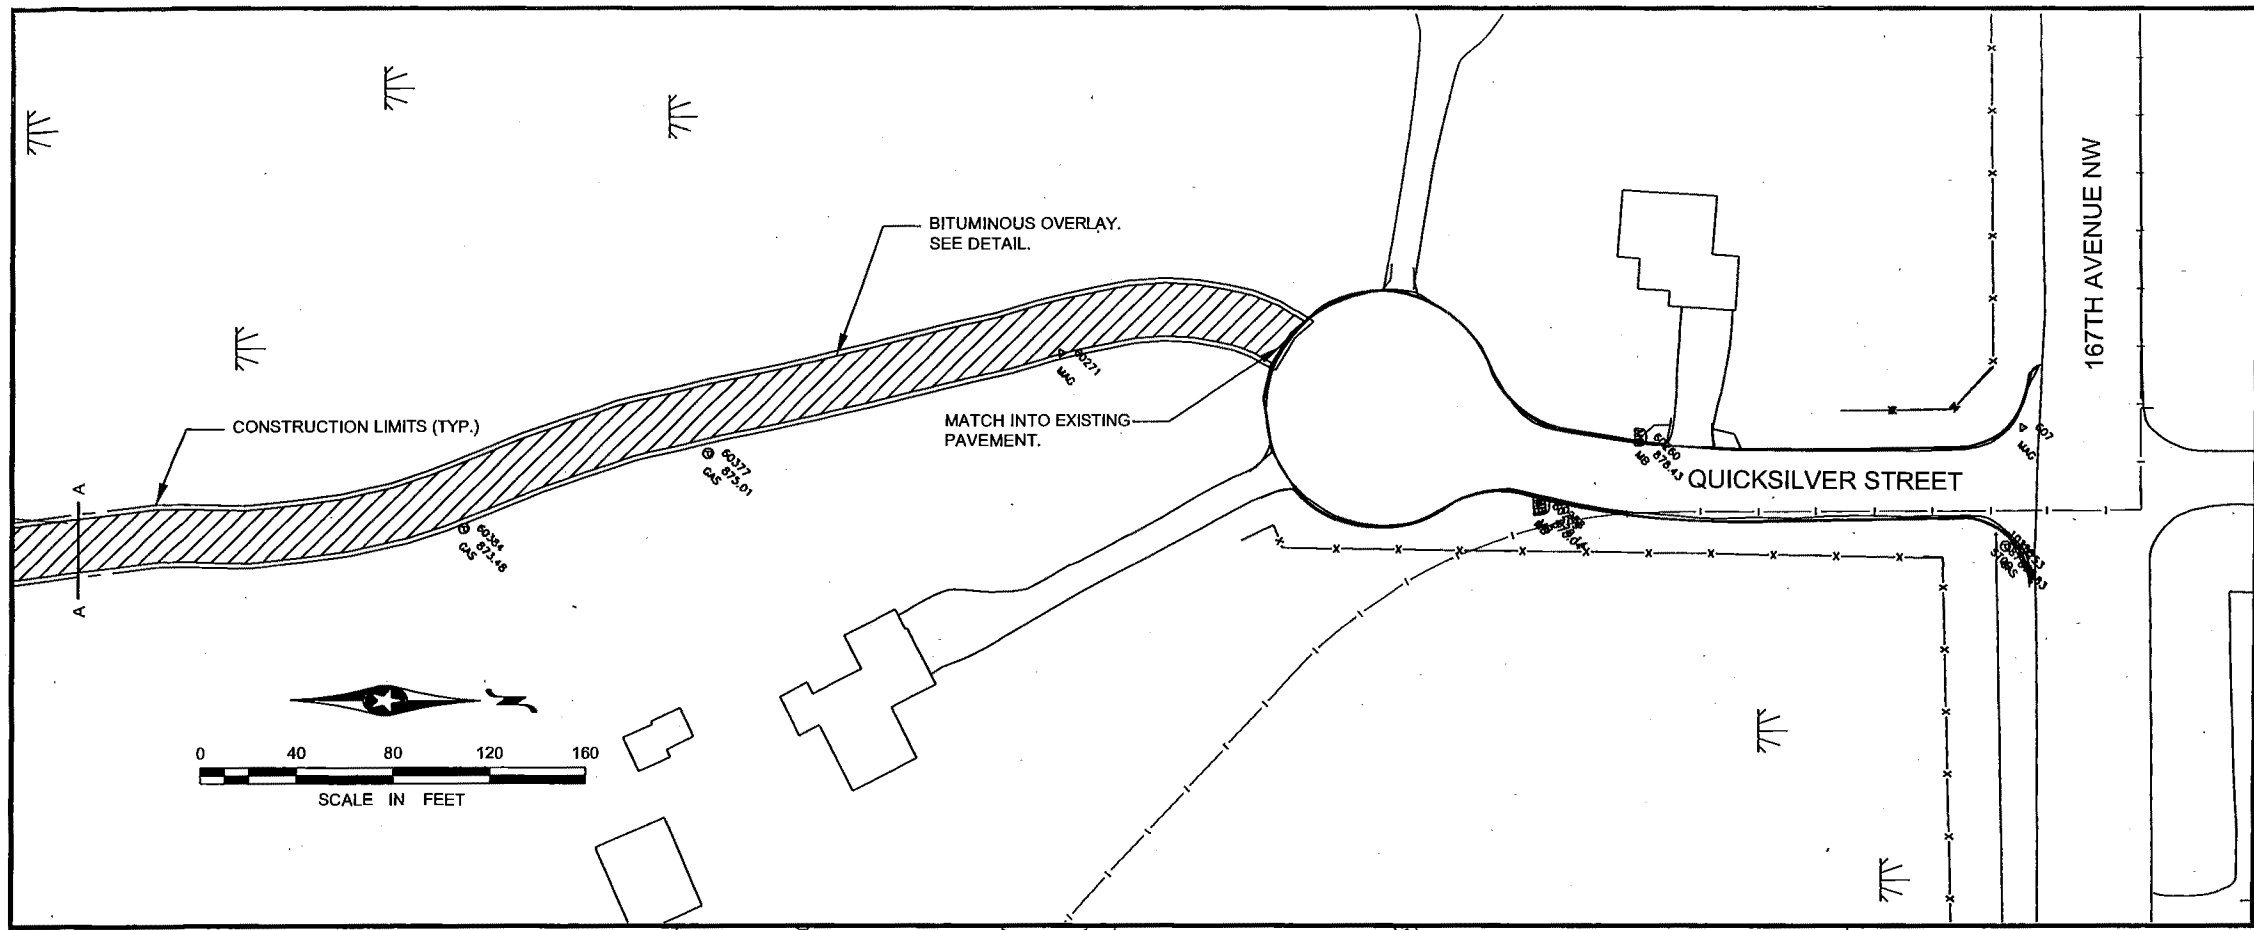

GENERAL NOTES

1. MATCH EXISTING ELEVATION AT CONSTRUCTION LIMITS UNLESS SHOWN OTHERWISE.
2. CONTRACTOR(S) MUST FIELD VERIFY LOCATION AND ELEVATION OF ALL EXISTING UTILITIES WHETHER SHOWN ON THE DRAWING OR NOT. LOCATIONS MUST BE ESTABLISHED IMMEDIATELY PRIOR TO CONSTRUCTION.
3. STATE LAW: 48 HOURS BEFORE EXCAVATING OR DEMOLISHING BUILDINGS, CALL GOPHER STATE ONE CALL AT 800-252-1166 FOR FIELD LOCATION OF UNDERGROUND UTILITY LINES
4. ALL UTILITY WORK TO BE INSPECTED BY CITY OF RAMSEY. CONTACT PUBLIC WORKS DEPARTMENT BEFORE BEGINNING WORK.
5. PROTECT EXISTING BITUMINOUS UNLESS NOTED FOR REMOVAL. REPLACE DAMAGED AREAS WITH NEW BITUMINOUS.
6. KEEP ALL EQUIPMENT, MATERIALS, ETC. INSIDE FENCED CONSTRUCTION AREA. CONTRACTOR TO DETERMINE SIZE AND LOCATION OF GATES. PROVIDE LOCKS AT ALL GATES. PROVIDE KEYS FOR OWNER AND ENGINEER.
7. PROVIDE TRAFFIC CONTROL PER THE MINNESOTA MANUAL ON UNIFORM TRAFFIC CONTROL DEVICES FOR ALL WORK WITHIN CITY RIGHT OF WAY. MAINTAIN ACCESS TO EXISTING HOMES AND PARK AT ALL TIMES.
8. SEED AND MULCH ALL DISTURBED AREAS. SEE SPECIFICATIONS.

LEGEND

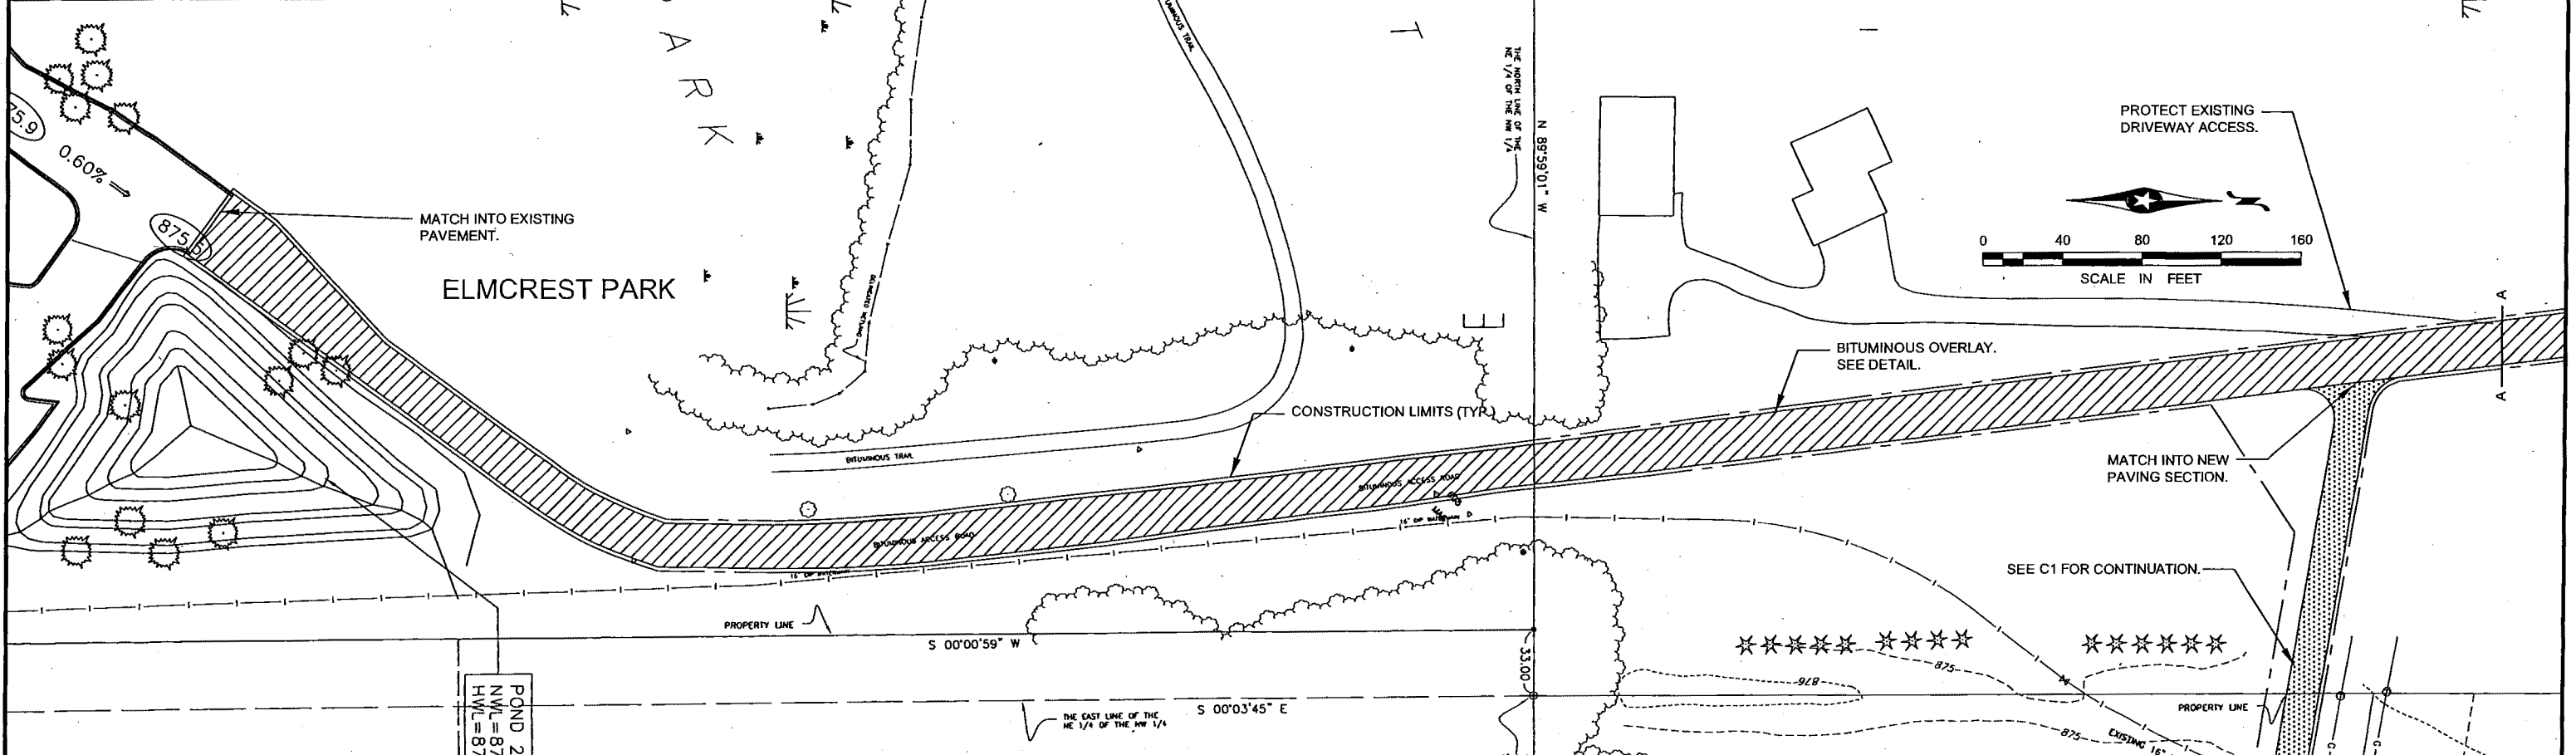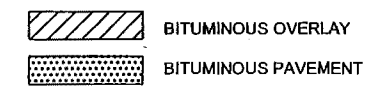

C2.dwg P:\2008 Project Files\08015 - City of Ramsey 2MG Tower\CAD Drawings\Bld Documents\05/27/09 - 10:27am

pce PROGRESSIVE CONSULTING ENGINEERS INC. (763)560-9133 FAX: (763)560-0333 8120 EARLE BROWN DR. MINNEAPOLIS, MN. 55430

ISSUE	DESCRIPTION	DATE
B	BID DOCUMENTS	5/22/09
A	MDH REVIEW SET	2/27/09

I HEREBY CERTIFY THAT THIS PLAN, SPECIFICATION, OR REPORT WAS PREPARED BY ME OR UNDER MY DIRECT SUPERVISION AND THAT I AM A DULY LICENSED PROFESSIONAL ENGINEER UNDER THE LAWS OF THE STATE OF MINNESOTA.

Signature: *Naem Qureshi*

NAME: NAEEM QURESHI DATE: 5/22/09 REG No: 11262


DESIGNED: BZ
 DRAWN: BD
 CHECKED: NQ
 DATE: 5/22/09

Water Tower No. 3 City of Ramsey

JOB NO. 08015 ISSUE B


DRAWING NO. C2

ACCESS ROAD PAVING PLAN

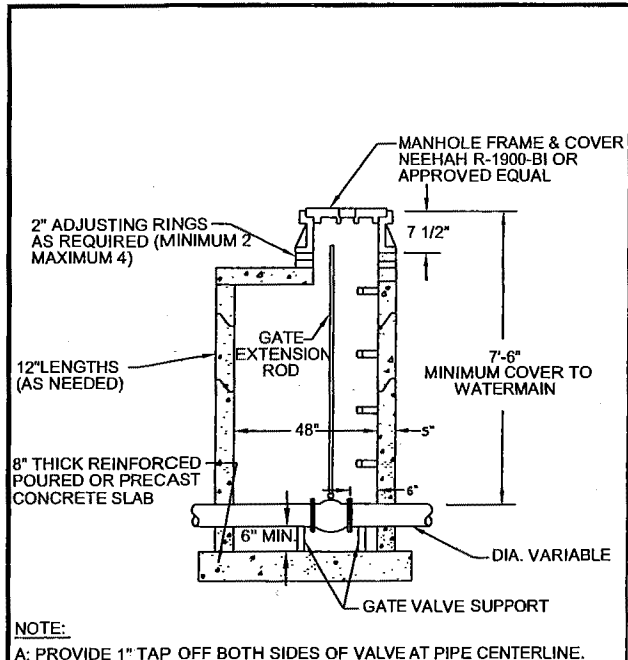


NOTE:
A: PROVIDE 1\"/>

1 GATE VALVE MANHOLE NO SCALE

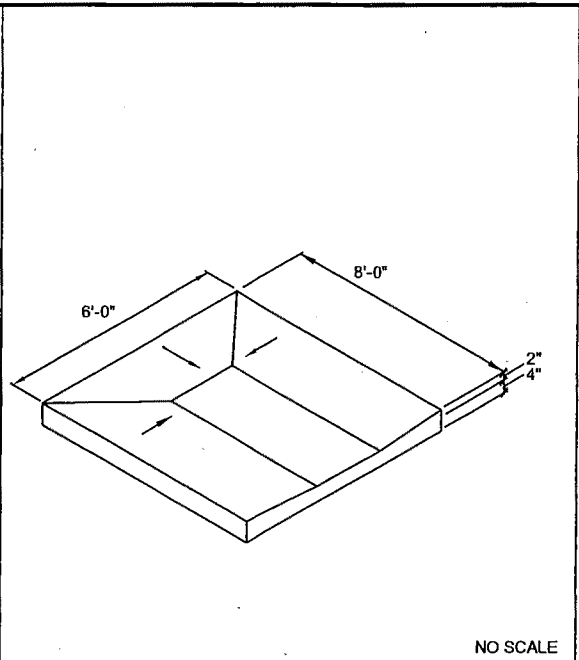

NO SCALE

2 CONCRETE SPLASH BLOCK NO SCALE

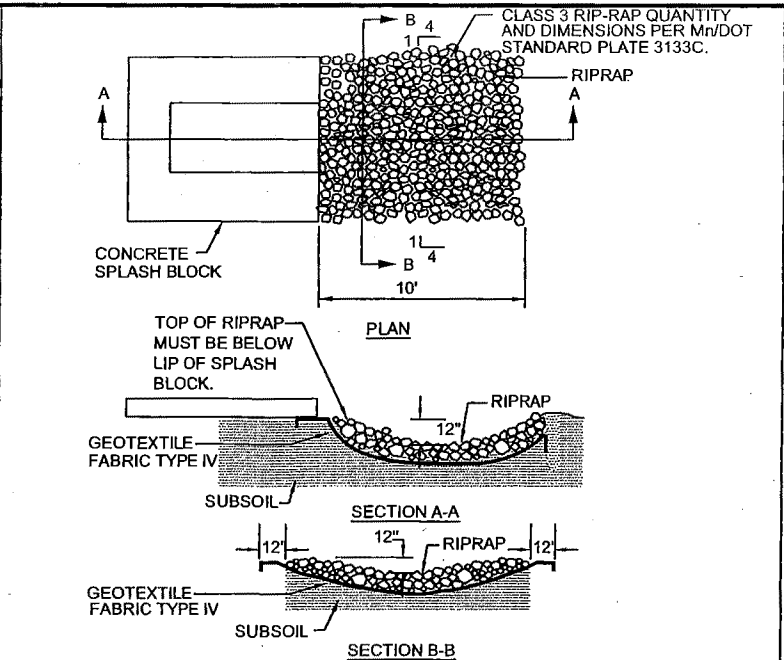

NO SCALE

3 RIP-RAP DETAIL NO SCALE

EROSION CONTROL STANDARD NOTES:

SEDIMENT CONTROL PRACTICES MUST BE ESTABLISHED ON ALL DOWN GRADIENT PERIMETERS BEFORE ANY UPGRADIENT LAND DISTURBING ACTIVITIES BEGIN. THESE PRACTICES SHALL REMAIN IN PLACE UNTIL FINAL STABILIZATION HAS BEEN ESTABLISHED. THE TIMING OF THE INSTALLATION OF SEDIMENT CONTROL PRACTICES MAY BE ADJUSTED TO ACCOMMODATE SHORT-TERM ACTIVITIES SUCH AS CLEARING OR GRUBBING, OR PASSAGE OF VEHICLES. ANY SHORT-TERM ACTIVITY MUST BE COMPLETED AS QUICKLY AS POSSIBLE AND THE SEDIMENT CONTROL PRACTICES MUST BE INSTALLED IMMEDIATELY AFTER THE ACTIVITY IS COMPLETED. HOWEVER, SEDIMENT CONTROL PRACTICES MUST BE INSTALLED BEFORE THE NEXT PRECIPITATION EVENT EVEN IF THE ACTIVITY IS NOT COMPLETE.

THE NORMAL WETTED PERIMETER OF ANY TEMPORARY OR PERMANENT DRAINAGE DITCH THAT DRAINS WATER FROM A CONSTRUCTION SITE, OR DIVERTS WATER AROUND A SITE, MUST BE STABILIZED WITHIN 200 LINEAL FEET FROM THE PROPERTY EDGE, OR FROM THE POINT OF DISCHARGE TO ANY SURFACE WATER. STABILIZATION MUST BE COMPLETED WITHIN 24 HOURS OF CONNECTING TO A SURFACE WATER.

OUTLETS MUST BE PROVIDED WITH TEMPORARY OR PERMANENT ENERGY DISSIPATION WITHIN 24 HOURS OF CONNECTION TO A SURFACE WATER.

ALL STORM DRAIN INLETS WITHIN 50' OF EXCAVATION LIMITS MUST BE PROTECTED BY APPROPRIATE BMPS DURING CONSTRUCTION UNTIL ALL SOURCES WITH POTENTIAL FOR DISCHARGING TO THE INLET HAVE BEEN STABILIZED.

TEMPORARY SOIL STOCKPILES MUST HAVE SILT FENCE OR OTHER EFFECTIVE SEDIMENT CONTROLS, AND CANNOT BE PLACED IN SURFACE WATERS, INCLUDING STORM WATER CONVEYANCES SUCH AS CURB AND GUTTER SYSTEMS, OR CONDUITS AND DITCHES.

VEHICLE TRACKING OF SEDIMENT FROM THE CONSTRUCTION SITE MUST BE MINIMIZED BY STONE PADS OR EQUIVALENT SYSTEMS. STREET SWEEPING MUST BE USED IF SUCH BMPS ARE NOT ADEQUATE TO PREVENT SEDIMENT FROM BEING TRACKED ONTO THE STREET. CONTRACTOR SHALL HAVE A STREET SWEEPER ON SITE OR HAVE ONE AVAILABLE WITHIN 3 HOURS. TRACKED SEDIMENT MUST BE REMOVED FROM ALL OFF-SITE PAVED SURFACES PROMPTLY UPON DISCOVERY, OR AS DIRECTED BY THE CITY.

THE CONSTRUCTION SITE MUST BE ROUTINELY INSPECTED ONCE EVERY SEVEN (7) DAYS DURING ACTIVE CONSTRUCTION AND WITHIN 24 HOURS AFTER A RAINFALL EVENT GREATER THAN 0.5 INCHES IN 24 HOURS. ALL INSPECTIONS AND MAINTENANCE CONDUCTED DURING CONSTRUCTION MUST BE RECORDED IN WRITING AND THESE RECORDS MUST BE RETAINED WITH THE SWPPP. ALL EROSION PREVENTION AND SEDIMENT CONTROL BMPS MUST BE INSPECTED TO ENSURE INTEGRITY AND EFFECTIVENESS. ALL NONFUNCTIONAL BMPS MUST BE REPAIRED, REPLACED, OR SUPPLEMENTED WITH FUNCTIONAL BMPS. THE PERMITTEE(S) MUST INVESTIGATE AND COMPLY WITH THE FOLLOWING INSPECTION AND MAINTENANCE REQUIREMENTS:

ALL INFILTRATION AREAS MUST BE INSPECTED TO ENSURE THAT NO SEDIMENT FROM ONGOING CONSTRUCTION ACTIVITIES IS REACHING THE INFILTRATION AREA AND THESE AREAS ARE PROTECTED FROM COMPACTION DUE TO CONSTRUCTION EQUIPMENT DRIVING ACROSS THE INFILTRATION AREA.

SOLID WASTE: COLLECTED SEDIMENT, ASPHALT AND CONCRETE MILLINGS, FLOATING DEBRIS, PAPER, PLASTIC, FABRIC, CONSTRUCTION AND DEMOLITION DEBRIS AND OTHER WASTES MUST BE DISPOSED OF PROPERLY AND MUST COMPLY WITH MPCA DISPOSAL REQUIREMENTS.

HAZARDOUS MATERIALS: OIL, GASOLINE, PAINT AND ANY HAZARDOUS SUBSTANCES MUST BE PROPERLY STORED, INCLUDING SECONDARY CONTAINMENT, TO PREVENT SPILLS, LEAKS OR OTHER DISCHARGE. RESTRICTED ACCESS TO STORAGE AREAS MUST BE PROVIDED TO PREVENT VANDALISM. STORAGE AND DISPOSAL OF HAZARDOUS WASTE MUST BE IN COMPLIANCE WITH MPCA REGULATIONS.

EXTERNAL WASHING OF TRUCKS AND OTHER CONSTRUCTION VEHICLES MUST BE LIMITED TO A DEFINED AREA OF THE SITE. RUNOFF MUST BE CONTAINED AND WASTE PROPERLY DISPOSED OF. NO ENGINE DEGREASING IS ALLOWED ON SITE.


ALL EXPOSED SOIL AREAS WITH A CONTINUOUS POSITIVE SLOPE WITHIN 200 LINEAL FEET OF A SURFACE WATER, MUST HAVE TEMPORARY EROSION PROTECTION OR PERMANENT COVER FOR THE EXPOSED SOIL AREAS YEAR ROUND, ACCORDING TO THE FOLLOWING TABLE OF SLOPES AND TIME FRAMES:

TYPE OF SLOPE	TIME	(MAXIMUM TIME AN AREA CAN REMAIN OPEN WHEN THE AREA IS NOT ACTIVELY BEING WORKED.)
STEEPER THAN 3:1	7 DAYS	
10:1 TO 3:1	14 DAYS	
FLATTER THAN 10:1	21 DAYS	


THESE AREAS INCLUDE CONSTRUCTED STORM WATER MANAGEMENT POND SIDE SLOPES, AND ANY EXPOSED SOIL AREAS WITH A POSITIVE SLOPE TO A STORMWATER CONVEYANCE SYSTEM, SUCH AS A CURB AND GUTTER SYSTEM, STORM SEWER INLET, TEMPORARY OR PERMANENT DRAINAGE DITCH OR OTHER NATURAL OR MAN MADE SYSTEMS THAT DISCHARGE TO A SURFACE WATER.

NPDES/SDS PERMIT IS REQUIRED BY MPCA. SEE SPECIFICATIONS.


MEET THE REQUIREMENTS OF THE CONSTRUCTION PERMIT FROM THE LOWER RUM RIVER WATERSHED MANAGEMENT ORGANIZATION (LRRWMO).

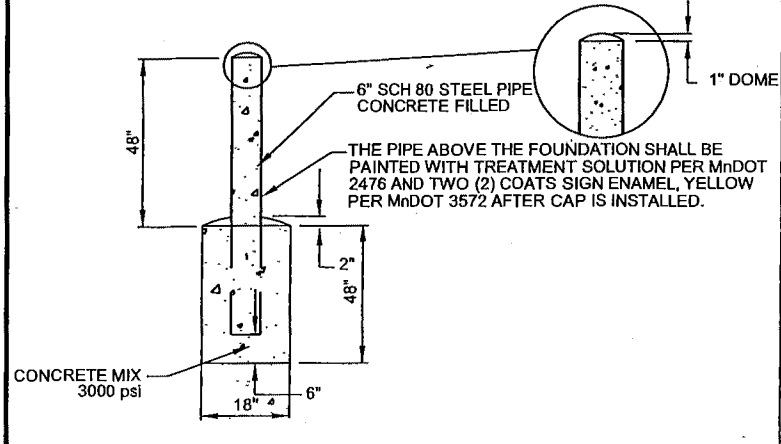


4 BOLLARD STEEL GUARD POST NO SCALE

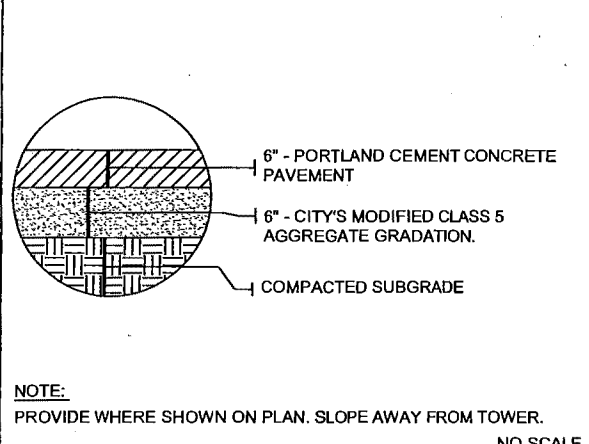


5 CONCRETE PAVING SECTION NO SCALE

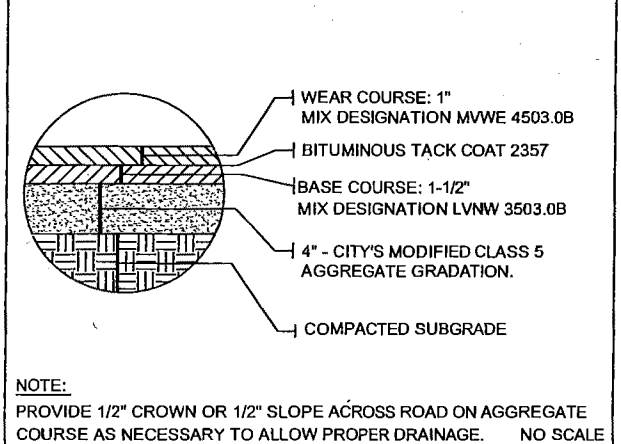

6 BITUMINOUS PAVING SECTION NO SCALE

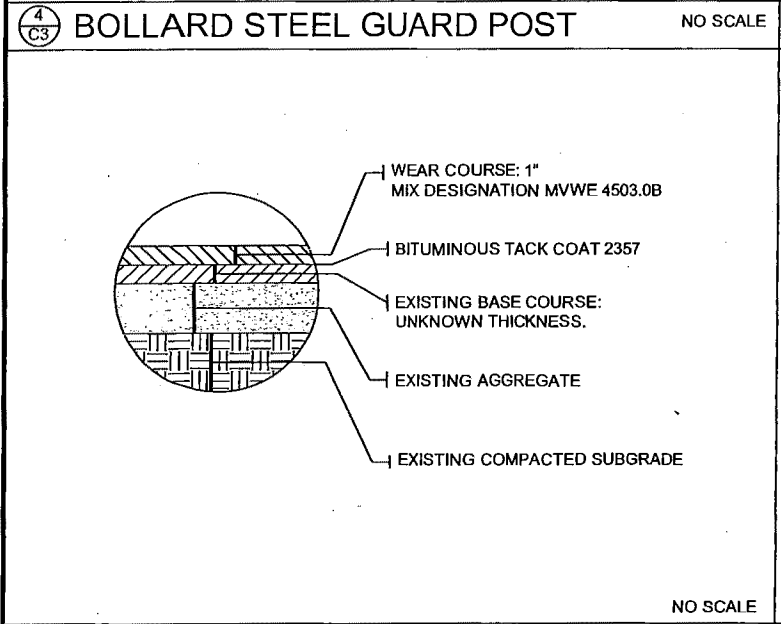

7 BITUMINOUS OVERLAY PAVING SECTION NO SCALE

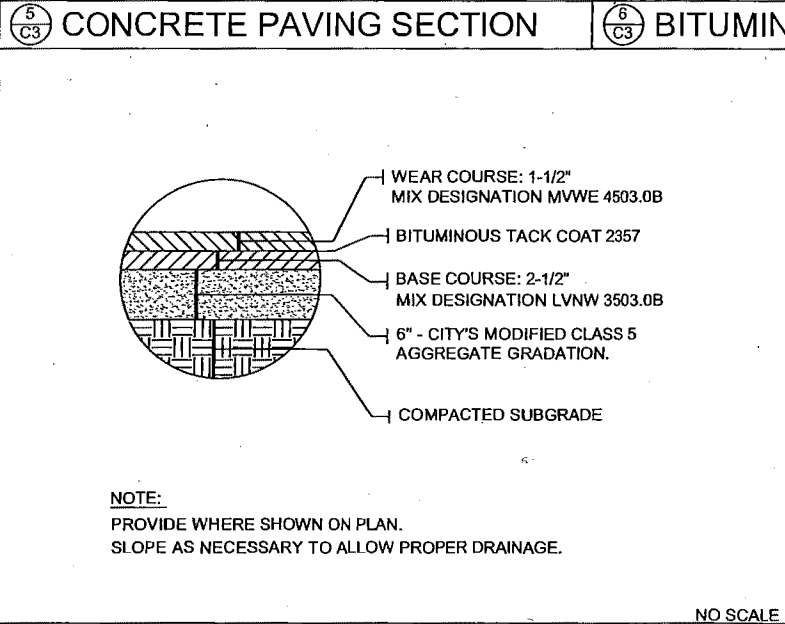

8 BITUMINOUS PARKING LOT PAVING SECTION NO SCALE

**CITY OF RAMSEY
MODIFIED CLASS 5 GRADATION**

SCREEN SIZE	% PASSING
1"	100
3/4"	90-100
3/8"	50-80
NO. 4	35-70
NO. 10	20-60
NO. 40	10-35
NO. 200	5-10

AGGREGATE

9 GRADATION NO SCALE

C3.dwg P:\2008 Project Files\08015 - City of Ramsey 2MG Tower\CAO Drawings\Bid Documents\05/27/09 - 10:32am

pce PROGRESSIVE CONSULTING ENGINEERS INC. (763)560-9133 FAX: (763)560-0333 6120 EARLE BROWN DR. MINNEAPOLIS, MN. 55430

ISSUE	DESCRIPTION	DATE
B	BID DOCUMENTS	5/22/09
A	MDH REVIEW SET	2/27/09

I HEREBY CERTIFY THAT THIS PLAN, SPECIFICATION, OR REPORT WAS PREPARED BY ME OR UNDER MY DIRECT SUPERVISION AND THAT I AM A DULY LICENSED PROFESSIONAL ENGINEER UNDER THE LAWS OF THE STATE OF MINNESOTA.


NAME: *Naem Qureshi* DATE: 5/22/09 REG No: 11262

DESIGNED: BZ
DRAWN: BD
CHECKED: NQ
DATE: 5/22/09

Water Tower No. 3 City of Ramsey, MN

CIVIL DETAILS


JOB NO. 08015 ISSUE B DRAWING NO. C3

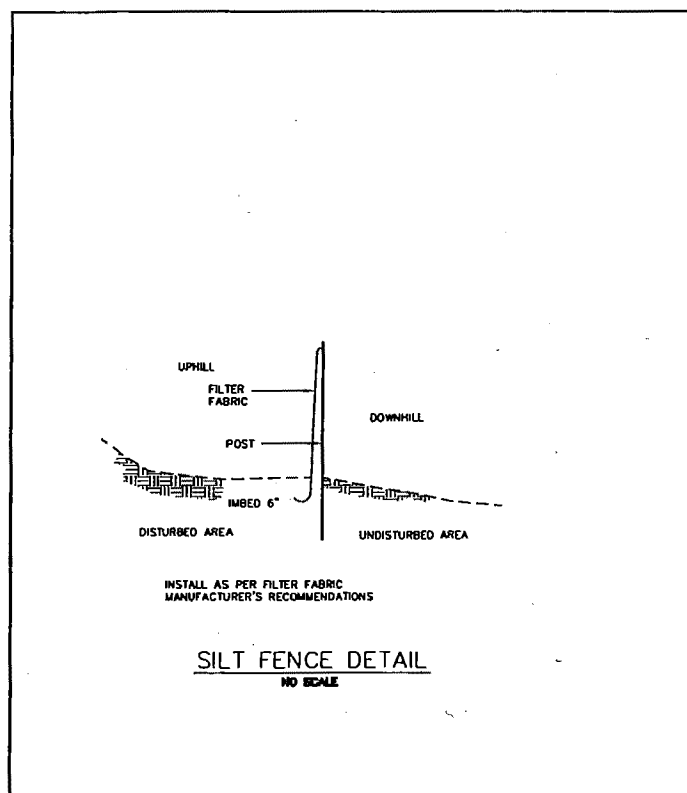

SILT FENCE DETAIL
NO SCALE


APPROVED DATE 2-2005

STANDARD DETAILS
SILT FENCE
CITY PLATE No. ERO-1

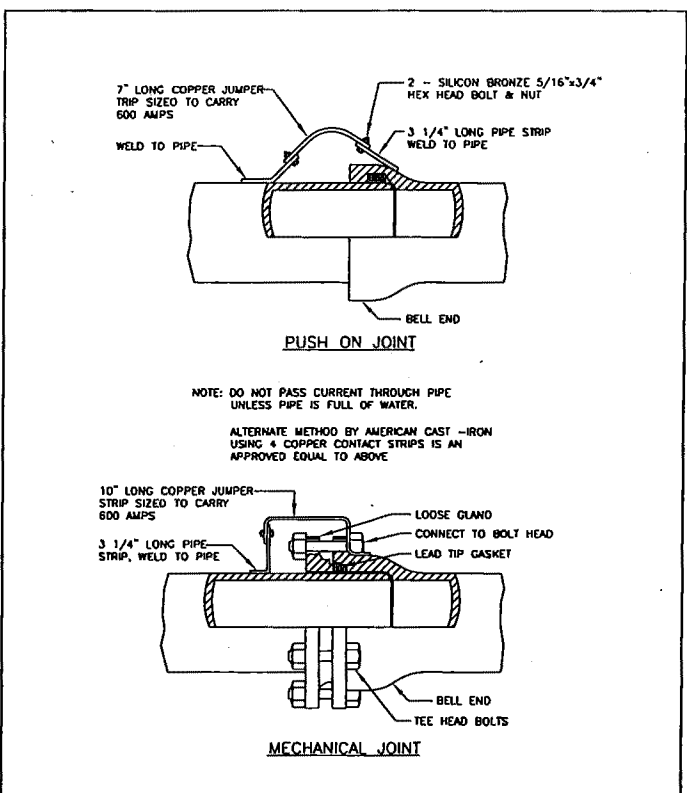

PUSH ON JOINT


NOTE: DO NOT PASS CURRENT THROUGH PIPE UNLESS PIPE IS FULL OF WATER.
ALTERNATE METHOD BY AMERICAN CAST-IRON USING 4 COPPER CONTACT STRIPS IS AN APPROVED EQUAL TO ABOVE.

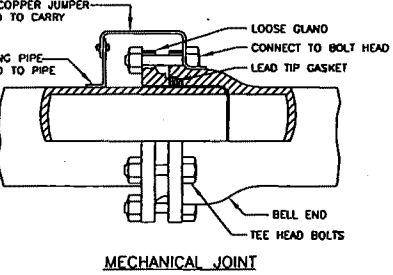

MECHANICAL JOINT

APPROVED DATE 7-93

STANDARD DETAILS
JOINT CONNECTION FOR ELECTRICAL CONDUCTIVITY
CITY PLATE No. WAT-1

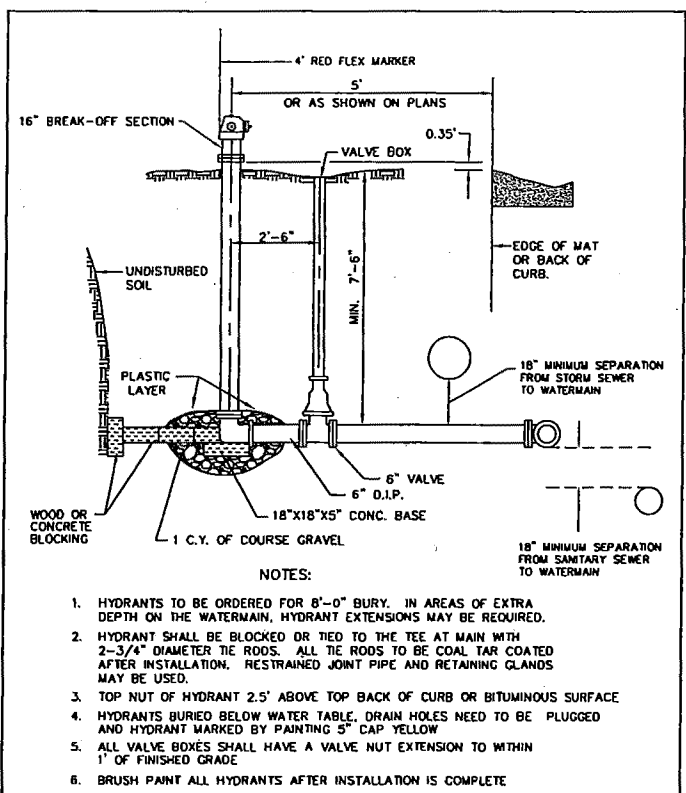


NOTES:

1. HYDRANTS TO BE ORDERED FOR 8'-0" BURY. IN AREAS OF EXTRA DEPTH ON THE WATERMAIN, HYDRANT EXTENSIONS MAY BE REQUIRED.
2. HYDRANT SHALL BE BLOCKED OR TIED TO THE TEE AT MAIN WITH 2-3/4" DIAMETER TIE RODS. ALL TIE RODS TO BE COAL TAR COATED AFTER INSTALLATION. RESTRAINED JOINT PIPE AND RETAINING GLANDS MAY BE USED.
3. TOP NUT OF HYDRANT 2.5' ABOVE TOP BACK OF CURB OR BITUMINOUS SURFACE
4. HYDRANTS BURIED BELOW WATER TABLE. DRAIN HOLES NEED TO BE PLUGGED AND HYDRANT MARKED BY PAINTING 5" CAP YELLOW
5. ALL VALVE BOXES SHALL HAVE A VALVE NUT EXTENSION TO WITHIN 1" OF FINISHED GRADE
6. BRUSH PAINT ALL HYDRANTS AFTER INSTALLATION IS COMPLETE

APPROVED DATE 4-2005


STANDARD DETAILS
HYDRANT
CITY PLATE No. WAT-3

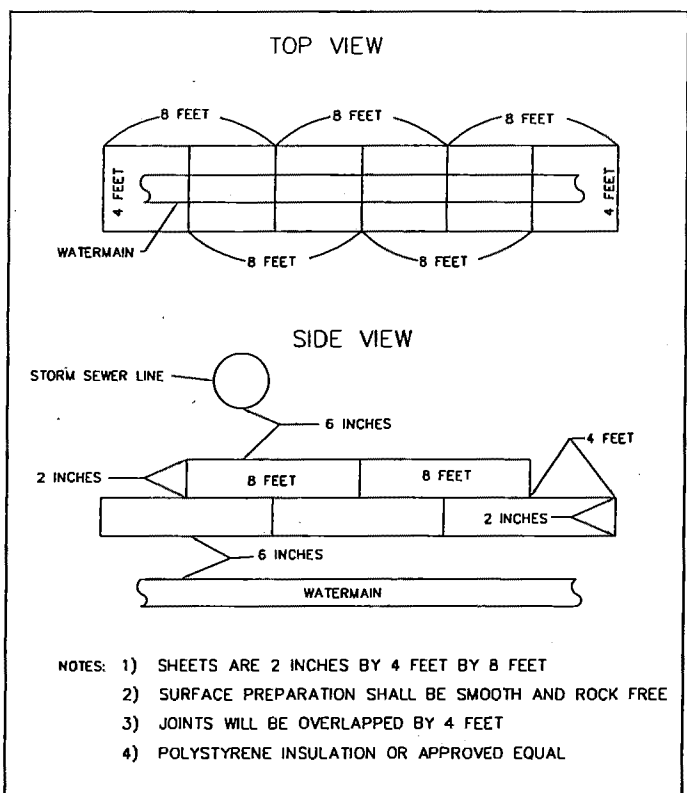

- NOTES:**
- 1) SHEETS ARE 2 INCHES BY 4 FEET BY 8 FEET
 - 2) SURFACE PREPARATION SHALL BE SMOOTH AND ROCK FREE
 - 3) JOINTS WILL BE OVERLAPPED BY 4 FEET
 - 4) POLYSTYRENE INSULATION OR APPROVED EQUAL


APPROVED DATE 4/2004

STANDARD DETAILS
UTILITY INSULATION
CITY PLATE No. WAT-5

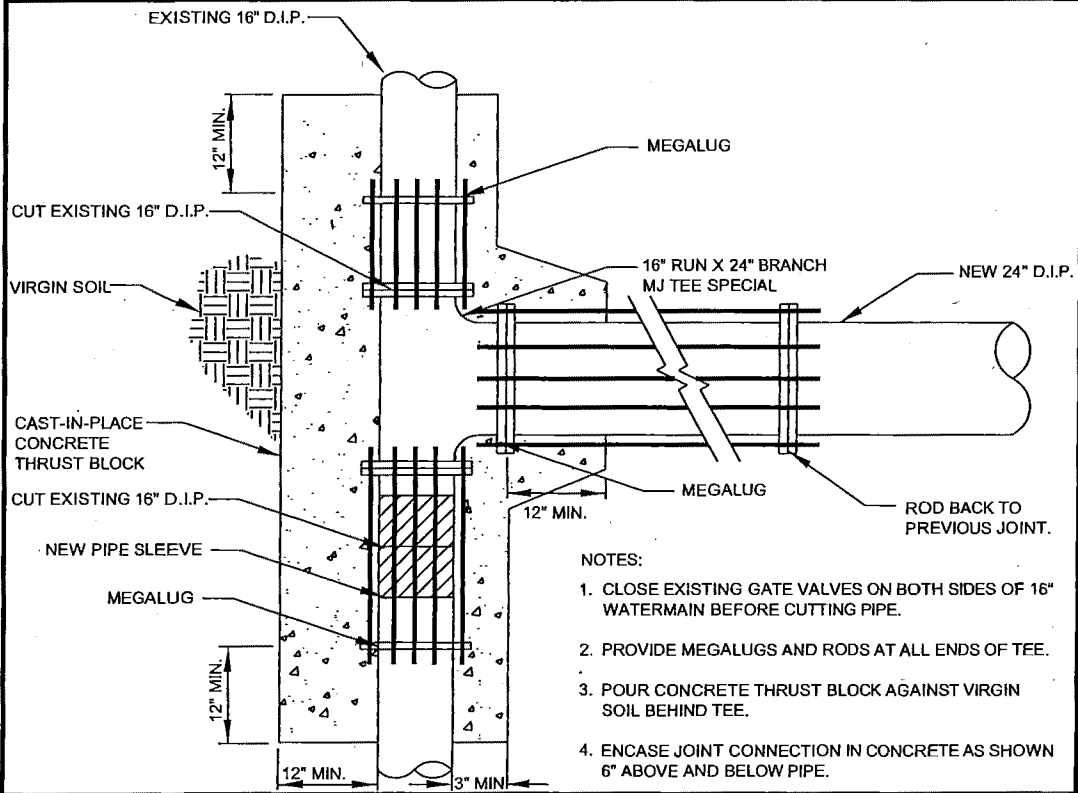

- NOTES:**
1. CLOSE EXISTING GATE VALVES ON BOTH SIDES OF 16" WATERMAIN BEFORE CUTTING PIPE.
 2. PROVIDE MEGALUGS AND RODS AT ALL ENDS OF TEE.
 3. POUR CONCRETE THRUST BLOCK AGAINST VIRGIN SOIL BEHIND TEE.
 4. ENCASE JOINT CONNECTION IN CONCRETE AS SHOWN 6" ABOVE AND BELOW PIPE.

1 WATERMAIN CONNECTION DETAIL NO SCALE

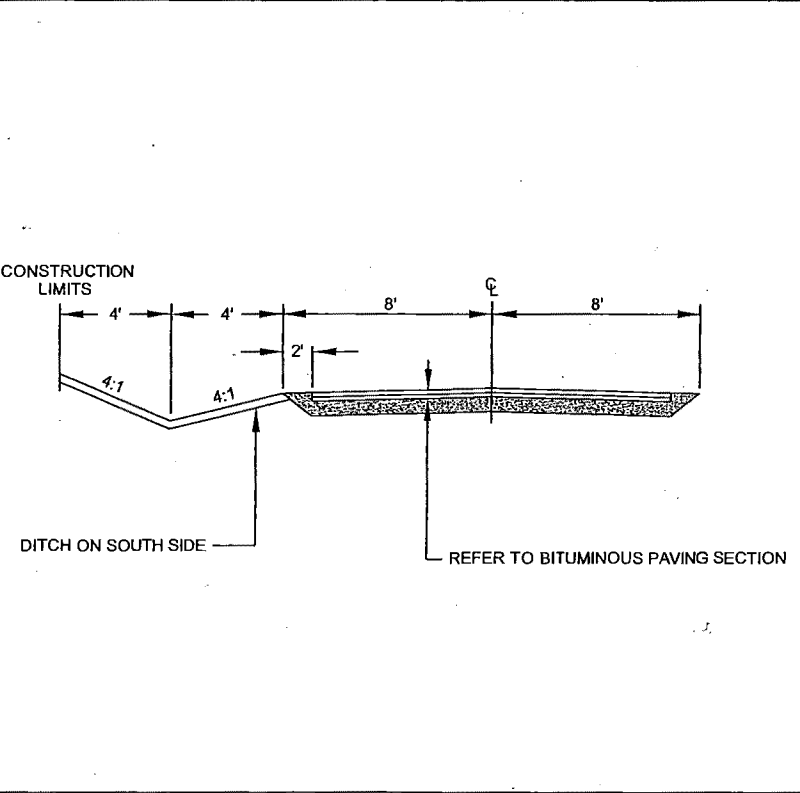

2 DRIVEWAY TYP. CROSS SECTION NO SCALE

C:\p\2006\Project Files\08015 - City of Ramsey 2MG Tower\CAD Drawings\Bld Documents\05/27/09 - 10:31am

PROGRESSIVE CONSULTING ENGINEERS INC.
6120 EARLE BROWN DR. MINNEAPOLIS, MN. 55430
(763)560-9133
FAX: (763)560-0333


ISSUE	DESCRIPTION	DATE	SIGNATURE
B	BID DOCUMENTS	5/22/09	<i>Naveen Qureshi</i>
A	MDH REVIEW SET	2/27/09	
I HEREBY CERTIFY THAT THIS PLAN, SPECIFICATION, OR REPORT WAS PREPARED BY ME OR UNDER MY DIRECT SUPERVISION AND THAT I AM A DULY LICENSED PROFESSIONAL ENGINEER UNDER THE LAWS OF THE STATE OF MINNESOTA.		NAME: NAEEM QURESHI	DATE: 5/22/09
		REG No: 11262	

DESIGNED: BZ
DRAWN: BD
CHECKED: NQ
DATE: 5/22/09

Water Tower No. 3
City of Ramsey, MN


CIVIL DETAILS

JOB NO. 08015
ISSUE B
DRAWING NO. C4

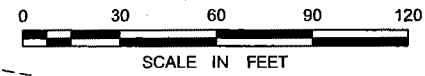

DATUM:
HORIZONTAL = ANOKA COUNTY COORDINATES (1996)
VERTICAL = NAVD 1988


- LEGEND**
- MONUMENT FOUND
 - ⊙ CAST IRON MONUMENT FOUND
 - BENCH MARK
 - △ BIRD FEEDER
 - CONTROL POINT
 - GAS FILL PIPE
 - GAS VALVE
 - SOIL BORING
 - TRAFFIC SIGN
 - TELEPHONE PEDESTAL
 - DECIDUOUS TREE
 - CONIFEROUS TREE
 - NEW BUSHES
 - NEW CONIFEROUS TREE
 - WET LAND
 - WATER VALVE
 - WATER SYSTEM
 - GAS LINE
 - INTERMEDIATE CONTOURS
 - INDEX CONTOURS
 - NEW CONTOURS

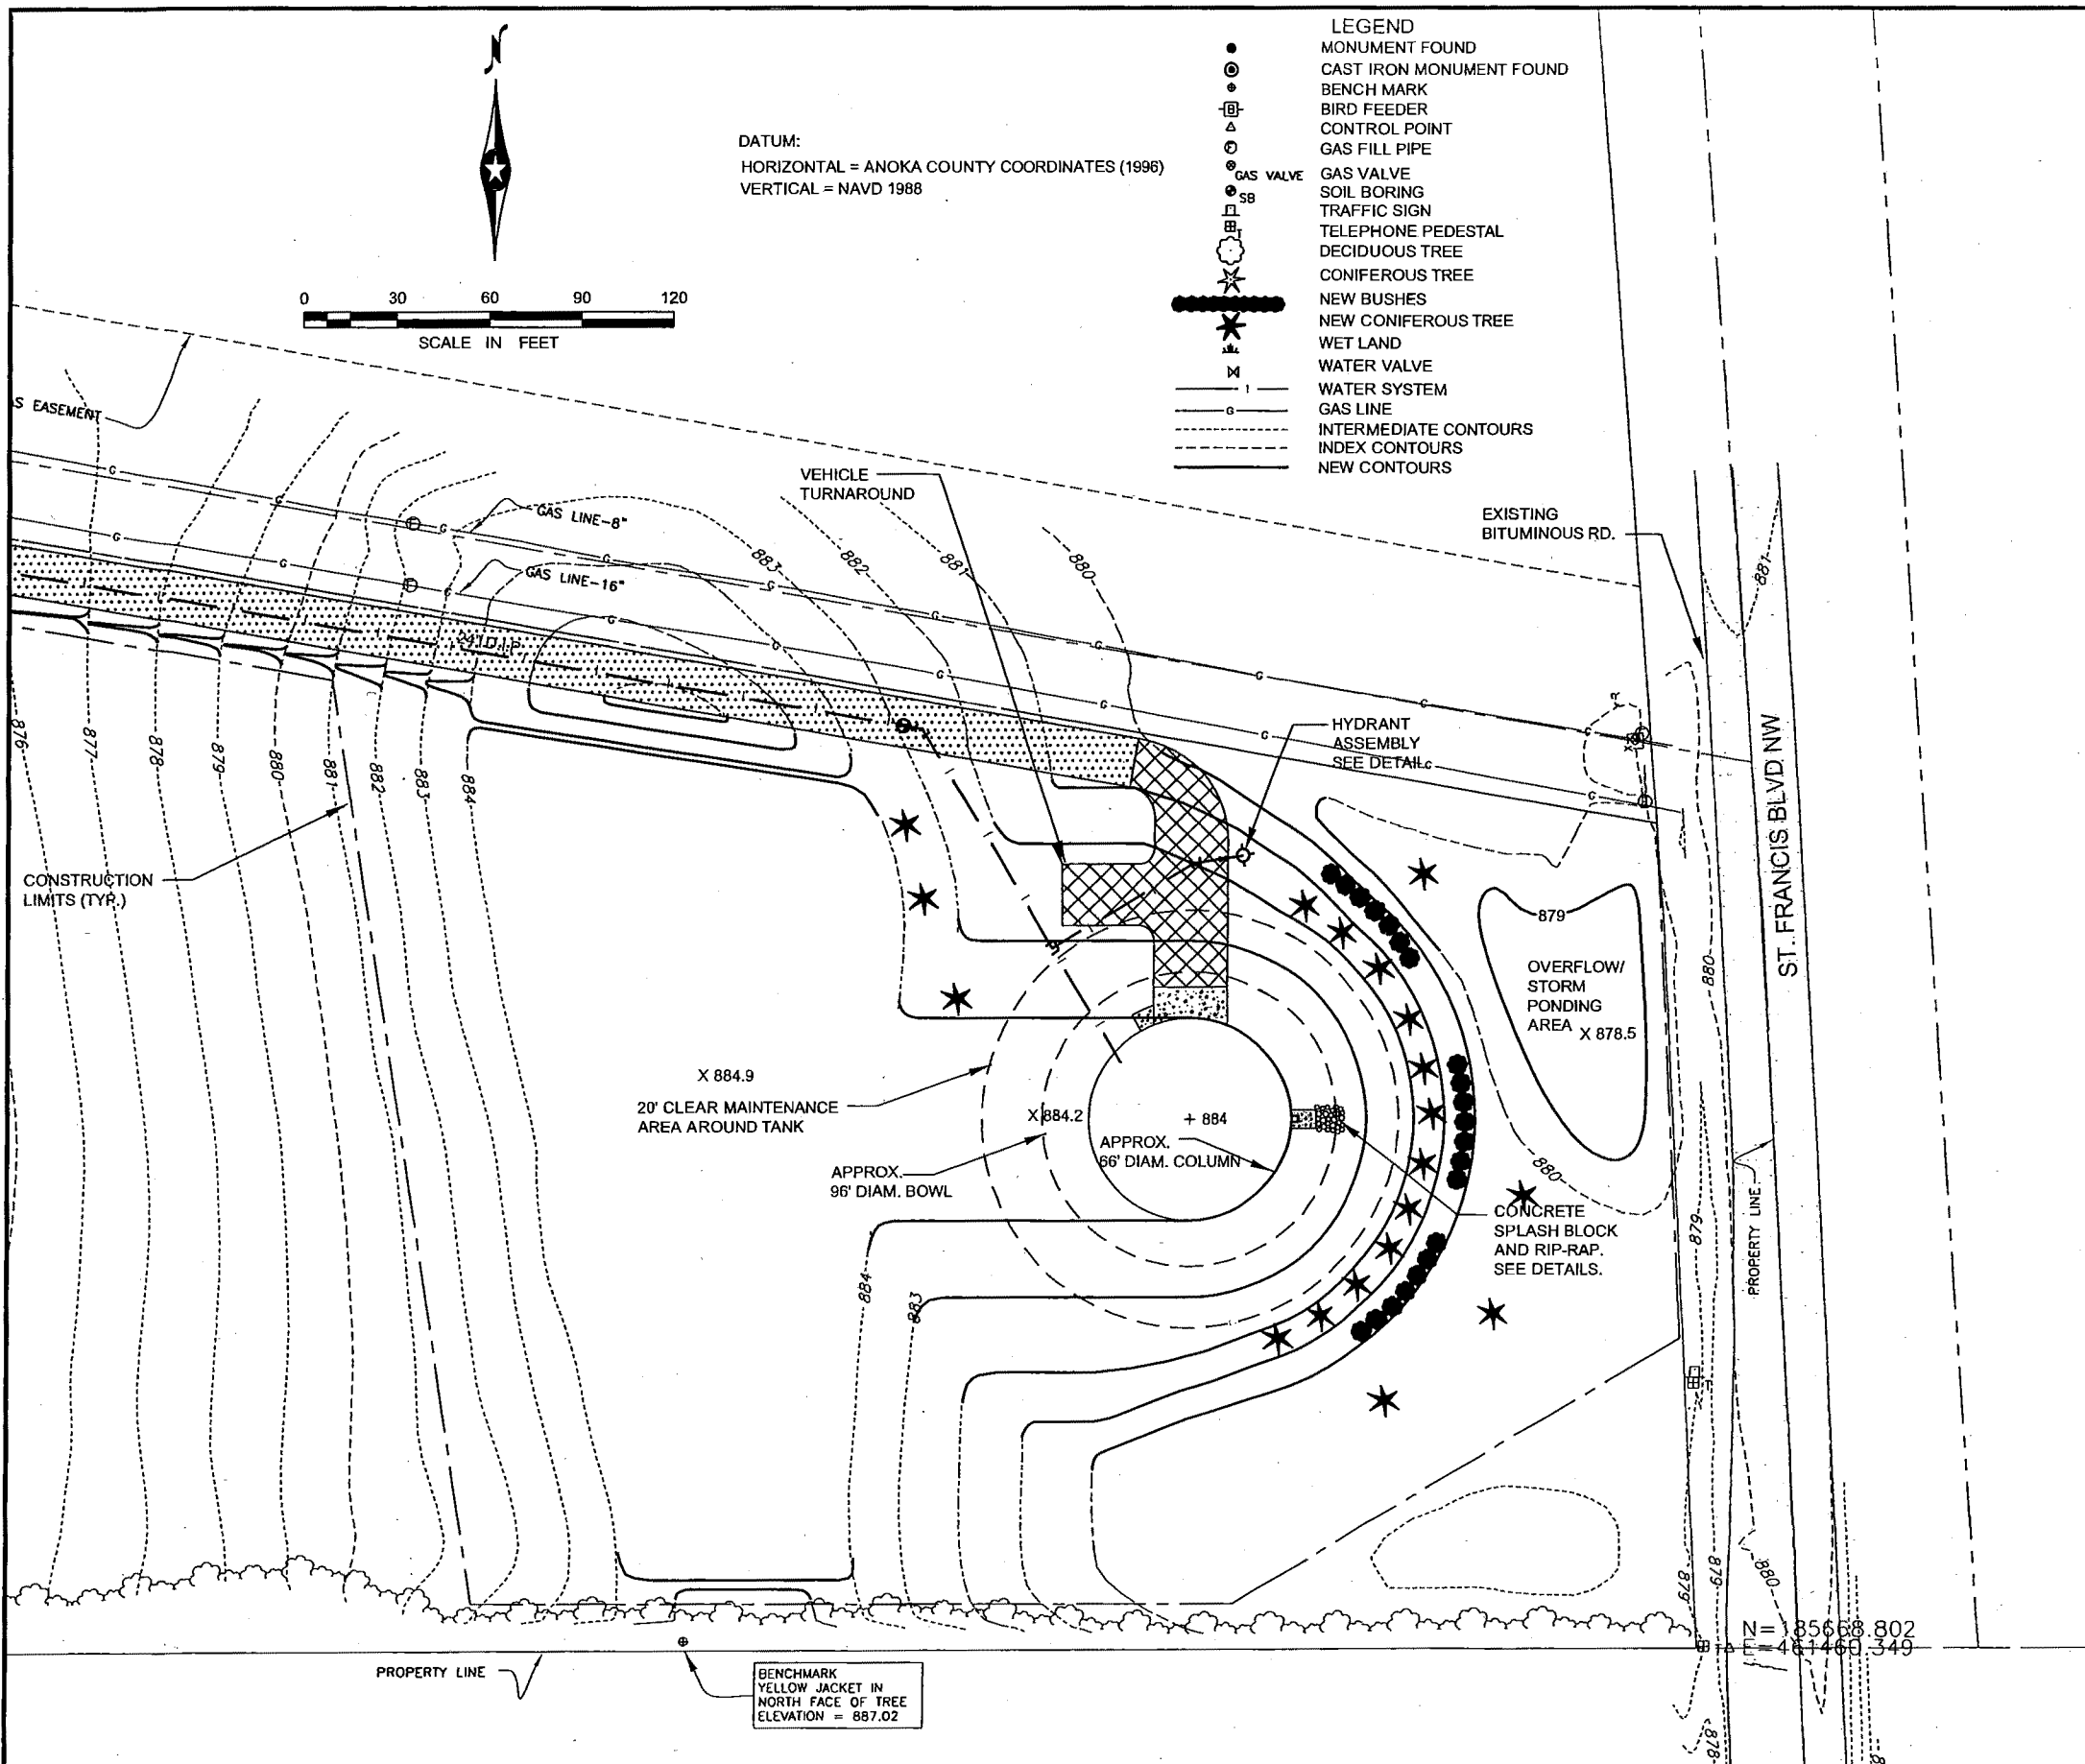


- GENERAL NOTES**
- CONTRACTOR(S) MUST FIELD VERIFY LOCATION AND ELEVATION OF ALL EXISTING UTILITIES WHETHER SHOWN ON THE DRAWING OR NOT. LOCATIONS MUST BE ESTABLISHED IMMEDIATELY PRIOR TO CONSTRUCTION.
 - STATE LAW: 48 HOURS BEFORE EXCAVATING OR DEMOLISHING BUILDINGS, CALL GOPHER STATE ONE CALL AT 800-252-1166 FOR FIELD LOCATION OF UNDERGROUND UTILITY LINES.
 - REFER TO CIVIL SHEETS FOR GRADING AND SEEDING.
 - PROVIDE FOUR INCHES OF MULCH EXTENDING THREE FEET FROM THE TRUNK. KEEP MULCH AWAY FROM THE TRUNK OF THE TREE.
 - ALL LANDSCAPE BEDS AND PLANTINGS TO HAVE DRAINABLE WEED BARRIER AND MULCH WITH CONTRACTOR GRADE EDGING. SEE SPECIFICATIONS.
 - NEW TREES SHALL BE 8' TALL. TREES SHALL BE WHITE SPRUCE, EXCEPT 4 TREES LOCATED EAST OF BUSHES SHALL BE WHITE PINE.
 - BUSHES SHALL BE SUMAC AND DOGWOOD, INTERMIXED. SPACE BUSHES 8' ON CENTER.

THE PLANTING DEPTH OF EACH TREE WILL BE INSPECTED. ANY TREE PLANTED TOO DEEPLY OR WITH FLARE BURIED WILL BE REJECTED.

- ALL TREES TO BE PREMIUM QUALITY, NO "PARK GRADE" TREES ARE PERMITTED.
- AFTER INSTALLATION, TRIM OUT DEADWOOD AND/OR DEFORMED TWIGS. DO NOT CUT LEADER.
- AMENDED SOIL SHALL CONTAIN 5% ORGANIC MATTER BY VOLUME.
- DIAMETER OF HOLE SHALL BE THREE TIMES THE DIAMETER OF THE ROOTBALL OR ROOT MASS.
- ORGANIC MATTER SHALL NOT BE BANKED AGAINST THE STEM OR TRUNK OF THE TREE.
- TREE SHALL NOT BE STAKED UNLESS IT IS ABSOLUTELY NECESSARY TO DO SO.
- ALL TAGS, BANDS AND WIRES SHALL BE REMOVED FROM TREE IMMEDIATELY AFTER PLANTING.
- THE TREE SHALL BE WATERED AS NECESSARY TO PREVENT WILTING AND PROMOTE ROOT GROWTH.
- A PHOTO DEGRADABLE TREE TUBE OR EQUIVALENT SHALL BE INSTALLED AROUND ALL NEWLY PLANTED TREES.
- PULL BURLAP AWAY FROM TREE STEM.
- CUT WIRE AND PULL AWAY FROM TREE STEM.

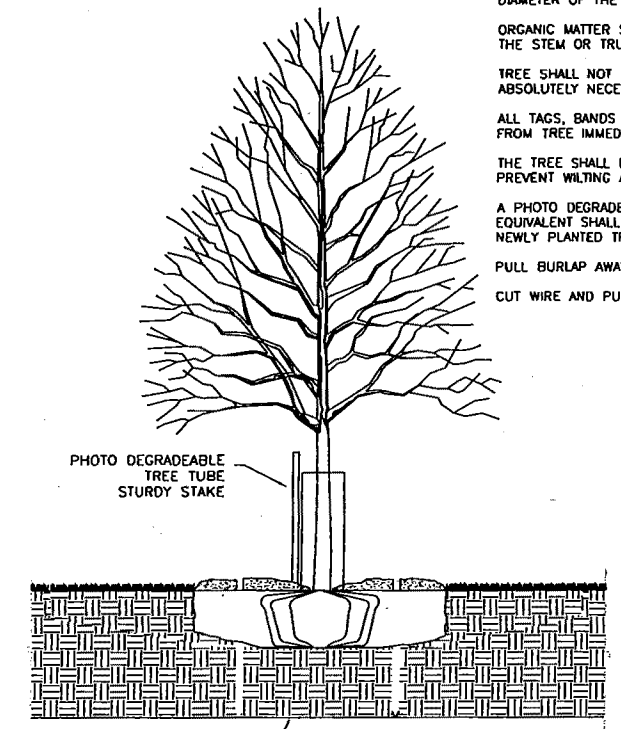

APPROVED
DATE 5-97

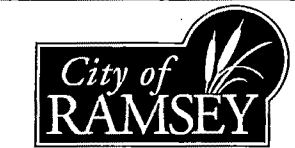

STANDARD DETAILS
TREE PLANTING
DETAIL
CITY PLATE No. PARK-2


L1.dwg P:\2008 Project Files\08015 - City of Ramsey 2MG Tower\CAD Drawings\Bld Documents\05/27/09 - 10:35am

pce PROGRESSIVE CONSULTING ENGINEERS INC.
6120 EARLE BROWN DR. MINNEAPOLIS, MN. 55430
(763)560-9133 FAX:(763)560-0333


ISSUE	DESCRIPTION	DATE
B	BID DOCUMENTS	5/22/09
A	MDH REVIEW SET	2/27/09

I HEREBY CERTIFY THAT THIS PLAN, SPECIFICATION, OR REPORT WAS PREPARED BY ME OR UNDER MY DIRECT SUPERVISION AND THAT I AM A DULY LICENSED PROFESSIONAL ENGINEER UNDER THE LAWS OF THE STATE OF MINNESOTA.
SIGNATURE: *Naem Qureshi*
NAME: NAEEM QURESHI DATE: 5/22/09 REG No: 11262


DESIGNED: BZ	Water Tower No. 3	City of Ramsey	JOB NO. 08015	ISSUE B
DRAWN: BD	LANDSCAPING PLAN		DRAWING NO. L1	
CHECKED: NQ				
DATE: 5/22/09				

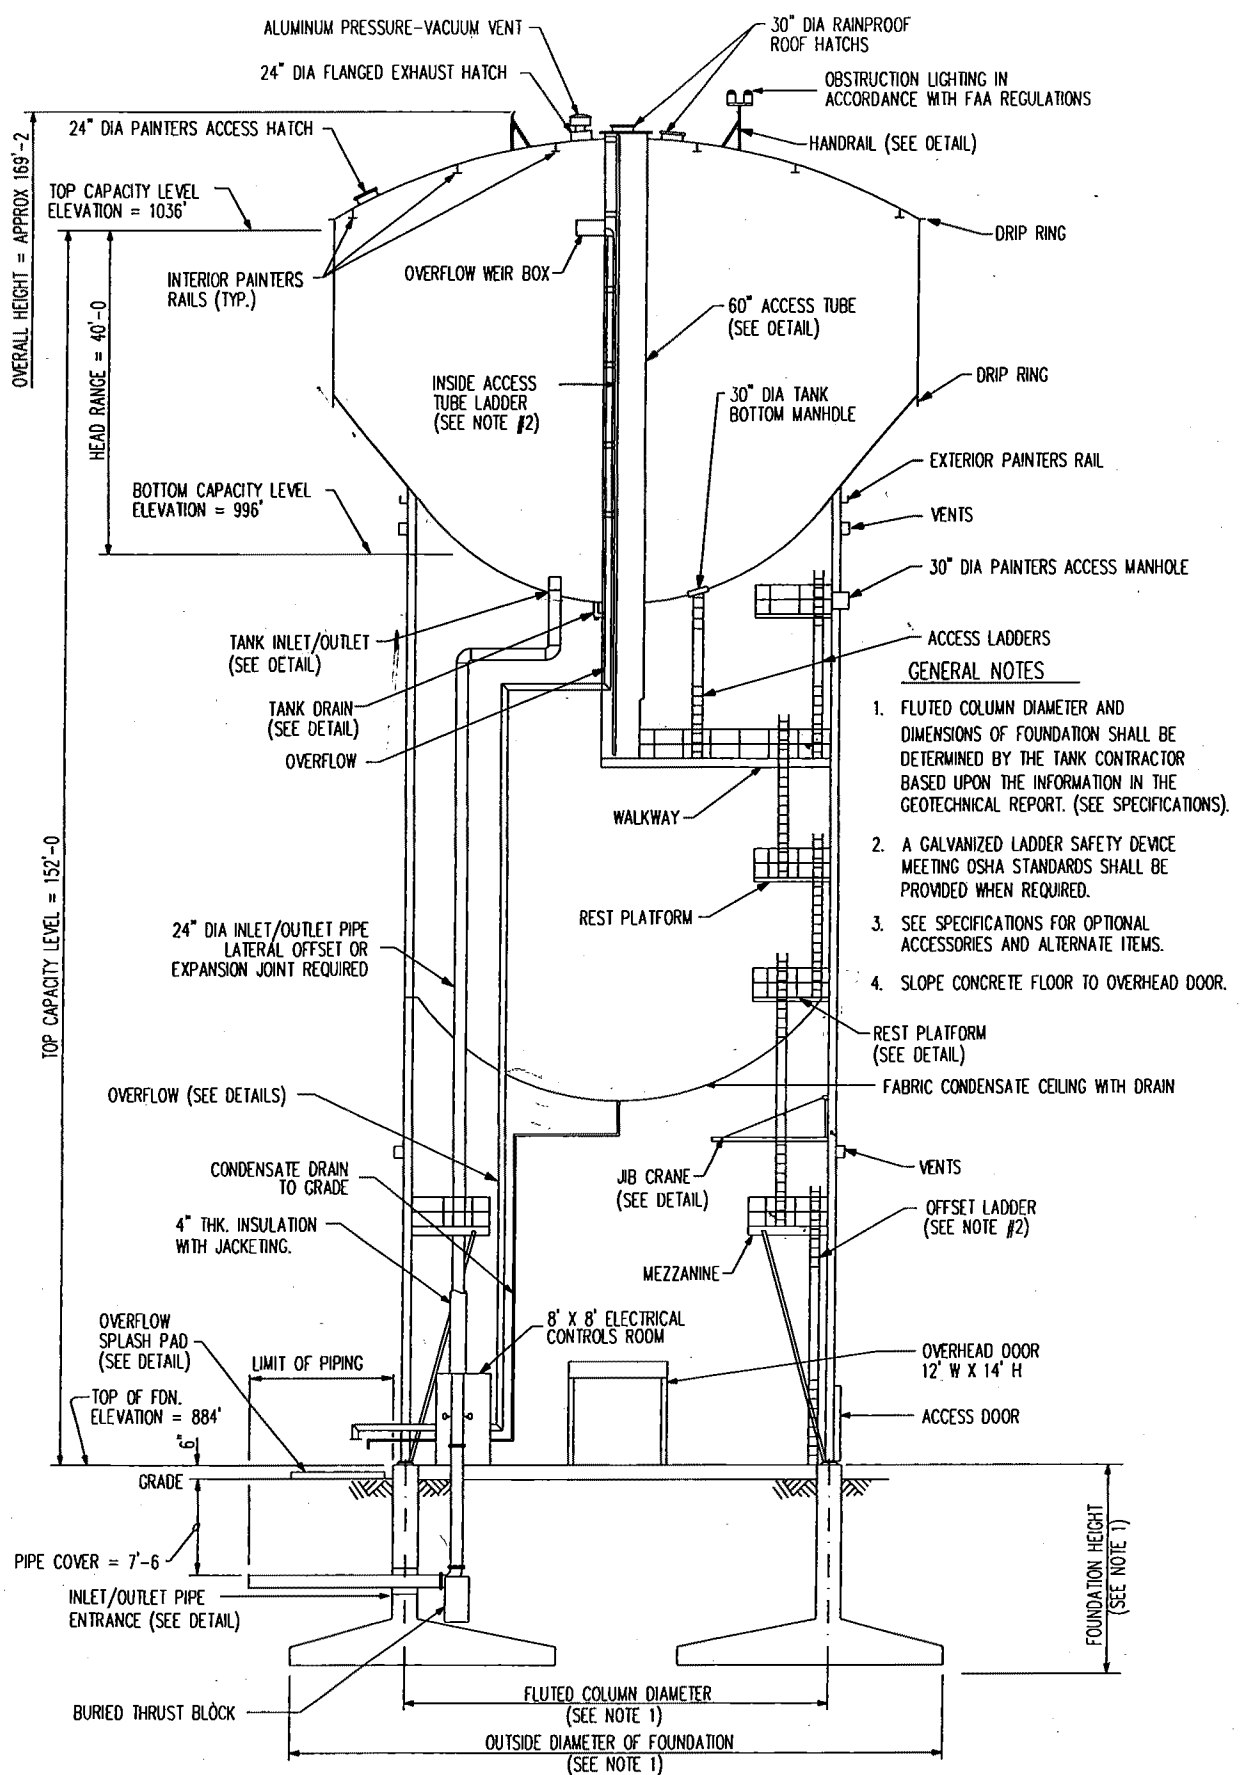

- GENERAL NOTES**
1. FLUTED COLUMN DIAMETER AND DIMENSIONS OF FOUNDATION SHALL BE DETERMINED BY THE TANK CONTRACTOR BASED UPON THE INFORMATION IN THE GEOTECHNICAL REPORT. (SEE SPECIFICATIONS).
 2. A GALVANIZED LADDER SAFETY DEVICE MEETING OSHA STANDARDS SHALL BE PROVIDED WHEN REQUIRED.
 3. SEE SPECIFICATIONS FOR OPTIONAL ACCESSORIES AND ALTERNATE ITEMS.
 4. SLOPE CONCRETE FLOOR TO OVERHEAD DOOR.

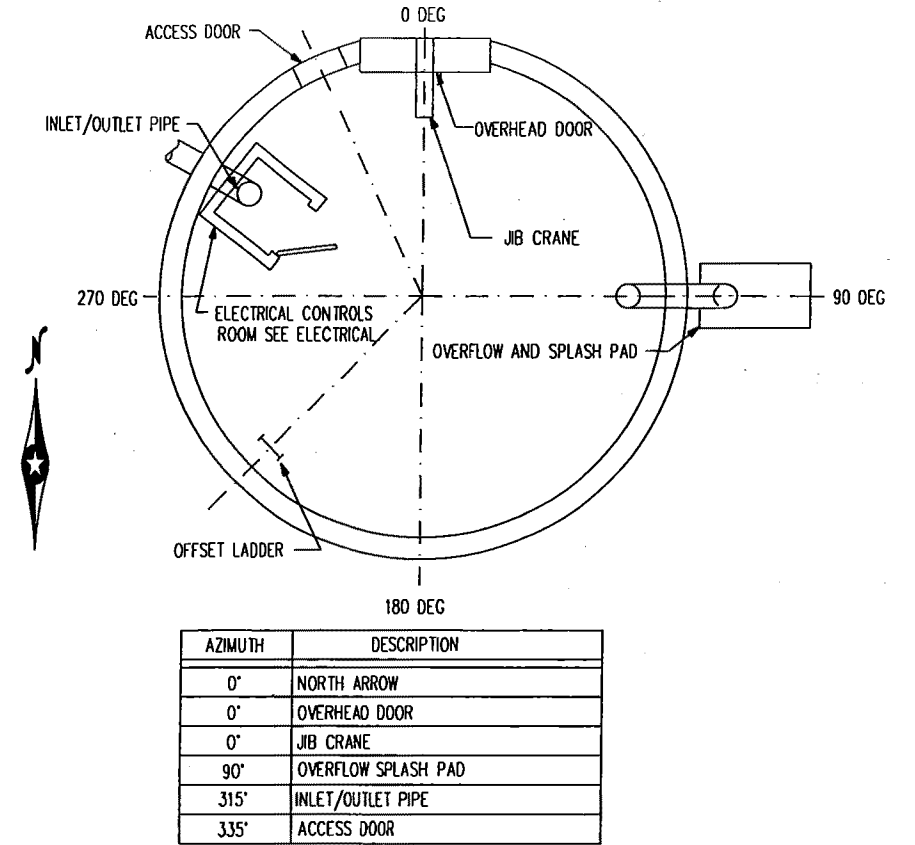



AZIMUTH	DESCRIPTION
0°	NORTH ARROW
0°	OVERHEAD DOOR
0°	JIB CRANE
90°	OVERFLOW SPLASH PAD
315°	INLET/OUTLET PIPE
335°	ACCESS DOOR

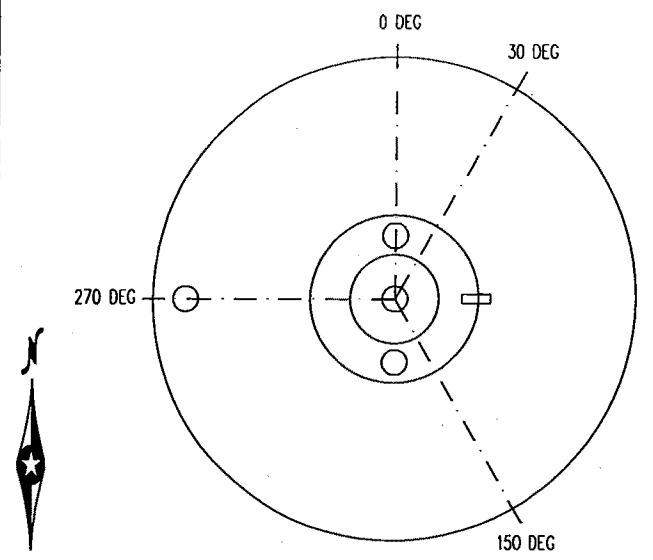

AZIMUTH	DESCRIPTION
0°	NORTH ARROW
30°	LOGO (CENTERED)
150°	LOGO (CENTERED)
270°	LOGO (CENTERED)

2 P1 COLUMN ORIENTATION PLAN NO SCALE

3 P1 ROOF ORIENTATION PLAN NO SCALE

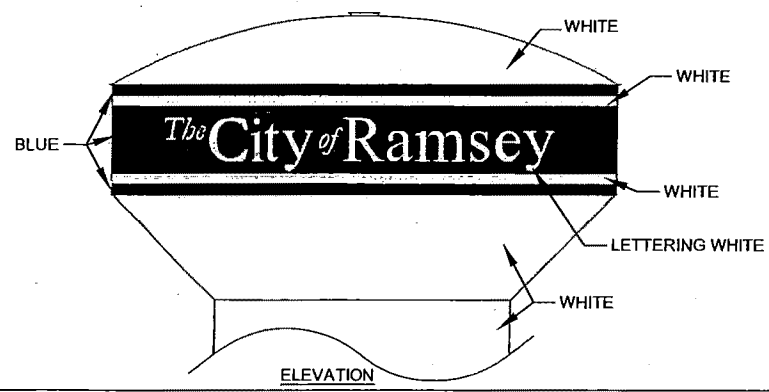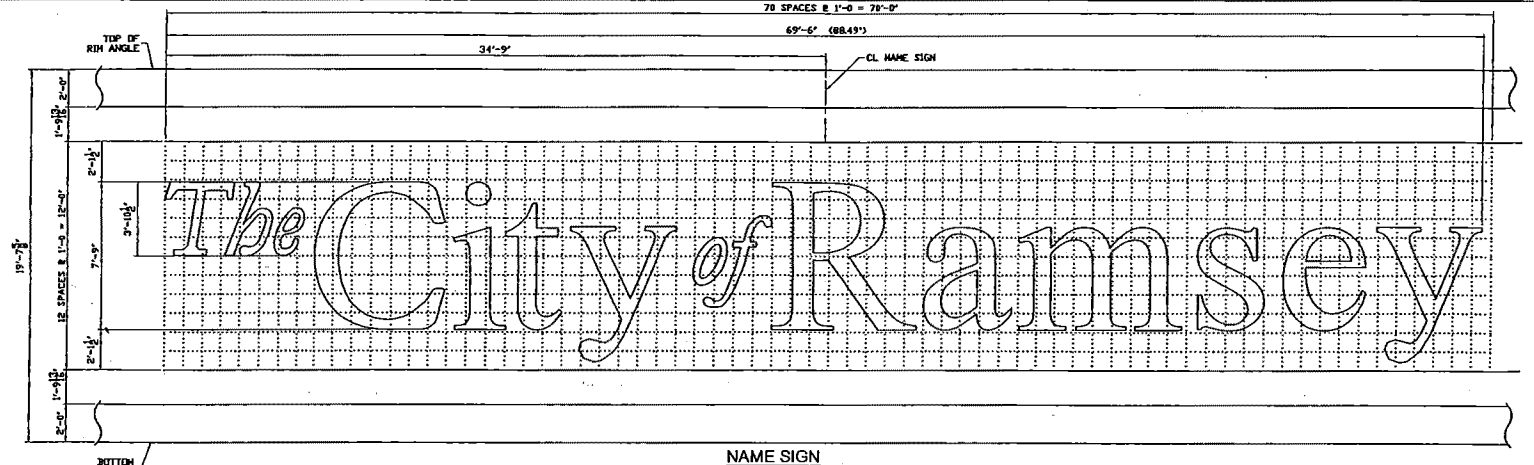

1. REFER TO COATING SCHEDULE IN THE SPECIFICATIONS FOR MATERIALS AND COLORS.

4 P1 LOGO DETAIL NO SCALE

1 P1 TOWER ELEVATION NO SCALE

P:\2008 Project Files\08015 - City of Ramsey 2MG Tower\CAD Drawings\Bid Documents\05/27/09 - 10.360m





pce PROGRESSIVE CONSULTING ENGINEERS INC. (763)560-9133 FAX: (763)560-0333 6120 EARLE BROWN DR. MINNEAPOLIS, MN. 55430

ISSUE	DESCRIPTION	DATE
B	BID DOCUMENTS	5/22/09
A	MDH REVIEW SET	2/27/09

I HEREBY CERTIFY THAT THIS PLAN, SPECIFICATION, OR REPORT WAS PREPARED BY ME OR UNDER MY DIRECT SUPERVISION AND THAT I AM A DULY LICENSED PROFESSIONAL ENGINEER UNDER THE LAWS OF THE STATE OF MINNESOTA.
 SIGNATURE: *Naem Qureshi*
 NAME: NAEEM QURESHI DATE: 5/22/09 REG No. 11282

DESIGNED: BZ
 DRAWN: BD
 CHECKED: NQ
 DATE: 5/22/09

Water Tower No. 3 City of Ramsey, MN
TOWER PLAN
 JOB NO. 08015 ISSUE B
 DRAWING NO. P1

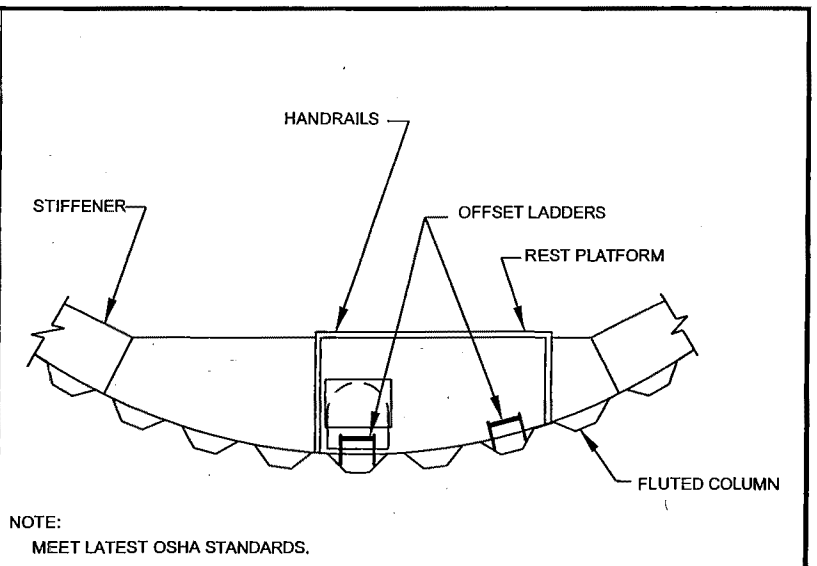
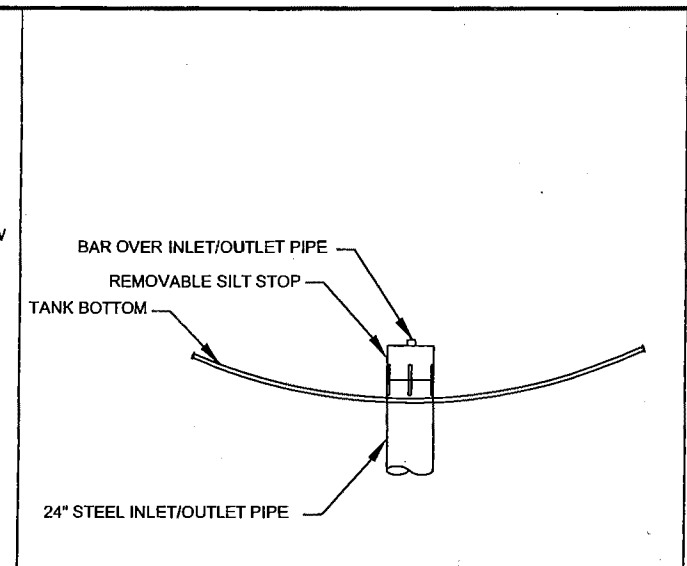
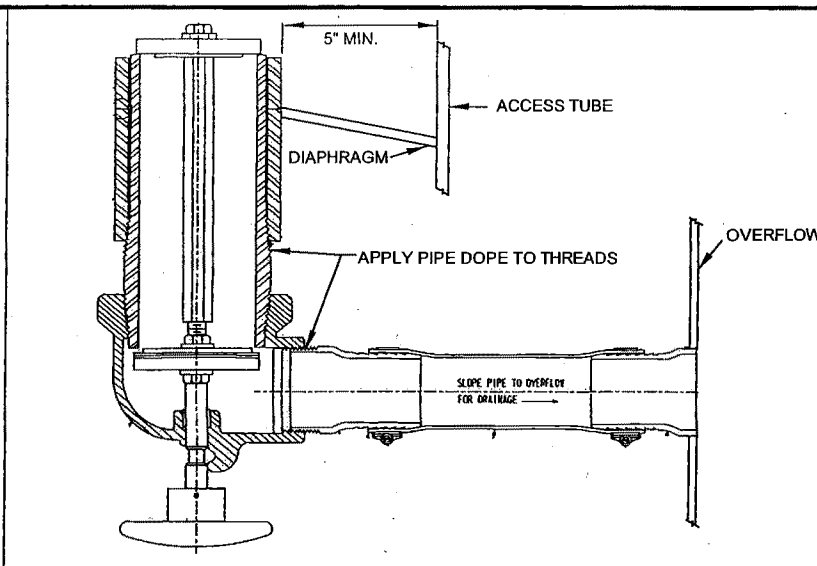
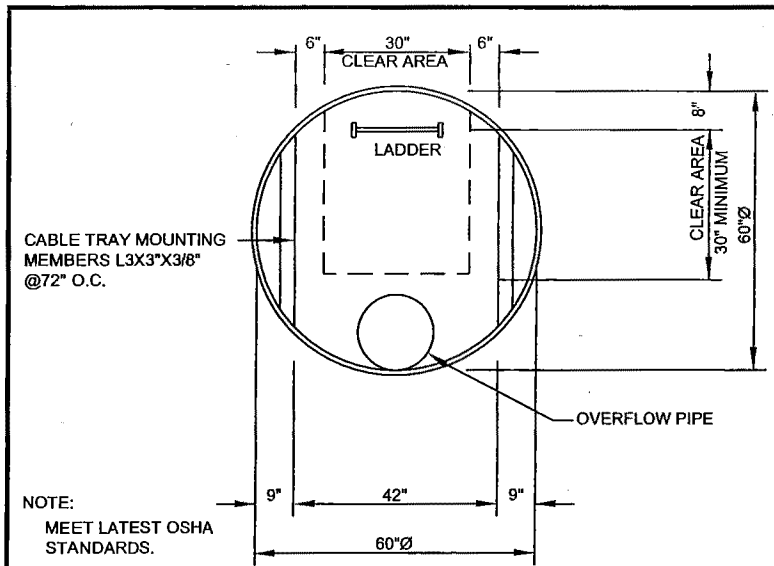


1 P2 ACCESS TUBE SECTION NO SCALE

2 P2 4" DIA. NON FREEZE DRAIN VALVE NO SCALE

3 P2 TANK INLET/OUTLET PIPE NO SCALE

4 P2 TYPICAL OFFSET LADDERS PLATFORMS NO SCALE

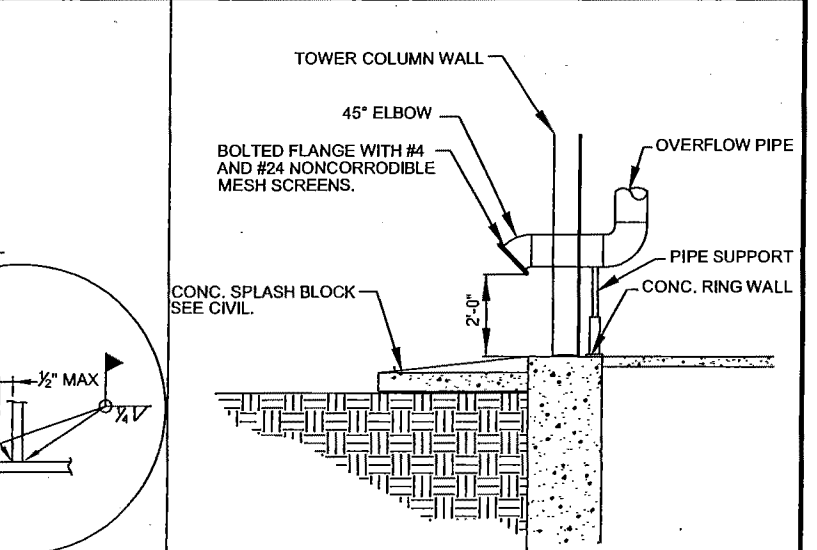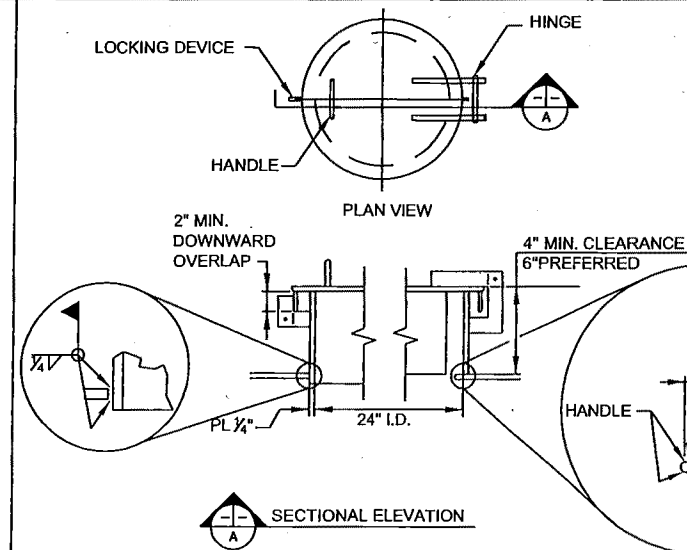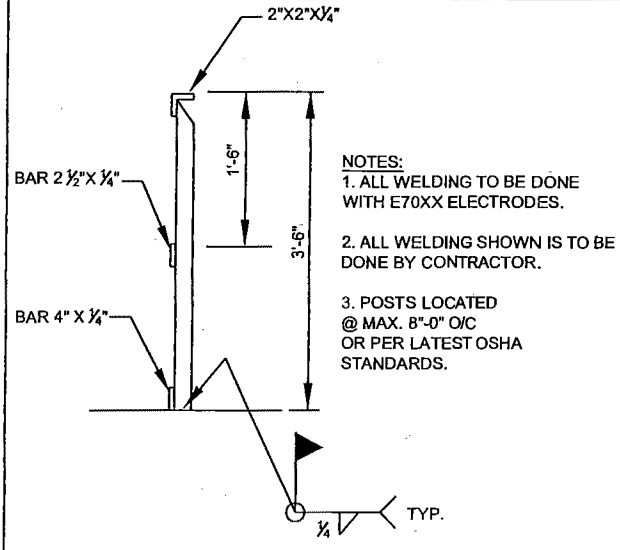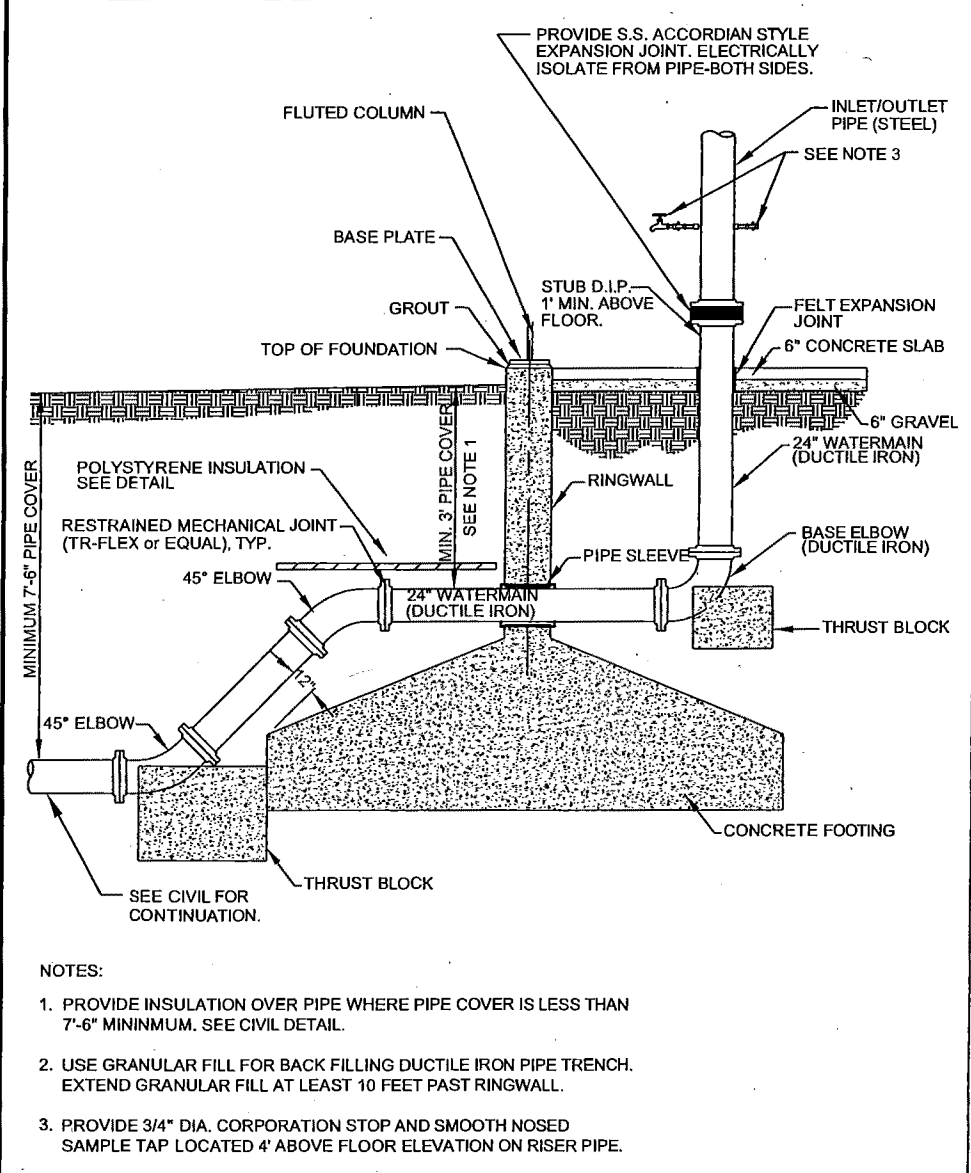

5 P2 INLET/OUTLET PIPE ENTRANCE DETAIL NO SCALE

6 P2 HANDRAIL SECTION NO SCALE

7 P2 ROOF HATCH NO SCALE

8 P2 OVERFLOW SECTION NO SCALE



PROGRESSIVE CONSULTING ENGINEERS INC.
 (763)560-9133
 FAX: (763)560-0333
 5120 EARLE BROWN DR. MINNEAPOLIS, MN. 55430

ISSUE	DESCRIPTION	DATE
B	BID DOCUMENTS	5/22/09
A	MDH REVIEW SET	2/27/09

I HEREBY CERTIFY THAT THIS PLAN, SPECIFICATION, OR REPORT WAS PREPARED BY ME OR UNDER MY DIRECT SUPERVISION AND THAT I AM A DULY LICENSED PROFESSIONAL ENGINEER UNDER THE LAWS OF THE STATE OF MINNESOTA.
 SIGNATURE: *Naem Oureshi*
 NAME: NAEM OURESHI DATE: 5/22/09 REG No. 11262

DESIGNED: BZ	Water Tower No. 3	City of Ramsey, MN	JOB NO. 08015	ISSUE B
DRAWN: BD	TOWER DETAILS			DRAWING NO. P2
CHECKED: NQ				
DATE: 5/22/09				

P2.dwg
 P:\2008 Project Files\08015 - City of Ramsey 2MG Tower\CAD Drawings\Bid Documents\05/27/09 - 10:37am

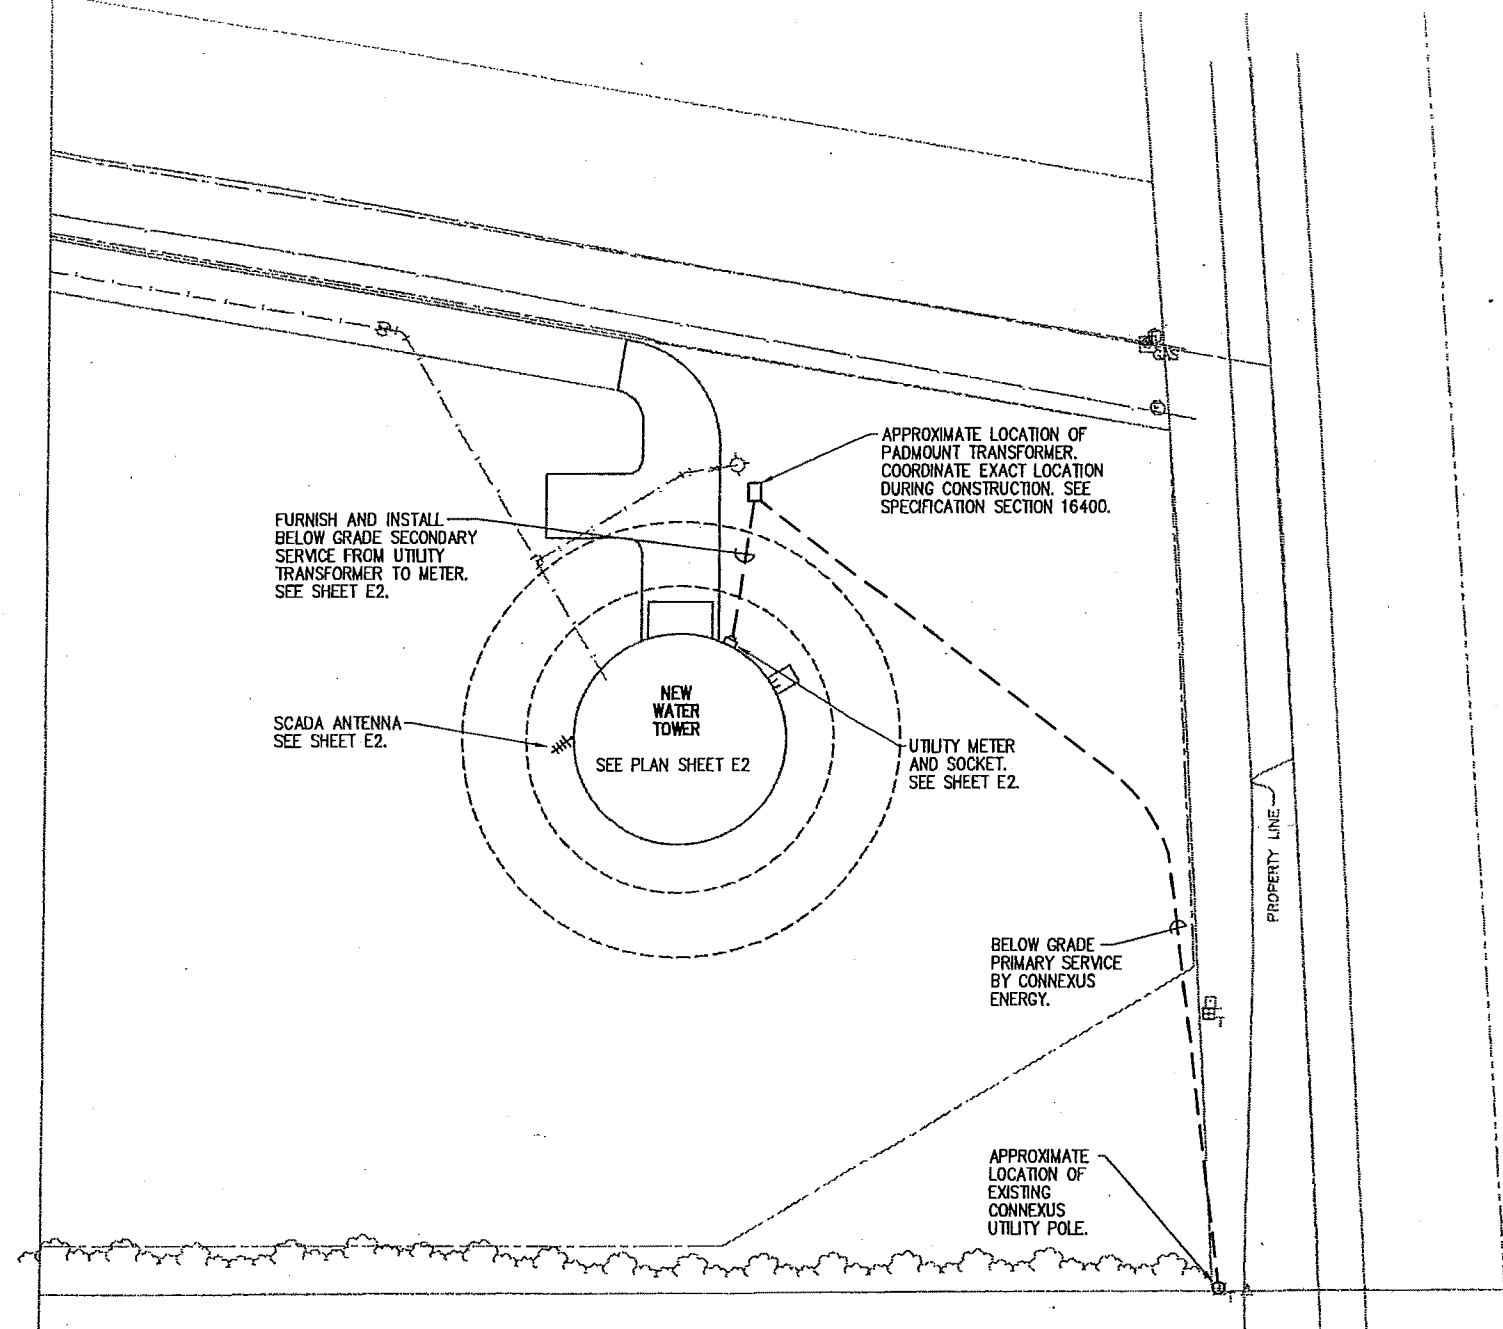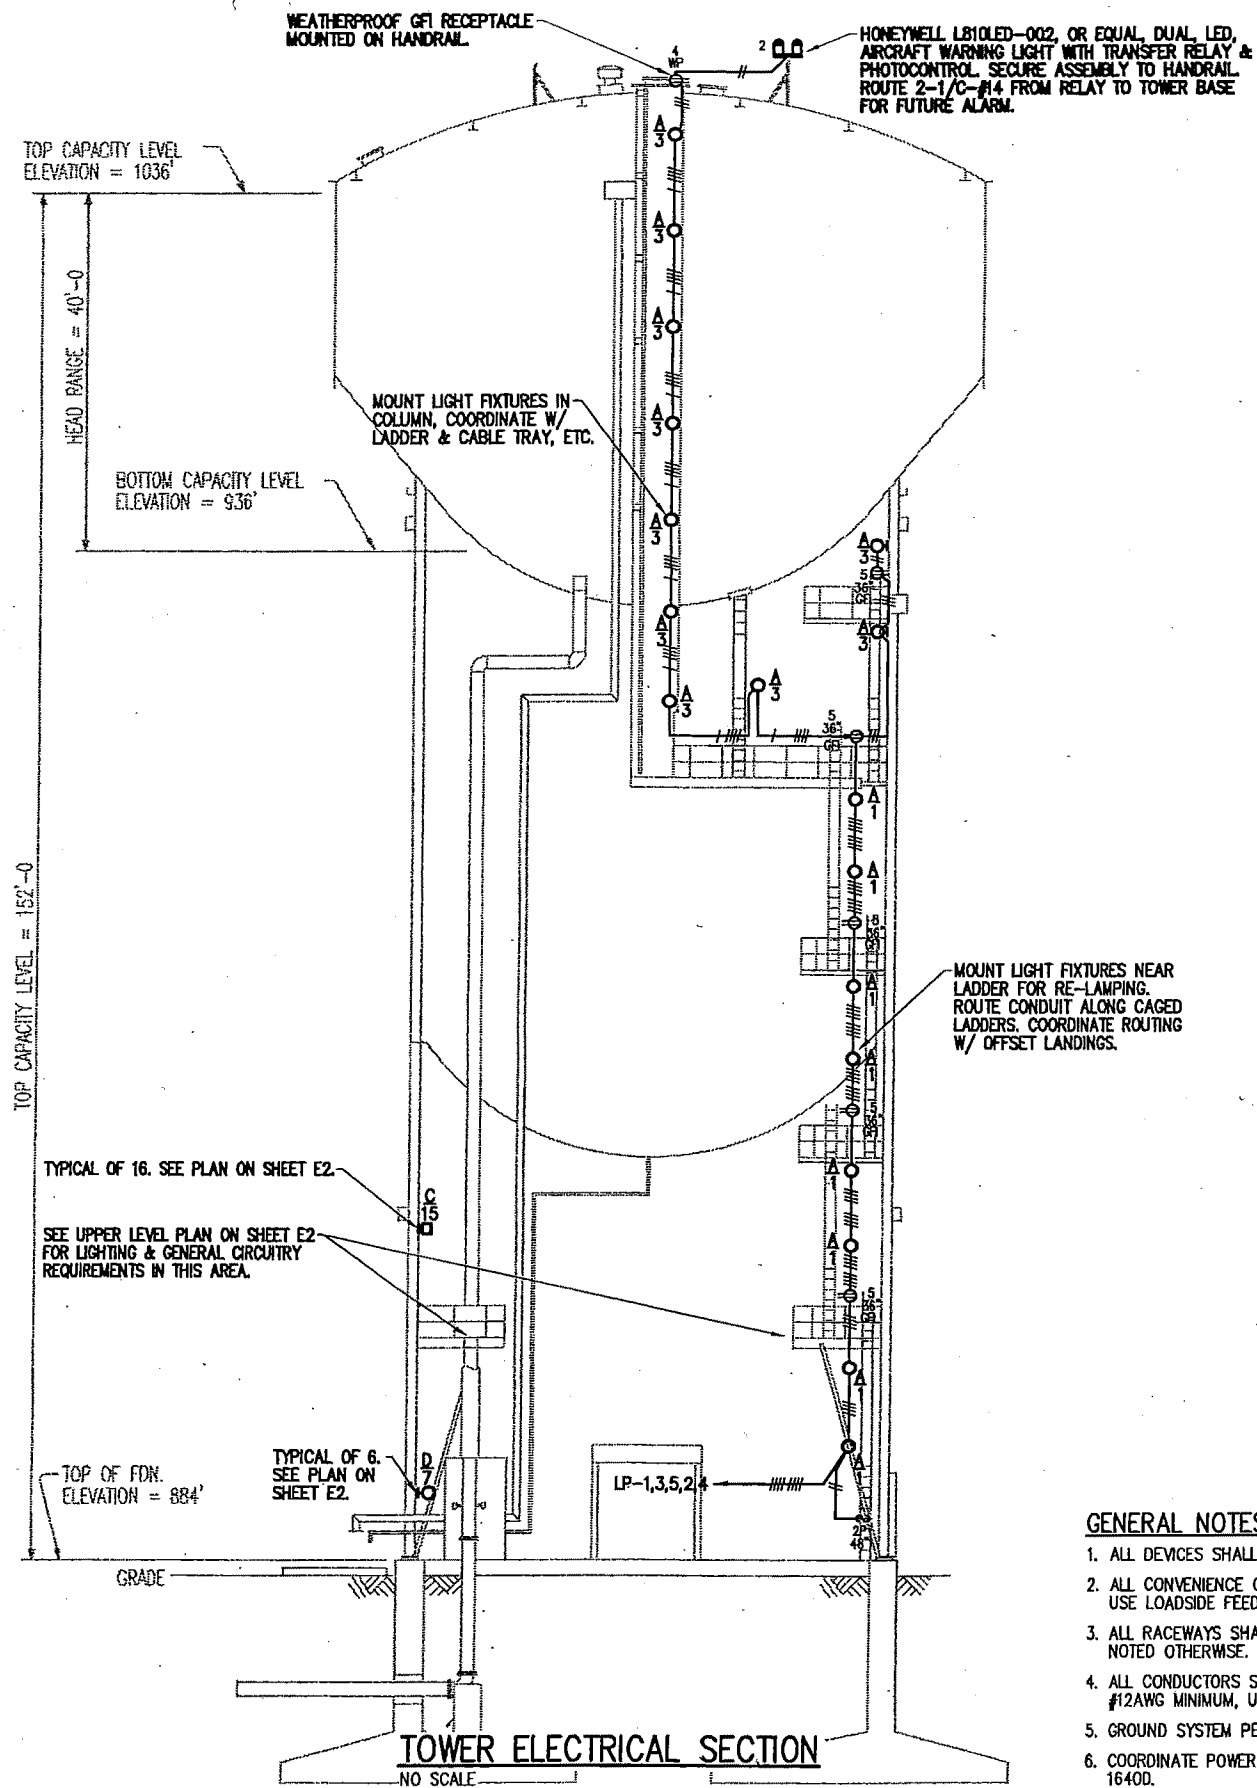

North
ELECTRICAL SITE PLAN
 SCALE: 1"=30'
 0 30 60
 SCALE IN FEET

- GENERAL NOTES**
1. ALL DEVICES SHALL HAVE WEATHERPROOF COVER PLATES.
 2. ALL CONVENIENCE OUTLETS SHALL BE DUPLEX GFI. DO NOT USE LOADSIDE FEED-THRU FEATURE.
 3. ALL RACEWAYS SHALL BE GALVANIZED RIGID STEEL, UNLESS NOTED OTHERWISE.
 4. ALL CONDUCTORS SHALL BE COPPER W/ THWN INSULATION, #12AWG MINIMUM, UNLESS NOTED OTHERWISE.
 5. GROUND SYSTEM PER NEC ARTICLE 250.
 6. COORDINATE POWER SERVICE W/ UTILITY. SEE SPEC. SECTION 16400.

NOTE: CONFIRM LAYOUT & ORIENTATION WITH OWNER AND ENGINEER DURING CONSTRUCTION.

NOTE: CONTRACTOR SHALL ARRANGE TO HAVE ALL EXISTING UNDERGROUND UTILITIES LOCATED. CONTRACTOR SHALL BE RESPONSIBLE FOR REPAIR OF ALL DAMAGES DUE TO WORK UNDER THIS CONTRACT.

NOTE: COORDINATE CONDUIT ROUTING & ELECTRICAL WORK W/ GENERAL CONSTRUCTION PLANS & OTHER CONTRACTORS.

pce PROGRESSIVE CONSULTING ENGINEERS INC.
 (763)580-9133 FAX: (763)580-0333
 6120 EARLE BROWN DR. MINNEAPOLIS, MN. 55430

B	BID DOCUMENT	5/22/09
A	MDH REVIEW SET	2/27/09
ISSUE	DESCRIPTION	DATE

I HEREBY CERTIFY THAT THIS PLAN, SPECIFICATION, OR REPORT WAS PREPARED BY ME OR UNDER MY DIRECT SUPERVISION AND THAT I AM A DULY LICENSED PROFESSIONAL ENGINEER UNDER THE LAWS OF THE STATE OF MINNESOTA.

SIGNATURE: *Stuart S. Stephens*
 NAME: STUART S. STEPHENS DATE: 5/22/09 REG No: 25763


DESIGNED: SSS
 DRAWN: CML
 CHECKED: SSS
 DATE: 5/22/09

2MG Water Tower No. 3 City of Ramsey, MN

TOWER ELECTRICAL SECTION AND SITE PLAN

JOB NO.	ISSUE
08015	B
DRAWING NO.	E1

001
002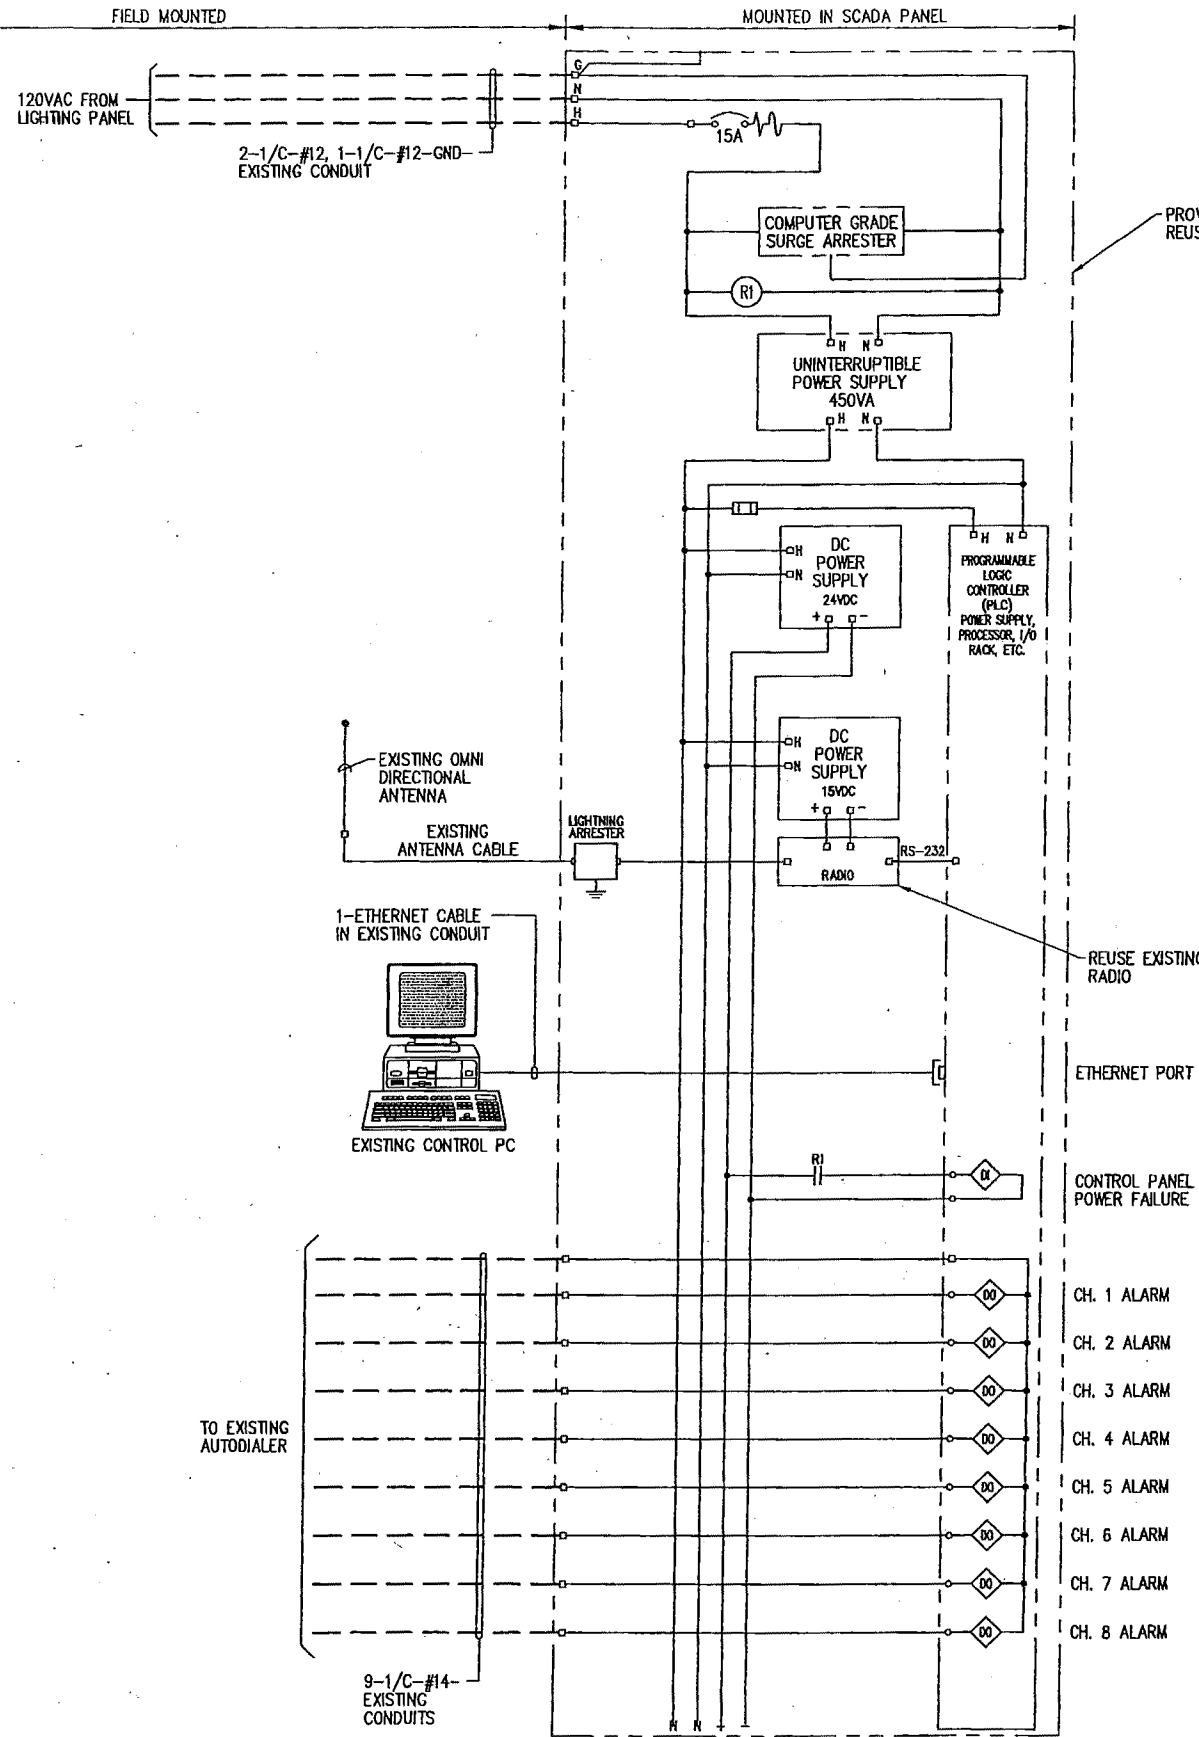
PROVIDE NEW BACKPLANE, REUSE EXISTING ENCLOSURE

REUSE EXISTING RADIO

ETHERNET PORT

CONTROL PANEL POWER FAILURE

CH. 1 ALARM
CH. 2 ALARM
CH. 3 ALARM
CH. 4 ALARM
CH. 5 ALARM
CH. 6 ALARM
CH. 7 ALARM
CH. 8 ALARM

CONTROL PANEL GENERAL NOTES

1. MODIFY SCHEMATIC AS REQUIRED FOR UL508 LABEL AT NO ADDITIONAL COST TO OWNER. SEE SPECIFICATION SECTION 16950.
2. ORGANIZE AND LACE ALL WIRING USING NYLON CABLE TIES.
3. REUSE EXISTING CONDUITS.
4. FURNISH AND INSTALL PANEL COMPONENTS ON A NEW BACKPLANE. DISCONNECT AND REMOVE OLD COMPONENTS FROM EXISTING PANEL AND REUSE EXISTING ENCLOSURE.


SCADA PANEL SCHEMATIC
NO SCALE

pce PROGRESSIVE CONSULTING ENGINEERS INC.
 (763)560-9133 FAX: (763)560-0333
 6120 EARLE BROWN DR. MINNEAPOLIS, MN. 55430

B	BID DOCUMENT	5/22/09
A	MDH REVIEW SET	2/27/09
ISSUE	DESCRIPTION	DATE


I HEREBY CERTIFY THAT THIS PLAN, SPECIFICATION, OR REPORT WAS PREPARED BY ME OR UNDER MY DIRECT SUPERVISION AND THAT I AM A DULY LICENSED PROFESSIONAL ENGINEER UNDER THE LAWS OF THE STATE OF MINNESOTA.
 SIGNATURE: *Stuart S. Stephens*
 NAME: STUART S. STEPHENS DATE: 5/22/09 REG No: 25753

DESIGNED: SSS	2MG Water Tower No. 3	City of Ramsey, MN	JOB NO. 08015	ISSUE B
DRAWN: CML	MASTER SCADA PANEL SCHEMATIC		DRAWING NO. E5	
CHECKED: SSS			DATE: 5/22/09	

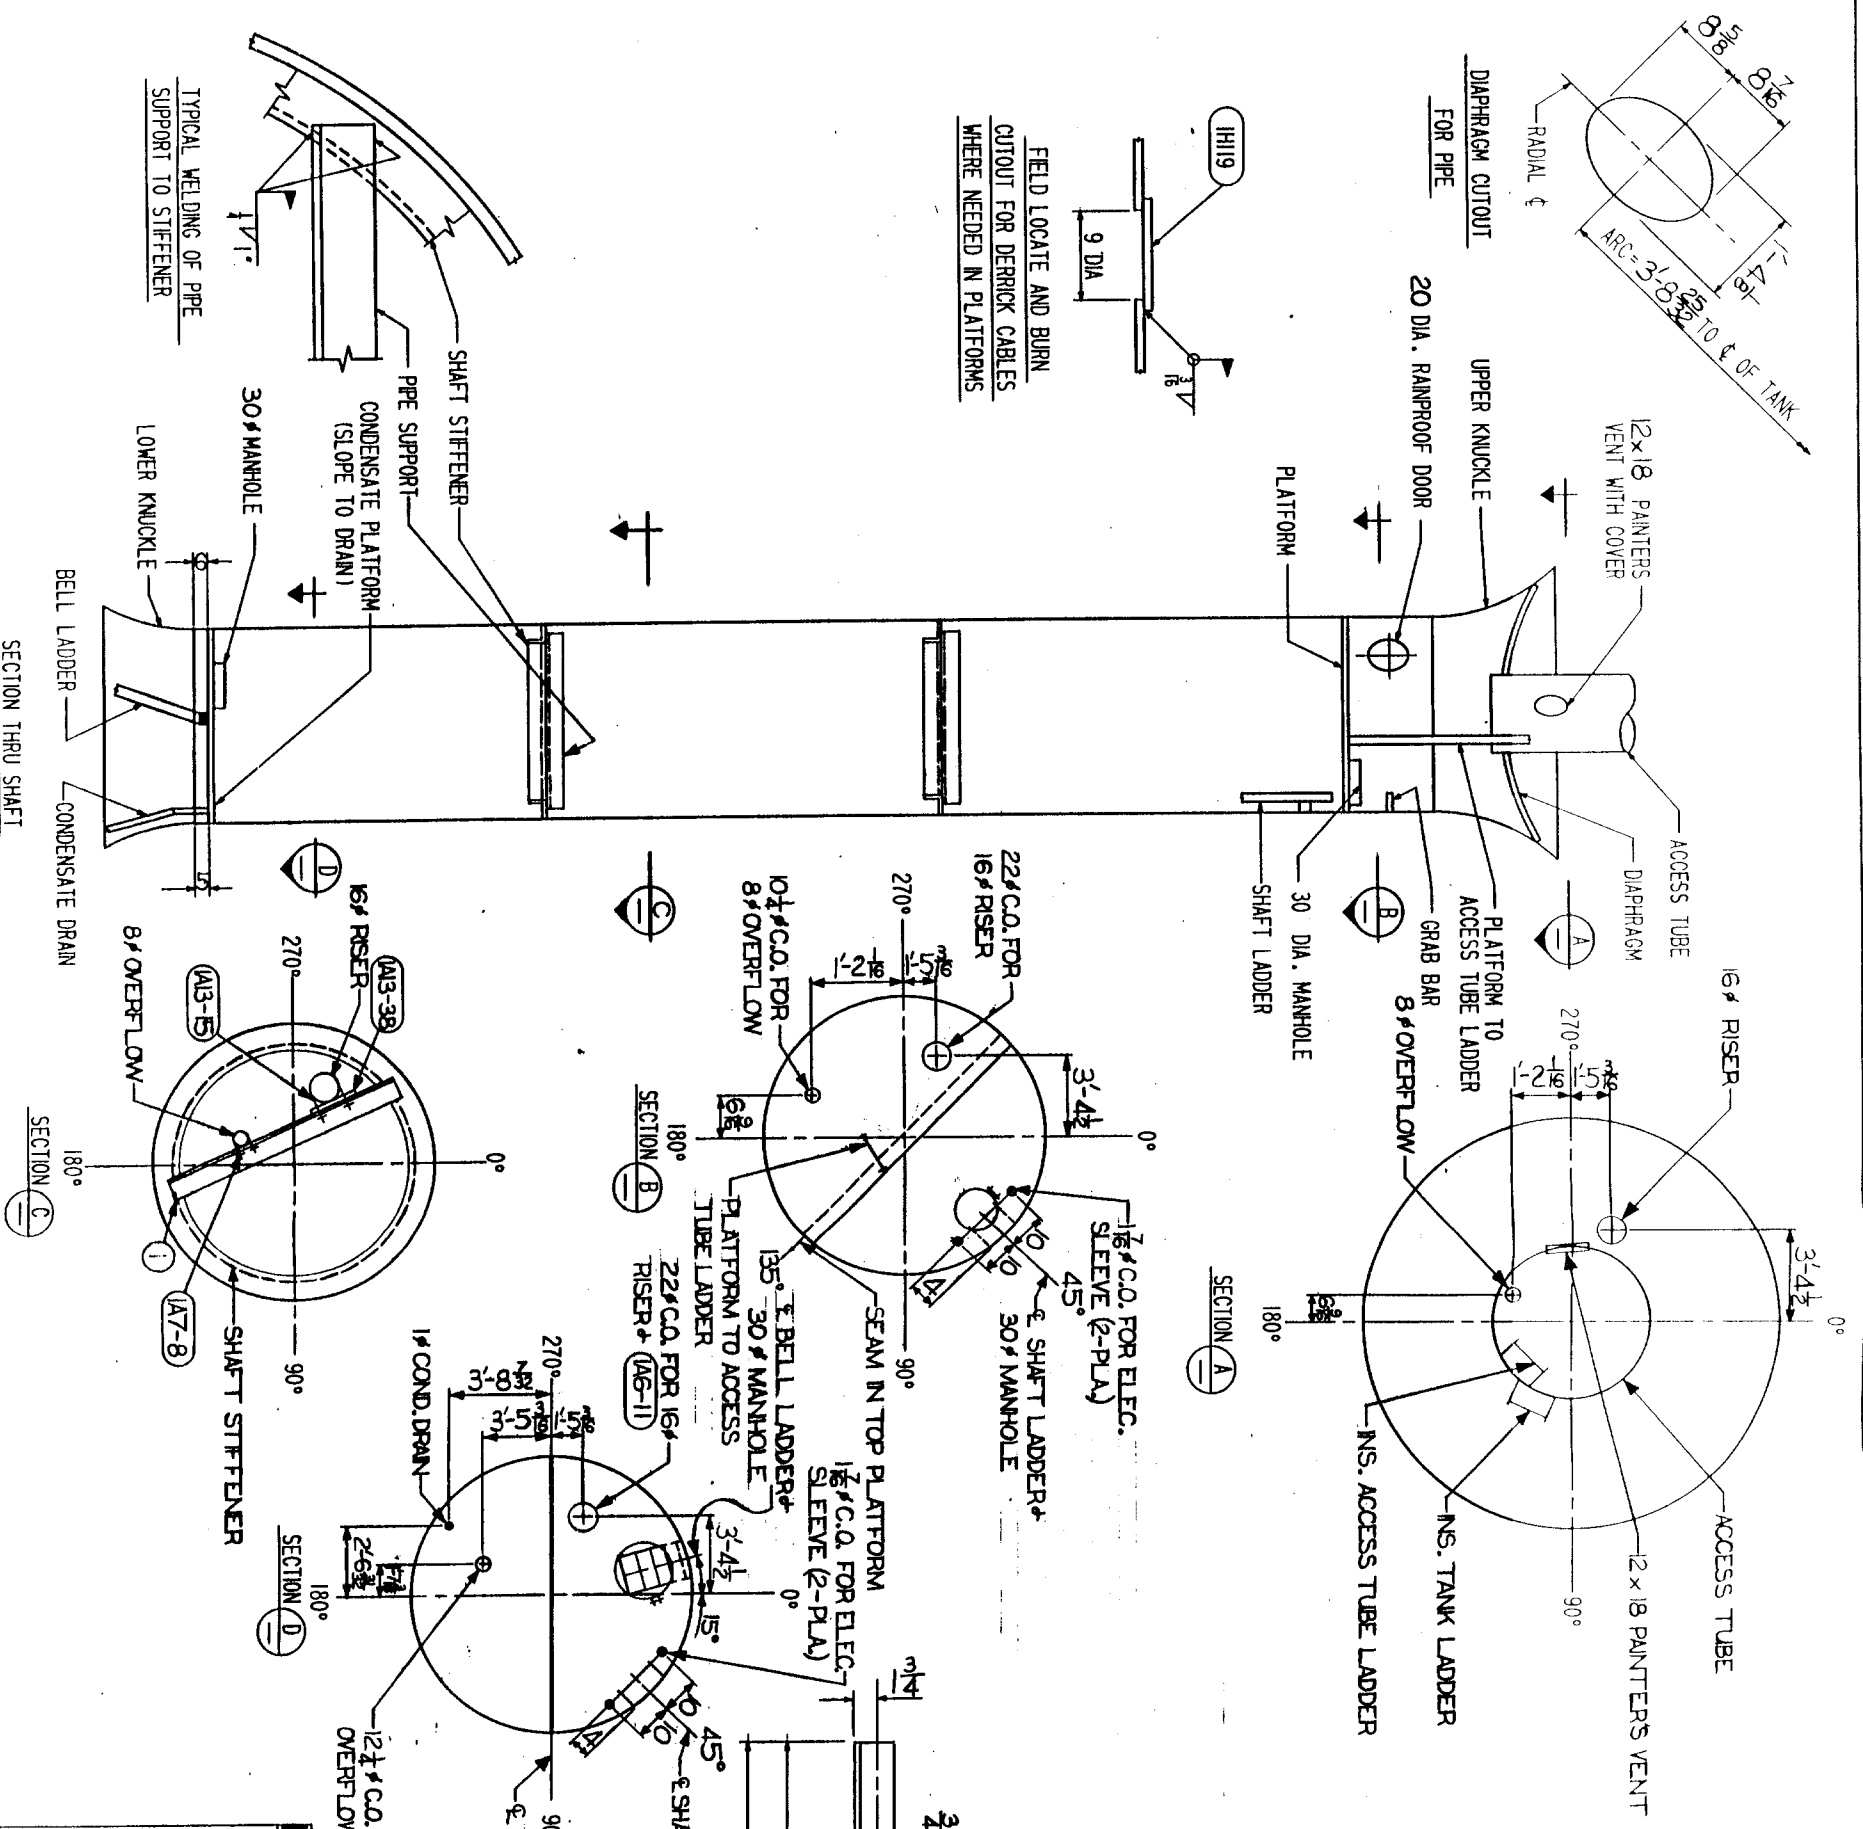


SHIP PC	MARK	ASSEMBLY PC	DESCRIPTION	LENGTH	QTY	CODE	EST WT
2	IH119		PL-11 DIA X 3/16	128.30	5-3	397	10
2	20-1		L-3 X 3 X 1/4 W HOLES	9	9 1/2	A36	5-3 373
2	1A7-8		10-BOLT 5/8 DIA (TUBE 2 1/2)	2	2 7/8	A36	10-0 300
4	1A13-15		4 NUTS FIN HEX 5/8 DIA	156.3A	10-0	300	
2	1A13-15		W/ HOLES BENT	HRS	5-3	300	8
4			4 BOLTS FIN HEX 1/2 DIA	A307B	10-0	300	2
4			4 NUTS FIN HEX 1/2 DIA	A563A	10-0	300	
4			4 WASHERS 1/2 DIA	CS	10-0	300	
2	1A13-38		WOOD SPACER 2 X 4	0	3/4	WOOD	10-0 300


FIELD LOCATE AND BURN CUTOUT FOR DERRICK CABLES WHERE NEEDED IN PLATFORMS

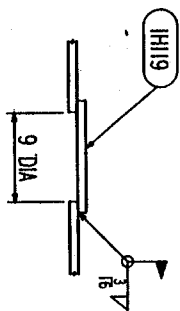

TYPICAL WELDING OF PIPE SUPPORT TO STIFFENER

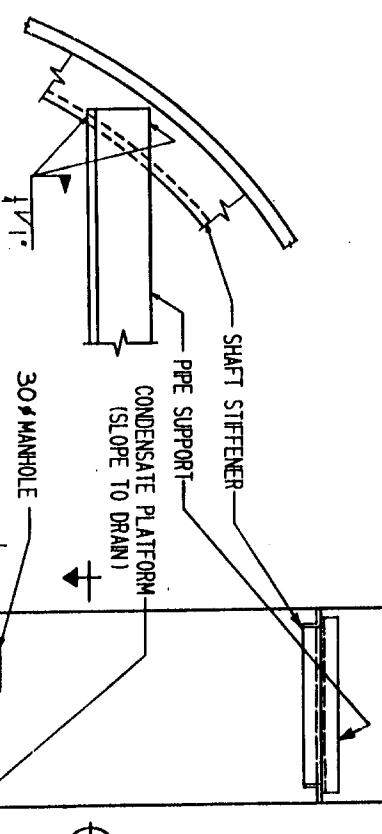

SECTION THRU SHAFT

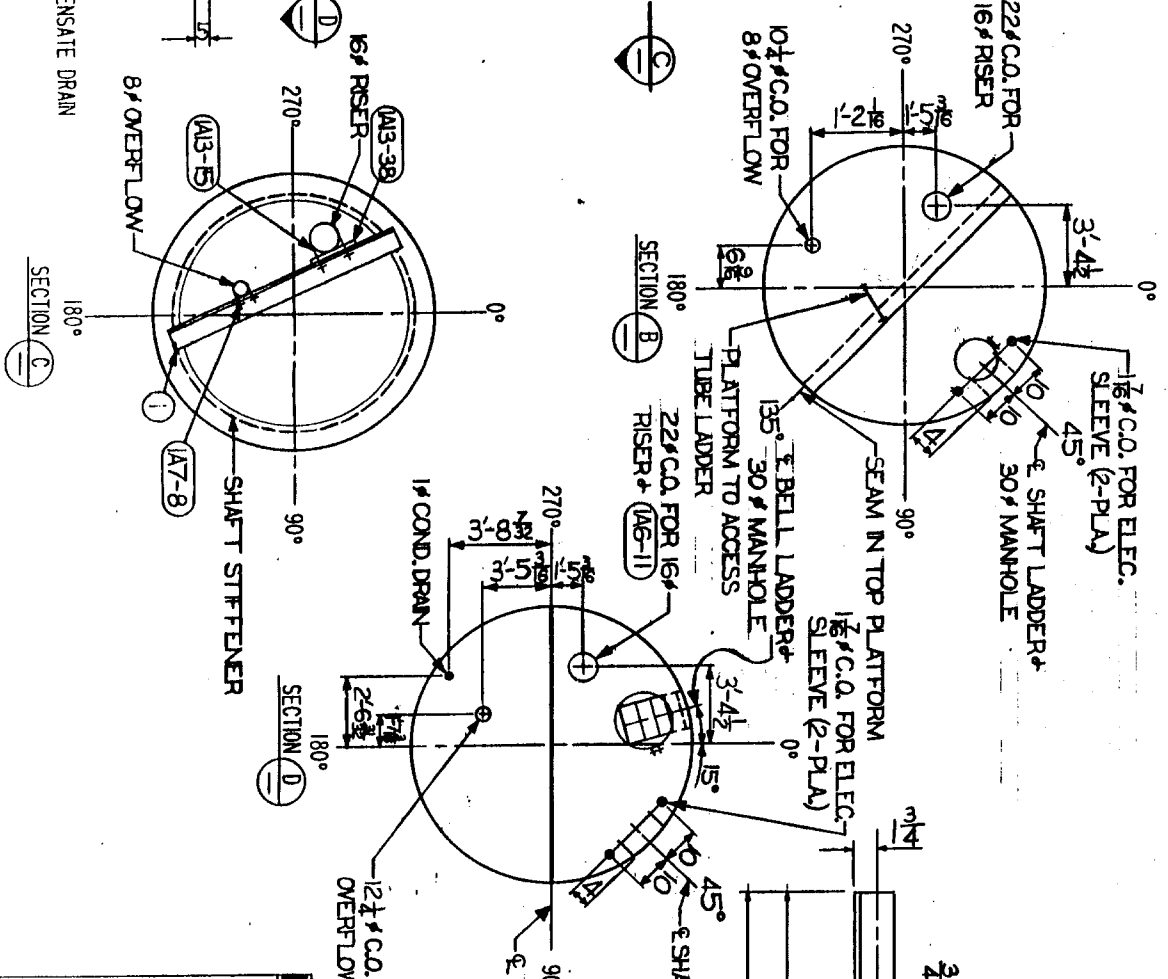

GENERAL NOTES

1. ALL CUTOUTS IN SHAFT PLATFORMS AND DIAPHRAGM ARE TO BE MADE IN THE SHOP UNLESS NOTED OTHERWISE.
2. SEE GENERAL PLAN FOR LOCATION OF PIPE SUPPORT BRACKETS IN SHAFT.
3. MAXIMUM SPACING OF PIPE SUPPORT BRACKETS IN SHAFT TO BE 32'-0".
4. SEE GENERAL PLAN FOR NUMBER OF STIFFENERS AND SHAFT STD. FOR LOCATION.

SUPPLIER'S / PURCHASER'S NO. **D81582**



ORIENTATION OF ACCESSORIES IN SHAFT

REV	DATE	BY	CHKD	DESCRIPTION
0				

CUSTOMER'S NO. **C80633**





BY **JFN** CHKD **DJC** DATE **8-26-88**

ENGINEERING SUPERVISOR


CONTRACT NO. **C80633**

REV **0**

CAD PROGRAM: COITON - OVERFLOW TO GROUND
 DATE OF VERSION: 5/19/86
 CAD FILE: C8063321

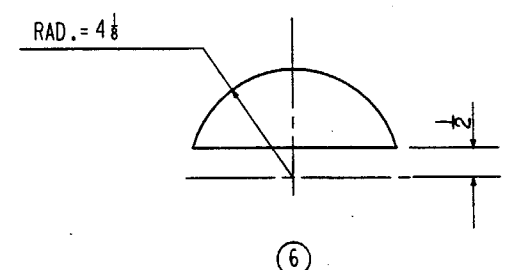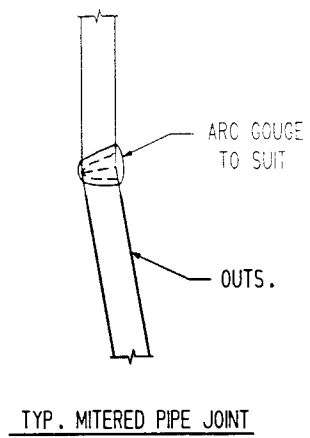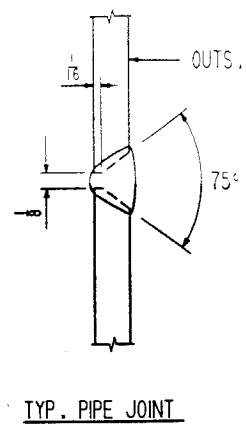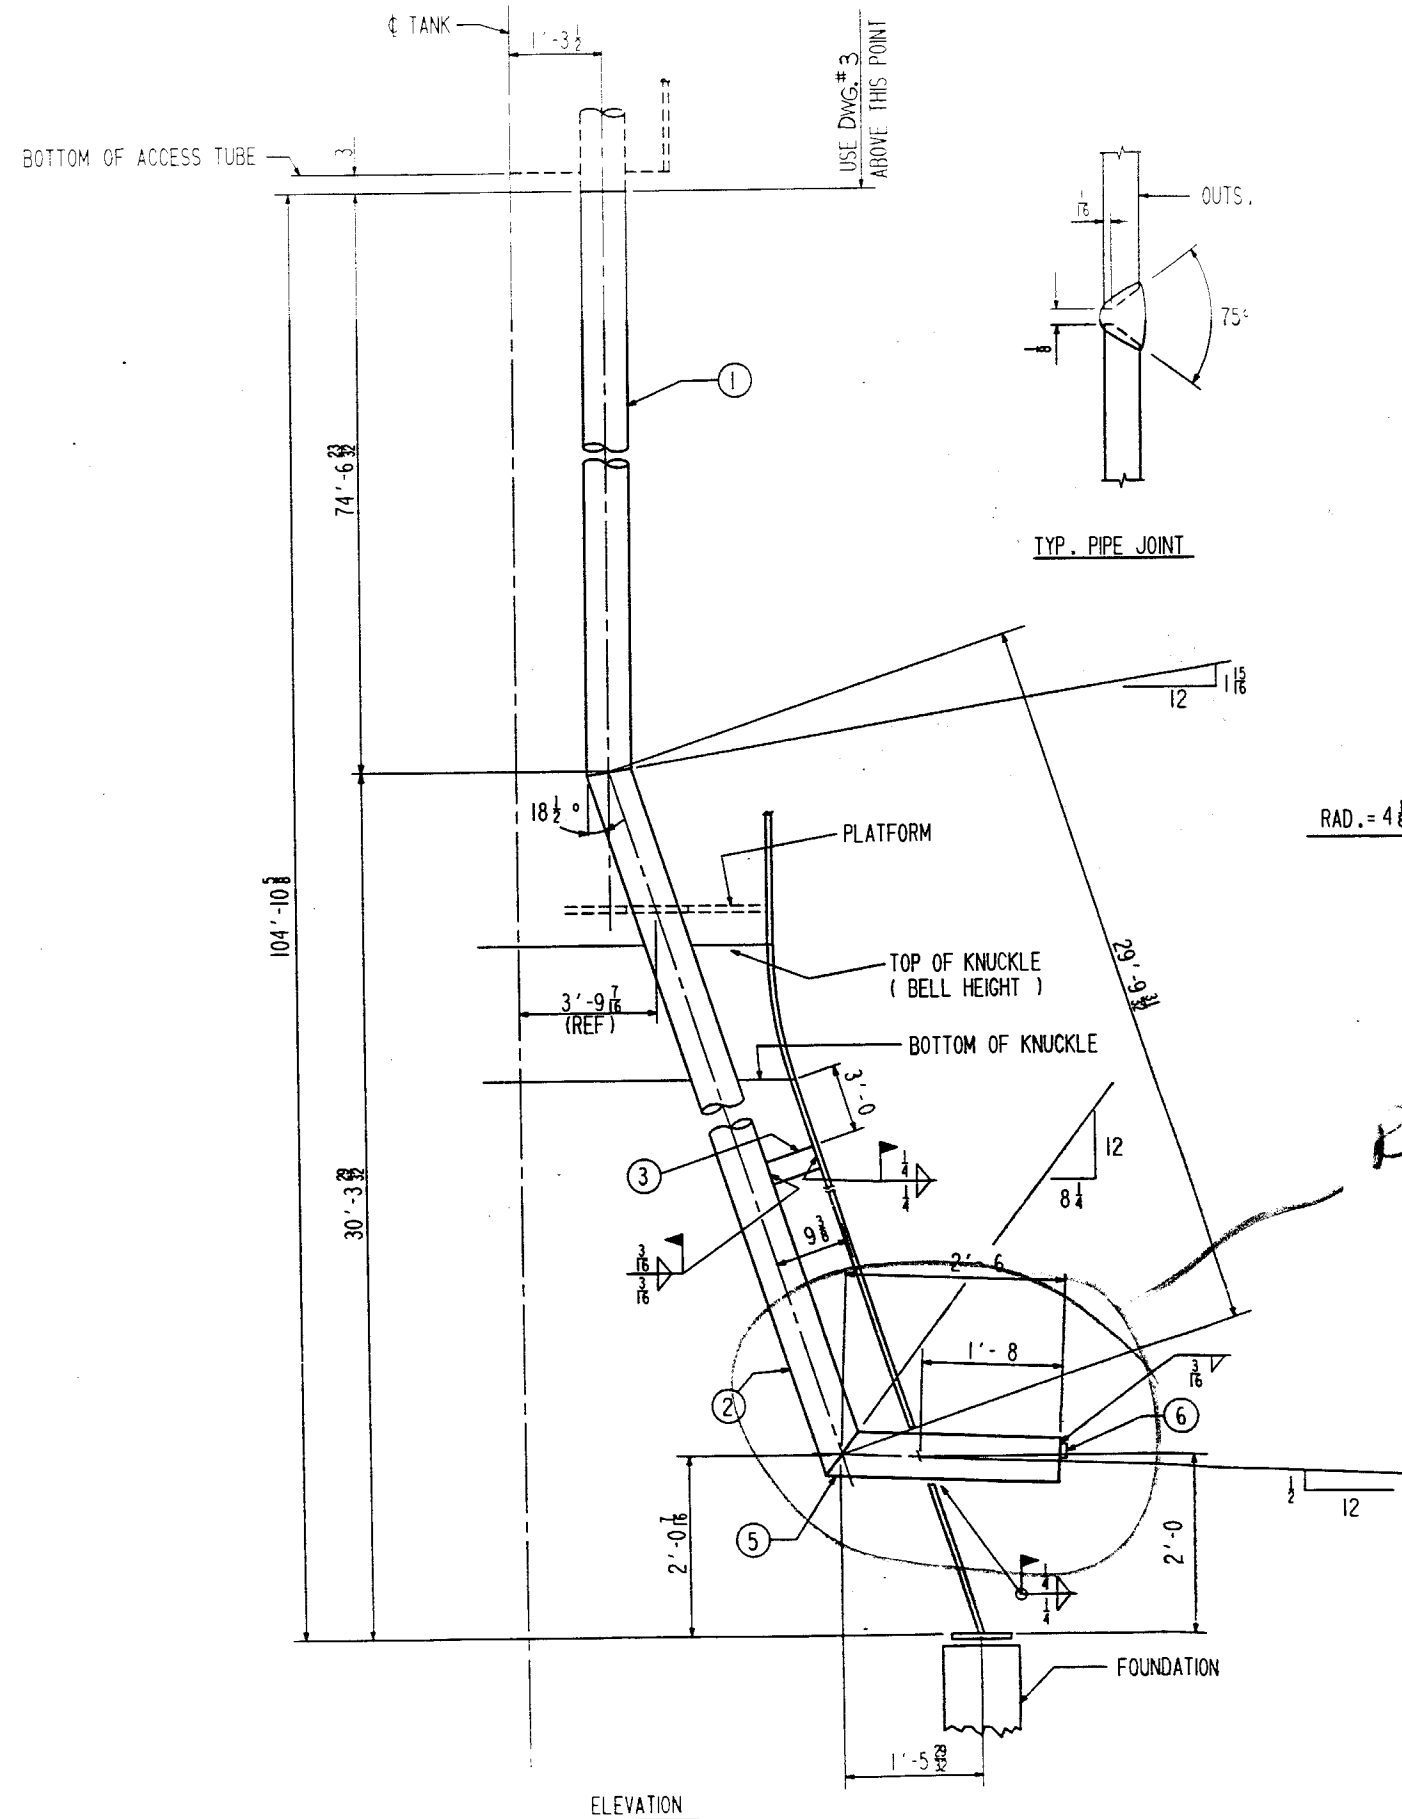

REFER TO SHEET 70FK ADD 4-03-80

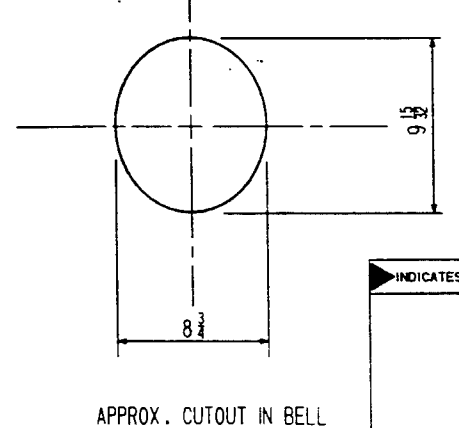

SHIP PC	MARK	ASSEM PC	DESCRIPTION	LENGTH FT	IN	SPEC	ID	CLN & PT	CODE	EST
1	21-1		PIPE 8 X SCH 40	74	6 23/32	M3	18	3-1	374	2129
			CTOE BOE MOE (C/F RUN	104'-7 3/4)						
			1/CUTS-ONE 21-1 & ONE 21-2							
1	21-2		PIPE 8 X SCH 40	29	9 31/32	M3	18	3-1	374	851
			CTOC MBE (C/W 21-1)							
1	21-3		BAR FLAT 3 X 1/4	0	5 1/16	A36	5-3	374		
1	21-A		PIPE ASSY							154
	21-5		PIPE 8 X SCH 120	2	6	M3	18	3-1	374	152
			CTOE POE MOE (C/F PC 21-9 1/4)							
	21-6		PL SK X 1/4			A283C	5-3	374		2
			(C/F PL 4 1/16 X 1/4 X 8 5/8)							

MATERIAL SPECS.

M3 - A53B TYPE E (ELECTRIC-RESISTANCE WELDED) OR TYPE S (SEAMLESS), OR API-5L GRADE B (ELECTRIC WELDED OR SEAMLESS).

GENERAL NOTES

- SEE PIPING & PLATFORM DWG. #20 FOR ORIENTATION & PIPE SUPPORT DETAILS.
- WORK THIS DWG. WITH DWG.#3

SUPPLIER'S/ PURCHASER'S NO. D81582




8" DIA. OVERFLOW TO GROUND
 FOR 500 M.G. WATERSPHEROID
 110'-6 TO BCL
 WITH ORIFICE

CUSTOMER'S NO. _____ CONTRACT NO. C80633
 BY JEN CHKD OKY DATE 8-26-88
 R.B. BURLESON
 ENGINEERING SUPERVISOR

NO.	DATE	BY	CHKD	DATE	REVISIONS

THIS DRAWING HAS BEEN PREPARED FOR AND IS THE PROPERTY OF CBI AND IS TO BE USED ONLY IN CONNECTION WITH PERFORMANCE OF WORK BY CBI. REPRODUCTION IN WHOLE OR IN PART FOR ANY OTHER PURPOSE IS EXPRESSLY FORBIDDEN.

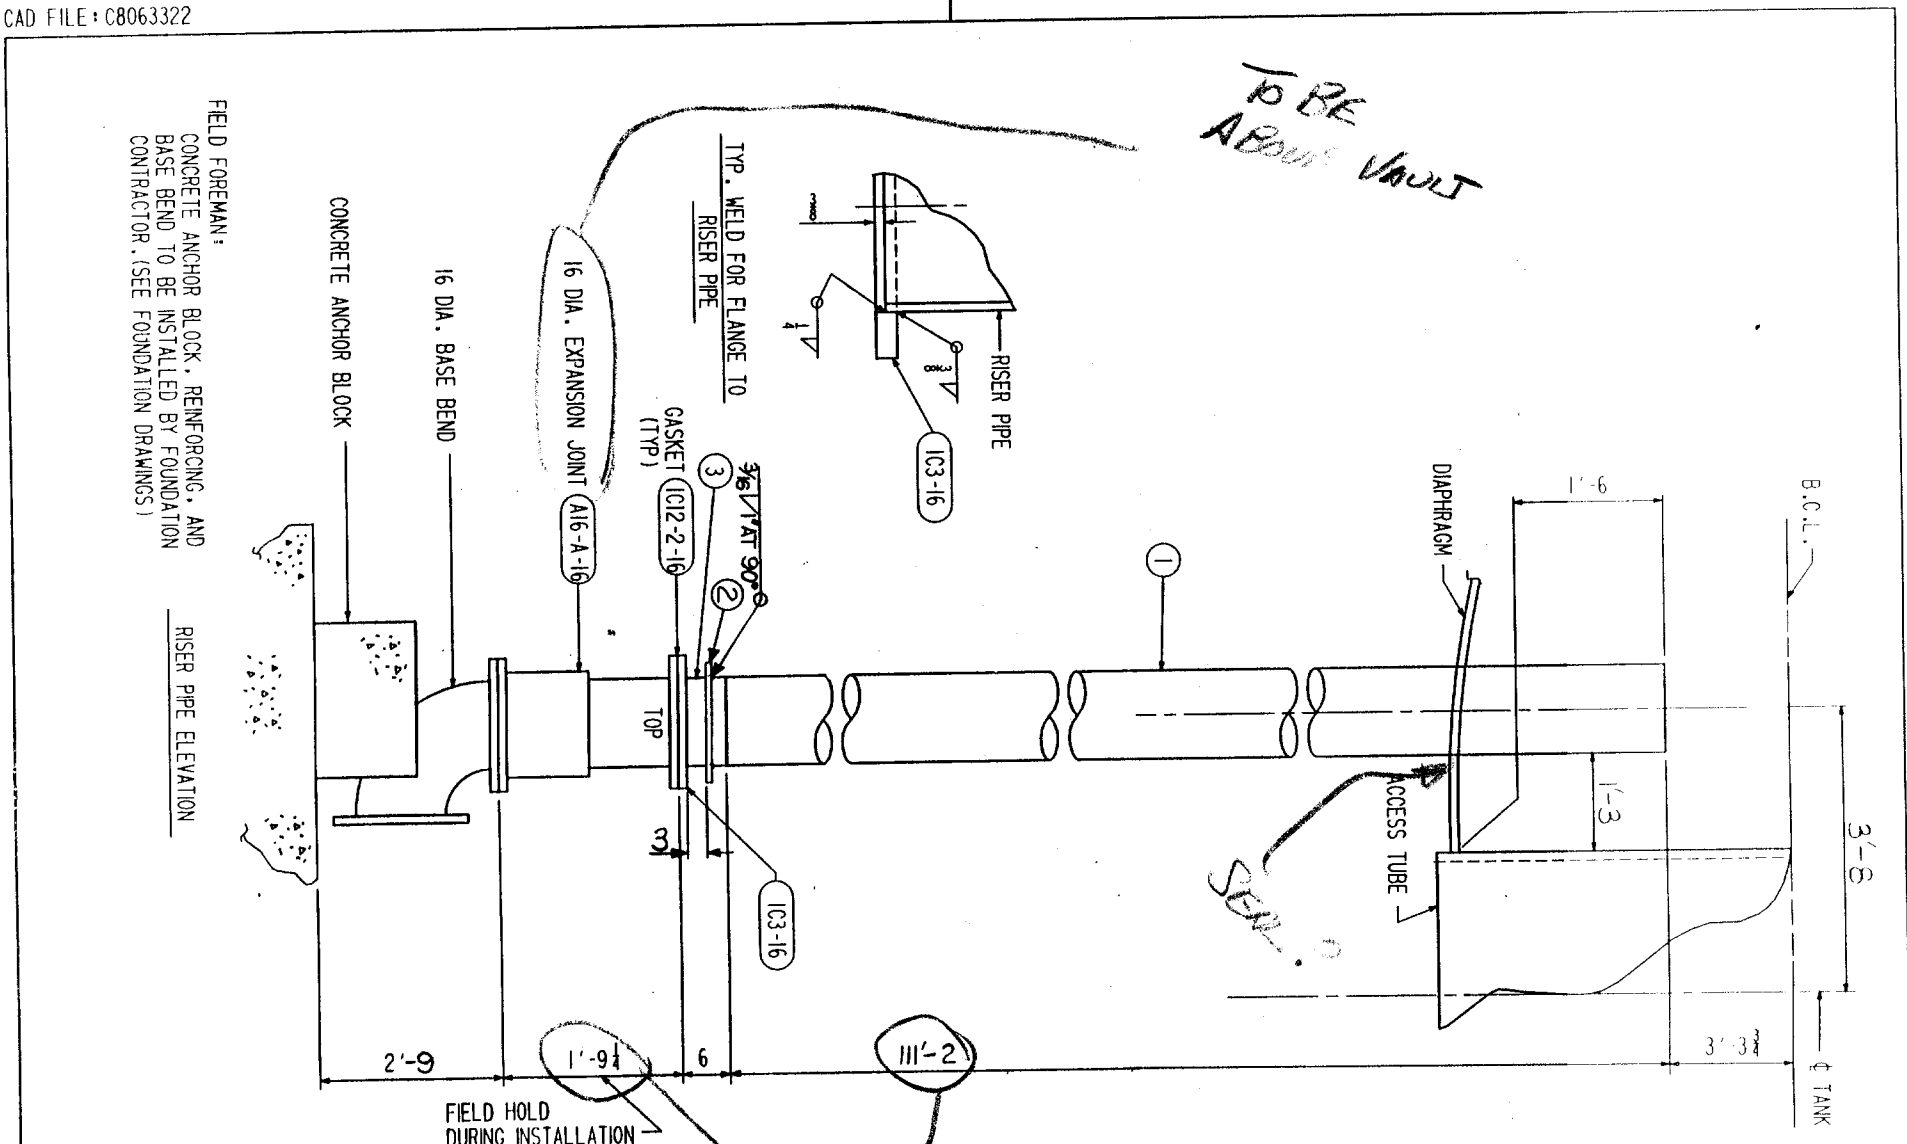

FIELD FOREMAN:
 CONCRETE ANCHOR BLOCK, REINFORCING, AND
 BASE BEND TO BE INSTALLED BY FOUNDATION
 CONTRACTOR. (SEE FOUNDATION DRAWINGS)

RISER PIPE ELEVATION

CONCRETE ANCHOR BLOCK

FIELD HOLD DURING INSTALLATION

TYP. WELD FOR FLANGE TO RISER PIPE

GASKET (IC12-2-16) (TYP)


16 DIA. EXPANSION JOINT (A16-A-16)

16 DIA. BASE BEND


CONCRETE ANCHOR BLOCK

TO BE ABOUT VAULT

SERV.

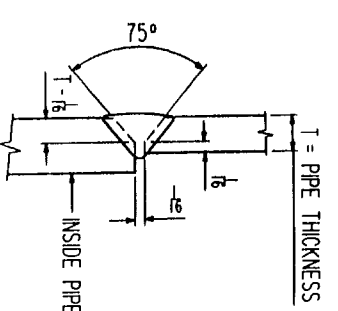

TYP. WELD JOINT FOR PIPE OF DIFFERENT THICKNESS

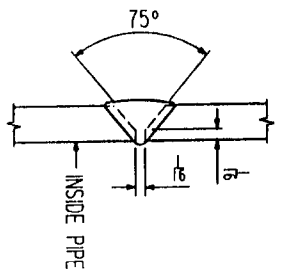

TYP. WELD JOINT FOR PIPE OF SAME THICKNESS

DIP. IN VAULT
 REUSE DIMENSIONS



SHIP PC	MARK	ASSEMBLY PC	DESCRIPTION	LENGTH FT IN	SPEC ID	QTY	CODE	EST #
			DWG. 22					
	22-1		PIPE 16 X .375 PIPE, BOLT III	2	M3	1813-1	374	0957
			B.E. BEVEL INTERM JTS FOR WELDING					
	22-B		PIPE SECTION					
	22-3		PIPE 16 X .375	0 5 7/8	M3	1813-1	374	31
			P.O.E. B.O.E.					
	103-16		FLG FLAT FACE 16 DIA		M8	1815-3	374	87
			150# (C/F PL 24 X 1 5/8 X 2'-0')					
	22-2		P-19 OD X 1/4 X 16 KLD		A083C	53	374	6
			EXPANSION JT. 16 DIA			1815-3	374	366
			GASKET FULL FACE		M9	10-0	300	3
			(23 1/2 O.D. X 1/8 X 16 I.D.)					
			WITH 16 - 1/18 DIA HOLES					
			ON 21 1/4 B.C.					
	22-4		BOLT FIN HEX 1 DIA	0 4 1/2	A307B	1810-0	300	54
			NUT HEX 1 DIA		A563A	1810-0	300	

MATERIAL SPECS: M3 = A538 TYPE E (ELECTRIC-RESISTANCE WELDED) OR TYPE S (SEAMLESS)
 OR API-5L GRADE B (ELECTRIC WELDED OR SEAMLESS).
 M8 = A516 FOR MANUFACTURED FLANGE; A105 FOR PURCHASED FLANGE.
 M9 = RED RUBBER HH-P-0015D, CLASS 1 AND CLASS 3.

NOTES: 1. SEE PIPING AND PLATFORM DWG. 20 FOR ORIENTATION OF RISER AND DETAIL OF PIPE SUPPORT BRACKET.

INDICATES CHANGE FROM PREVIOUS ISSUE

BY	CHKD	DATE	BY	CHKD	DATE	BY	CHKD	DATE	REVISIONS	REMARKS
CUSTOMER'S NO: _____ BY: J.N. CHKD DATE: 6/26/86 ENGINEERING SUPERVISOR: R.B. BIBBESIN CONTRACT NO: 080633 REV: 0 THIS DRAWING HAS BEEN PREPARED FOR AND IS THE PROPERTY OF CBI. IT IS TO BE USED ONLY IN CONNECTION WITH PERFORMANCE OF WORK BY CBI. REPRODUCTION IN WHOLE OR IN PART FOR ANY OTHER PURPOSE IS EXPRESSLY FORBIDDEN.										
SUPPLIER'S / PURCHASER'S NO: DB1582 CBI 16" DIAMETER RISER PIPE FOR 500 M.G. WATERSPHEROID CITY OF RAMSEY, MINNESOTA										

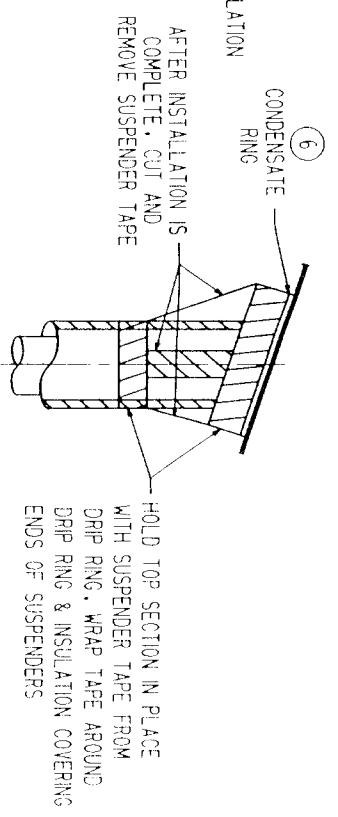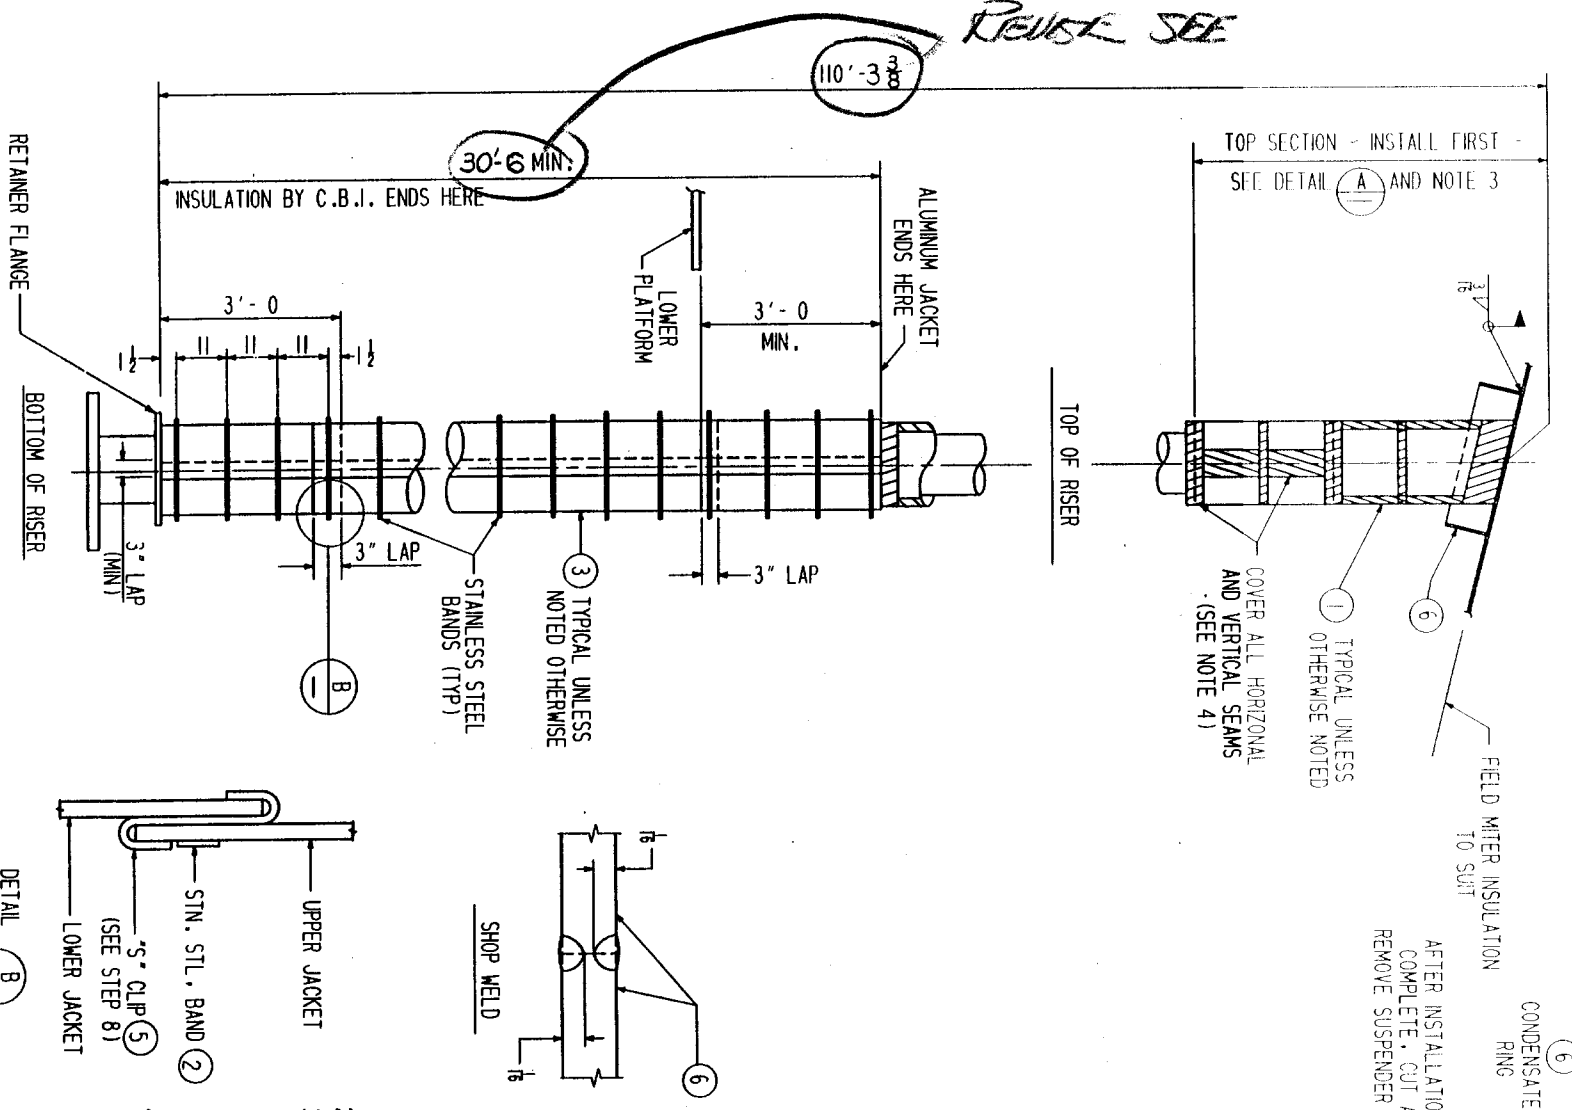

- INSTALLATION INSTRUCTIONS**
- TEST ALL JOINTS FOR LEAKS BEFORE APPLYING INSULATION.
 - OFFSET CONDENSATE RING TO CLEAR INSULATION AND ACCESS TUBE.
 - INSTALL TOP SECTION OR SECTIONS FIRST. MITER CAREFULLY WITH HACKSAW TO FIT TANK BOTTOM OR PIPE BEND. SEAL VERTICAL JOINTS WITH TAPE. SEAL GRTH JOINTS AND TOP END WITH ONE AND A HALF TURNS OF TAPE AS SHOWN. SMOOTH TAPE DOWN FIRMLY. PUSH TOP SECTION FIRMLY AGAINST TANK BOTTOM AND SUSPEND FROM DRIP RING WITH TAPE AS SHOWN ON DETAIL "A".
 - AT BOTTOM OF THE RISER, PLACE 3 OR 4 SECTIONS OF INSULATION AROUND RISER PIPE ON TOP OF RETAINER FLANGE. STAGGER VERTICAL SEAMS 90°. SEAL VERTICAL JOINTS WITH TAPE. SEAL GRTH JOINTS WITH ONE AND A HALF TURNS OF TAPE AS SHOWN. LOCATE ONE AND A HALF TURNS OF TAPE MIDWAY BETWEEN GRTH JOINTS ON ALL STANDARD SECTIONS.
 - SLIDE FIRST SECTIONS UP AND PLACE ADDITIONAL SECTIONS UNDER THEM REPEATING STEP 4. (IF WEIGHT OF INSULATION IS TOO GREAT TO INSTALL IN THIS MANNER, INSUL. CAN BE STACKED TO FACILITATE INSTALLATION)
 - CONTINUE THE PROCESS TO COMPLETION. LAST SECTION IS MADE-UP AND MUST BE CUT TO LENGTH.
 - TAPE GRTH JOINT AT TOP SECTION. AND CUT TAPES HOLDING TOP SECTION IN PLACE FROM DRIP RING.
 - INSTALL ALUMINUM JACKET WITH BANDS AND SEALS. USE 3 "S" CLIPS PER SEAM. "S" CLIPS ARE TO BE MADE FROM BANDING.
 - INSTALL PIPE SUPPORTS AS REQUIRED. (SEE DRAWING 20)

IMPORTANT
 TAPE SHOULD NOT BE APPLIED AT TEMPERATURE BELOW 15° F. KEEP TAPE WARM DURING APPLICATION.

SHIP PK. NO.	MARK	QSSM	DESCRIPTION	LENGTH IN.	SPEC.	QTY.	CODE	EST. #
38	23-1		INSULATION PAIRS OF 180 DEGREE SECTIONS X 1 1/2 THICK FOR PIPE 16 DIA	3	0	10-0	300	132
			EXPANDED POLYURETHANE BANDING #10 STAINL. STL 6 1/2" WIDE X 20 GAUGE			10-0	300	15
			WITH SEALS AS MANUFACTURED BY CHILDERS OR EQUAL			10-0	300	53
			64" HORIZONTAL X .020 THICK			10-0	300	15
			TAPE - 180 FOOT ROLLS MANUFACTURED BY TECHNICAL TAPE CO. 90T-3 (COMMONLY CALLED TUCK TAPE)			10-0	300	1
			3" WIDE ROLL BANDING #10 STAINL. STL 0 5 1/2" WIDE X 20 GAUGE			10-0	300	1
			FOR "S" CLIPS BAR 3 X 1/4			5-3	300	14
			ROLL RAD = 1'-2"					

ALL INSULATION SECTIONS SHALL BE
 FURNISHED WITH FACTORY APPLIED FIRE
 RETARDANT, LAMINATED KRAFT PAPER/
 ALUMINUM FOIL VAPOR BARRIER

INSULATION VALUE IS REQ'D

INDICATES CHANGE FROM PREVIOUS ISSUE

BY	CHKD	DATE	REVISIONS	REMARKS

SUPPLIER'S / PURCHASER'S NO. **DB1582**

CBI

1 1/2" THK POLYURETHANE INSULATION
 FOR 16" RISER PIPE
 CITY OF RAMSEY, MINNESOTA


CUSTOMER'S NO. **C80633**
 BY **J.R. OHM** DATE **5-26-82**
 R.B. BRILESON
 ENGINEERING SUPERVISOR

CONTRACT NO. **C80633**
 DWG 23
 REV 0


THIS DRAWING HAS BEEN PREPARED FOR AND IS THE PROPERTY OF CBI AND IS TO BE USED ONLY IN CONNECTION WITH PERFORMANCE OF WORK BY CBI. REPRODUCTION IN WHOLE OR IN PART FOR ANY OTHER PURPOSE IS EXPRESSLY FORBIDDEN.

TO BE LOCATED INSIDE
 ABOVE 6" DIAM SLEEVES IN FOUNDATION

CAD Program: CO10N
 Date of Version: 9-17-86
 CAD FILE: C8063324

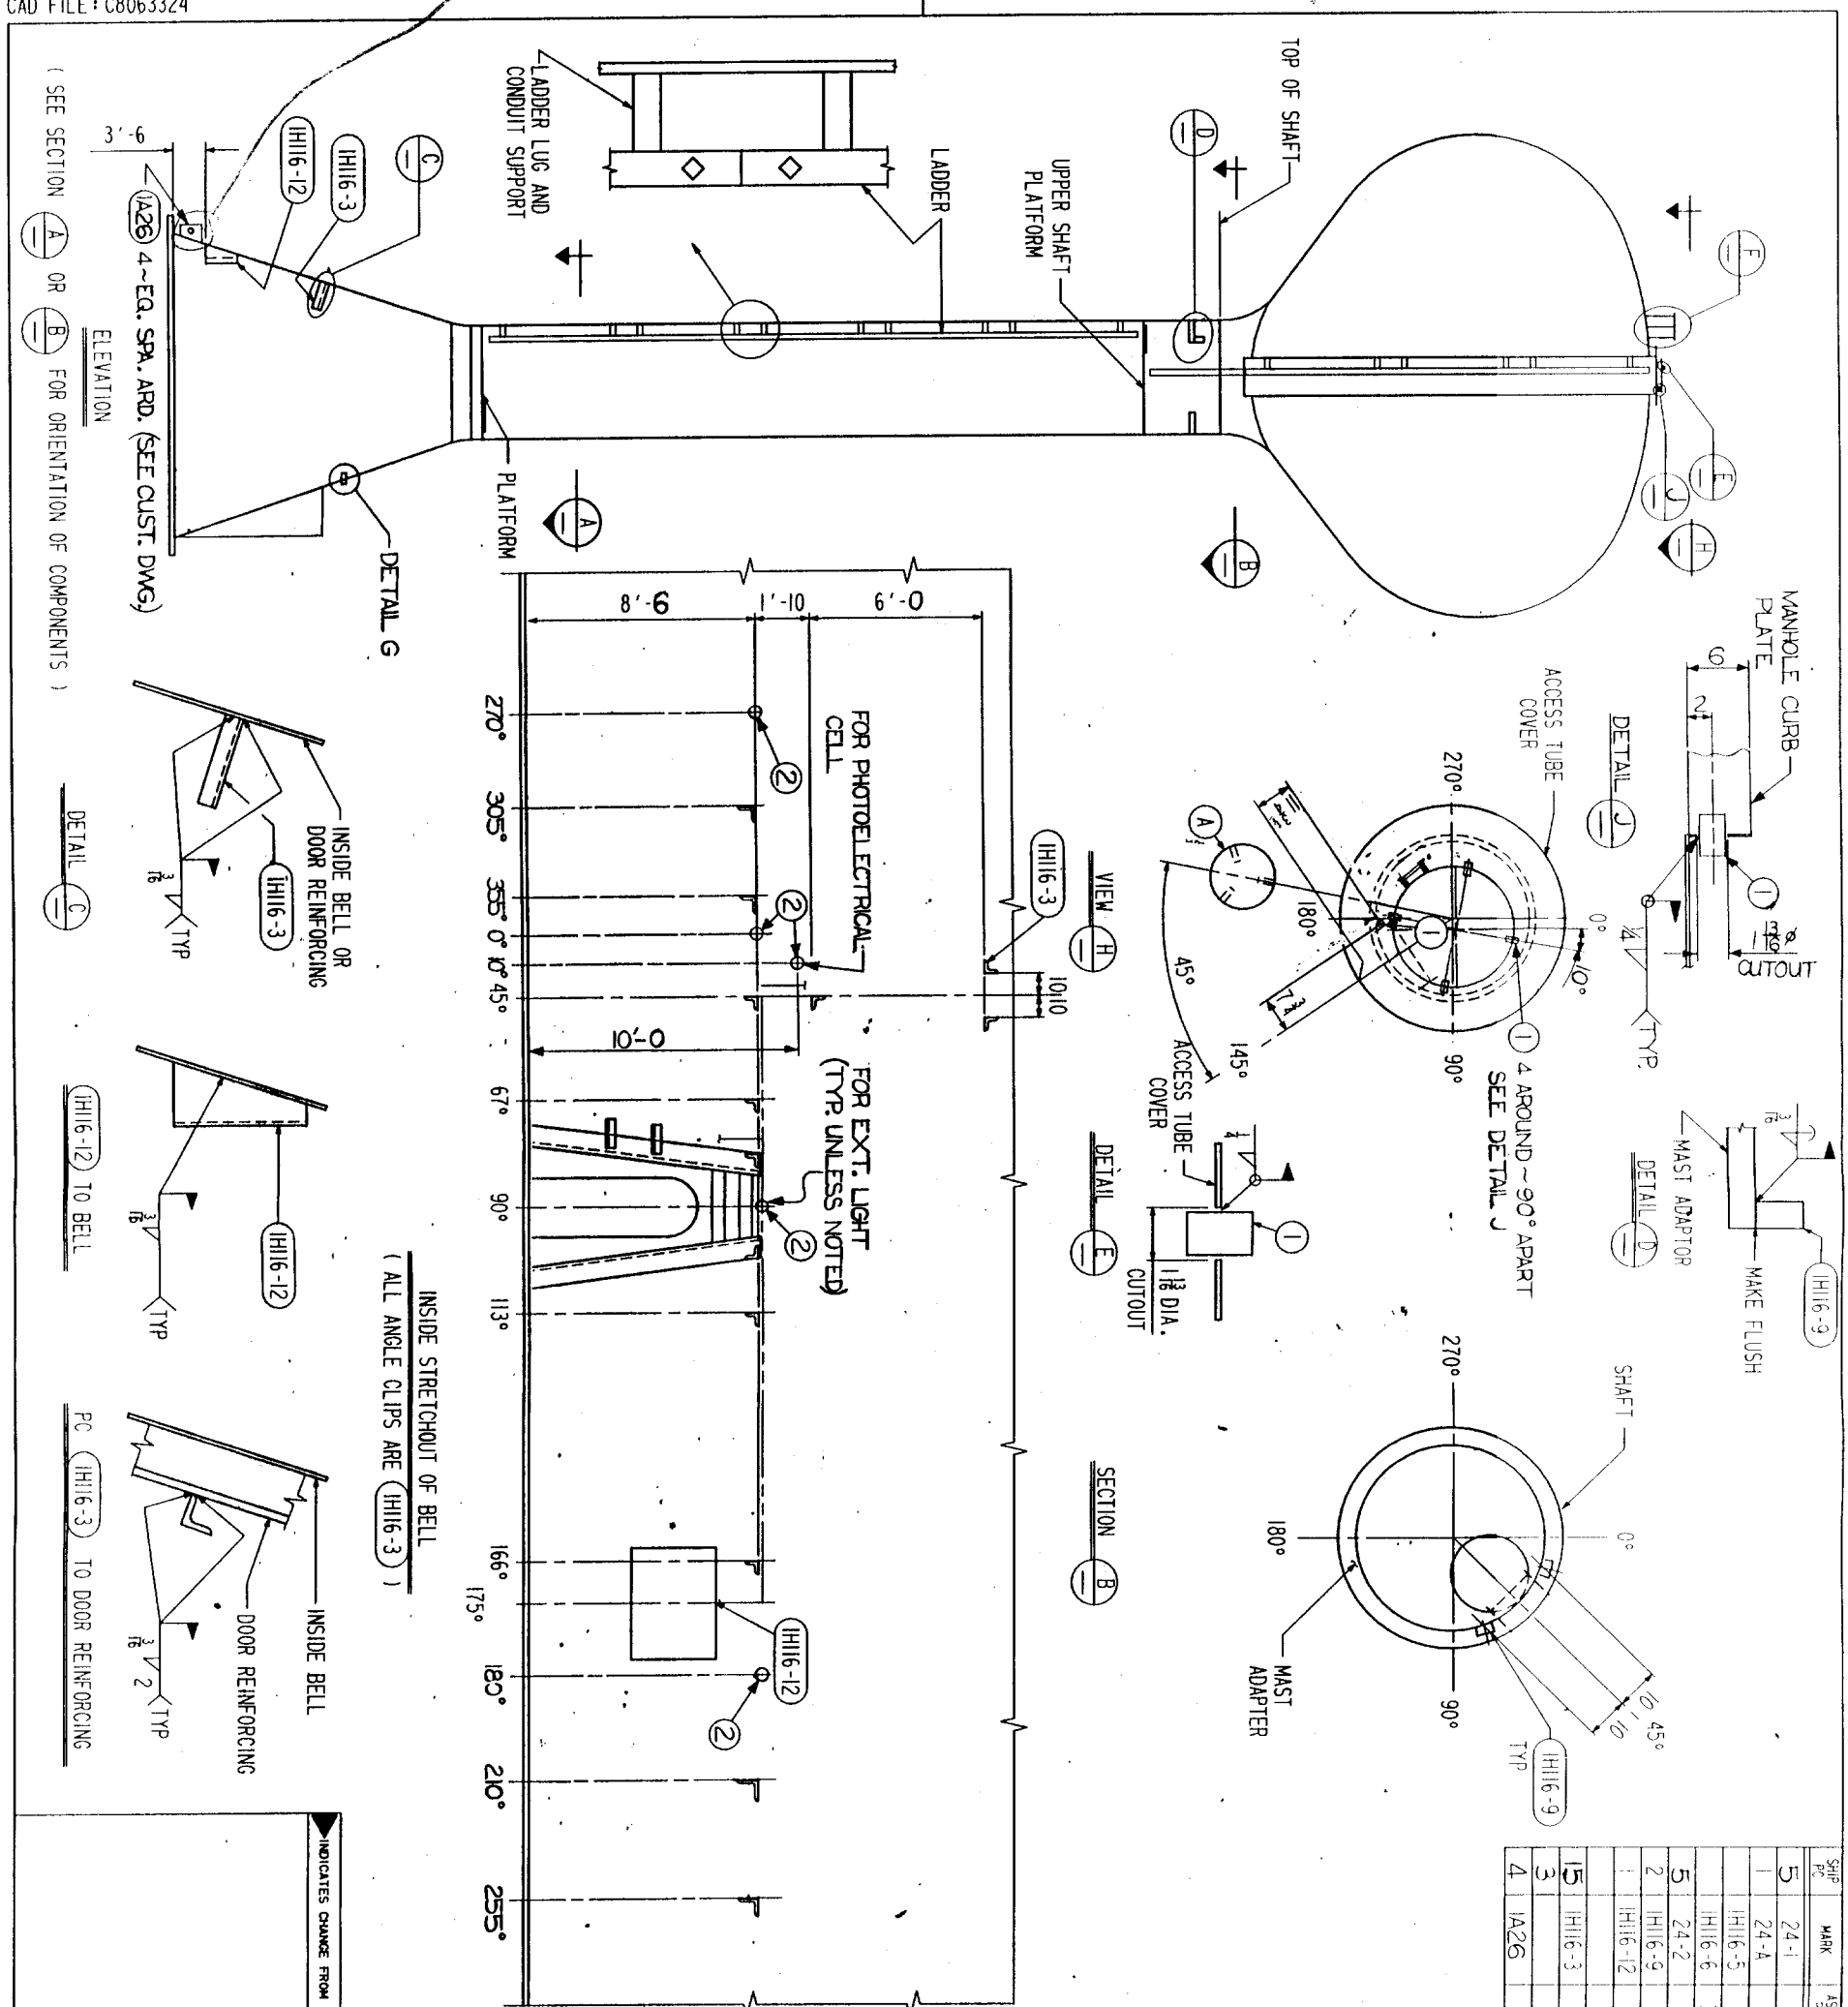


SHP	MARK	AS9M	DESCRIPTION	LENGTH	SPEC	QTY	CODE	EST	WT.
5	24-1		OPLG SRWD 1" DIA 3000#	F.S.	0-0-370	3			
1	24-4		BEACON SUPPORT ASS'Y						
	IH116-5		PL 15 DIA X 1/4	A283C	5-3-370	13			
	IH116-6		3 BAR FLAT 1/2 X 1/4	A36	5-3-370	3			
5	24-2		OPLG SRWD 3/4 DIA 6000#	F.S.	0-0-370	5			
2	IH116-9		BAR FLAT 1/2 X 1/4	A36	5-3-370	2			
1	IH116-12		PL 5K X 1/4	A283C	5-3-370	163			
15	IH116-3		LC/F 36 3/8 X 6'-4 3/8	A36	5-3-370	25			
3			SQ HEAD PLUG ~ 1" DIA.	F.S.	0-0-370	1			
4	1A26		GROUNDING LUG BAR 2x3/8	A283-C	5-3-300	1			

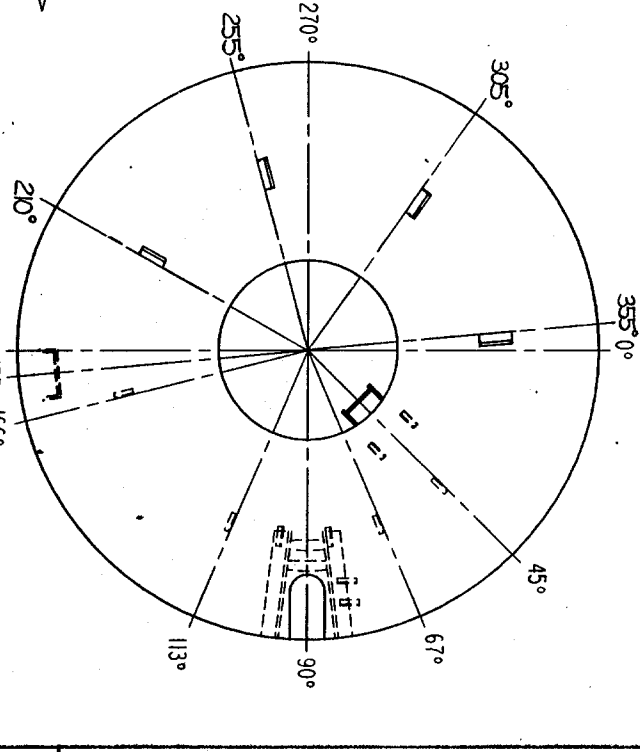

INSIDE STRETCHOUT OF BELL
 (ALL ANGLE CLIPS ARE IH116-3)

(SINGLE VERTICAL CONDUIT
 SUPPORT ANGLES OMITTED FOR
 CLARITY)

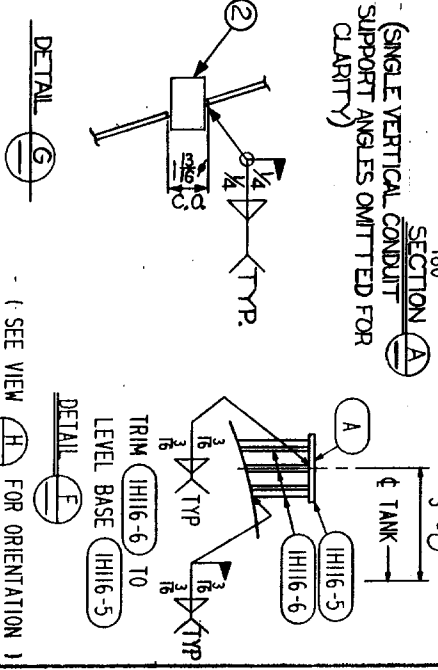

(SEE SECTION A OR B FOR ORIENTATION OF COMPONENTS)

DETAIL C

IH116-12 TO BELL

FC (IH116-3) TO DOOR REINFORCING

INDICATES CHANGE FROM PREVIOUS ISSUE

BY	CHKD	DATE	REVISIONS	REMARKS






CUSTOMER'S NO. _____
 BY: R.B. BRILESON, ENGINEERING SUPERVISOR
 DATE: 8-22-86
 CONTRACT NO. C80633
 SUPPLIER'S / PURCHASER'S NO. 081582

INDICATES CHANGE FROM PREVIOUS ISSUE


REMARKS

ELECTRICAL ORIENTATION
 500 M.C. WATERSPHEROID
 CITY OF RAMSEY, MINNESOTA

CONTRACT NO. C80633
 REV 0
 DWG 24
 SHT 0

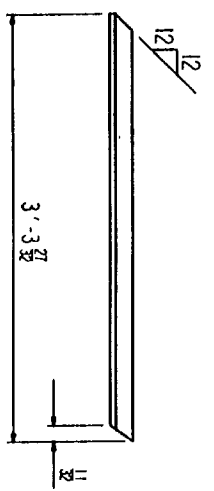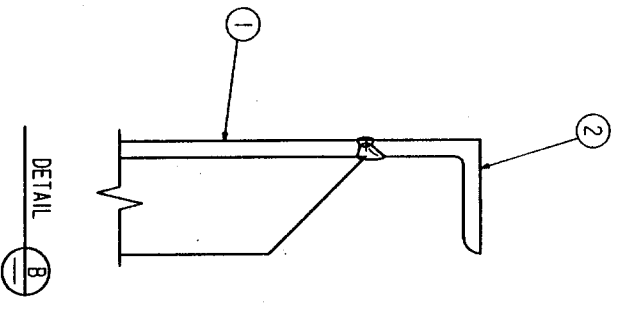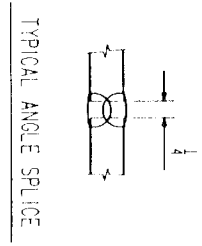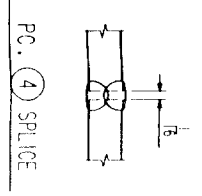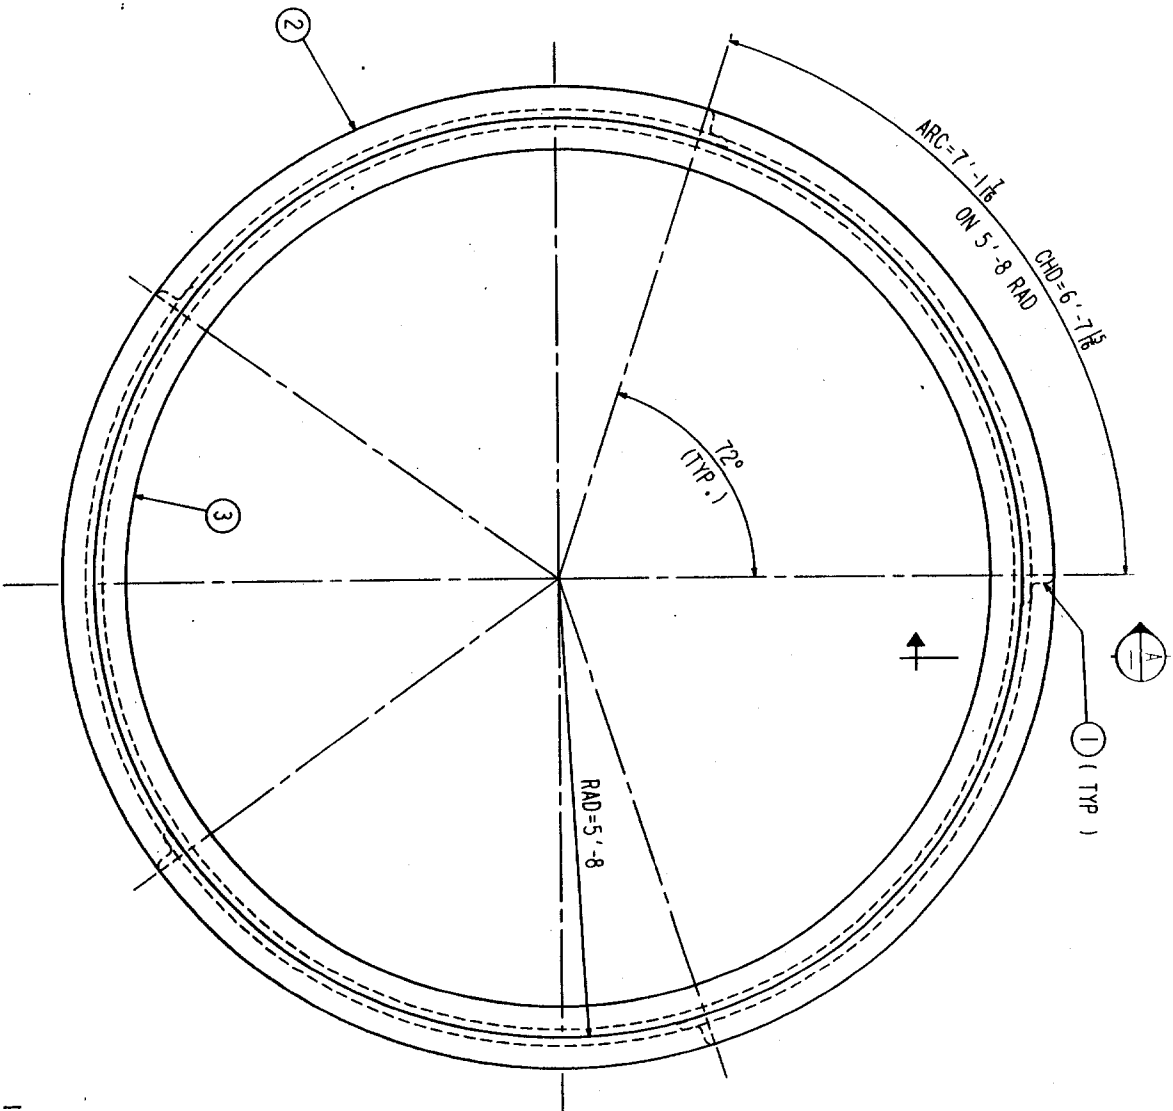








SPR	MARK	ASSEMBLY	DESCRIPTION	LENGTH	SPEC	QTY	UNIT	CODE	ES
5	25-1	L	2 1/2 X 2 1/2 X 1/4 S.K.B.E.	3 3 27/32	A36	15	-3	372	
2	25-2	L	2 1/2 X 2 1/2 X 1/4 (ROLL)	17 10 9/32	A36	5	-3	372	146
			FIN RAD = 5'-8 1/4						
2	25-3	L	2 1/2 X 2 1/2 X 1/4 (ROLL)	17 9 1/2	A36	15	-3	372	146
			FIN RAD = 5'-8						
2	25-4	BAR	4 X 1/4 (ROLL)	17 9 1/4	A36	5	-3	372	121
			ROLL RAD = 5'-7 3/4						

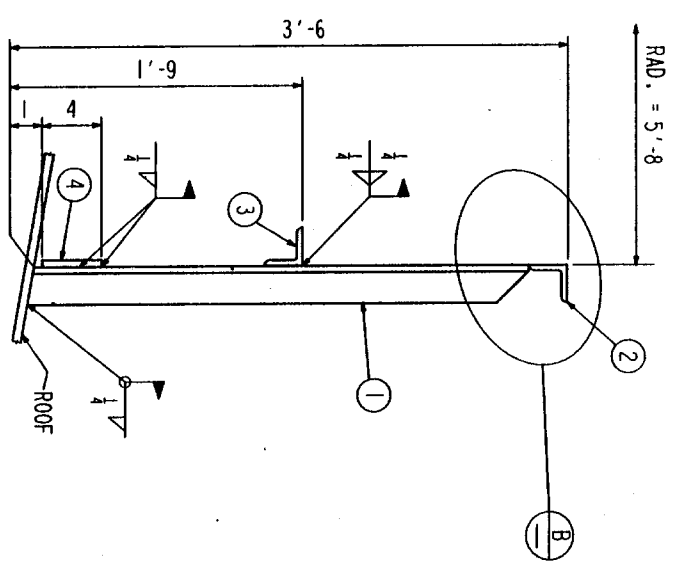

INDICATES CHANGE FROM PREVIOUS ISSUE

BY	CHKD	DATE	REVISIONS	REMARKS

SUPPLIER S/V PURCHASER S. NO. 081582
CBI
 ROOF HANDRAIL
 500 M.G. WATERSPHEROID
 CITY OF RAMSEY, MINNESOTA
 CONTRACT NO. 080633
 BY J.N. CHKD DATE 8-26-86
 F.B. BRITTON
 ENGINEERING SUPERVISOR
 THIS DRAWING HAS BEEN PREPARED FOR AND IS THE PROPERTY OF CBI. REPRODUCTION IN WHOLE OR IN PART FOR ANY OTHER PURPOSE IS EXPRESSLY FORBIDDEN.

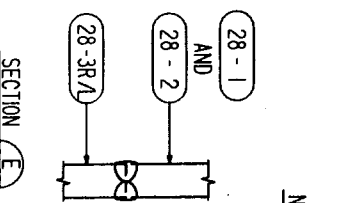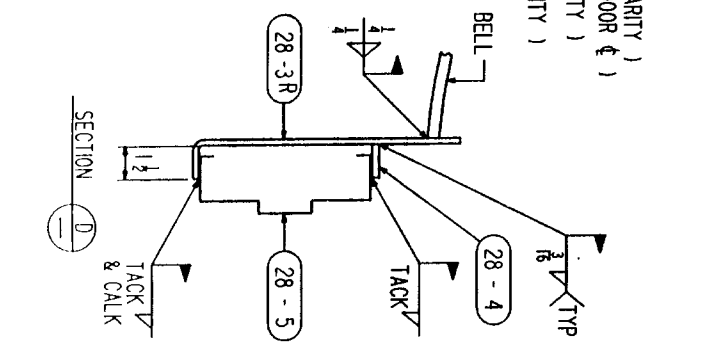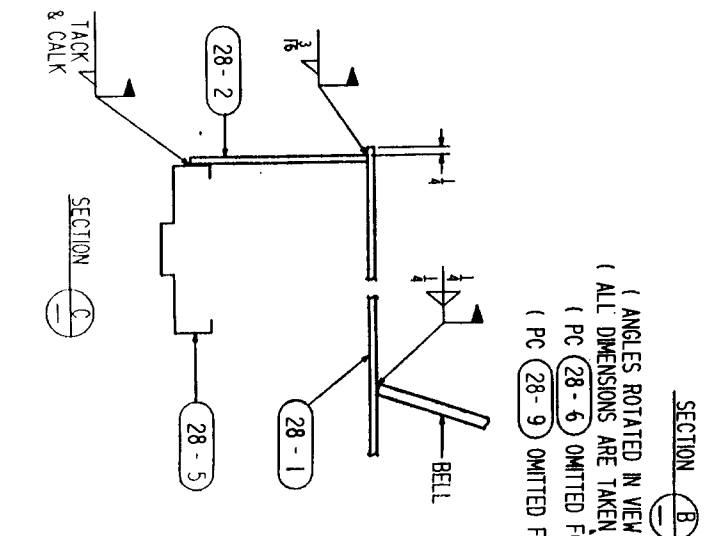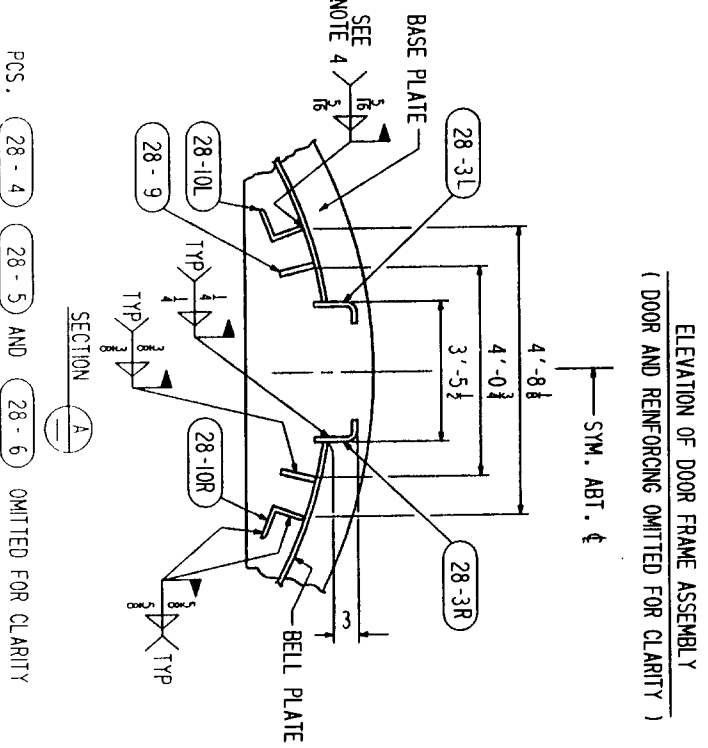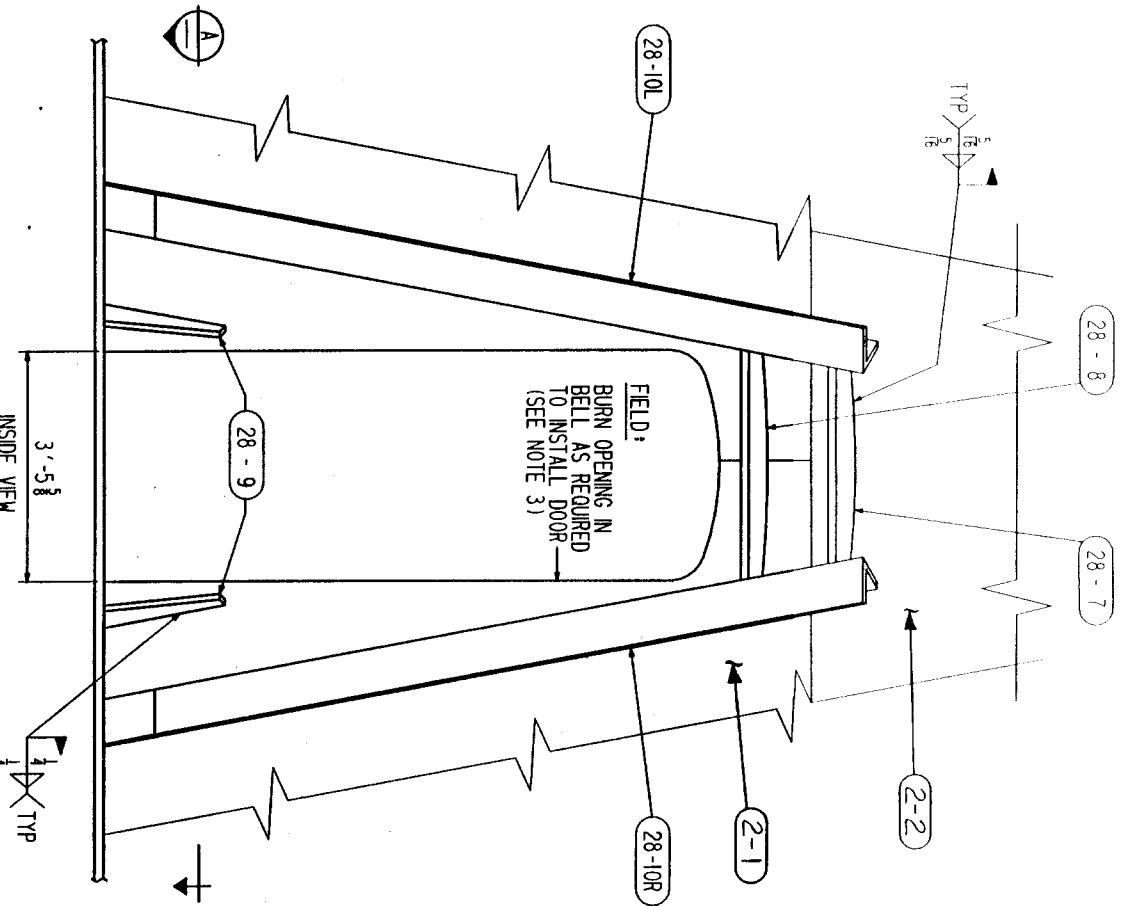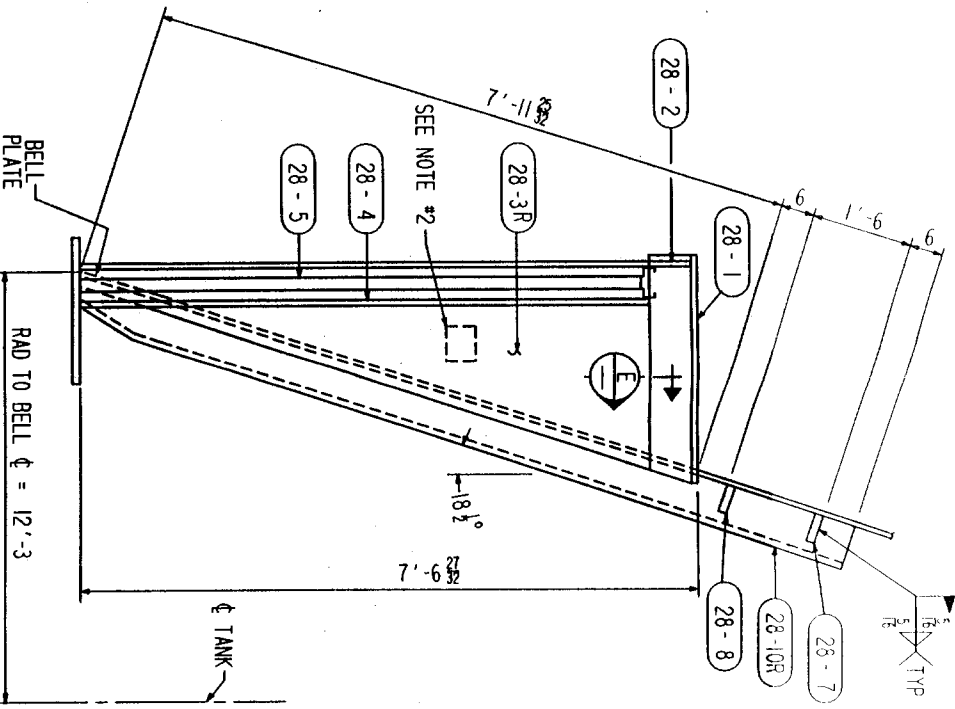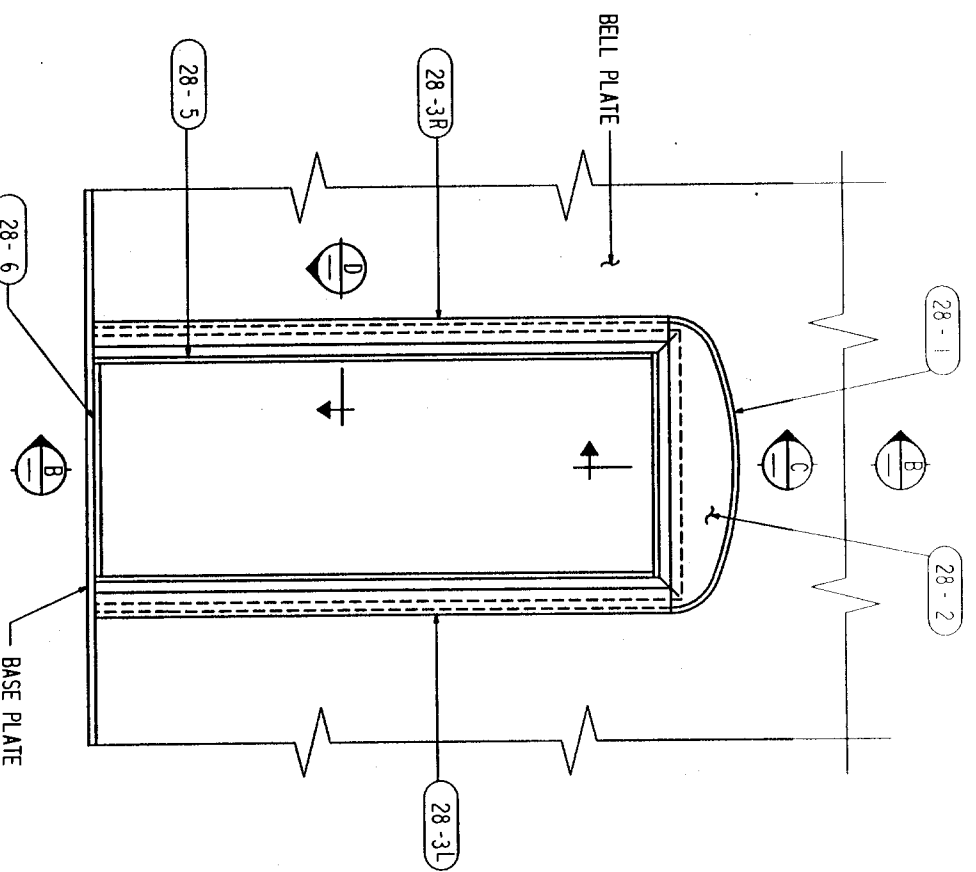

- NOTES:
1. LOCATE BELL DOOR ON VERTICAL SEAM OF BELL PLATE.
 2. WATERSPHEROID NAME PLATE, LOCATE BOTTOM EDGE APPROX. 5'-0" ABOVE GROUND, FASTEN WITH FOUR DRIVE SCREWS USE 3/8" DIA. OR #20 DRILL BIT FOR HOLES FOR NAME PLATE.
 3. DO NOT MAKE CUTOUT IN BELL FOR DOOR UNTIL REINFORCING IS WELDED IN PLACE.
 4. USE 3/8" CONTINUOUS FILET WELD FOR 3'-0" AT TOP AND 1'-6" AT BOTTOM. USE 3/8" INTERMITTENT FILET OF 2'-12" IN BETWEEN TOP AND BOTTOM CONTINUOUS WELDS.
 5. WORK THIS DRAWING WITH DRAWING 28.

INDICATES CHANGE FROM PREVIOUS ISSUE

BY	CHKD	DATE	REVISIONS	REMARKS

CUSTOMER'S NO. _____ CONTRACT NO. C806333

BY: J.N. CHOD ~~DATE 8/22/82~~ DATE 8/22/82

ENGINEERING SUPERVISOR: R.B. BRILESON

DWG 27










REV 0

36 X 80 BELL DOOR
 HOOD AND REINFORCEMENT ASSEMBLY
 500 M.G. WATERSPHEROID
 CITY OF RAMSEY, MINNESOTA

SUPPLIER'S / PURCHASER'S NO. D81582

CBI

THIS DRAWING HAS BEEN PREPARED FOR AND IS THE PROPERTY OF CBI AND IS TO BE USED ONLY IN CONNECTION WITH PERFORMANCE OF WORK BY CBI. REPRODUCTION IN WHOLE OR IN PART FOR ANY OTHER PURPOSE IS EXPRESSLY FORBIDDEN.

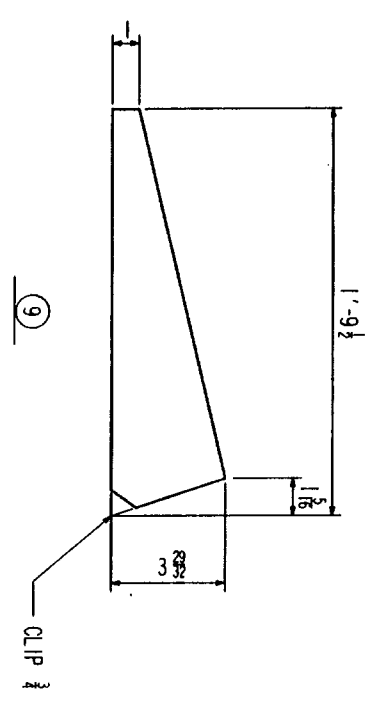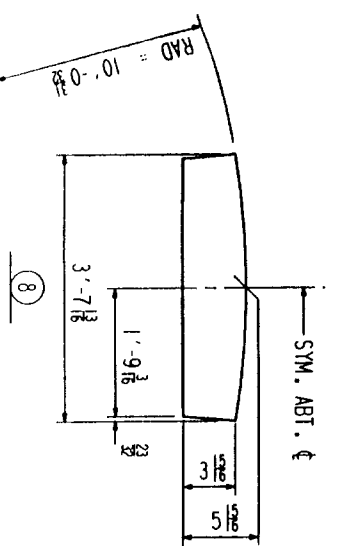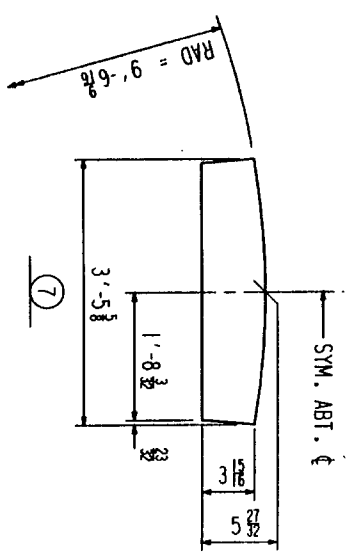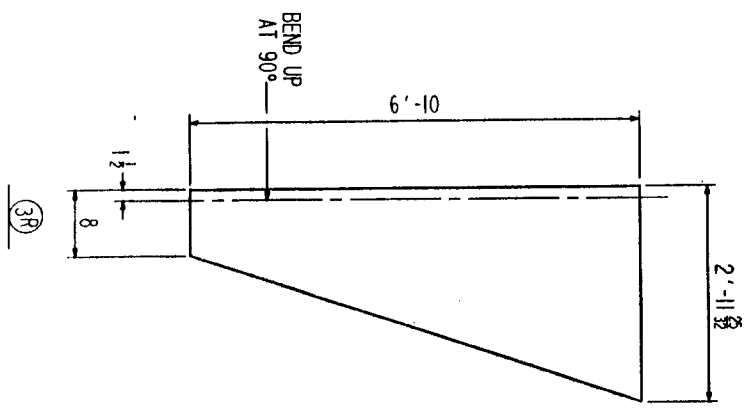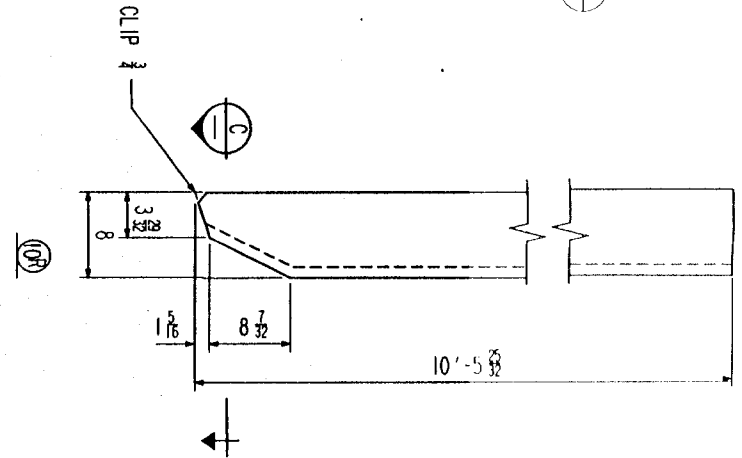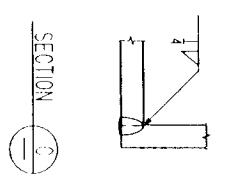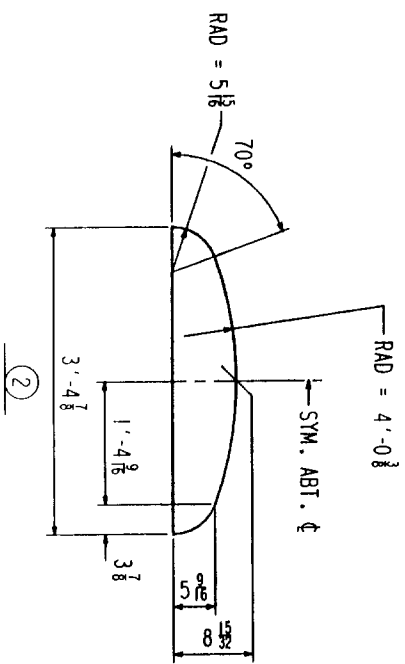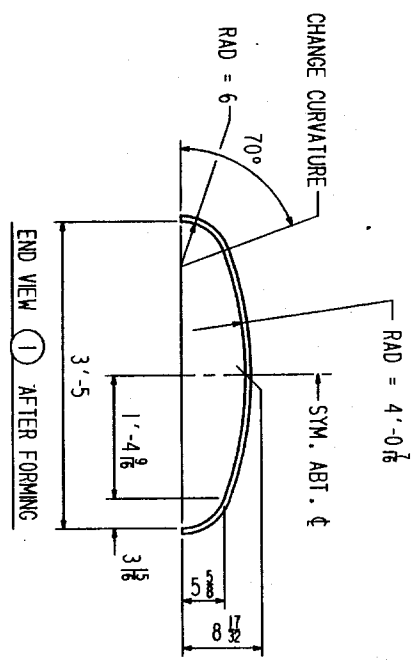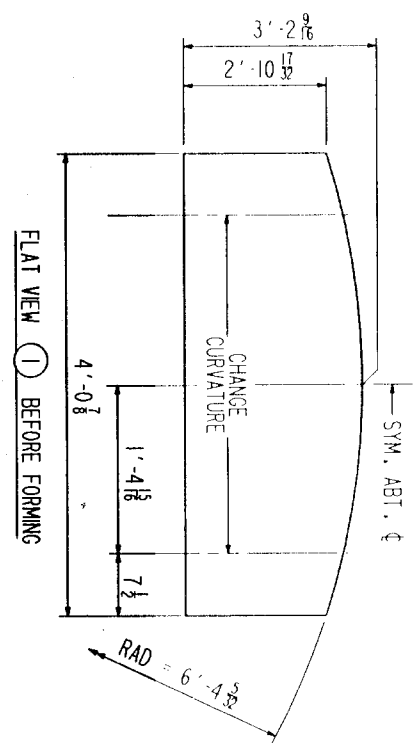

SHIP P.C.	MARK	ISSUE	DESCRIPTION	LENGTH ft	SPEC	QTY	CODE	EST	WT	AB
1	28-1		PL 5K X 1/4 (FORM)		A283C/A5-3	351		129		
			(C/F PL 39 3/4 X 4'-2)							
1	28-2		PL 5K X 1/4		A283C	5-3	351	19		
			(C/F PL 9 1/2 X 3'-6)							
2	28-3	FAL	PL 5K X 1/4		A283C/A5-3	351		255		
			(C/F PL 45 1/2 X 6'-11 1/2)							
2	28-4		BAR FLAT 1 1/2 X 1/4	6	A36	5-3	351	17		
			DOOR CECC IMPERIAL			0-0	300	161		
			IM-3068 M-LHR (16 GA.) WITH							
			FRAME KD 16 GA. 5 3/4							
			HINGES FULL MORTISE 2110-NRP-USP							
			LOCKSET MORTISE			0-0	300	3		
			CECC #A8048/KD/05/10							
			THRESHOLD CECC 424/30		ALUM	0-0	300	3		
1	5/45		NAME PL WATERSPHEROID		SS	0-0	300	1		
4			SCREWS #10 PARKER DRV		SS	0-0	300	0		
1	28-7		PL 5K X 1/2		A283C/B5-3	351		28		
			(C/F PL 13 3/4 X 3'-9)							
1	28-8		PL 5K X 1/2		A283C/B5-3	351		30		
			(C/N 28-7)							
2	28-9		PL 5K X 1/2		A283C/B5-3	351		15		
			(C/F PL 7 X 1'-10 3/4 Q/2)							
2	28-10R/L		L 8 X 8 X 1 SMOE	10	A36	B5-3	351	1070		

INDICATES CHANGE FROM PREVIOUS ISSUE

WORK THIS DRAWING WITH DRAWING 27

SUPPLIER'S / PURCHASER'S NO. **DB1582**

CBI


36 X 80 BELL DOOR
 HOOD AND REINFORCEMENT ASSEMBLY
 500 M.C. WATERSPHEROID
 CITY OF RANSEY, MINNESOTA

CONTRACT NO. **C80633**

BY: **R.B. BRILESON**
 ENGINEERING SUPERVISOR

DATE: **8-26-86**

THIS DRAWING HAS BEEN PREPARED FOR AND IS THE PROPERTY OF CBI AND IS TO BE USED ONLY IN CONNECTION WITH PERFORMANCE OF WORK BY CBI. REPRODUCTION IN WHOLE OR IN PART FOR ANY OTHER PURPOSE IS EXPRESSLY FORBIDDEN.

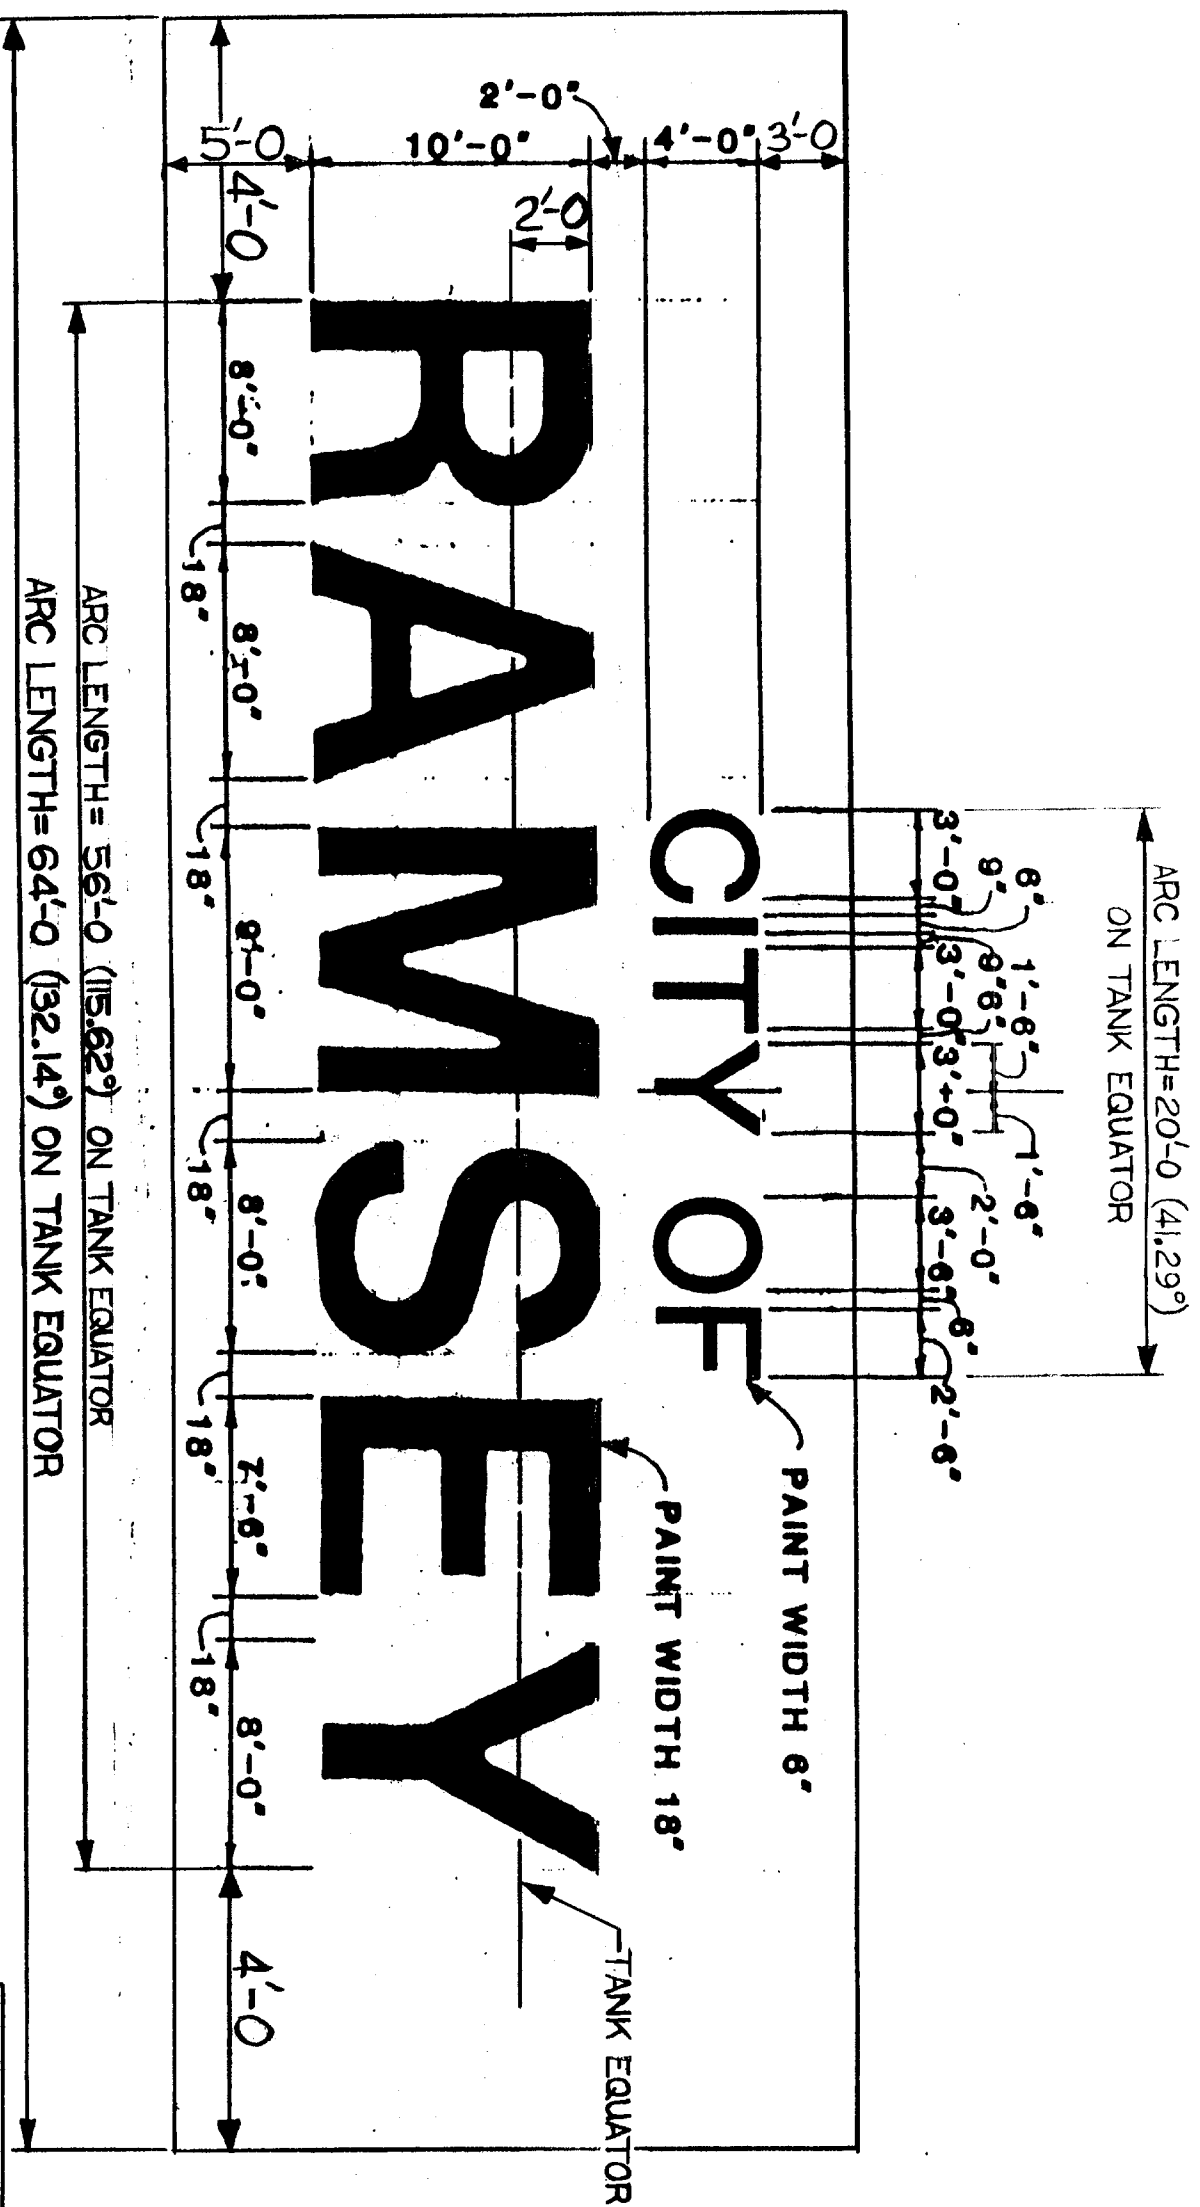

EXTERIOR LETTERING

AFTER THE FINAL EXTERIOR COAT HAS BECOME THOROUGHLY DRY, PAINT THE ABOVE SIGN ON 2 SIDES OF THE TANK SHELL IN ACCORDANCE WITH PAINT SHEETS. THE EXACT SHAPE, SIZE, AND SPACING OF THE LETTERS SHALL BE AS SHOWN ABOVE. THE EXACT LOCATION AND COLOR OF THE LETTERING SHALL BE DESIGNATED BY THE CUSTOMER'S REPRESENTATIVE. (LETTERS TO BE PAINTED SOLID)

By	Chkd	Date	By	Chkd	Date

Revisions

Remarks

SUPPLIER'S/PURCHASER'S NO. D81582

CBI Na-Con, Inc.

Na-Con

SIGN DETAIL




Purchaser's No. _____ Contract No. **C80633**

By **JFN** Chkd **OKJ** Date **8-26-88**

Engineering Supervisor **R.B. BURLERSON** Dwg: **SD1** Rev. **0**

This drawing is the property of CBI Na-Con, Inc. and is to be used only in connection with performance of work by CBI Na-Con, Inc. Reproduction in whole or in part for any other purpose is expressly forbidden.

Indicates change from previous issue

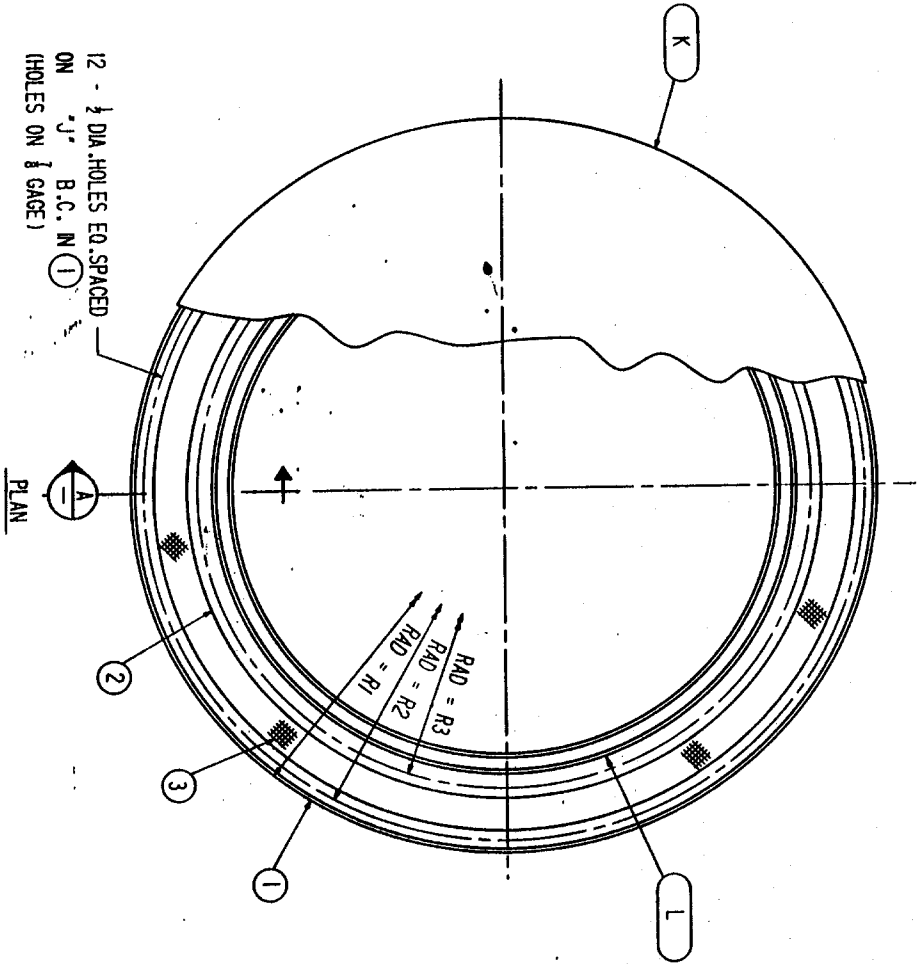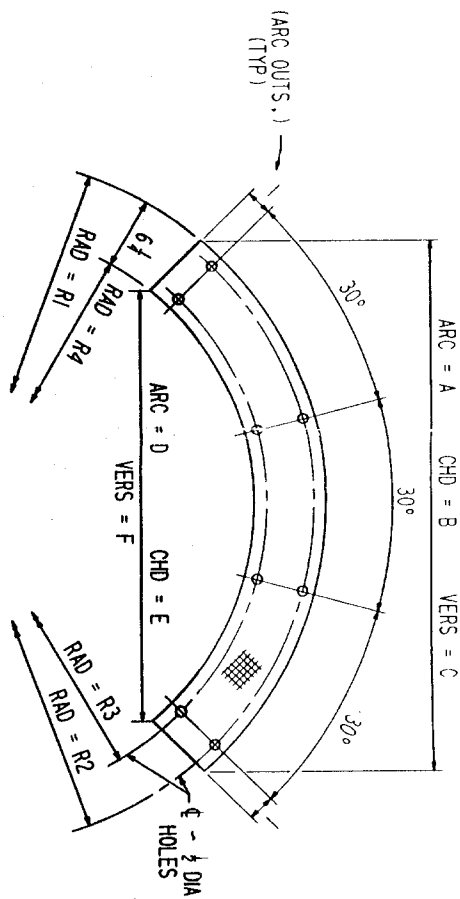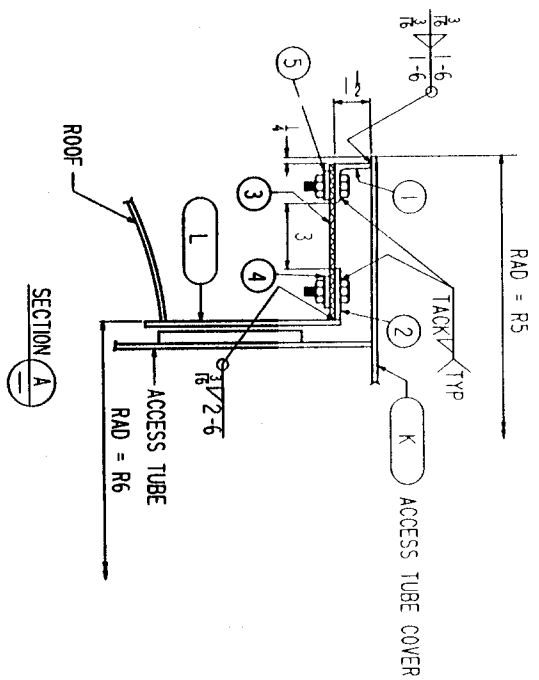


VENT SIZE	RADIUS R1	RADIUS R2	RADIUS R3	RADIUS R4	RADIUS R5	RADIUS R6	ARC A	CHD B	VERS C	ARC D	CHD E	VERS F	G	H	J	PC MK. K	PC MK. L
36	2'-1 1/2	2'-0 3/8	1'-8 1/4	1'-7 1/4	2'-1 1/4	1'-7	3'-6 1/8	3'-1 1/8	8 1/2	2'-7 1/4	2'-4 3/8	6 1/2	3'-2	3'-3	4'-1 1/4	4B2-4	4B2-5
42	2'-4 1/2	2'-3 3/8	1'-11 1/4	1'-10 1/4	2'-4 1/4	1'-10	3'-10 3/8	3'-5 1/8	9 1/2	3'-0 1/2	2'-8 1/8	7 1/2	3'-6	3'-3	4'-7 1/4	4C3-4	4C3-5
48	2'-7 1/2	2'-6 3/8	2'-2 1/4	2'-1 1/4	2'-7 1/4	2'-1	4'-3 3/8	3'-9 1/8	9 1/2	3'-5 3/8	3'-0 1/2	7 1/2	3'-10 1/8	3'-6 1/2	5'-1 1/4	SEE BILLS	SEE BILLS

DIMENSIONS FOR 36 ACCESS TUBE

PC. MK.	M	N	P	R	S	T
1	13'-4 1/2	16'-4	24	-	-	-
2	10'-5 3/8	13'-6	18	40 1/2	42	38
4	10'-7 1/4	13'-7	7	40 1/2	41 1/2	39 1/2
5	12'-10 3/8	15'-11	8	49 1/2	50 1/2	48 1/2


DIMENSIONS FOR 42 ACCESS TUBE

PC. MK.	M	N	P	R	S	T
1	14'-11 1/2	17'-11	27	-	-	-
2	12'-0 1/2	15'-0	20	46 1/2	48	44
4	12'-2 3/8	15'-2	8	46 1/2	47 1/2	45 1/2
5	14'-5 1/8	17'-6	9	55 1/2	56 1/2	54 1/2

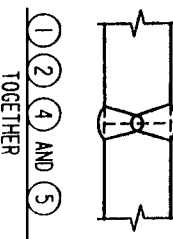

SHOP MARK	ASSEMBLY	DESCRIPTION	LENGTH	SPEC ID	QTY	CODE	EST WT	AB-LIN
05-1	1	SHOP ATTACH TO ACCESS TUBE COVER WITH HOLES	M	A36	5-33410	P		
05-2	1	SHOP ATTACH TO ACCESS TUBE COVER WITH HOLES	N	A36	5-33410	P		
05-3	12	BOLT FIN HEX 3/8 DIA	0	A307B	0-02100			
05-4	12	NOT FIN HEX 3/8 DIA	0	A563A	0-02100			
05-5	4	SCREEN W/ 1/2" WIRE MESH (SK) WITH HOLES (1/2" DIA WIRE)	0		0-03410			
05-6	1	BANDING NOT NECESSARY						
05-7	1	EQ. SPOD. ON 1/2 DIA BOLT HOLES	M	A36	5-33410	P		
05-8	1	EQ. SPOD. ON 1/2 DIA BOLT HOLES	N	A36	5-33410	P		

SEE GENERAL PLAN - #16 WIRE MESH DIAMETER = .018 AND #4 WIRE MESH DIAMETER = .047. BRASS & STAINLESS STEEL USE BRASS EXCEPT WHEN REQUIRED BY CUSTOMER.

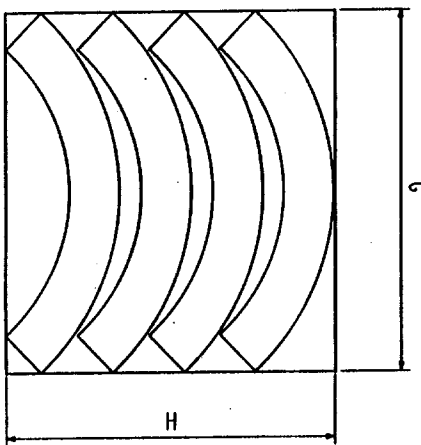

INDICATES CHANGE FROM PREVIOUS ISSUE

1, 2, 4 AND 5 TOGETHER

REVISIONS

BY	CHKD	DATE	REVISIONS

REMARKS


36, 42, AND 48 DIAMETER ACCESS TUBE

APPROVED BY: RBB DATE: 7/1/85



STANDARD DRAWING NO. 05-1

SCREENED VENT FOR 36, 42, AND 48 DIAMETER ACCESS TUBE


THIS DRAWING HAS BEEN REPRODUCED FOR AND IS THE PROPERTY OF CBI AND IS TO BE USED ONLY IN CONNECTION WITH PERFORMANCE OF WORK BY CBI. REPRODUCTION IN WHOLE OR IN PART FOR ANY OTHER PURPOSE IS EXPRESSLY PROHIBITED.

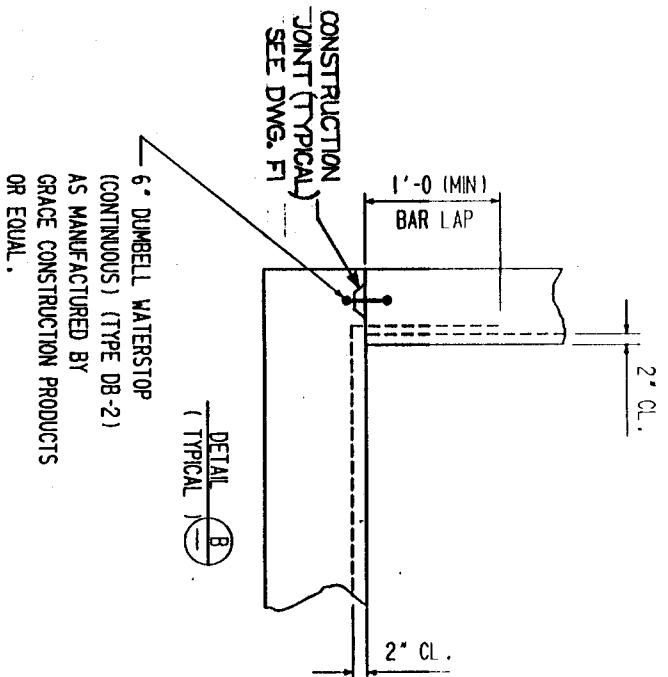

*Review!
 Electrical Sheet
 location
 4'-1" ELEC. GROUNDS
 1'-3" AIR-DE-TERMINATE
 1'-3" ELECTRIC SERVICE*

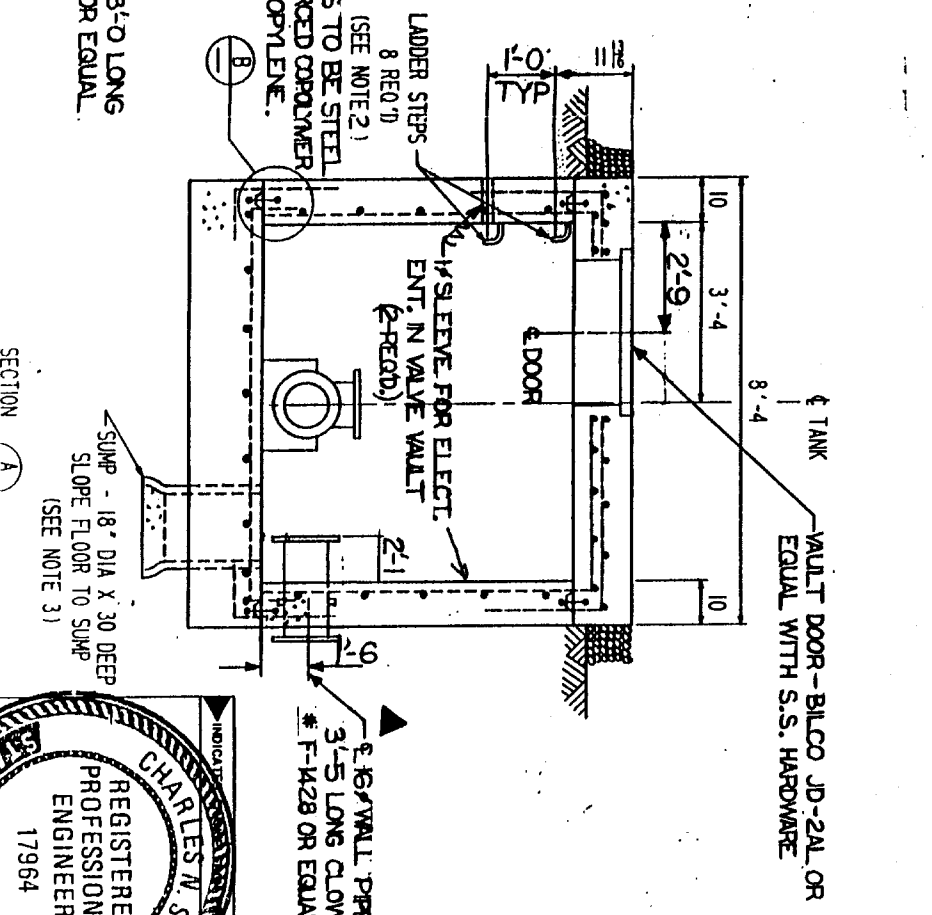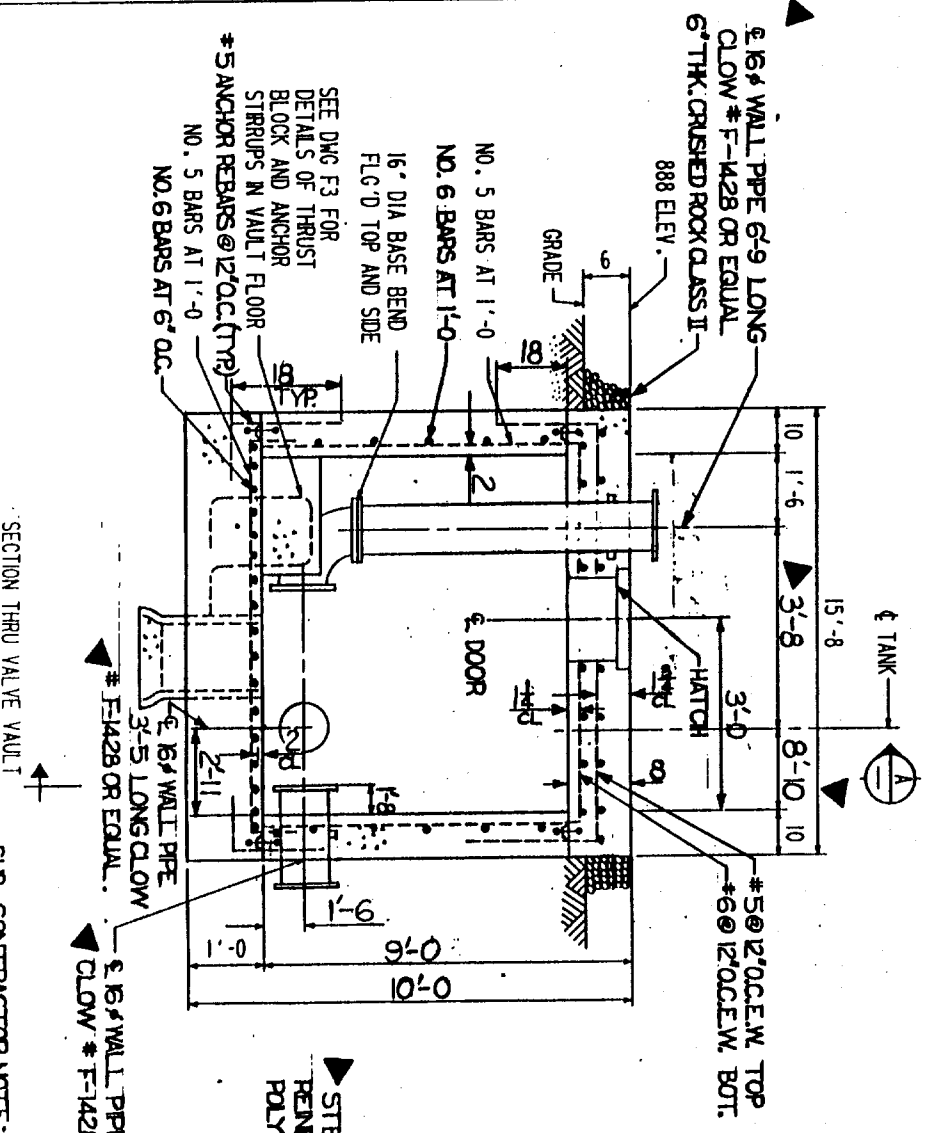

SUB-CONTRACTOR NOTE:
 SEE SHEETS 9, 10, & 11 OF 14 OF CUSTOMER'S SPECS. FOR
 REMAINDER OF PIPING DETAILS. SEE ATTACHED CUSTOMER'S
 DRAWING PIPE PLAN TOWER VAULT.

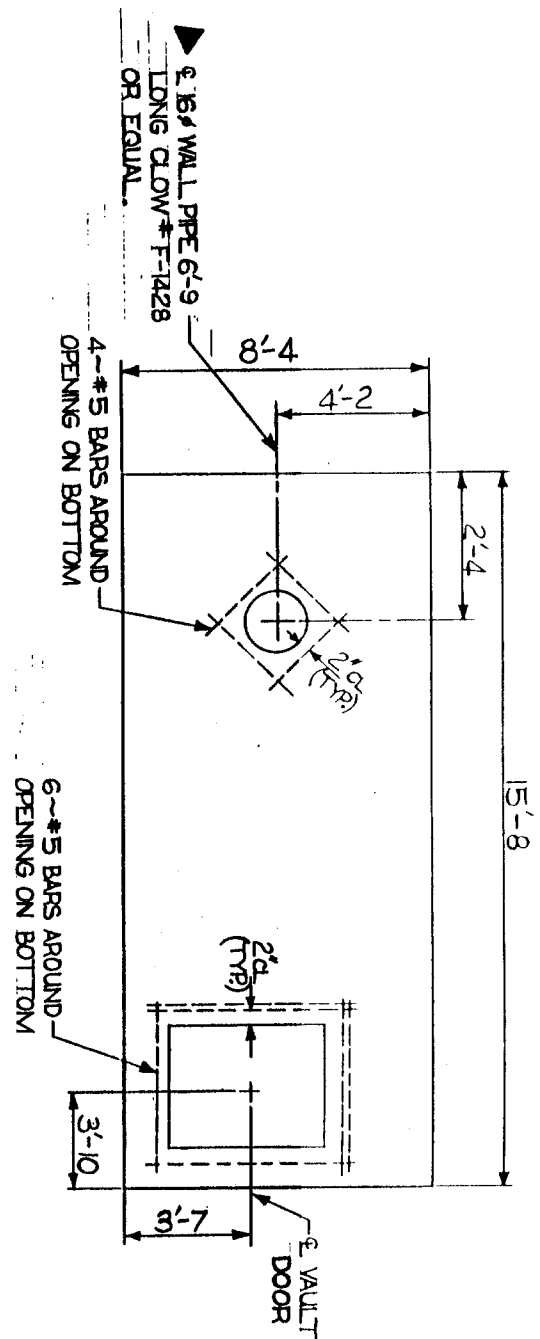


PLAN OF COVER

I hereby certify that this plan, specification, or report was prepared by me or under my direct supervision and that I am a duly Registered Professional Engineer under the laws of the State of Minnesota.

Charles Muel
 Date 8-9-88 Registration No. 17964

NOTES:

- WORK THIS DRAWING WITH DRAWING F1 AND F3+CUSTOMER'S DWG.
- SEE DRAWING F1 FOR TRUE ORIENTATION OF LADDER STEPS AND SUMP.

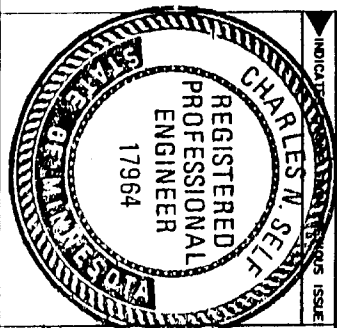


REVISIONS	REMARKS
1	REVISED PER CUST. APPROVAL

CUSTOMER'S NO.	VALVE VAULT
BY	J.M. CHOD
DATE	7-6-88
ENGINEERING SUPERVISOR	R.B. BURTON
DWG. NO.	C80633
REV.	

FILE COPY
 RAS:15-4

NOT TO SCALE

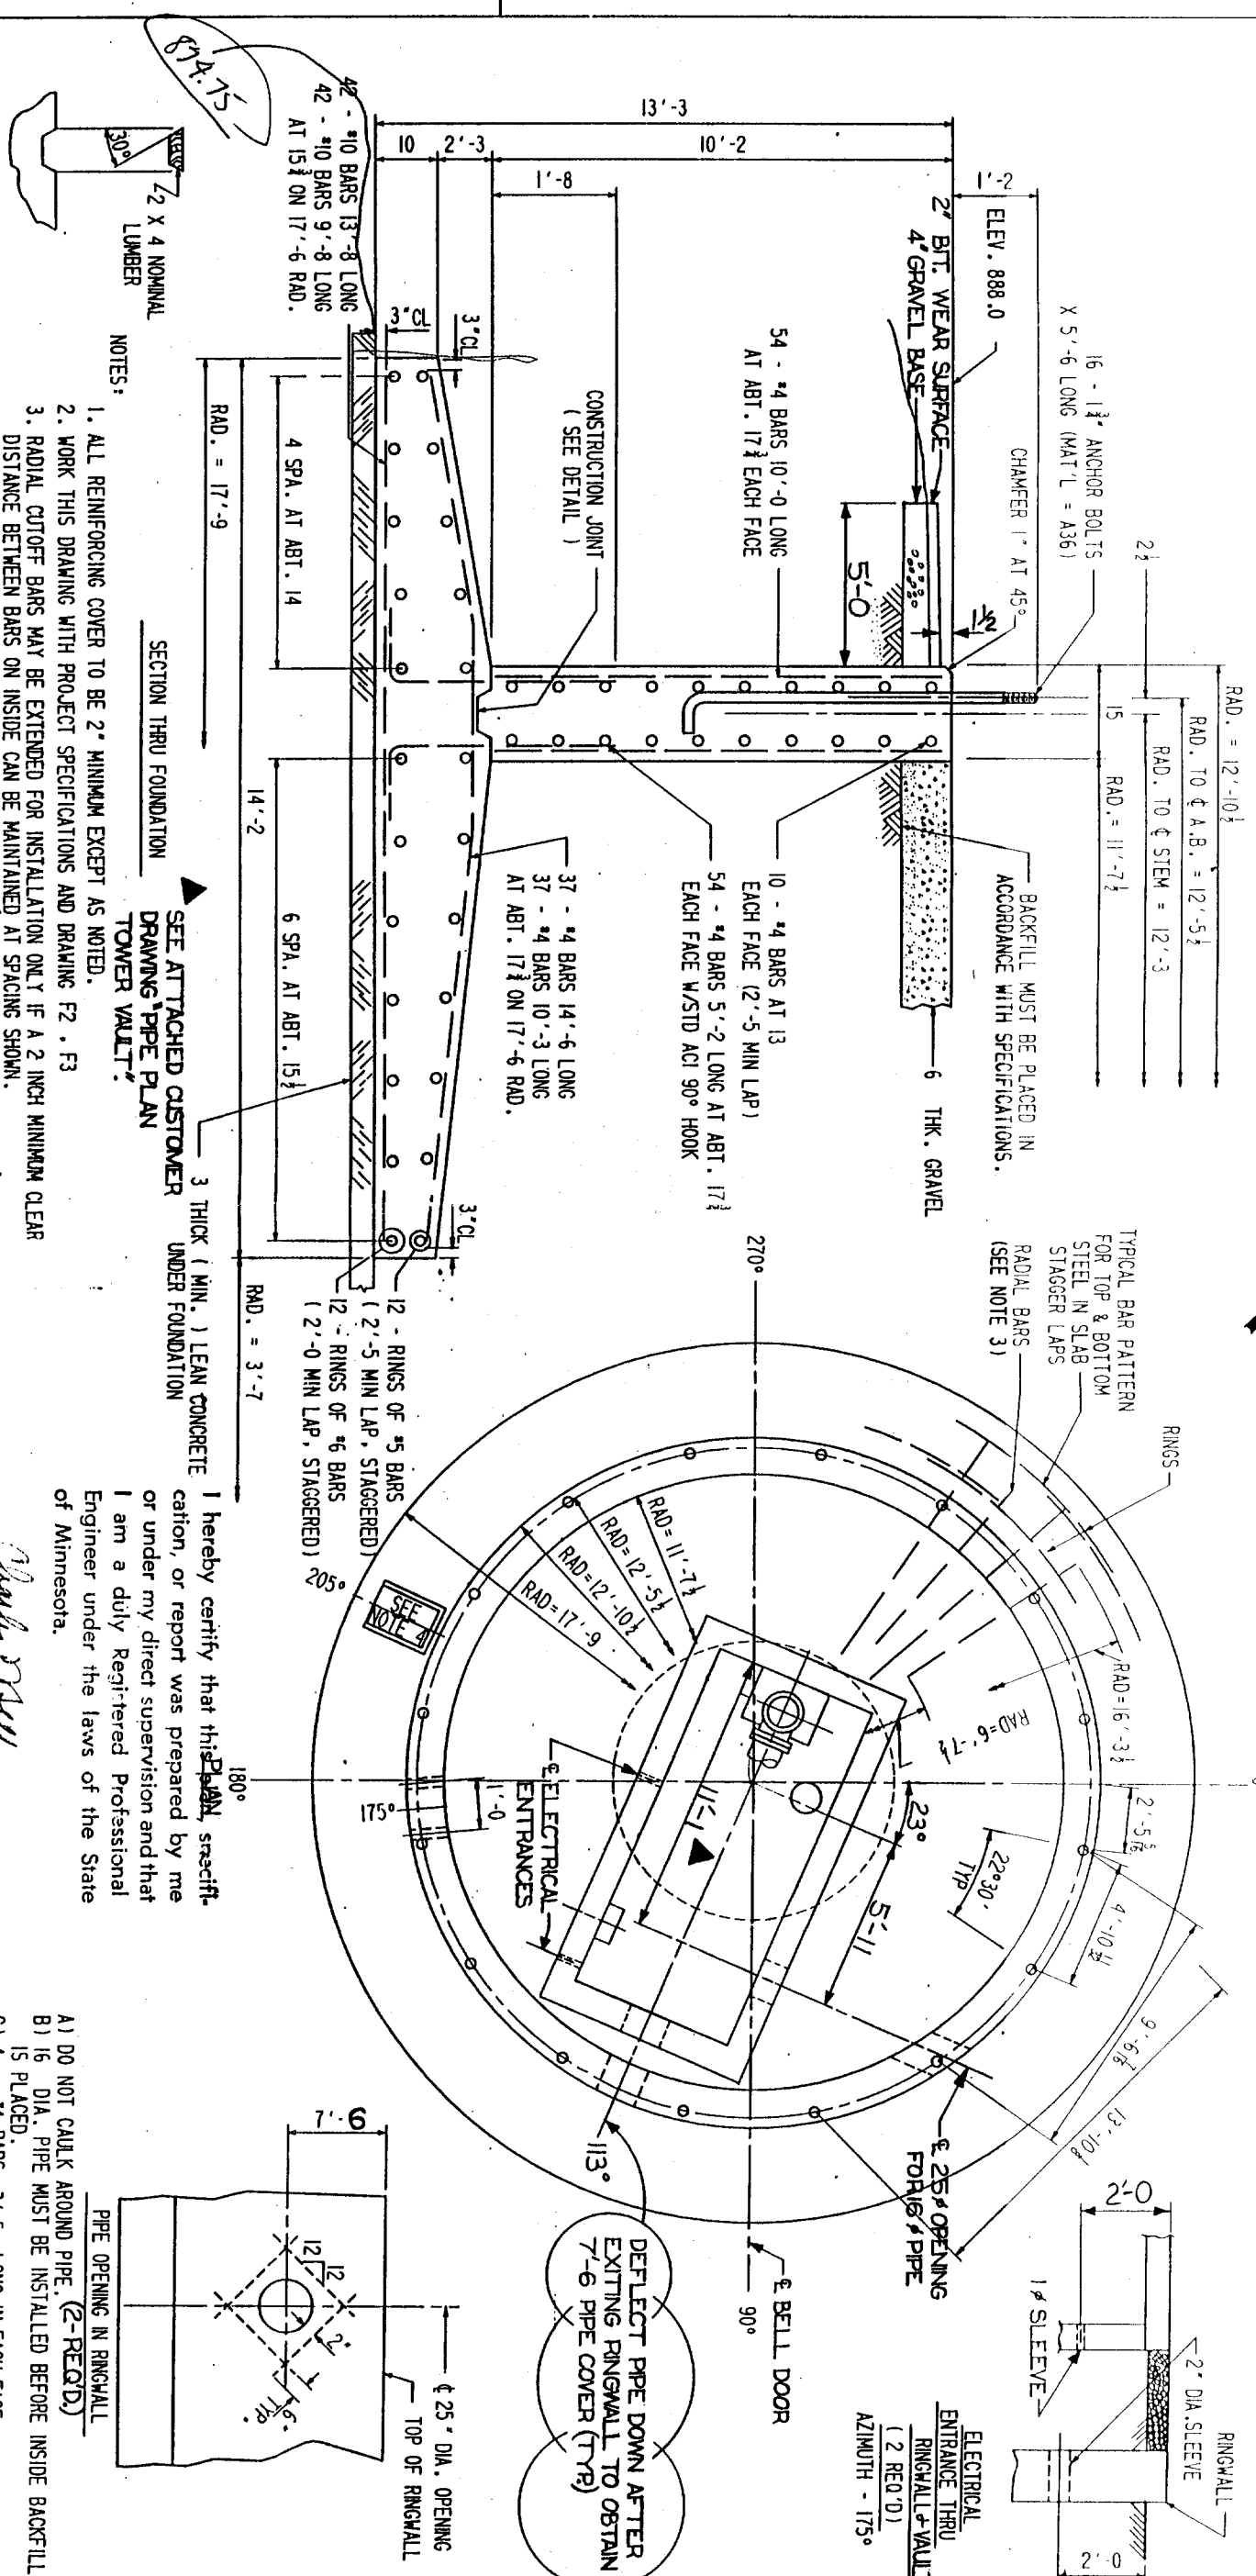

TYP. CONSTRUCTION JOINT

- NOTES:
1. ALL REINFORCING COVER TO BE 2" MINIMUM EXCEPT AS NOTED.
 2. WORK THIS DRAWING WITH PROJECT SPECIFICATIONS AND DRAWING F2, F3.
 3. RADIAL CUTOFF BARS MAY BE EXTENDED FOR INSTALLATION ONLY IF A 2 INCH MINIMUM CLEAR DISTANCE BETWEEN BARS ON INSIDE CAN BE MAINTAINED AT SPACING SHOWN.
 4. SPLASH PAD AT AZIMUTH 205°, 4'-0" x 10'-0" x 1'-0" (SEE CUST. DWS. SHT. 7)
 5. LADDER TO BE LOCATED A MIN. OF 15" FROM ϕ OF VAULT WALL.

I hereby certify that this ~~plan~~ specification, or report was prepared by me or under my direct supervision and that I am a duly Registered Professional Engineer under the laws of the State of Minnesota.

Charles M. Self
 Date: 8-9-88 Registration No. 17964

ESTIMATED FOUNDATION QUANTITIES


ITEM	CONCRETE (CU. YDS.)	REIN. STEEL (LB.)
END. STEM	36.2	1850
END. BASE SLAB	74.7	7450
VALVE VAULT	19	2150
TOTAL	129.9	11450

TABLE OF LOADINGS

ITEM	LOAD (KIPS)	BEARING PRESSURE (PSF)
WATER	4231.9	305.1
METAL	305.1	136.5
CONCRETE (44 PCF)	136.5	
TOTAL W/O WIND	4673.5	4922
OVERTURNING MOMENT (KIP-FT)	6156	1404
MAXIMUM TOE PRESSURE (PSF)		6326

TOLERANCES:
 TOP OF RINGWALL TO BE TROWELLED LEVEL AND TO BE WITHIN $\pm 1/4$ " OF THEORETICAL ELEVATION. ANCHOR BOLTS TO BE WITHIN $1/4$ " OF THEORETICAL POSITION. TO BE PLUMB WITHIN $1/2$ " AND WITH PROJECTION ABOVE THE TOP OF RINGWALL WITHIN $1/4$ " OF THE SPECIFIED HEIGHT.

SEE SPECIFICATIONS BY CUSTOMER AND C.B.I.. ALL CONCRETE TO HAVE 4000 P.S.I. COMP. STRENGTH IN 28 DAYS. REINFORCING STEEL TO HAVE MINIMUM YIELD STRENGTH OF 60000 P.S.I. AND CONFORM TO ASTM A615 (SI) GR. 60. ALL MATERIAL UNLESS OTHERWISE NOTED TO BE FURNISHED AND INSTALLED BY FOUNDATION CONTRACTOR. ANCHOR BOLTS ARE FURN. BY C.B.I.. PIPE COVER = 6'-7" (AT RINGWALL)

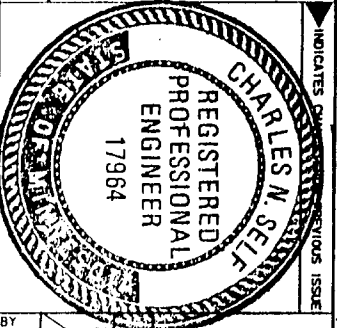

REVISIONS

BY	CHKD	DATE	REVISIONS
JFM	JFM	7/27/88	REVISED PER CUST. APPROVAL

REMARKS

FOUNDATION PLAN FOR 500 M.G. WATERSPHEROID CITY OF RANSEY, MINNESOTA

CUSTOMER'S NO. 081582
 SUPPLIER'S/PURCHASER'S NO. 081582

CONTRACT NO. C80633


BY: R.B. BIRLSON, ENGINEERING SUPERVISOR
 DATE: 7-6-88

NOTE: ANCHOR BOLTS ARE EQUALLY SPACED AS SHOWN. USE CHORDS FOR CHECKING PURPOSES ONLY.

IMPROVEMENT PROJECT 84-13

PUMP HOUSE AND HYDRO-PNEUMATIC TANK

CITY OF RAMSEY

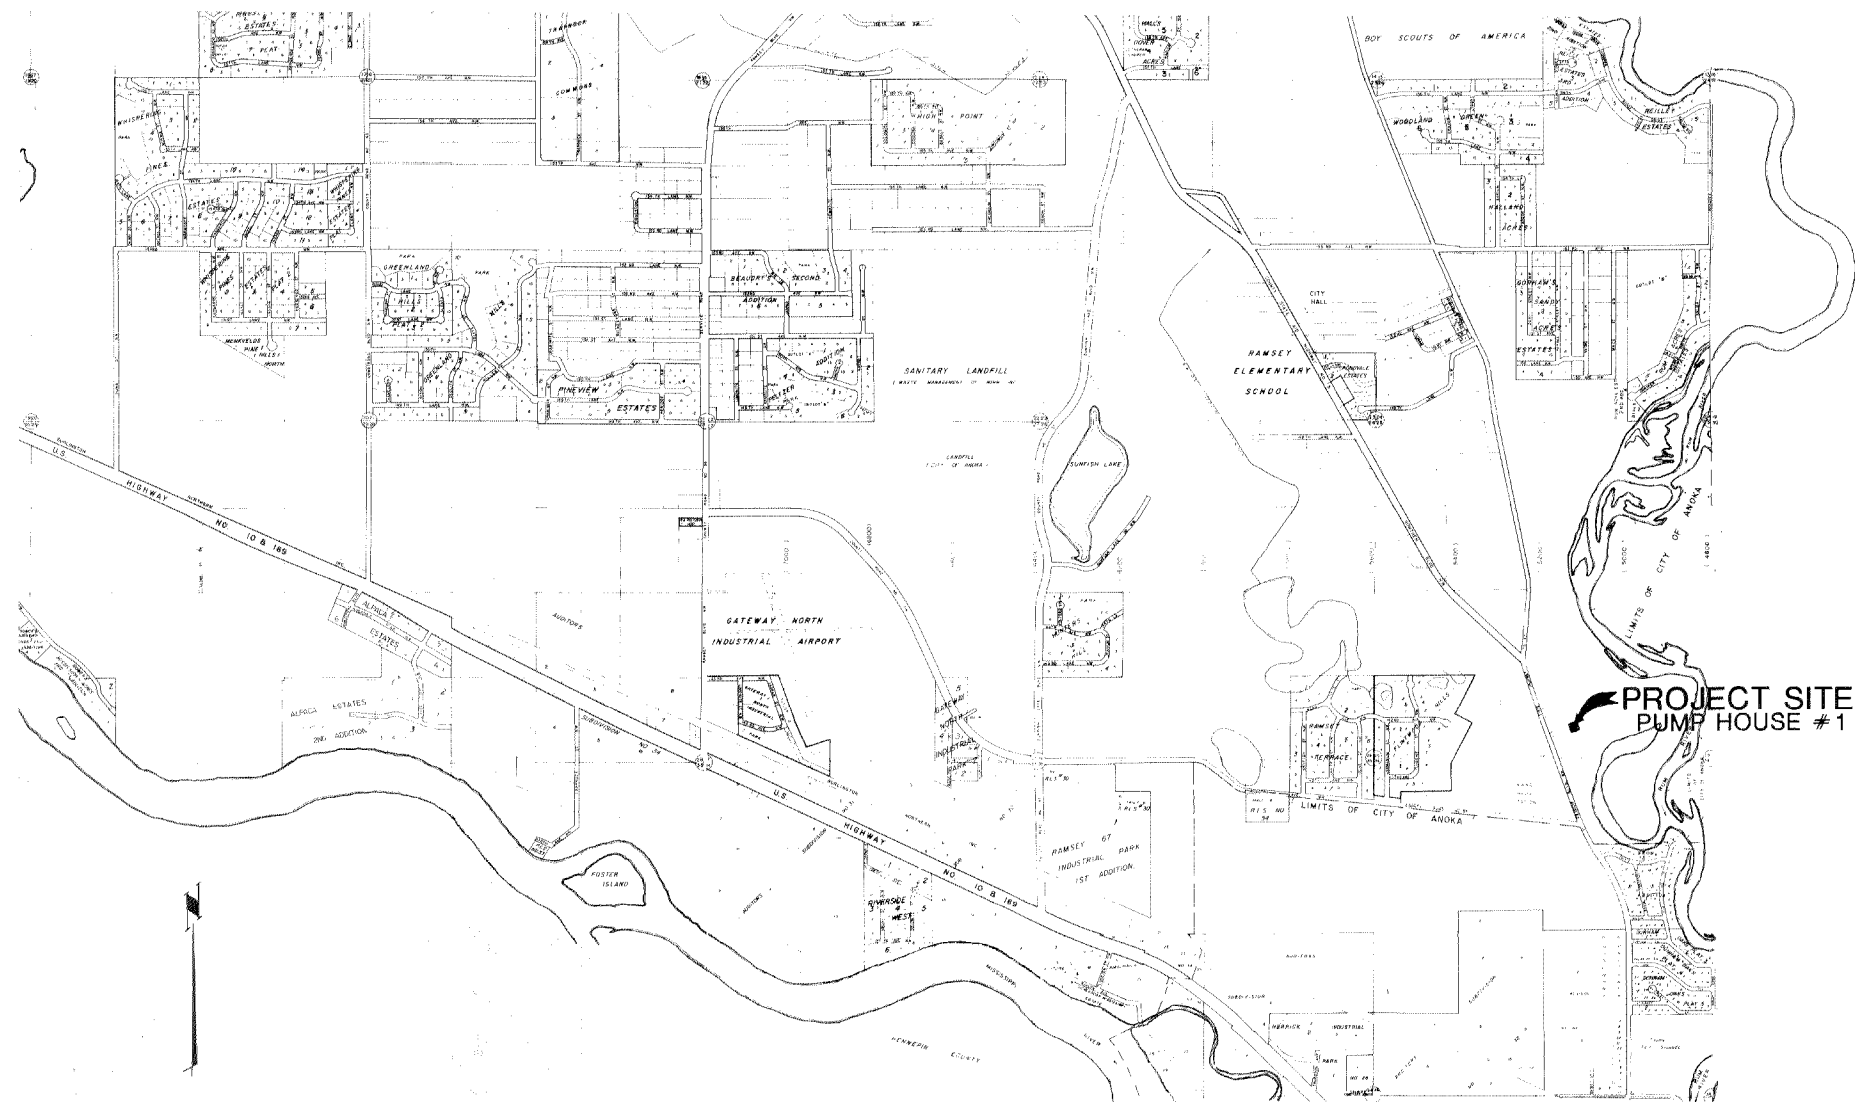


LOCATION MAP
SCALE: 1" = 1500'

INDEX TO PLAN SHEETS	
DESCRIPTION	SHEET
TITLE SHEET	1
SITE & LOCATION	2
FLOOR & FOOTING	3
BUILDING ELEVATION	4
MECHANICAL	5
HYDRO-PNEUMATIC TANK	6
ROOF PLANK & FLOOR DRAIN	7
BUILDING & DETAILS	8
ELECTRICAL SYSTEM DIAGRAM	9
ELECTRICAL POWER & CONTROLS	10
ELECTRICAL LIGHTING & GROUNDING	11
ELECTRICAL DETAIL	12
CONTROL DIAGRAMS	13


MINNESOTA DEPARTMENT OF TRANSPORTATION
Division of Environmental Management
This is to certify that this is a duplicate copy
of the plan referred to in report on
works improvements, dated
OCT 10 1984

I hereby certify that this plan,
specification, or report was prepared
by me or under my direct supervision
and that I am a duly Registered Pro-
fessional Engineer under the laws of
the State of Minnesota.
Lawrence G. Aschak
Date 9/26/84 Reg. No. 11261

Hakanson Anderson Associates, Inc.
engineers and surveyors
222 Monroe Street • Anoka, Minnesota 55303 • 612/427-5860

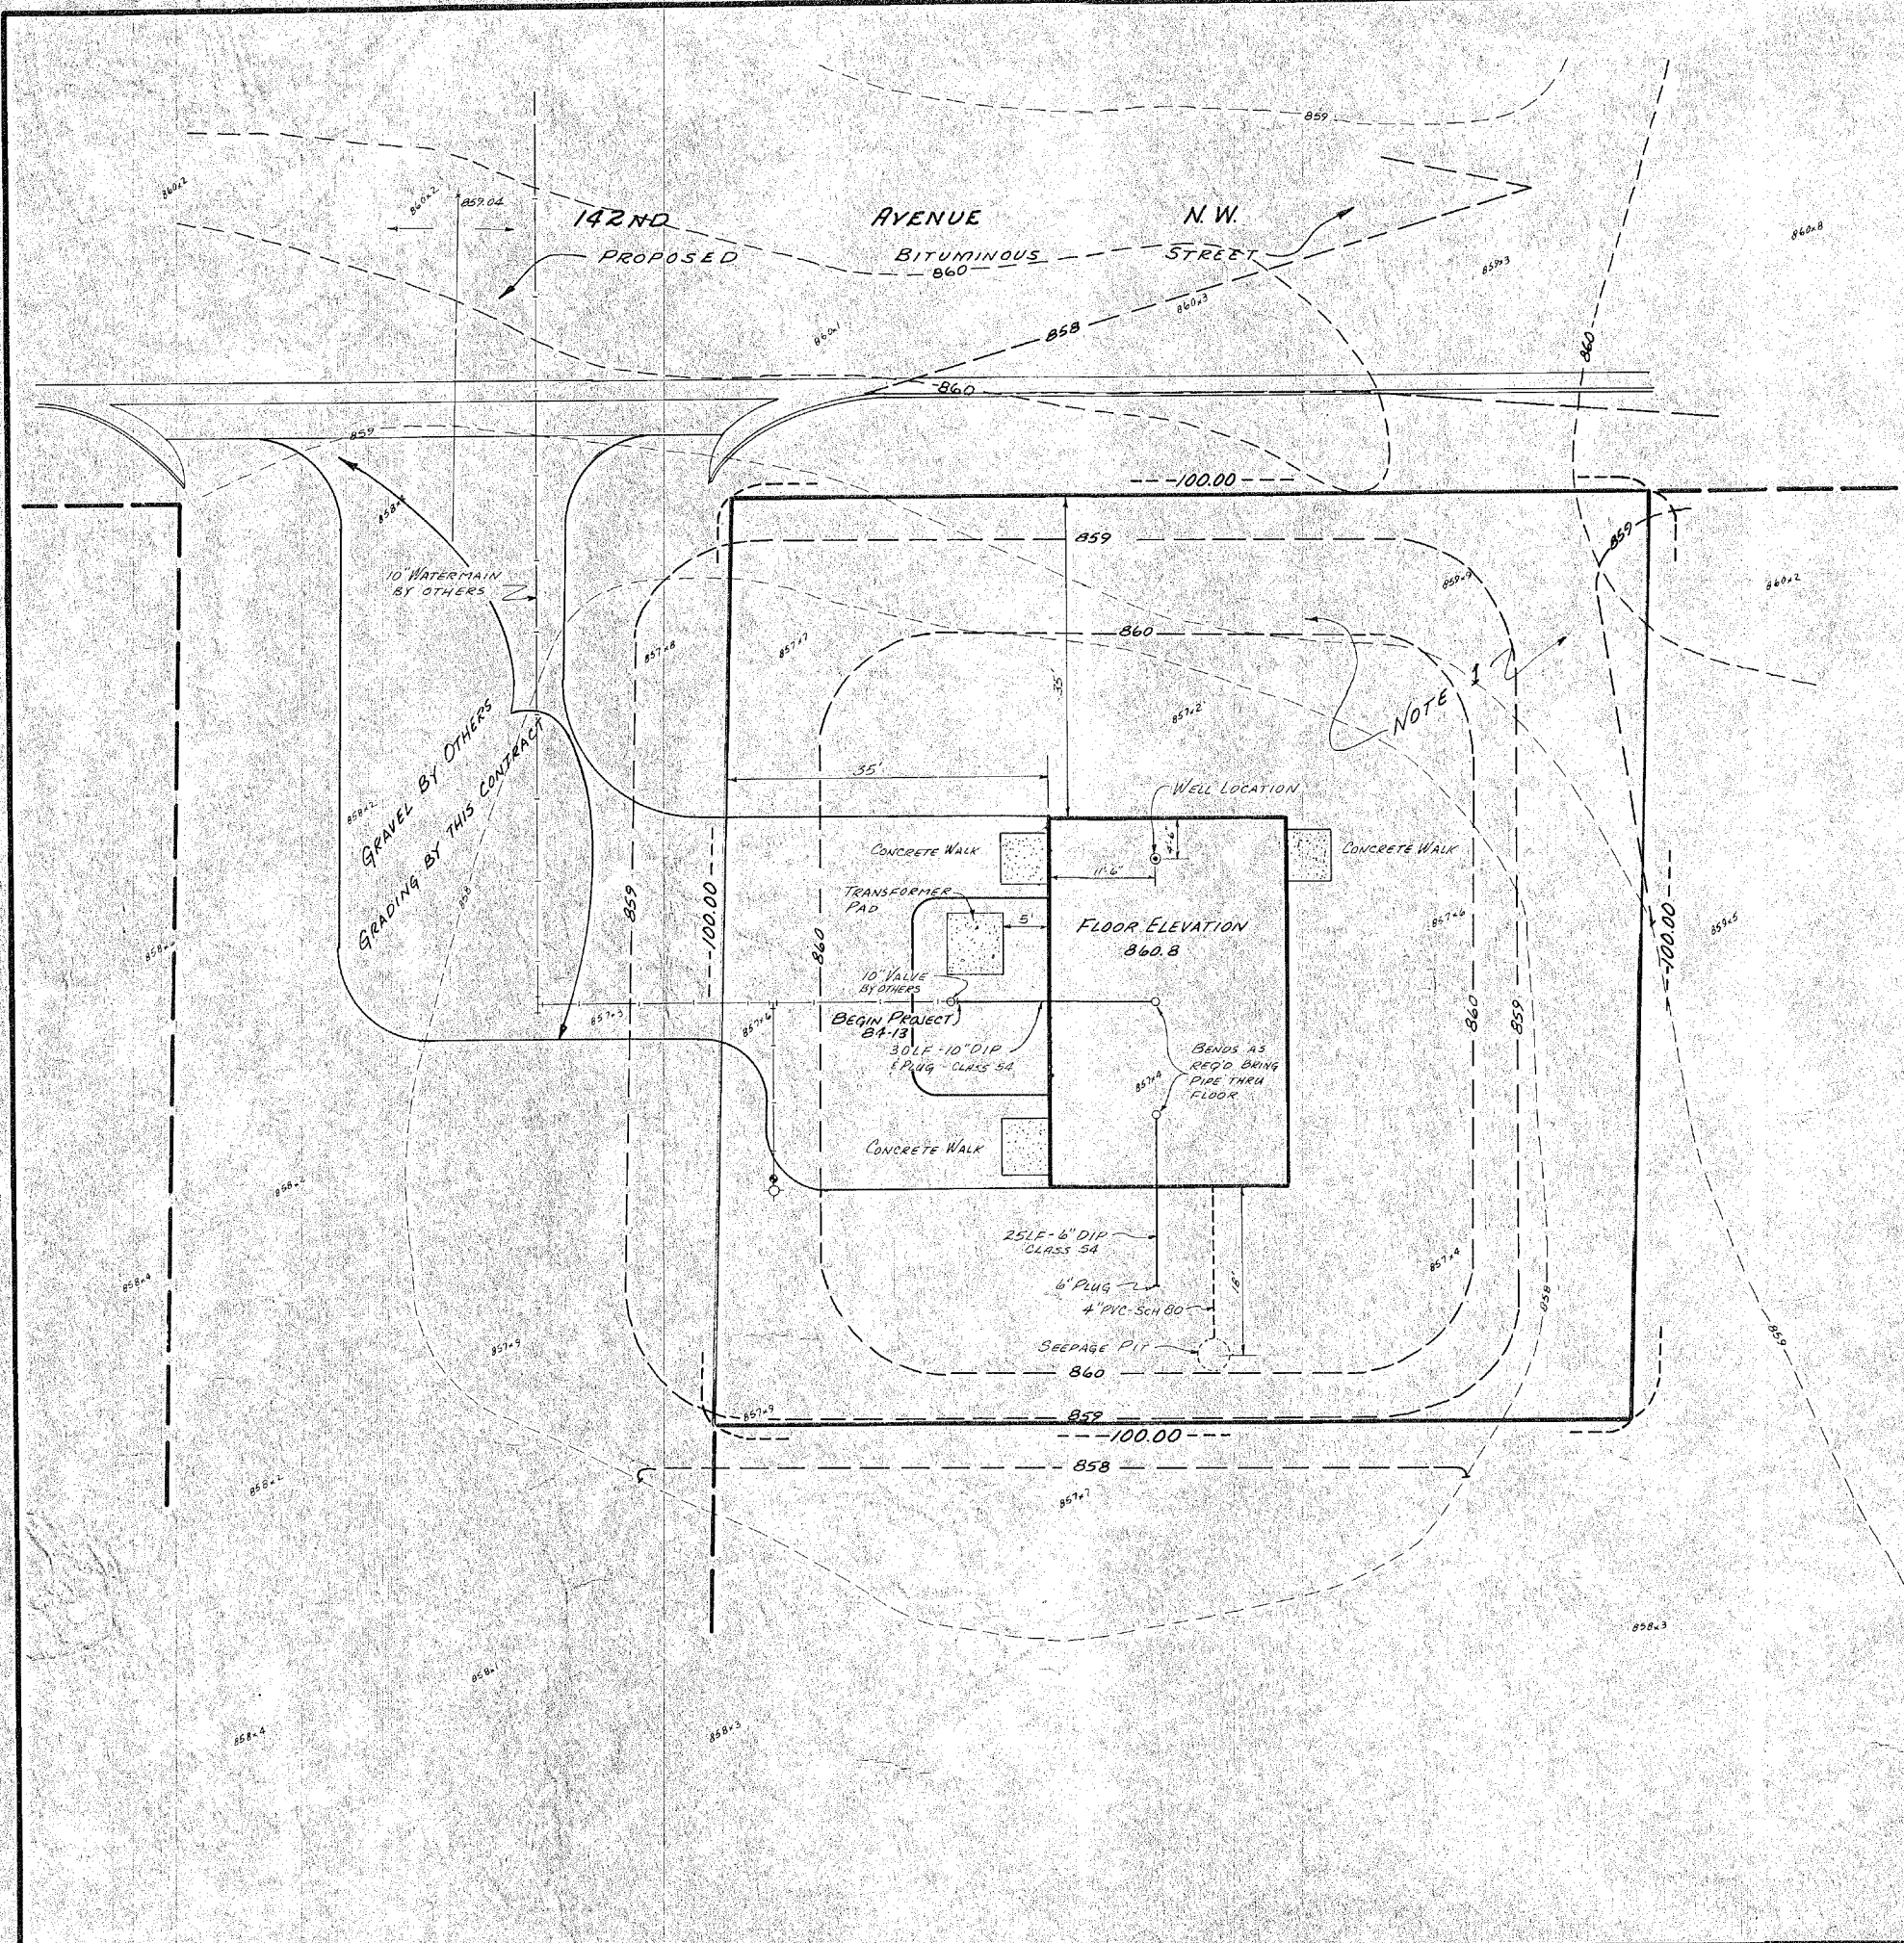

ST. FRANCIS BLVD.
(STATE TRUNK HIGHWAY No. 47)

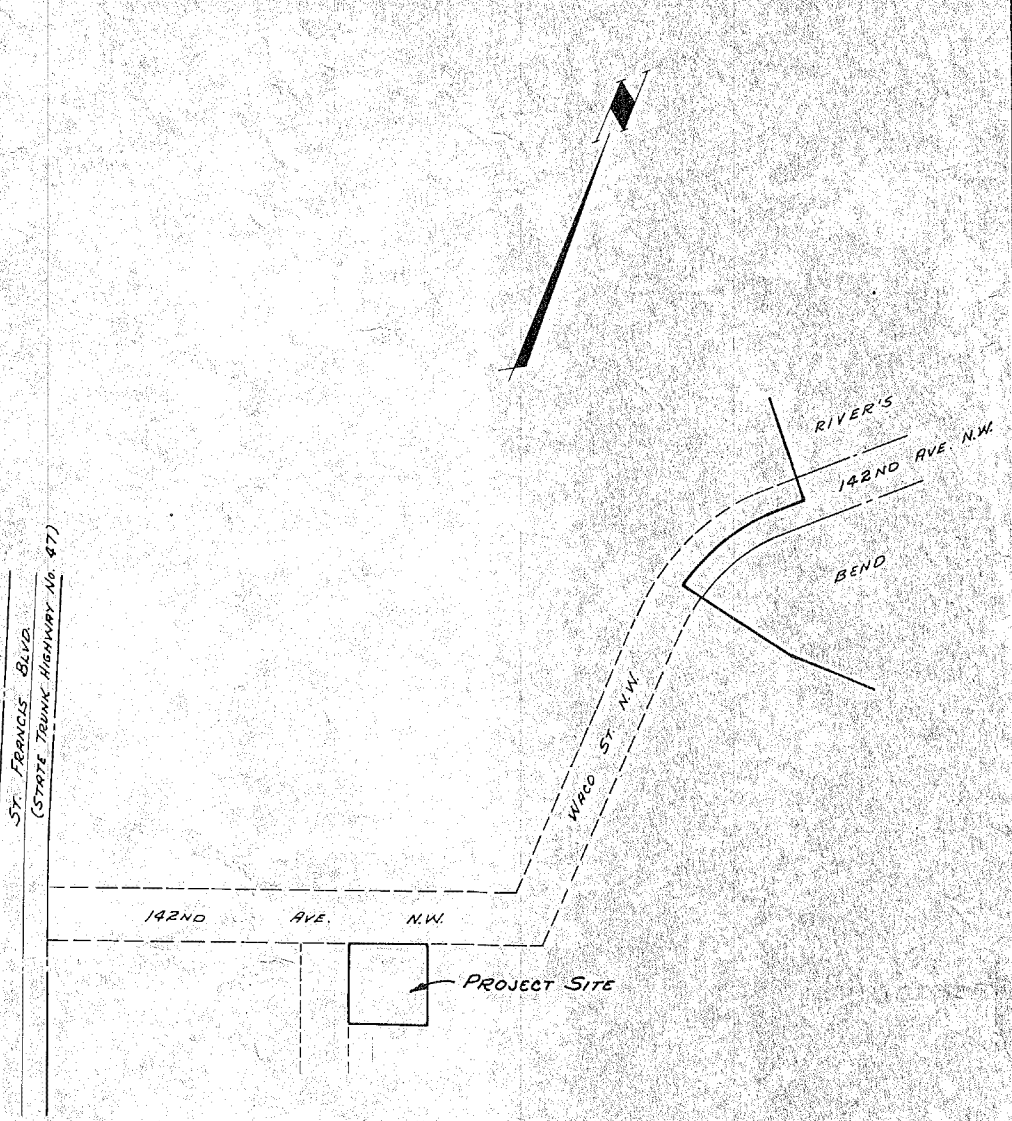

LOCATION MAP
NO SCALE

NOTES:

1. THE CONTRACTOR SHALL PLACE TOPSOIL, SEED, FERTILIZER AND MULCH OVER THE AREA DISTURBED BY HIS OPERATIONS.
2. ALL WATERMAIN SHALL BE BURIED A MINIMUM OF 7 1/2 FEET.
3. THE CONTRACTOR SHALL GRADE AND SHAPE THE ENTIRE SITE AND DRIVEWAY ACCORDING TO THESE PLANS.
4. SOIL BORING LOG AVAILABLE IN SPECIFICATIONS.


MINNESOTA DEPARTMENT OF HEALTH
Division of Environmental Health
This is to certify that this is a duplicate copy
of the plan referred to in report on water
works improvements, dated

OCT 10 1984


I hereby certify that this plan,
specification, or report was prepared
by me or under my direct supervision
and that I am a duly Registered Pro-
fessional Engineer under the laws of
the State of Minnesota.

Amundson
Date 9/26/84 Reg. No. 11261

IMPROVEMENT PROJECT 84-13		Scale	Hakanson Anderson Associates, Inc. engineers and surveyors
SITE & LOCATION PLAN		Horiz. 1" = 10'	
PUMP HOUSE #1 - HYDRO-PNEUMATIC		Vert. -	222 Monroe Street • Anoka, Minnesota 55203 • 612/427-3860
CITY OF RAMSEY		Book 95	
Revisions	Date 9-26-84	Sheet 2 of 13 sheets	File No. 845C-02-1
			Page 72-75
			Designed by L.G.K. Drawn by Larry Checked by P.R.R.

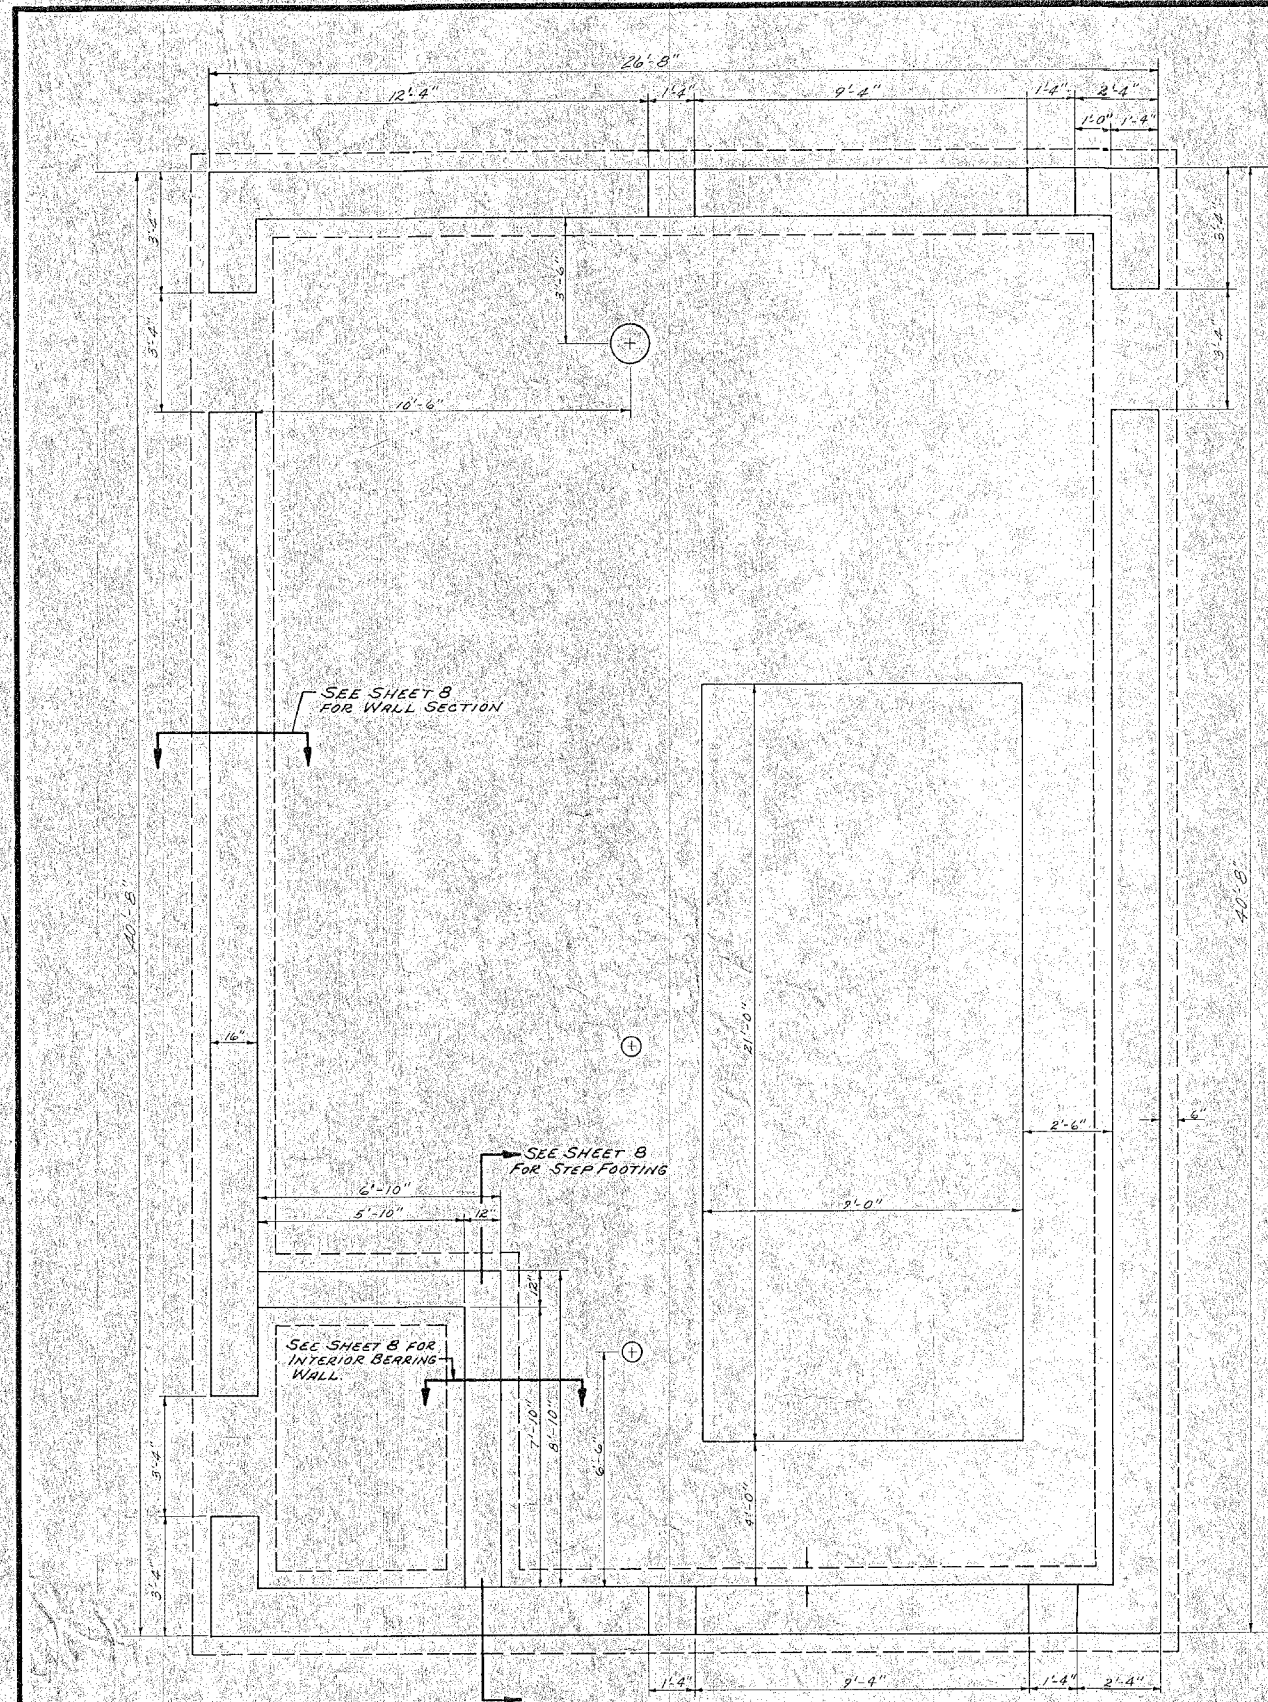

FOOTING PLAN
3/8" = 1'-0"

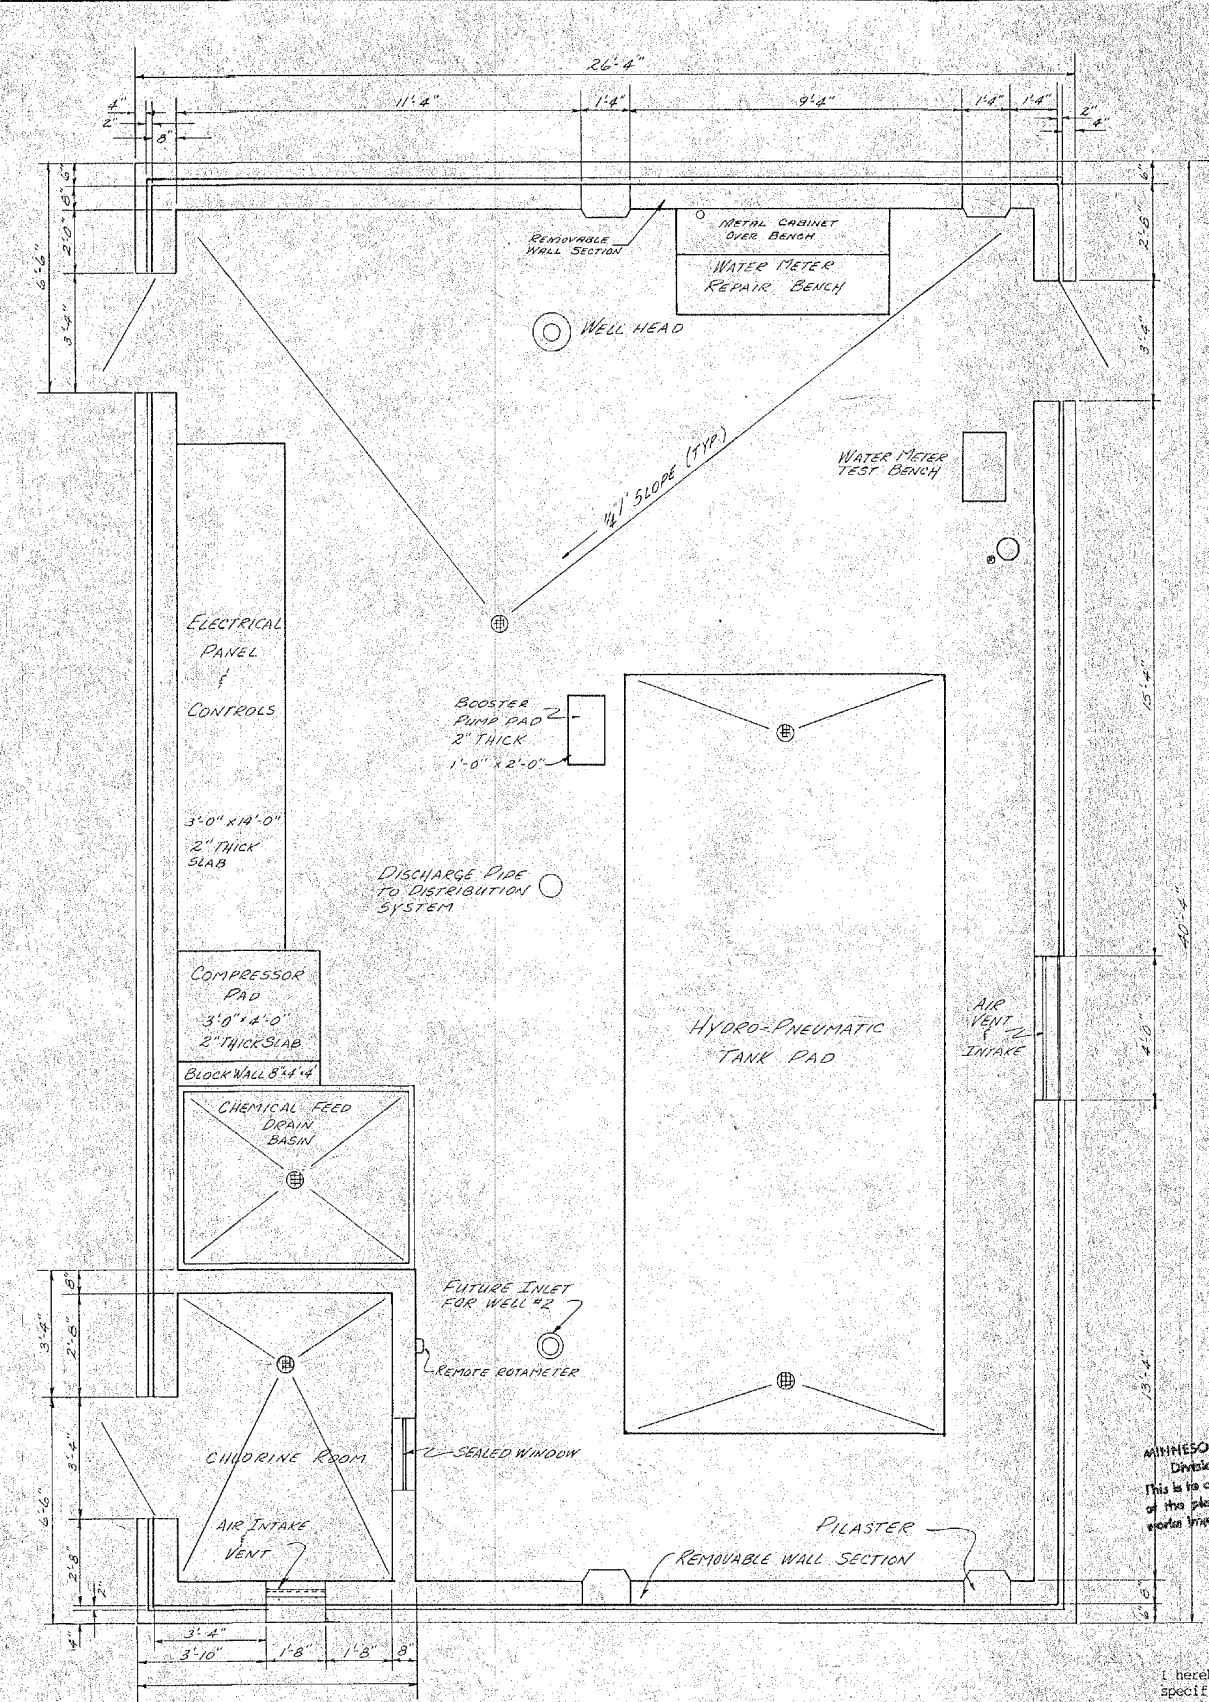


FLOOR PLAN
3/8" = 1'-0"


MINNESOTA DEPARTMENT OF HEALTH
Division of Environmental Health
This is to certify that this is a duplicate copy
of the plan referred to in report on water
works improvements, dated
OCT 10 1984

I hereby certify that this plan, specification, or report was prepared by me or under my direct supervision and that I am a duly Registered Professional Engineer under the laws of the State of Minnesota.
Lawrence W. Poshak
Date 9/26/84 Reg. No. 11261


IMPROVEMENT PROJECT 84-13 FLOOR PLAN - FOOTING PLAN PUMPHOUSE #1 - HYDRO-PNEUMATIC CITY OF RAMSEY		Scale Horiz. 3/8" = 1'-0" Vert. - Book -	Hakanson Anderson Associates, Inc. engineers and surveyors 222 Murray Street • Anoka, Minnesota 55303 • 612/427-5860
Revisions	Date 9-26-84	Sheet 3 of 13 sheets	File No. R45C-02-1 Page -
Designed by ZGK		Drawn by Auh	Checked by PRR

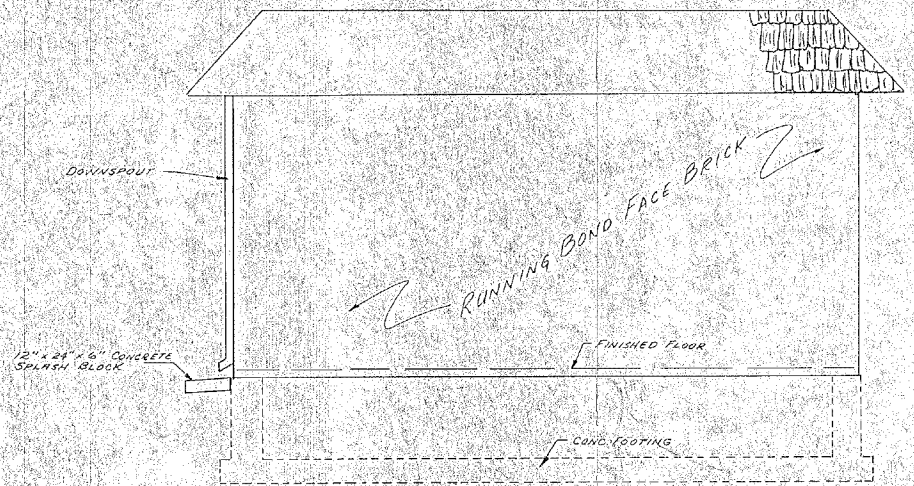


NORTH ELEVATION

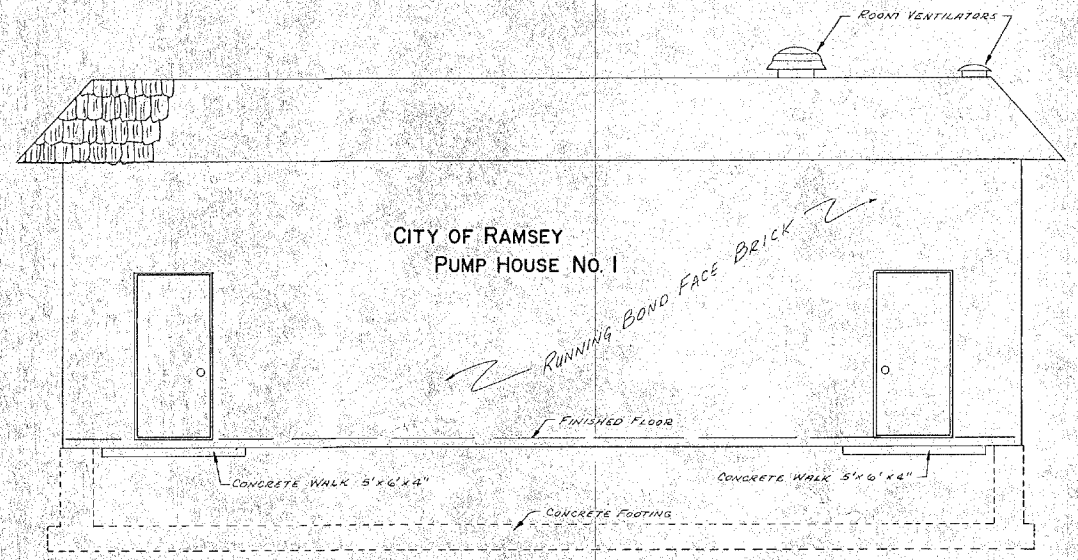

WEST ELEVATION

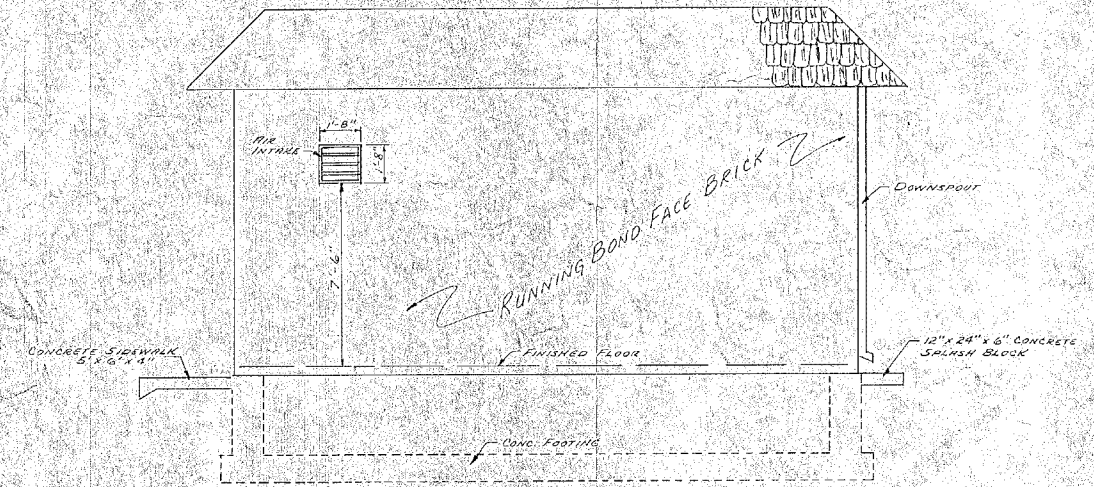

SOUTH ELEVATION

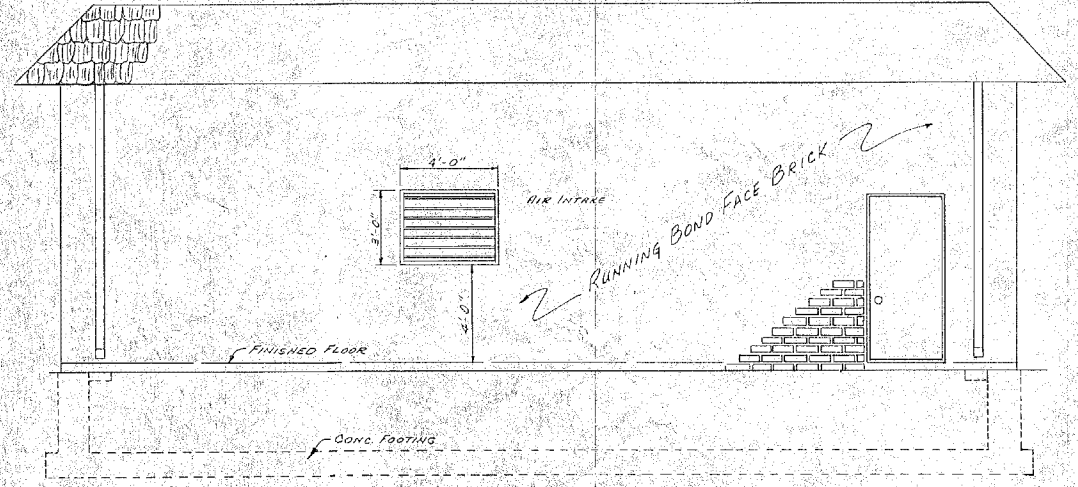

EAST ELEVATION


MINNESOTA DEPARTMENT of HEALTH
 Division of Environmental Health
 This is to certify that this is a duplicate copy
 of the plan referred to in report on water
 works improvements, dated
 OCT 4 1984

I hereby certify that this plan,
 specification, or report was prepared
 by me or under my direct supervision
 and that I am a duly Registered Pro-
 fessional Engineer under the laws of
 the State of Minnesota.
James D. Hestel
 Date 9/26/84 Reg. No. 11361


IMPROVEMENT PROJECT 84-13		Scale	Hakanson Anderson Associates, Inc. engineers and surveyors 232 Monroe Street • Anoka, Minnesota 55303 • 612/427-5800
BUILDING ELEVATIONS		Horiz. 1/4" = 1'-0"	
PUMPHOUSE #1 - HYDRO-PNEUMATIC		Vert. 1" = 1'-0"	
CITY OF RAMSEY		Book -	
Revisions	Date 9-26-84	Sheet 4 of 13 sheets	File No. RR5C-02-1
		Page -	Designed by LGK Drawn by HGL Checked by PRR

KRY

1. Air Compressor
2. Future Polyphosphate Tank & Mixer
3. Fluoride Acid Tank
4. Exhaust Hood
5. Water Meter Repair Bench
6. Water Meter Test Bench
7. Chlorine Gas Cylinders on Line
8. Chlorine Gas Cylinders in Storage
9. Exhaust Ventilator - Chlorine Room
10. Fresh Air Intake
11. Chlorine Gas Auto Switchover Module
12. Remote Chlorine Gas Flow Meter
13. 3/4" Service Water Tap & Water Line
14. Booster Pump
15. Chlorine Gas Line
16. Fluoride Pump
17. Fluoride System Break Tank
18. Sealed Viewing Window
19. Fluoride Solution Line
20. Chlorine Vent Line to Outside
21. Future Polyphosphate Pump
22. Electrical & Controls Center
23. Fluoride Solution Injector & Check Valve
24. Meter Test Tank
25. Mechanical Air Pressure Relief
26. Add Air
27. Compressed Air Line
28. Air Release - Solenoid Valves to Control Panel
29. Tank Level Switch to Control Panel
30. Air Pressure - to Control Unit
31. Flexible Coupling
32. Frost Free Hose Bid & Back Flow Preventor Valve
33. Hose Bib & Back Flow Preventor Valve
34. Water Service to Meter Repair Bench
35. Air Release Valve
36. Check Valve
37. Flow Meter
38. 6" Valve
39. Chlorine Injector
40. Water Line to Booster Pump
41. Well Head

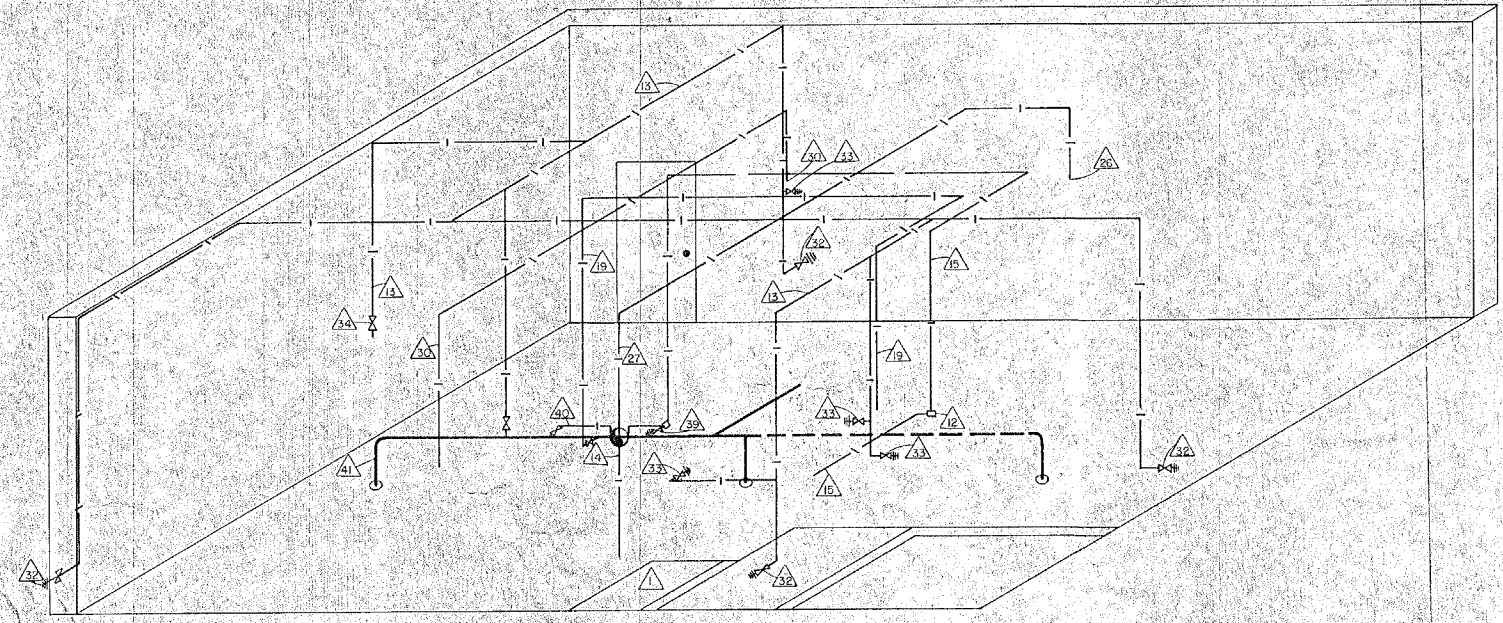

PIPING SCHEMATIC
SCALE 1/4" = 1'


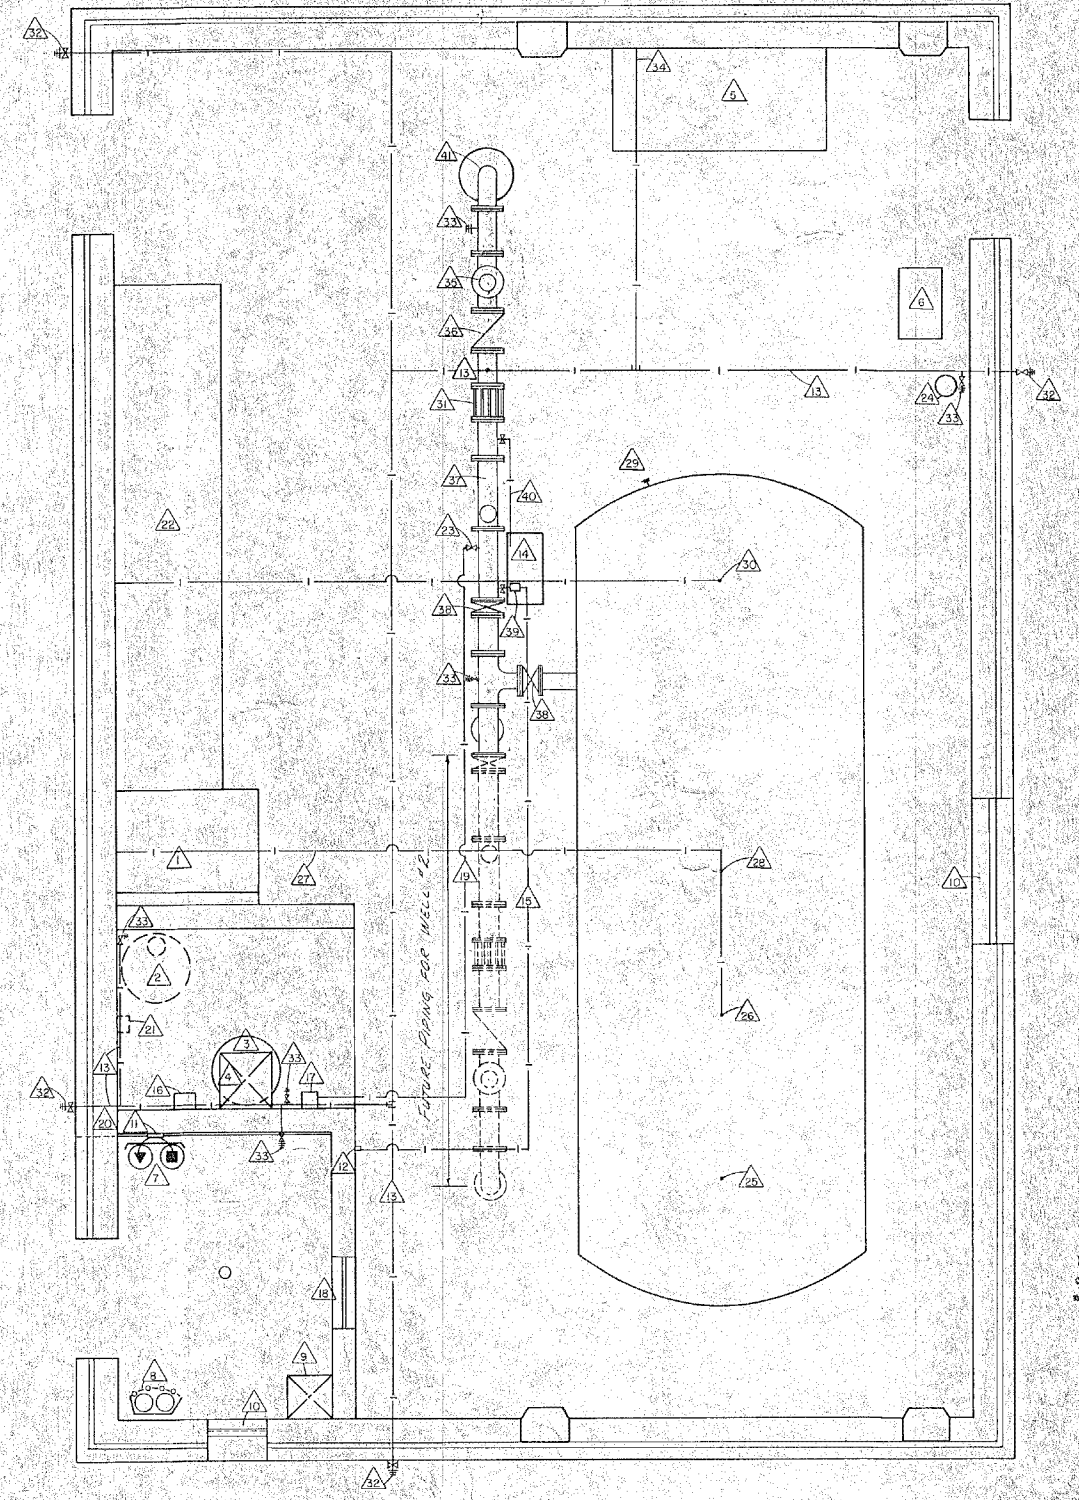


MECHANICAL PLAN
SCALE 3/8" = 1'

MINNESOTA DEPARTMENT OF HEALTH
Division of Environmental Health
This is to certify that this is a duplicate copy
of the plan referred to in report on water
works improvements, dated
OCT 10 1984

I hereby certify that this plan, specification, or report was prepared by me or under my direct supervision and that I am a duly Registered Professional Engineer under the laws of the State of Minnesota.
Edward M. Kishel
Date 9/26/84 Reg. No. 11061


IMPROVEMENT PROJECT 84-13 MECHANICAL PLAN - SCHEMATIC PUMPHOUSE #1 - HYDRO-PNEUMATIC CITY OF RAMSEY		Scale None SHOWN	Hakanson Anderson Associates, Inc. engineers and surveyors 222 Monroe Street • Anoka, Minnesota 55303 • 612/437-8800
Revisions	Date 9-26-84 Sheet 5 of 13 sheets File No. RASG-021 Page	Book	
Designed by LCK Drawn by H.A.S. Checked by P.R.R.			

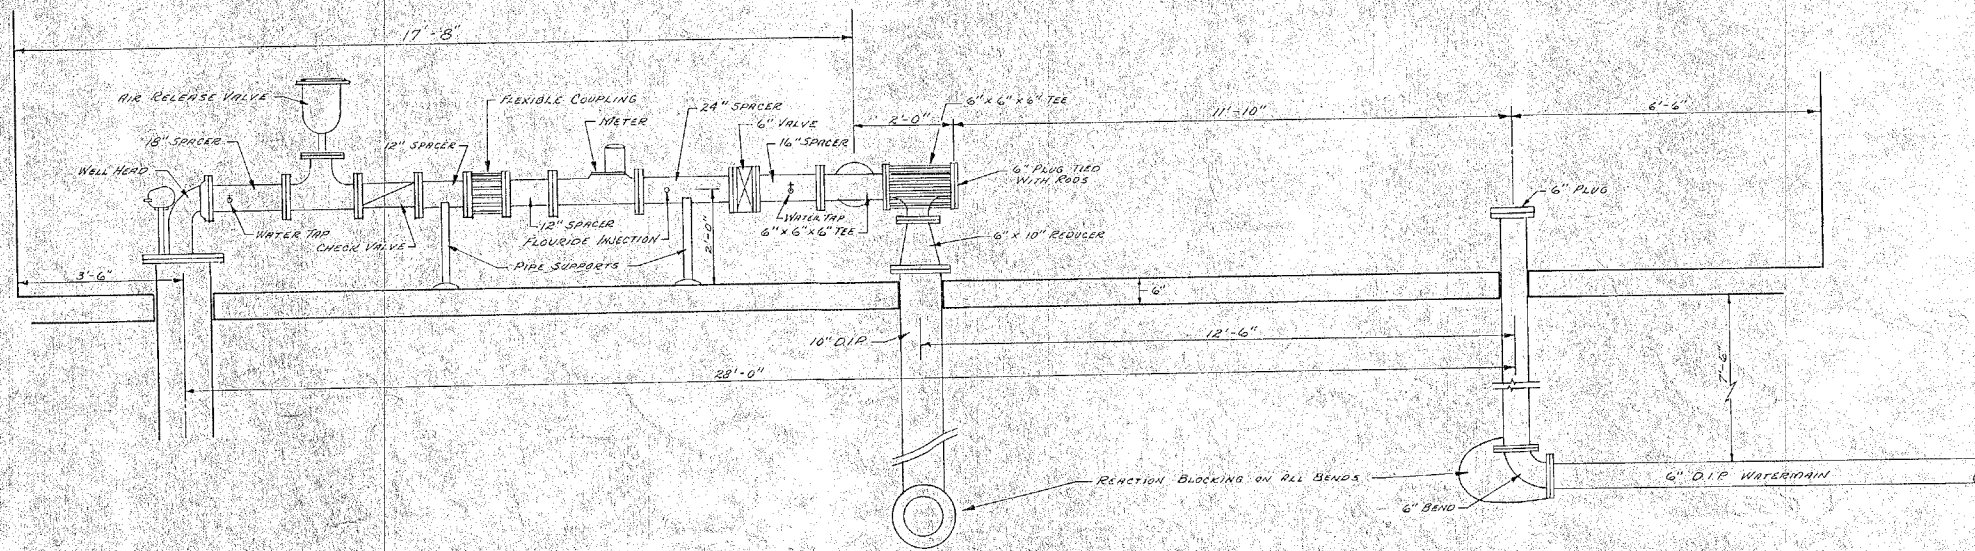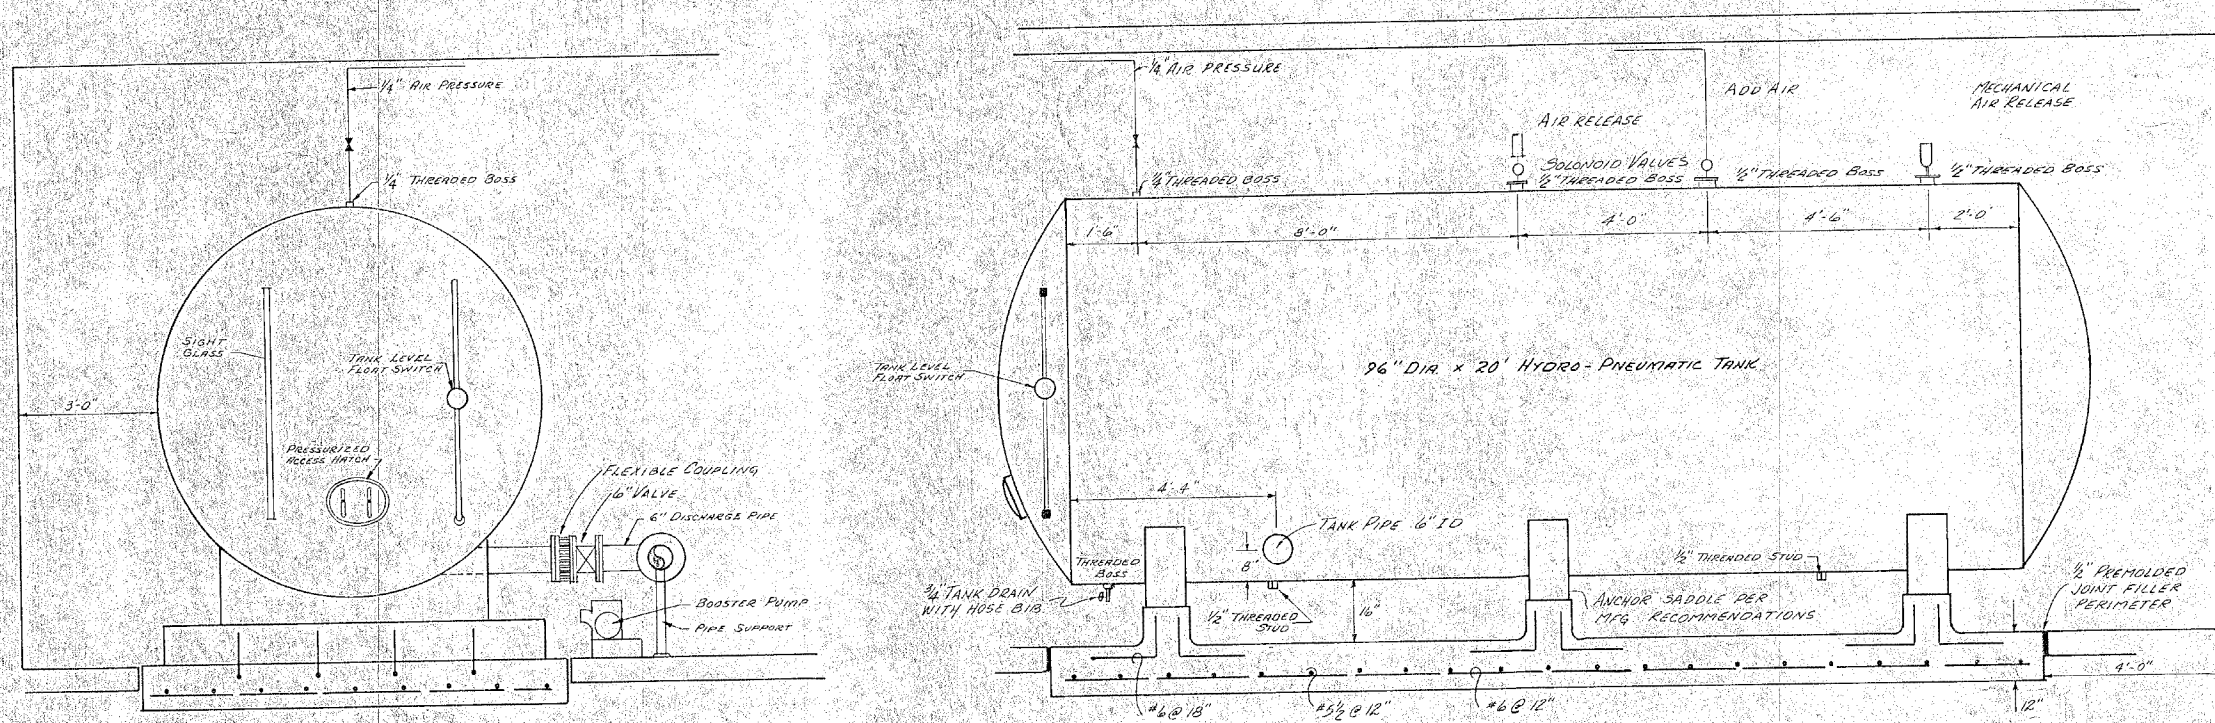


MINNESOTA DEPARTMENT of HEALTH
 Division of Environmental Health
 This is to certify that this is a duplicate copy
 of the plan referred to in report on water
 works improvements, dated OCT 10 1984

I hereby certify that this plan,
 specification, or report was prepared
 by me or under my direct supervision
 and that I am a duly Registered Pro-
 fessional Engineer under the laws of
 the State of Minnesota
Lawrence J. Kishak
 Date 9/26/84 Reg. No. 11261

IMPROVEMENT PROJECT 84-13		Scale	Hakanson Anderson Associates, Inc. engineers and surveyors 222 Monroe Street • Anoka, Minnesota 55301 • 612/427-5860
HYDRO-PNEUMATIC TANK & PIPING DETAILS		Horiz. 1/2" = 1'-0"	
PUMPHOUSE #1		Vert. ---	
CITY OF RAMSEY		Book ---	
Revisions	Date 9-26-84	Sheet 6 of 13 sheets	File No. RA50-02-1
			Page ---
			Designed by LGR
			Drawn by Andy
			Checked by PRR

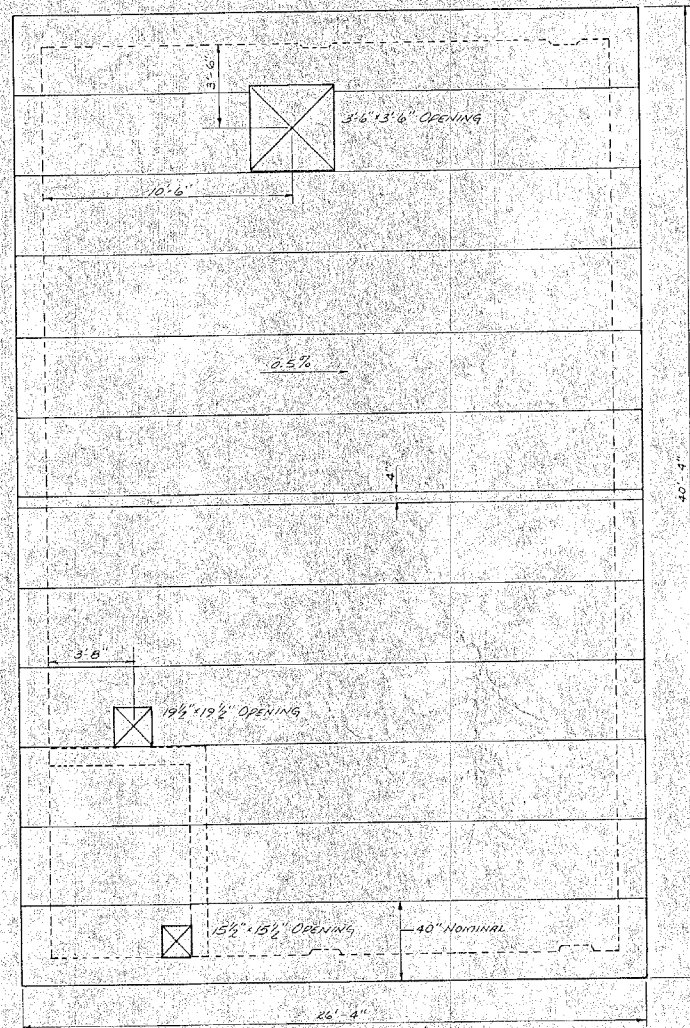

ROOF PLANK PLAN
1/4" = 1'-0"

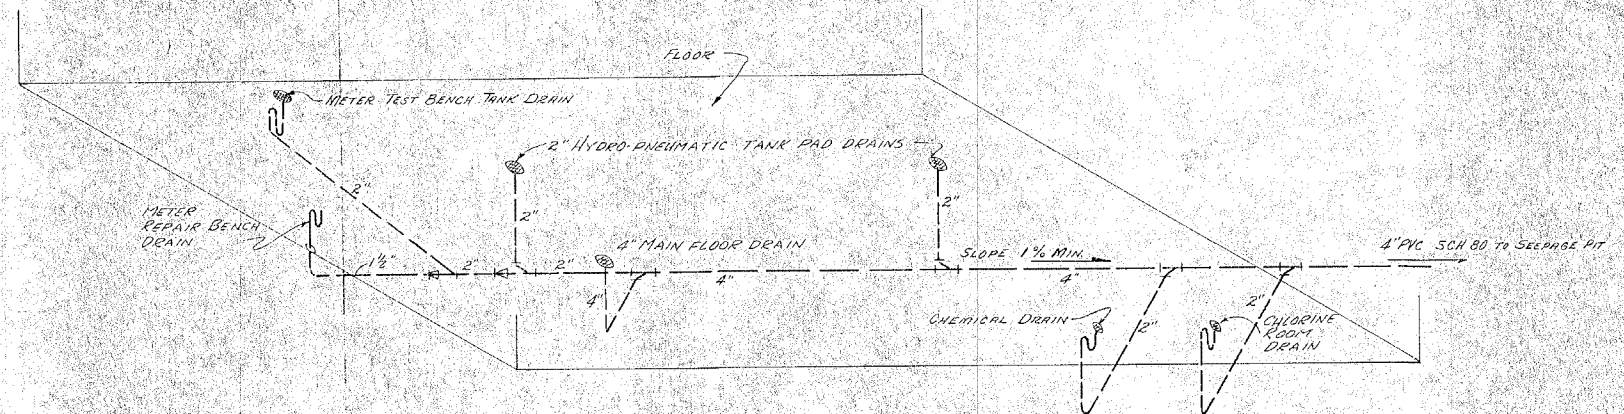

FLOOR DRAIN SYSTEM
NO SCALE


MINNESOTA DEPARTMENT OF HEALTH
Division of Environmental Health
This is to certify that this is a duplicate copy
of the plan submitted to in report on water
works improvements, dated

OCT 10 1984


I hereby certify that this plan,
specification, or report was prepared
by me or under my direct supervision
and that I am a duly Registered Pro-
fessional Engineer under the laws of
the State of Minnesota.

James H. Kishak
Date 9/26/84 Reg. No. 11261


IMPROVEMENT PROJECT 84-13 ROOF PLANK PLAN AND FLOOR DRAIN SYSTEM PUMP HOUSE #1 CITY OF RANSEY		Scale HORIZ. SHOWN VERT. BOOK	Hakanson Anderson Associates, Inc. engineers and surveyors 222 Monroe Street • Anoka, Minnesota 55303 • 612/427-5860
Revisions	Date 9-26-84	Sheet 7 of 13 sheets	File No. RNSC-02-1
Designed by L.G.K.		Drawn by Andy	Checked by P.R.R.

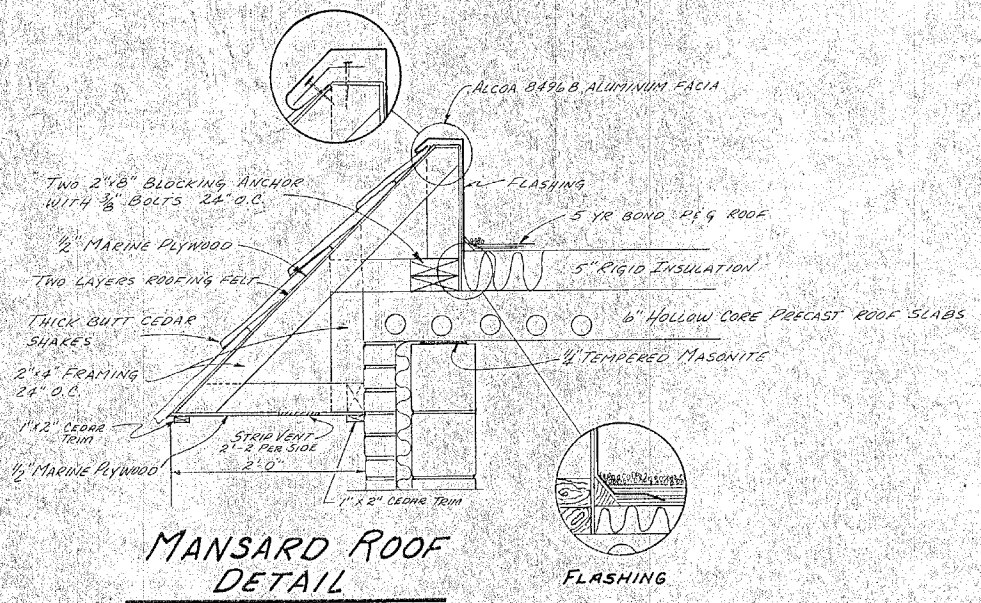


MANSARD ROOF DETAIL

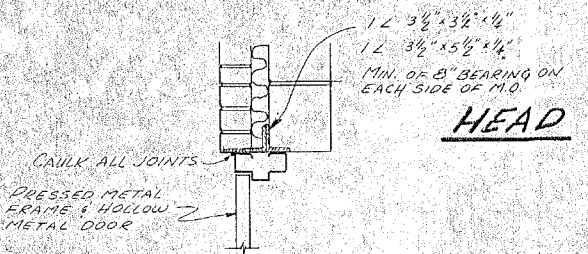

HEAD

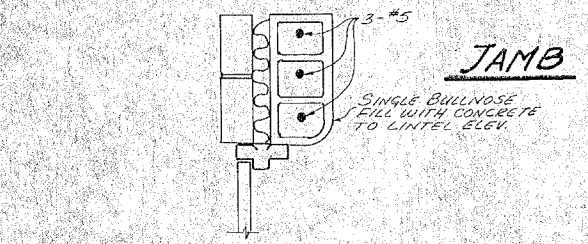


JAMB

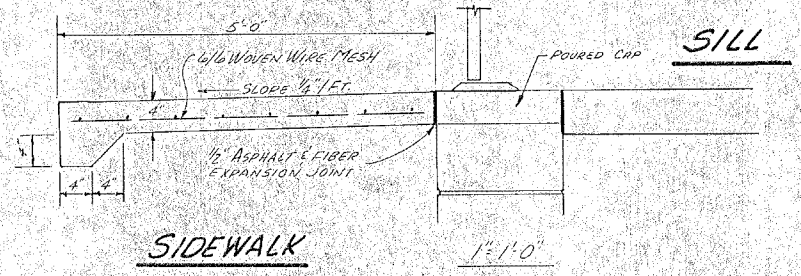


SIDEWALK


SILL

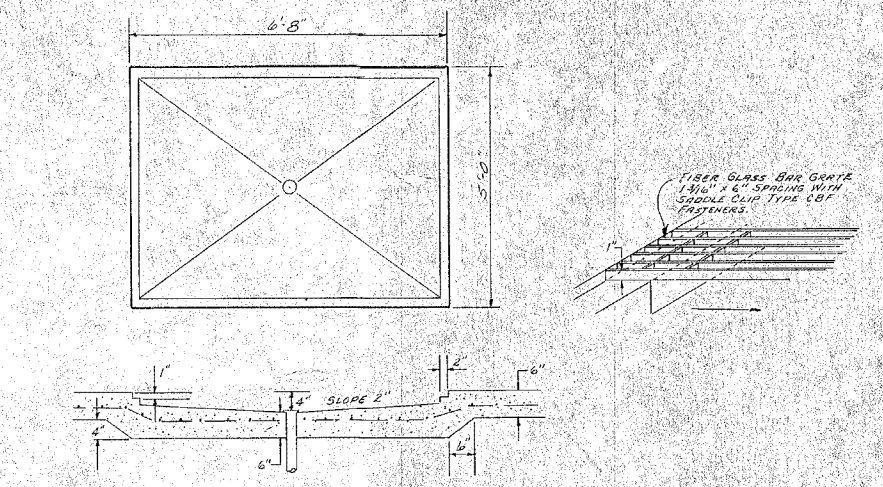

CHEMICAL FEED DRAIN BASIN

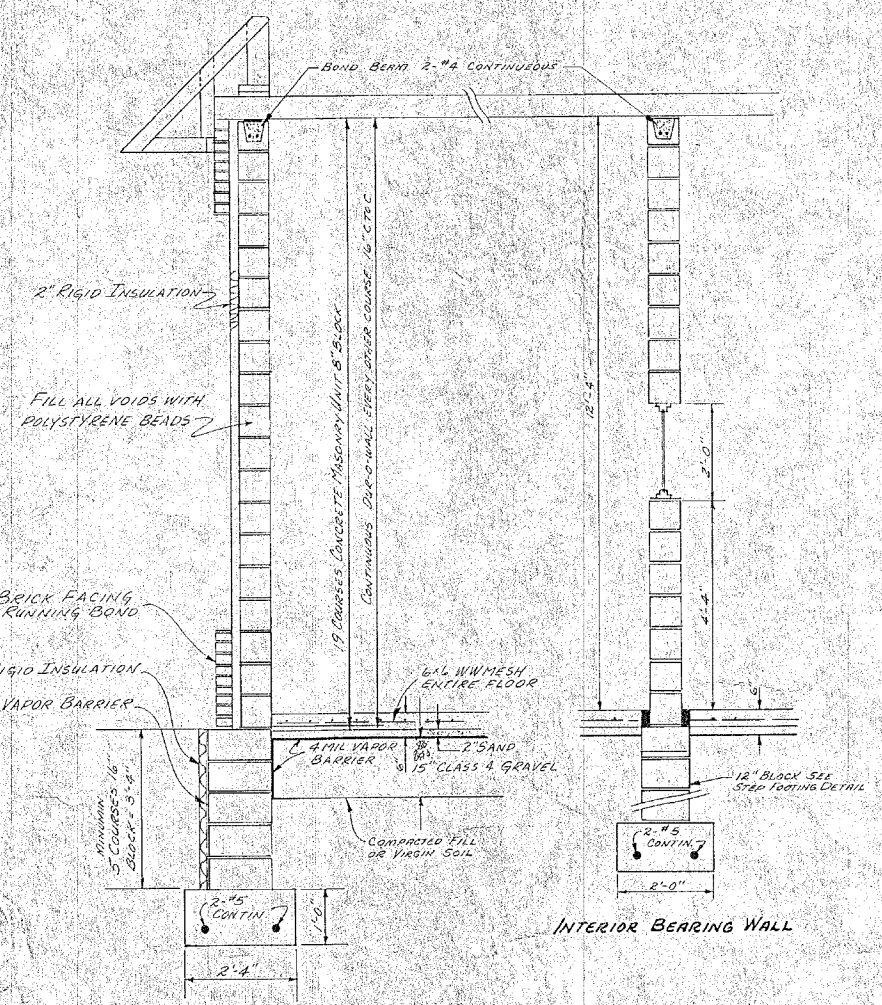


WALL SECTIONS

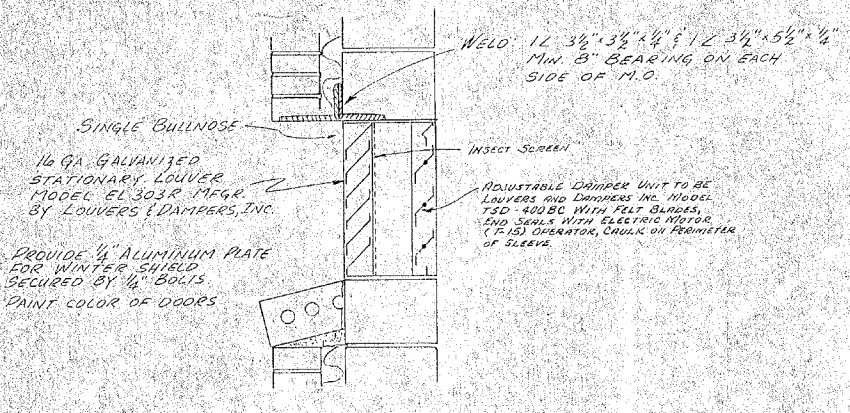


AIR INTAKE DETAIL

CHLORINE ROOM

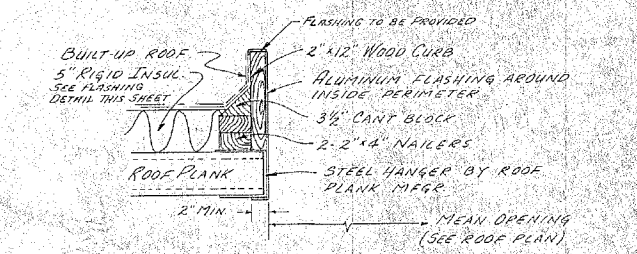

CURB DETAIL

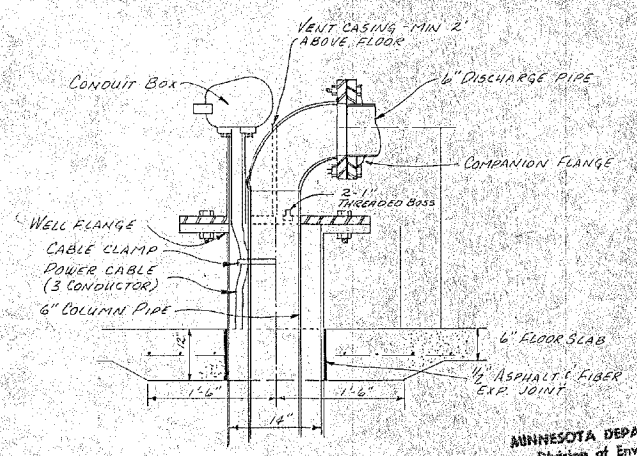


PUMP BASE & WELL HEAD DETAIL


MINNESOTA DEPARTMENT OF HEALTH
Division of Environmental Health
This is to certify that this is a duplicate copy
of the plan referred to in report on water
supply improvements, dated _____

OCT 10 1984

NOTE: FOOTING SHALL BE FOUND IN NATURAL SOILS. CONDITIONS MAY REQUIRE A DEEP FOOTING SETTING THAN SHOWN.

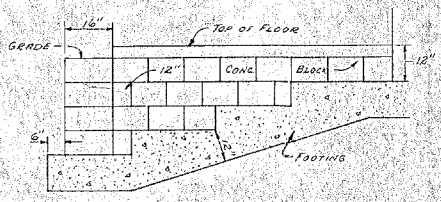


STEP FOOTING

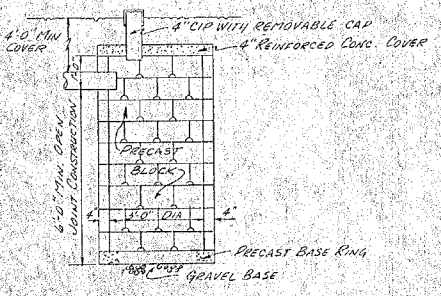

SEEPAGE PIT

I hereby certify that this plan, specification, or report was prepared by me or under my direct supervision and that I am a duly Registered Professional Engineer under the laws of the State of Minnesota.
Lawrence J. Hyslop
Date 9/26/84 Reg. No. 11261


IMPROVEMENT PROJECT 84-13		Scale		Hakanson Anderson Associates, Inc.	
DETAILS		Hons. AS SHOWN		engineers and surveyors	
Pumphouse #1 - Hydro-Pneumatic		Vert. -		222 Monroe Street • Anoka, Minnesota 55301 • 612/427-5800	
CITY OF RAMSEY		Book -		Designed by LGK Drawn by RAB Checked by PRR	
Revisions	Date 9-26-84	Sheet 8 of 13 sheets	File No. RASC-02-1	Page -	

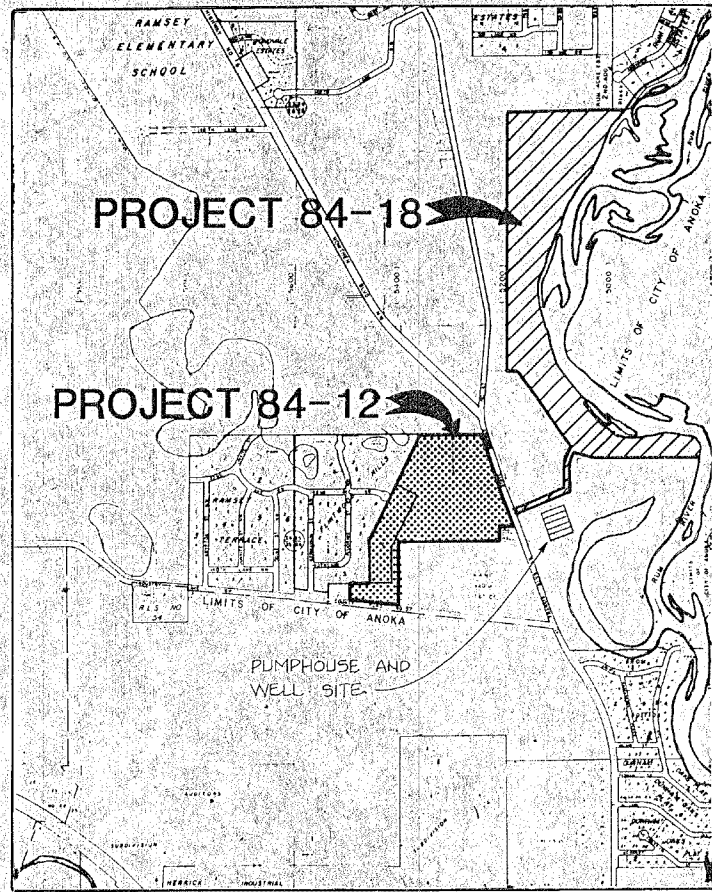


PROJECT 84-18

PROJECT 84-12

PROJECT SITE LOCATION

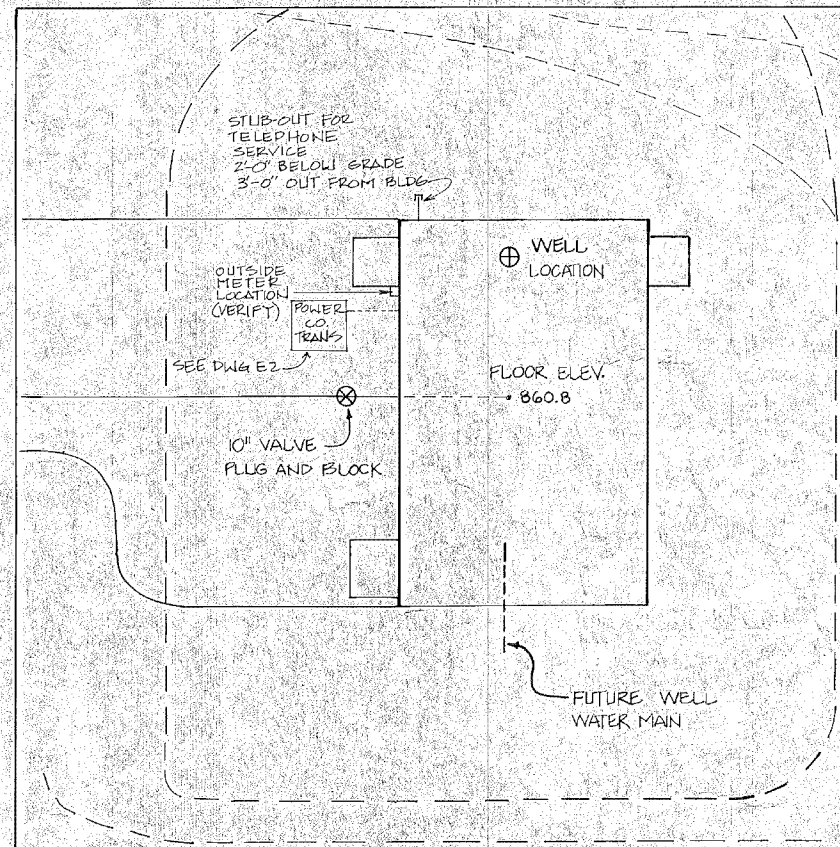

SITE PLAN
PUMPHOUSE & WELL

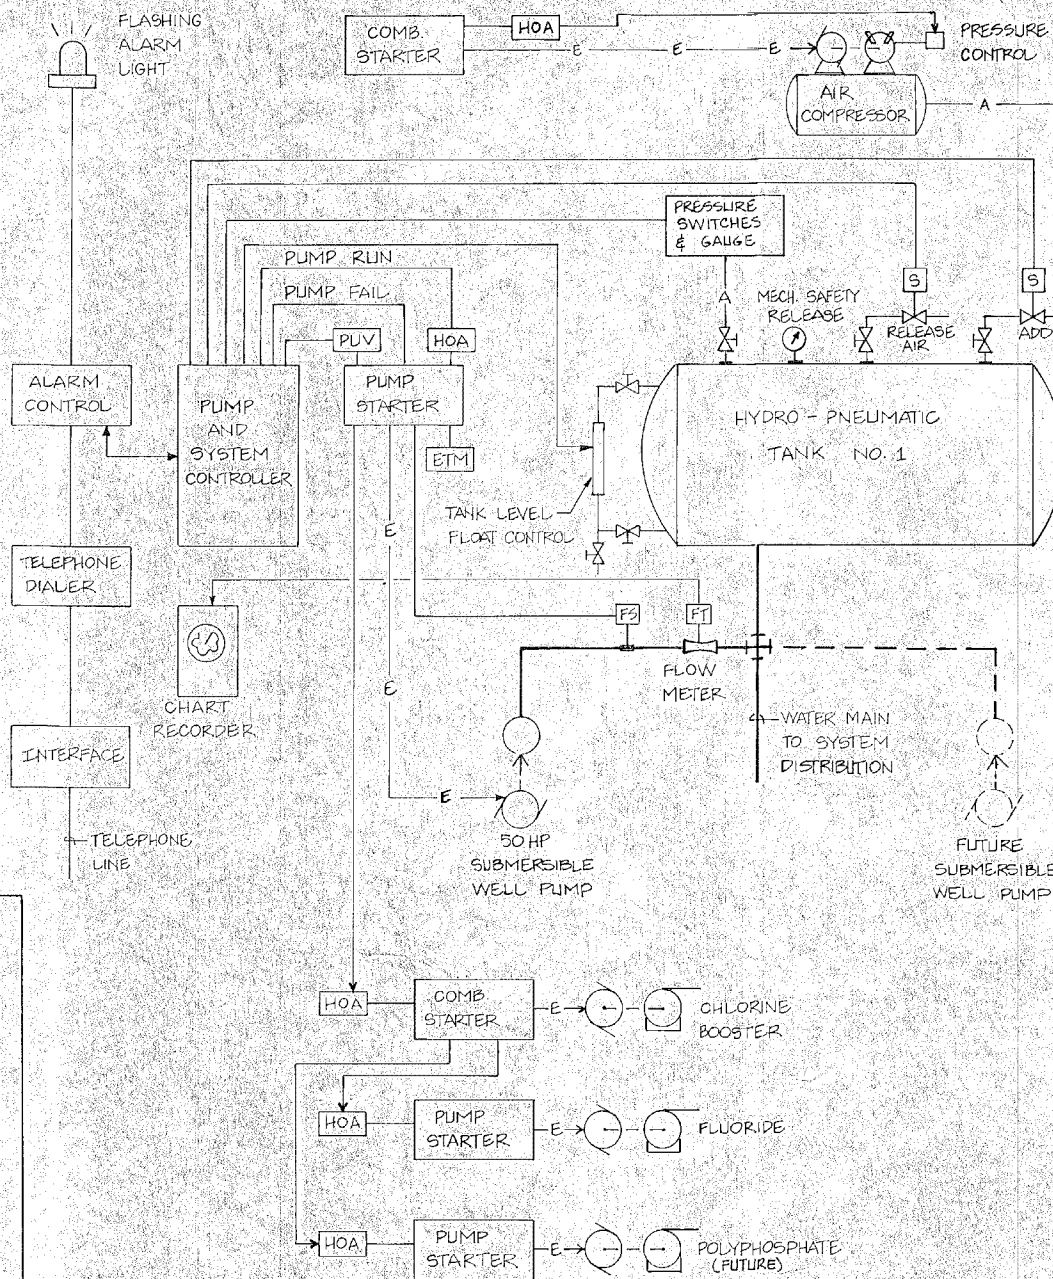

ELECTRICAL CONTROL AND HYDRAULIC SYSTEM DIAGRAM

HOA - HAND-OFF-AUTO
 PUV - PHASE FAILURE AND UNDER VOLTAGE PROTECTION
 FT - FLOW METER SIGNAL TRANSMITTER
 FS - FLOW SWITCH
 -A- - AIR PIPING
 -W- - WATER PIPING
 -E- - ELECTRICAL POWER WIRING
 -C- - CONTROL FUNCTIONS

SYMBOL SCHEDULE

- FLUORESCENT LIGHTING FIXTURE
- WALL MOUNTED LIGHTING FIXTURE
- ⊖ RECEPTACLE OUTLET - GFI @ 48"
- ⊖ TELEPHONE OUTLET
- ⊖ JUNCTION BOX
- ⊖ SINGLE POLE SWITCH, 20A - 120V
- ⊖ 3-WAY SWITCH, 20A - 120V
- ⊖ THERMOSTAT
- ⊖ NS NIGHT SETBACK THERMOSTAT
- ⊖ MOTOR (NUMBER REFERS TO SCHEDULE)
- ⊖ SHEET NOTE REFERENCE
- CONDUIT ROUTED ABOVE GRADE - CONCEALED
- CONDUIT ROUTED ABOVE GRADE - EXPOSED
- CONDUIT ROUTED BELOW GRADE
- GROUND CONDUCTOR
- INDICATES CONDUIT TERMINATES IN SECTION 3 OF SWITCHBOARD
- CROSS MARK DENOTE QUANTITY OF # 12 WIRES OR CONDUCTOR SIZE AS MARKED.
- GROUNDING CONDUCTOR IN PVC CONDUIT
- ⊖ CONDUIT TERMINATION - SEE DETAIL 2/E2
- ⊖ M MANUAL MOTOR STARTER WITH PILOT LIGHT
- ⊖ SINGLE POLE SWITCH WITH PILOT LIGHT
- ⊖ SEAL-OFF FITTING - SEE DETAIL 4/E4
- MT EMPTY CONDUIT
- ⊖ TR MANUAL SET TIMER - 0-24RS
- ⊖ D MOTORIZED DAMPER CONNECTION & FLUSH OUTLET BOX

ELECTRICAL DRAWING INDEX

E 1	SITE PLAN, SYSTEM DIAGRAMS, SYMBOLS
E 2	FLOOR PLAN, POWER & CONTROLS - DETAILS
E 3	FLOOR PLAN, LIGHTING & GROUNDING - DETAILS
E 4	DETAILS
E 5	CONTROL DIAGRAMS

MINNESOTA DEPARTMENT OF HEALTH
 Division of Environmental Health
 This is to certify that this is a duplicate copy of the plan returned to its preparer on these works improvements, dated

OCT 10 1984

E 1

I HEREBY CERTIFY THAT THIS PLAN WAS PREPARED BY ME OR UNDER MY DIRECT SUPERVISION AND THAT I AM A DULY REGISTERED ENGINEER UNDER LAWS OF THE STATE OF MINNESOTA
James W. Wolcott
 DATE 9/26/84 REG. NO. 6920

RC CONSULTANTS OF ANOKA, INC.
 10666 UNIVERSITY AVE. N.W.
 COON RAPIDS, MN. 55433
 (612) 757-0540



IMPROVEMENT PROJECT 84-13
 SITE PLAN, SYSTEM DIAGRAM AND SYMBOL SCHEDULE
 PUMPHOUSE NO. 1
 CITY OF RAMSEY

Hakanson Anderson Associates, Inc.
 engineers and surveyors
 222 Monroe Street • Anoka, Minnesota 55303 • 612/427-5860
 Designed by JDW Drawn by HCP Checked by JDW

ELECTRICAL SHEET NOTES

- ① Minimum conduit to be 3/4". All conduit under floor to be schedule 40 PVC with ground wire. Minimum wire to be #12 AWG copper with THWN, THWN or XHNW insulation.
- ② Thermostat with remote capillary sensor bulb Honeywell No. T675A1508 (CL2 Unit Heater).
- ③ Remote capillary tube from thermostat in pump room terminated in flush mounted cast junction box below window sill; box shall be furnished with Sierra No. S-40-N S.S. cover.
- ④ Typical accessible seal-off fitting installed in all conduit runs penetrating chlorine wall.
- ⑤ Make 120V connection to roof mounted chlorine room exhaust fan; fan shall operate simultaneously with lighting fixture. Refer to lighting plan and control diagram.
- ⑥ Furnish and install ceiling mounted electric unit heater; 3.3 KW, Berke No. HUH-327A-CD-1ASW/24V control transformer and relay. Locate all controls for unit (relocate is required) in switchboard control section.
- ⑦ Receptacle on-off switch and pilot for connection to dehumidifier.
- ⑧ Flush-mounted switch with pilot at 48" A.F.F.; engrave plate, "exhaust fan".
- ⑨ Make connection to flow switch.
- ⑩ Furnish and install junction box and 3/4" conduit and make 3Ø connection to chlorine booster pump.
- ⑪ Make 460V, 3Ø connection to 50 HP motor. Field verify exact rough-in requirements with pump supplier.
- ⑫ Furnish and install ceiling mounted electric unit heater; 5 KW, Berke No. HUH-548A-CD-1ASW/24V control transformer and relay.
- ⑬ Remote thermostat furnished and installed by electrical contractor. Make connection in switchboard control section. See control diagram.
- ⑭ Mount box level with opening in wall.
- ⑮ 6" concrete pad same size as switchgear.
- ⑯ Transformer pad furnished and installed by the Contractor. Verify size. Pad shall be 6" deep with re-enforcing rod as required. Provide ground rods (4) and connecting grid.
- ⑰ All conduit shall be run concealed in walls, floor slab or below slab except conduits shown by a straight solid line at ceiling.
- ⑱ Make connections to switchboard heaters as required (300 watt @ 120 volts each).
- ⑲ Chart recorder shall be: 12" circular type, 7 day chart drive, 4-20 MA. input, 0-6" charts. Transmitter required to convert flow meter pulse signal to MA, OMA-OGPM to 20MA-600 GPM. Chart recorder shall be compatible with flow meter.

PANEL SCHEDULE		
100A-3Ø-4W MAINS, 120/208V, MAIN BREAKER-100A-3P		
CIRCUIT NUMBER	CIRCUIT BREAKER AMP POLES	DESCRIPTION
1	20 1	Outdoor lights - Type C
2	20 1	Pumproom - Type B
3	20 1	Outdoor lights - Type C
4	20 1	Pumproom - Type A
5	15 1	Chlorine Room - Lights
6	15 1	Chlorine Room - Ex. Fan
7	15 1	Chlorine Room - Elec. U.H. Control
8	15	Chlorine Room - U.H. & Lite Control
9	15 1	Pump Rm #1-E.U.H. Control
10	20 1	Hydro-Pneumatic Tank Controls
11	15 1	Pump Rm #2-E.U.H. Control
12	15 1	Hood Exhaust Fan
13	15 1	Poly-Phosphate Agitator
14	15 1	Poly-Phosphate Pump
15	15 1	Fluoride Pump
16	20 1	Bench-GFI Outlet
17	15 1	Dehumidifier
18	15 1	Chart Recorder
19	15 1	Recept (GFI)
20	15 1	Telephone Dialer
21	15 1	Outdoor-Receptacle
22	15 1	Alarm System & Warning Light
23	15 1	Switchboard Heater
24		
25	15 1	Switchboard Heaters
26		
27	15 1	Switchboard Heaters
28		
29		
30		

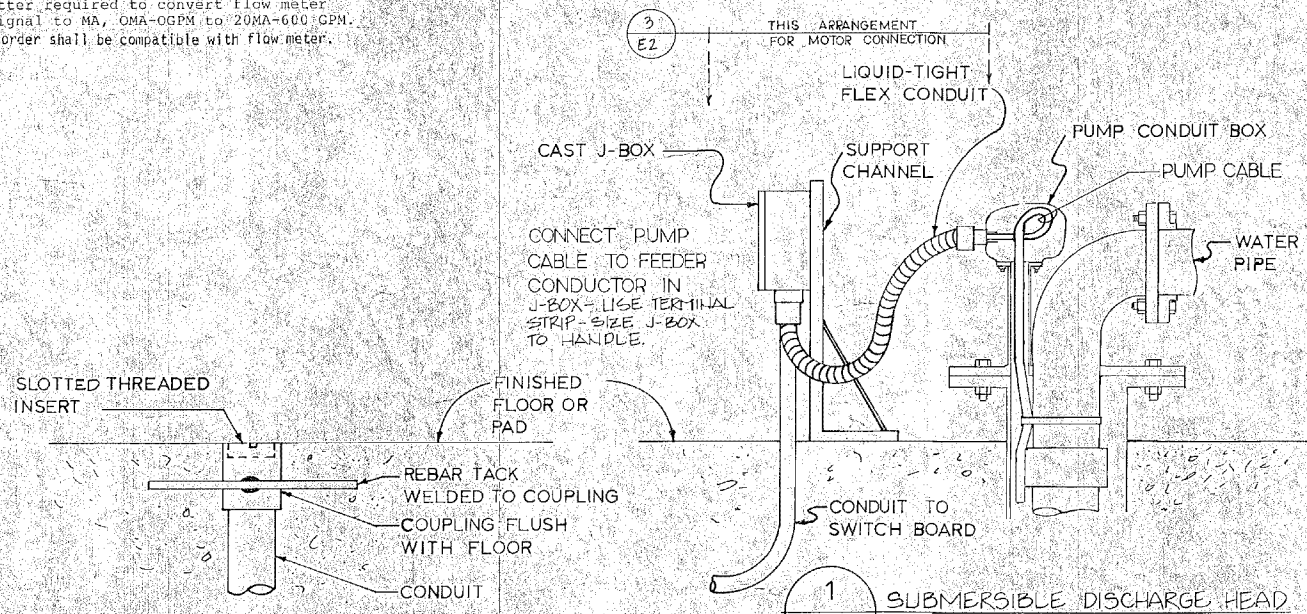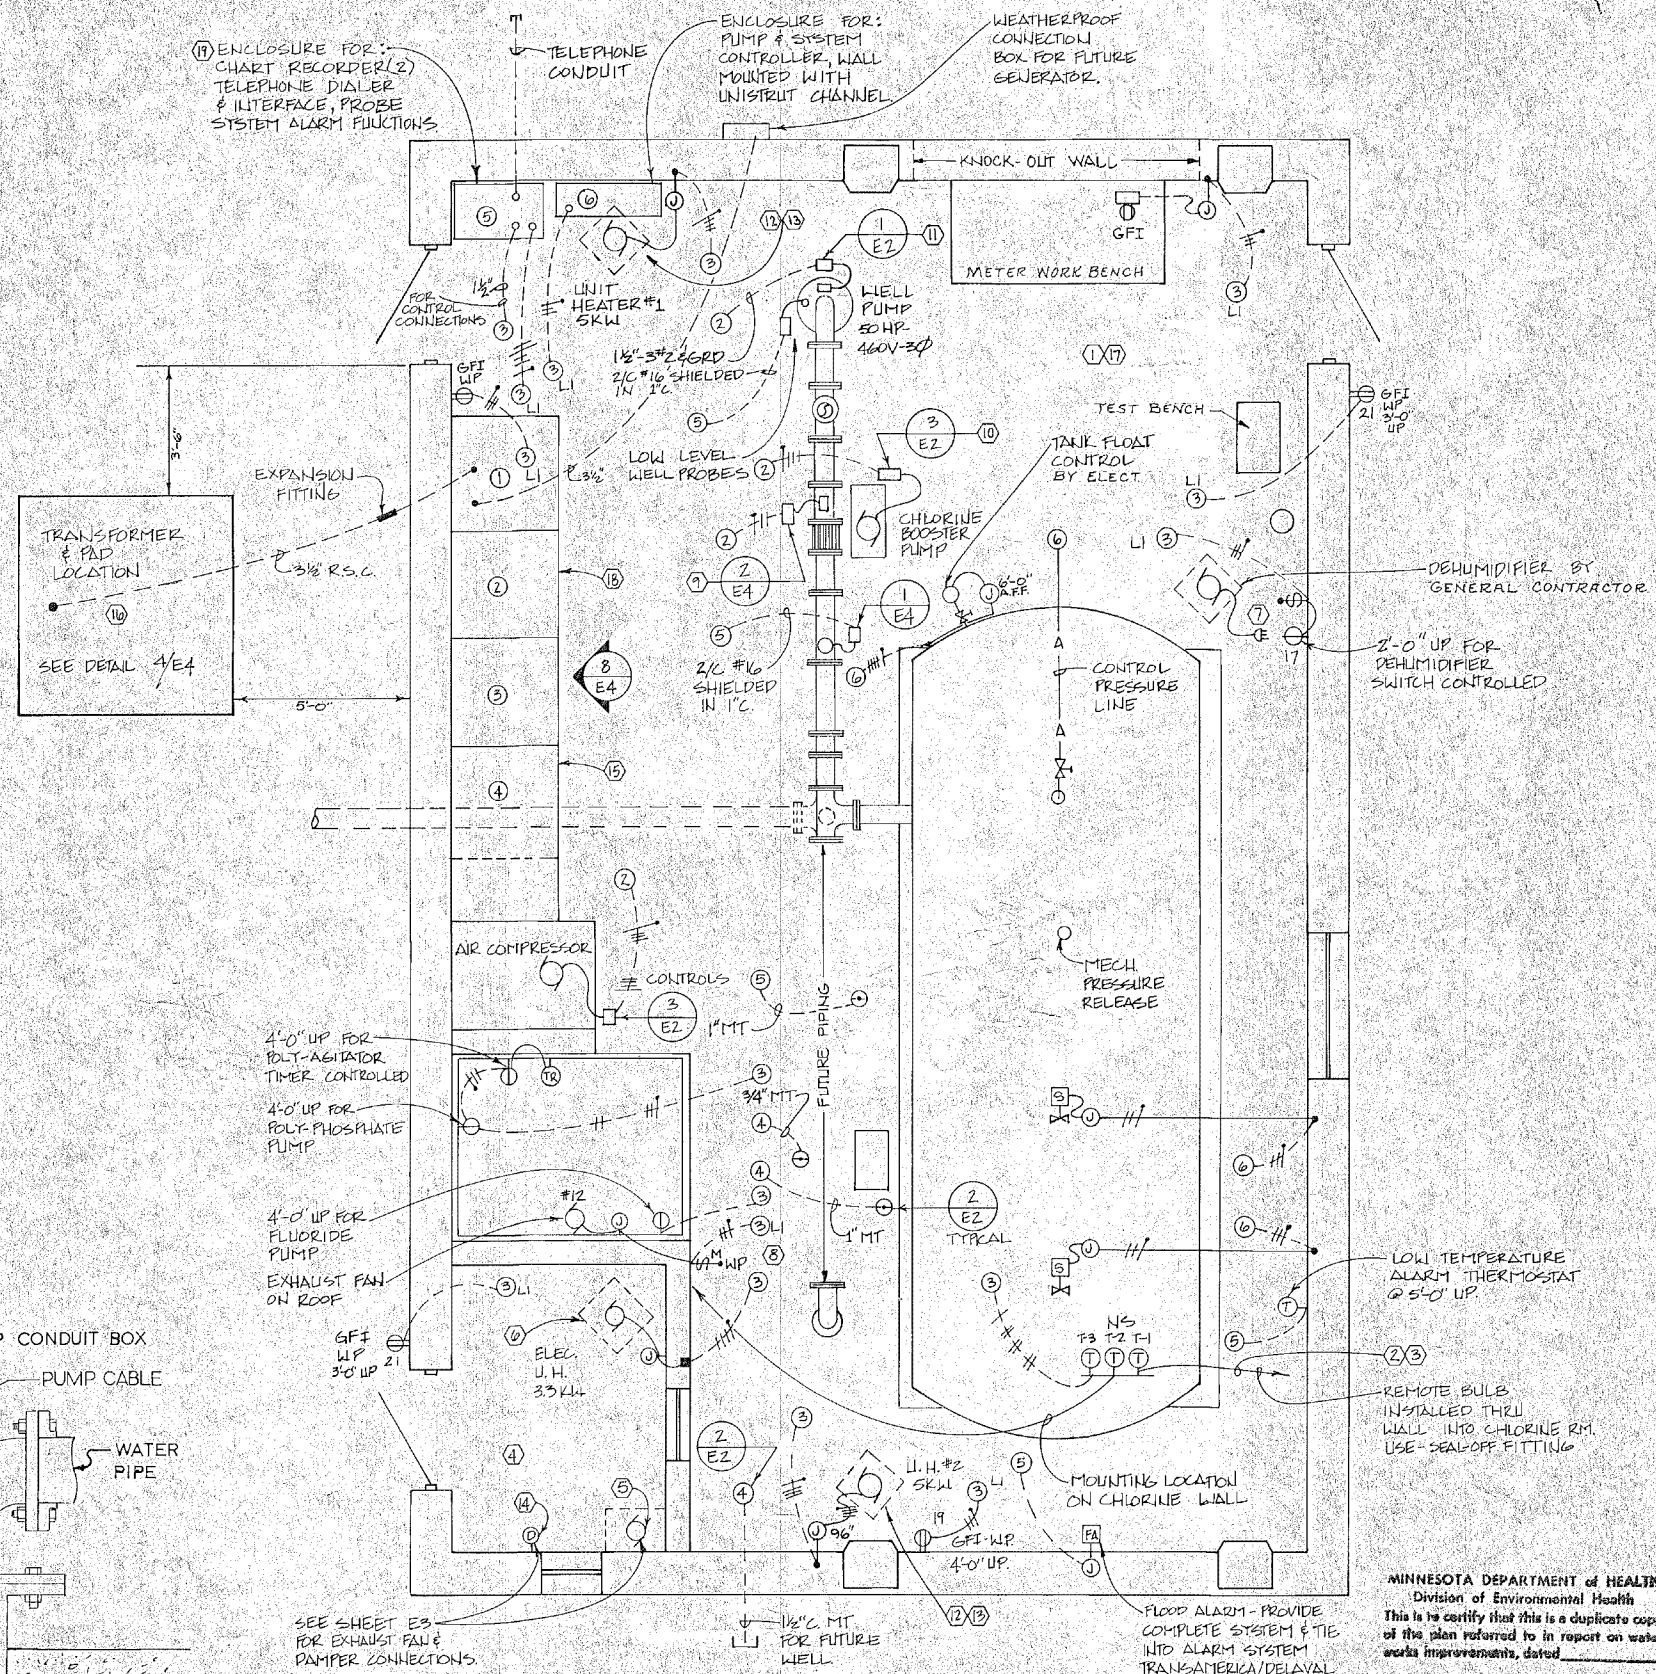

POWER AND CONTROL FLOOR PLAN
3/8" = 1'-0"

<p>I HEREBY CERTIFY THAT THIS PLAN WAS PREPARED BY ME OR UNDER MY DIRECT SUPERVISION AND THAT I AM A DULY REGISTERED ENGINEER UNDER LAWS OF THE STATE OF MINNESOTA</p> <p><i>James J. Walcott</i> DATE 9/26/84 REG. NO. 69220</p>	<p>RC CONSULTANTS OF ANOKA, INC.</p> <p>10666 UNIVERSITY AVE. N.W. COON RAPIDS, MN. 55433 (612) 757-0540</p>	<p>IMPROVEMENT PROJECT 84-13 FLOOR PLAN POWER & CONTROLS DETAILS PUMPHOUSE NO. 1 CITY OF RAMSEY</p>	<p>Scale</p> <p>Horizontal SHOWN</p> <p>Vertical</p> <p>Book</p>	<p>Hakanson Anderson Associates, Inc. engineers and surveyors</p> <p>222 Monroe Street • Anoka, Minnesota 55303 • 612/427-5860</p> <p>Designed by JDL Drawn by HCP Checked by JDL</p>
			<p>Revisions</p> <p>Date 9/26/84 Sheet 10 of 13 sheets File No. RASC-02-1 Page</p>	



OCT 10 1984

E 2

ELECTRICAL SHEET NOTES

- 1 Minimum conduit to be 3/4". All conduit under floor to be schedule 40 PVC with ground wire. Minimum wire to be #12 AWG copper with THHN, THHN or XHHW insulation.
- 2 Make grounding connection to floor drain using #6 AWG grounding conductor.
- 3 Make grounding connection to pipe using #1/0 AWG grounding conductor.
- 4 Make grounding connection from grounding bus to a 15'-0" grounding electrode using a #2/0 AWG grounding conductor. Drive electrode in ground 9'-0" out from building.
- 5 Furnish and install a battery operated emergency lighting unit with three heads aimed for good distribution. Unit shall be a Teledyne Bid Beam #3TC6140-22 or approved equal.
- 6 Furnish and install a Square D class 900T Type Y limit switch with a N.O. and N.C. contacts and NEMA 4 enclosure at top of jamb side of door frame as that when door is opened the room light and exhaust fan will operate. See control diagram.
- 7 All conduit runs that extend between areas of different temperatures shall be sealed.
- 8 Ground connection for transformer.
- 9 Control outdoor light with 24-hour, astronomical dial time clock mounted in the control section of the switchgear. Torq #72002L.
- 10 Stub-up PVC conduit for ground connection to chlorine booster pump. Provide seal-bushing; ground conductor whip shall be 24".
- 11 Furnish and install alarm light on a 1" conduit stubbed up 24" above finished roof. Provide pitch pocket at roof penetration. Guy and brace at 3 points. Alarm light to be Stonco VP-210C/VC3200. Fixture to have wet label and blue globe. Provide with 150 watt, inside frosted extended service lamp.
- 12 All conduit shall be run concealed in walls, floor slab or below slab except conduits shown by a straight solid line at ceiling.
- 13 All grounding conductors run under floor shall be routed thru a 3/4" conduit stub up when rising thru floor slab. Allow minimum of 4" conduit above floor.

LIGHTING FIXTURE SCHEDULE						
Fixture Type	Description	Lamp Type	Wattage	Mounting	Lens, Media, Diffuser	Manufacturer's Catalog No. Remarks
A	Vapor tight	1-150A.	150W.	Surface	Clear Gasketed glass	Appleton AC1930SH 18'-6" AFF-Flush mounted box
B	Wrap-around	2-F40CW	150W.	PENDANT MTE WITH UNI-STRUT	Wrap-around gasketed plastic	Lithonia DL240A120 12'-0" AFF
C	Recessed Square	High Pressure Sodium	100W.	Flush in Soffit	Shock-Resisting Wide Spread	Kirilin 2208-10 Wet-locations
D	Colored Exterior	1-150A.	150W.	3/4" C, above roof	Gasketed Glass	Stonco VP-210C/VGB200 With "wet locations" label

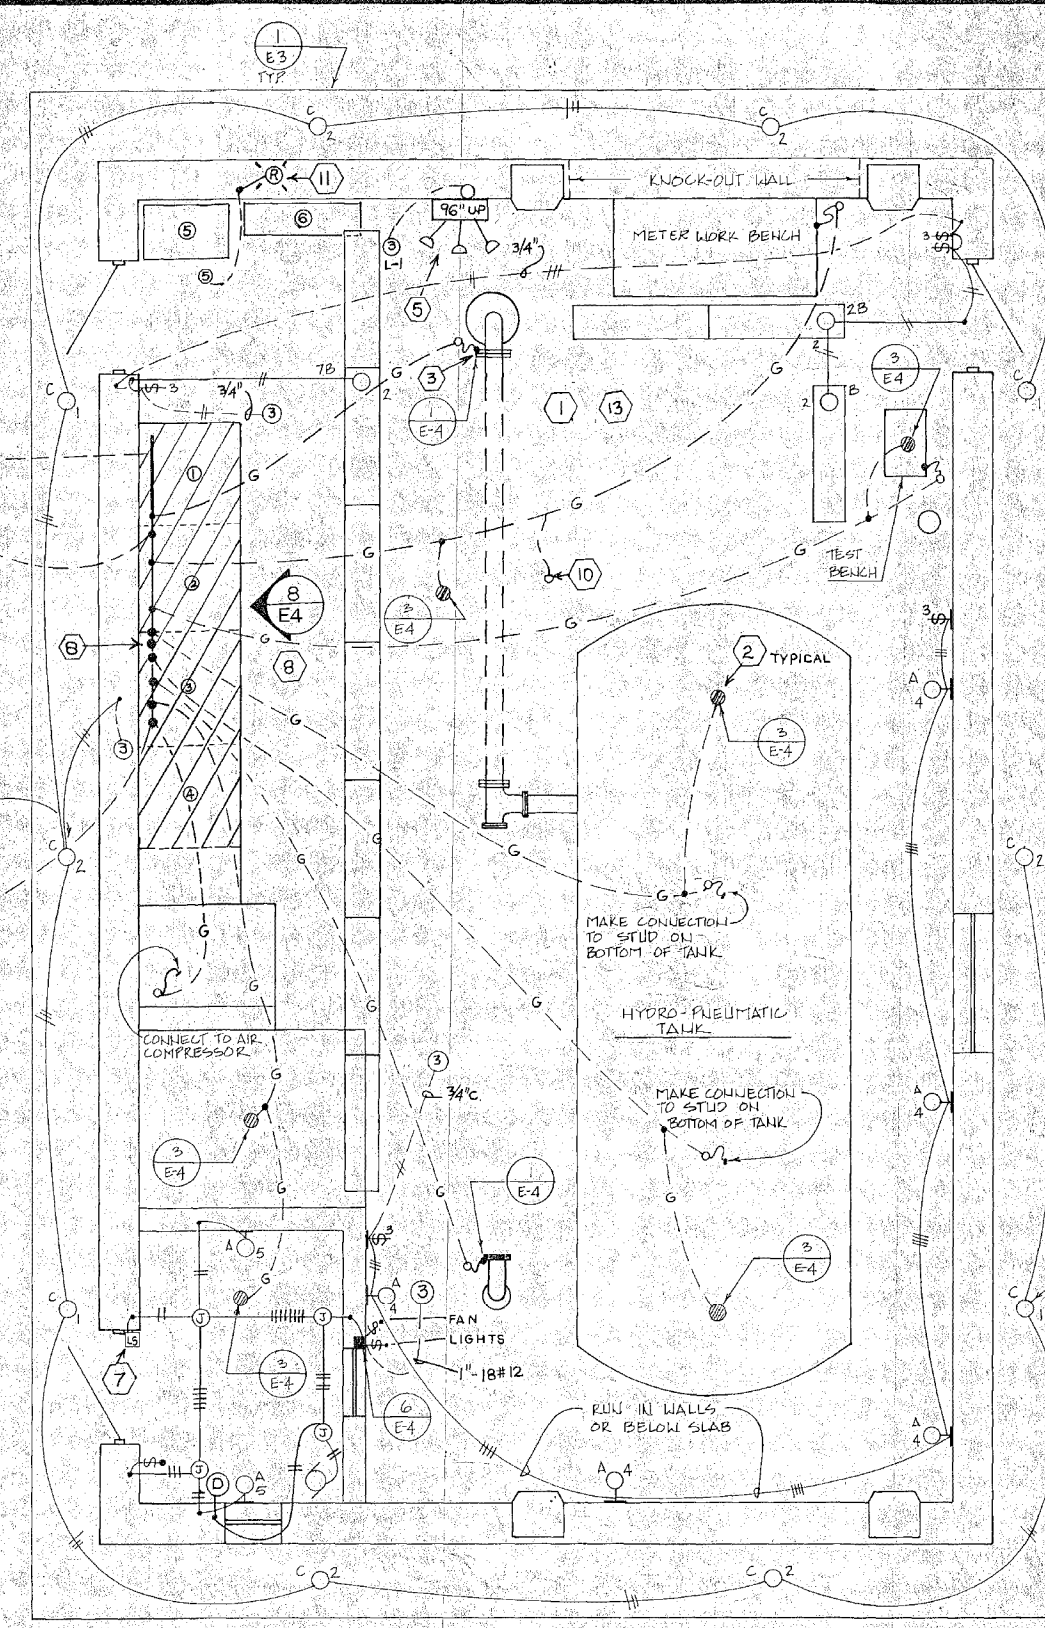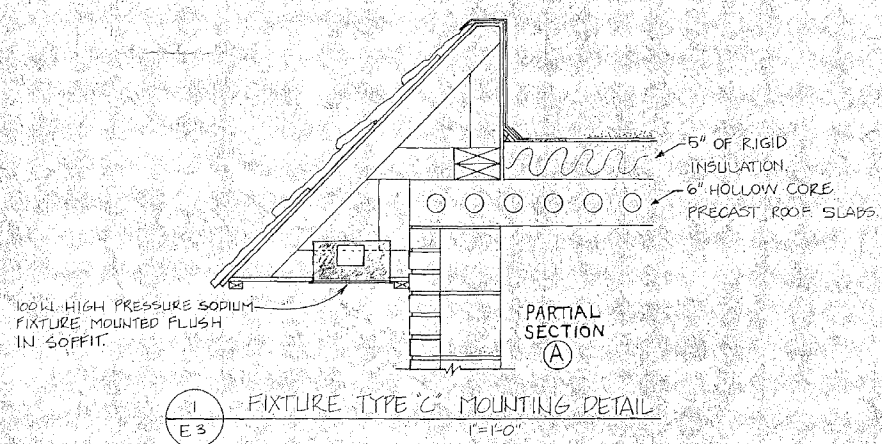


LIGHTING AND GROUNDING FLOOR PLAN
3/8"=1'-0"

MINNESOTA DEPARTMENT OF HEALTH
Division of Environmental Health
This is to certify that this is a duplicate copy of the plan submitted to us in respect on which work improvements should


OCT 10 1984

I HEREBY CERTIFY THAT THIS PLAN WAS PREPARED BY ME OR UNDER MY DIRECT SUPERVISION AND THAT I AM A DULY REGISTERED ENGINEER UNDER LAWS OF THE STATE OF MINNESOTA <i>James W. Walcott</i> DATE 9-26-84 REG. NO. 6920	RC CONSULTANTS OF ANOKA, INC. 10666 UNIVERSITY AVE. N.W. COON RAPIDS, MN. 55433 (612) 757-0540	IMPROVEMENT PROJECT 84-13 FLOOR PLAN - LIGHTING & GROUNDING DETAILS PUMPHOUSE NO. 1 CITY OF RAMSEY	Scale	Hakanson Anderson Associates, Inc. engineers and surveyors 222 Monroe Street • Anoka, Minnesota 55303 • 612/427-5860
			Revisions Date 9-26-84 Sheet 11 of 13 sheets File No. RA56-02-1 Page	


E 3

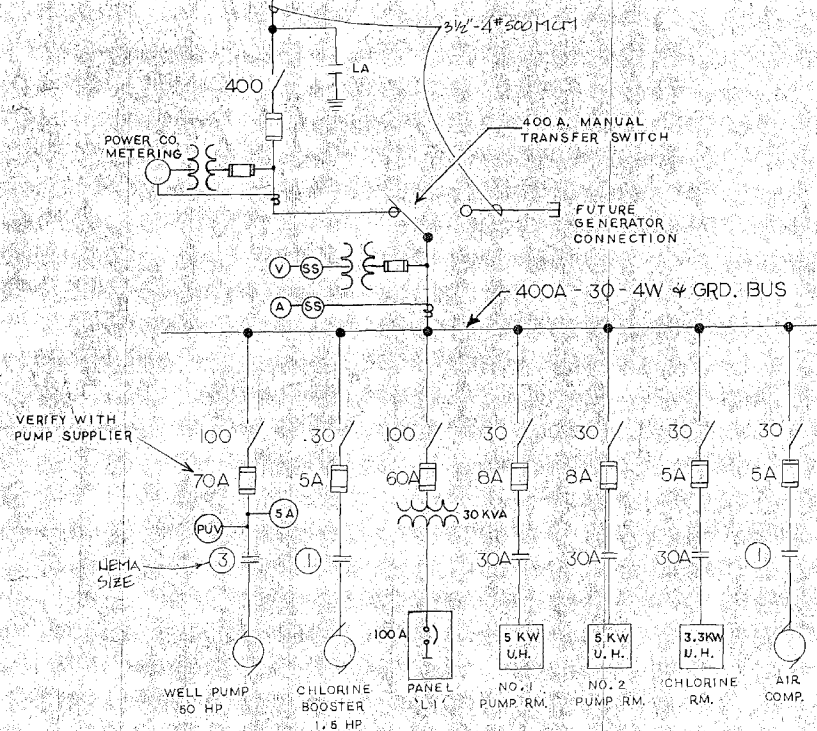


17 E4 ELECTRICAL SYSTEM ONE-LINE DIAGRAM

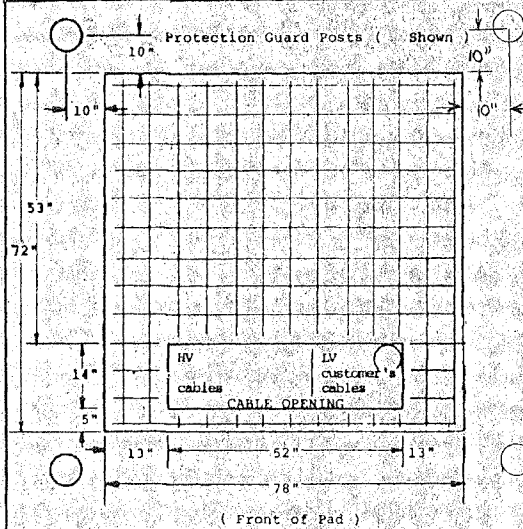


4 E4 DETAIL-TRANSFORMER PAD NO SCALE

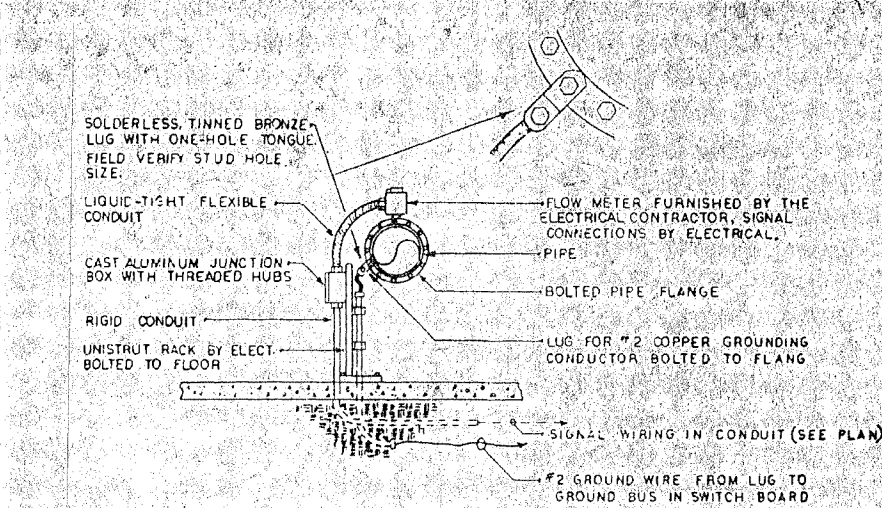


1 E4 DETAIL-GROUND CONNECTION TO PIPING AND SIGNAL CONNECTION TO FLOW METER NO SCALE

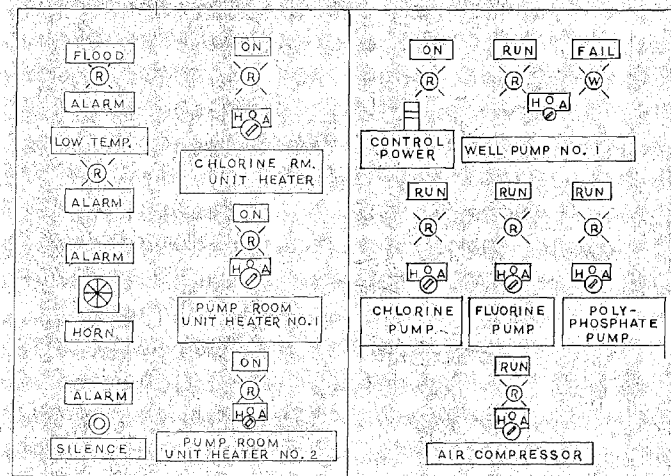


5 E4 CONTROL PANEL LAYOUT NO SCALE

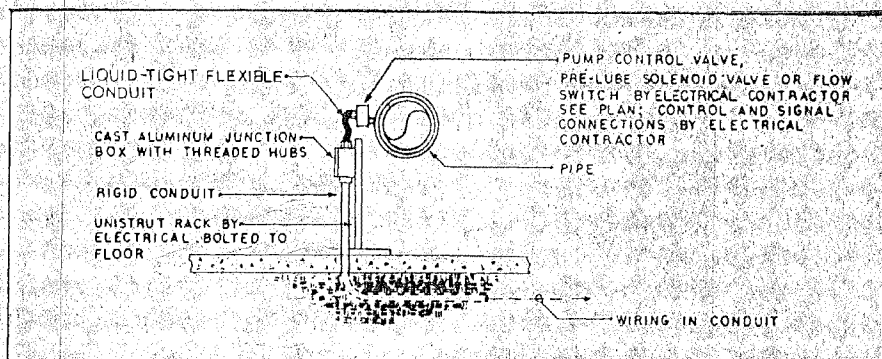


2 E4 DETAIL TYPICAL CONTROL AND SIGNAL CONNECTIONS TO FLOW SWITCH - PRE-LUBE SOLENOID VALVE OR PUMP CONTROL VALVE NO SCALE

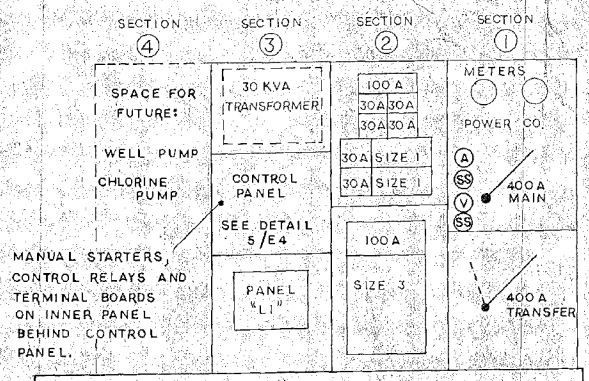

8 E4 ELEVATION MAIN SWITCHBOARD

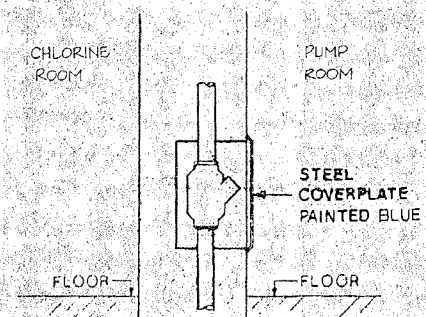

6 E4 DETAIL - CONCEALED SEALED-OFF FITTING NO SCALE

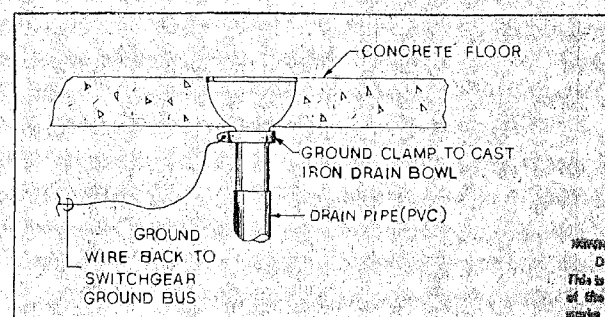


3 E4 DETAIL- DRAIN GROUND CONNECTION (TYPICAL) NO SCALE


MINNESOTA DEPARTMENT OF HEALTH
Division of Environmental Health
This is to certify that this is a duplicate copy of the plan referred to in report on water works improvements, dated

10 OCT 10 1994


I HEREBY CERTIFY THAT THIS PLAN WAS PREPARED BY ME OR UNDER MY DIRECT SUPERVISION AND THAT I AM A DULY REGISTERED ENGINEER UNDER LAWS OF THE STATE OF MINNESOTA <i>James Wolventar</i> DATE 9-26-84 REG. NO. 6920	RC CONSULTANTS OF ANOKA, INC. 10666 UNIVERSITY AVE. N.W. COON RAPIDS, MN. 55433 (612) 757-0540	IMPROVEMENT PROJECT 84-13 DETAILS PUMPHOUSE NO. 1 CITY OF RAMSET	Scale	Hakanson Anderson Associates, Inc. <i>engineers and surveyors</i> 222 Monroe Street • Anoka, Minnesota 55303 • 612/427-5860
			Revisions Date 9-26-84 Sheet 12 of 13 sheets File No. RASC-02-1 Page	

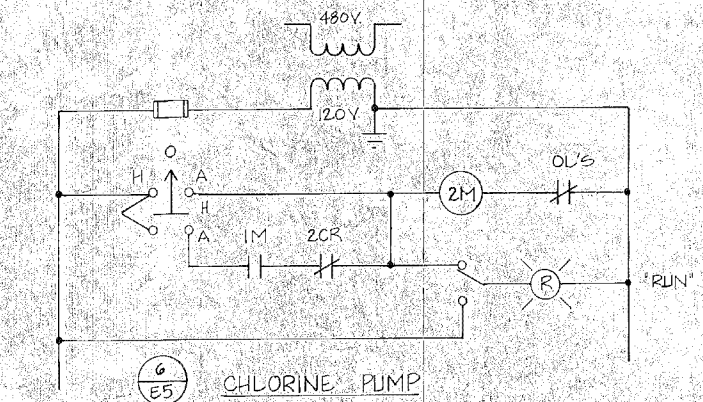


6/E5 CHLORINE PUMP

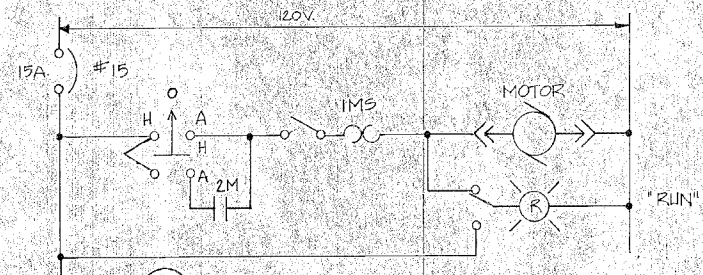


7/E5 FLUORIDE PUMP

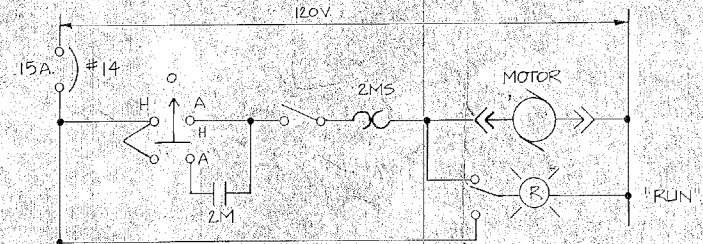

8/E5 POLYPHOSPHATE PUMP

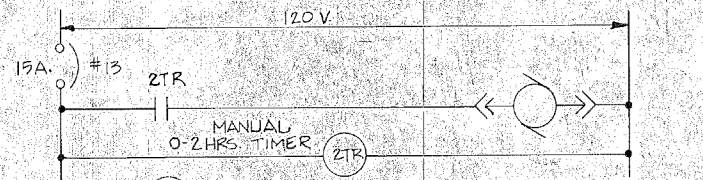


9/E5 AGITATOR

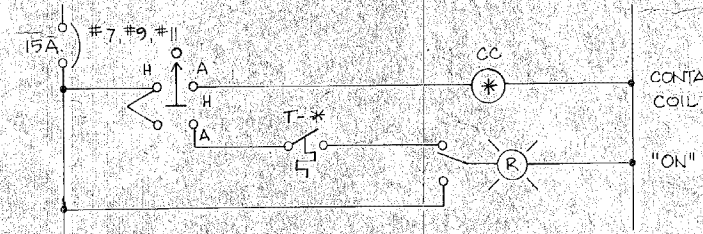


10/E5 ELECTRIC UNIT HEATERS




TEMP SETTINGS	CONTACTOR COIL	T-*
45°F	CHLORINE ROOM	T-1
70°F	PUMP ROOM #1	T-2
70°F	PUMP ROOM #2	T-3

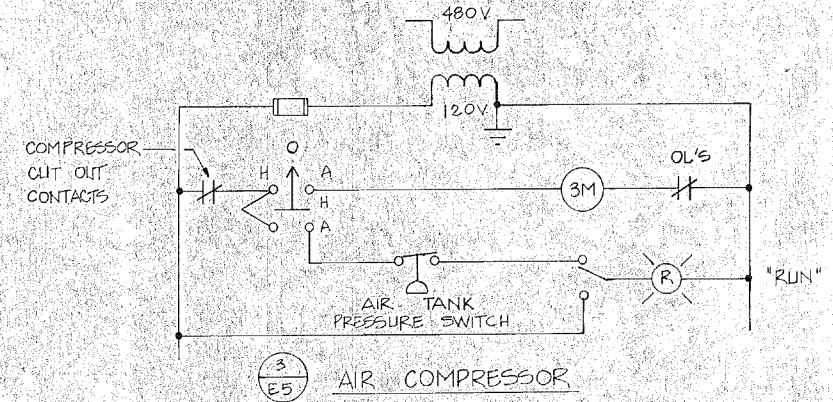



3/E5 AIR COMPRESSOR

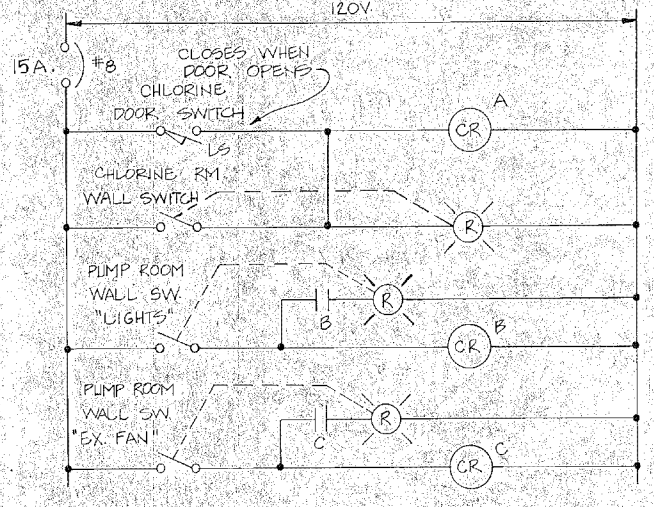

4/E5 EXHAUST FAN AND LIGHTING CONTROL CHLORINE ROOM

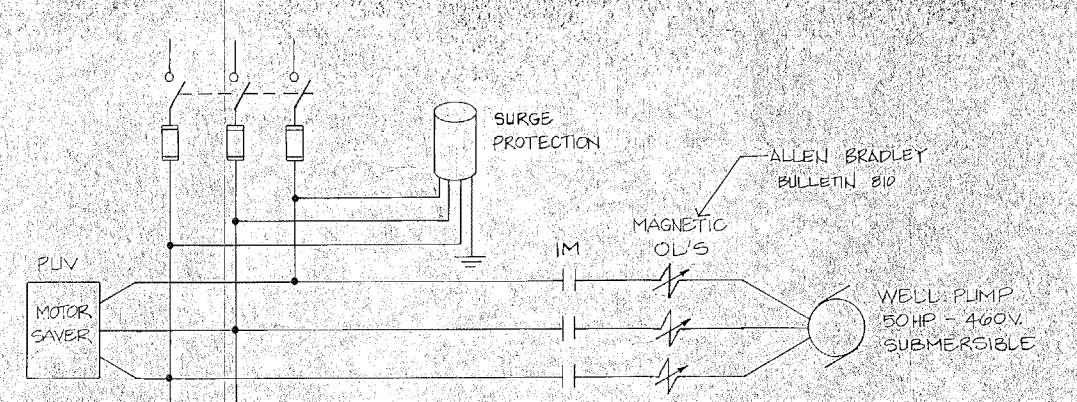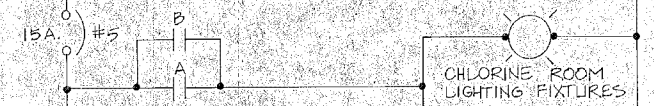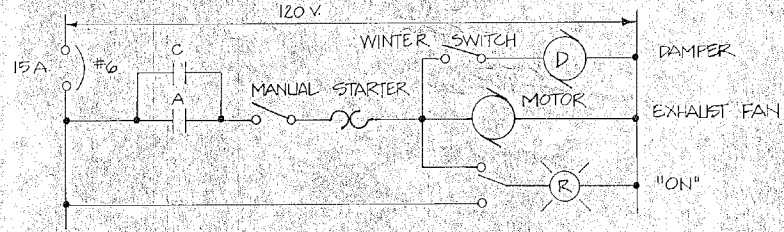

1/E5 SUBMERSIBLE WELL PUMP

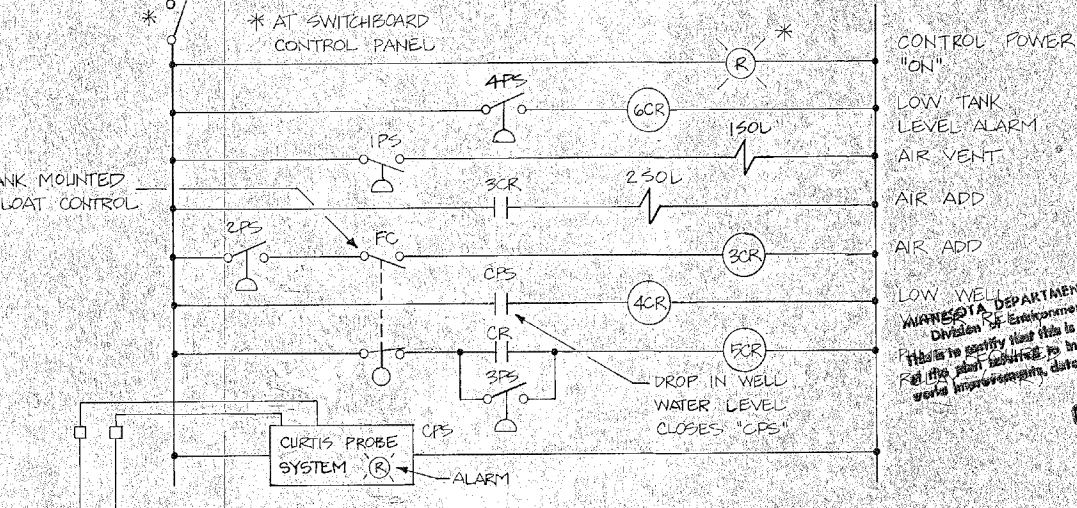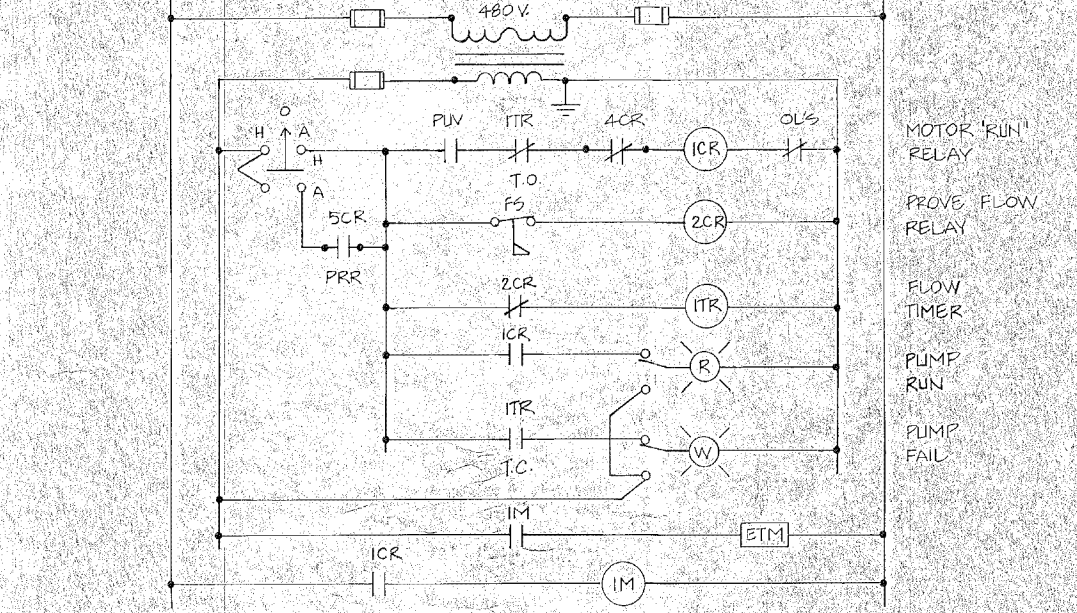

2/E5 HYDRO-PNEUMATIC TANK PUMP AND SYSTEM CONTROL (SEE SPECIFICATION FOR ADDITIONAL INFORMATION)

MINNESOTA DEPARTMENT OF HEALTH
 Division of Environmental Health
 This is to certify that this is a duplicate copy.
 Fee for this service is in report on work
 work improvement, dated
 OCT 10 1984

I HEREBY CERTIFY THAT THIS PLAN WAS PREPARED BY ME OR UNDER MY DIRECT SUPERVISION AND THAT I AM A DULY REGISTERED ENGINEER UNDER LAWS OF THE STATE OF MINNESOTA
 James W. Wilkerson
 DATE 7-26-84 REG. NO. 6910

RC CONSULTANTS OF ANOKA, INC.
 10666 UNIVERSITY AVE. N.W.
 COON RAPIDS, MN. 55433
 (612) 757-0540

IMPROVEMENT PROJECT 84-13
 CONTROL DIAGRAMS
 PUMPHOUSE NO. 1
 CITY OF RAMSEY
 Revisions Date 7-26-84 Sheet 13 of 13 sheets File No. RA5C-02-1 Page

Hakanson Anderson Associates, Inc.
 engineers and surveyors
 222 Monroe Street • Anoka, Minnesota 55303 • 612/427-5860
 Designed by JDW Drawn by HCP Checked by JDW


RAMSEY, MINNESOTA

WELL HOUSE
NO. 4

CONTRACT DRAWINGS
2007


BOLTON & MENK, INC.
CONSULTING ENGINEERS AND LAND SURVEYORS
MANKATO, MINNESOTA

I HEREBY CERTIFY THAT THIS PLAN,
SPECIFICATION OR REPORT WAS PRE-
PARED BY ME OR UNDER MY DIRECT
SUPERVISION, AND THAT I AM A DULY
LICENSED PROFESSIONAL ENGINEER
UNDER THE LAWS OF THE STATE OF
MINNESOTA

SIGNATURE 
TYPED OR
PRINTED NAME Jon D. Peterson


DATE 5-3-07 REG. NO. 21309

REC'D JUN 19 2007

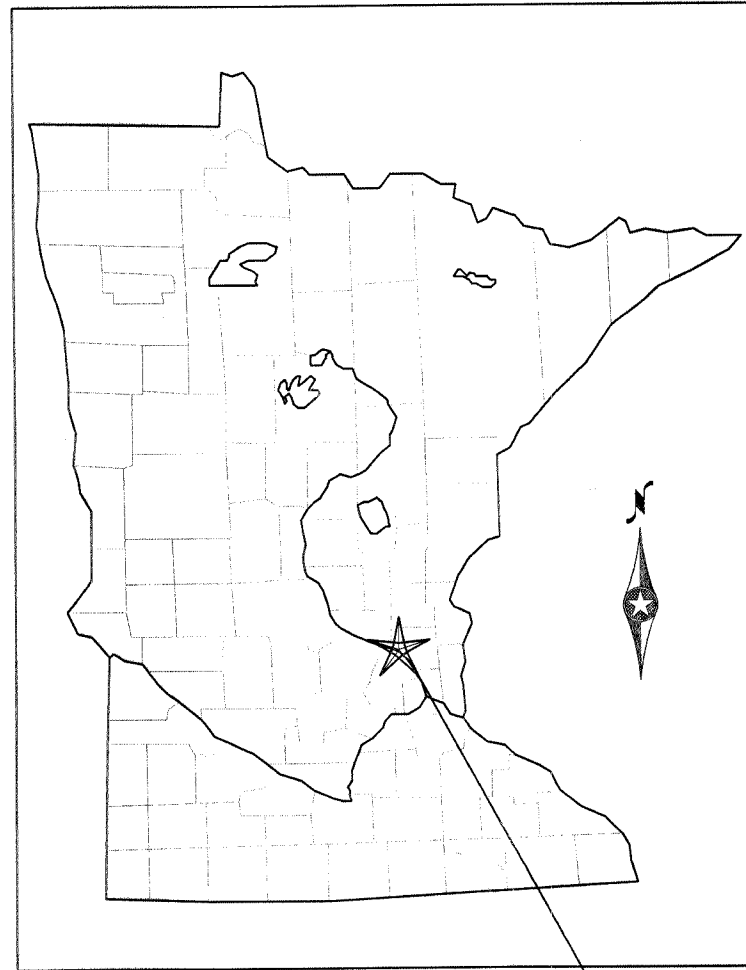

VICINITY MAP
NO SCALE

PROJECT LOCATION

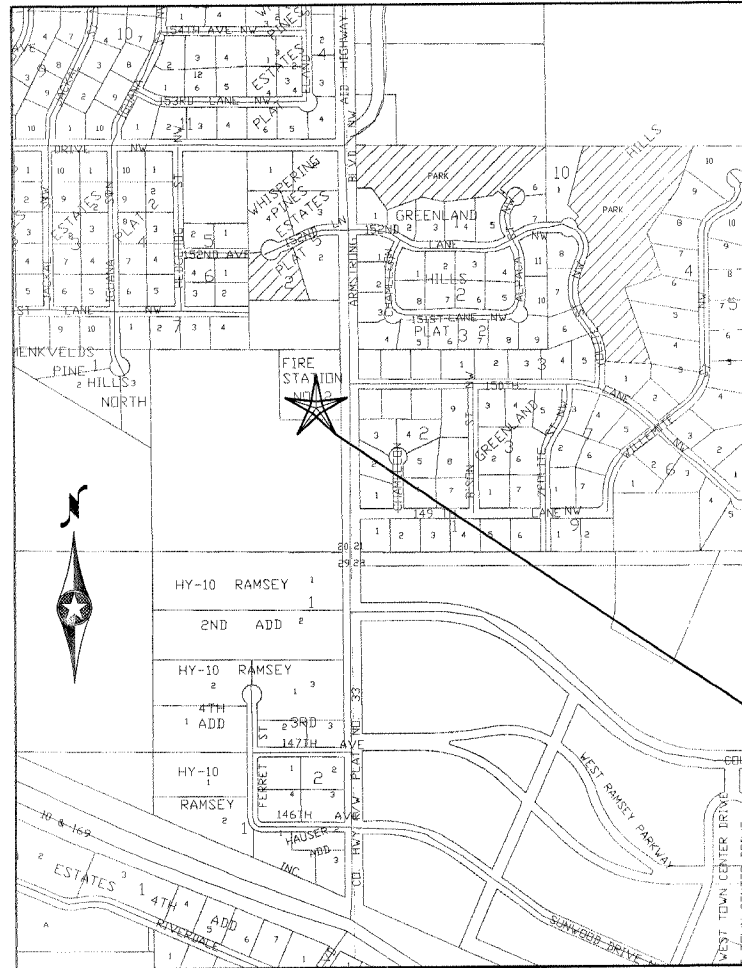

LOCATION MAP
NO SCALE

PROJECT LOCATION

SHEET INDEX

- 1.01 TITLE
- 1.02 VICINITY MAP, LOCATION MAP, AND SHEET INDEX
- 1.03 ABBREVIATION
- 1.04 LEGEND
- 1.05 STANDARD DETAILS
- 1.06 STANDARD DETAILS
- 2.01 SITE PLAN AND DETAIL
- 3.01 PLANS & SCHEDULES
- 3.02 ROOF PLAN, EXTERIOR ELEVATIONS & SECTIONS
- 3.03 STRUCTURAL NOTES
- 4.01 PLAN AND SECTION
- 4.02 CHEMICAL DETAILS
- 5.01 MECHANICAL PLAN
- 5.02 MECHANICAL DETAILS AND EQUIPMENT SCHEDULES
- 6.01 ELECTRICAL PLANS
- 6.02 CONTROL SCHEMATIC
- 6.03 ONE-LINE DIAGRAM, SCHEDULES AND DETAILS

I HEREBY CERTIFY THAT THIS PLAN, SPECIFICATION OR REPORT WAS PREPARED BY ME OR UNDER MY DIRECT SUPERVISION, AND THAT I AM A DULY LICENSED PROFESSIONAL ENGINEER UNDER THE LAWS OF THE STATE OF MINNESOTA

SIGNATURE: *Jon D. Peterson* TYPED OR PRINTED NAME: Jon D. Peterson
DATE: 5-3-07 LIC. NO.: 21309

BOLTON & MENK, INC
CONSULTING ENGINEERS & SURVEYORS
MANKATO, MN FAIRMONT, MN BURNSVILLE, MN SLEEPY EYE, MN
WILLMAR, MN CHASKA, MN RAMSEY, MN AMES, IA


REV.	BY	DATE
A	WRH	11-3-06
0	WRH	5-7-07

RAMSEY, MINNESOTA	SHEET
WELL HOUSE NO. 4	
VICINITY MAP, LOCATION MAP AND SHEET INDEX	1.02

PIPING & FITTINGS	
—AC	Air Cock
—BP—	Backflow Preventer
—B—	Blind Flange
—D—	Drip Trap
↑	Exhaust to Atmosphere (Inside)
↑	Exhaust to Atmosphere (Outside)
—FT—	Flame Trap
—FC—	Flame Cell
—FCA—	Flanged Coupling Adapter (F.C.A.)
—FH—	Flexible Hose
—FD—	Floor Drain - Size
—HSC—	Harnessed Sleeve Coupling (H.S.C.)
—SC—	Sleeve Coupling (S.C.)
—HB—	Hose Bib
—HG—	1-1/2" Hose Gate
—HWR—	Hot Water Recirculation (H.W.R.)
—L—	Lavatory
—M—	Meter
—NC—	Normally Closed
—NO—	Normally Open
—O—	Orifice
—PJ—	Pipe & Joint Designations
—BS—	Bell & Spigot Joint
—CW—	Cold Water
—FA—	Flanged Adapter
—FJF—	Flanged Joint Fitting
—HW—	Hot Water
—MJF—	Mechanical Joint Fitting
—WP—	Wall Pipe
—WS—	Wall Sleeve
—QDC—	Quick Disconnect Coupling
—R—	Reducer
—RC—	Removable Cap
—RP—	Removable Plug
—RD—	Roof Drain (Above Grade)
—RD—	Roof Drain (Below Grade)
—RD—	Roof Drain - Size
—RD—	Rupture Disc
—ST—	Sediment Trap
—SS—	Service Sink
—SH—	Shower
—SFI—	Sight Flow Indicator
—SAG—	Soil or Waste (Above Grade)
—SBL—	Soil or Waste (Below Grade)
—U—	Union
—UR—	Urinal
Valves	
—AV—	Angle Valve
—BV—	Ball Valve
—BV—	Butterfly Valve
—CV—	Check Valve
—DV—	Diaphragm Valve
—GV—	Gate Valve
—GV—	Globe Valve
—HGV—	Hose Gate Valve
—KGV—	Knife Gate Valve
—NV—	Needle Valve
—PV—	Pinch Valve
—PV—	Plug Valve
—PRV—	Pressure Regulating Valve
—PTV—	Pressure/Temperature Relief Valve
—RSV—	Relief or Safety Valve
—SSV—	Shear, Slide, Sluice or Stop Gate
—WV—	3-Way Plug Valve (2-Port)
—WV—	3-Way Plug Valve (3-Port)
—WV—	3-Way Valve
—WV—	3-Way Plug Valve (4-Port)
—V—	Vent
—VTR—	Vent Through Roof
—WH—	Wall Hydrant
—WC—	Water Closet
—WH—	Water Heater
—WC—	Welded Cap
—YH—	Yard Hydrant
—YS—	Y-Type Strainer

HEATING, VENTILATING & AIR CONDITIONING	
—AED—	Adjustable Extracting Device
—ASD—	Adjustable Splitter Damper
—BOD—	Bottom of Duct
—CC—	Cooling Coil
—D—	Damper
—DIR—	Drop in Respect to Air Flow
—EA—	Exhaust Air
—F—	Fan
—FDC—	Flexible Duct Connection
—HC—	Heating Coil
—HWR—	Hot Water Return
—HWS—	Hot Water Supply
—LSD—	Linear or Slot Diffuser
—OA—	Outside Air
—P—	Pump
—RDC—	Rectangular Duct Dimension (1st Figure is Side Shown, 2nd Figure is Side Not Shown)
—RE—	Rectangular Elbow With Turning Vanes
—RA—	Return Air
—REAS—	Return or Exhaust Air Duct Section
—RIS—	Rise in Respect to Air Flow
—RD—	Round Diffuser
—RDC—	Round Duct Dimension
—SRA—	Sidewall RA or EA Grille or Register
—SRA—	Sidewall SA Register or Grille
—SD—	Splitter Damper (Adjustable)
—SRD—	Square or Rectangular Diffuser
—SRD—	Square or Rectangular to Round Transition
—SA—	Supply Air
—SAOS—	Supply or Outside Air Duct Section
—TWV—	Tee With Turning Vanes
—T—	Thermostat
—TOD—	Tap of Duct
—UH—	Unit Heater



INSTRUMENT IDENTIFICATION LETTERS				
FIRST LETTER	SUCCEEDING LETTERS			
MEASURED OR INITIATING VARIABLE	MODIFIER	READOUT OR PASSIVE FUNCTION	OUTPUT FUNCTION	MODIFIER
A	Analysis		Alarm	
B	Burner Flame			
C	Conductivity (Electrical)		Control	
D	Density (Mass) or Specific Gravity	Differential		
E	Voltage (EMF)		Primary Element	
F	Flow Rate	Ratio (Fraction)		
G	Gauging (Dimensional)		Glass	
H	Hand (Manually Initiated)			High
I	Current (Electrical)		Indicate	
J	Power	Scan		
K	Time or Time-Schedule		Control Station	
L	Level		Light (Pilot)	Low Middle or Intermediate
M	Moisture or Humidity			
N			Orifice (Restriction)	
O			Point (Test Connection)	
P	Pressure or Vacuum			
Q	Quantity or Event	Integrate or Totalize	Meter	
R	Radioactivity		Record or Print	
S	Speed or Frequency			Switch
T	Temperature		Totalizing	Transmit
U			Valve, Damper or Louver	
V	Viscosity			
W	Weight or Force		Well	
X				Relay or Compute
Y				Drive, Actuate or Unclassified Final Control Element
Z	Position			

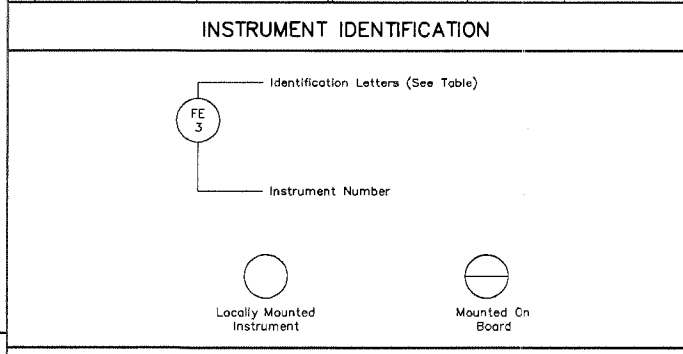


VALVE OPERATORS	
—C—	Cylinders
—CW—	Chainwheel
—D—	Diaphragm
—E—	Electric
—F—	Float
—H—	Hydraulic
—HW—	Handwheel
—L—	Lever
—M—	Motor
—P—	Pneumatic
—S—	Solenoid
—SB—	Soil Boring

PIPING SCHEDULE	
PIPING SYSTEM DESIGNATION	FLUID
AE	Aerator Effluent
AA	Aqueous Ammonia
AW	Filter Air Wash
BW	Filter Backwash
CD	Chemical Drain and Vent
CL	Chlorine (Gas or Liquid State)
CLS	Chlorine Solution
CLV	Chlorine Gas Under Vacuum
CS	Caustic Soda
CV	Chlorinator Vent and Detection Line
DW	Demineralized Water
FI	Filter Influent
FE	Filtered Effluent
FTW	Filtered Water to Waste
HF	Hydrofluosilicic Acid
HR	Heating Water Return
HS	Heating Water Supply
IA	Instrument Air
LA	Liquid Alum
MF	Membrane Feed
NG	Natural Gas
PA	Plant Air
PD	Plant Drain
PEA	Polymer - Anionic
PEC	Polymer - Cationic
PEN	Polymer - Nonionic
PO	Plant Overflow
PP	Process Piping
PPH	Poly Phosphate
PPM	Potassium Permanganate
PW	Potable Water
RW	Raw Water
SA	Sample Line
SD	Sanitary Drain and Vent
SDR	Storm Drain
SI	Sodium Silicate
SL	Sludge
SPD	Sump Pump Discharge
SS	Sanitary Sewer
SW	Filtered Surface Washwater
UW	Utility Water (Non-Potable Water)
V	Vacuum
WW	Filter Waste Washwater
WWR	Washwater Return

EQUIPMENT SCHEDULE	
DESIGNATION	EQUIPMENT TYPE
F	Fan
ME	Miscellaneous Equipment
P	Pump
S	Special
SG	Stop Gate, shear gate, sluice gate, slide gate, flap gate
UH	Unit Heater
V	Valve (Valves 4" Diameter and Larger Included in Schedule)

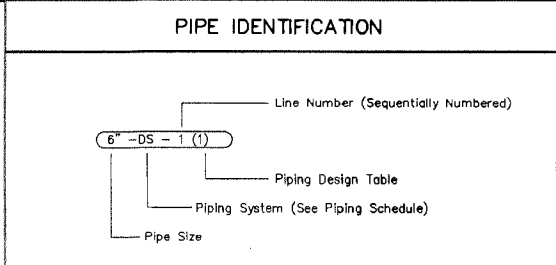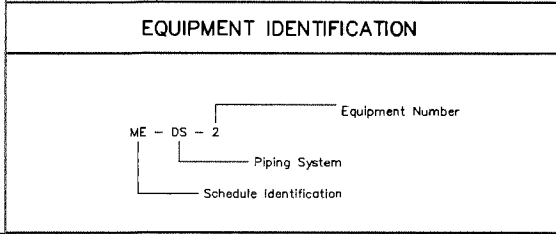

PIPE DESIGN TABLE		
PDT NO.	PIPE MATERIAL	FITTING MATERIAL
1	Class 50 Ductile Iron ANSI A21.51 (AWWA C151) Flanged or Mechanical Joints as Indicated, Class 53 for Threaded Flange	Class 125 Ductile or Cast Iron, ANSI A21.10 (AWWA C110) Flanged or Mechanical Joint as Indicated
2	Standard Weight Carbon Steel, ASTM A120, Black	3-Inch and Smaller - 150 lb. Malleable Iron, ANSI B16.3 Banded, Screwed, 3-1/2 inch and Larger - Standard Weight - ASTM A234 ANSI B16.9 Welded Steel or 125 lb. Flanged Cast Iron as Indicated
3	Standard Weight Carbon Steel, ASTM A120, Galvanized	3-Inch and Smaller - 150 lb. Malleable Iron, ANSI B16.3 Banded, Screwed, Galvanized 3-1/2 inch and Larger - 125 lb. Cast Iron Flanged or Mechanical Coupling as Indicated
4	Copper, ASTM B88 Buried Service - Type K, Soft Temper Exposed Service - Type L, Hard Temper	Wrought Copper or Cast Bronze Solder Joint, ANSI B16.22, 150 psi
5	Polyvinyl Chloride, Schedule 80, Normal Impact ASTM D1785	Schedule 80 Polyvinyl Chloride, Socket Solvent Weld Joints, ASTM D2467
6	Fiberglass Reinforced Plastic (FRP) ASTM D2996	Epoxy Resin Fragment Wound or Matted Type - 150 psi @ 200 F
7	Flexible Teflon Tubing, Vacuum Rated, Installed Inside 2" Schedule 80 PVC Pipe	Compression Fitting or Solvent Weld
8	Cast Iron Soil ANSI A112.5.1, Service Weight, Bell and Spigot or Hubless	Cast Iron Soil ANSI A112.5.1, Service Weight, Bell and Spigot or Hubless
9	Class 50 Ductile Iron ANSI A21.51 (AWWA C151) Bell and Spigot	Class 125 Ductile or Cast Iron, ANSI A21.10 (AWWA C110), Mechanical Joint
10	Polyvinyl Chloride Sewer Pipe, Bell and Spigot ASTM D-3034	Polyvinyl Chloride, Bell and Spigot, ASTM D-3034
11	Standard Weight Steel, ASTM A53, Seamless, (10 Mil Polyethylene or PVC Coated @ Exterior)	Standard Weight, Butt Weld Steel ANSI B16.9 ASTM A234
12	Polyvinyl Chloride Pressure Pipe ASTM D2241 with Bell & Spigot Ends, Wall thickness as Specified	Class 125 Ductile Iron or ANSI A21.10 (AWWA C110) Flanged or Mechanical Joints as Indicated
13	Polypropylene, ASTM D2146 Schedule 40 with Heat Fused Joints	Polypropylene, Schedule 40 Drainage Type with Heat Fused Socket Joints
14	Stainless Steel AISI Type 304, ASTM A312 Schedule 5S	Stainless Steel AISI Type 316 ANSI B16.9 Butt-Welded Schedule 5S or 150 lb Flanged
15	Welded Steel, AWWA C200 with Specified Wall Thickness, Epoxy/Cement Mortar Lined for Potable Water Service	ASTM A234, Grade B, Seamless or Butt-welded, Fittings 14-inches and Larger Mitered to Conform to AWWA C208 Table 2 with Butt-Weld Ends

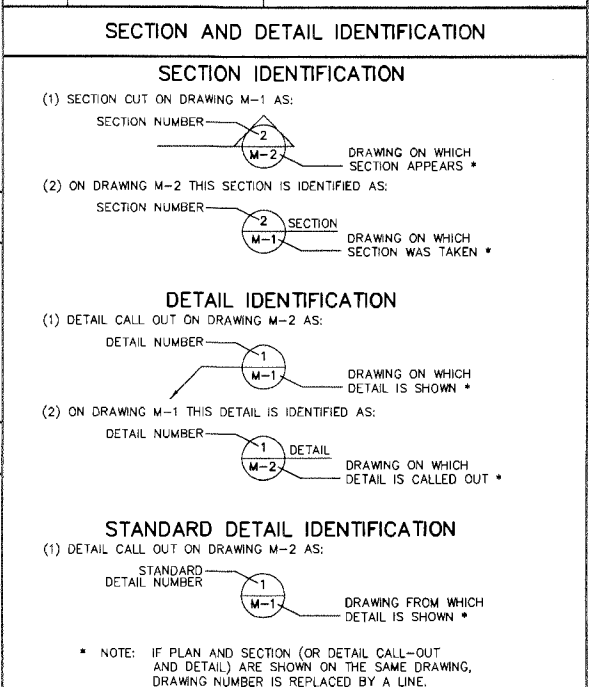


I HEREBY CERTIFY THAT THIS PLAN, SPECIFICATION OR REPORT WAS PREPARED BY ME OR UNDER MY DIRECT SUPERVISION, AND THAT I AM A FULLY LICENSED PROFESSIONAL ENGINEER UNDER THE LAWS OF THE STATE OF MINNESOTA.

SIGNATURE: *Jon D. Peterson* TITLE OR PRINTED NAME: Jon D. Peterson
DATE: 5-3-07 LIC. NO.: 21309


BOLTON & MENK, INC
CONSULTING ENGINEERS & SURVEYORS
MANKATO, MN FAIRMONT, MN BURNSVILLE, MN SLEEPY EYE, MN
WILLMAR, MN CHASKA, MN RAMSEY, MN AMES, IA

REV.	BY	DATE
A	WRH	11-3-06
0	WRH	5-7-07


RAMSEY, MINNESOTA
WELL HOUSE NO. 4
LEGEND

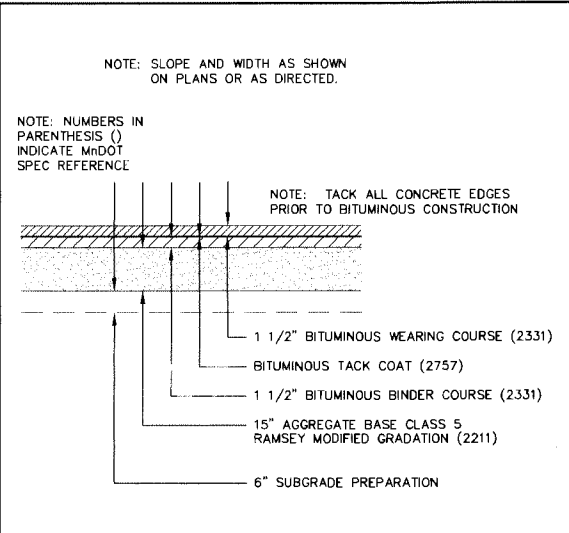


1 BITUMINOUS ROADWAY SECTION
 1.05 NO SCALE

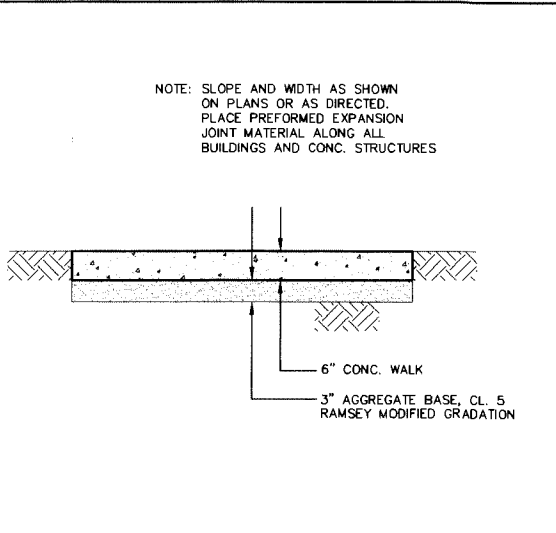


2 CONCRETE WALK SECTION
 1.05 NO SCALE

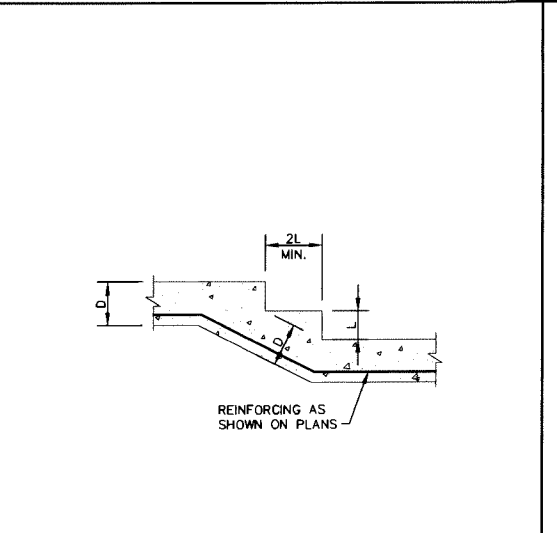


3 STEP FOOTING DETAIL
 1.05 SCALE: 1/2"=1'-0"

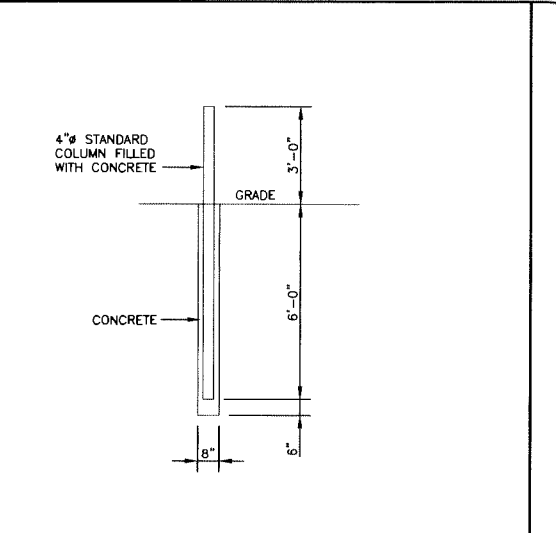


4 GUARDPOST DETAIL
 1.05 SCALE: 3/8"=1'-0"

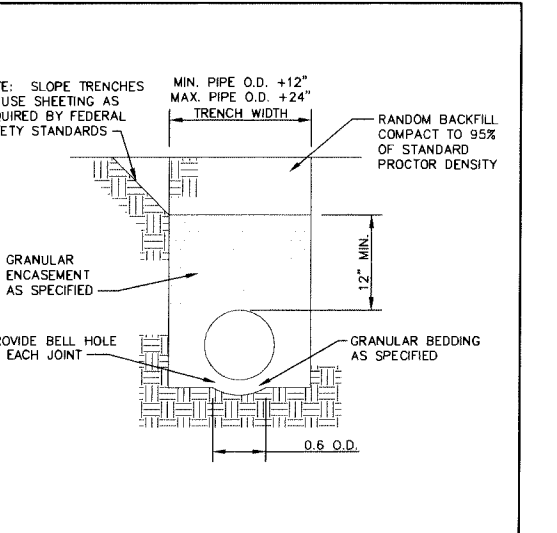


5 TRENCH DETAIL DUCTILE IRON PIPE
 1.05 SCALE: 1"=1'-0"

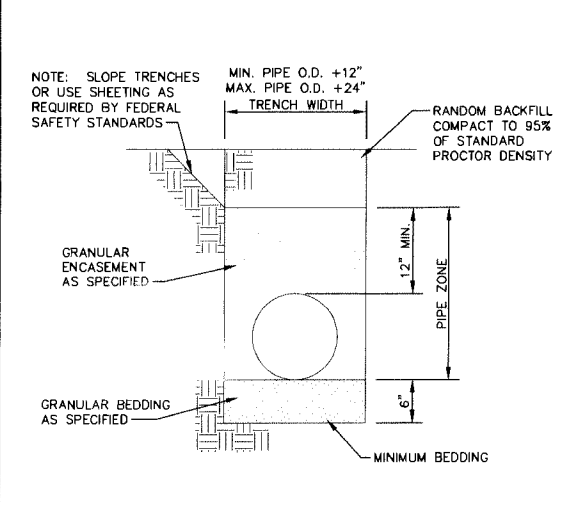


6 TRENCH DETAIL PVC PIPE
 1.05 SCALE: 1"=1'-0"

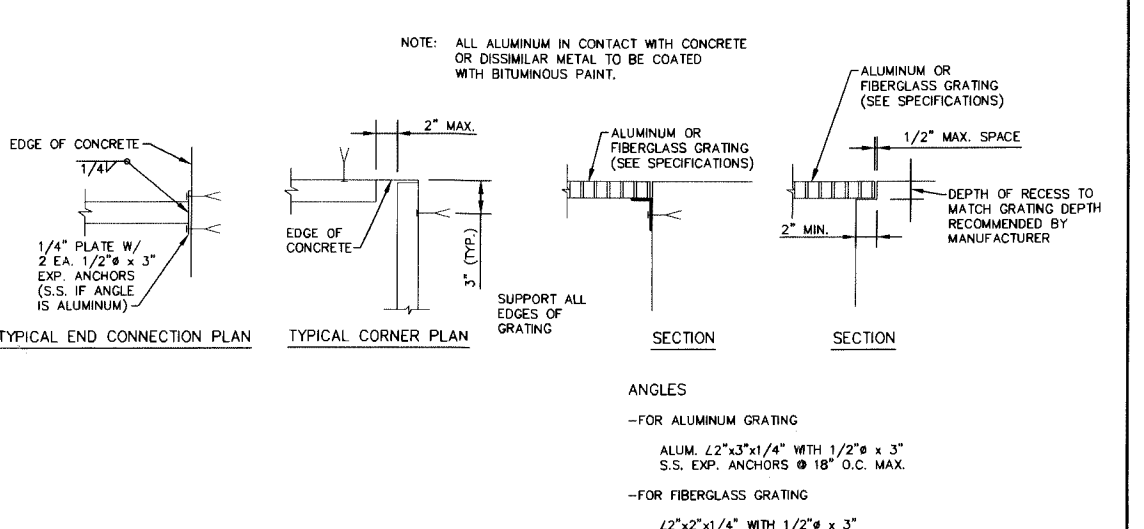

7 GRATING INSTALLATION
 1.05 SCALE: 1 1/2"=1'-0"

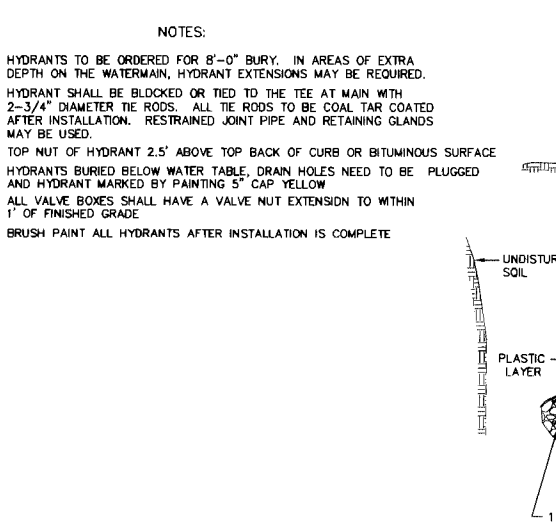

8 HYDRANT INSTALLATION, TIED TO MAIN
 1.05 NOT TO SCALE

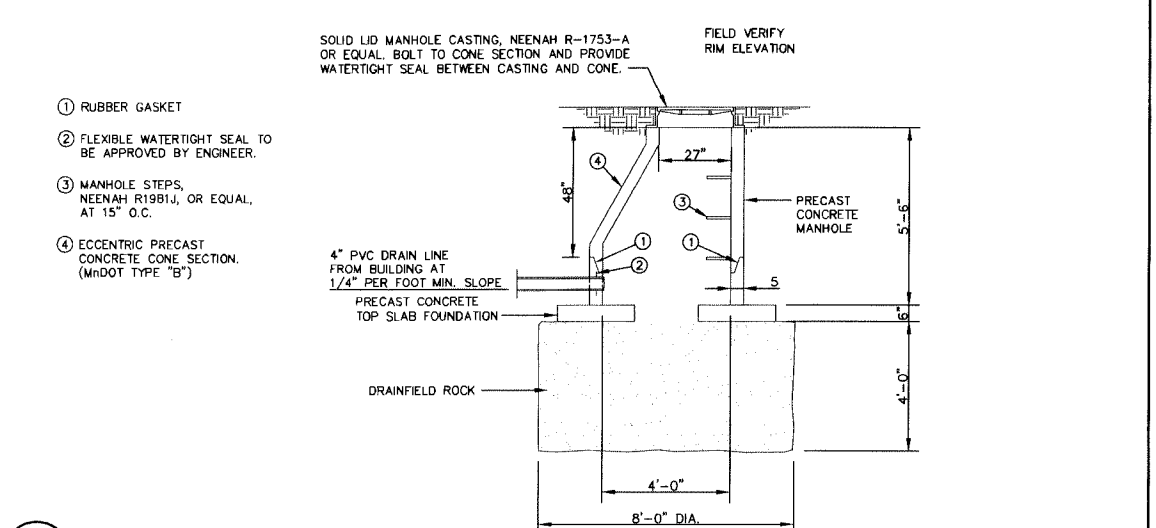

9 GRAVEL POCKET DETAIL
 1.05 SCALE: 3/8"=1'-0"

I HEREBY CERTIFY THAT THIS PLAN, SPECIFICATION OR REPORT WAS PREPARED BY ME OR UNDER MY DIRECT SUPERVISION, AND THAT I AM A DULY LICENSED PROFESSIONAL ENGINEER UNDER THE LAWS OF THE STATE OF MINNESOTA

SIGNATURE: *J.D. Peterson* PRINTED NAME: Jon D. Peterson

DATE: 5-21-07 LIC. NO.: 21309

BOLTON & MENK, INC

CONSULTING ENGINEERS & SURVEYORS

MANKATO, MN FAIRMONT, MN BURNSVILLE, MN SLEEPY EYE, MN
 WILLMAR, MN CHASKA, MN RAMSEY, MN AMES, IA

REV	BY	DATE
A	WRH	11-3-06
O	WRH	5-21-07

RAMSEY, MINNESOTA


WELL HOUSE NO. 4

STANDARD DETAILS


1.05

NOTES:


1. VALVE BOX SHALL BE CENTERED ON OPERATING NUTS. STRAIGHT, FREE FROM DEBRIS, AND ALL SECTIONS UNBROKEN.
2. VALVES IN EASEMENTS SHALL BE MARKED WITH BLUE CARBONITE MARKER.
3. ALL VALVES SHALL HAVE VALVE NUT EXTENSION INSTALLED TO WITHIN 1 FOOT OF SURFACE. DEEP EXTENSIONS SHALL BE WELDED TOGETHER.
4. COMPACTION WITHIN THE UPPER 3 FEET OF SUBGRADE SHALL BE 100%.
5. GATE VALVES LOCATED WITHIN THE CONCRETE SIDEWALK SHALL INCLUDE A METAL SEPARATOR BETWEEN THE VALVE BOX AND THE CONCRETE.

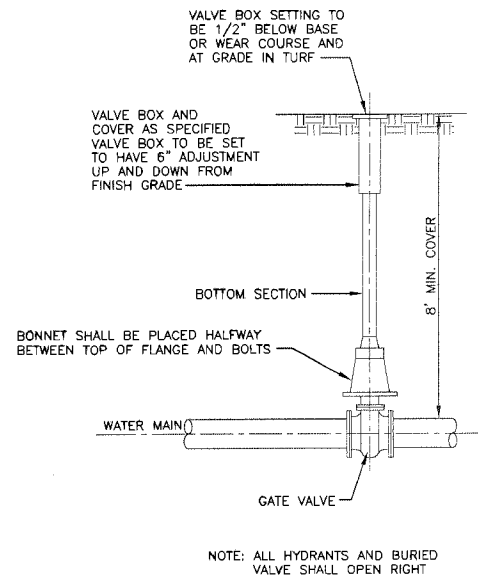


1 TYPICAL BURIED VALVE
1.06 SCALE: 1/2"=1'-0"

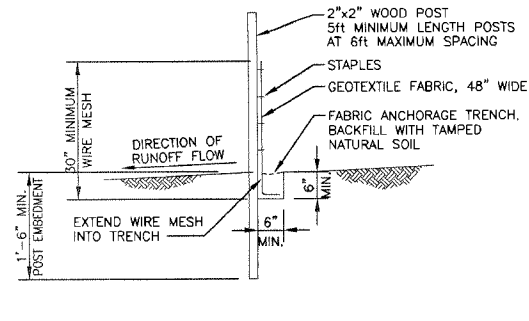


2 SILT FENCE - PREASSEMBLED
1.06 NOT TO SCALE

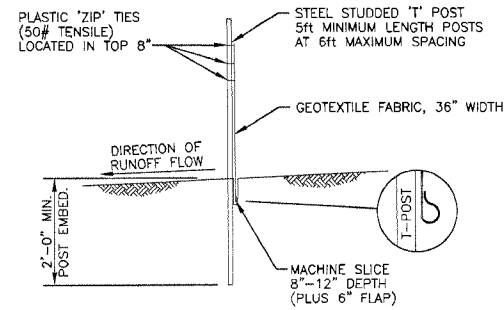


3 SILT FENCE - MACHINE SLICED
1.06 NOT TO SCALE

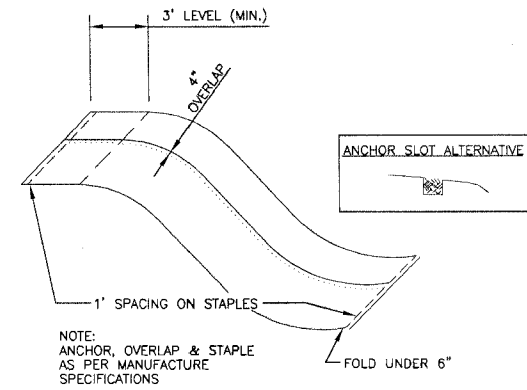


4 EROSION CONTROL BLANKET INSTALLATION
1.06 NOT TO SCALE

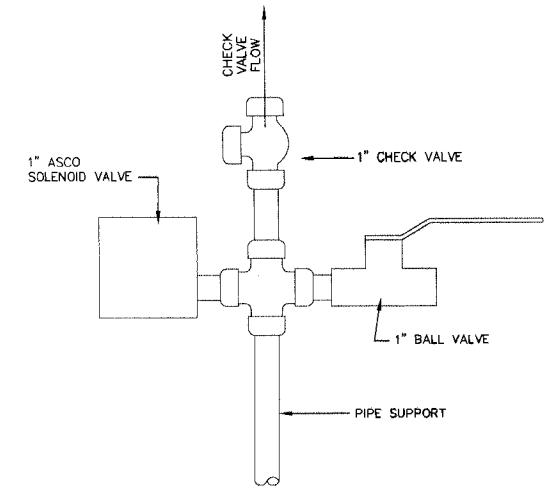


5 SIPHON VALVE DETAIL
1.06 NO SCALE

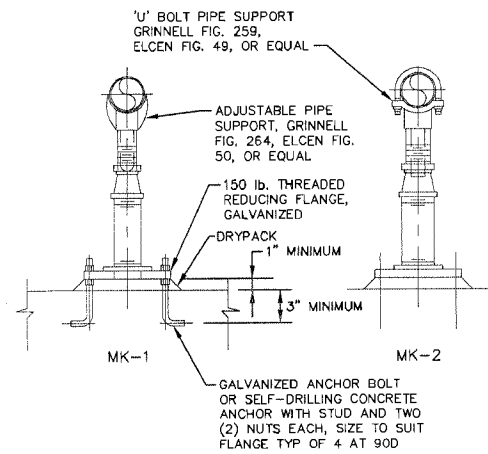


6 ADJUSTABLE PIPE SUPPORT
1.06 SCALE: 1 1/2"=1'-0"

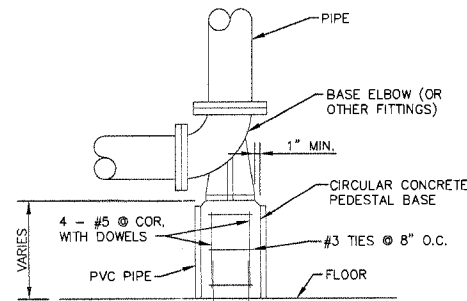


7 CONCRETE PEDESTAL BASE
1.06 SCALE: 3/4"=1'-0"

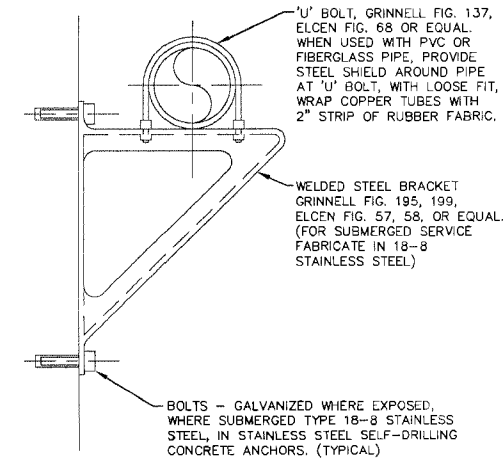


8 PIPE BRACKET
1.06 SCALE: 3"=1'-0"

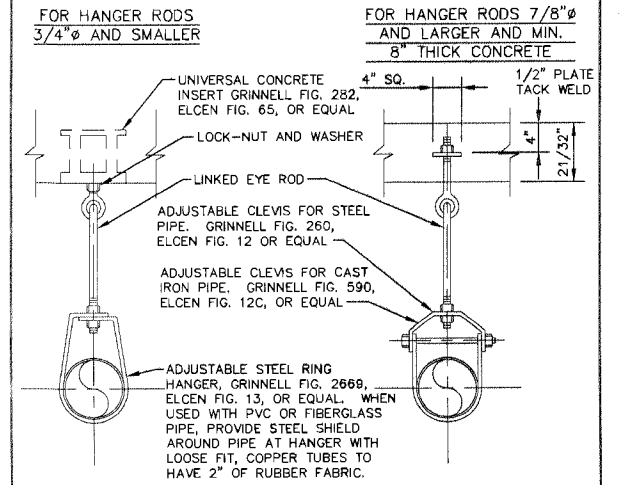


9 PIPE BRACKET
1.06 SCALE: 1 1/2"=1'-0"

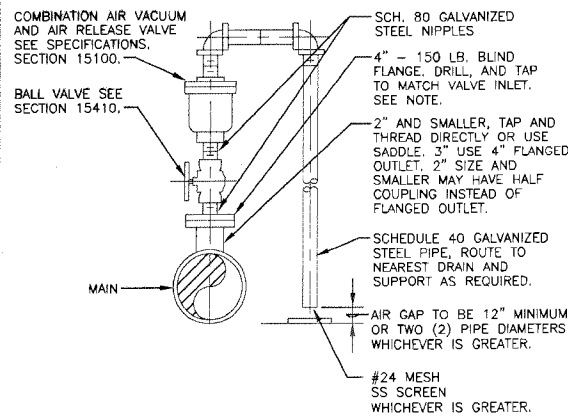


10 AIR-VACUUM AND AIR-RELEASE VALVE ASSEMBLY 3\"/>

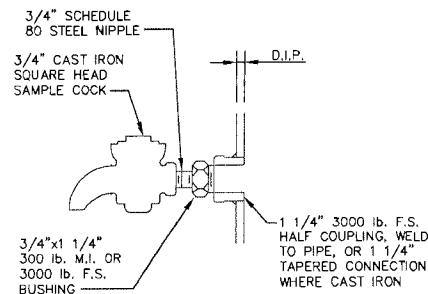




11 SAMPLE COCK
1.06 SCALE: 3"=1'-0"

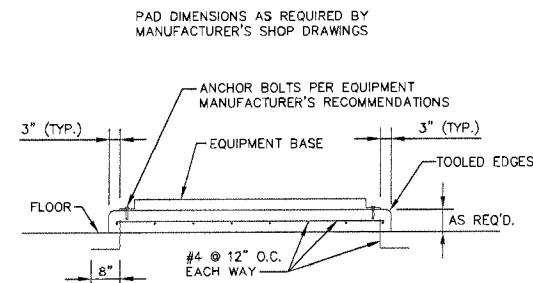

12 CONCRETE EQUIPMENT BASE
1.06 SCALE: 1/2"=1'-0"

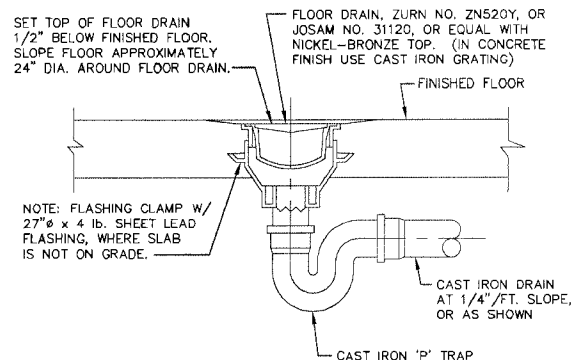

13 FLOOR DRAIN
1.06 SCALE: 1"=1'-0"

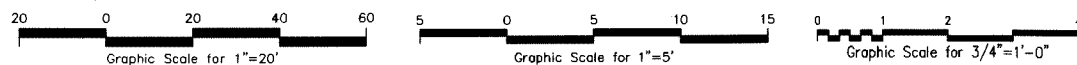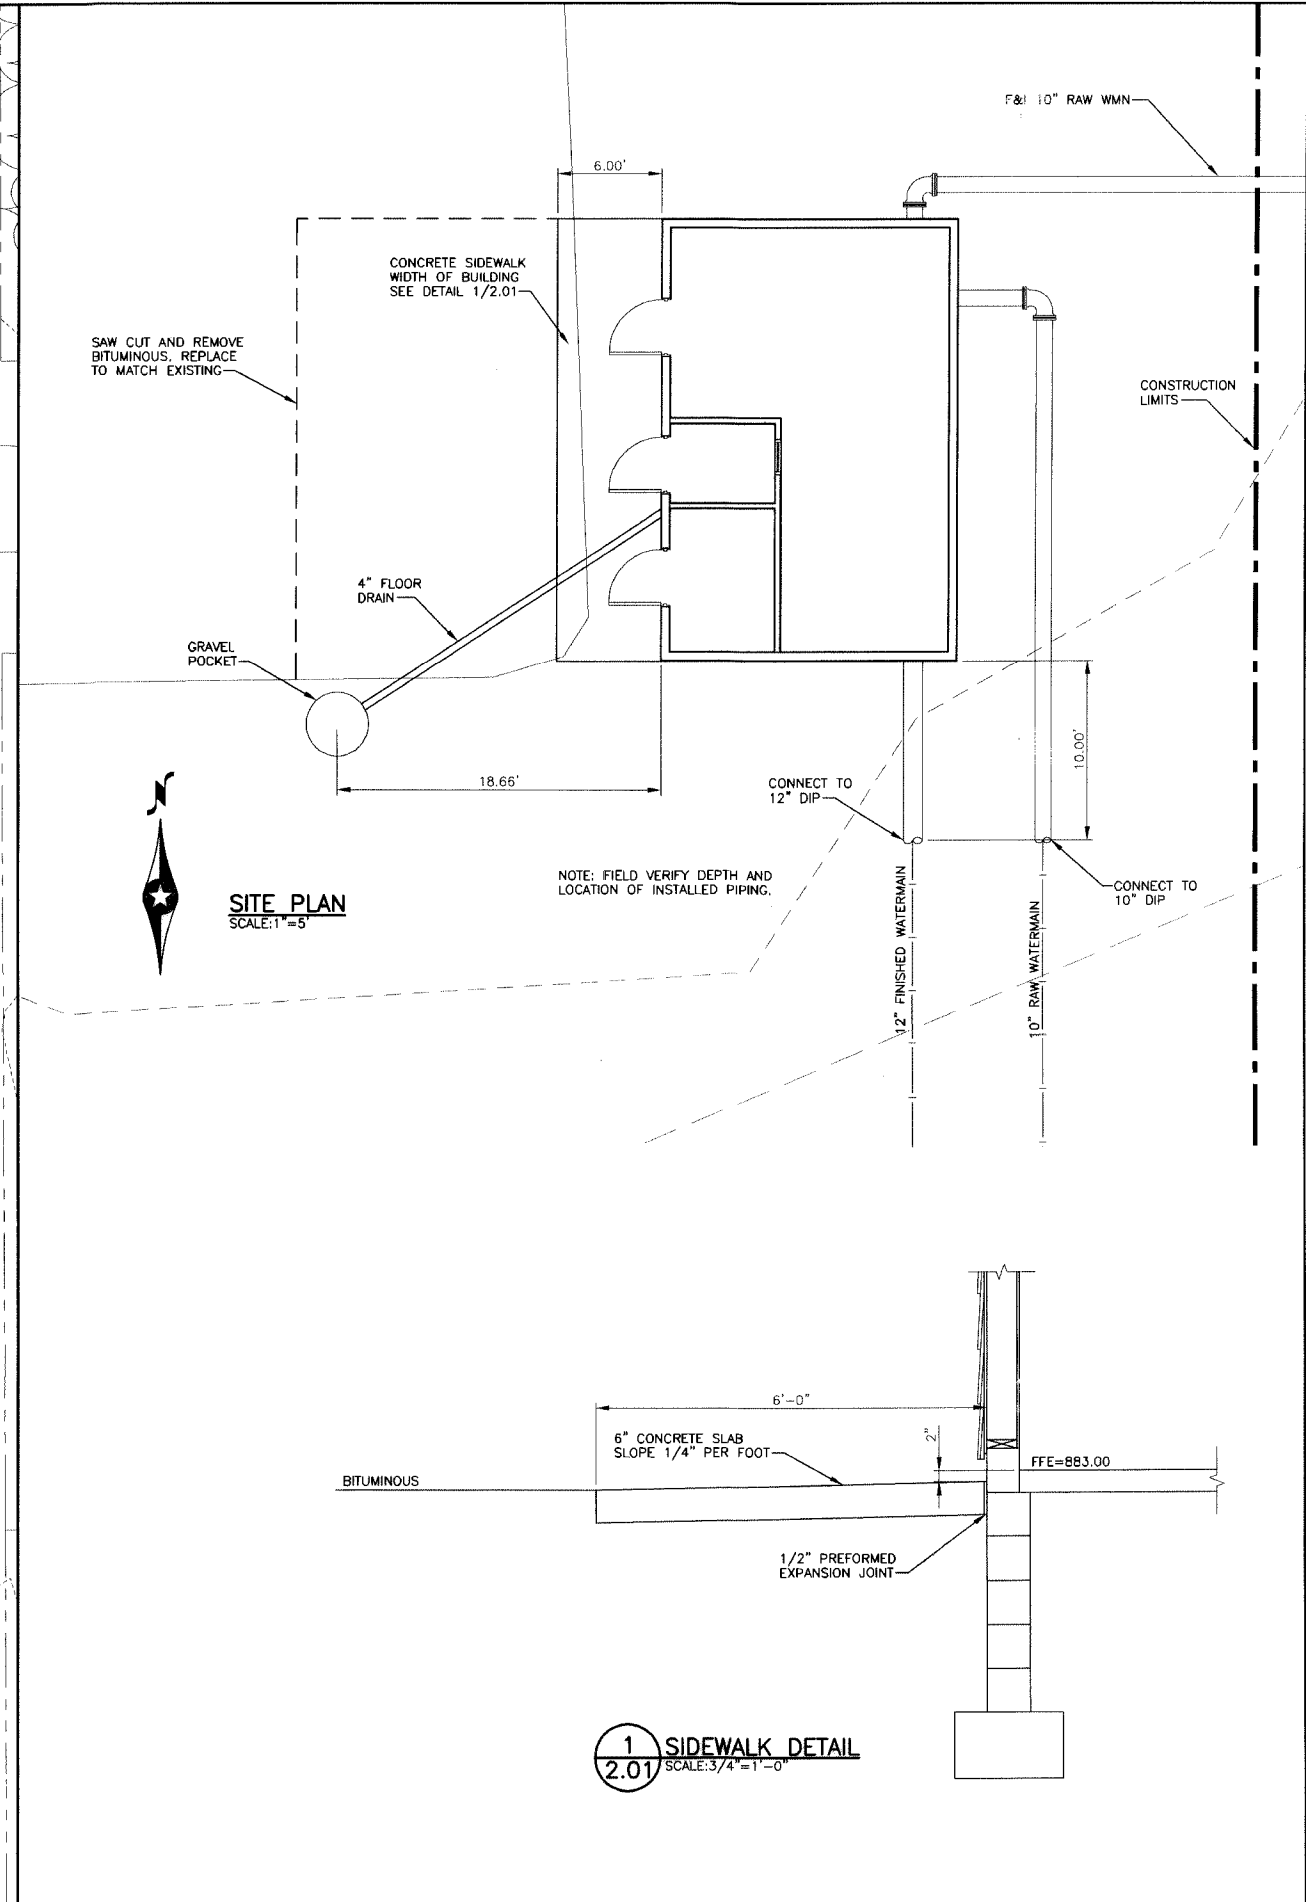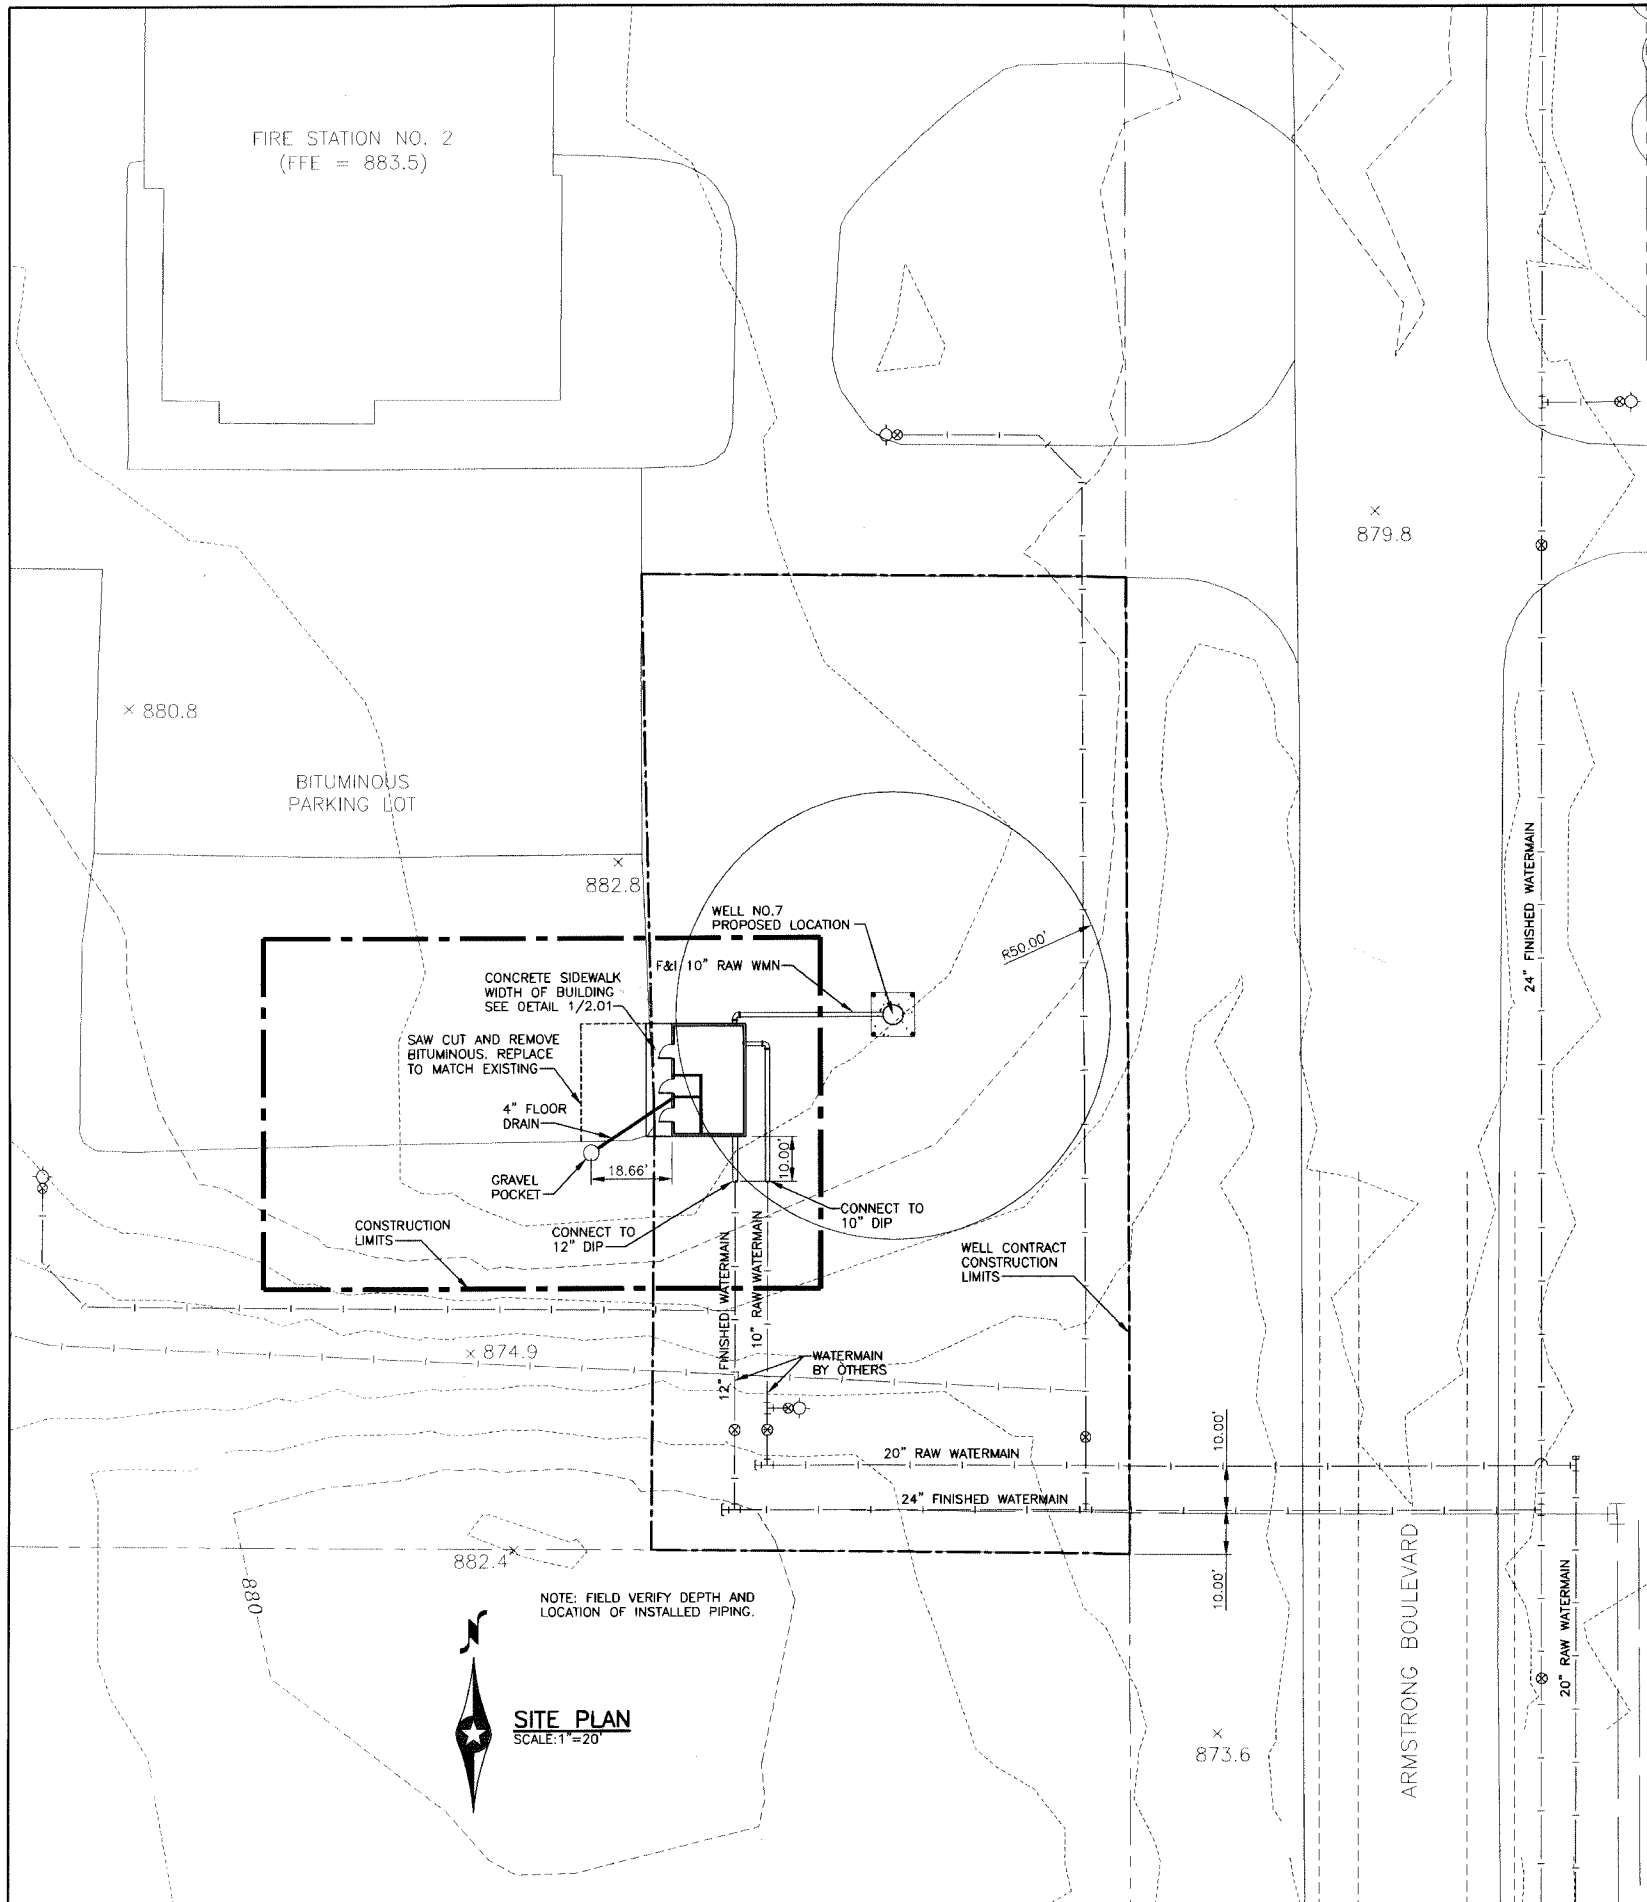

I HEREBY CERTIFY THAT THIS PLAN, SPECIFICATION OR REPORT WAS PREPARED BY ME OR UNDER MY DIRECT SUPERVISION, AND THAT I AM A DULY LICENSED PROFESSIONAL ENGINEER UNDER THE LAWS OF THE STATE OF MINNESOTA

SIGNATURE: *Jon D. Peterson* FILED OR PRINTED NAME: Jon D. Peterson
DATE: 5-21-07 LIC. NO.: 21309

BOLTON & MENK, INC
CONSULTING ENGINEERS & SURVEYORS
MANKATO, MN FAIRMONT, MN BURNSVILLE, MN SLEEPY EYE, MN
WILLMAR, MN CHASKA, MN RAMSEY, MN AMES, IA


REV.	BY	DATE
A	WRH	11-3-06
0	WRH	5-21-07

RAMSEY, MINNESOTA
WELL HOUSE NO. 4
SITE PLAN AND DETAIL


SHEET
2.01

CODE REVIEW: WATER TREATMENT FACILITY- RAMSEY, MINNESOTA


BUILDING CODE:	INTERNATIONAL BUILDING CODE-2006 EDITION MINNESOTA STATE BUILDING CODE-2007 EDITION CITY OF RAMSEY ZONING ORDINANCES
OCCUPANCY:	F-2 (WATER TREATMENT FACILITY)
OCCUPANTS:	5 OCC. (PER TABLE 1003.2.2.2) 1 OCC. (ACTUAL)
CONSTRUCTION TYPE:	V-B WOOD STUD WALL STANDARD WOOD TRUSS
ALLOWABLE AREA:	13,000 SQ. FT.
PROPOSED AREA:	425 SQ. FT. (GROSS)
SPRINKLERED:	CHLORINE ROOM SPRINKLER ONLY
BUILDING HEIGHT:	13'-0" +/- (RIDGE HEIGHT)

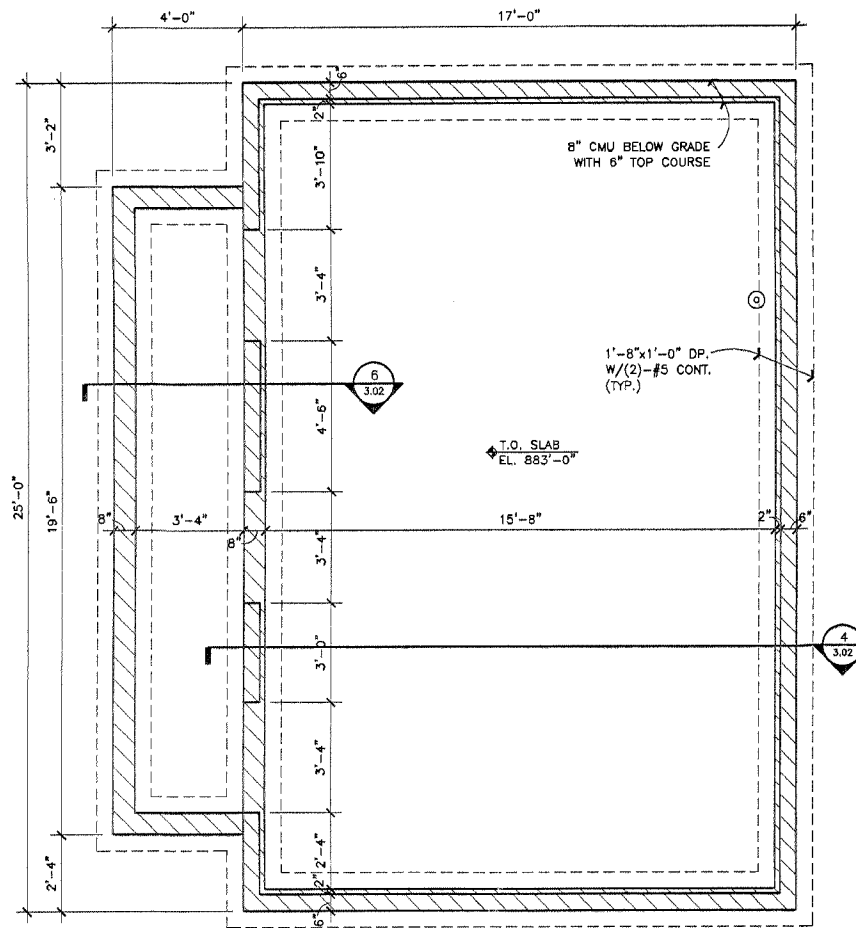

FOUNDATION PLAN

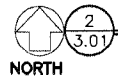

SCALE: 3/8"=1'-0"

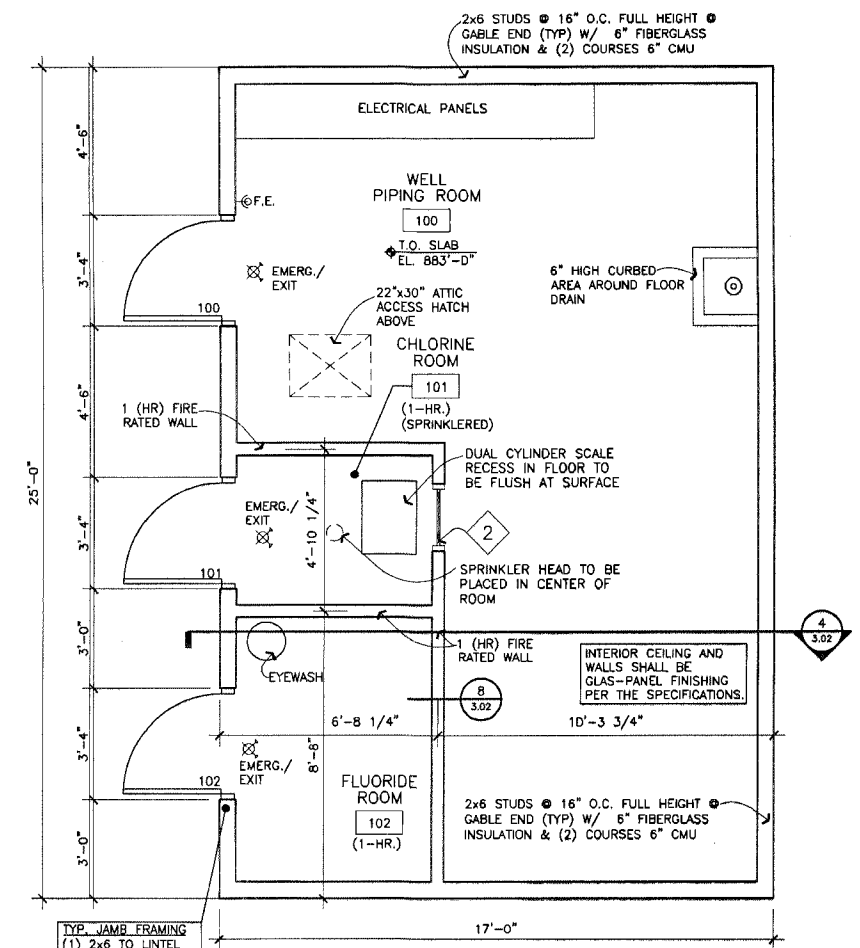

FLOOR PLAN



SCALE: 3/8"=1'-0"

DOOR SCHEDULE


DOOR NO.	DOOR SIZE	DOOR TYPE	DOOR FINISH	FRAME TYPE	HDWE.	JAMB	RAT'G.	REMARKS
100	3'-0"x6'-8"x1-3/4"	(A)	PAINT	1		7-1/4"		EX. HVY. DUTY HINGES/CLOSER/LEVER LOCKSET/T-HOLD/W-STRIP/RAIN DRIP/SWEEP/KICKPLATE/O.H. STOP
101	3'-0"x6'-8"x1-3/4"	(A)	PAINT	1		7-1/4" 6DMIN		EX. HVY. DUTY HINGES/CLOSER/T-HOLD/W-STRIP/RAIN DRIP/SWEEP/KICKPLATE/O.H. STOP/PANIC DEVICE
102	3'-0"x6'-8"x1-3/4"	(A)	PAINT	1		7-1/4"		EX. HVY. DUTY HINGES/CLOSER/LEVER LOCKSET/T-HOLD/W-STRIP/RAIN DRIP/SWEEP/KICKPLATE/O.H. STOP

DOOR TYPES




HOLLOW METAL (PRIME & PAINT) 16 GAUGE

FRAME TYPES

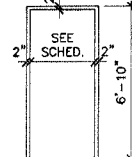

HOLLOW METAL (PRIME & PAINT) 16 GAUGE

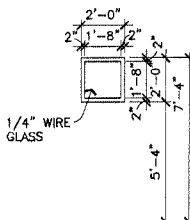

HOLLOW METAL W/ 45 MIN. FIRE RATING (PRIME & PAINT) 16 GAUGE

ROOM FINISH SCHEDULE

NO	ROOM NAME	FLOOR	BASE	WALLS	CEILING	REMARKS
100	WELL PIPING ROOM	CONCRETE	PAINTED	GLAS-PANEL FINISHING PER THE SPECS.	GLAS-PANEL FINISHING PER THE SPECS.	
101	CHLORINE ROOM (1-HR. RATED)	CONCRETE	PAINTED	GLAS-PANEL FINISHING PER THE SPECS.	GLAS-PANEL FINISHING PER THE SPECS.	
102	FLUORIDE ROOM	CONCRETE	PAINTED	GLAS-PANEL FINISHING PER THE SPECS.	GLAS-PANEL FINISHING PER THE SPECS.	

NOTES:

- SEE SITE PLAN FOR ORIENTATION AND FINISHED SITE GRADE.
- COLOR OF STEEL SIDING SHALL BE SELECTED BY ENGINEER.
- COLOR OF STEEL ROOFING SHALL BE SELECTED BY ENGINEER.
- COLOR OF ALUMINUM SOFFIT AND FASCIA SHALL BE SELECTED BY ENGINEER.
- DOORS AND FRAMES SHALL BE SUPPLIED AS SPECIFIED IN SECTION 08110.

I HEREBY CERTIFY THAT THIS PLAN, SPECIFICATION OR REPORT WAS PREPARED BY ME OR UNDER MY DIRECT SUPERVISION, AND THAT I AM A DULY LICENSED PROFESSIONAL ENGINEER UNDER THE LAWS OF THE STATE OF MINNESOTA.
 SIGNATURE: *Brian J. Salfer* TYPED OR PRINTED NAME: **BRIAN J. SALFER**
 DATE: **MAY 7, 2007** REG. NO. **41632**

LS ENGINEERS
 200 S. Main St.
 LeSueur, MN 56058

I HEREBY CERTIFY THAT THIS PLAN, SPECIFICATION OR REPORT WAS PREPARED BY ME OR UNDER MY DIRECT SUPERVISION, AND THAT I AM A DULY LICENSED ARCHITECT UNDER THE LAWS OF THE STATE OF MINNESOTA (ARCHITECTURAL ONLY).
 SIGNATURE: *David J. Medin* TYPED OR PRINTED NAME: **DAVID J. MEDIN**
 DATE: **MAY 7, 2007** REG. NO. **9898**

ARCH. PROJ. #: 2875
architects plus
 203 nw first ave.
 faribault, minn.
 507/334-2251 55021
 507/334-8850 FAX


BOLTON & MENK, INC
 CONSULTING ENGINEERS & SURVEYORS
 MANKATO, MN FAIRMONT, MN BURNSVILLE, MN SLEEPY EYE, MN
 WILLMAR, MN CHASKA, MN RAMSEY, MN AMES, IA

REV.	BY	DATE
A	TJR	11-3-06
0	TJR	5-7-07

RAMSEY, MINNESOTA
WELL HOUSE NO. 4
PLANS AND SCHEDULES


SHEET

3.01

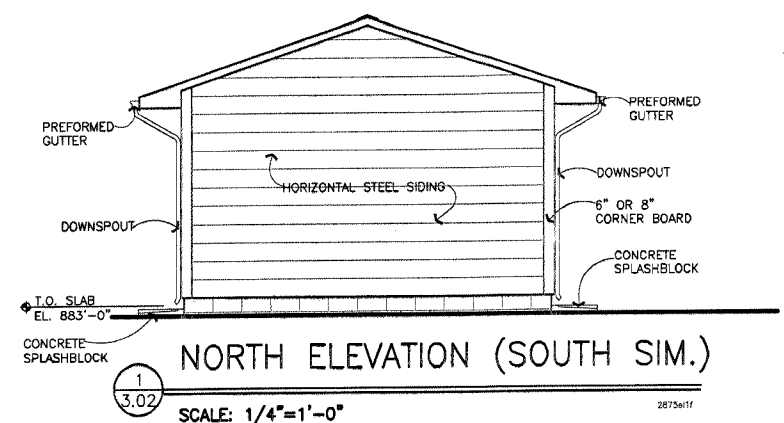


NORTH ELEVATION (SOUTH SIM.)

SCALE: 1/4"=1'-0"

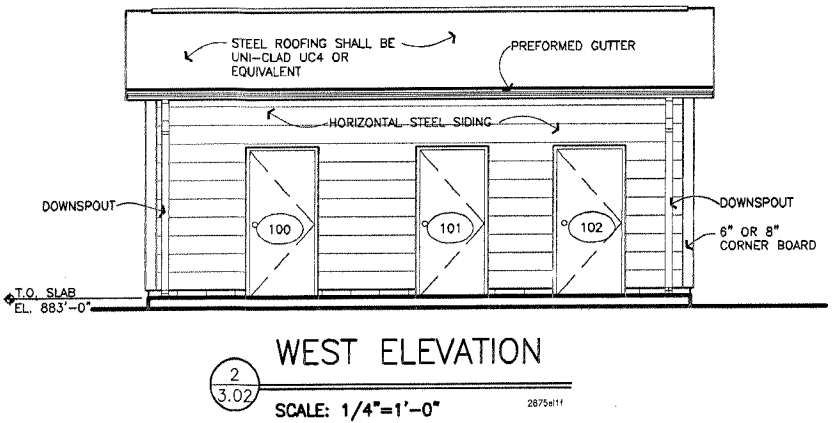


WEST ELEVATION

SCALE: 1/4"=1'-0"

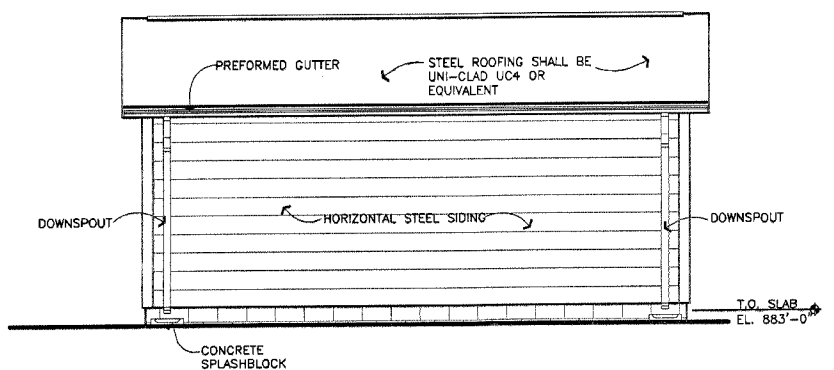


EAST ELEVATION

SCALE: 1/4"=1'-0"

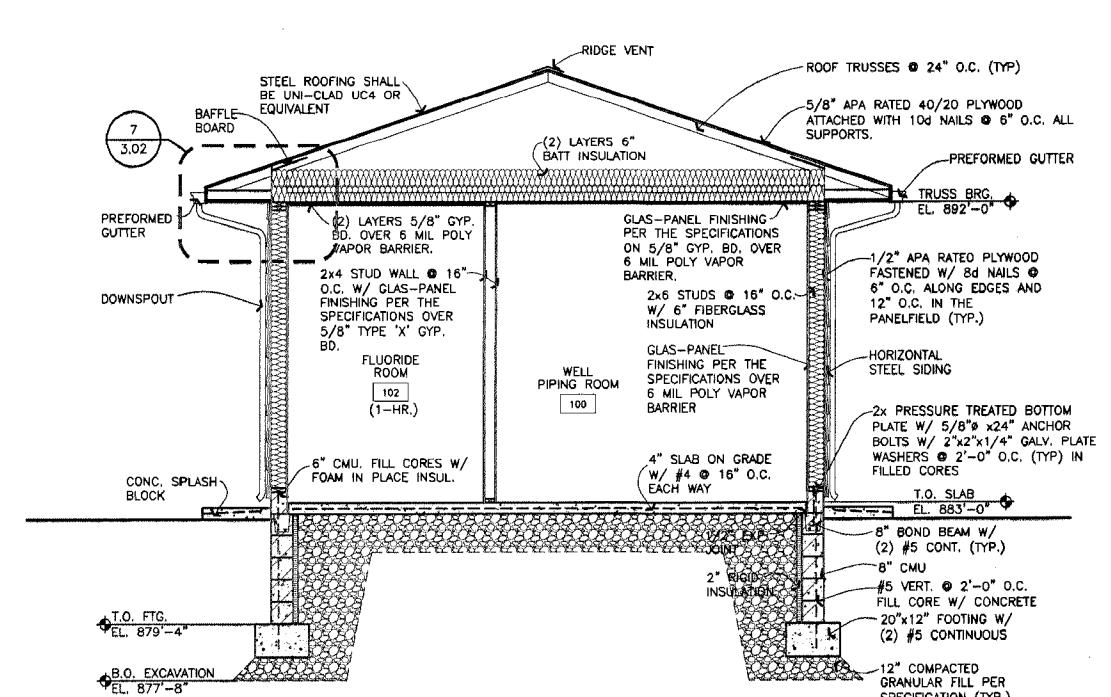



BUILDING SECTION

SCALE: 3/8"=1'-0"

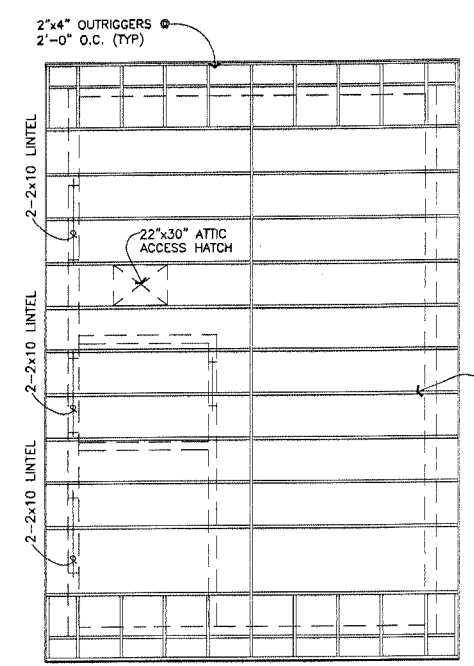


TRUSS PLAN

SCALE: 1/4"=1'-0"

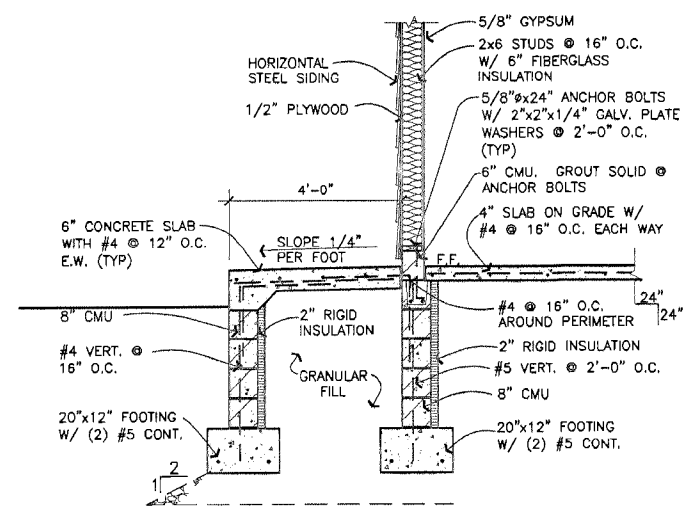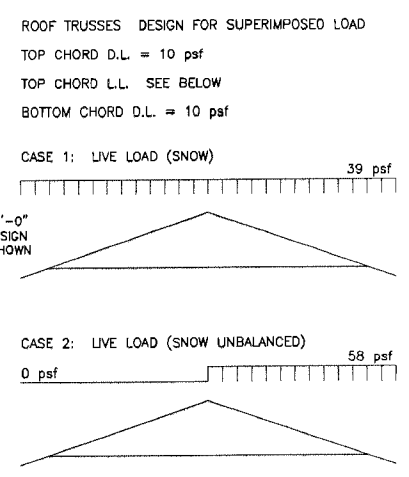


SECTION

SCALE: 1/2"=1'-0"

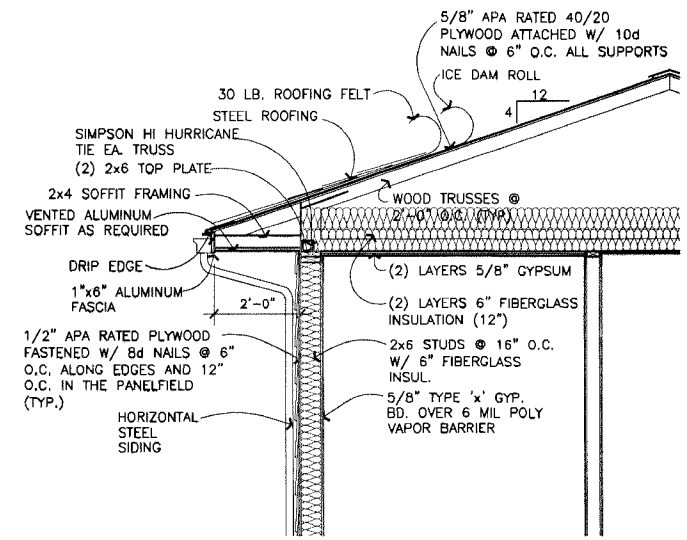

SECTION

SCALE: 1/2"=1'-0"

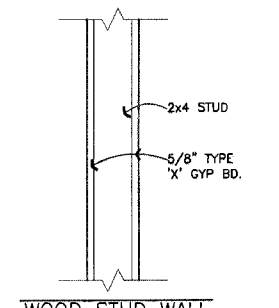

WALL TYPE

SCALE: 1 1/2"=1'-0"

I HEREBY CERTIFY THAT THIS PLAN, SPECIFICATION OR REPORT WAS PREPARED BY ME OR UNDER MY DIRECT SUPERVISION, AND THAT I AM A DULY LICENSED PROFESSIONAL ENGINEER UNDER THE LAWS OF THE STATE OF MINNESOTA.
 SIGNATURE: *Brian J. Salfer* TYPED OR PRINTED NAME: BRIAN J. SALFER
 DATE: MAY 7, 2007 REG. NO.: 41632

LS 0094 06-349
LS ENGINEERS
 200 S. Main St.
 LaSueur, MN 56058

I HEREBY CERTIFY THAT THIS PLAN, SPECIFICATION OR REPORT WAS PREPARED BY ME OR UNDER MY DIRECT SUPERVISION, AND THAT I AM A DULY LICENSED ARCHITECT UNDER THE LAWS OF THE STATE OF MINNESOTA. (ARCHITECTURAL ONLY)
 SIGNATURE: *David J. Medin* TYPED OR PRINTED NAME: DAVID J. MEDIN
 DATE: MAY 7, 2007 REG. NO.: 9898

ARCH. PROJ. #: 2875
architects plus
 203 nw first ave.
 faribault, minn.
 56104-2251 55021
 507/334-8250 FAX


BOLTON & MENK, INC
 CONSULTING ENGINEERS & SURVEYORS
 MANKATO, MN FAIRMONT, MN BURNSVILLE, MN SLEEPY EYE, MN
 WILLMAR, MN CHASKA, MN RAMSEY, MN AMES, IA

REV.	BY	DATE
A	TJR	11-3-06
0	TJR	5-7-07



RAMSEY, MINNESOTA
WELL HOUSE NO. 4
 ROOF PLAN, EXTERIOR ELEVATIONS AND SECTIONS

SHEET
3.02


F:\ad2\proj\2875\plan\2875a3.02.dwg, 5/3/2007 2:16:13 PM, Arch D (24x36)

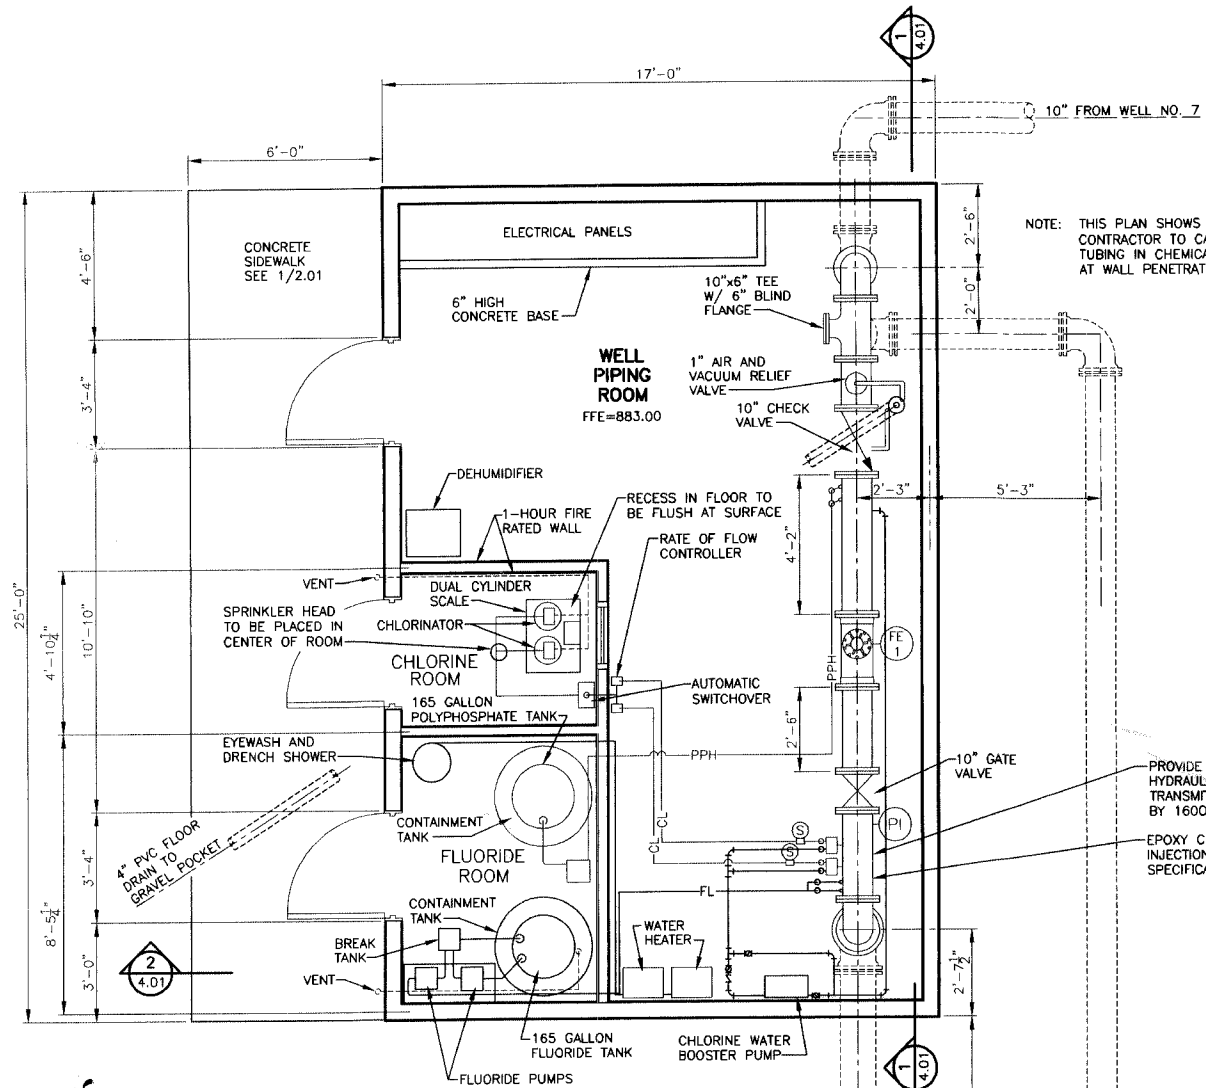

PLAN
SCALE: 3/8" = 1'-0"

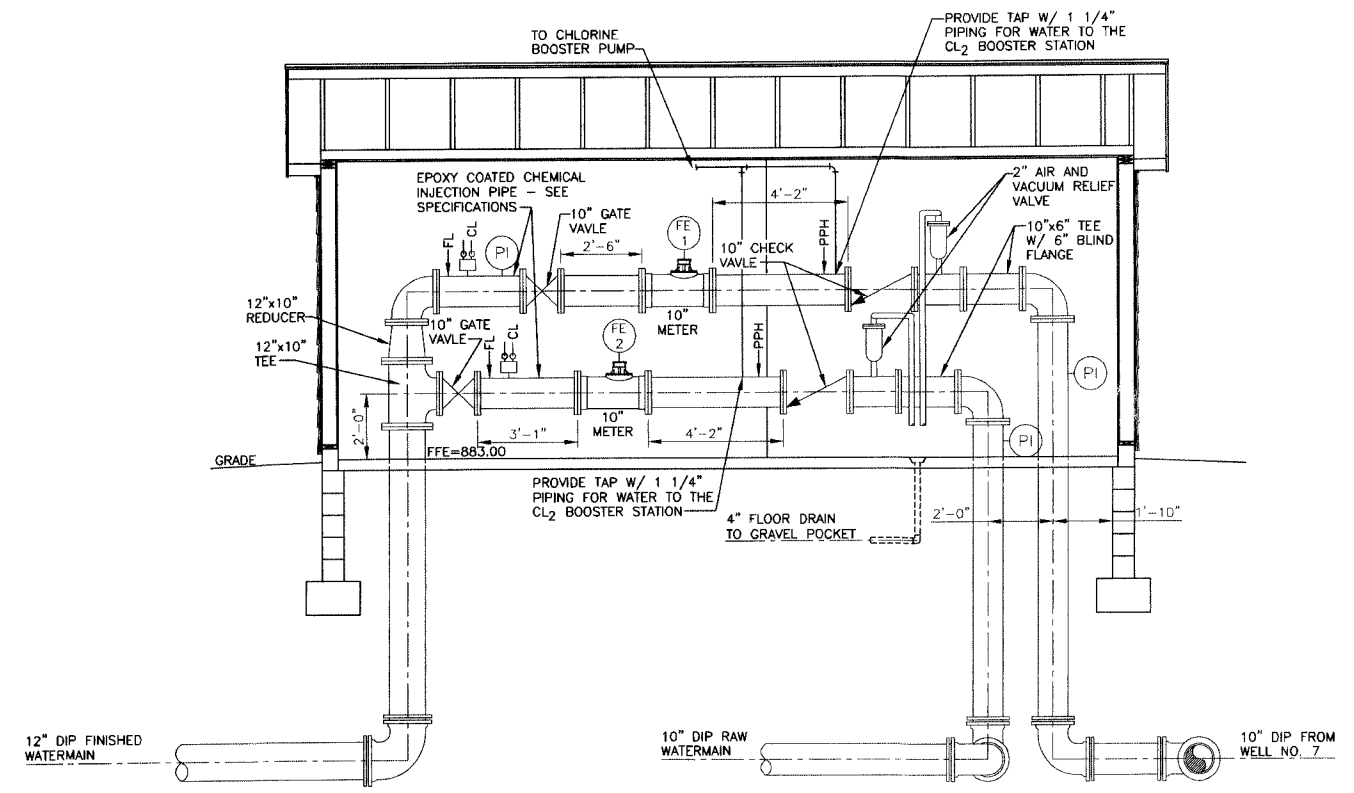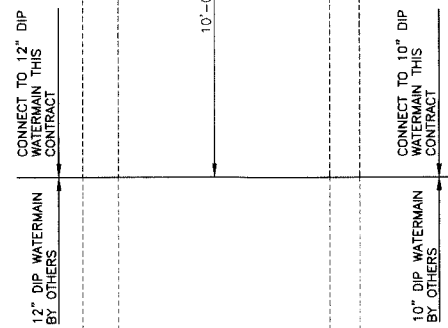

SECTION
1
4.01
SCALE: 3/8" = 1'-0"

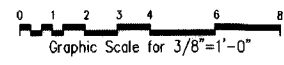

I HEREBY CERTIFY THAT THIS PLAN, SPECIFICATION OR REPORT WAS PREPARED BY ME OR UNDER MY DIRECT SUPERVISION, AND THAT I AM A DULY LICENSED PROFESSIONAL ENGINEER UNDER THE LAWS OF THE STATE OF MINNESOTA

SIGNATURE: *Jan D. Peterson* TYPED OR PRINTED NAME: Jan D. Peterson
DATE: 5-21-07 LIC. NO.: 21309

BOLTON & MENK, INC
CONSULTING ENGINEERS & SURVEYORS
MANKATO, MN FAIRMONT, MN BURNSVILLE, MN SLEEPY EYE, MN
WILLMAR, MN CHASKA, MN RAMSEY, MN AMES, IA


REV.	BY	DATE
A	WRH	11-3-06
O	WRH	5-21-07

RAMSEY, MINNESOTA
WELL HOUSE NO. 4
PLAN AND SECTION

SHEET
4.01

DIFFUSER TYPE 1


NO SCALE

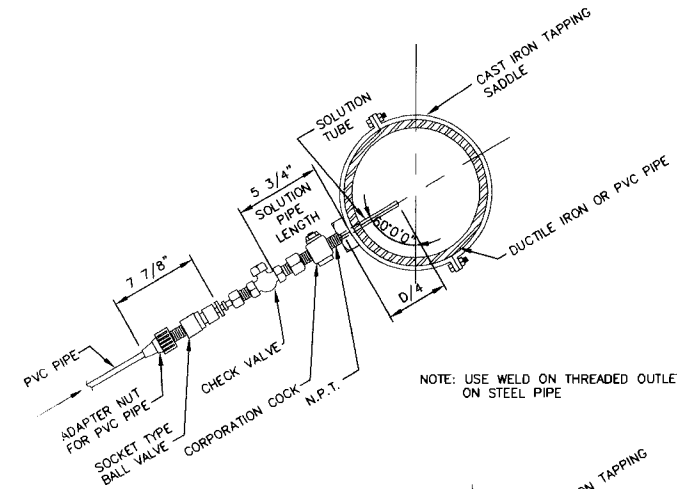

NOTE: USE WELD ON THREADED OUTLET ON STEEL PIPE

DIFFUSER TYPE 2


NO SCALE

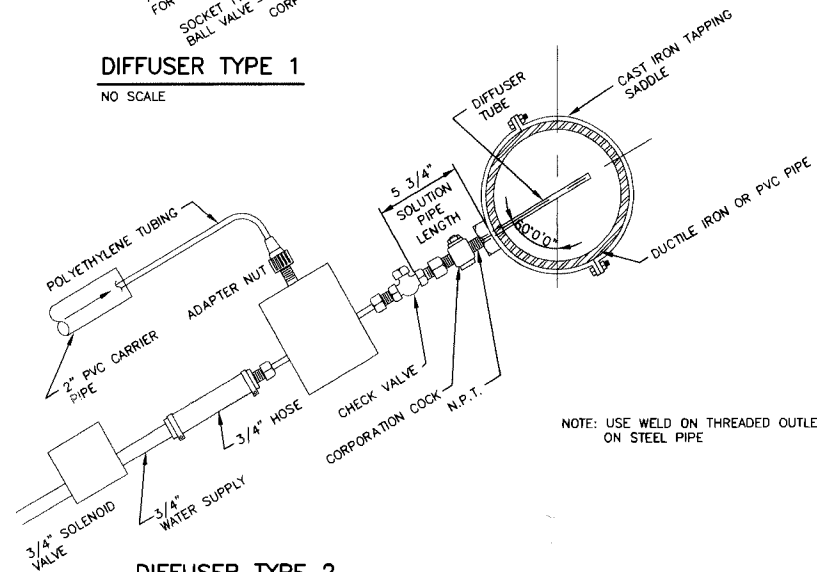

NOTE: USE WELD ON THREADED OUTLET ON STEEL PIPE


CHLORINE CYLINDER STORAGE RACK

SCALE: 3/4" = 1'-0"

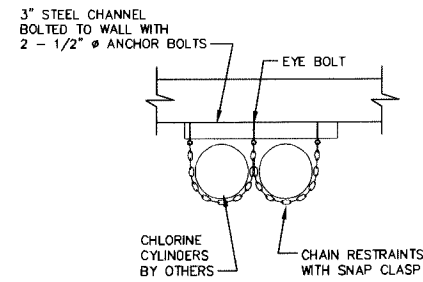


CHLORINE FEED SYSTEM

NO SCALE

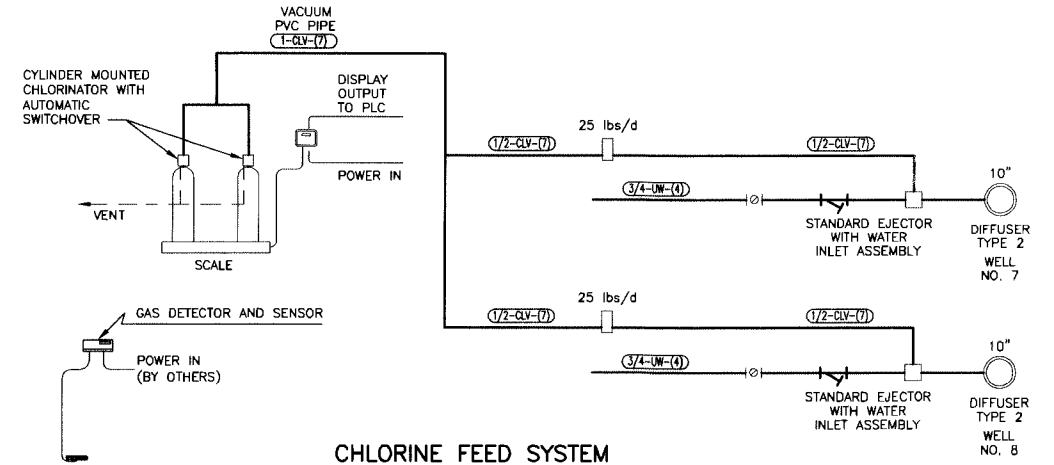


CHLORINE BOOSTER SCHEMATIC

NO SCALE

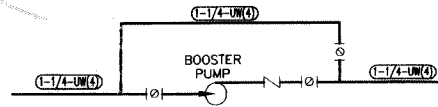

FLUORIDE FEED SYSTEM


NO SCALE

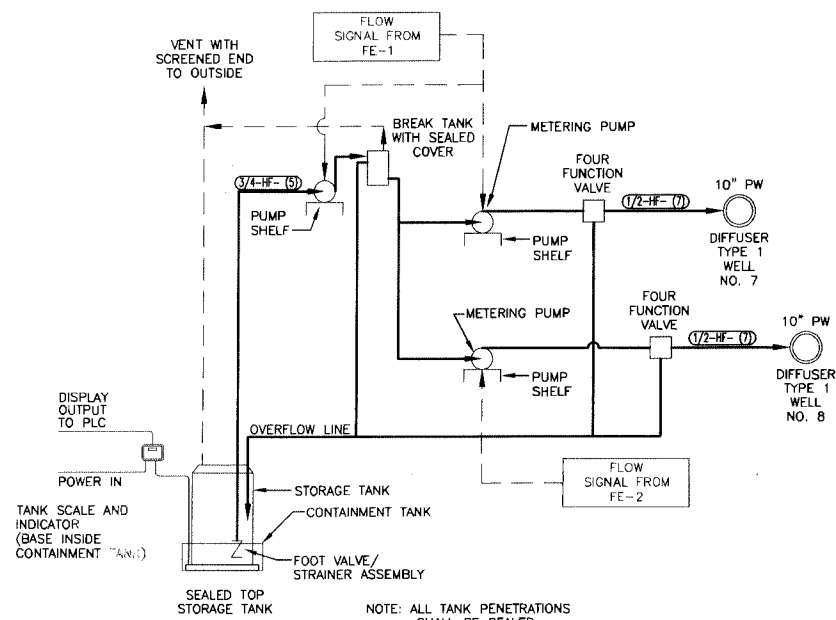

NOTE: ALL TANK PENETRATIONS SHALL BE SEALED

DUAL FEED POLYPHOSPHATE FEED SYSTEM

NO SCALE

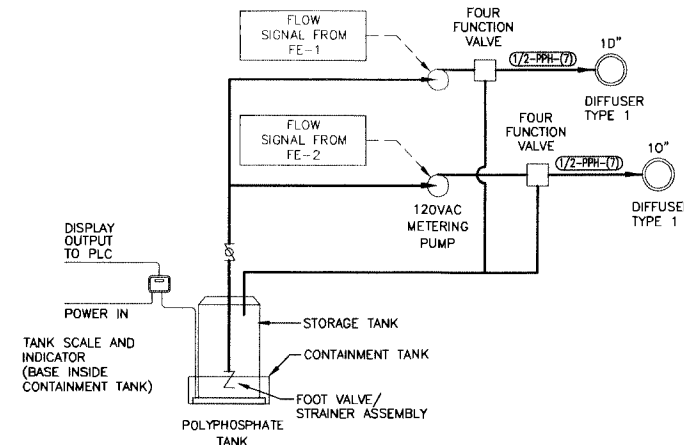

I HEREBY CERTIFY THAT THIS PLAN, SPECIFICATION OR REPORT WAS PREPARED BY ME OR UNDER MY DIRECT SUPERVISION, AND THAT I AM A DULY LICENSED PROFESSIONAL ENGINEER UNDER THE LAWS OF THE STATE OF MINNESOTA

SIGNATURE: *Jon D. Peterson* PRINTED NAME: Jon D. Peterson
 DATE: 5-21-07 LIC. NO.: 21309


BOLTON & MENK, INC
 CONSULTING ENGINEERS & SURVEYORS
 MANKATO, MN FAIRMONT, MN BURNSVILLE, MN SLEEPY EYE, MN
 WILLMAR, MN CHASKA, MN RAMSEY, MN AMES, IA

REV.	BY	DATE
A	WRH	11-3-06
O	WRH	5-21-07


RAMSEY, MINNESOTA
 WELL HOUSE NO. 4
 CHEMICAL DETAILS

SHEET


4.02

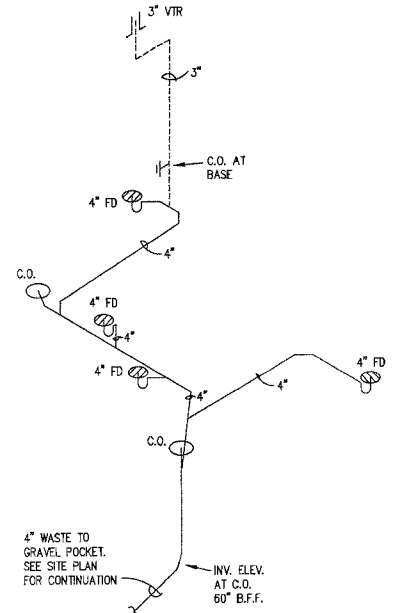


2 WASTE & VENT PIPING DIAGRAM
5.01 NO SCALE

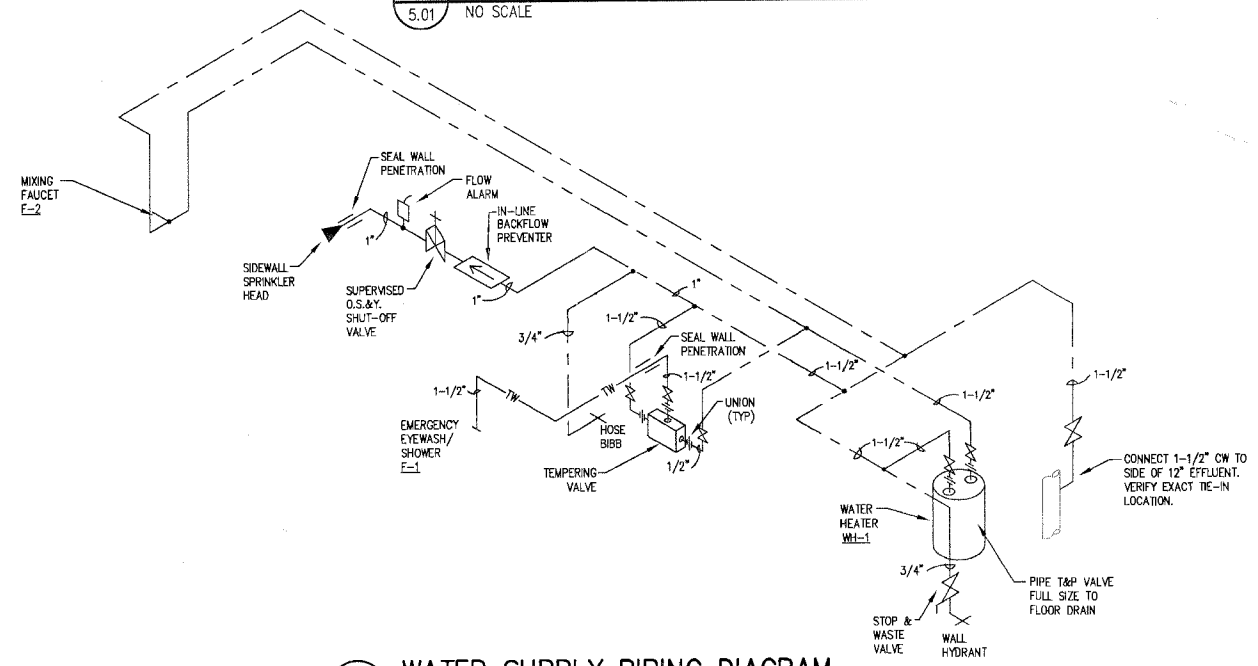

3 WATER SUPPLY PIPING DIAGRAM
5.01 NO SCALE

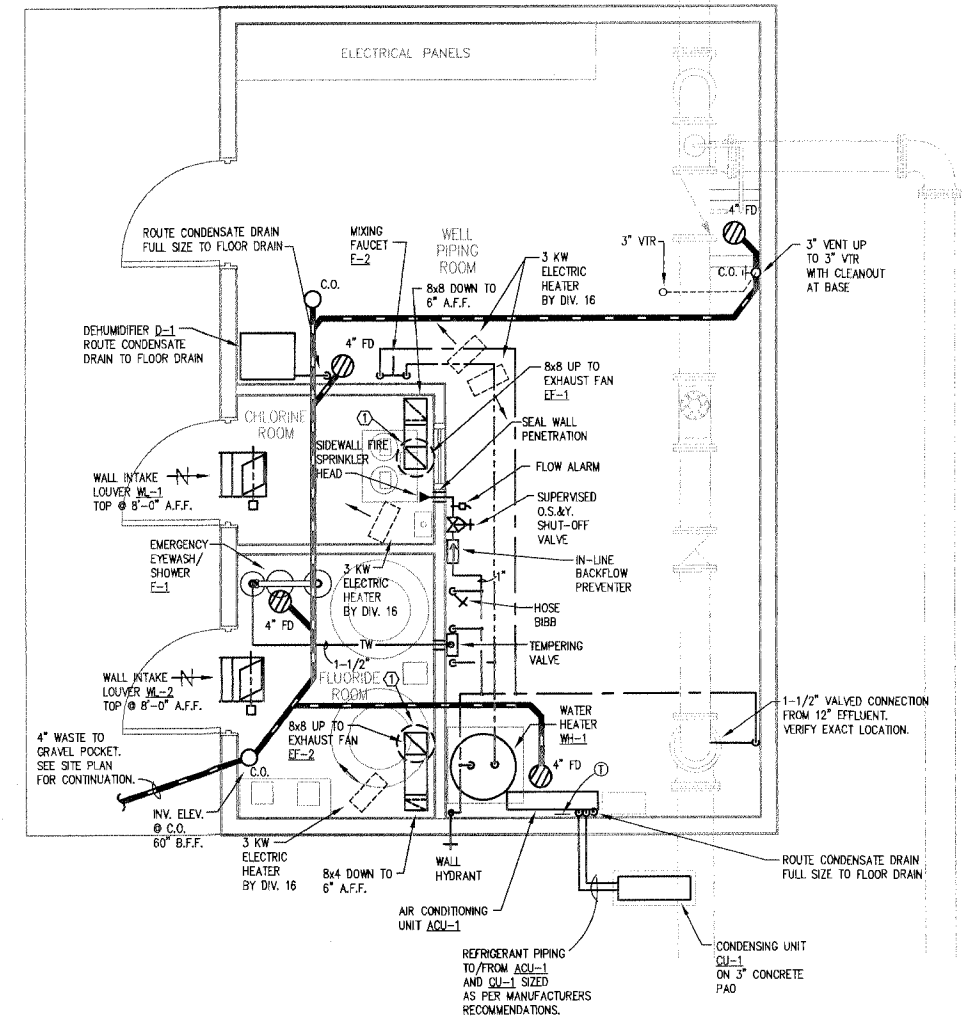

1 MECHANICAL PLAN
5.01 SCALE: 3/8" = 1'-0"

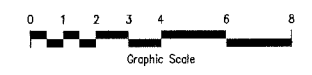

GENERAL NOTES

- 1 - HOLD ALL PIPING AS HIGH AS POSSIBLE UNDER CEILING SYSTEM.
- 2 - HOSE BIBB TO BE MOUNTED AT 36" A.F.F. AND WALL HYDRANT AT 24" ABOVE FINAL GRADE.
- 3 - SEAL ALL PIPE PENETRATIONS INTO CHEMICAL ROOMS.
- 4 - MAINTAIN REQUIRED CLEARANCES IN FRONT OF AND DIRECTLY OVER ELECTRICAL PANELS AND EQUIPMENT.
- 5 - MOUNT WATER HEATER ON 3" HIGH CONCRETE HOUSEKEEPING PAD.

NUMBERED NOTES

- ① 8x8 DUCT THRU CEILING SYSTEM INTO ATTIC SPACE. INSULATE ALL DUCTWORK IN ATTIC SPACE. PROVIDE STAINLESS STEEL FLASHING ESCUTCHEON ON DUCT AT CEILING PENETRATION OF FLUORIDE ROOM. PROVIDE FIRE DAMPER AT CEILING PENETRATION OF CHLORINE ROOM. PROVIDE DUCT ACCESS PANEL ON ROOM SIDE OF FIRE DAMPER.

I HEREBY CERTIFY THAT THIS PLAN, SPECIFICATION OR REPORT WAS PREPARED BY ME OR UNDER MY DIRECT SUPERVISION, AND THAT I AM A DULY LICENSED PROFESSIONAL ENGINEER UNDER THE LAWS OF THE STATE OF MINNESOTA
 SIGNATURE: *Thomas A. Wentz* TYPED OR PRINTED NAME: Thomas A. Wentz
 DATE: 7 MAY 07 LIC. NO.: 18609

BOLTON & MENK, INC
 CONSULTING ENGINEERS & SURVEYORS
 MANKATO, MN FAIRMONT, MN BURNSVILLE, MN SLEEPY EYE, MN
 WELLMAR, MN CHASKA, MN RAMSEY, MN AMES, IA

REV.	BY	DATE
0	TAW	5-7-07

RAMSEY, MINNESOTA
 WELL HOUSE NO. 4
 MECHANICAL PLAN

SHEET
 5.01

EXHAUST FANS

FAN NO.	LOCATION	SERVICE	MODEL NO. *	FAN TYPE	CAPACITY CFM	S.P. *W.G.	ROOF OPENING SQ.	TIP SPEED FPM	EST. FAN RPM	SONES	DRIVE	MOTOR			ELECTRICAL CHARACTERISTICS	ACCESSORIES	REMARKS	INTER-LOCK WITH
												TYPE	H.P.	R.P.M.				
EF-1	ROOF	CHLORINE RM	G-075-D	PRV	300	0.25	10-1/2	3274	1539	4.8	DIRECT	OOP	1/25	1539	115/60/1	PITCHED ROOF CURB, EXTENDED BASE W/ SIDE ACCESS, MOTORIZED DAMPERS, UNIT MTD. SPEED CONTROLLER		WL-1, LIGHTS
EF-2	ROOF	FLUORIDE RM	G-065-D	PRV	100	0.25	10-1/2	2848	1339	2.8	DIRECT	OOP	1/30	1365	115/60/1	PITCHED ROOF CURB, EXTENDED BASE W/ SIDE ACCESS, MOTORIZED DAMPERS, UNIT MTD. SPEED CONTROLLER		WL-2, LIGHTS

* BASED ON: GREENHECK

DEHUMIDIFIERS

UNIT NO.	LOCATION	SERVICE	MODEL NO. *	PROCESS AIR				ELECTRICAL CHARACTERISTICS	REMARKS
				CFM	MOISTURE REMOVAL LB./DAY	INLET AIR F. DB	REL HUM %		
D-1	WELL PIPING ROOM	WELL PIPING ROOM	HI-E DRY 100	255	70	70	50	115/60/1	
D-2	EXTRA UNIT	EXTRA UNIT	HI-E DRY 100	255	70	70	50	115/60/1	PROVIDE TO OWNER

* BASED ON: THERMA-STOR

ELECTRIC WATER HEATERS

WATER HEATER NO.	LOCATION	SERVICE	MODEL NO. *	STORAGE CAPACITY GALLONS	ELECTRIC			CAPACITY GPH	TEMP. RISE F.	WORKING PRESSURE P.S.I.	ELECTRICAL CHARACTERISTICS	REMARKS
					UPPER ELEM. KW	LOWER ELEM. KW	ELEMENT OPERATION					
WH-1	WELL PIPING RM	DOMESTIC HW	DEN-80	80	5	5	NON-SIMULT	26	80	150	480/60/1	CONCRETE PAD, T&P VALVE

* BASED ON: A.O. SMITH

WALL LOUVERS

LOUVER NO.	LOCATION	TYPE	SERVING	WIDTH INCHES	HEIGHT INCHES	DEPTH INCHES	FRAME TYPE	BLADE TYPE	SQ. FT. FREE AREA	REMARKS
WL-1	W. WALL	INTAKE	CHLORINE ROOM	16	12	4	FLANGE	DRAINABLE	0.46	MOTORIZED DAMPERS
WL-2	W. WALL	INTAKE	FLUORIDE RM	16	12	4	FLANGE	DRAINABLE	0.46	MOTORIZED DAMPERS

* BASED ON: RUSKIN ELF375DX

AIR-COOLED CONDENSING UNITS


UNIT NO.	LOCATION	MODEL NO. *	CAPACITY TOTAL MBH	TONS	AMB. TEMP. F.	SUCT. TEMP. F.	MINIMUM CIRCUIT AMPACITY	ELECTRICAL CHARACTERISTICS	REMARKS
CU-1	S. GRADE	38BNC009	9.0	0.75	95	40	9.0	115/60/1	CONCRETE PAD, MATCH TO ACU-1

* BASED ON: CARRIER


DUCTLESS SPLIT AIR CONDITIONER

UNIT NO.	MODEL NO. *	TOTAL CAPACITY MBH	AIR VOLUME CFM	FAN SPEEDS	ELECTRICAL	AIR FILTER	CONTROLS	REMARKS
ACU-1	40BNC009	9.0	350	3	30VDC	CLEANABLE	REMOTE WALL MTD T-STAT	MATCH TO CU-1


* BASED ON: CARRIER

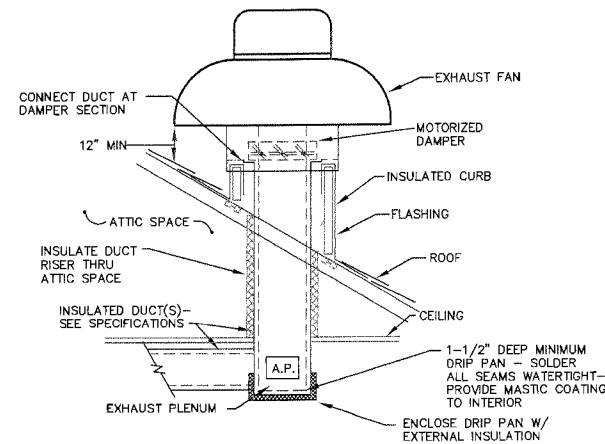


1 ROOF MOUNTED EXHAUST FAN
5.02 NO SCALE

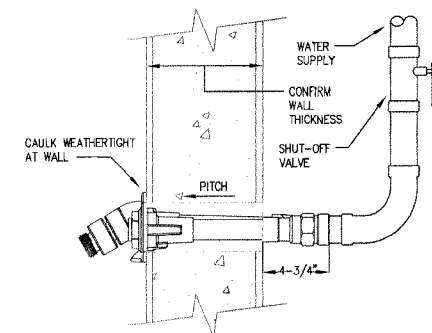

2 WALL HYDRANT DETAIL
5.02 NO SCALE

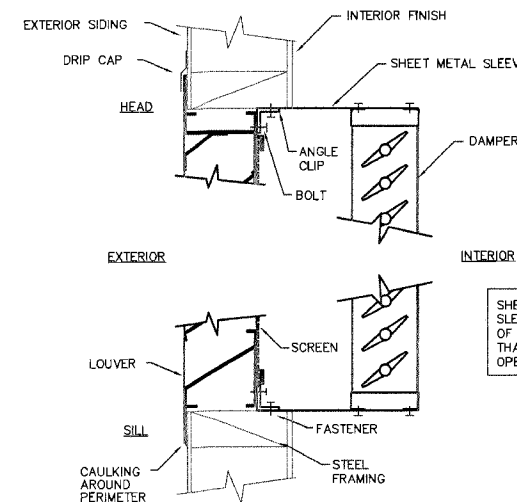

3 LOUVER INSTALLATION
5.02 NO SCALE

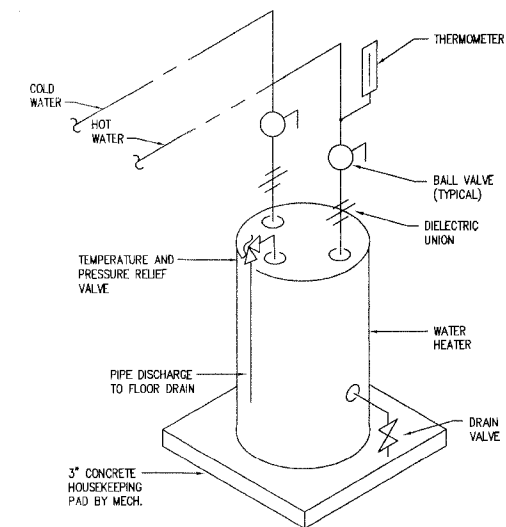

4 TYPICAL WATER HEATER PIPING
5.02 NO SCALE

RAMSEY WELL HOUSE
MECHANICAL EQUIPMENT
SEQUENCE OF OPERATIONS

A. Chlorine Room Ventilation System:

Exhaust fan EF-1 and 120 volt N.C. motorized damper of wall lower WL-1:

Exhaust fan shall operate and normally closed motorized damper shall open when lights are switched on or door switch on room doors are opened as indicated on the electrical plans.

Damper actuators shall be furnished and installed by Division 15.

All interlocks, control wiring to be furnished and installed by the Division 16. All power wiring to be by Division 16.

B. Fluoride Room Ventilation System:

Exhaust fan EF-2 and 120 volt N.C. motorized damper of wall lower WL-2:

Exhaust fan shall operate and normally closed motorized damper shall open when lights are switched on.

Damper actuators shall be furnished and installed by Division 15.


All interlocks, control wiring to be furnished and installed by the Division 16. All power wiring to be by Division 16.

I HEREBY CERTIFY THAT THIS PLAN, SPECIFICATION OR REPORT WAS PREPARED BY ME OR UNDER MY DIRECT SUPERVISION, AND THAT I AM A DULY LICENSED PROFESSIONAL ENGINEER UNDER THE LAWS OF THE STATE OF MINNESOTA
 SIGNATURE: *Thomas A. Wentz* TYPED OR PRINTED NAME: Thomas A. Wentz
 DATE: 7 MAY 07 LIC. NO.: 18609


BOLTON & MENK, INC
 CONSULTING ENGINEERS & SURVEYORS
 MANKATO, MN FAIRMONT, MN BURNSVILLE, MN SLEEPY EYE, MN
 WILLMAR, MN CHASKA, MN RAMSEY, MN AMES, IA

REV.	BY	DATE
0	TAW	5-7-07

RAMSEY, MINNESOTA
 WELL HOUSE NO. 4
 MECHANICAL DETAILS AND EQUIPMENT SCHEDULES

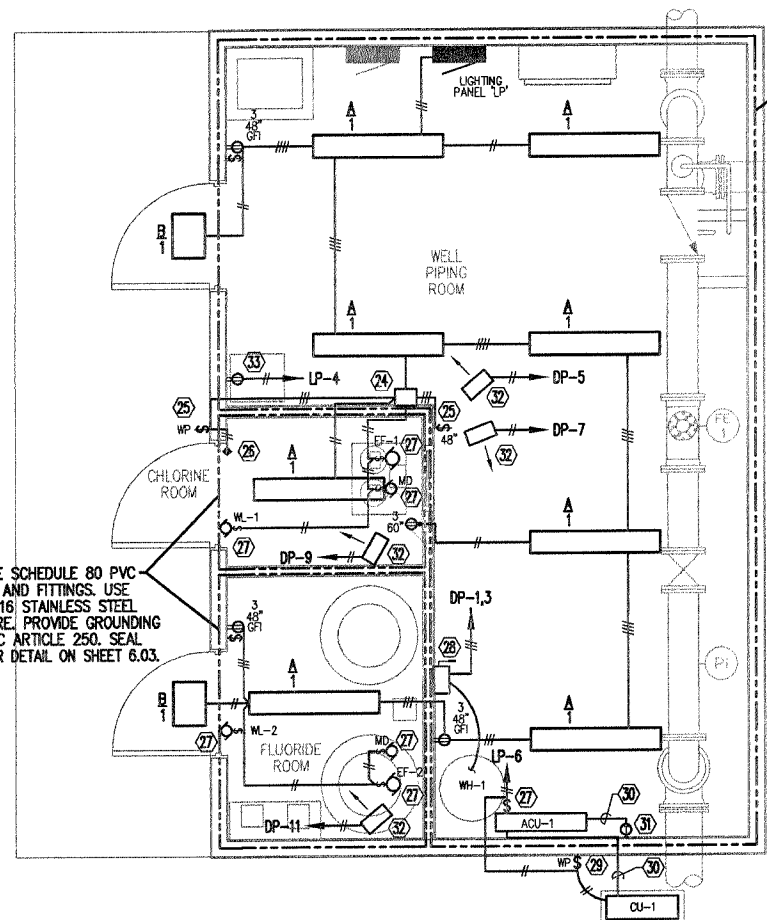


North
LIGHTING & GENERAL POWER PLAN

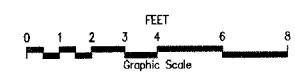


SCHEDULE 80 PVC CONDUIT, PVC BOXES AND FITTINGS MAY BE USED IN THIS AREA. USE ALL PVC AND TYPE 316 STAINLESS STEEL SUPPORTING HARDWARE.

CHEMICAL AREAS. USE SCHEDULE 80 PVC CONDUIT, PVC BOXES AND FITTINGS. USE ALL PVC AND TYPE 316 STAINLESS STEEL SUPPORTING HARDWARE. PROVIDE GROUNDING CONDUCTORS PER NEC ARTICLE 250. SEAL CONDUITS AT WALL PER DETAIL ON SHEET 6.03.

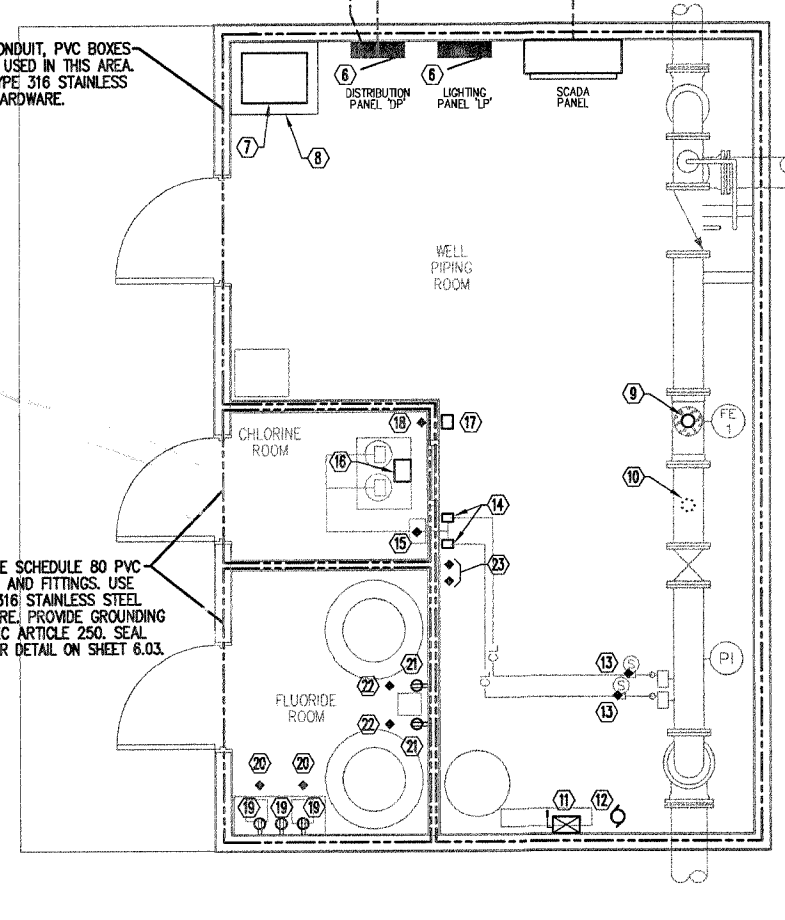

North
PROCESS ELECTRICAL PLAN

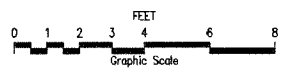

CHEMICAL AREAS. USE SCHEDULE 80 PVC CONDUIT, PVC BOXES AND FITTINGS. USE ALL PVC AND TYPE 316 STAINLESS STEEL SUPPORTING HARDWARE. PROVIDE GROUNDING CONDUCTORS PER NEC ARTICLE 250. SEAL CONDUITS AT WALL PER DETAIL ON SHEET 6.03.

TO EXISTING WELL 7 CONTROL PANEL APPROX. 100 FEET NORTHEAST OF WELLHOUSE.

GENERAL NOTES

1. FIELD CONFIRM ALL CONDUIT ROUTING.
2. DO NOT ROUTE CONDUITS EXPOSED ON BUILDING EXTERIOR.
3. DO NOT ROUTE CONDUITS ACROSS WALKWAYS.
4. NOT ALL CIRCUITRY IS SHOWN ON PLAN. SEE ONE-LINES AND SCHEMATICS FOR ADDITIONAL CIRCUITRY REQUIREMENTS.

NUMBERED NOTES

- ① 4-1/C-#3 & 1-1/C-#3 GROUND-2" SCHEDULE 80 PVC. AT EXISTING WELL 7 CONTROL PANEL, ROUTE CONDUCTORS THRU EXISTING 2" CONDUIT STUBBED UNDER CONCRETE PAD. COORDINATE WITH SEPARATE CONTRACTOR.
- ② 2" SCHEDULE 80 PVC WITH FIBER OPTIC CABLE OR SIGNAL CABLE AS FURNISHED BY SCADA EQUIPMENT SUPPLIER. AT EXISTING WELL 7 CONTROL PANEL, ROUTE CABLE THRU EXISTING 2" CONDUIT STUBBED UNDER CONCRETE PAD. COORDINATE W/ SEPARATE CONTRACTOR.
- ③ 3/4" X 10' COPPER-CLAD GROUND ROD WITH EXOTHERMIC WELD(S) TO CONDUCTOR(S) SHOWN. SET TOP 12" DEEP.
- ④ #1/0 BARE STRANDED COPPER GROUND CONDUCTOR, 12" DEEP.
- ⑤ STUB 1.5" SCHEDULE 80 PVC CONDUIT.
- ⑥ PANELBOARD. SEE ONE-LINE DIAGRAM AND SCHEDULES ON SHEET 6.03.
- ⑦ 'LP' TRANSFORMER. SEE ONE-LINE DIAGRAM ON SHEET 6.03.
- ⑧ CONSTRUCT 2" HIGH CONCRETE PAD WITH 3/4" CHAMFERED EDGE.
- ⑨ WELL NO. 7 FLOWMETER FE1.
- ⑩ WELL NO. 8 FLOWMETER FE2.
- ⑪ CHLORINE BOOSTER PUMP STARTER. SEE SCHEMATIC ON SHEET 6.03.
- ⑫ CHLORINE BOOSTER PUMP.
- ⑬ WELLS NO. 7 AND NO. 8 CHLORINE SOLENOID VALVES.
- ⑭ WELLS NO. 7 AND NO. 8 CHLORINE RATE CONTROL VALVES.
- ⑮ CHLORINE SWITCHOVER UNIT.
- ⑯ CHLORINE SCALE.
- ⑰ CHLORINE LEAK DETECTOR.
- ⑱ CHLORINE SENSOR. CONFIRM HEIGHT AND LOCATION W/ SUPPLIER.
- ⑲ RECEPTACLES FOR FLUORIDE BREAK TANK PUMP, WELL NO. 7 FEED PUMP AND WELL NO. 8 FEED PUMP. CONFIRM MOUNTING HEIGHTS & LOCATIONS WITH SUPPLIER. LABEL EACH RECEPTACLE WITH PUMP NAME. LABEL BOSSES "CONTROLLED" AND "HOT" PER SCHEMATICS.
- ⑳ WELLS NO. 7 AND NO. 8 FLUORIDE PUMP CONTROLLERS.
- ㉑ RECEPTACLES FOR WELLS NO. 7 AND NO. 8 POLYPHOSPHATE FEED PUMPS. CONFIRM MOUNTING HEIGHTS AND LOCATIONS WITH SUPPLIER. LABEL EACH RECEPTACLE WITH PUMP NAME. LABEL BOSSES "CONTROLLED" AND "HOT" PER SCHEMATICS.
- ㉒ WELLS NO. 7 AND NO. 8 POLYPHOSPHATE PUMP CONTROLLERS.
- ㉓ SPRINKLER TAMPER AND FLOW SWITCHES.
- ㉔ CHLORINE ROOM LIGHTS/VENTILATION RELAY ENCLOSURE. SEE SCHEMATIC ON SHEET 6.02.
- ㉕ MOMENTARY CONTACT SWITCH. SEE SCHEMATIC ON SHEET 6.02.
- ㉖ DOOR LIMIT SWITCH. SEE SCHEMATIC ON SHEET 6.02.
- ㉗ 120VAC, SINGLE-PHASE MECHANICAL EQUIPMENT (DIV. 15) AS INDICATED BY TAG. FURNISH AND INSTALL SINGLE-POLE DISCONNECT SWITCH.
- ㉘ 5.0KW, 480VAC, SINGLE-PHASE WATER HEATER (DIV. 15). FURNISH AND INSTALL 30A, 2P, 480V, NEMA 12, NON-FUSED, HEAVY-DUTY DISCONNECT SWITCH.
- ㉙ 120VAC, SINGLE-PHASE MECHANICAL EQUIPMENT (DIV. 15) AS INDICATED BY TAG. FURNISH AND INSTALL WEATHERPROOF, PADLOCKABLE, SINGLE-POLE DISCONNECT SWITCH.
- ㉚ 3/4" CONDUIT BETWEEN MECHANICAL UNITS. FURNISH AND INSTALL SIGNAL AND CONTROL CABLES PER MANUFACTURER REQUIREMENTS.
- ㉛ THERMOSTAT (DIV. 15). MOUNT AT 54".
- ㉜ 3.0KW, 277VAC, SINGLE-PHASE UNIT HEATER. BERKO "HUHAA" SERIES, OR EQUAL, WITH INTEGRAL THERMOSTAT, INTEGRAL DISCONNECT SWITCH AND MFR'S WALL-MOUNT BRACKET. MOUNT BOTTOM AT 7'0".
- ㉝ DEDICATED OUTLET FOR DEHUMIDIFIER D-1. COORDINATE MOUNTING HEIGHT W/ SUPPLIER.


I HEREBY CERTIFY THAT THIS PLAN, SPECIFICATION OR REPORT WAS PREPARED BY ME OR UNDER MY DIRECT SUPERVISION, AND THAT I AM A DULY LICENSED PROFESSIONAL ENGINEER UNDER THE LAWS OF THE STATE OF MINNESOTA

Signature: *Sheldon J. Sorenson*
 PRINTED NAME: Sheldon J. Sorenson
 DATE: 07 MAY 07 U.C. NO.: 18925

BOLTON & MENK, INC.
 CONSULTING ENGINEERS & SURVEYORS
 MANKATO, MN FAIRMONT, MN BURNSVILLE, MN SLEEPY EYE, MN
 WILLMAR, MN CHASKA, MN RAMSEY, MN AMES, IA

REV.	BY	DATE
A	SJS	11-03-06
0	SJS	05-07-07

RAMSEY, MINNESOTA	SHEET
WELL HOUSE NO. 4	
ELECTRICAL PLANS	6.01

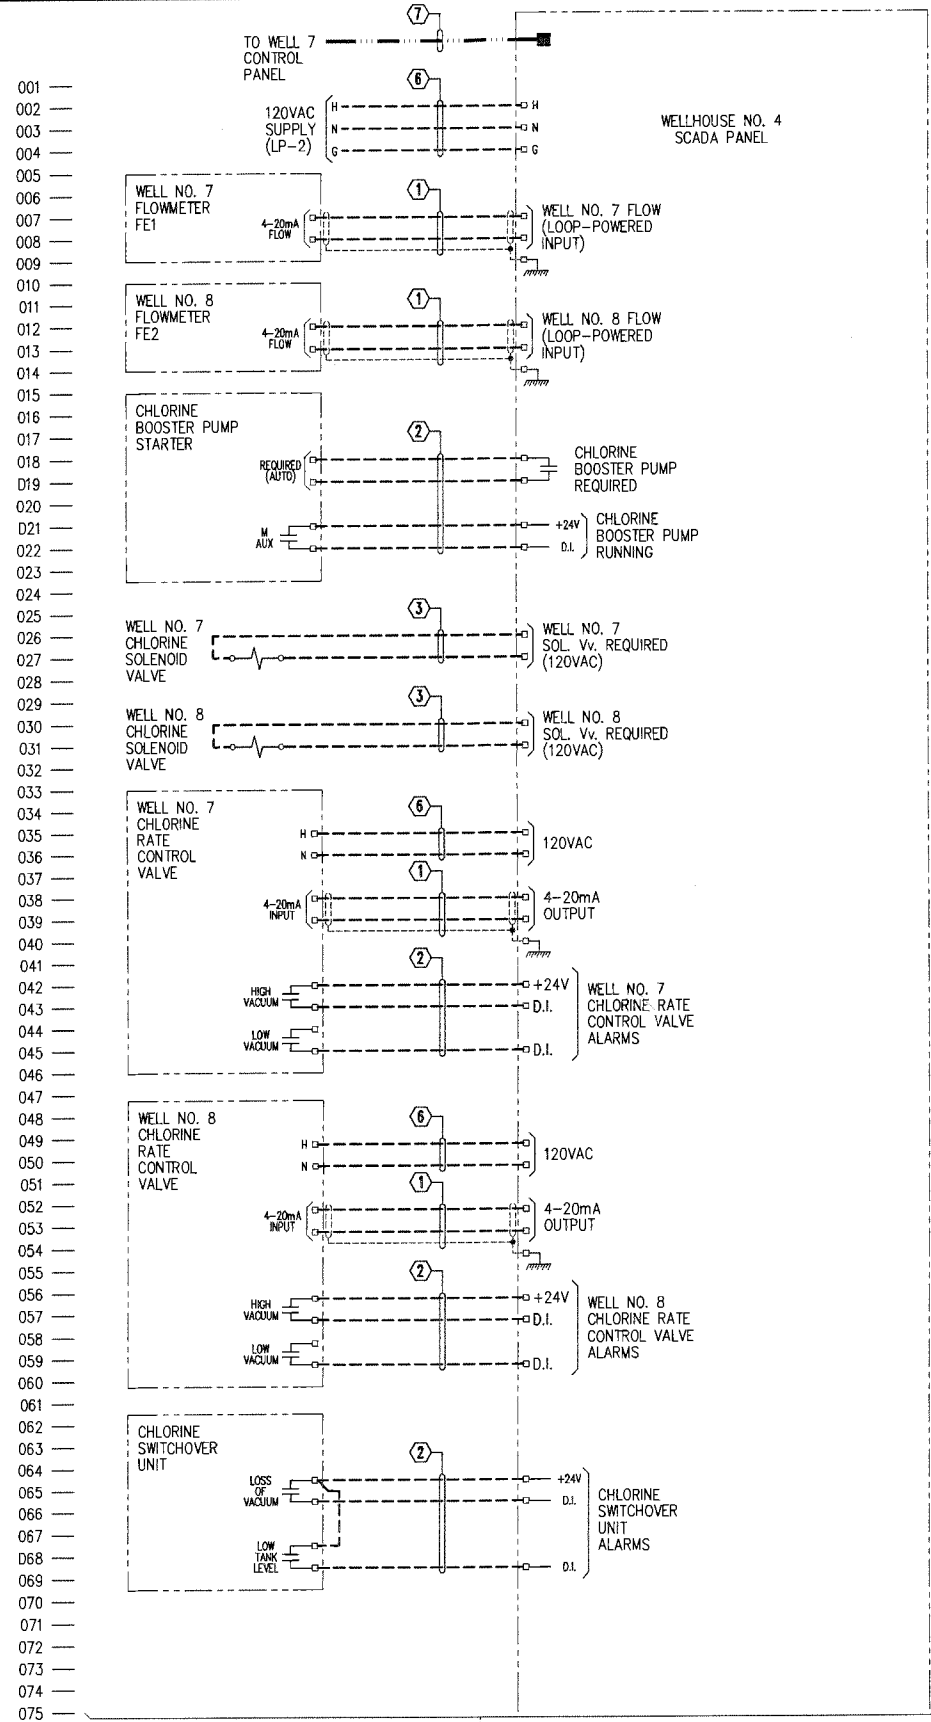


CONTROL PANEL GENERAL NOTES

1. CONFIRM WIRING REQUIREMENTS WITH EQUIPMENT MANUFACTURERS.
2. CONTRACTOR MAY COMBINE CIRCUITS OF LIKE KIND IN COMMON CONDUITS IN ACCORDANCE WITH N.E.C. REQUIREMENTS. MAINTAIN 30% MAXIMUM CONDUIT FILL.
3. GROUND CONDUCTORS ARE NOT SHOWN. FURNISH & INSTALL GROUND CONDUCTORS PER N.E.C. REQUIREMENTS.


A
6.02

CONTROL SCHEMATIC

NO SCALE

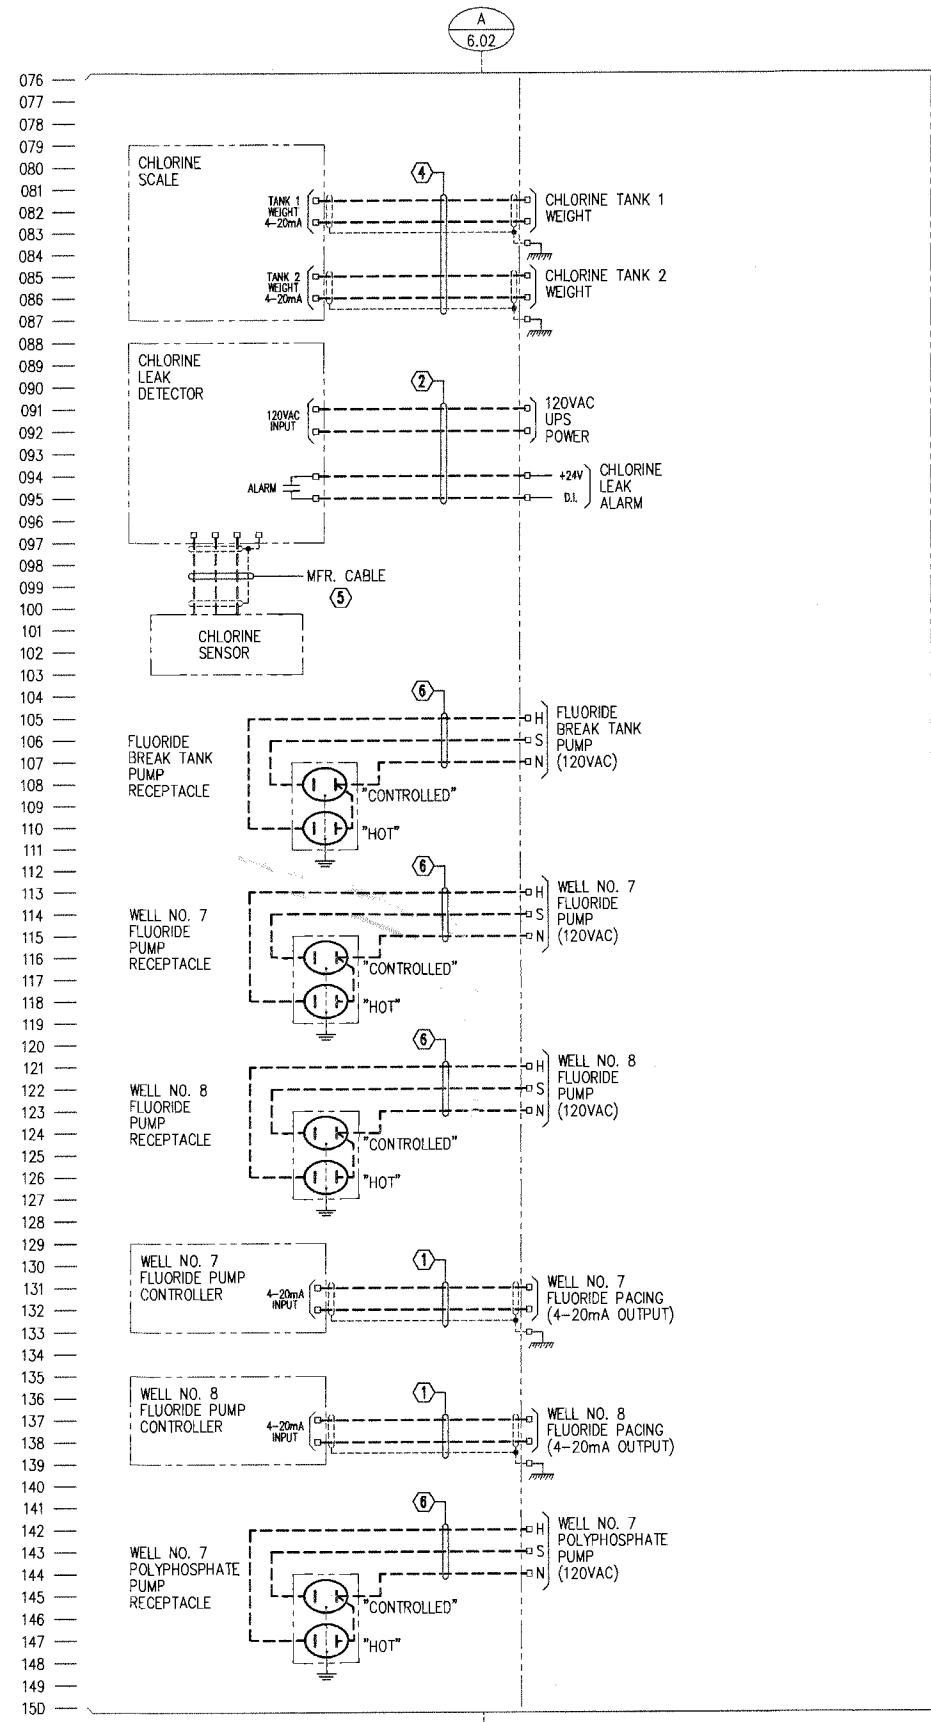

B
6.02

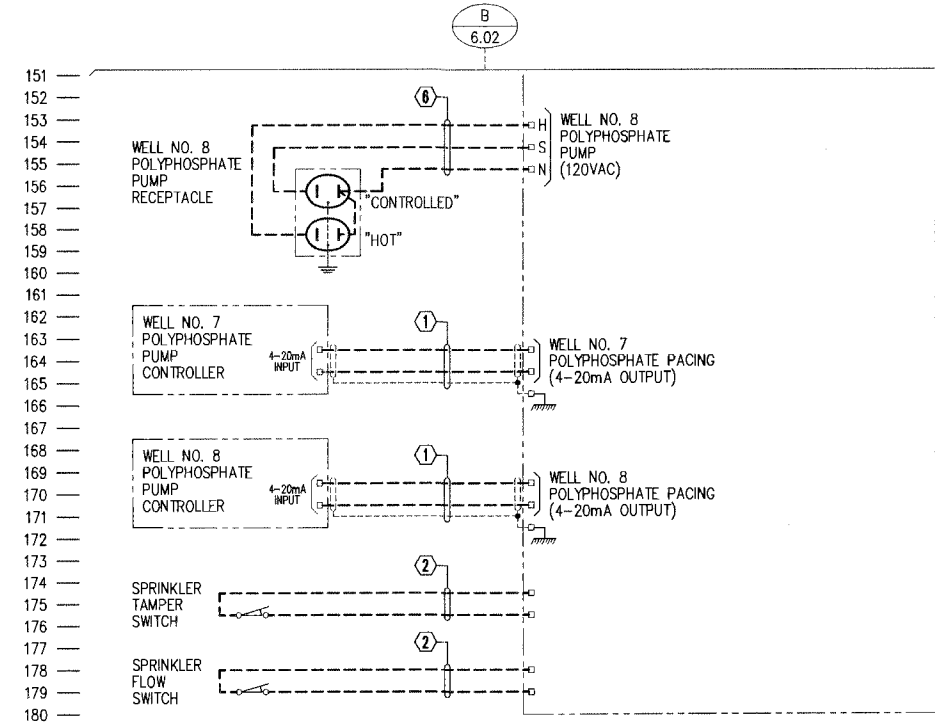

ENTRANCE DOOR LIMIT SWITCH, LIMIT SWITCH CLOSING WHEN DOOR IS OPENED. SQUARE 'D' CLASS 9007, TYPE C WITH LEVER ARM, OR EQUAL, FABRICATE TYPE 316 STAINLESS STEEL MOUNTING BRACKET AS REQUIRED.

MOMENTARY CONTACT SWITCH W/ SPRING RETURN TO CENTER OFF POSITION, W/ LOCKABLE COVER LOCATED AT OUTSIDE ENTRANCE DOOR.

MOMENTARY CONTACT SWITCH W/ SPRING RETURN TO CENTER OFF POSITION, W/ LOCKABLE COVER LOCATED AT INTERIOR VIEWING WINDOW.

ALL WIRING SHALL BE #12 AWG IN 3/4" CONDUIT. GROUND CONDUCTORS ARE NOT SHOWN.

CHLORINE ROOM LIGHTS/EXHAUST SCHEMATIC

NO SCALE

NUMBERED NOTES

- ① 1-2/C-#16 SHIELDED-3/4".
- ② 4-1/C-#14-3/4" (MAY INCLUDE SPARES).
- ③ 2-1/C-#12-3/4".
- ④ 2-2/C-#16 SHIELDED-1".
- ⑤ PROVIDE 3/4" CONDUIT.
- ⑥ 3-1/C-#12-3/4".
- ⑦ 2" SCHEDULE 80 PVC CONDUIT W/ FIBER OPTIC CABLE OR SIGNAL CABLE AS FURNISHED BY SCADA EQUIPMENT SUPPLIER.

LEGEND

SYMBOL	DESCRIPTION
—	PANEL WIRING
- - -	FIELD WIRING
---	CONDUCTOR SHIELD
---	EXISTING CIRCUITRY

I HEREBY CERTIFY THAT THIS PLAN, SPECIFICATION OR REPORT WAS PREPARED BY ME OR UNDER MY DIRECT SUPERVISION, AND THAT I AM A DULY LICENSED PROFESSIONAL ENGINEER UNDER THE LAWS OF THE STATE OF MINNESOTA.


DATE: 07 MAY 07 LIC. NO. 18925

BOLTON & MENK, INC
CONSULTING ENGINEERS & SURVEYORS
MANKATO, MN FAIRMONT, MN BURNSVILLE, MN SLEEPY EYE, MN
WILLMAR, MN CHASKA, MN RAMSEY, MN AMES, IA


REV.	BY	DATE
A	SJS	11-03-06
0	SJS	05-07-07

RAMSEY, MINNESOTA
WELL HOUSE NO. 4
CONTROL SCHEMATIC

SHEET
6.02

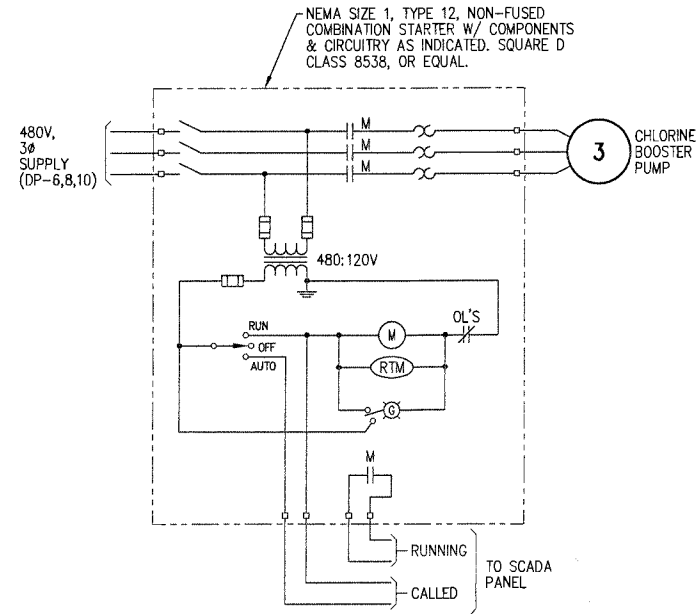


CHLORINE BOOSTER PUMP SCHEMATIC
NO SCALE

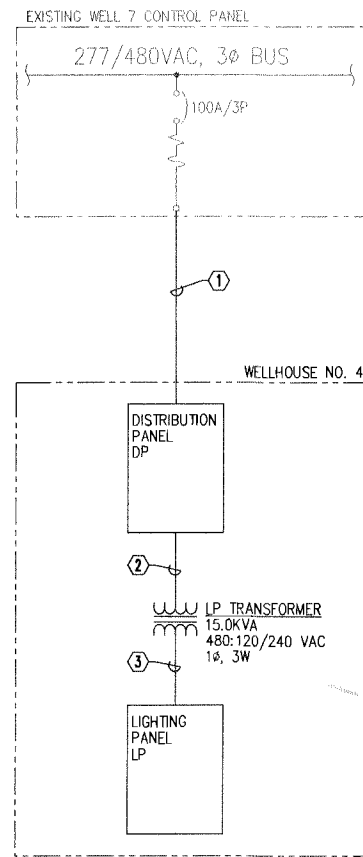

ONE-LINE DIAGRAM
NO SCALE

NUMBERED NOTES

- ① 4-1/C-#3 & 1-1/C-#3 GROUND-2" SCHEDULE 80 PVC.
- ② 2-1/C-#5 & 1-1/C-#6 GROUND-1" SCHEDULE 80 PVC.
- ③ 3-1/C-#3 & 1-1/C-#6 GROUND-2" SCHEDULE 80 PVC.

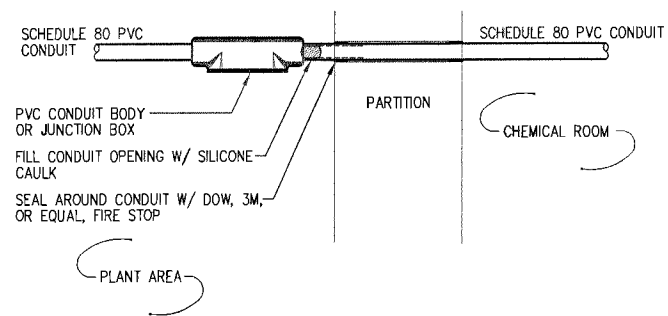

CHEMICAL ROOM CONDUIT PENETRATION DETAIL
NO SCALE TYPICAL

DISTRIBUTION PANEL DP									
MOUNTING	LOCATION	BUS				REMARKS			
SURFACE	WELLHOUSE NO. 4	AMPS	VOLTS	PHASE	WIRE	1. 100A/3P MAIN CIRCUIT BREAKER 2. ISOLATED GROUND BUS			
		100	277/480	3	4				
CIRCUIT DESCRIPTION		BKR	CKT	ANTICIPATED LOAD IN VA	PHASE	ANTICIPATED LOAD IN VA	CKT	BKR	CIRCUIT DESCRIPTION
WATER HEATER WH-1		15A	1	2500	A	2500	2	40A	LIGHTING PANEL LP TRANSFORMER
" " "		2P	3	2500	B	2500	4	2P	" " "
PIPING ROOM N. UNIT HEATER		20A1P	5	3000	C	1200	6	15A	CHLORINE BOOSTER PUMP
PIPING ROOM S. UNIT HEATER		20A1P	7	3000	A	1200	8	"	" " "
CHLORINE ROOM UNIT HEATER		20A1P	9	3000	B	1200	10	3P	" " "
FLUORIDE ROOM UNIT HEATER		20A1P	11	3000	C	1200	12	"	" " "
SPACE		"	13	"	A	"	14	"	SPACE
SPACE		"	15	"	B	"	16	"	SPACE
SPACE		"	17	"	C	"	18	"	SPACE
SPACE		"	19	"	A	"	20	"	SPACE
SPACE		"	21	"	B	"	22	"	SPACE
SPACE		"	23	"	C	"	24	"	SPACE

LIGHTING PANEL LP									
MOUNTING	LOCATION	BUS				REMARKS			
SURFACE	WELLHOUSE NO. 4	AMPS	VOLTS	PHASE	WIRE	1. 100A/2P MAIN CIRCUIT BREAKER 2. ISOLATED GROUND BUS			
		100	120/240	1	3				
CIRCUIT DESCRIPTION		BKR	CKT	ANTICIPATED LOAD IN VA	PHASE	ANTICIPATED LOAD IN VA	CKT	BKR	CIRCUIT DESCRIPTION
LIGHTS		20A1P	1	775	A	600	2	20A1P	SCADA PANEL
OUTLETS		20A1P	3	800	B	1200	4	20A1P	DEHUMIDIFIER OUTLET
SPARE		20A1P	5	"	C	1200	6	20A1P	PIPING ROOM AIR CONDITIONER, CU-1
SPARE		20A1P	7	"	A	"	8	"	SPACE
SPARE		20A1P	9	"	B	"	10	"	SPACE
SPARE		20A1P	11	"	C	"	12	"	SPACE
SPARE		20A1P	13	"	A	"	14	"	SPACE
SPARE		20A1P	15	"	B	"	16	"	SPACE
SPARE		20A1P	17	"	C	"	18	"	SPACE
SPARE		20A1P	19	"	A	"	20	"	SPACE
SPARE		20A1P	21	"	B	"	22	"	SPACE
SPARE		20A1P	23	"	C	"	24	"	SPACE
SPACE		"	25	"	A	"	26	"	SPACE
SPACE		"	27	"	B	"	28	"	SPACE
SPACE		"	29	"	C	"	30	"	SPACE

LIGHT FIXTURE SCHEDULE						
TYPE	DESCRIPTION	MANUFACTURER	CATALOG NUMBER	LAMPS	VOLTS	REMARKS
A	VAPOR-TIGHT FLUORESCENT	COLUMBIA	FNPS4-232-PP-EBRIH-2HS-SSTP-PTBS	2-32W-T8-3500K	120	1,2
B	HPS EXTERIOR WALL PACK	HUBBELL	LMC-70S-8-2-PC(120)-LP	1-70W-HPS-CLEAR	120	3

- 1. SOLID STATE, RAPID START, ELECTRONIC BALLAST(S) RATED FOR MAXIMUM 10% THD.
- 2. MOUNT FIXTURE TO CEILING.
- 3. WALL MOUNT 10'-0" ABOVE FINISHED GRADE.

I HEREBY CERTIFY THAT THIS PLAN, SPECIFICATION OR REPORT WAS PREPARED BY ME OR UNDER MY DIRECT SUPERVISION, AND THAT I AM A DULY LICENSED PROFESSIONAL ENGINEER UNDER THE LAWS OF THE STATE OF MINNESOTA

DATE: 07 MAY 07 LIC. NO.: 18925

BOLTON & MENK, INC
CONSULTING ENGINEERS & SURVEYORS
MANKATO, MN FAIRMONT, MN BURNSVILLE, MN SLEEPY EYE, MN
WILLMAR, MN CHASKA, MN RAMSEY, MN AMES, IA

REV.	BY	DATE
A	SJS	11-03-06
0	SJS	05-07-07

RAMSEY, MINNESOTA
WELL HOUSE NO. 4
ONE-LINE DIAGRAM,
SCHEDULES AND DETAILS

SHEET
6.03

Approval Data/Drawings

Pump House No. 3

Ramsey, MN

Engineer Bolton & Menk, Inc.
1960 Premiere Drive
Mankato, MN 56001
(507) 625-4171

General Contractor Magney Construction, Inc.
19425 Highway 7
P.O. Box 249
Excelsior, MN 55331
(952) 474-1674

Electrical Contractor Marko Electric
7843 18th St. N.
Oakdale, MN 55128
(952) 887-4538

Owner Ramsey, City of
1513 Nowthen Blvd. N.W.
Ramsey, MN 55303

Electrical Engineer: Dolejs Associates, Inc.
1624 Riverfront Drive
Mankato, MN 56001
(507) 625-7869

Supplier Automatic Systems Company
2400 West County Road D
Roseville, MN 55113
(651) 631-9005

SHOP DRAWING TRANSMITTAL
 APPROVED APPROVED REVISE AND RE-SUBMIT
 AS NOTED
 This document has been reviewed by Magney Construction, Inc. Any action shown is subject to the requirements of the plans and specifications. Subcontractor/ supplier is responsible for all dimensions.
 BY: *[Signature]* DATE: 12/10/01 TRANS. # _____

BOLTON & MENK, INC. CONSULTING ENGINEERS	
A NO EXCEPTIONS TAKEN	C AMEND-RESUBMIT
B MAKE CORRECTIONS NOTED	D REJECTED-RESUBMIT
REVIEWER: <i>DP</i>	DATE: 12-12-01
CORRECTIONS OR COMMENTS MADE BY CONTRACTORS SHOP DRAWING DURING THIS REVIEW DO NOT RELIEVE THE CONTRACTOR FROM COMPLIANCE WITH THE CONTRACT DRAWINGS AND SPECIFICATIONS. THE SHOP DRAWING HAS BEEN REVIEWED FOR CONFORMANCE WITH THE DESIGN CONCEPT AND GENERAL COMPLIANCE WITH THE CONTRACT DOCUMENTS ONLY. CONTRACTOR IS RESPONSIBLE FOR CONFIRMING AND CORRELATING ALL DIMENSIONS AND FABRICATION PROCESSES AND TECHNIQUES, COORDINATING WORK WITH OTHER TRADES AND SATISFACTION AND SAFE PERFORMANCE OF THE WORK.	

Table of Contents

Pump House No. 3

Ramsey, MN

<u>Tab</u>	<u>Description</u>
1	Control Description
2	Control System Drawings and Bill of Materials
3	Panel Components
4	Motor Control Center (Allen-Bradley)
5	Variable Frequency Drive (Allen-Bradley)
6	Transformer (Cutler-Hammer)
7	Lighting Panelboard (Cutler-Hammer)
8	CT Cabinet (EMI)
9	Fusible Disconnect Switch (Cutler-Hammer)
10	Unit Heaters (Berko)

Light Fixtures
(Hubbell, Lithonia Lighting and Stonco)

CONTROL DESCRIPTION

Job Name: Well House No. 3
Ramsey, Minnesota

A.S.C. ORDER NUMBER: ASC20011028

DATE: November 7, 2001

UNIT DESCRIPTION:
Adjustable Frequency Drive
Potassium Permanganate Mixer Panel

UNIT LOCATION:
Well House 3
Well House 3

System operation:


An Adjustable Frequency Drive (AFD) is provided for Well No. 1. The AFD will vary the speed of Well No. 1 based on set points from the customer supplied/future RTU. The RTU will monitor speed, running and fault conditions.

A chlorine booster pump motor starter is interlocked with the customer's provided/future RTU to operate whenever a well pump operation is confirmed.

The Potassium Permanganate Mixer Panel will control the $KmnO_4$ mixer with an operator adjustable timer.

Refer to the manufacturers literature for a more detailed description of operation on the individual components used.

Future RTU to be supplied
by ASC as per Change Order #
RTU submittal will show
tie in for chemical feed pumps
and chlorine booster pumps.

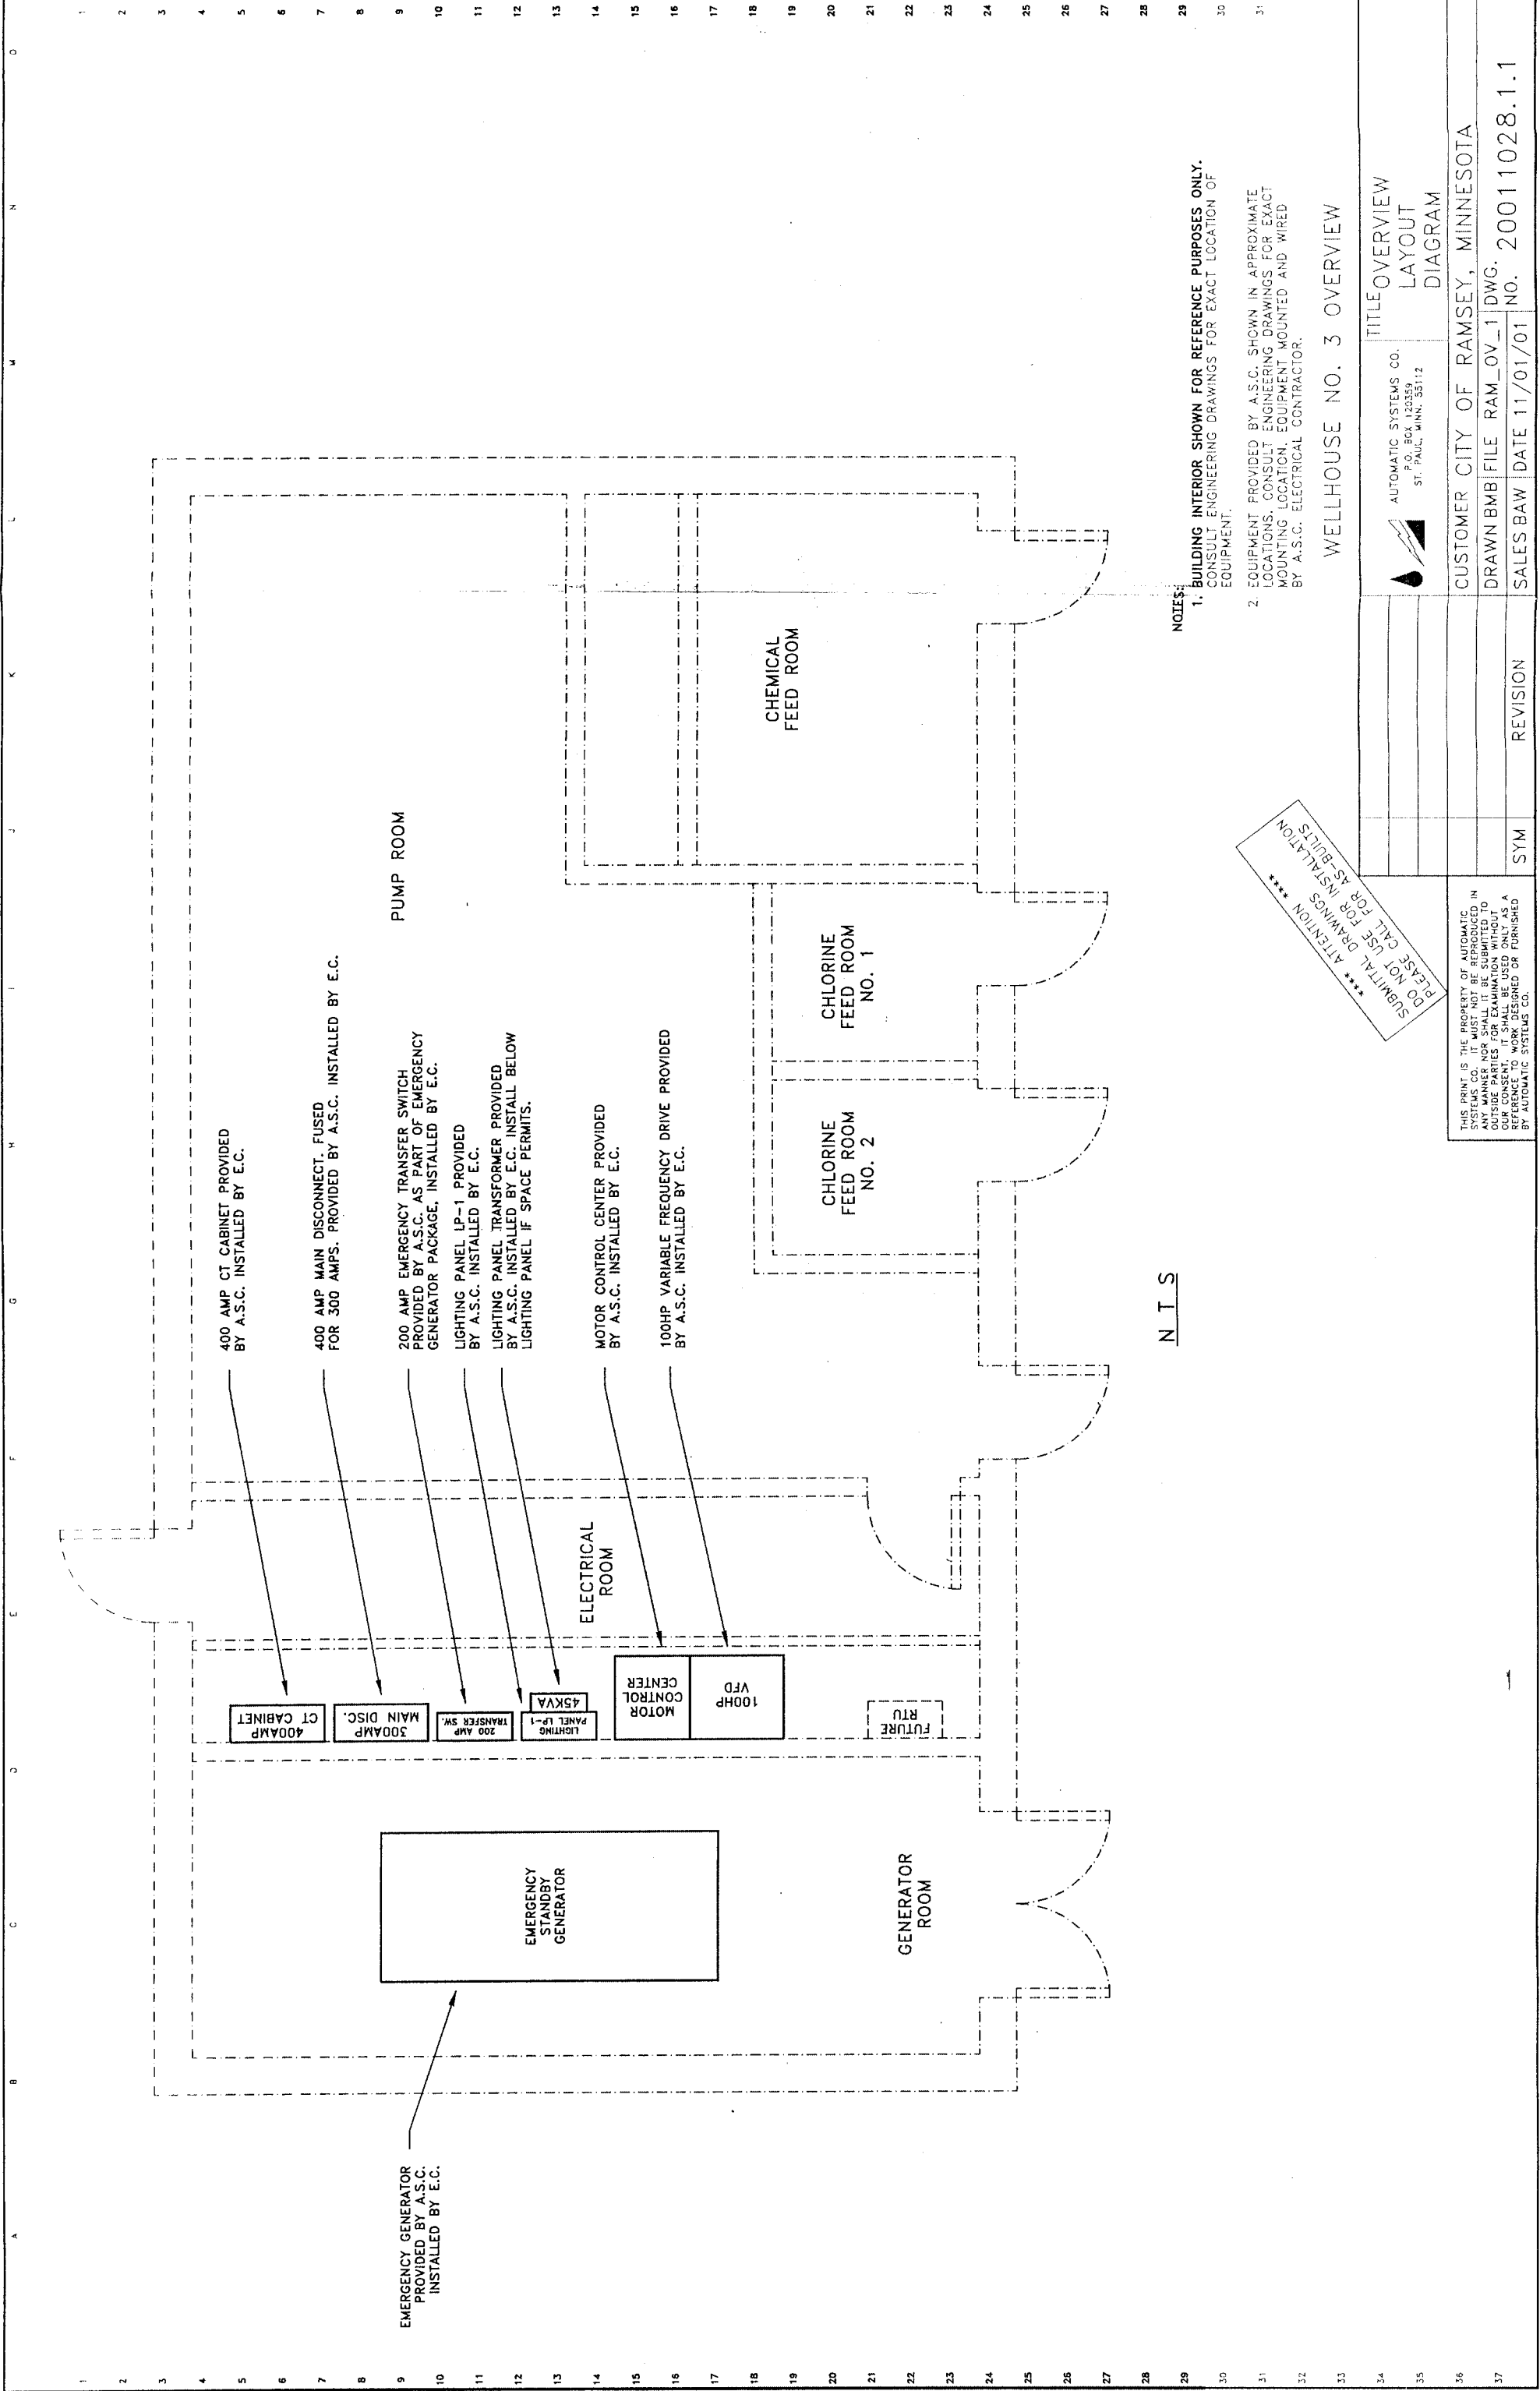

N T S

NOTES:
 1. BUILDING INTERIOR SHOWN FOR REFERENCE PURPOSES ONLY. CONSULT ENGINEERING DRAWINGS FOR EXACT LOCATION OF EQUIPMENT.
 2. EQUIPMENT PROVIDED BY A.S.C. SHOWN IN APPROXIMATE LOCATIONS. CONSULT ENGINEERING DRAWINGS FOR EXACT MOUNTING LOCATION. EQUIPMENT MOUNTED AND WIRED BY A.S.C. ELECTRICAL CONTRACTOR.

WELLHOUSE NO. 3 OVERVIEW

AUTOMATIC SYSTEMS CO. P.O. BOX 120359 ST. PAUL, MINN. 55112		TITLE OVERVIEW LAYOUT DIAGRAM	
CUSTOMER CITY OF RAMSEY, MINNESOTA		DRAWN BMB/FILE RAM_OV_1 DWG. NO. 20011028.1.1	
SALES BAW DATE 11/01/01		REVISION	
SYM		SYM	


*** SUBMITAL ATTENTION ***
 PLEASE CALL FOR INSTALLATION
 DO NOT USE FOR AS-BUILTS

THIS PRINT IS THE PROPERTY OF AUTOMATIC SYSTEMS CO. IT MUST NOT BE REPRODUCED IN ANY MANNER NOR SHALL IT BE SUBMITTED TO ANY OTHER PARTY FOR EXAMINATION WITHOUT THE WRITTEN PERMISSION OF AUTOMATIC SYSTEMS CO. THIS DRAWING IS A REFERENCE TO WORK DESIGNED OR FURNISHED BY AUTOMATIC SYSTEMS CO.

N.P. NO.	NAMEPLATE DESIGNATIONS	QTY
1	MAIN LUGS	1
2	POWER MONITOR	1
3	REMOTE RADIATOR	1
4	CHLORINE BOOSTER PUMP NO. 1	1
5	VAPORIZER	1
6	LIGHTING PANEL LP-1	1

N.P. NO.	NAMEPLATE DESIGNATIONS	QTY
1	POWER ON	1
2	RUN	1
3	FAULT	1
4	HAND-OFF-AUTO	1

STANDARD NAMEPLATES

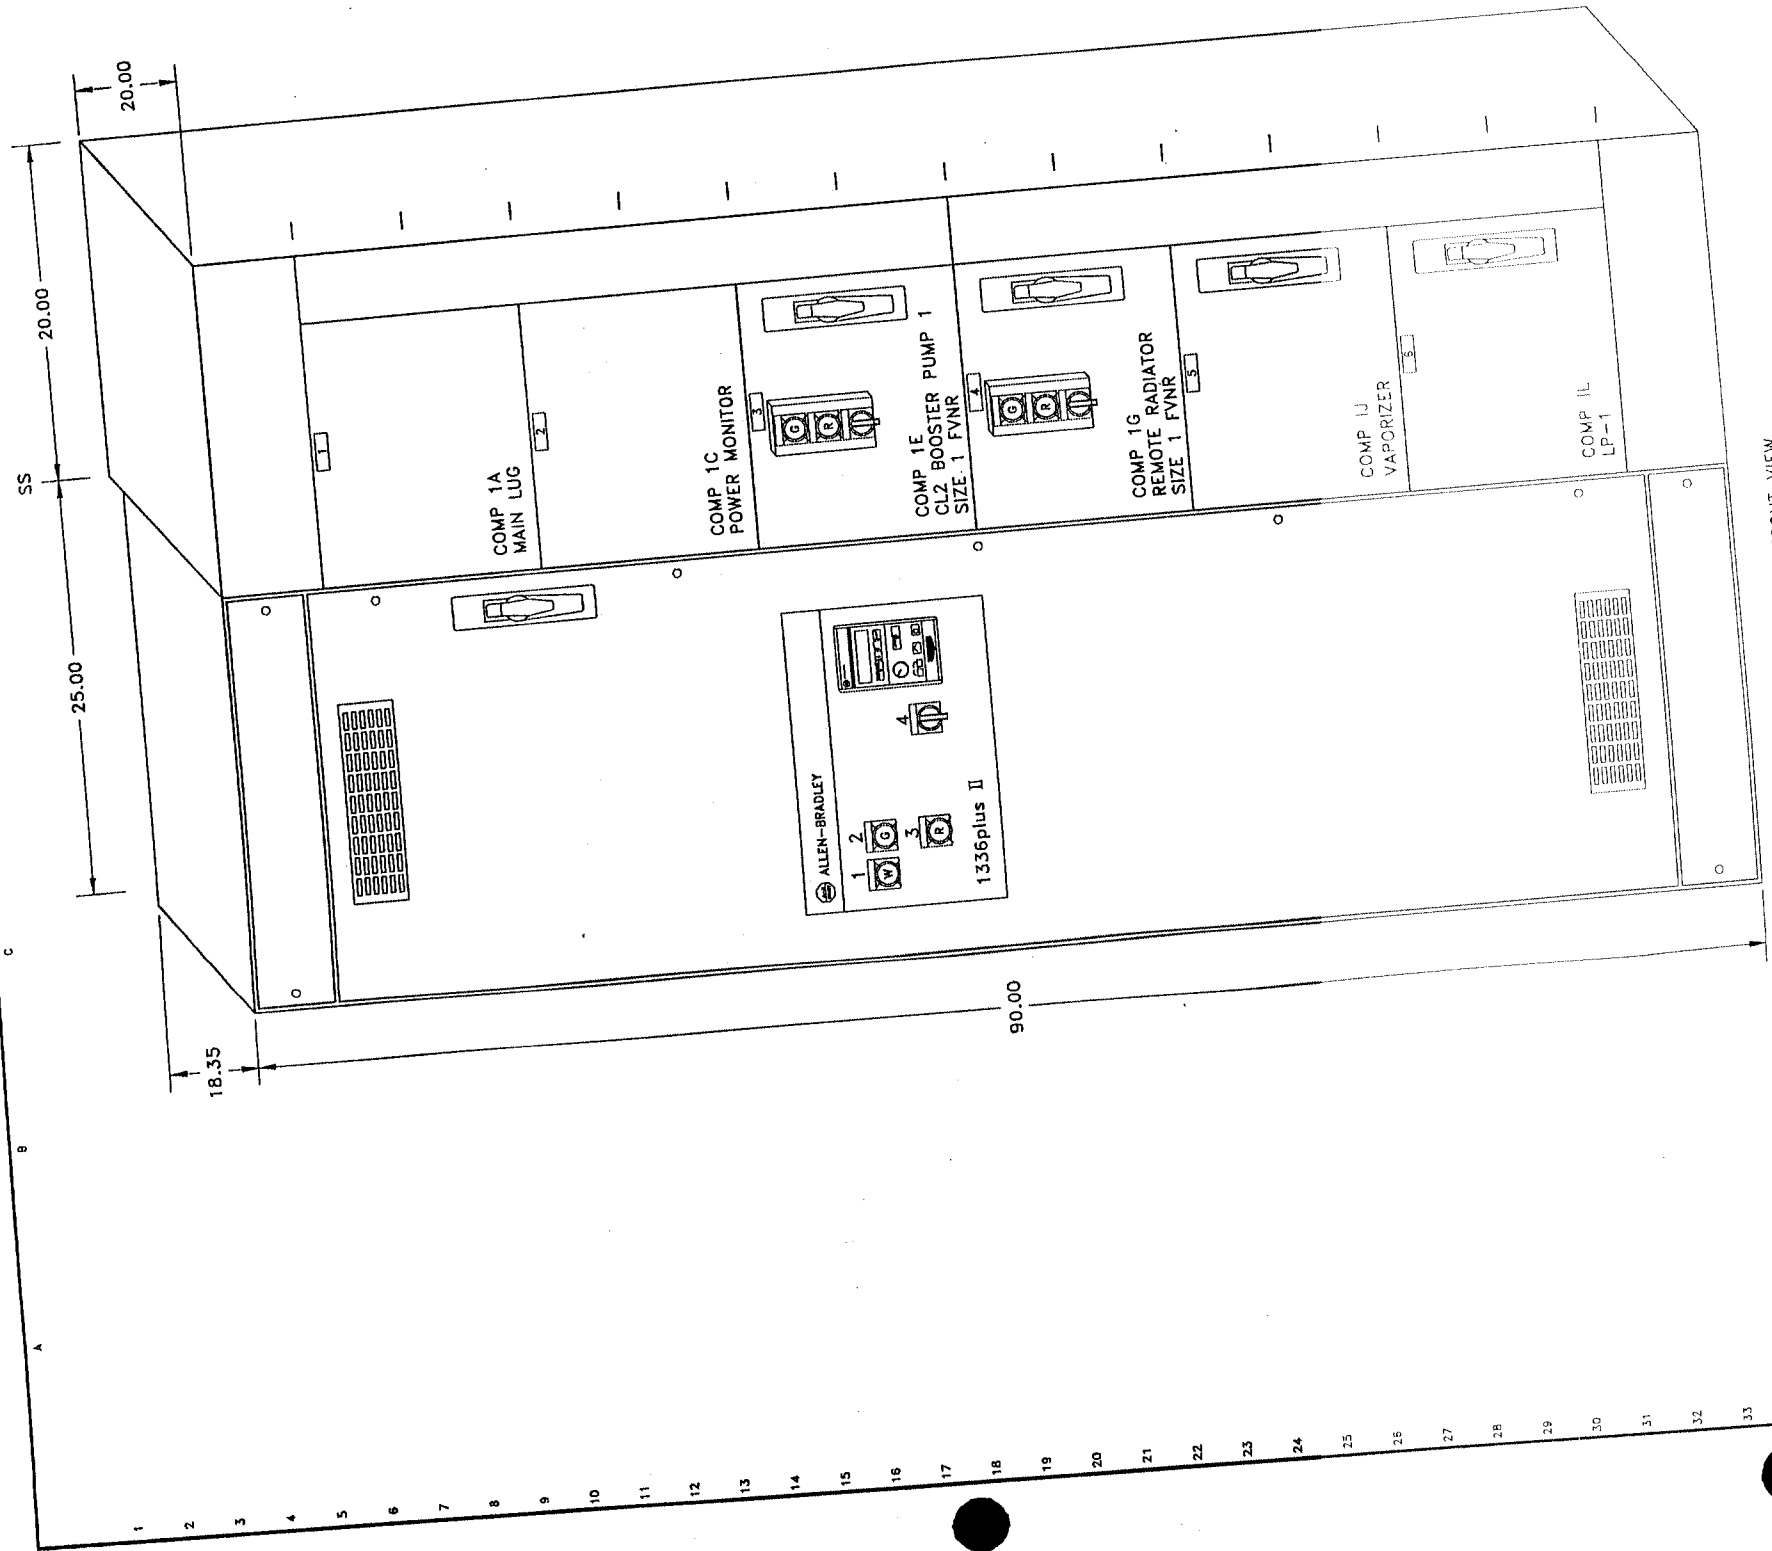

FRONT VIEW

- NOTES:
1. MOTOR CONTROL CENTER IS ALLEN BRADLEY, DIMENSIONS AS SHOWN. MCC IS NEMA 1, 480VAC, 3Ø, 3 WIRE, 60HZ. VFD IS CUTLER HAMMER TYPE SY9000, NEMA 1, 480VAC, 3Ø, 3 WIRE, 60HZ.
 2. FINISH IS MANUFACTURERS STANDARD.
 3. HORIZONTAL POWER BUS IS RATED AT 1200 AMPS.
 4. BUS BRACING IS 42KA RMS SYMMETRICAL.
 5. DOOR DEVICES SHOWN IN APPROXIMATE LOCATIONS. CONSULT MANUFACTURERS DRAWINGS FOR FURTHER DETAIL.

SUBMITAL ATTENTION *****
 DO NOT USE FOR INSTALLATION
 PLEASE CALL FOR AS-BUILTS

PUMP HOUSE NO. 3 - MCC

AUTOMATIC SYSTEMS CO.
 P.O. BOX 120359
 ST. PAUL, MINN. 55112
 TITLE MCC
 ENCLOSURE LAYOUT


CUSTOMER CITY OF RAMSEY, MINNESOTA
 DRAWN BMB/FILE RAM_M1_1
 SALES BAW DATE 11/01/01

THIS PRINT IS THE PROPERTY OF AUTOMATIC SYSTEMS CO. IT IS NOT TO BE REPRODUCED IN ANY MANNER WITHOUT THE WRITTEN CONSENT OF AUTOMATIC SYSTEMS CO. REFERENCE TO WORKSHEETS OR FURNISHED BY AUTOMATIC SYSTEMS CO.

REVISION


SYM

DWG. NO. 20011028.2

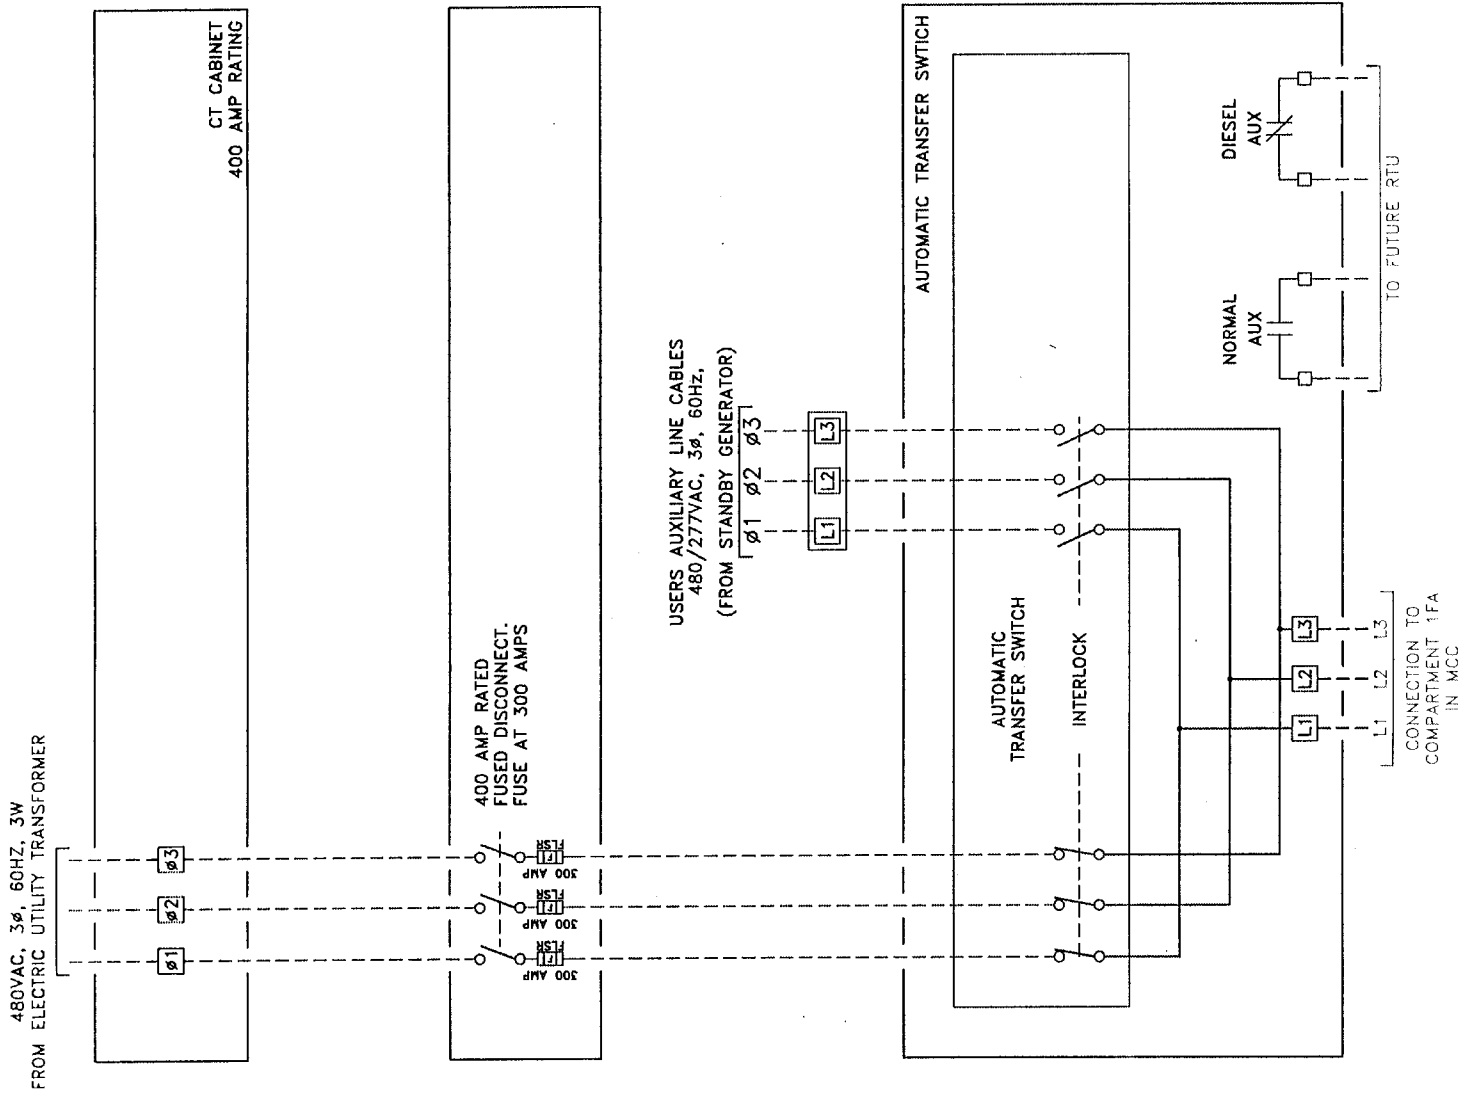

NOTES:
1. GENERAL NOTES PER DRAWING 20011028.2.1.

PUMP HOUSE NO. 3 - MCC

 AUTOMATIC SYSTEMS CO. P.O. BOX 110289 ST. PAUL, MINN. 55112		TITLE CONTROL WIRING DIAGRAM	
CUSTOMER CITY OF RAMSEY, MINNESOTA		DRAWN BMB FILE RAM_XS_1 DWG. 20011028.2.2	
SALES BAW DATE 11/01/01		REVISION	SYM


***** ATTENTION *****
 DO NOT USE FOR INSTALLATION
 SERIAL DRAWINGS

THIS PRINT IS THE PROPERTY OF AUTOMATIC SYSTEMS CO. IT IS TO BE RETURNED TO THE COMPANY IN ANY MANNER FOR EXAMINATION WITHOUT OUR CONSENT. IT SHALL BE USED ONLY AS A REFERENCE AND NOT REPRODUCED OR FORWARDED BY AUTOMATIC SYSTEMS CO.


480VAC, 3 ϕ , 60HZ, 3 WIRE
 1200 AMP HORIZONTAL BUS
 42,000 AMP BUS BRACING

Interlock with generator run signal. Shall be wired back to generator control panel.

480VAC, 3 ϕ , 60HZ, 3W
 FROM GENERATOR TRANSFER SWITCH

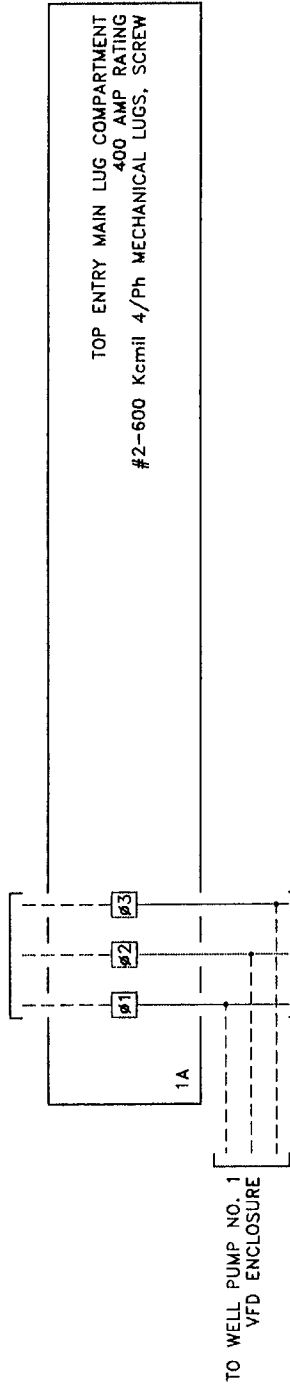


TO WELL PUMP NO. 1
 VFD ENCLOSURE

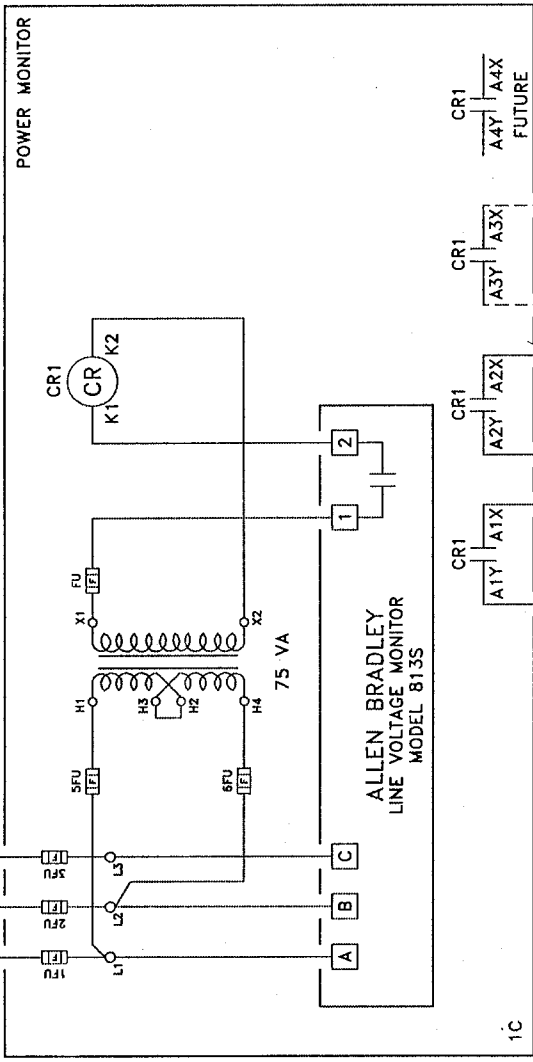


POWER MONITOR


ALLEN BRADLEY
 LINE VOLTAGE MONITOR
 MODEL 813S

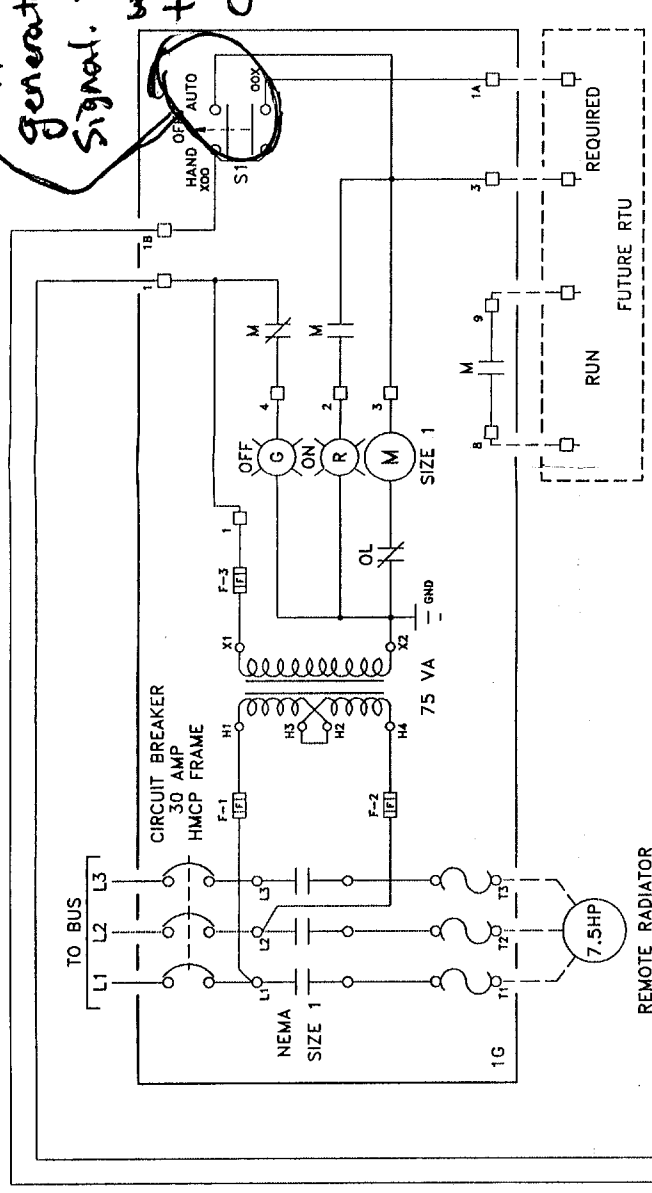


REMOTE RADIATOR
 480 VAC _____ AMPS

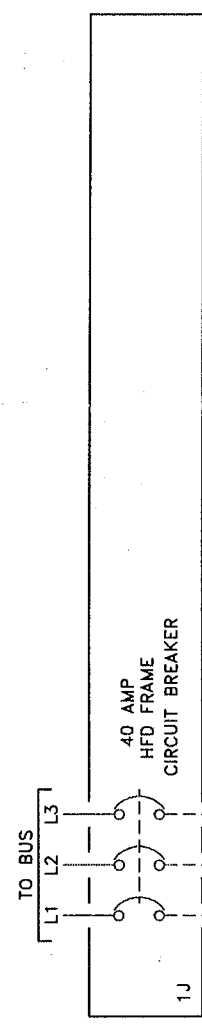

40 AMP
 HFD FRAME
 CIRCUIT BREAKER

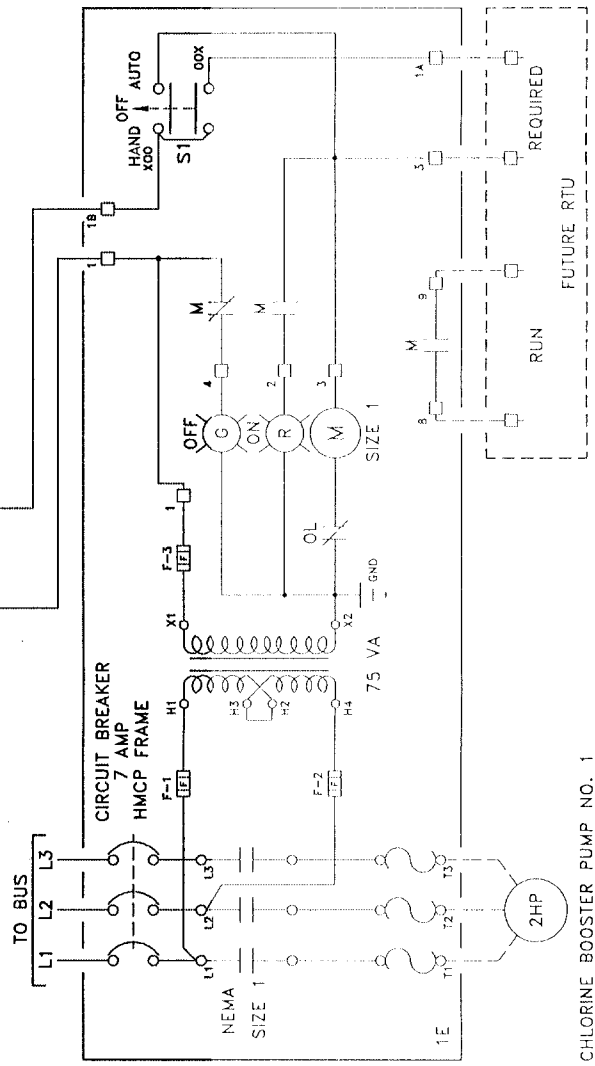

CHLORINE BOOSTER PUMP NO. 1
 480 VAC _____ AMPS

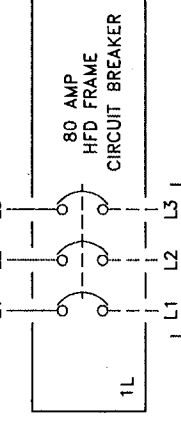

80 AMP
 HFD FRAME
 CIRCUIT BREAKER



LIGHTING PANEL TRANSFORMER

 SUBMITAL ATTENTION *****
 PLEASE CALL FOR INSTALLATION

NOTES:
 1. GENERAL NOTES PER DRAWING 20011028.2.1.

PUMP HOUSE NO. 3 - MCC

AUTOMATIC SYSTEMS CO. P.O. BOX 120459 ST. PAUL, MINN. 55112		TITLE CONTROL WIRING DIAGRAM	
CUSTOMER CITY OF RAMSEY, MINNESOTA		DRAWN BMB FILE RAM_M1_2	
SYMBOL		REVISION	
SALES BAW		DATE 11/01/01	
NO. 20011028.2.3		DWG. 20011028.2.3	

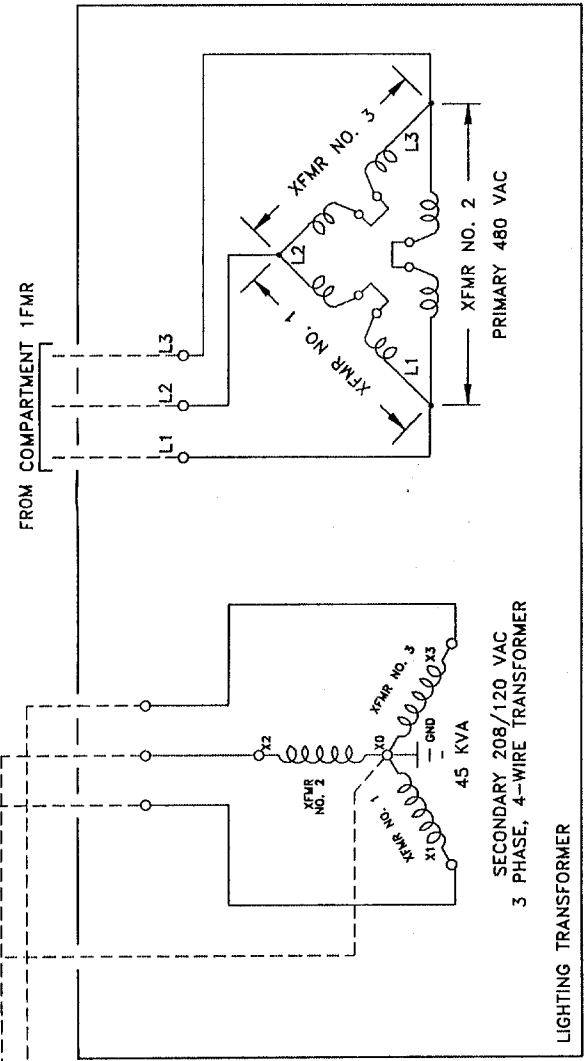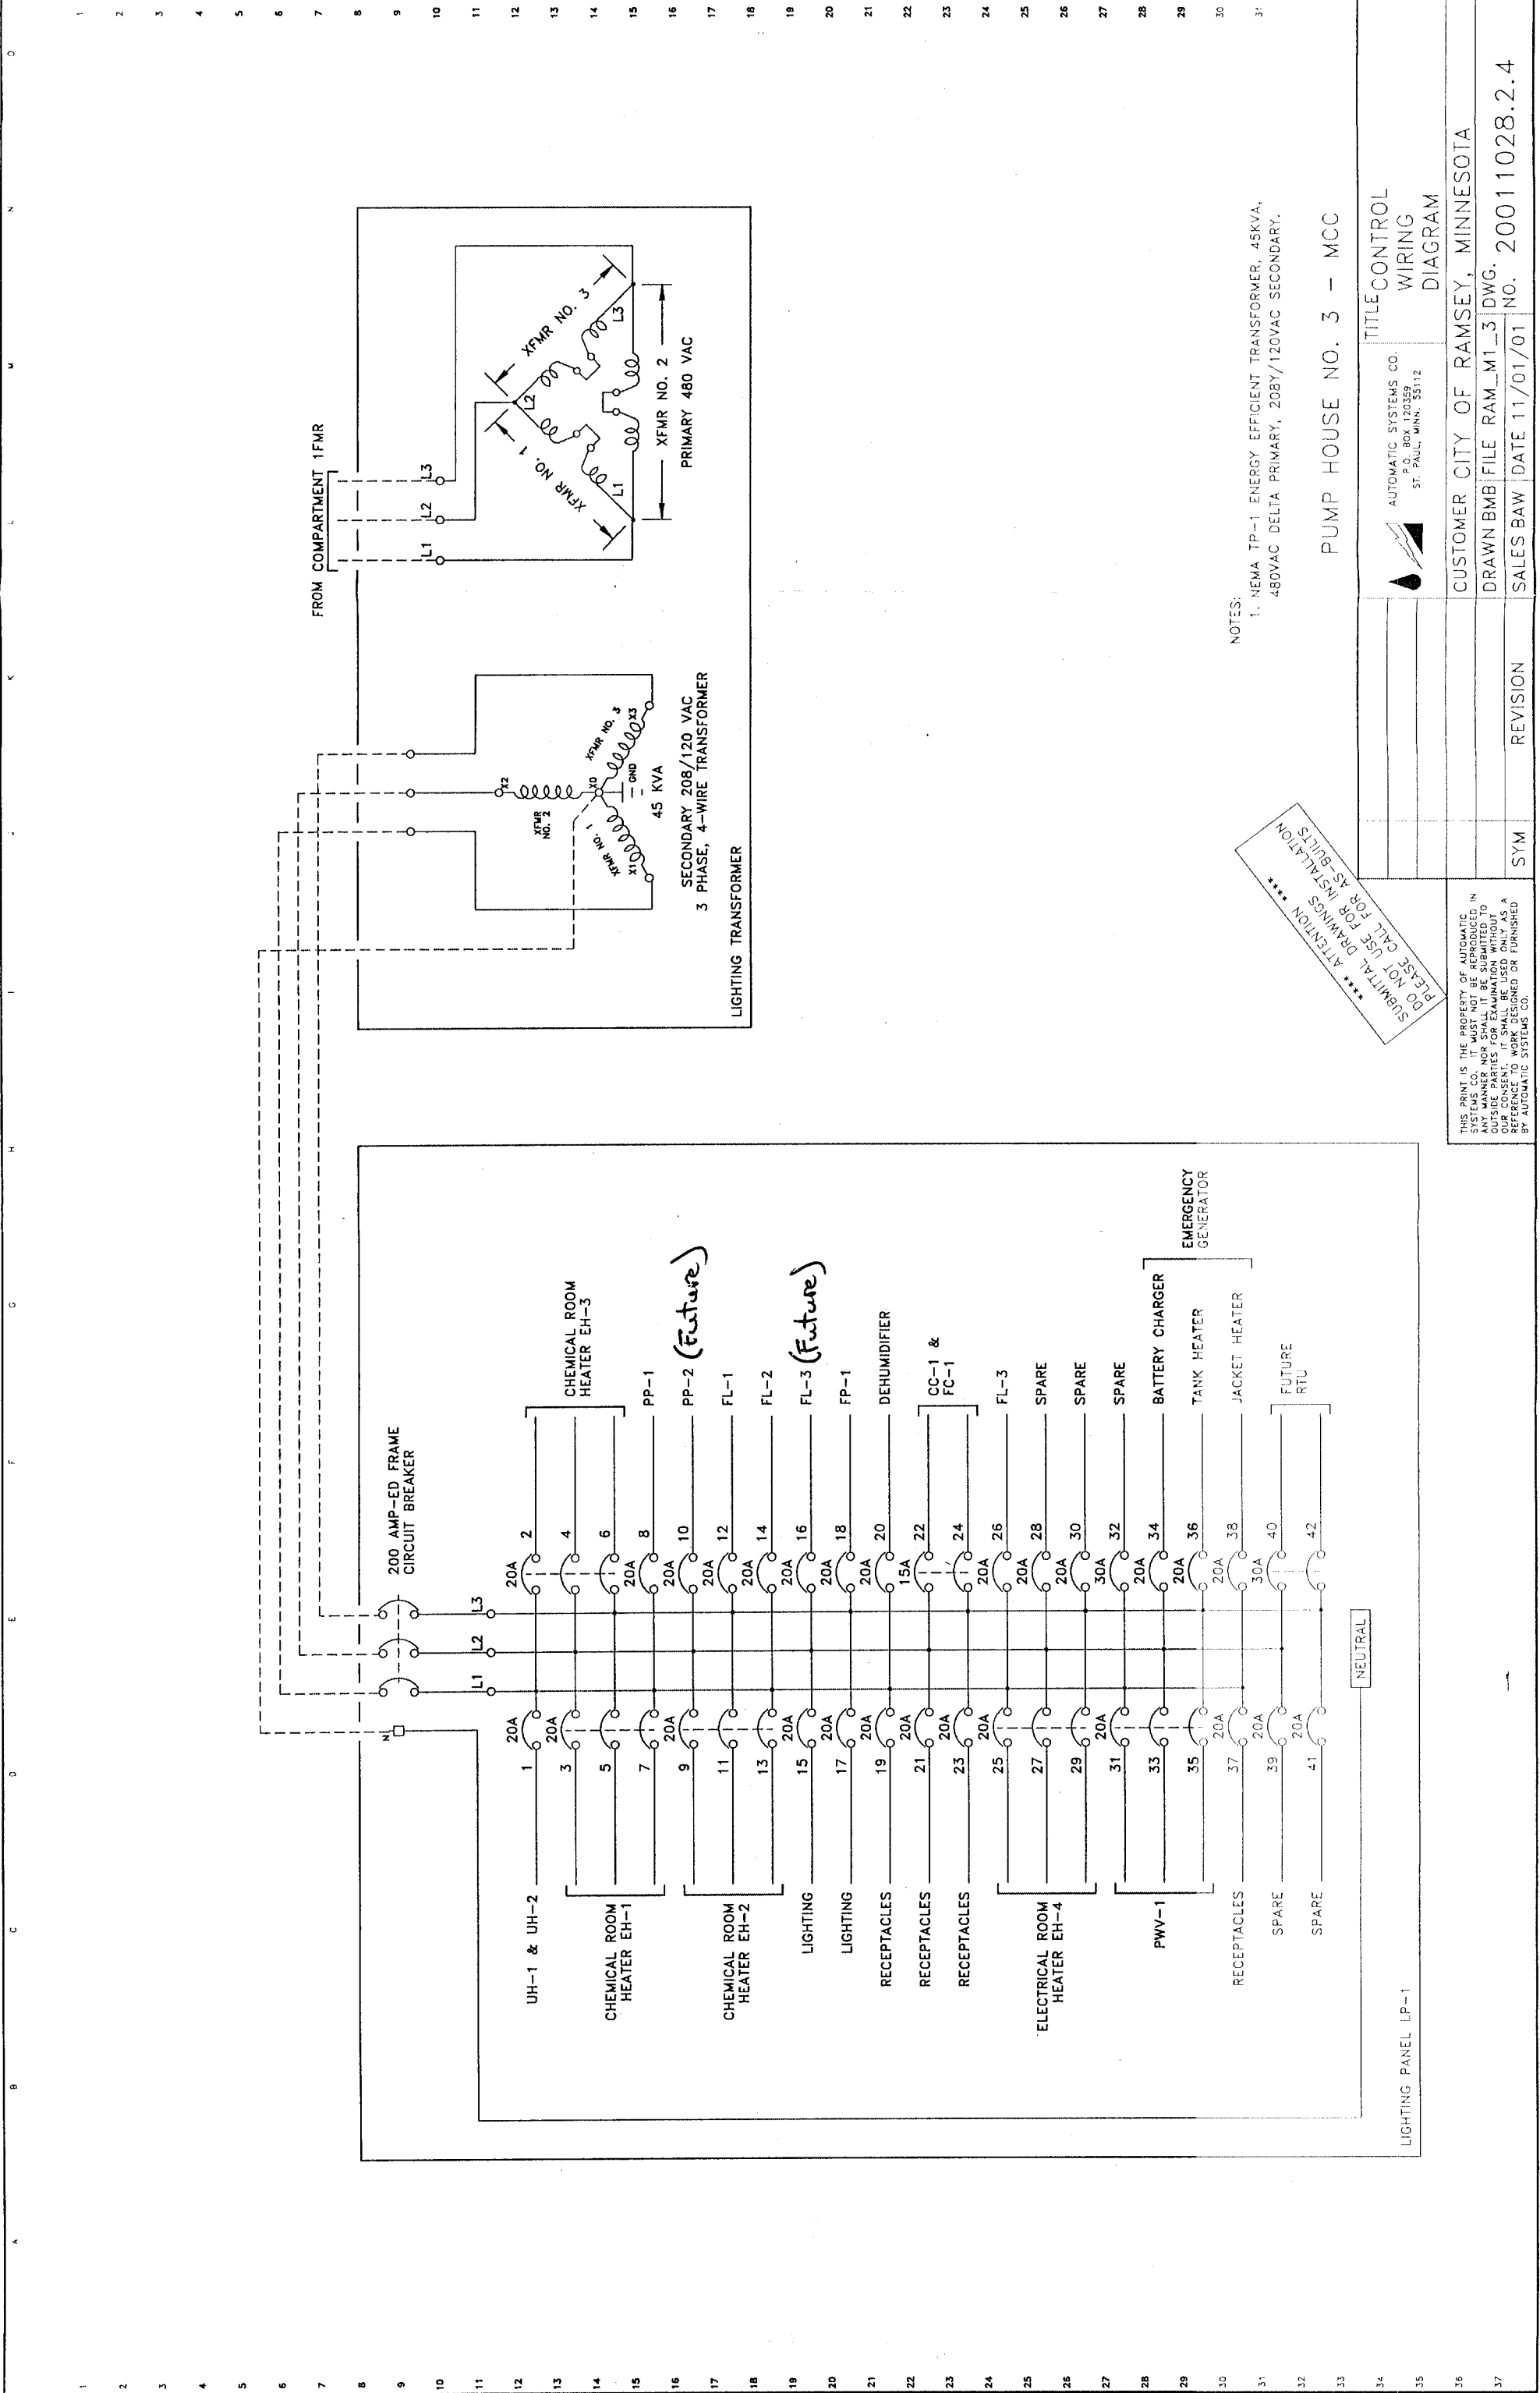

NOTES:
 1. NEMA TP-1 ENERGY EFFICIENT TRANSFORMER, 45KVA,
 480VAC DELTA PRIMARY, 208Y/120VAC SECONDARY.


PUMP HOUSE NO. 3 - MCC

*** ATTENTION ***
 SUBMITAL DRAWINGS
 DO NOT USE FOR INSTALLATION
 PLEASE CALL FOR AS-BUILTS

AUTOMATIC SYSTEMS CO. P.O. BOX 120359 ST. PAUL, MINN. 55112		TITLE CONTROL WIRING DIAGRAM	
CUSTOMER CITY OF RAMSEY, MINNESOTA	DATE 11/01/01	REVISION	SYM
DRAWN BMB FILE RAM_M1_31 DWG.	SALES BAW		
NO. 20011028.2.4			

THIS PRINT IS THE PROPERTY OF AUTOMATIC SYSTEMS CO. IT MUST NOT BE REPRODUCED IN ANY MANNER WITHOUT THE WRITTEN CONSENT OF AUTOMATIC SYSTEMS CO. OUTSIDE PARTIES FOR EXAMINATION WITHOUT OUR CONSENT. IT SHALL BE USED ONLY AS A REFERENCE TO WORK DESIGNED OR FURNISHED BY AUTOMATIC SYSTEMS CO.

LIGHTING PANEL LP-1

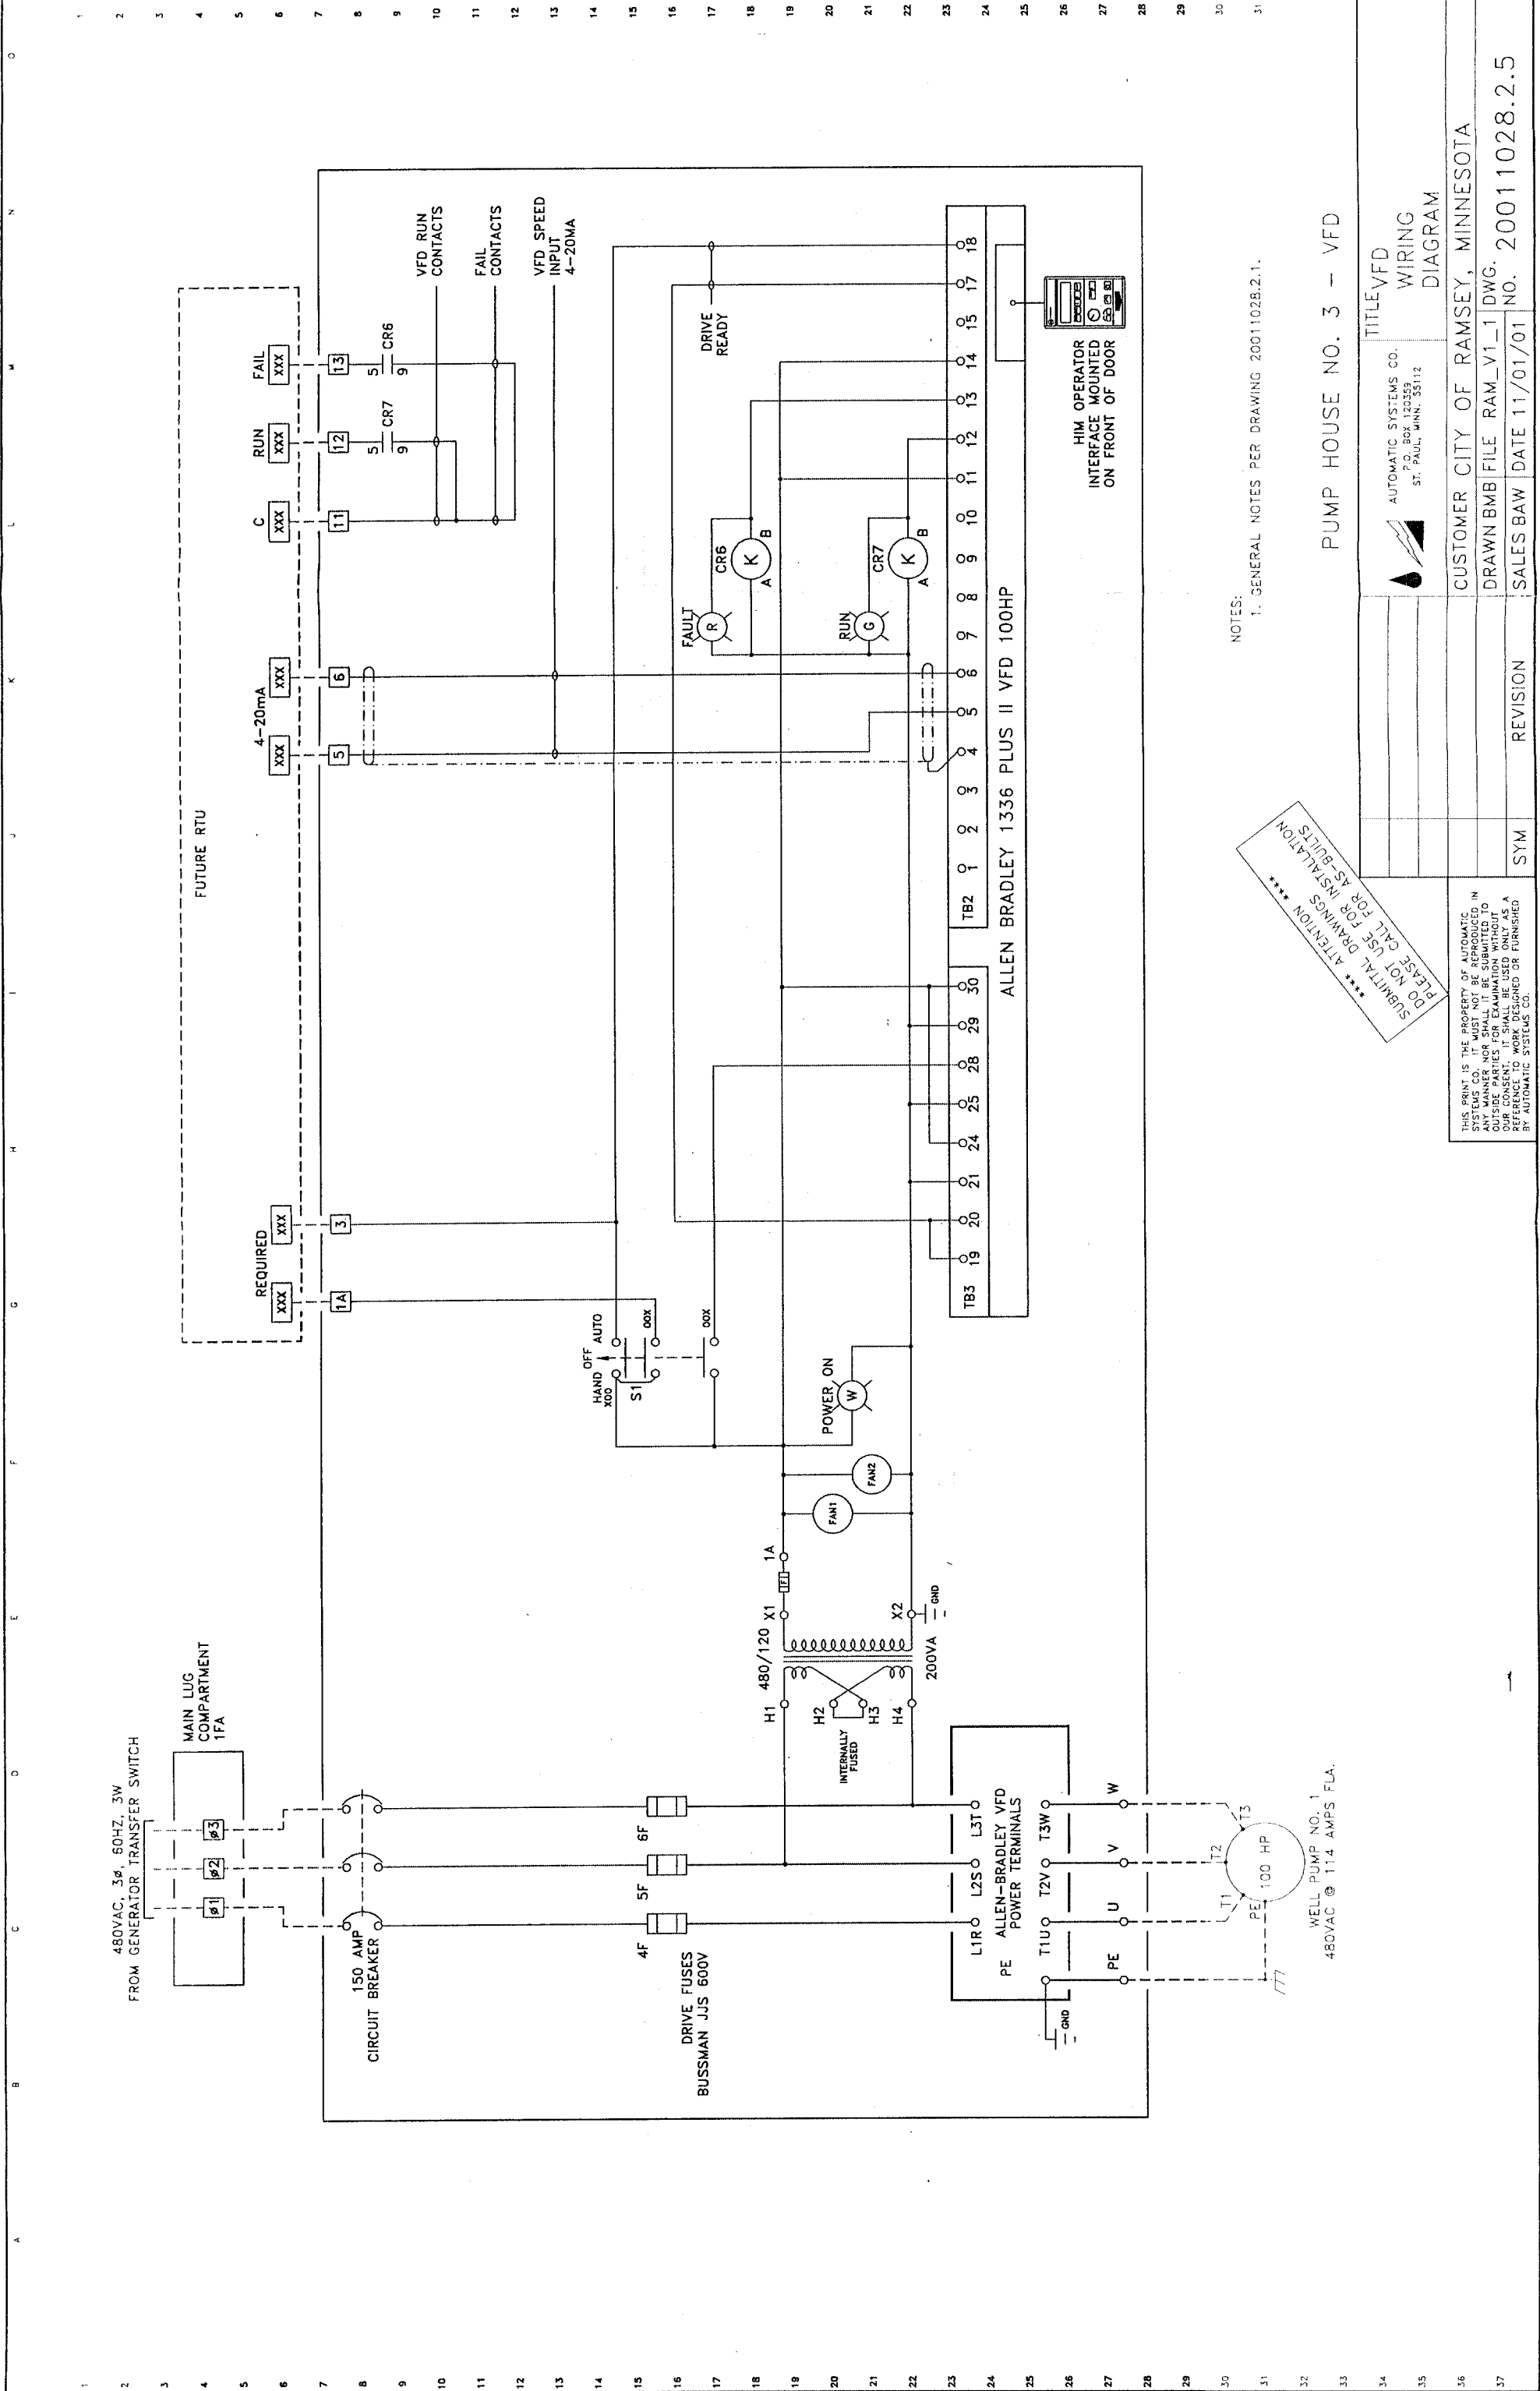

NOTES:
1. GENERAL NOTES PER DRAWING 20011028.2.1.

SUBMITAL ATTENTION *****
DO NOT USE FOR AS-BUILTS
PLEASE CALL FOR AS-BUILTS

WELL PUMP NO. 1
480VAC @ 114 AMPS FLA.


PUMP HOUSE NO. 3 - VFD

AUTOMATIC SYSTEMS CO. P.O. BOX 120359 ST. PAUL, MINN. 55112		TITLE VFD WIRING DIAGRAM	
CUSTOMER CITY OF RAMSEY, MINNESOTA	DRAWN BMB FILE RAM_V1_1	REVISION	DATE 11/01/01
SALES BAW	NO. 20011028.2.5	SYM	


THIS PRINT IS THE PROPERTY OF AUTOMATIC SYSTEMS CO. IT MUST NOT BE REPRODUCED IN ANY MANNER NOR SHALL IT BE SUBMITTED TO OUTSIDE PARTIES FOR EXAMINATION WITHOUT THE WRITTEN PERMISSION OF AUTOMATIC SYSTEMS CO. REFERENCE TO WORK DESIGNED OR FURNISHED BY AUTOMATIC SYSTEMS CO.

N.P. NO.	NAMEPLATE DESIGNATIONS	QTY
1	POTASSIUM PERMANGANATE RELAY PANEL	1

STANDARD NAMEPLATES
BLACK PHENOLIC W/ 3/16" WHT LETTERS
2.5" X .75" ATTACH W/ 4-40 SS SCREWS

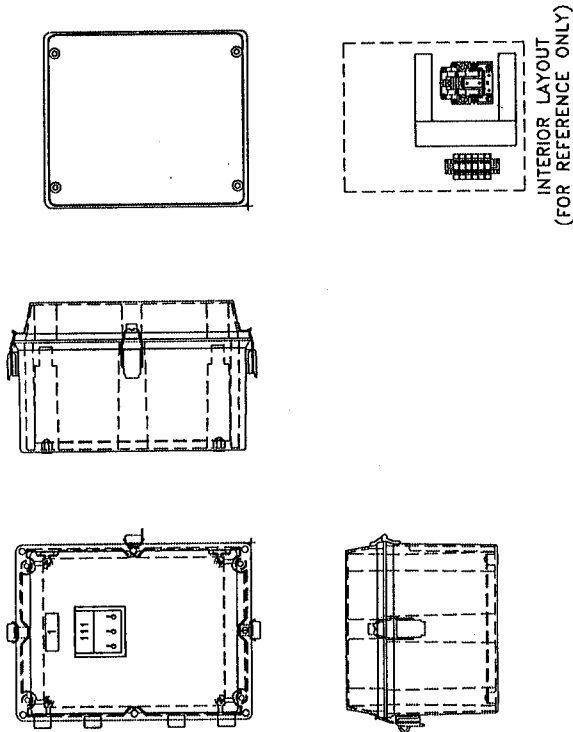

POTASSIUM PERMANGANATE MIXER CONTROL PANEL

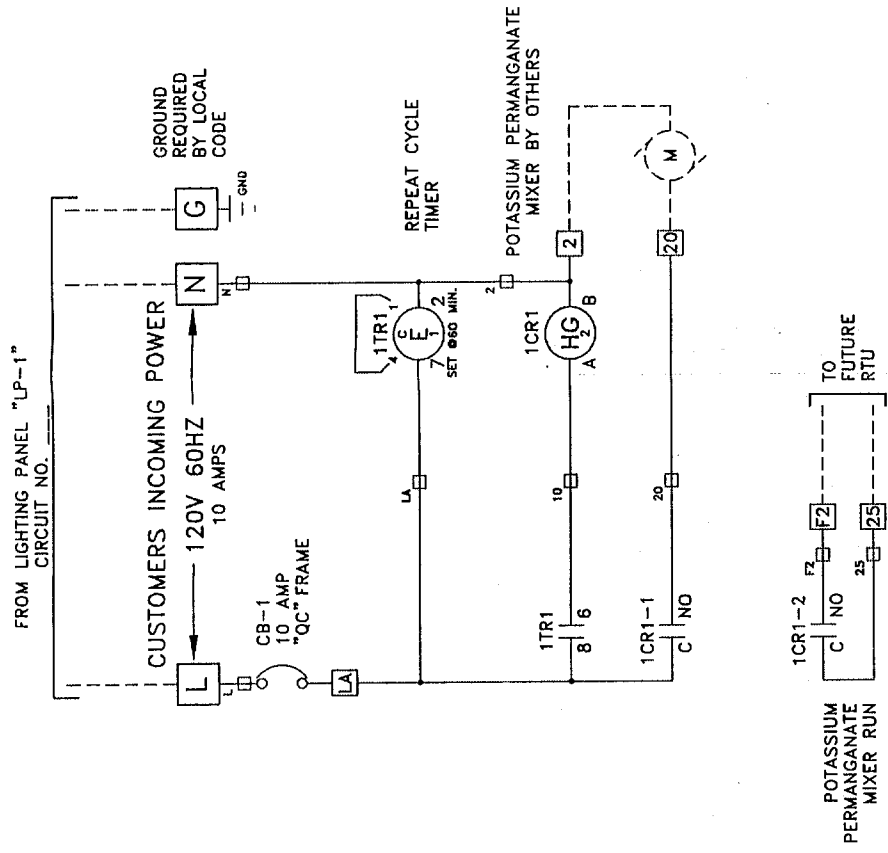

NOTES:

- ENCLOSURE IS NEMA 4X, FIBERGLASS.
- FIELD WIRING TO BE COPPER 90°C MIN, TORQUE TO 20 IN. LBS.
- U.L. 508 LABELED.

ATTENTION
FOR INSTALLATION
CALL FOR AS-BUILTS
DO NOT USE
DRAWINGS

POTASSIUM PERMANGANATE MIXER TIMER CONTROL PANEL

AUTOMATIC SYSTEMS CO.
P.O. BOX 202559
ST. PAUL, MINN. 55112

TITLE ENCLOSURE
AND WIRING
DIAGRAM

CUSTOMER CITY OF RAMSEY, MINNESOTA


DRAWN BMB FILE RAMKMN04

SALES BAW DATE 11/01/01 DWG. NO. 20011028.3.1


THIS PRINT IS THE PROPERTY OF AUTOMATIC SYSTEMS CO. IT MUST NOT BE REPRODUCED, IN WHOLE OR IN PART, OR LOANED, COPIED, OR OUTSIDE PARTS FOR EXAMINATION WITHOUT OUR CONSENT. IT SHALL BE USED ONLY AS A REFERENCE TO WORK DESIGNED OR FURNISHED BY AUTOMATIC SYSTEMS CO.

SYM


REVISION

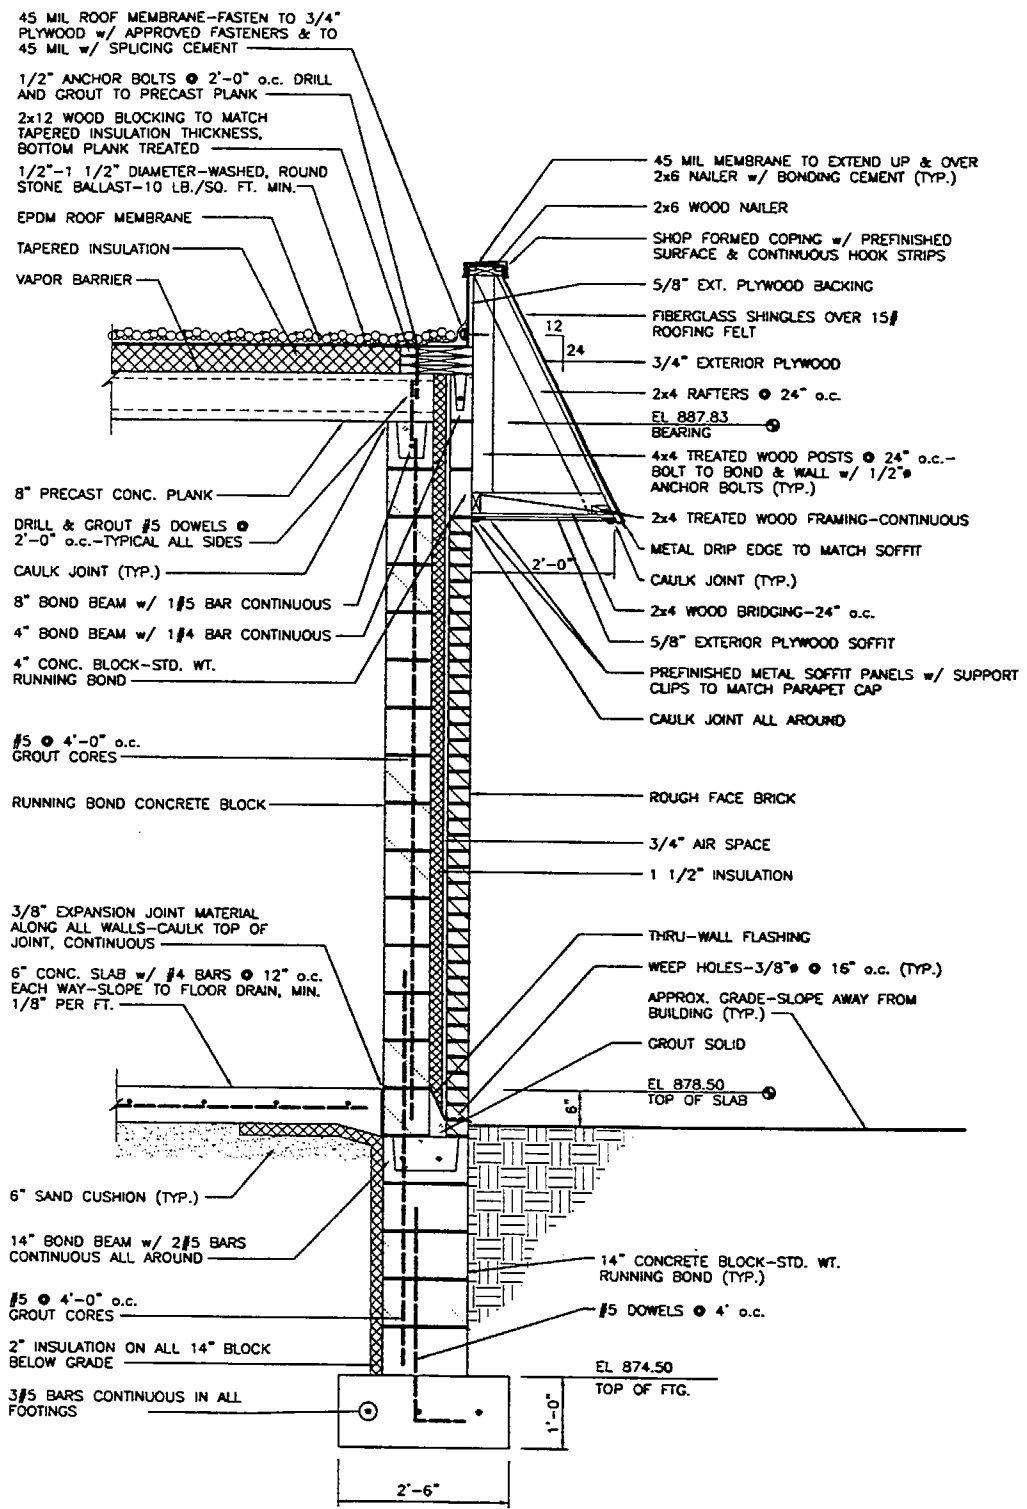


A
SECTION
SCALE IN FEET

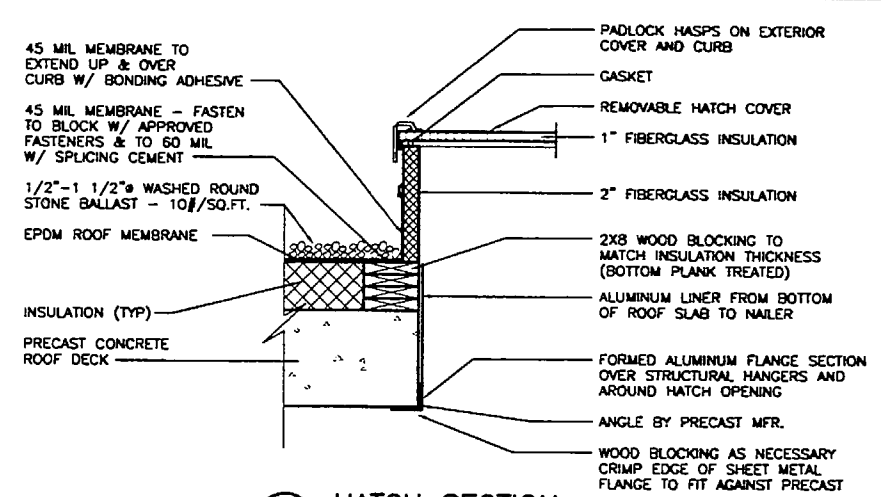


B
HATCH SECTION
SCALE IN FEET

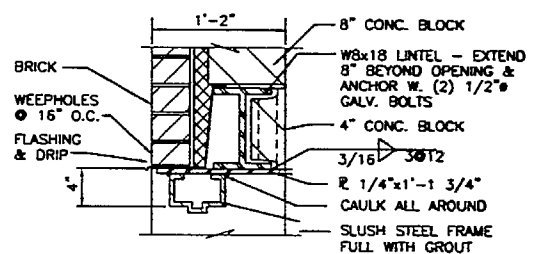


C
DOOR HEAD DETAIL
SCALE IN FEET

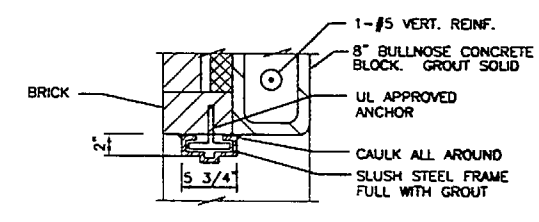


D
DOOR JAMB DETAIL
SCALE IN FEET

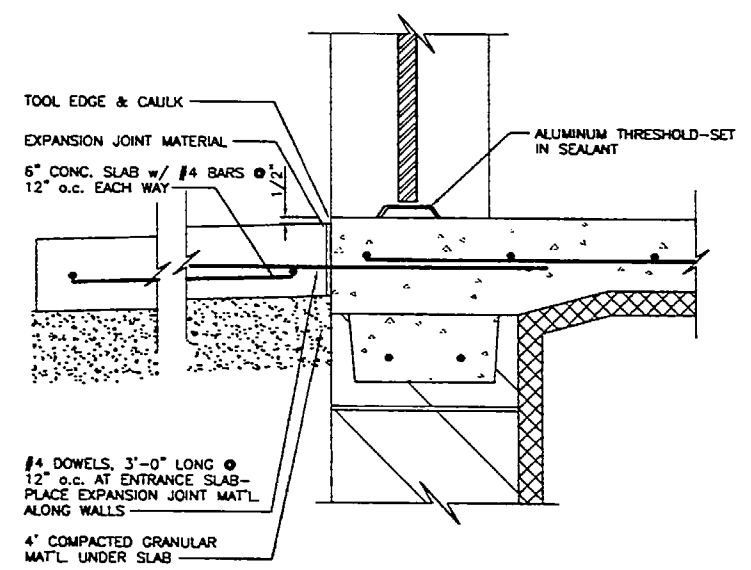


E
DOOR SILL DETAIL
SCALE IN FEET

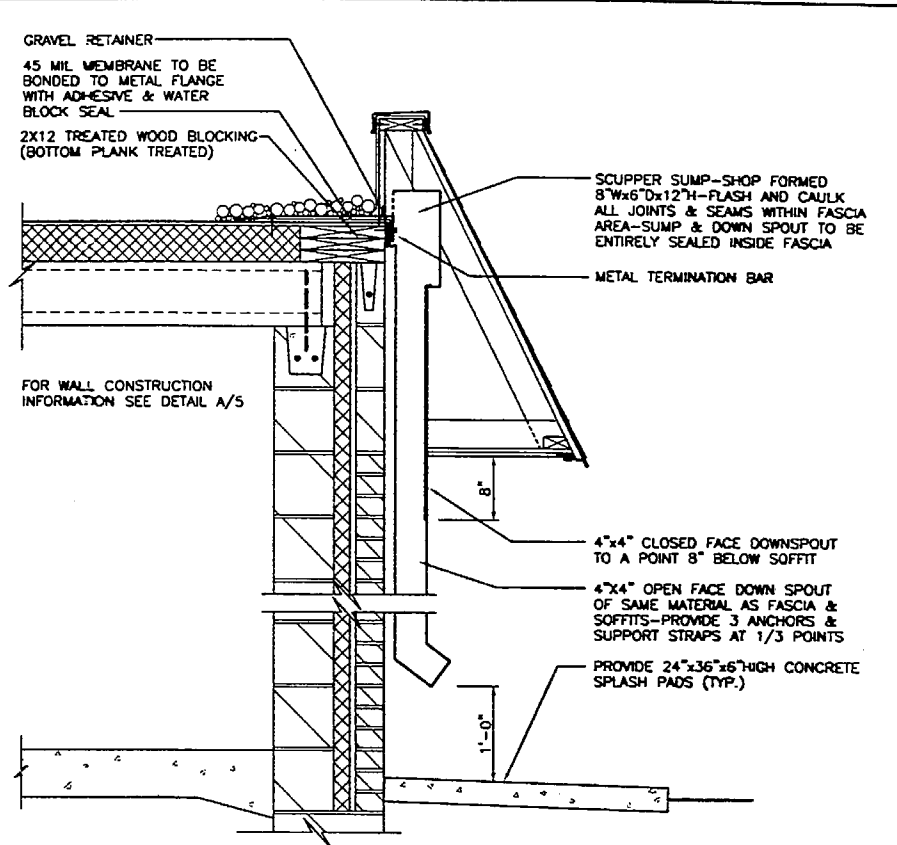

F
SCUPPER & DOWNSPOUT DETAIL
SCALE IN FEET

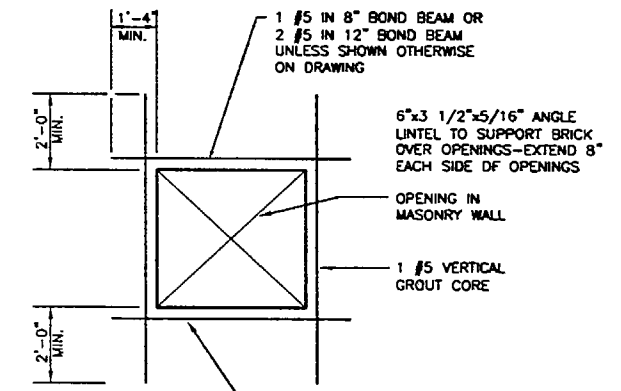

G
REINFORCING AT OPENING
NO SCALE

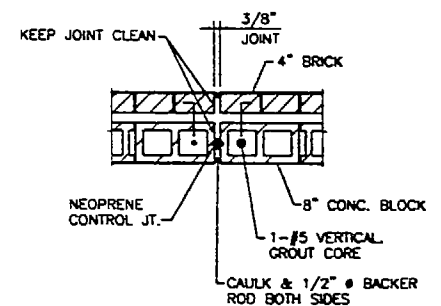


H
BRICK CONTROL JOINT RECORD DRAWING
NO SCALE

DOOR AND WINDOW SCHEDULE					
LOCATION	ROUGH OPENING	DOOR SIZE	DOOR/FRAME MATERIAL	HARDWARE	COMMENTS
PUMP ROOM TO OUTSIDE	6'-4"x7'-4"	(2) 3'-0"x7'-0"	STEEL	GROUP 1	INSULATE & WEATHER STRIP
CHEMICAL ROOM TO OUTSIDE	3'-4"x7'-4"	3'-0"x7'-0"	FIBERGLASS	GROUP 2	INSULATE & WEATHER STRIP
PUMP ROOM TO CHEMICAL ROOM	2'-3"x2'-3"				FIRE RATED ASSEMBLY


ENGINEERS & ARCHITECTS
Bonestroo Robene Anderlik & Associates
 51 Paul • Milwaukee
 REG. NO. 11609
 DATE 4/30/03
 DRAWN BY LJK
 DESIGNED BY RWF
 APPROVED BY DATE
 SURVEYED BY DATE
 REVISIONS
 DATE
 43803
 SHEET 5 OF 11
 060898

RAMSEY, MINNESOTA
WELL NO.3 PUMPING FACILITY
 WALL SECTION AND DETAILS

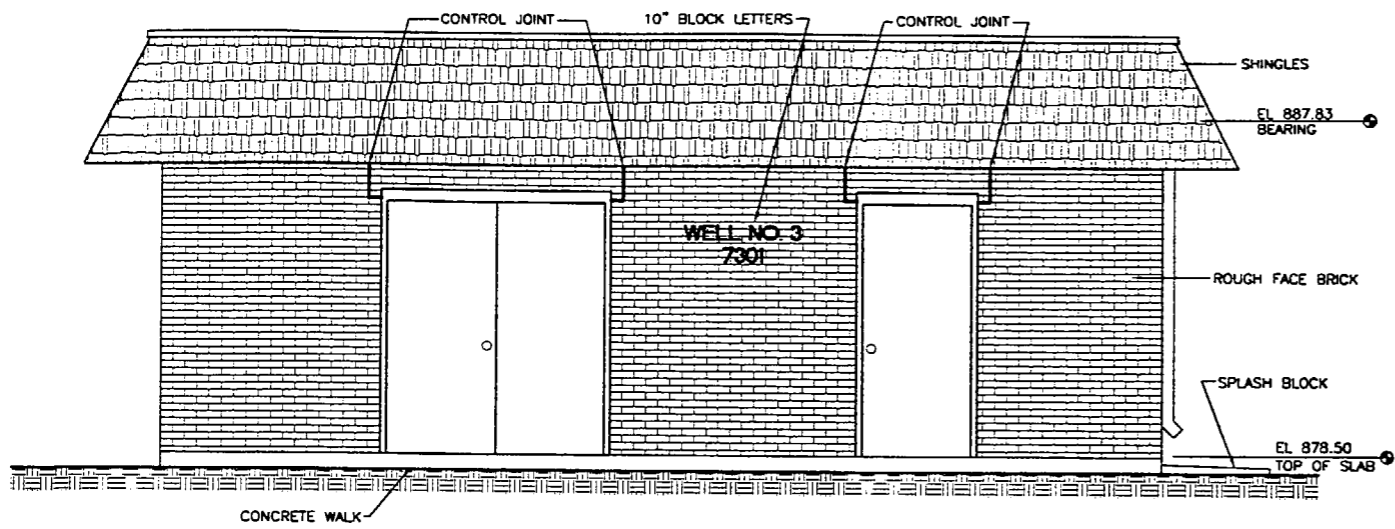


SOUTH ELEVATION

0 1 2 3
SCALE IN FEET

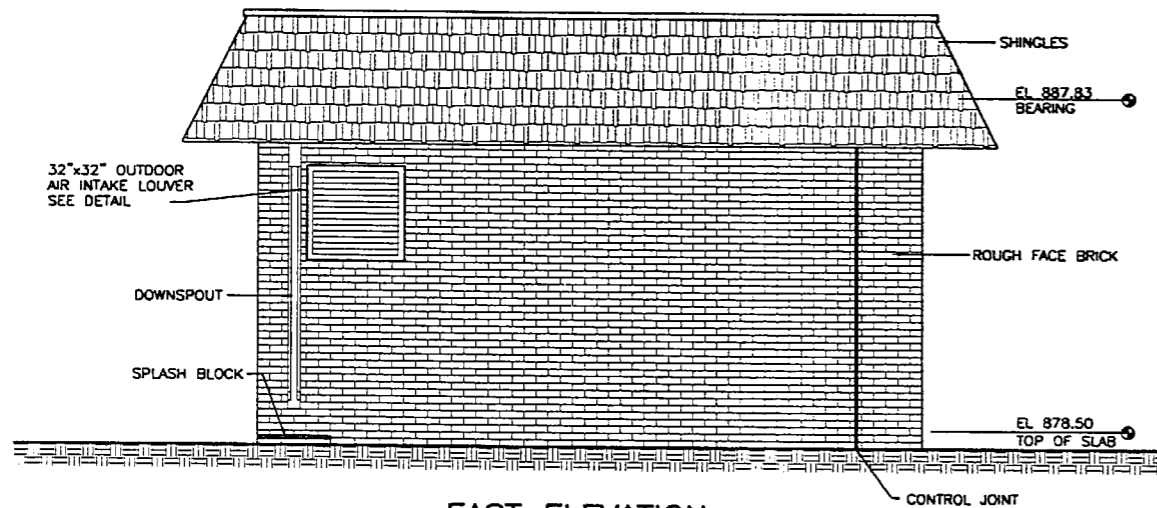


EAST ELEVATION

0 1 2 3
SCALE IN FEET

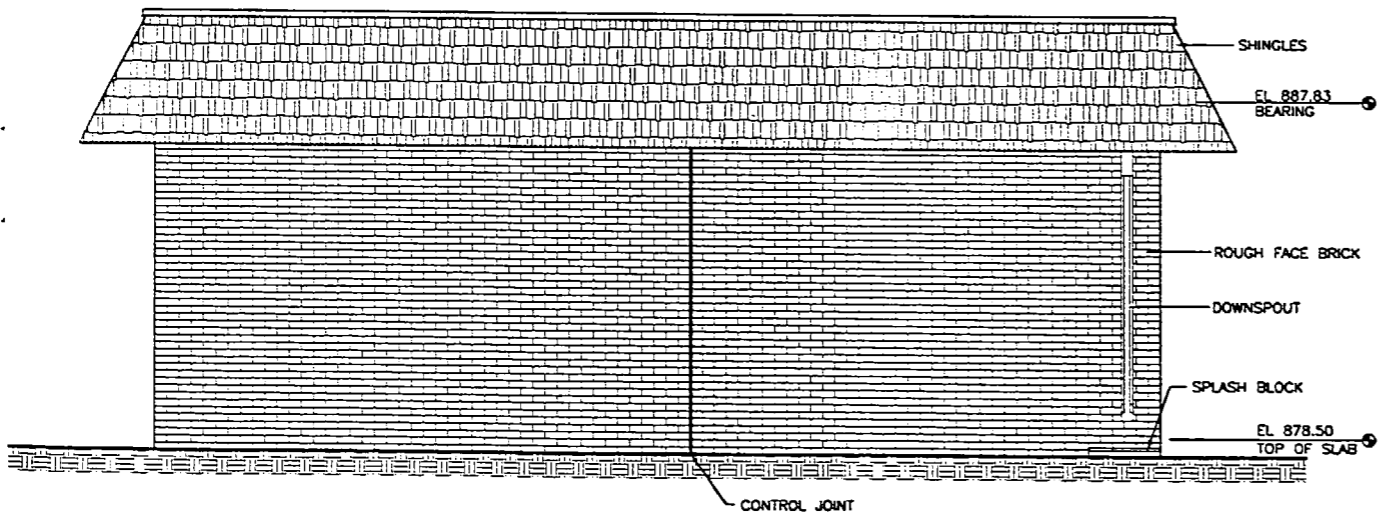

NORTH ELEVATION

0 1 2 3
SCALE IN FEET

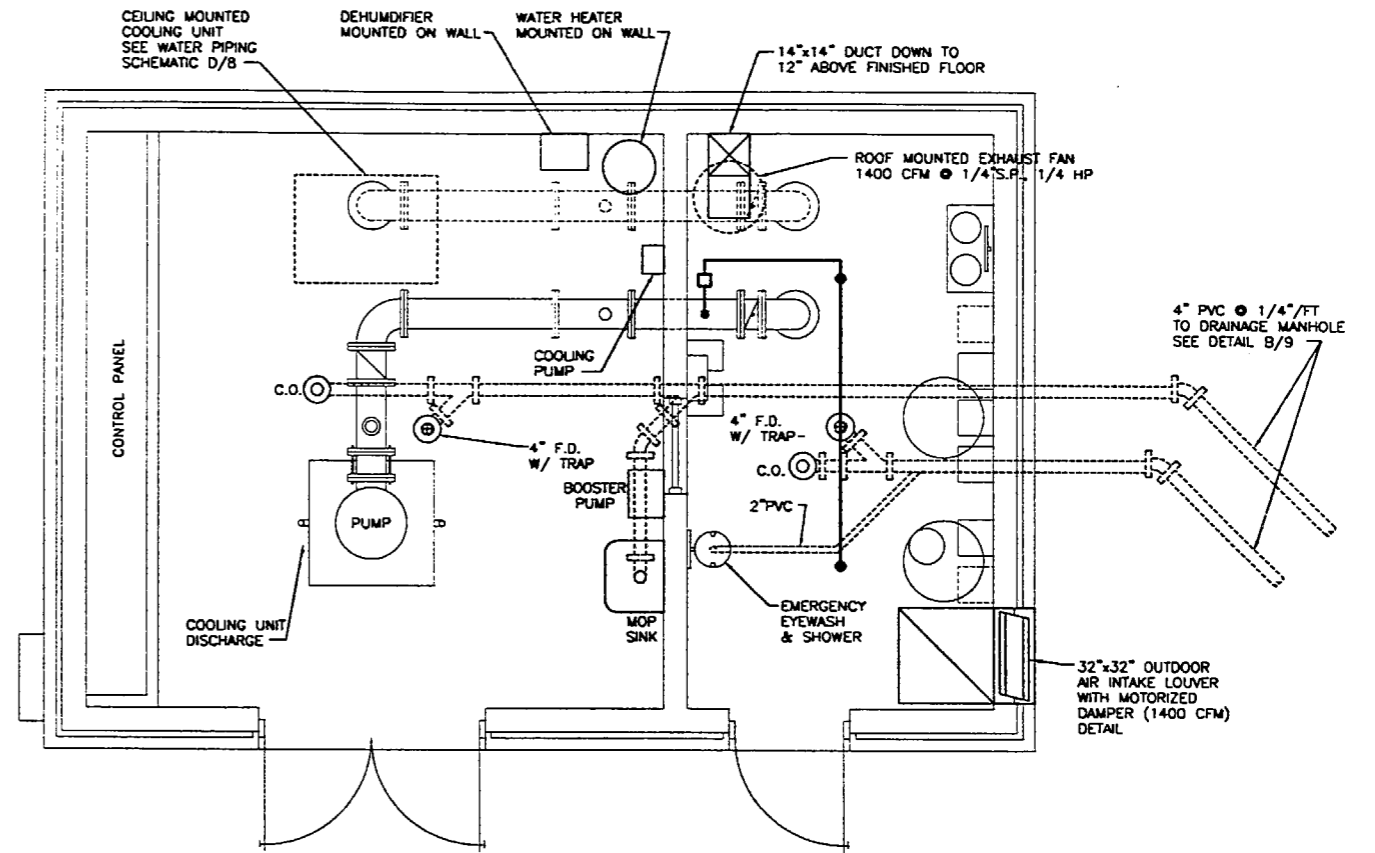


MECHANICAL FLOOR PLAN

0 1 2 3
SCALE IN FEET

NOTE:

1. ALL DUCT WORK IN CHLORINE ROOM TO BE ALUMINUM CONSTRUCTION.
2. SPRINKLER SYSTEM - ORDINARY HAZARD (GROUP 2) PROVIDE 1 1/2" TAP SHUT OFF VALVE, FLOW INDICATOR AND TWO SPRINKLER HEADS.

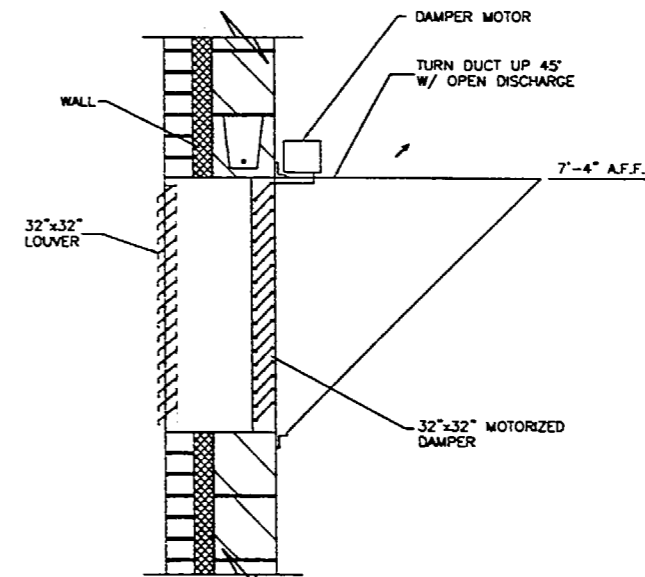


OUTSIDE AIR INTAKE LOUVER SECTION

NO SCALE


DATE					
REVISION					
SURVEY	DATE	BY	DATE	BY	DATE
DRAWN					
DESIGNED					
APPROVED					
DATE	11/09	REG. NO.	11099	DATE	4/30/10
I HEREBY CERTIFY THAT THIS PLAN WAS PREPARED BY ME OR UNDER MY SUPERVISION AND THAT I AM AN ENGINEER REGISTERED AND LICENSED UNDER THE LAWS OF THE STATE OF MINNESOTA.					
© BONESTROO, ROSENE, ANDERLIK & ASSOCIATES, INC. 1916					
Engineers & Architects					
Bl. Paul • Milwaukee					
Bonestroo Rosene Anderslik & Associates					
RAMSEY, MINNESOTA WELL NO.3 PUMPING FACILITY MECHANICAL FLOOR PLAN AND ELEVATION					
RECORD DRAWING					
SHEET 6 OF 11					

RECORD DRAWING

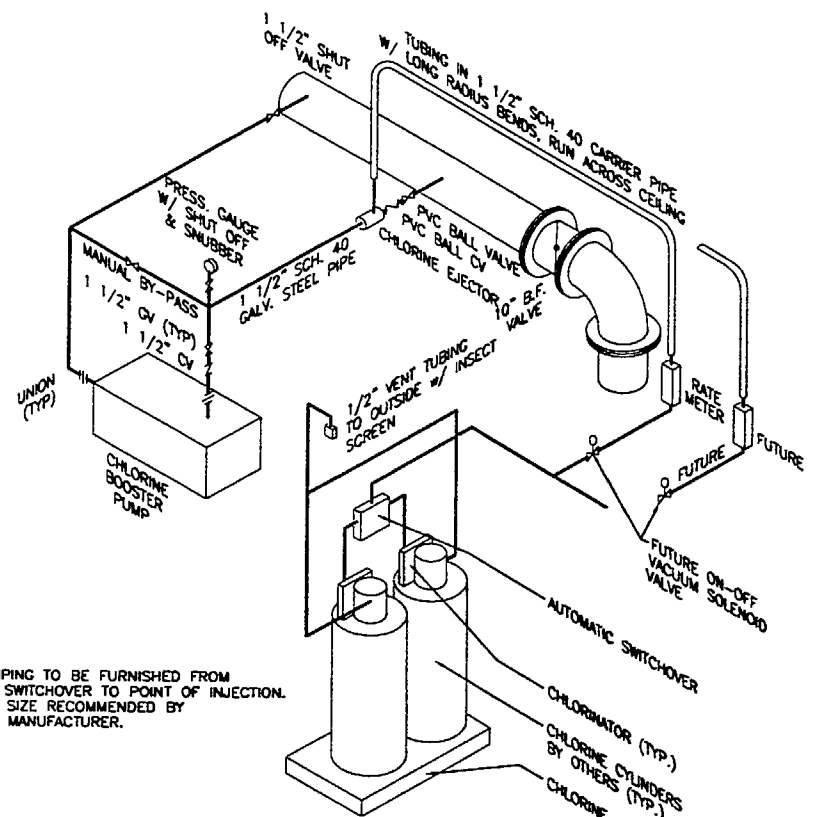


NOTE:
 1. CARRIER PIPING TO BE FURNISHED FROM AUTOMATIC SWITCHOVER TO POINT OF INJECTION.
 2. TUBING OF SIZE RECOMMENDED BY EQUIPMENT MANUFACTURER.

A CHLORINATION SCHEMATIC
 NOT TO SCALE

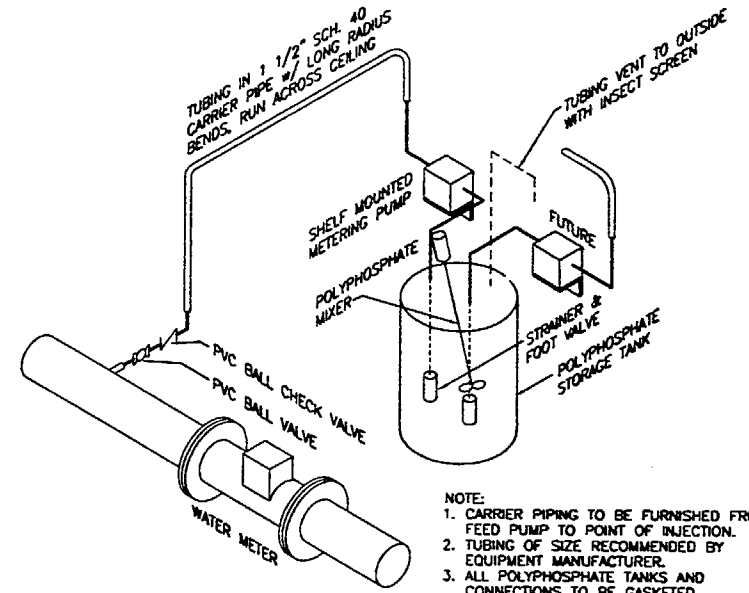


NOTE:
 1. CARRIER PIPING TO BE FURNISHED FROM FEED PUMP TO POINT OF INJECTION.
 2. TUBING OF SIZE RECOMMENDED BY EQUIPMENT MANUFACTURER.
 3. ALL POLYPHOSPHATE TANKS AND CONNECTIONS TO BE GASKETED.

B POLYPHOSPHATE SCHEMATIC
 NOT TO SCALE

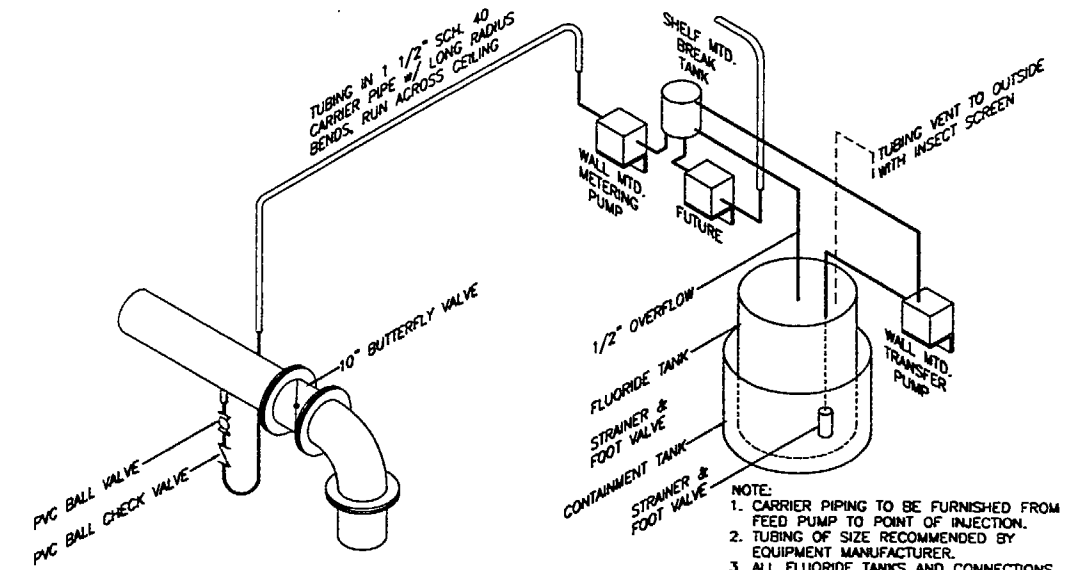


NOTE:
 1. CARRIER PIPING TO BE FURNISHED FROM FEED PUMP TO POINT OF INJECTION.
 2. TUBING OF SIZE RECOMMENDED BY EQUIPMENT MANUFACTURER.
 3. ALL FLUORIDE TANKS AND CONNECTIONS TO BE GASKETED.

C FLUORIDE SCHEMATIC
 NOT TO SCALE

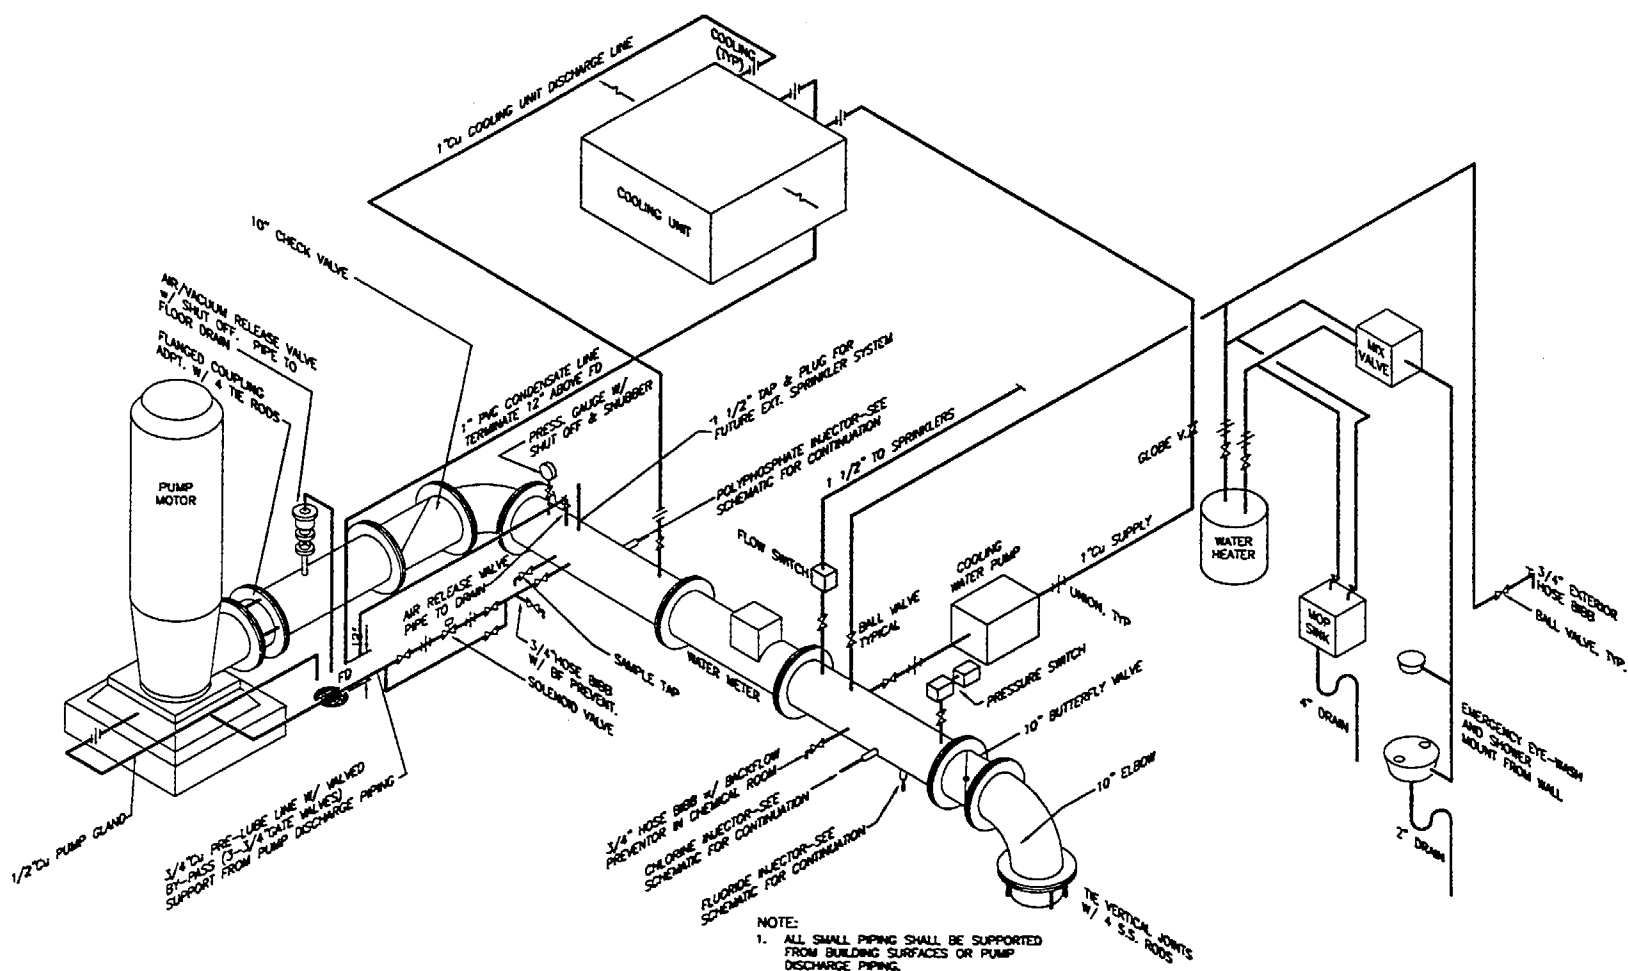

NOTE:
 1. ALL SMALL PIPING SHALL BE SUPPORTED FROM BUILDING SURFACES OR PUMP DISCHARGE PIPING.
 2. SMALL PIPING SHALL NOT BE RUN ACROSS FLOORS.
 3. SMALL PIPING SHALL FOLLOW BUILDING LINES OR PUMP DISCHARGE PIPING.


D WATER PIPING DIAGRAM
 NO SCALE

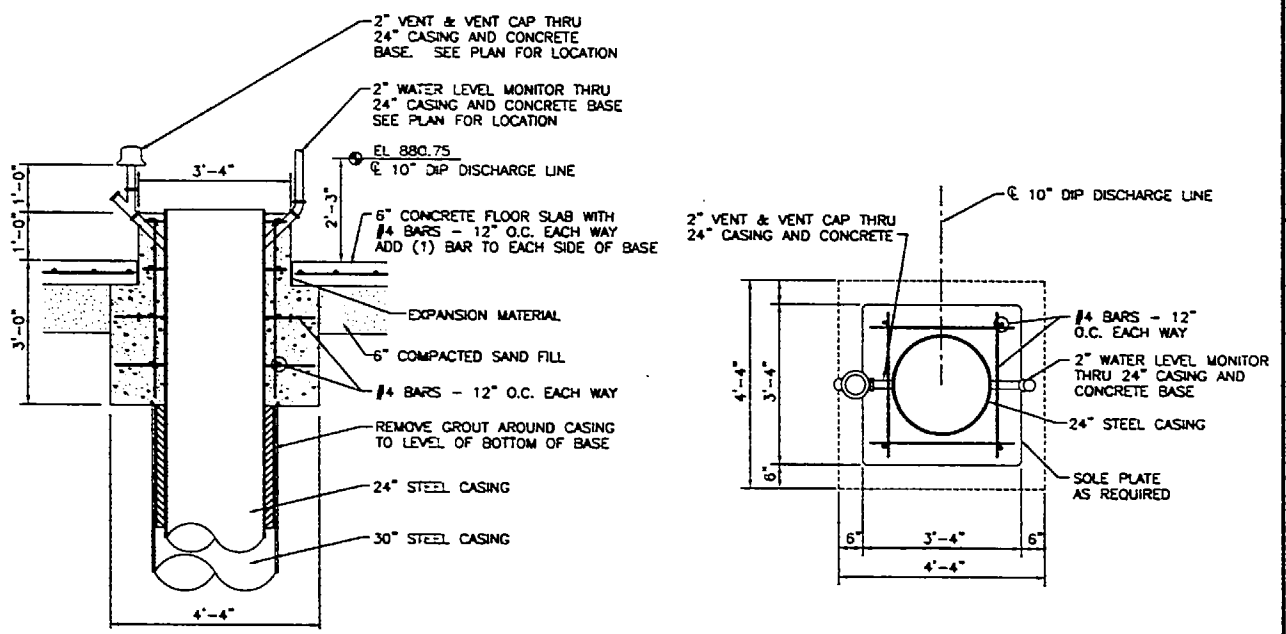


NOTE:
 1. ALL EXPOSED EDGES OF PUMP BASE SHALL HAVE 3/4" CHAMFER.
 2. ALL EXPOSED SURFACES OF PUMP BASE SHALL BE FILLED AND RUBBED.
 3. 2" CASING CONNECTIONS SHALL BE SCH. 40 GALV. STEEL.
 4. WELD 2" CASING CONNECTIONS TO THE CASING AND GRIND INTERIOR SURFACE SMOOTH.
 5. CUT OFF CASING AS REQUIRED TO PROVIDE A 1" PROJECTION INTO PUMP DISCHARGE HEAD.
 6. PROVIDE SOLE PLATE, IF REQUIRED, AND GROUT TO SET PUMP DISCHARGE HEAD TO THE ELEVATION SHOWN.

E PUMP BASE DETAIL
 SCALE IN FEET


DATE	REVISION	DESIGNED	DRAWN	APPROVED	DATE	COMPL.
		LHK	DJK	RWF	4.30.03	4.30.03
I HEREBY CERTIFY THAT THIS PLAN WAS PREPARED BY ME OR UNDER MY DIRECT SUPERVISION AND THAT I AM A DULY REGISTERED PROFESSIONAL ENGINEER UNDER THE LAWS OF THE STATE OF MINNESOTA.						
DATE	REQ. NO.	REG. NO.	11809			
© BONESTROO, ROSENE, ANDERLIK & ASSOCIATES, INC. 1998						
Engineers & Architects						
Bi. Paul • Milwaukee						
Bonestroo Rosene Anderlik & Associates						
RAMSEY, MINNESOTA WELL NO.3 PUMPING FACILITY PIPING SCHEMATICS AND DETAILS						
SHEET	8	OF	11	43803		

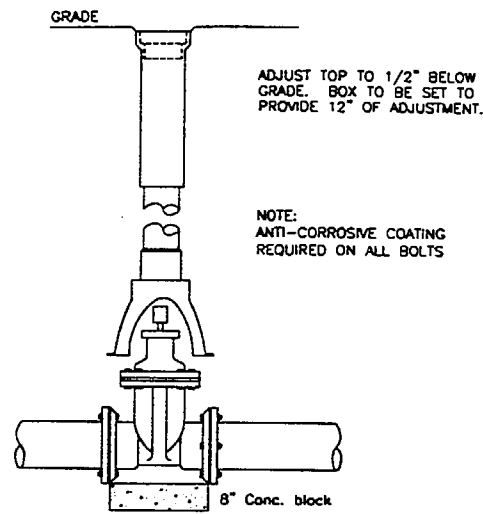


A VALVE AND BOX DETAIL
NO SCALE

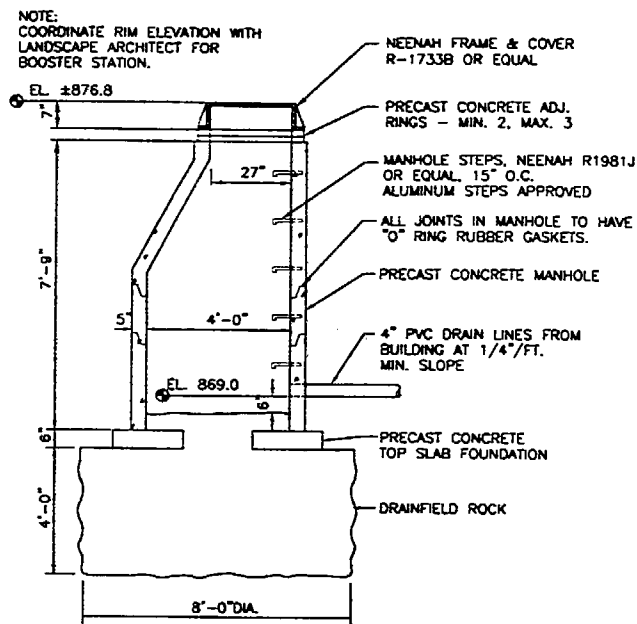

B DRAINAGE MANHOLE DETAIL
NO SCALE

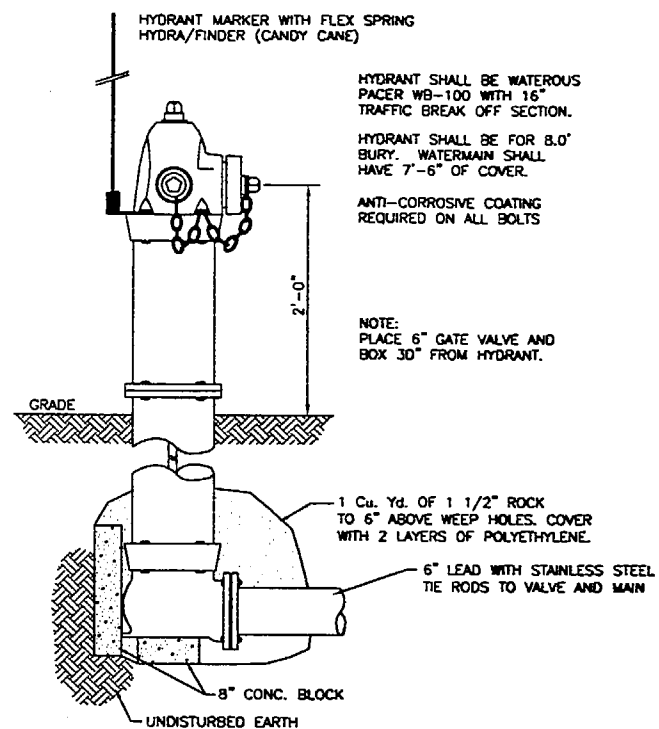

C HYDRANT INSTALLATION
NO SCALE


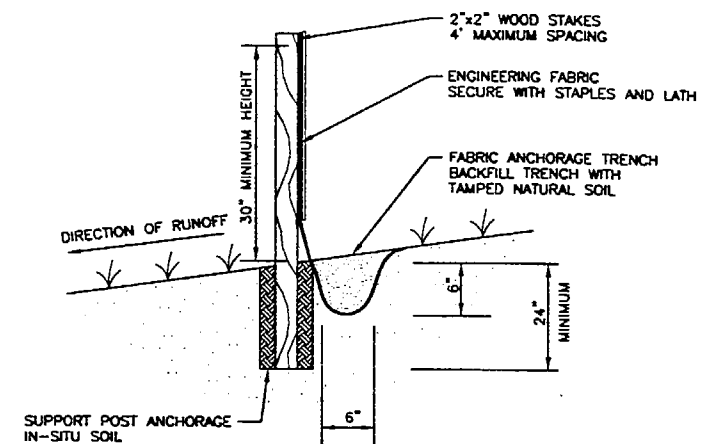


D EROSION CONTROL DETAIL
NO SCALE


NOTE:

1. SHAPE OF BACK OF BUTTRESS MAY VARY AS LONG AS POUR IS AGAINST FIRM UNDISTURBED EARTH.
2. DIMENSION "A" SHOULD BE AS LARGE AS POSSIBLE.
3. PLAN FOR 45°-90° BENDS & SECTION A-A SHALL APPLY TO TEES.

PIPE SIZE	BUTTRESS DIMENSIONS					
	22 1/2° BEND		45° BEND		90° BEND	
	E1	D1	B2	D2	B3	D3
6"	1'-5"	1'-5"	1'-5"	1'-5"	2'-1"	1'-6"
8"	1'-5"	1'-5"	2'-1"	1'-6"	2'-8"	2'-0"
10"	1'-8"	1'-8"	2'-11"	1'-10"	4'-0"	2'-4"
12"	1'-10"	1'-10"	3'-4"	2'-0"	4'-9"	2'-6"
16"	3'-0"	2'-0"	3'-10"	3'-0"	6'-2"	3'-6"
18"	3'-3"	2'-4"	4'-6"	3'-4"	7'-0"	4'-0"
20"	3'-6"	2'-8"	5'-6"	3'-4"	8'-4"	4'-0"
24"	4'-4"	3'-0"	6'-10"	3'-10"	9'-8"	5'-0"

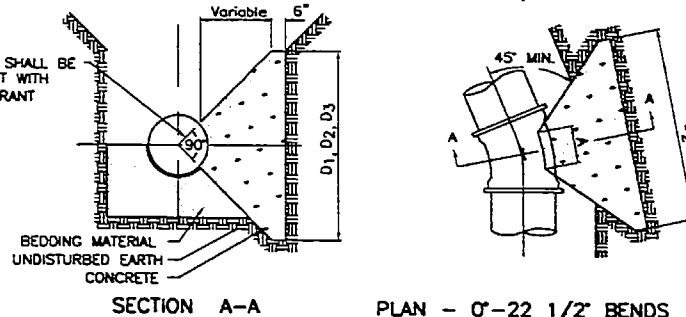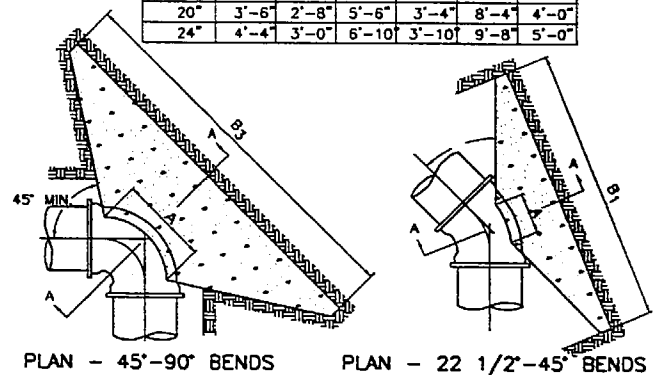


F THRUST BLOCKING DETAIL
NO SCALE

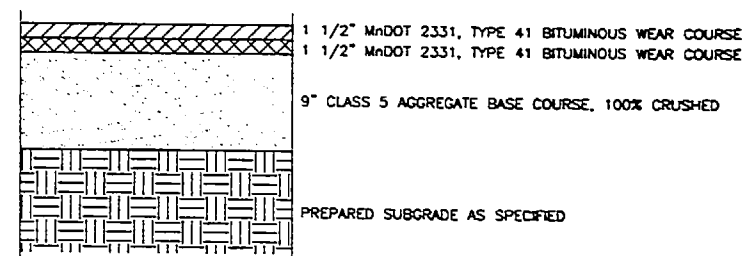

NOTE: THICKNESS INDICATED SHALL BE FINAL THICKNESS AFTER COMPACTION.

E BITUMINOUS DRIVE SECTION
SCALE IN FEET

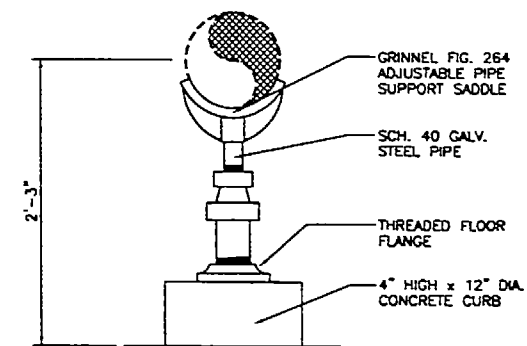

G PIPE SUPPORT DETAIL
NO SCALE

Engineers & Architects

Bonestroo
Rosene
Anderlik &
Associates

81. Paul • Milwaukee

RAMSEY, MINNESOTA
WELL NO.3 PUMPING FACILITY

DETAILS

RECORD DRAWING

DATE

REVISION

SURVEY

DRAWN

DESIGNED

APPROVED

DATE

EDWARD

43803

11609


REG. NO. 11609

© BONESTROO, ROSENE, ANDERLIK & ASSOCIATES, INC. 1996


43803.DWG

9 11


CONTROL SCHEMATIC FOR EXTERIOR LIGHT

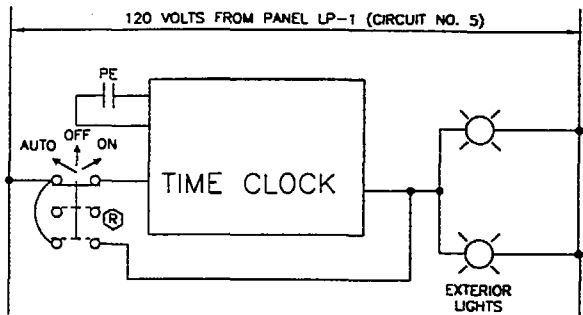

CONTROL SCHEMATIC FOR CHLORINE BOOSTER PUMP

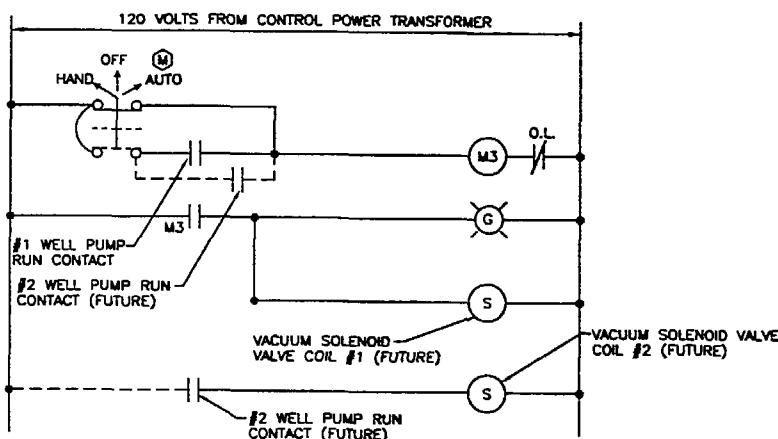


CONTROL SCHEMATIC FOR WELL NO.3 POLYPHOSPHATE DRUM MIXER

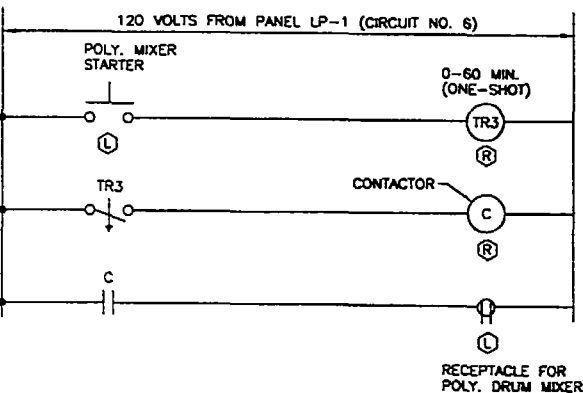


- NOTES:**
- (R) = IN OR ON THE TERMINAL COMPARTMENT
 - (L) = LOCAL
 - (M) IN OR ON THE MOTOR CONTROL CENTER


TYPICAL CONTROL SCHEMATIC FOR POLYPHOSPHATE PUMP #1

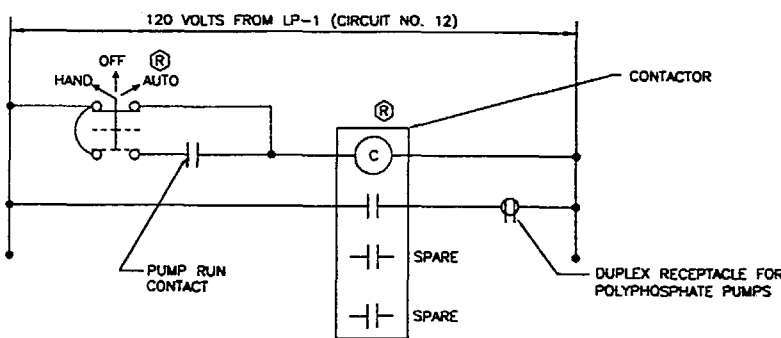


TYPICAL CONTROL SCHEMATIC FOR FUTURE POLYPHOSPHATE PUMP #2

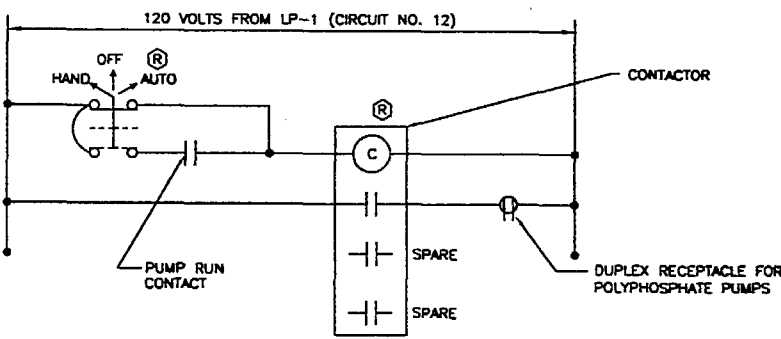


CONTROL SCHEMATIC FOR FLUORIDE PUMPS #1 & #2 AND FLUORIDE TRANSFER PUMP

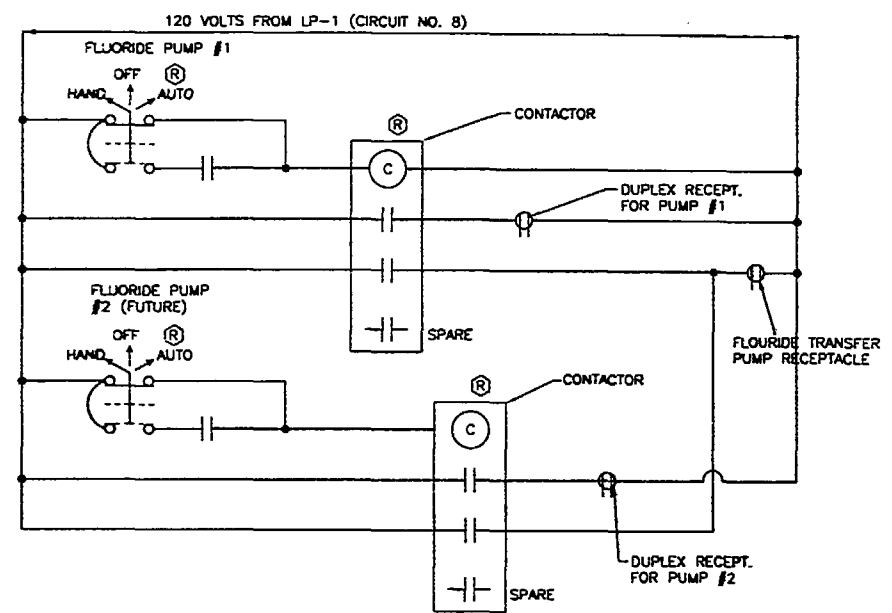

CONTROL SCHEMATIC FOR COOLING UNIT FAN

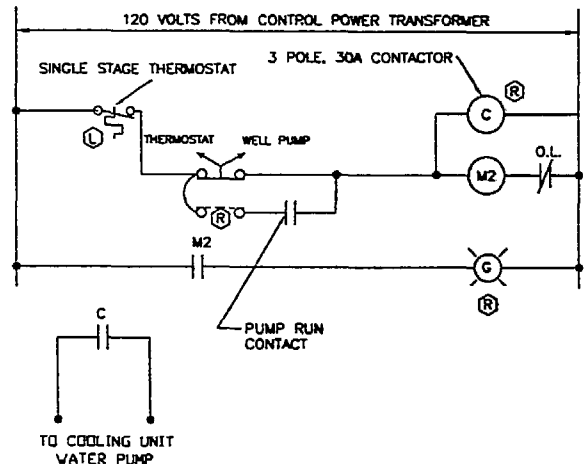

CONTROL SCHEMATIC FOR COOLING UNIT WATER PUMP

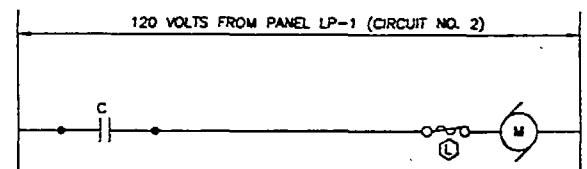

ELECTRICAL SYMBOLS

ONE-LINE DIAGRAM SYMBOLS	CONTROL SCHEMATIC SYMBOLS	ELECTRICAL PLAN SYMBOLS
DRAW-OUT UNIT	PUSHBUTTON	EMERGENCY BALLAST
CONTROL TRANSFORMER AND FUSES	THREE-POSITION SELECTOR SWITCH	FUTURE TYPE FLUORESCENT FIXTURE
STARTER SIZE	LIMIT SWITCH	SWITCH LOCATION
AUXILIARY CONTACT	OPEN SW. WITH TIME DELAY CLOSING	MOUNTING HT.
NUMBER OF CONTROL CIRCUIT COILS ALL #14 UNLESS OTHERWISE SPECIFIED	CLOSED SW. WITH TIME DELAY OPENING	RACK MOUNTED UNIT (NO SYMBOL - CEILING MOUNT)
REMOTE CONTROL DEVICE	OPEN SW. WITH TIME DELAY OPENING	EXIT LIGHT
CIRCUIT BREAKER	CLOSED SW. WITH TIME DELAY CLOSING	INDICATES ARROW DIRECTION (OF ART) FACED ON WHICH LETTERING APPEARS
SINGLE THROW DISC. SW. SWITCH AND FUSE	FLOW SWITCH	WEATHERPROOF
CURRENT TRANSFORMER	LEVEL SWITCH	DUPLEX RECEPTACLE
POTENTIAL TRANSFORMER	PRESSURE SWITCH	CIRCUIT NUMBER
LIGHTNING ARRESTER	TEMPERATURE SWITCH	GROUND FAULT TYPE
TRANSFORMER	NORMALLY OPEN CONTACTS	WELDING RECEPTACLE
KEY INTERLOCK	NORMALLY CLOSED CONTACTS	3-PHASE RECEPTACLE
CAPACITOR	INDICATING LIGHT	SPECIAL PURPOSE RECEPTACLE
RELAY (* RELAY NO.)	PUSH TO TEST INDICATING LIGHT	JUNCTION BOX
SURGE SUPPRESSOR	CONTROL SYSTEM OUTPUT	SINGLE POLE SWITCH
AMMETER	TIMING RELAY	SWITCHING LOCATION
DEMAND METER	RELAY	DOUBLE POLE SWITCH
POWER FACTOR METER	SOLENOID	THREE-WAY SWITCH
VOLTMETER	MANUAL STARTER	FOUR-WAY SWITCH
WATT-HOUR METER	STARTER COIL & OVERLOAD CONTACTS	AUTOMATIC DOOR SWITCH
CONTACTOR	GROUND	KEY OPERATED SWITCH
	CONTROL CIRCUIT TRANSFORMER	SWITCH AND PILOT LIGHT
		TELEPHONE OUTLET
		COMPUTER OUTLET
		LIGHTING PANEL
		TERMINAL CABINET
		EXPOSED CONDUIT
		UNDERGROUND OR UNDERFLOOR CONDUIT
		SOLENOID
		LEVEL SWITCH
		MANUAL STARTER
		DOOR CONTACT
		PILOT LIGHT
		LIMIT SWITCH
		FLOOD FLOAT SWITCH
		PRESSURE SWITCH
		TEMPERATURE SWITCH
		SPEED SWITCH
		BELL
		BUZZER
		HORN
		DOOR HOLDER
		SMOKE DETECTOR
		SMOKE DETECTOR IN DUCT
		GLASS BREAK DETECTOR
		INTRUSION DETECTOR
		LOCAL DISCONNECT SWITCH
		MOTOR
		FRACTIONAL HP MOTOR
		PUSHBUTTON WITH ILLUMINATED STOP
		SELECTOR SWITCH WITH INDICATING LIGHT
		DAMPER OPERATOR
		PUSHBUTTON STATION
		SELECTOR SWITCH

1. HEREBY CERTIFY THAT THIS PLAN WAS PREPARED BY ME OR UNDER MY DIRECT SUPERVISION AND THAT I AM A LICENSED PROFESSIONAL ENGINEER UNDER THE LAWS OF THE STATE OF MINNESOTA.

DATE: 10/2/98 REG. NO.: 7588
 © BONESTROD, ROSENE, ANDERLIK & ASSOCIATES, INC. 1998 COLM. 43803

Engineers & Architects
**Bonestrood
 Rosene
 Anderlik &
 Associates**
 61. Paul • Milwaukee

**RAMSEY, MINNESOTA
 WELL NO.3 PUMPING FACILITY**

ELECTRICAL DETAILS

RECORD DRAWING

SHEET 11 OF 11

101596