


7550 Sunwood Drive NW.
 Ramsey, MN 55303
 763-433-9850 - Phone
 763-433-9848 - Fax

RECEIVED
 JUN 07 2017
 BY: 34880

ONSITE SEWAGE TREATMENT AS-BUILT DRAWING

PERMIT # RA034880 DATE 6-7-17
 ADDRESS 17650 Argon St. NW PIN/PID NO. 01-32-25-31-0017
 CONTRACTOR Casper's Excavating LIC. NO. 265 PHONE NO. 763-434-3618
 DESIGNER Casper's Excavating Inc. PHONE NO. 763-434-3618
 TANK SIZE(S) 1500 gal. 2 comp. 1000 lift NO. OF TANKS 2
 TANK MANUFACTURER Knife River TANK MATERIAL: PRECAST / FIBERGLASS / PLASTIC
 TYPE OF DRAINFIELD Pressure Bed
 S.F. OF DRAINFIELD 1000 NO. OF DRAINFIELD RUNS 6
 DEPTH OF DIRT OVER DRAINFIELD 3" DEPTH OF ROCK UNDER TRENCH 6"
 DEPTH OF ROCK OVER PIPE 2" TOTAL DEPTH OF TRENCH 20"
 NUMBER OF BEDROOMS 4 WHIRLPOOL: YES/NO GARBAGE DISPOSAL: YES/NO
 MOUND SYSTEM: YES/NO GEOTEXTILE: YES/NO SCHEDULE 40: YES/NO

Show well location and distance from septic tank, easements, and property lines.

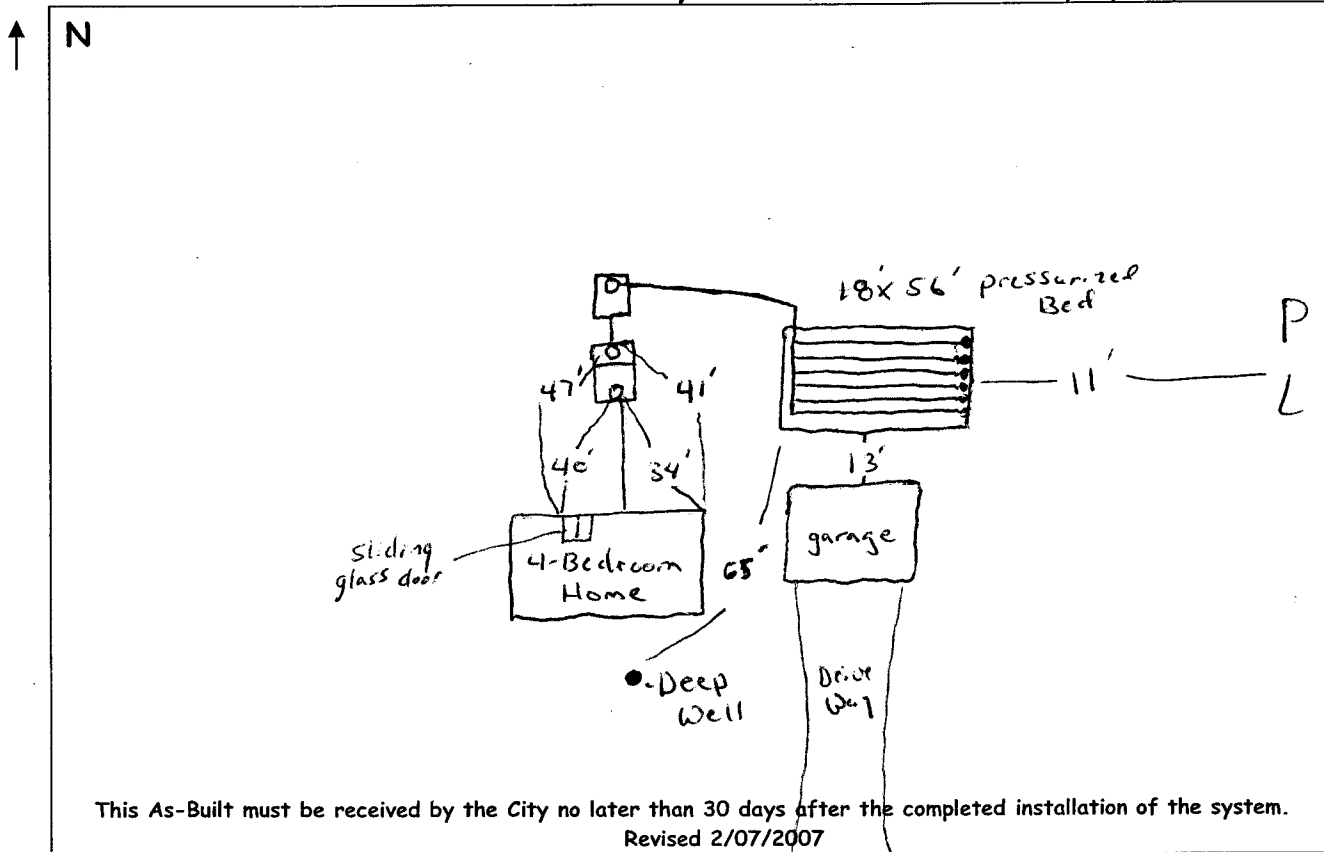

This As-Built must be received by the City no later than 30 days after the completed installation of the system.
 Revised 2/07/2007

NOTE: An electrical permit is required for all electrical connections.

Argon St. NW

Distance from BM To:
 Limiting Layer _____
 Bottom Rock Bed _____