


MUNICIPAL LANDSCAPE REQUIREMENTS

1. PARKING LOT REQUIREMENT
 - 1.1. TREES REQUIRED: 5
 - 1.2. TREES PROPOSED: 5
2. MITIGATION TREES
 - 2.1. PROPOSED: 15

PLANT SCHEDULE

SYMBOL	CODE	QTY	BOTANICAL NAME	COMMON NAME	CONT	CAL
OVERSTORY TREES						
	AR2	3	ACER RUBRUM 'RED ROCKET'	RED ROCKET MAPLE	B&B	2.5"
	AH	3	ALNUS HIRSUTA 'HARBIN'	PRAIRIE HORIZON® MANCHURIAN ALDER	B&B	2.5"
	GI	3	GLEDITSIA TRIACANTHOS INERMIS 'HARVE'	NORTHERN ACCLAIM® HONEY LOCUST	B&B	2.5"
	GD	3	GYMNOCLADUS DIOICA 'ESPRESSO'	KENTUCKY COFFEETREE	B&B	2.5"
	QE2	3	QUERCUS X 'CRIMSCHMIDT'	CRIMSON SPIRE™ OAK	B&B	2.5"
	TE	2	TILIA AMERICANA SENTRY	AMERICAN SENTRY LINDEN	B&B	2.5"
UNDERSTORY TREES						
	AG	3	AMELANCHIER X GRANDIFLORA 'AUTUMN BRILLIANCE'	AUTUMN BRILLIANCE SERVICEBERRY CLUMP	B&B	6' HT.

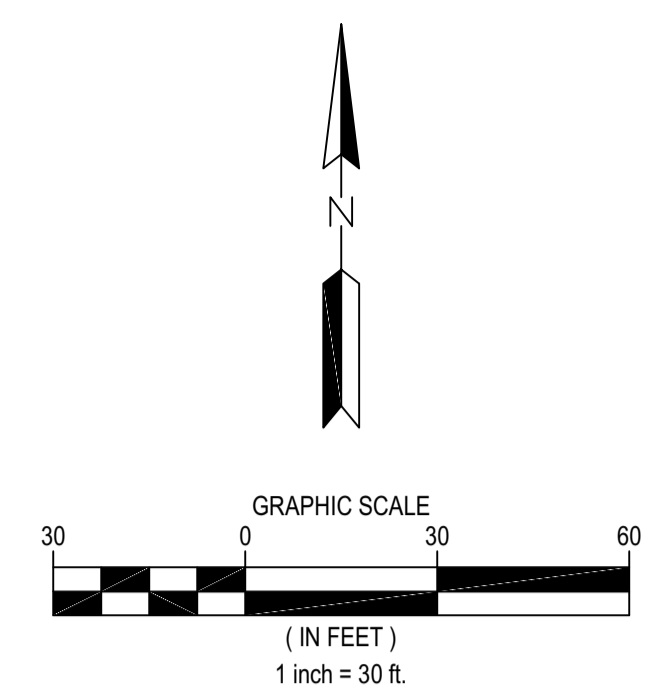

LEGEND

- PROPERTY BOUNDARY
- LOT LINE
- EASEMENT LINE
- SETBACK LINE
- RIGHT OF WAY LINE
- EXISTING EASEMENT LINE
- EXISTING PROPERTY LINE
- CURB AND GUTTER
- LOW MAINTENANCE TURF SOD SEE TURF RESTORATION NOTES
- WET DITCH SEED MIX
- MESIC SEED MIX



WARNING:
 THE CONTRACTOR SHALL BE RESPONSIBLE FOR CALLING FOR LOCATIONS OF ALL EXISTING UTILITIES. THEY SHALL COOPERATE WITH ALL UTILITY COMPANIES IN MAINTAINING THEIR SERVICE AND/OR RELOCATION OF LINES.

THE CONTRACTOR SHALL CONTACT GOPHER STATE ONE CALL AT 651-454-0002 AT LEAST 48 HOURS (EXCLUDING HOLIDAYS AND WEEKENDS) IN ADVANCE FOR THE LOCATIONS OF ALL UNDERGROUND WIRES, CABLES, CONDUITS, PIPES, MANHOLES, VALVES OR OTHER BURIED STRUCTURES BEFORE DIGGING. THE CONTRACTOR SHALL REPAIR OR REPLACE THE ABOVE WHEN DAMAGED DURING CONSTRUCTION AT NO COST TO THE OWNER.
 CALL BEFORE YOU DIG

GOPHER STATE ONE CALL
 TWIN CITY AREA: 651-454-0002
 TOLL FREE: 1-800-252-1166

Stantec
 733 MARQUETTE AVENUE
 SUITE 1000
 MINNEAPOLIS, MN 55402
 WWW.STANTEC.COM



CLIENT:
ACE SOLID WASTE - NATURAL GAS FUELING STATION
 RAMSEY, ANOKA COUNTY, MN 55303

PROJECT TITLE:	ACE SOLID WASTE - NATURAL GAS FUELING STATION	
ISSUE NO.:	0	1
DESCRIPTION:	SITE PLAN REVIEW SUBMITTAL CITY COMMENT REVISIONS	
DATE:	03/13/2026	04/09/2026
CERTIFICATION:	I HEREBY CERTIFY THAT THIS PLAN SPECIFICATION OR REPORT WAS PREPARED BY ME OR UNDER MY DIRECT SUPERVISION AND I AM A DULY LICENSED LANDSCAPE ARCHITECT UNDER THE LAWS OF THE STATE OF MINNESOTA.	
MARK & DRAWN BY:	MSF	
LIC. NO.:	56541	
DATE:	03/13/2026	
PROJECT NO.:		
DWN BY:	CHK'D BY:	APP'D BY:
MSF	JDR	MSF
ISSUE DATE:	04/09/2026	
ISSUE NO.:	1	
SHEET TITLE:	LANDSCAPE PLAN	
SHEET NO.:	L-101	

1 - Evergreens

Created by: Chris Anderson
On: 04/13/2026 12:27 PM

Per City Code Section 106-570 (d) (4), at least 25% of the plantings shall be be coniferous.
Please update the Plant Schedule so that the project includes not less than 25% deciduous or
25% coniferous plantings.

----- 0 Replies -----

