


8/2/2024 4:21:27 PM

FACTORY FORMED METAL CLOSURE @ HIGH EAVES 3

SCALE: N.T.S.

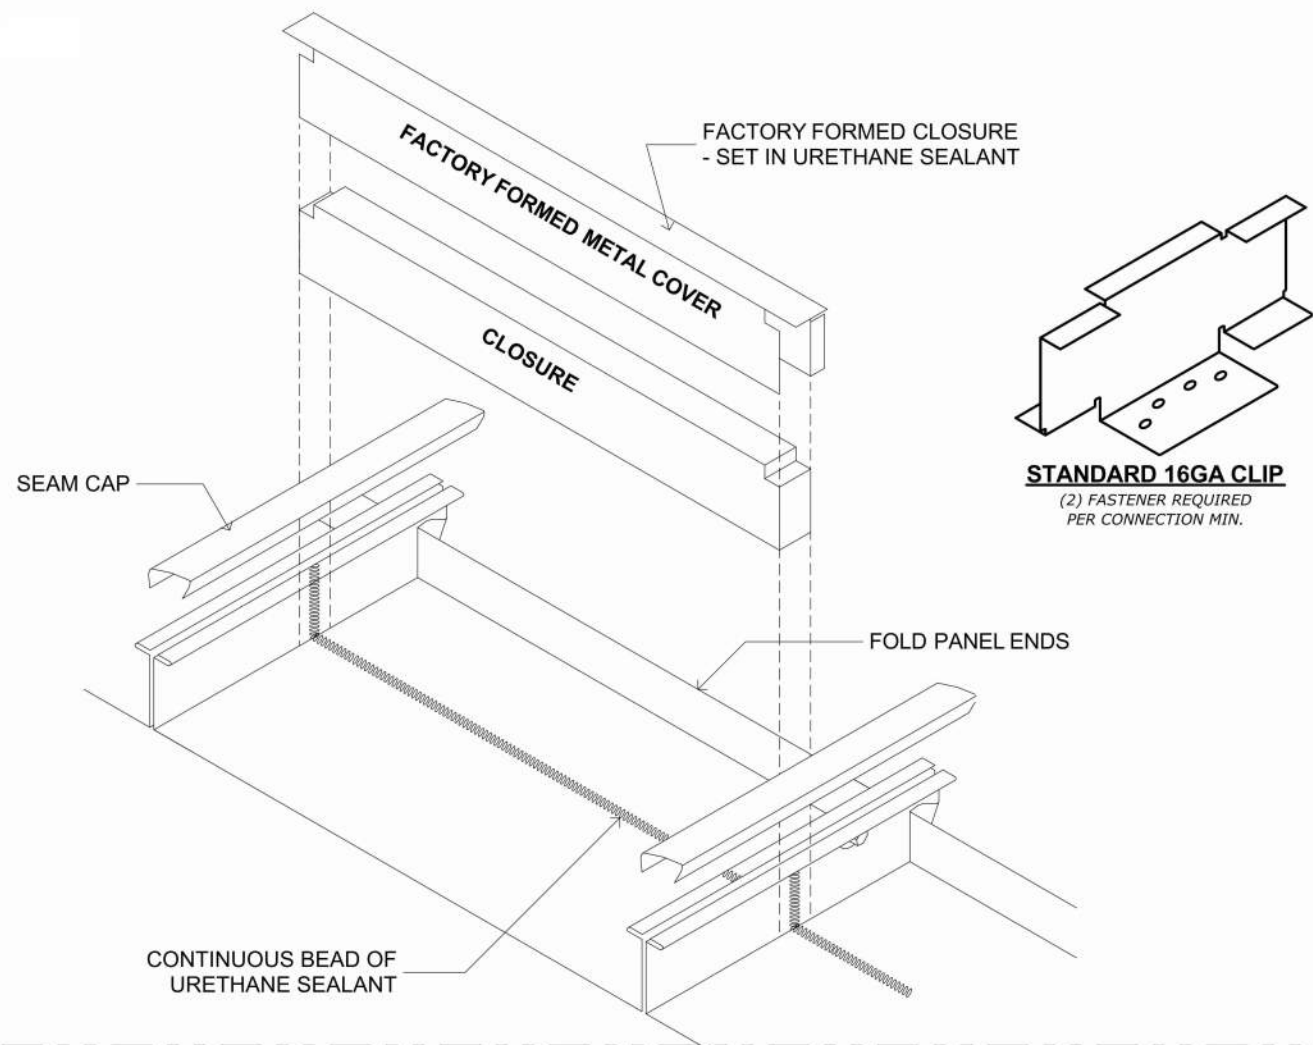


CONTINUOUS WOOD CAP FABRICATED OF 3/4" PLYWOOD FASER FASTENED TO 2x SOLID WOOD BLOCKING AND HORIZONTAL 2x STUDS @ 16" O.C. AND CUT TO PROVIDE THE REQUIRED SLOPE. GLUE AND FASTEN WOOD FRAMING TO EXISTING SOLID FRAMING WITH GALVANIZED STEEL ANGLES. ADJUST CAP HEIGHT AS REQUIRED TO PROVIDE MINIMUM FLASHING HEIGHTS AS PER MANUFACTURER'S INSTALLATION REQUIREMENTS. ANCHOR WOOD LOCKING TO EXISTING FRAMING AT 16" O.C.

- FILL ALL VOIDS BETWEEN RIBS WITH BATT OR RIGID INSULATION (TYP.)
- 24 GA. STAINLESS STEEL CLEATS - FASTEN @ 6" O.C.
- 2"x2" GALV. STEEL SUPPORT ANGLES @ 12" O.C. (TYP.)
- 1" FULLY SOLDERED STANDING SEAMS @ 48" O.C.
- 20 OZ. COPPER COPING w/FULLY SOLDERED SEAMS
- 2 x WOOD BLOCKING AS REQUIRED - CUT TO SIZE AND CONTINUOUS SHIMS AS REQUIRED TO PROVIDE SLOPES


- MATCH TOP'S HEIGHTS OF ADJACENT "ROOF-SIDE" FASCIA TRIM
- EXTEND BASE PLY & BASE FLASHING TO COVER OVER TOP OF PARAPET WALL & EXTEND BELOW HIGH-TEMPERATURE, SELF ADHERING UNDERLAYMENT.
- MATCH DRIP HEIGHTS OF ADJACENT "ROOF-SIDE" FASCIA TRIM
- 20 OZ. COPPER TWO-PIECE FASCIA w/ 24 GA. STAINLESS STEEL CLEATS - EXTEND BASE PLY & KEE/PVC ROOFING MEMBRANE OVER TOPS OR PARAPETS AND SELF-ADHERING UNDER-LAYMENT

- 20 OZ. COPPER FLASHING TRIM w/FULLY SOLDERED SEAMS
- 24 GA. STAINLESS STEEL CLEAT - FASTEN @ 6" O.C. (TYP.)

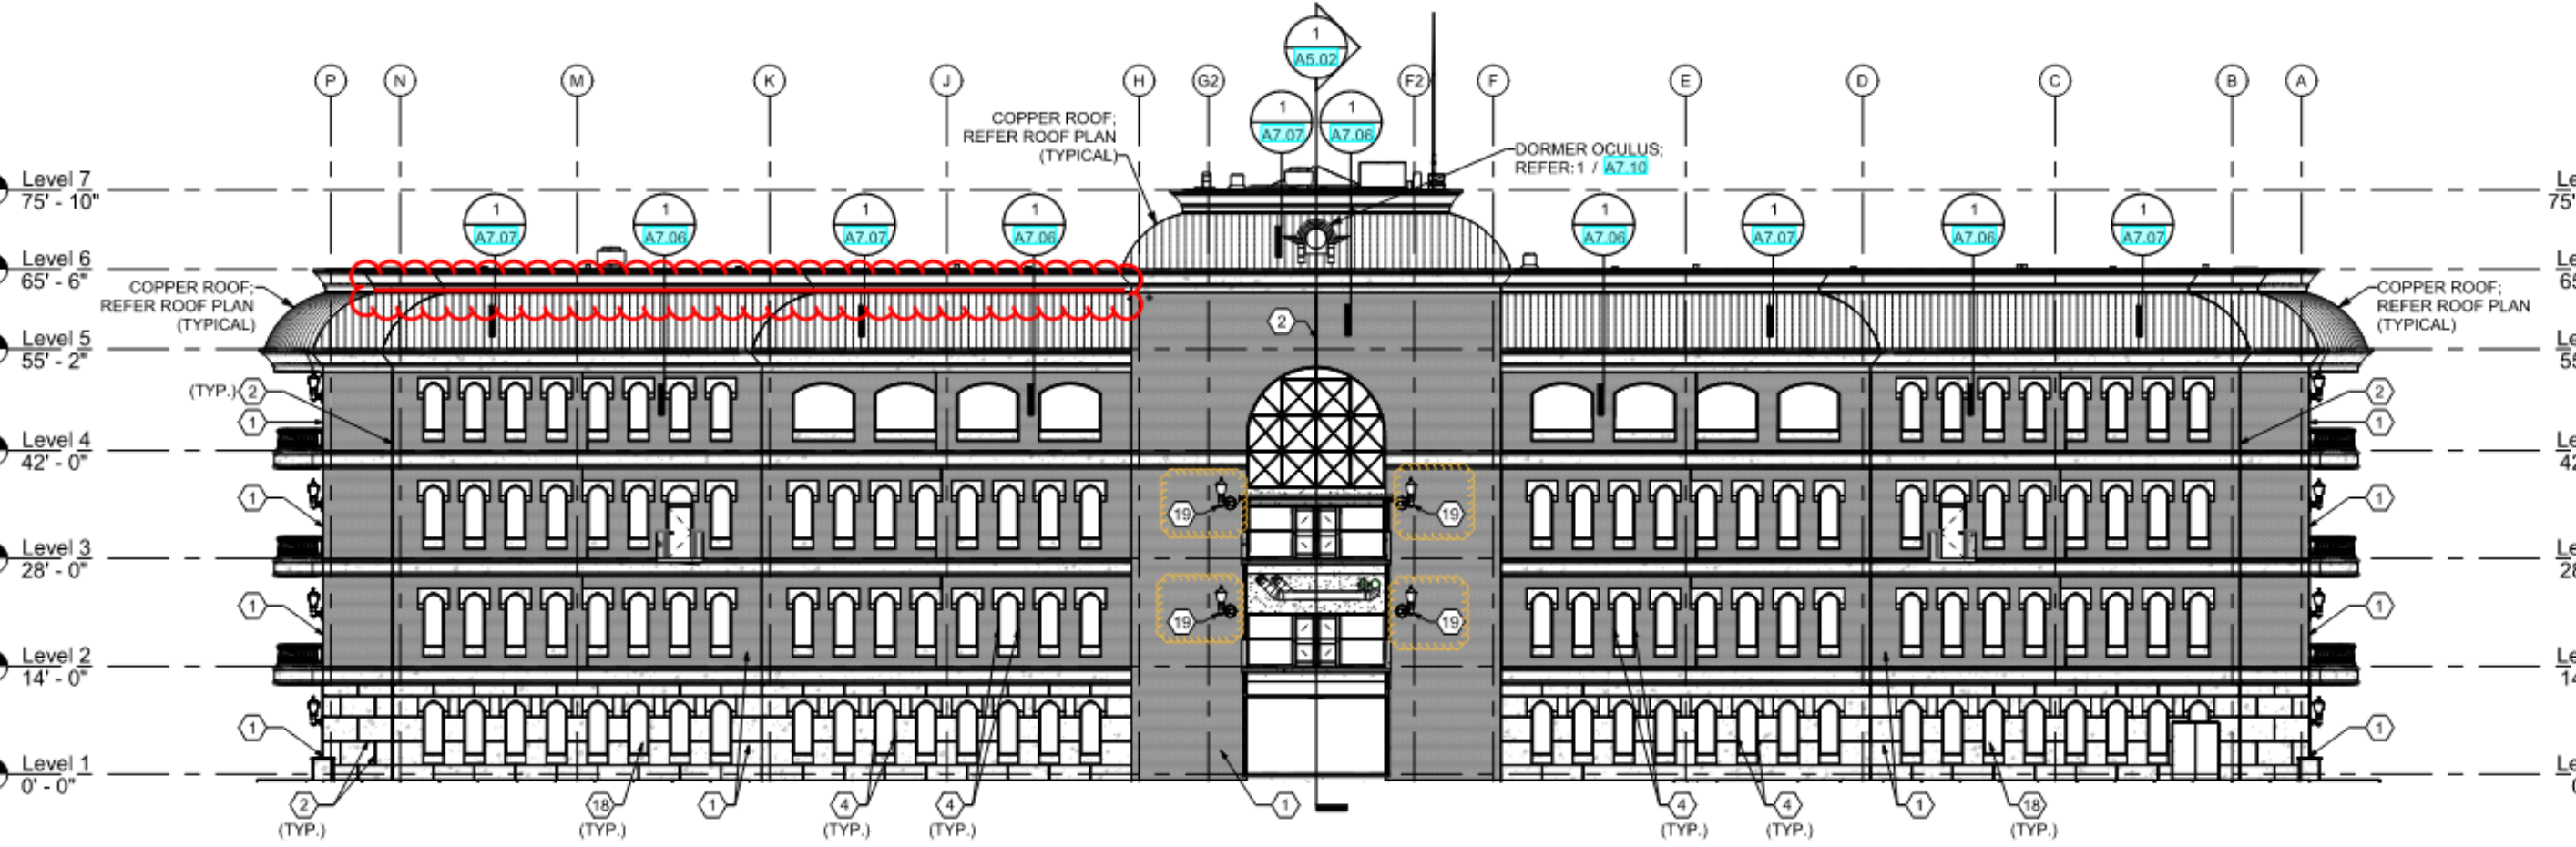

NORTH - BUILDING ELEVATION 2

SCALE: 1/16" = 1'-0"

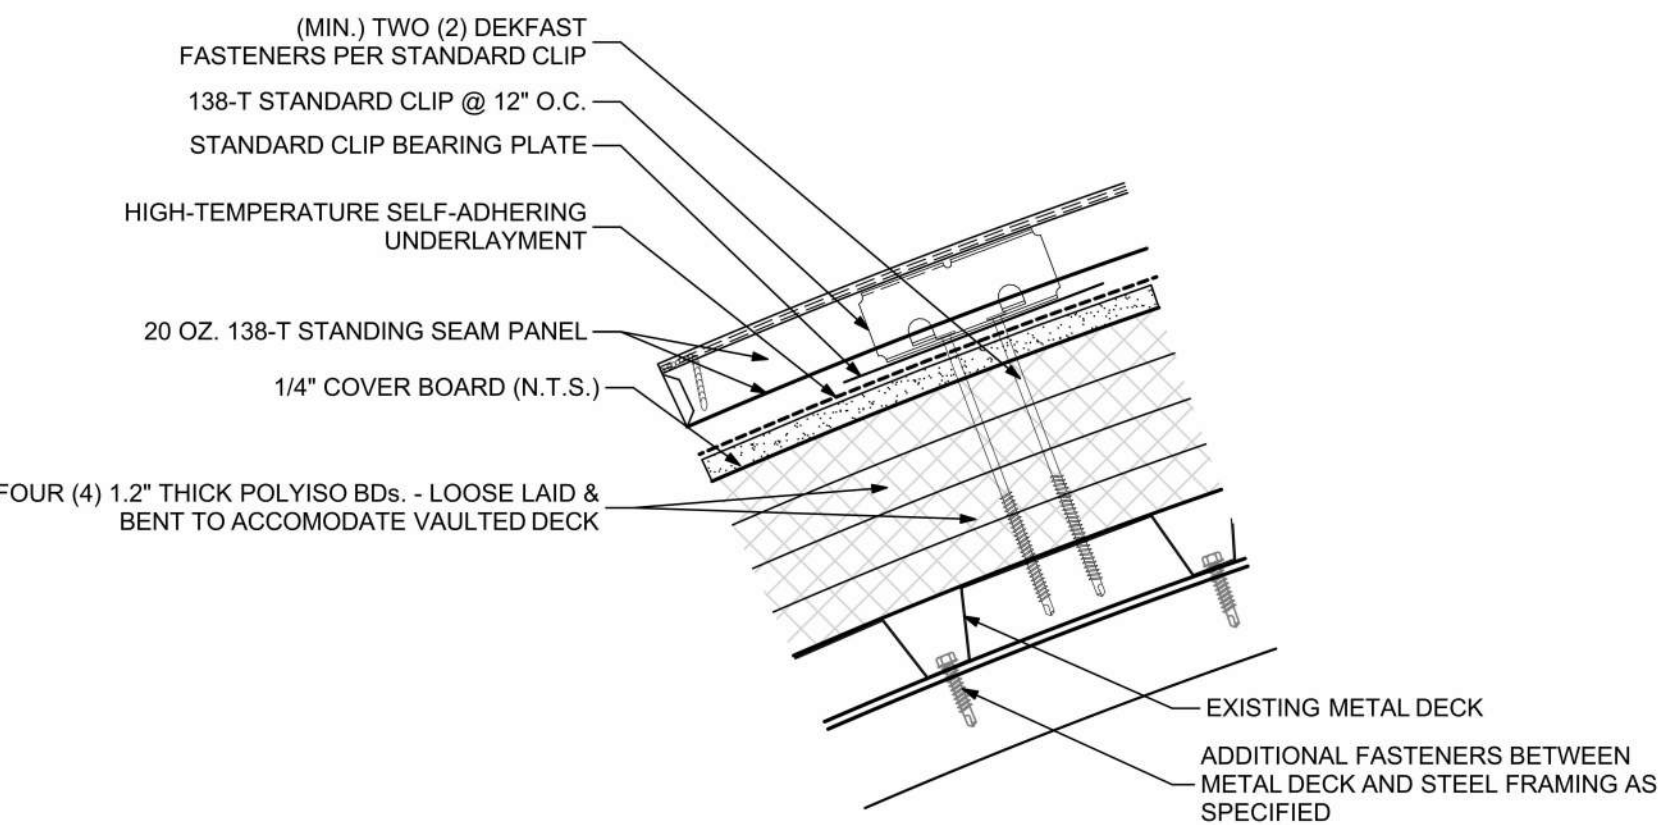

ALTERNATE No. 1 - ROOF SYSTEM PROFILE - COPPER ROOF


SCALE: 3" = 1'-0"

2

ALTERNATE No. 1 - SECTION DETAIL - PARAPET @ FRAMED COPPER CLADDED CORNICE (Level 6)

SCALE: 3" = 1'-0"


1

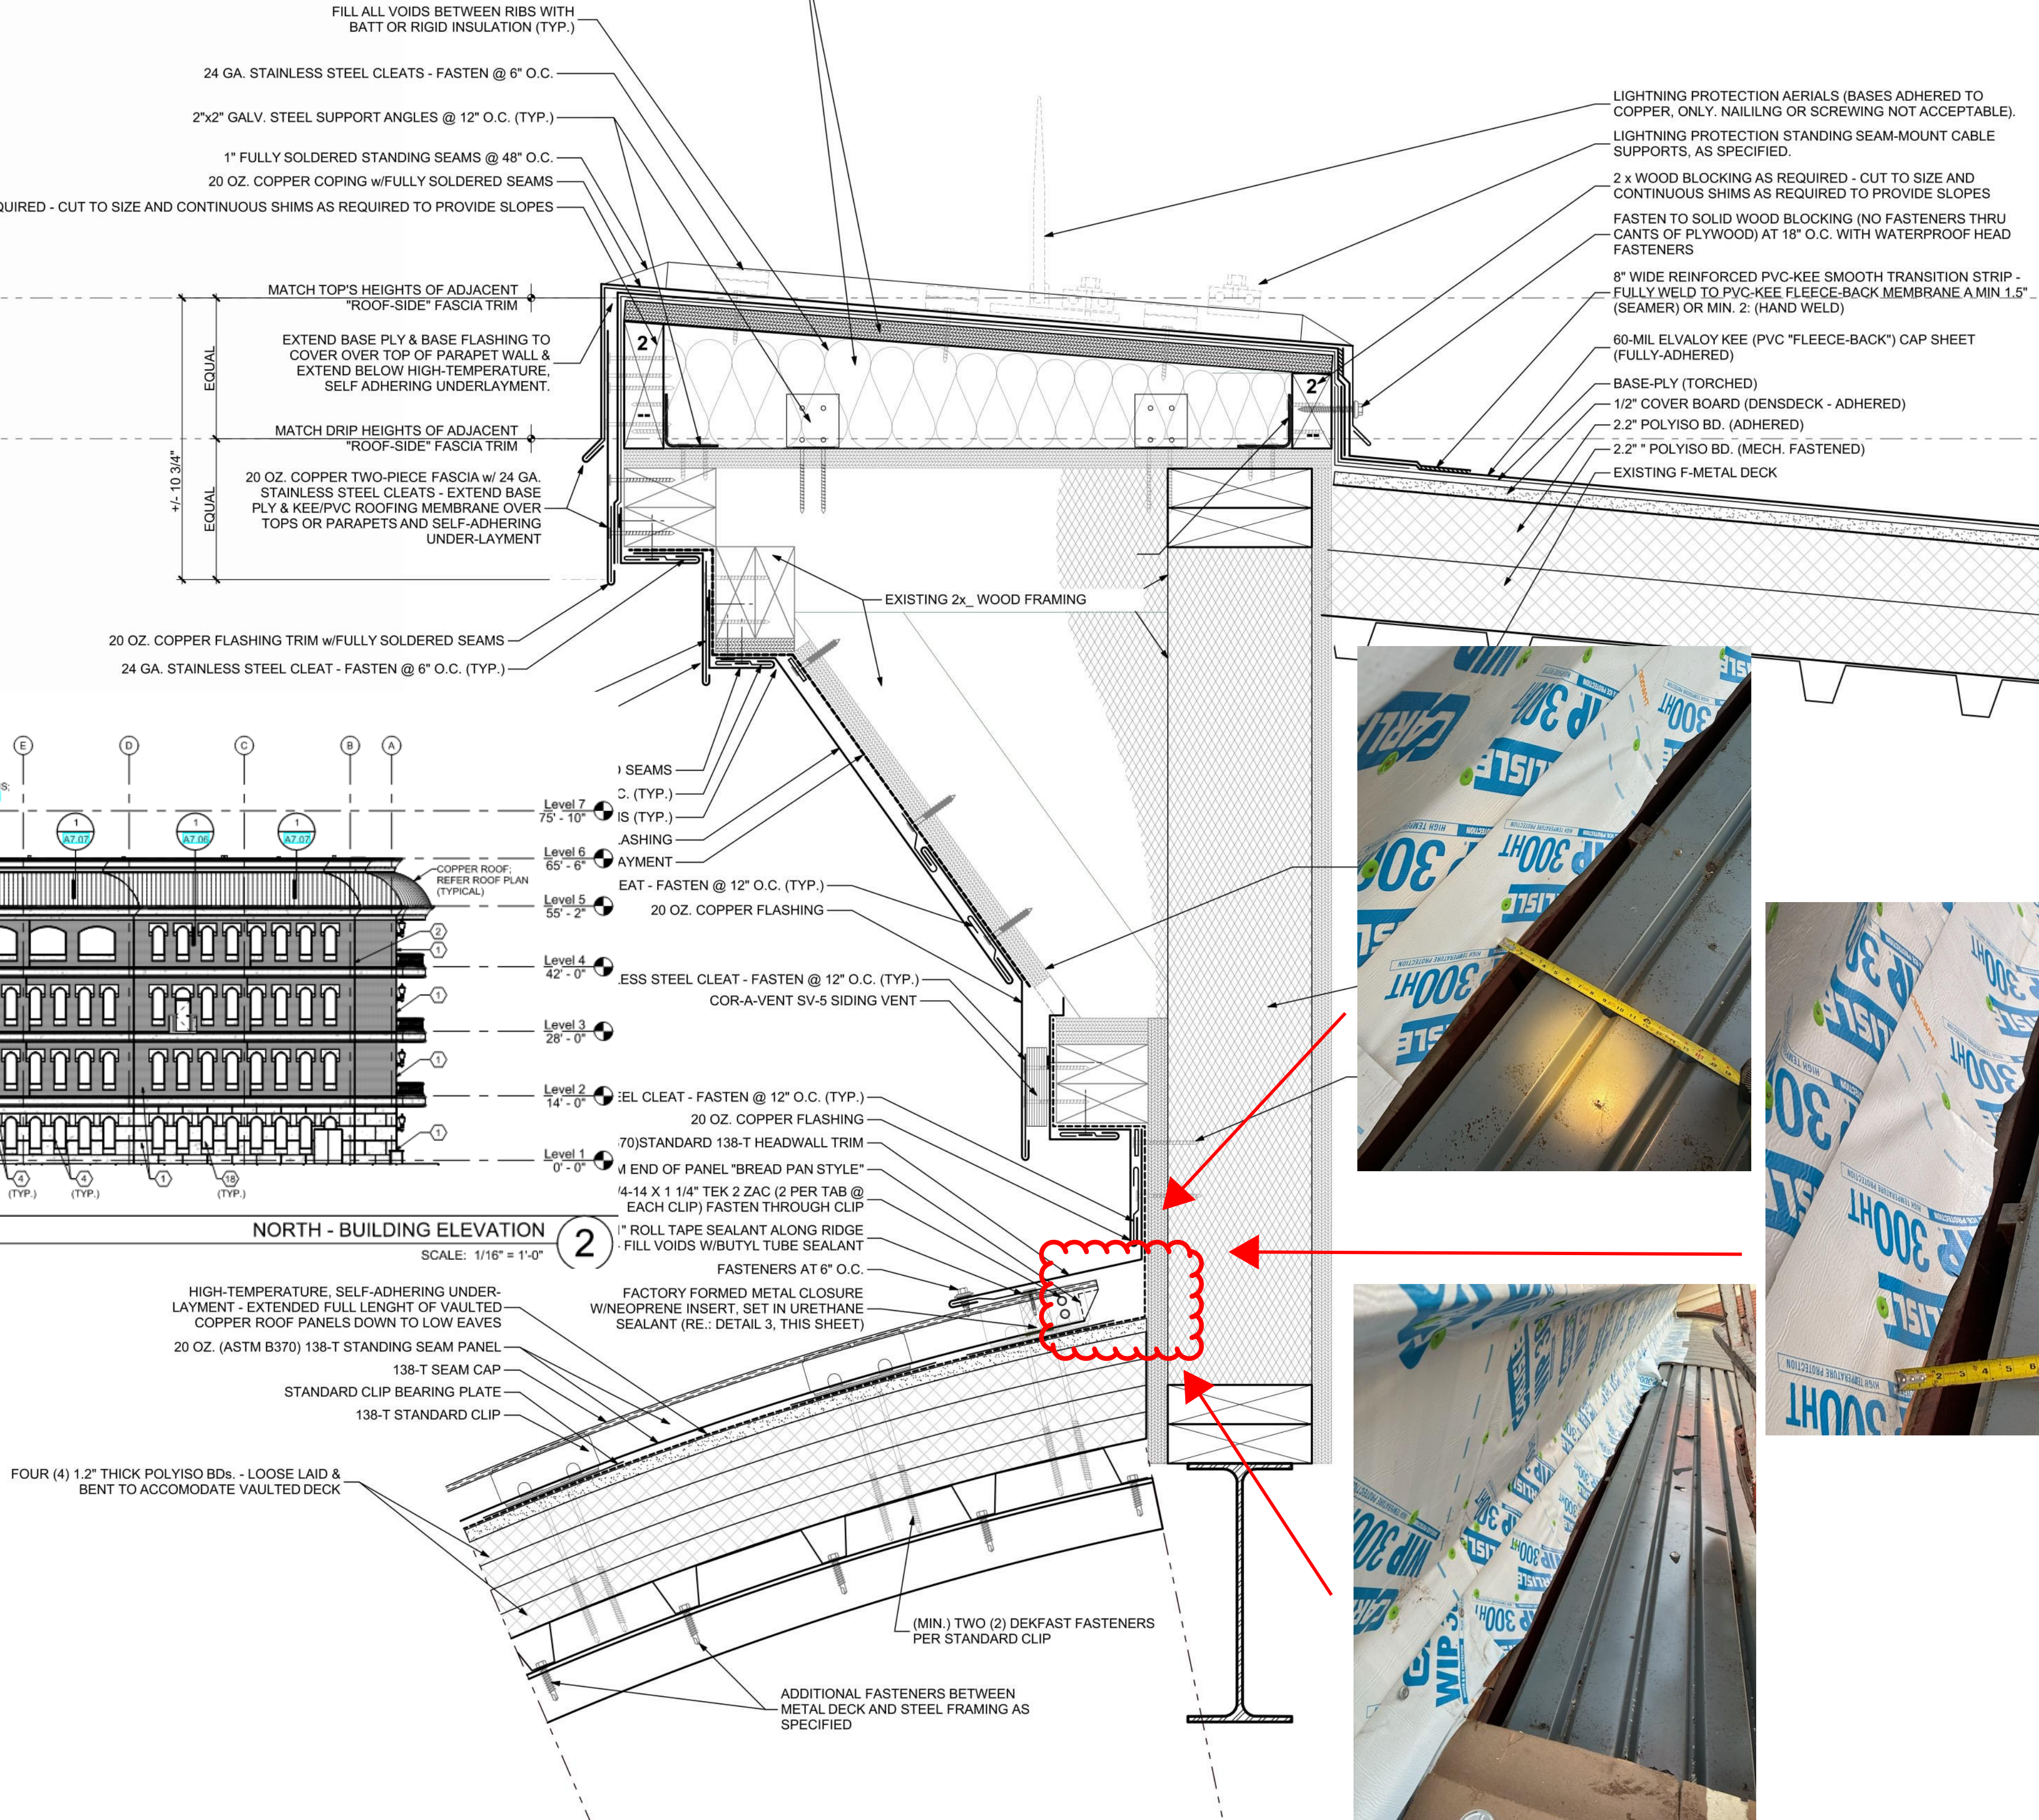

DETAILS - ROOF (alternate)

WEBB COUNTY
WEBB COUNTY JUSTICE CENTER BUILDING
ENVELOPE and SITE REHABILITATION PROJECT

1110 VICTORIA STREET
LAREDO, TEXAS 78040

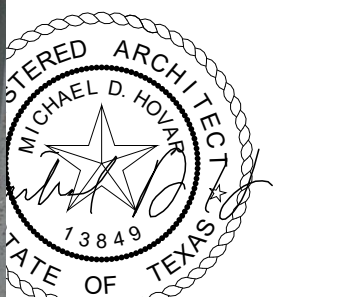

07/26/2024

OR:

Description
100% CONSTRUCTION DOCUMENTS

These documents and the ideas incorporated herein as instruments of professional service are the property of Raba-Kistner Consultants, Inc. and are not to be used in whole or part without the written authorization of Raba-Kistner Consultants, Inc.

PROJECT No.:
ASB23-019-00

ISSUE DATE: 07/26/2024

DRAWN BY: a3

CHECKED BY:

REVIEWED BY:

SHEET
A7.07-A
OF