

CONSTRUCTION CONTRACT CHANGE ORDER NUMBER:

001

1. CONTRACTOR: Chasco Constructors

2. Change Order Work Limits: Sta. 238+18 to Sta. 254+84

3. Type of Change (on federal-aid non-exempt projects): Minor (Major/Minor)

4. Describe the change and the reason for the change order. When necessary, include exceptions to this agreement.

Based on field conditions, LA and Civil modified lengths and positions of various CONC CURBS. French drain added at STA 243+40 to aid drainage. See attached. A copy of this CO should be sent to the Field Coordination Section of the Design Division.

CCSJ: 0914-05-191
Project: Brushy Creek Trail
Highway: n/a
County: Williamson
Georgetown Office
District:
Contract Number:

5. New or revised plan sheet(s) are attached and numbered: 40-45 & drain detail

Each signatory hereby warrants that each has the authority to execute this Change Order.

By signing this change order, the contractor agrees to waive any and all claims for additional compensation due to any and all other expenses; additional changes for time, overhead and profit; or loss of compensation as a result of this change. Further, the contractor agrees that this agreement is made in accordance with Item 4 and the Contract. Exceptions should be noted in the response for #5 above.		The following information must be provided	
THE CONTRACTOR		Time Ext. #: <u>20</u> Days added on this C.O.: <u>001</u>	
By 		Amt. added by this change order: <u>-\$27,462.00</u>	
Date <u>12/23/19</u>		For TxDOT use only:	
Typed/Printed Name <u>Charles King</u>		Days participating: _____	
Typed/Printed Title <u>Vice President / CFO</u>		Amount participating: _____	
		Signature _____ Date _____	
		Name/Title _____	

RECOMMENDED FOR EXECUTION:

Drew Carman / LA, Project Manager 12/20/19
Name/Title Date

DREW CARMAN
Name/Title Date
☒ APPROVED ☐ REQUEST APPROVAL

Heather McNeal 12/30/19
Name/Title Date

Heather McNeal
Name/Title Date
☒ APPROVED ☐ REQUEST APPROVAL

TOM STANFELDS 12/30/19
Name/Title Date
WILCO FAC PROS MGR

Tom Stanfelds 12/30/19
Name/Title Date
☒ APPROVED ☐ REQUEST APPROVAL

Name/Title Date

Name/Title Date
☐ APPROVED

Engineer's Seal:



BRUSHY CREEK REGIONAL TRAIL PH 5

12/23/2019

CP 01R - DRAINAGE CHANGES

12/23/2019

ITEM	SPEC	DESCRIPTION - ORIGINAL BID ITEMS	UNIT	UNIT PRICE	QTY	
450	6052	RAIL (HANDRAIL) (TY F) - <u>SHEET 44</u> MOVE END OF WALL FROM STATION 254+84 TO 254+12	LF	\$115.00	(72.00)	(\$8,280.00)
529	6015	CONC CURB (TY C1) - <u>SHEET 40</u> MOVE BEGINNING OF WALL FROM STATION 238+18 TO 238+63	LF	\$65.00	(45.00)	(\$2,925.00)
529	6027	CONC CURB (TY C2) - SHEET 41&42 MOVE BEGINNING OF WALL FROM 242+82 TO 243+40 AND END OF WALL FROM 245+63 TO 245+00	LF	\$145.00	(121.00)	(\$17,545.00)
529	6018	CONC CURB (TY F3) - <u>SHEET 44</u> MOVE END OF WALL FROM STATION 254+84 TO 254+12	LF	\$275.00	(72.00)	(\$19,800.00)
531	6001	CONC SIDEWALKS (4") - INCREASE LIMITS OF SIDEWALK WHERE ABOVE ITEMS DECREASED	SY	\$42.00	264.00	\$11,088.00
						(\$37,462.00)

FRENCH DRAIN DETAIL PER EMAIL DATED 11/6/19


		FRENCH DRAIN DETAIL 243+40 - 245+00	LF	\$50.00	160.00	\$8,000.00
		4" PVC PIPE OUTFALL 10 LF	EA	\$500.00	3.00	\$1,500.00
		4" FLAP VALVE ALLOWANCE	EA	\$500.00	3.00	\$1,500.00
		UNUSED REBAR PREVIOUSLY APPROVED AND DELIVERED	LS	\$1,000.00	(1.00)	(\$1,000.00)
						\$10,000.00

TOTAL (\$27,462.00)

ADDITIONAL DAYS REQUESTED 20


THIS ESTIMATE IS BASED ON MARKED UP PLAN SHEETS 40, 41, 42, 43, 44, 45, FRENCH DRAIN DETAIL SHEET

ITEM	DESC	UNIT	QTY
0100	6002 PREPARING ROW	SY	244
0110	6001 EXCAVATION (ROADWAY)	CY	108
0120	6003 CONCRETE (TOTAL) (DEMS CONT) (TY B)	SY	844
0130	6014 COMPOST MANUF TOPSOIL (BDS OR FB) (4")	SY	844
0140	6037 DRILL SEEDING (PERM) (URBAN) (SANDY)	MG	14.20
0150	6001 SOIL RETENTION BLANKETS (CL 1) (TY A)	SY	844
0160	6001 SOIL RETENTION BLANKETS (CL 1) (TY A)	SY	844
0170	6015 CONC CURB (TY C1)	LF	139
0180	6027 CONC CURB (TY C2)	LF	118
0190	6001 CONC SIDEWALKS (4")	SY	271
0200	6003 CONC SIDEWALKS (6")	SY	373

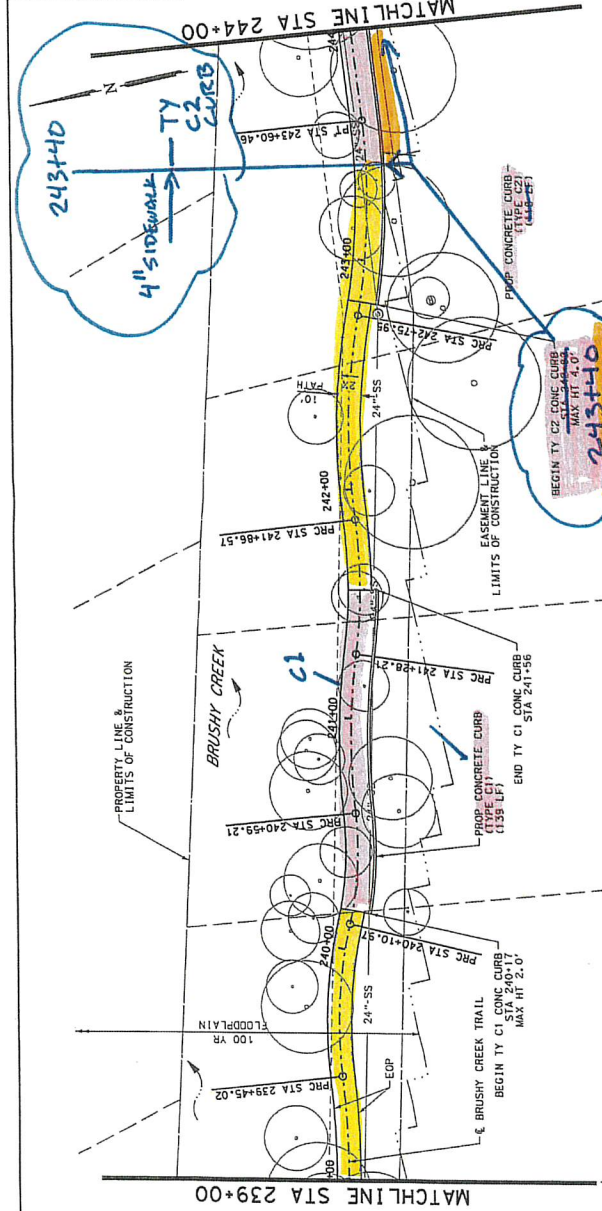

ADDENDUM NO. 01

PLAN SCALE: 1" = 50'
PROFILE SCALE: 1" = 5'

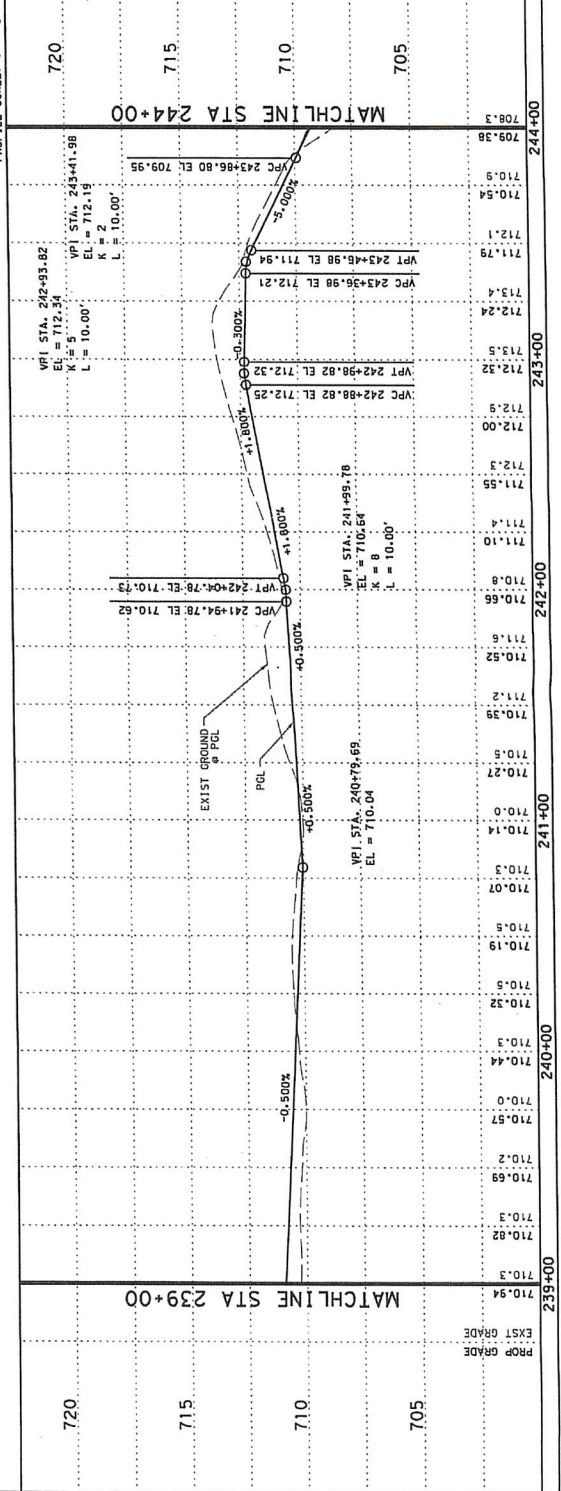

LEGEND

- LIMITS OF CONSTRUCTION
- PROPERTY LINE
- EASEMENT LINE
- 100 YR FLOODPLAIN LIMIT
- CREEK FLOW DIRECTION
- TREE

DESIGN



REVIEW AND APPROVAL



PAPE-DAWSON
ENGINEERS


AUSTIN L. PAPE, ARCHITECT & ENGINEER, LICENSE NO. 10001, STATE OF TENNESSEE
JAMES A. LUTZ, PROFESSIONAL ENGINEER, LICENSE NO. 84722, STATE OF TENNESSEE
THESE ENGINEERS HAVE REVIEWED THIS PROJECT AND HAVE FOUND IT TO BE IN ACCORDANCE WITH THE REQUIREMENTS OF THE TENNESSEE ENGINEERING ACT.

BRUSHY CREEK TRAIL

PLAN AND PROFILE
STA 239+00 TO STA 244+00

DESIGNER: EG	DRAWN BY: EG	CHECKED BY: HK	SHEET NO.: 41
TITLE: SUBMITTAL	PROJECT NO.: STP 180205TP	DATE: 9/24/2018	SHEET 7 OF 10


ITEM	DESC	DESCRIPTION	UNIT	QTY
0100	6002	PREPARING ROW	STA	5
0100	6001	EXCAVATION (ROADWAY)	CY	137
0132	6004	EMBANKMENT (FINAL) (DENS CONT) (TY B)	CY	30
0164	6014	COMPOST MANUF TOPSOIL (BOS OR PB) (4")	SY	403
0164	6037	DRILL SEEDING (PEWM) (URBAN) (SANDY)	MG	403
0169	6001	VEGETATIVE WATERING	MG	6.79
0169	6001	SOIL RETENTION BLANKETS (CL 1) (TY A)	SY	403
0420	6011	CL B CONC (FLUME)	CY	2
0432	6022	RIPRAP (STONE COMMON) (DRY) (6 IN)	CY	126
0529	6027	STR STEEL (MISC NON - BRIDGE)	LF	153
0531	6001	CONC SIDEWALKS (4")	SY	213
0531	6002	CONC SIDEWALKS (6")	SY	236

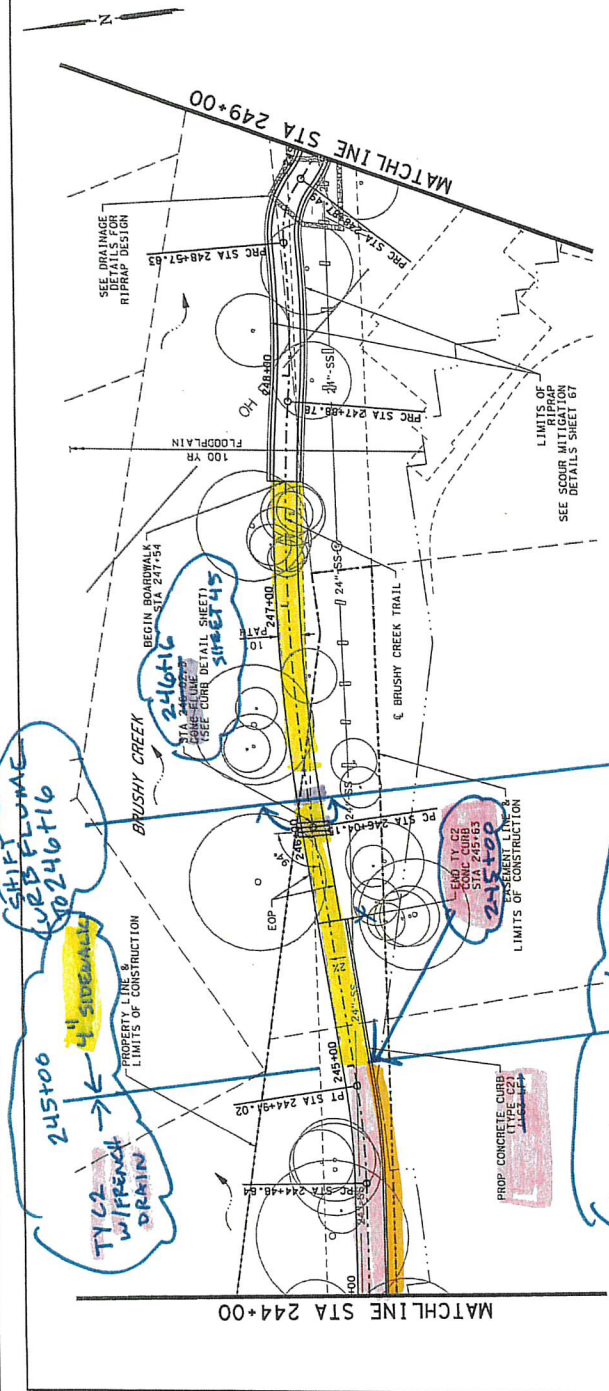

ADDENDUM NO. 01

PLAN SCALE: 1" = 50'

PROFILE SCALE: 1" = 5'

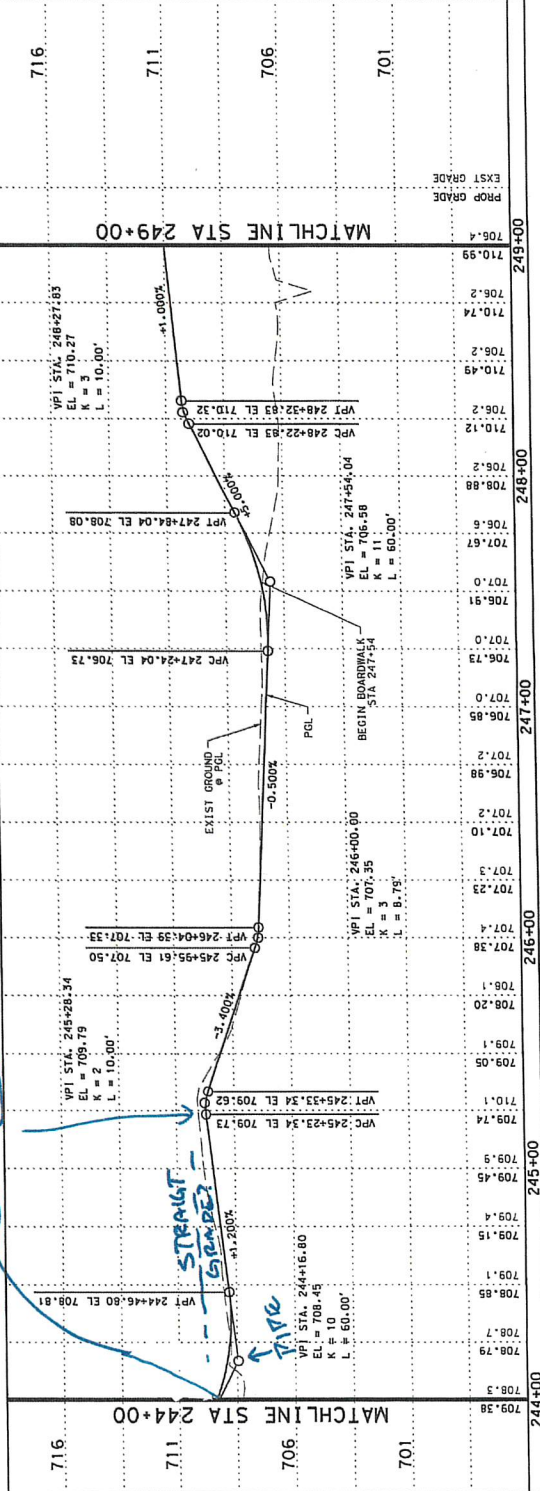

- LEGEND
- LIMITS OF CONSTRUCTION
 - PROPERTY LINE
 - EASEMENT LINE
 - 100 YR FLOODPLAIN LIMIT
 - CREEK FLOW DIRECTION
 - TREE

DESIGN

 REVIEW AND APPROVAL

 DATE: 9/24/2018

PAPE-DAWSON ENGINEERS
 10001 KAM ANTONIO INDUSTRIAL COURT WESTERLY DALLAS
 TEXAS 75243-4271
 TEL: 972.414.1111 FAX: 972.414.1111
 WWW.PAPE-DAWSON.COM

BRUSHY CREEK TRAIL
 PLAN AND PROFILE
 (STA 244+00 TO STA 249+00)

100% SUBMITTAL	PROJECT NO. STP 18002209TP	SHEET 8 OF 10
DESIGNED BY: EG	CHECKED BY: HM	DATE: 9/24/2018
DRAWN BY: EG	CHECKED BY: HM	SHEET NO.: 42

ITEM	DESC	UNIT	QTY
0100	6002 PREPARING ROW (ROADWAY)	STA	63
0101	6001 EMBANKMENT (FINAL) (DENS. CONT.) (CY B)	CY	8
0102	6004 COMPOST MANIF TOPSOIL (BOS OR PH) (4")	SY	238
0161	6014 COMPOST MANIF TOPSOIL (BOS OR PH) (4")	SY	238
0162	6037 DRILL SEEDING (PERM) (URBAN)	SY	238
0163	6001 VEGETATIVE WATERING	MG	4.00
0169	6001 SOIL RETENTION BLANKETS (CL 1) (TY A)	SY	238
0432	6022 RIPRAP (STONE COMMON) (DRY) (16 IN)	CY	220
0450	6052 RAIL (HANDRAIL) (TY F)	LF	91
0529	6018 CONC CURB (TY F3)	LF	91
0531	6001 CONC SIDEWALKS (4")	SY	304


NO CHANGE TO F3 CURB
THIS SHEET

- LEGEND**
- LIMITS OF CONSTRUCTION
 - PROPERTY LINE
 - EASEMENT LINE
 - 100 YR FLOODPLAIN LIMIT
 - CREEK FLOW DIRECTION
 - TREE

ADDENDUM NO. 01

PLAN SCALE: 1" = 50'

PROFILE SCALE: 1" = 5'

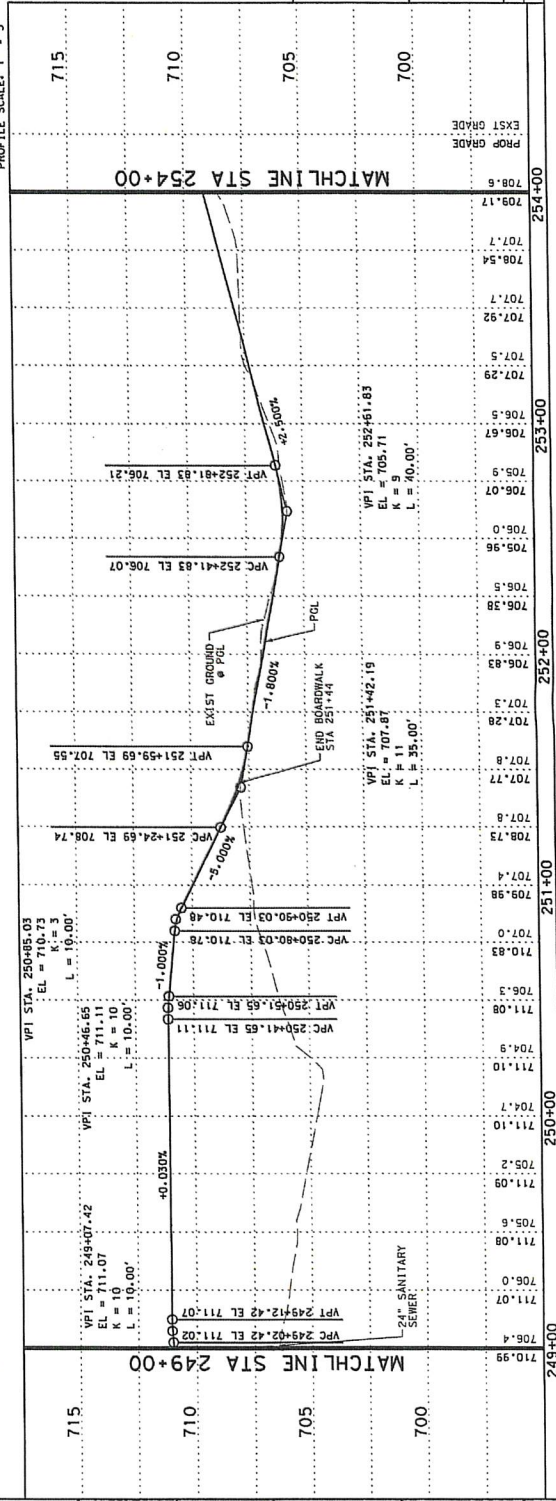

DESIGN



REVIEW AND APPROVAL



DATE: 9/24/2018


PAPE-DAWSON ENGINEERS

ASTUTE | SAV | ADROUS | CUNTERY | CREAT | PASSION | DEDICATION
TOP QUALITY DESIGN SERVICES | 100% CLIENT SATISFACTION

BRUSHY CREEK TRAIL
PLAN AND PROFILE
(STA 249+00 TO STA 254+00)

100% SUBMITTAL	PROJECT NO.: STP 18020291P	SHEET 9 OF 10
DRAWN BY: EG	DESIGN BY: HM	DATE: 9/24/2018
CHECKED BY: HM	CHECKED BY: HM	SHEET NO.: 43

11/13/19

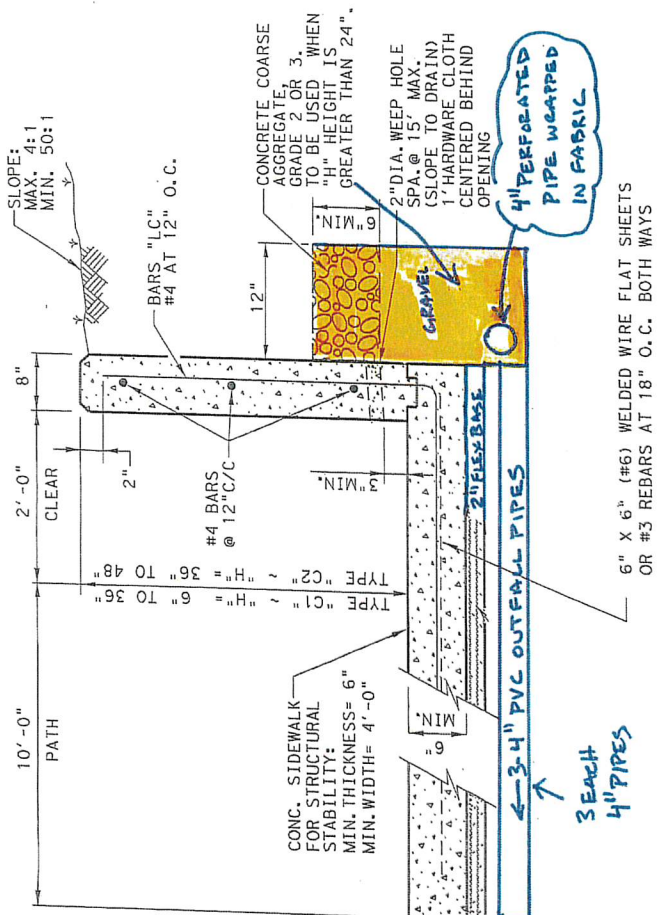

TYPE "C2" CURB - MODIFIED
w/ FRENCH DRAIN

3 Each
4" PIPES