

WILLIAMSON COUNTY, TEXAS

CHANGE ORDER NUMBER: 7

1. CONTRACTOR: Capital Excavation

2. Change Order Work Limits: Sta. 54+93.6 RT to Sta. 55+27.6 RT

3. Type of Change(on federal-aid non-exempt projects): Minor (Major/Minor)

4. Reasons: 1B (3 Max. - In order of importance - Primary first)

Project: 221FB39
Roadway: FM 1460 - SH 130
CSJ Number: _____

5. Describe the work being revised:

1B. Design Error or Omission. Other: This Change Order provides additional items to the Contract for adjusting an existing headwall, wingwalls and adding concrete rail along an existing culvert that is to remain in place. Due to the height of the existing culvert, the proposed roadway can not be built to the proposed width. Raising the headwall and constructing the rail will allow for the roadway portion to be constructed to the proposed width. This rail will mirror the existing rail along the upstream portion of the existing culvert.

6. Work to be performed in accordance with Items: See Attached.

7. New or revised plan sheet(s) are attached and numbered: Revised Sheets: 2, 15, 17, 92, 113A-C

8. New Special Provisions/Specifications to the contract are attached: ☐ Yes ☒ No

9. New Special Provisions to Item N/A No. N/A, Special Specification Item N/A are attached.

Each signatory hereby warrants that each has the authority to execute this Change Order (CO).

<i>The contractor must sign the Change Order and, by doing so, agrees to waive any and all claims for additional compensation due to any and all other expenses; additional changes for time, overhead and profit; or loss of compensation as a result of this change.</i> THE CONTRACTOR Date <u>12.1.22</u> By <u>[Signature]</u> Typed/Printed Name <u>JOE CHESNEY</u> Typed/Printed Title <u>V.P.</u>	The following information must be provided Time Ext. #: _____ Days added on this CO: <u>0</u> Amount added by this change order: <u>\$28,440.00</u>
--	---

RECOMMENDED FOR EXECUTION:

[Signature] 12/2/2022
Project Manager Date

N/A
Design Engineer Date

[Signature] 12/2/2022
Program Manager Date

Design Engineer's Seal:

see attached plan sheets

County Commissioner Precinct 1 Date
☐ APPROVED ☐ REQUEST APPROVAL

County Commissioner Precinct 2 Date
☐ APPROVED ☐ REQUEST APPROVAL

County Commissioner Precinct 3 Date
☐ APPROVED ☐ REQUEST APPROVAL

County Commissioner Precinct 4 Date
☐ APPROVED ☐ REQUEST APPROVAL

County Judge Date
☐ APPROVED

WILLIAMSON COUNTY, TEXAS

CHANGE ORDER NUMBER: 7

Project # 221FB39**TABLE A: Force Account Work and Materials Placed into Stock**[illegible]

TABLE B: Contract Items:

				ORIGINAL + PREVIOUSLY		ADD or (DEDUCT)	NEW		
ITEM	DESCRIPTION	UNIT	UNIT PRICE	QUANTITY	ITEM COST	QUANTITY	QUANTITY	ITEM COST	OVERRUN/ UNDERRUN
0450-6006	RAIL TYPE T223	LF	\$260.00	0.00	\$0.00	34.00	34.00	\$8,840.00	\$8,840.00
0540-6006	MTL W- BEAM GD FEN TRANS (THRIE-BEAM)	EA	\$2,800.00	0.00	\$0.00	2.00	2.00	\$5,600.00	\$5,600.00
999-WC05	EXTEND EXISTING WINGWALLS AND HEADWALL	LS	\$14,000.00	0.00	\$0.00	1.00	1.00	\$14,000.00	\$14,000.00
TOTALS					\$0.00			\$28,440.00	\$28,440.00

CHANGE ORDER REASON(S) CODE CHART

1. Design Error or Omission	1A. Incorrect PS&E 1B. Other
2. Differing Site Conditions (unforeseeable)	2A. Dispute resolution (expense caused by conditions and/or resulting delay) 2B. Unavailable material 2C. New development (conditions changing after PS&E completed) 2D. Environmental remediation 2E. Miscellaneous difference in site conditions (unforeseeable)(Item 9) 2F. Site conditions altered by an act of nature 2G. Unadjusted utility (unforeseeable) 2H. Unacquired Right-of-Way (unforeseeable) 2I. Additional safety needs (unforeseeable) 2J. Other
3. County Convenience	3A. Dispute resolution (not resulting from error in plans or differing site conditions) 3B. Public relations improvement 3C. Implementation of a Value Engineering finding 3D. Achievement of an early project completion 3E. Reduction of future maintenance 3F. Additional work desired by the County 3G. Compliance requirements of new laws and/or policies 3H. Cost savings opportunity discovered during construction 3I. Implementation of improved technology or better process 3J. Price adjustment on finished work (price reduced in exchange for acceptance) 3K. Addition of stock account or material supplied by state provision 3L. Revising safety work/measures desired by the County 3M. Other
4. Third Party Accommodation	4A. Failure of a third party to meet commitment 4B. Third party requested work 4C. Compliance requirements of new laws and/or policies (impacting third party) 4D. Other
5. Contractor Convenience	5A. Contractor exercises option to change the traffic control plan 5B. Contractor requested change in the sequence and/or method of work 5C. Payment for Partnering workshop 5D. Additional safety work/measures desired by the contractor 5E. Other
6. Untimely ROW/Utilities	6A. Right-of-Way not clear (third party responsibility for ROW) 6B. Right-of-Way not clear (County responsibility for ROW) 6C. Utilities not clear 6D. Other

Williamson County Road Bond Program

CR 111 Westinghouse Rd Williamson County Project No. 22IFB39 Change Order No. 7

Reason for Change

This Change Order provides payment to the Contractor for additional work needed to adjust an existing headwall and wingwalls to allow for the roadway to be constructed to the proposed plan width. The existing Culvert 4 is to remain in place, but due to the location of the existing headwall it will not allow for the roadway to be built to plan width as there is no support for the roadway section at the culvert. RFI 27 addresses the issue and provides additional plan sheets to extend the headwall, wingwalls and adds traffic rail so that the roadway portion can be constructed to the proposed width.

The following is a list of new items required for this Change Order.

ITEM	DESCRIPTION	QTY	UNIT
0450-6006	Rail TYPE T223	34	LF
0540-6006	MTL BEAM GD FEN TRANS (THRIE-BEAM)	2	EA
999-WC05	Drill, Dowel, and Extend Existing Wingwalls and Headwall	1	LS

This Change Order results in an increase of \$28,440.00 to the Contract amount, for an adjusted Contract total of \$21,833,559.18. The original Contract amount was \$21,024,332.88. As a result of this and previous Change Orders, \$809,226.30 has been added to the Contract, resulting in a 3.85% increase in the Contract cost. As a result of this Change Order, (0) days will be added to the Contract.

HNTB Corporation

Oscar Salazar-Bueno, P.E.



PO Box 1301
Austin, TX 78767
Email: Estimating@CapitalExcavation.com

Change Request # 16

Date: 9/28/2022

QuoteTo: Chuck Evans
HNTB CORPORATION

Project: CR 111 / 110 (1024)

Capital Project #: 1024

Description: Existing Culvert 4 Wall Extension & 223 Rail Addition

Item	Description	Quantity	Unit	Unit Price	Amount
999-WC05	Drill, Dowel, and Extend Existing Wingwall Height	1.00	LS	14,000.00	14,000.00
450-6006	Rail (TY T223)	34.00	LF	260.00	8,840.00
540-6006	MTL W-BEAM DG FEN TRANSITION THRIE BEAM	2.00	EA	2,800.00	5,600.00

GRAND TOTAL 28,440.00

Scope: Price to extend the headwall and wingwall heights of existing culvert #4 to allow for proposed roadway construction.
Price for the addition of T223 traffic rail, and changes to the proposed MBGF.

Capital Excavation Requests an additional : Yes-TBD day(s)

The Ty T223 Rail and MTL Beam Thrie Beam Transitions are in line with TxDOT Low Bid Averages and our current projects under construction. The lump sum price for the headwall and wingwall extensions are also a reasonable price for this work.



CHANGE ORDER BREAKDOWN

Capital Excavation Company

PROJECT: CR 111
DESCRIPTION: Extending Culv 4 Headwall & T223 Rail

DATE: 10/14/2022

	<u>REGULAR</u> <u>HRS</u>	<u>OVERTIME</u> <u>HRS</u>	<u>UNIT</u>	<u>REG.</u> <u>UNIT</u> <u>PRICE</u>	<u>OT. UNIT PRICE</u>	<u>TOTALS</u>
LABOR						
Concrete Foreman	50	0	HR	\$45.00	\$67.50	\$2,250.00
Concrete Finisher	100	0	HR	\$21.00	\$31.50	\$2,100.00
Concrete Formsetter	150	0	HR	\$20.00	\$30.00	\$3,000.00
Survey Party Chief	10	0	HR	\$42.00	\$63.00	\$420.00
Survey Laborer	20	0	HR	\$18.00	\$27.00	\$360.00
					Total:	\$8,130.00
					Burden 30%	\$2,739.00
LABOR TOTAL						\$10,869.00
EQUIPMENT						
Excavator 420	50		HR	\$18.00		\$900.00
Backhoe 420	50		HR	\$35.00		\$1,750.00
	38.75					\$1,356.25
EQUIPMENT TOTAL						\$2,650.00
MATERIALS						
Cl C Concrete	12.71		CY	\$135.00		\$1,715.85
Rebar	2054		LB	\$0.85		\$1,745.90
Formwork	526		SF	\$2.00		\$1,052.00
MATERIALS TOTAL						\$4,513.75
SUBS						
Subcontractor	1		DAY	\$2,000.00		\$2,000.00
SUBS TOTAL						\$2,000.00
TOTAL COST						\$12,571.00
MARKUP						\$7,000.00
TOTAL PRICE						\$19,571.00
						\$14,000.00

This is a reasonable price for extending the existing headwall and wingwalls.



REQUEST FOR INFORMATION FORM

RFI NO.: 27 DATE: 8/15/2022
PROJECT: 22IFB39 - CR 111 / Westinghouse RESPONSE REQUESTED BY
DATE: 8/22/2022
TO: HNTB: Chuck Evans; Eddie Church, P.E.

REFERENCE: Existing Culvert 4 Conflict

PROBLEM:

The existing culvert 4 headwall at STA 55+44 on the southern side is in conflict with the proposed roadway, curb, and metal beam guard fence installation. The existing culvert needs to be addressed for safety and constructability. Please review and advise.

RECOMMENDED SOLUTION:

Andy Wynes
Originator

Supervisor

RESPONSE:

We revised the design to be in line with the recommended solution provided by HNTB; extend the existing headwall and wingwall height and install a concrete traffic rail. Sheets showing the plan revisions, standard details, and updated quantities are attached.

Bryan Moore
Responder

9/16/2022
Date

Sign, Date & Return to HNTB via e-mail.

Mail original to: HNTB Corporation
101 E. Old Settlers Blvd.
Round Rock, Texas 78664

Attachments to RFI: Sheets 92, 292

Cc:

2

206
216

A circular professional engineer seal for Benjamin R. Lake. The outer ring contains the text "STATE OF TEXAS" at the top and "PROFESSIONAL ENGINEER" at the bottom, separated by two stars on each side. The inner circle features a five-pointed star at the top, the name "BENJAMIN R. LAKE" in the center, and the license number "118699" below it. The word "LICENSED" is written in a smaller font at the bottom of the inner circle.



ADDRESS	1978 S. AUSTIN AVENUE		GEORGETOWN, TX 78626	
METRO	512.930.9412	TBPE FIRM NO. 181 TBPLS FIRM NO. 10003700	WEB	STEGERBIZZELL.COM
SERVICES	>>ENGINEERS >>PLANNERS >>SURVEYORS			

SUPPLEMENTAL
INDEX OF SHEETS

DATE: 8/26/2022	DN:	DW:	CK:	AP:
FED. RD. DIV. NO.	FEDERAL AID PROJECT NO.			SHEET NO.
6	----			2
STATE	DIST.	COUNTY		
TEXAS	---	WILLIAMSON		
CONT.	SECT.	JOB	HIGHWAY NO.	
----	--	---	CR 111	

	ITEM CODE			DESCRIPTION	UNIT	TOTAL	
	ITEM NO.	DESC. CODE	SP NO.			EST.	FINAL
7	100	6002		PREPARING ROW	STA	217	
	106	6002		OBLITERATING ABANDONED ROAD	SY	40,673	
	110	6001		EXCAVATION (ROADWAY)	CY	107,513	
	132	6003		EMBANKMENT (FINAL)(ORD COMP)(TY B)	CY	42,149	
	160	WC02		FURNISHING AND PLACING TOPSOIL (4")	SY	148,530	
	161	WC001		EROSION CONTROL COMPOST (3")	SY	37,133	
	162	WC103		MULCH TOPDRESSING (5")	SY	37,133	
	164	WC04		SEEDING FOR EROSION CONTROL (TEMP)(COOL)(TY 4)	SY	74,271	
	164	WC11		SEEDING FOR EROSION CONTROL (TEMP & PERM)(TY 11)	SY	222,801	
	166	6002		FERTILIZER	TON	9.28	
	168	WC01		VEGETATIVE WATERING	MG	4,456	
	169	6001		SOIL RETENTION BLANKETS (CL 1)(TY A)	SY	40,000	
	169	6006		SOIL RETENTION BLANKETS (CL 2)(TY F)	SY	1,620	
	247	6044		FL BS (CMP IN PLC)(TY A GR 4)(FNAL POS	CY	38,060	
	260	6002		LIME (HYDRATED LIME (SLURRY))	TON	2,075	
	260	6073		LIME TRT (SUBGRADE) (8")	SY	115,225	
	310	6001		PRIME COAT (MULTI OPTION)	GAL	20,391	
	316	6193		AGGR(TY-D GR-5 SAC-B)	CY	613	
	316	6413		ASPH (AC-15P, HFRS-2P OR CRS-2P)	GAL	25,305	
	341	6008		D-GR HMA TY-B PG64-22	TON	25,840	
6	341	6042		D-GR HMA TY-D SAC-B PG70-22	TON	12,049	
	351	6006		FLEXIBLE PAVEMENT STRUCTURE REPAIR(10")	SY	500	
	354	6041		PLANE ASPH CONC PAV (1.5")	SY	2,273	
	354	6044		PLANE ASPH CONC PAV (7")	SY	386	
	402	6001		TRENCH EXCAVATION PROTECTION	LF	525	
	432	6002		RIPRAP (CONC)(5 IN)	CY	867	
	432	6003		RIPRAP (CONC)(6 IN W/ 6 X 6 X #6 WELDED WIRE)	CY	46	
	432	6031		RIPRAP (STONE PROTECTION)(12 IN)	CY	1,954	
	432	6045		RIPRAP (MOW STRIP)(4 IN)	CY	40	
	450	6006		RAIL (TY T223)	LF	34	
	460	6002		CMP (GAL STL 18 IN)	LF	367	
	460	6003		CMP (GAL STL 24 IN)	LF	673	
	462	6004		CONC BOX CULV (4 FT X 3 FT)	LF	180	
	462	6007		CONC BOX CULV (5 FT X 3 FT)	LF	600	
	462	6010		CONC BOX CULV (6 FT X 3 FT)	LF	2,373	
	464	6003		RC PIPE (CL III)(18 IN)	LF	4,453	
	464	6005		RC PIPE (CL III)(24 IN)	LF	2,332	
	464	6007		RC PIPE (CL III)(30 IN)	LF	3,078	
	464	6008		RC PIPE (CL III)(36 IN)	LF	1,439	
	464	6009		RC PIPE (CL III)(42 IN)	LF	174	
5	465	6005		JCTBOX(COMPL)(PJB)(3FTX3FT)	EA	1	
	465	6006		JCTBOX(COMPL)(PJB)(4FTX4FT)	EA	3	
	465	6009		JCTBOX(COMPL)(PJB)(5FTX5FT)	EA	1	
	465	6014		INLET (COMPL)(PCO)(3FT)(LEFT)	EA	3	
	465	6015		INLET (COMPL)(PCO)(3FT)(RIGHT)	EA	4	
	465	6016		INLET (COMPL)(PCO)(3FT)(BOTH)	EA	20	
	465	6020		INLET (COMPL)(PCO)(4FT)(BOTH)	EA	6	
	465	6126		INLET (COMPL)(PSL)(FG)(3FTX3FT-3FTX3FT	EA	1	
	466	6003		HEADWALL (CH-FW-0) (DIA=18 IN)	EA	3	
	466	6009		HEADWALL (CH-FW-0) (DIA=36 IN)	EA	1	
	466	6010		HEADWALL (CH-FW-0) (DIA=42 IN)	EA	2	
	466	6022		HEADWALL (CH-FW-15) (DIA=30 IN)	EA	2	
	466	6037		HEADWALL (CH-FW-30) (DIA=30 IN)	EA	1	
	466	6054		HEADWALL (CH-FW-45) (DIA=36 IN)	EA	1	
	466	6132		HEADWALL (CH-PW-S) (DIA=30 IN)	EA	1	
	466	6134		HEADWALL (CH-PW-S) (DIA=36 IN)	EA	1	
	466	6165		WINGWALL (FW-S) (HW=4FT)	EA	3	
	466	6179		WINGWALL (PW-1) (HW=4FT)	EA	5	
	466	6207		WINGWALL (SW-0) (HW=4FT)	EA	3	
	467	6014		SET (TY I)(36 IN)(3:1)(C)	EA	1	
3	467	6356		SET (TY II)(18 IN)(RCP)(3:1)(C)	EA	1	
	467	6362		SET (TY II)(18 IN)(RCP)(6:1)(C)	EA	1	
	467	6363		SET (TY II)(18 IN)(RCP)(6:1)(P)	EA	41	
	467	6395		SET (TY II)(24 IN)(RCP)(6:1)(P)	EA	41	
	467	6422		SET (TY II)(30 IN)(RCP)(6:1)(C)	EA	1	
	467	6423		SET (TY II)(30 IN)(RCP)(6:1)(P)	EA	17	
	467	6454		SET (TY II)(36 IN)(RCP)(6:1)(P)	EA	4	
	496	6016		REMOV STR (PIPE)	EA	17	
	500	6001		MOBILIZATION	LS	1	
	502	6001		BARRICADES, SIGNS AND TRAFFIC HANDLING	MO	18	
	506	6002		ROCK FILTER DAMS (INSTALL) (TY 2)	LF	1,040	

6

6

8

	ITEM CODE			DESCRIPTION	UNIT	TOTAL	
	ITEM NO.	DESC. CODE	SP NO.			EST.	FINAL
5	506	6011		ROCK FILTER DAMS (REMOVE)	LF	1,040	
	506	6020		CONSTRUCTION EXITS (INSTALL) (TY 1)	SY	240	
	506	6024		CONSTRUCTION EXITS (REMOVE)	SY	240	
	506	6038		TEMP SEDMT CONT FENCE (INSTALL)	LF	195	
	506	6039		TEMP SEDMT CONT FENCE (REMOVE)	LF	195	
	506	6040		BIODEG EROSN CONT LOGS (INSTL) (8")	LF	23,660	
	506	6043		BIODEG EROSN CONT LOGS (REMOVE)	LF	23,660	
	508	6001		CONSTRUCTING DETOURS	SY	3,775	
	512	6009		PORT CTB (FUR & INST)(LOW PROF)(TY 1)	LF	1,240	
	512	6010		PORT CTB (FUR & INST)(LOW PROF)(TY 2)	LF	120	
	512	6057		PORT CTB (REMOVE)(LOW PROF)(TY 1)	LF	1,240	
	512	6058		PORT CTB (REMOVE)(LOW PROF)(TY 2)	LF	120	
	528	6001		COLORLED TEXTURED CONC (4")	SY	954	
	529	6008		CONC CURB & GUTTER (TY II)	LF	24,461	
	529	6038		CONC CURB (RIBBON)	LF	755	
	530	6004		DRIVEWAYS (CONC)	SY	975	
	530	6005		DRIVEWAYS (ACP)	SY	4,523	
	531	6001		CONC SIDEWALK (4")	SY	87	
	531	6010		CURB RAMPS (TY 7)	EA	5	
	540	6001		MTL W-BEAM GD FEN (TIM POST)	LF	643	
	544	6001		GUARDRAIL END TREATMENT (INSTALL)	EA	3	
6	560	6004		MAILBOX INSTALL-S (TWG-POST) TY 2	EA	18	
	560	6005		MAILBOX INSTALL-D (TWG-POST) TY 2	EA	2	
	560	6006		MAILBOX INSTALL-M (TWG-POST) TY 2	EA	2	
	618	6023		CONDIT (PVC)(SCH 40)(2")	LF	25	
	620	6007		ELEC CONDR (NO.8) BARE	LF	25	
	628	6001		RELOCATE ELECTRICAL SERVICES	EA	1	
	644	6001		INS SM RD SN SUP & AM TY 10BWG (1) SA (P)	EA	16	
	644	6004		INS SM RD SN SUP&AM TY 10BWG(1) SA(T)	EA	2	
	644	6007		IN SM RD SN SUP&AM TY 10BWG (1) SA (U)	EA	14	
	644	6061		INS SM RD SN SUP&AM TY TWT(1) WS(T)	EA	61	
	658	6046		INSTL OM ASSM (OM-2X)(WC)GND	EA	23	
	662	6004		WK ZN PAV MRK NON-REMOV (W) 4" (SLD)	LF	33,412	
	662	6012		WK ZN PAV MRK NON-REMOV (W) 8" (SLD)	LF	3,389	
	662	6016		WK ZN PAV MRK NON-REMOV (W) 24" (SLD)	LF	333	
	662	6017		WK ZN PAV MRK NON-REMOV (W) (ARROW)	EA	11	
	662	6029		WK ZN PAV MRK NON-REMOV (W) (WORD)	EA	11	
	662	6032		WK ZN PAV MRK NON-REMOV (Y) 4" (BRK)	LF	2,010	
	662	6034		WK ZN PAV MRK NON-REMOV (Y) 4" (SLD)	LF	53,873	
	662	6041		WK ZN PAV MRK NON-REMOV (Y) 24" (SLD)	LF	1,831	
	666	6035		REFL PAV MRK TY I (W) 8"(SLD)(090MIL)	LF	5,347	
6	666	6041		REFL PAV MRK TY I (W) 12"(SLD)(090MIL)	LF	370	
	666	6047		REFL PAV MRK TY I (W) 24"(SLD)(090MIL)	LF	606	
	666	6053		REFL PAV MRK TY I (W) (ARROW) (090MIL)	EA	27	
	666	6077		REFL PAV MRK TY I (W) (WORD) (090MIL)	EA	19	
	666	6146		REFL PAV MRK TY I (Y) 24"(SLD)(090MIL)	LF	1,359	
	666	6299		RE PM W/RET REQ TY I (W)4"(BRK)(090MIL)	LF	800	
	666	6302		RE PM W/RET REQ TY I (W)4"(SLD)(090MIL)	LF	23,127	
	666	6311		RE PM W/RET REQ TY I (Y)4"(BRK)(090MIL)	LF	2,747	
	666	6314		RE PM W/RET REQ TY I (Y)4"(SLD)(090MIL)	LF	47,414	
	672	6007		REFL PAV MRKR TY I-C	EA	146	
	672	6009		REFL PAV MRKR TY II-A-A	EA	623	
	672	6010		REFL PAV MRKR TY II-C-R	EA	116	
	682	6001		VEH SIG SEC (12")LED(GRN)	EA	1	
	682	6002		VEH SIG SEC (12")LED(GRN ARW)	EA	1	
	682	6003		VEH SIG SEC (12")LED(YEL)	EA	1	
	682	6004		VEH SIG SEC (12")LED(YEL ARW)	EA	1	
	682	6005		VEH SIG SEC (12")LED(RED)	EA	1	
	682	6025		BACK PLATE (12") (5 SEC)	EA	1	
	684	6033		TRF SIG CBL (TY A)(14 AWG)(7 CONDR)	LF	225	
	684	6080		TRF SIG CBL (TY C)(14 AWG)(2 CONDR)	LF	25	
7	687	6001		PED POLE ASSEMBLY	EA	3	
	690	6007		REPLACE OF GROUND BOX	EA	2	
	690	6057		REMOVAL OF PEDESTRIAN RAMPS	EA	3	
	730	6003		SPOT MOWING	AC	15.3	
	730	6107		FULL - WIDTH MOWING	CYC	3	
	3076	6066		TACK COAT	GAL	8,156	
	6001	6001		PORTABLE CHANGEABLE MESSAGE SIGN	DAY	300	
	6120	6001		DEAD END ROAD BARRICADE	LF	112	
	7056	6057		PIPE ENCASEMNET (24") STEEL	LF	129	

3

5

6

7

8

(01/05/22): RFI #1

(03/23/22): RFI #12 & RFI #13

(07/15/22): RFI #9

(06/14/22): RFI #22

(08/26/22): RFI #27



© 2016



ADDRESS1978 S. AUSTIN AVENUEGEORGETOWN, TX 78626

PHONE512.930.9412TSPF FIRM NO. 151TBPIS FIRM NO. 10003700WEBSTEGERBIZZELL.COM

SERVICES>>ENGINEERS>>PLANNERS>>SURVEYORS

WILLIAMSON COUNTY
CR 111 IMPROVEMENTS

ESTIMATE &
QUANTITIES

DATE: 8/26/2022DN:DW:CK:AP:

FED. RD. DIV. NO.6

FEDERAL AID PROJECT NO.----

SHEET NO.15

STATETEXAS

DIST.---

COUNTYWILLIAMSON

CONT.----

SECT.--

JOB---

HIGHWAY NO.CR 111

7

8

6

6

6

7




8



ADDRESS	1978 S. AUSTIN AVENUE		GEORGETOWN, TX 78626	
METRO	512.930.9412	TBPE FIRM NO. 181 TBPLS FIRM NO. 10003700	WEB	STEGERBIZZELL.COM
SERVICES	>>ENGINEERS		>>PLANNERS	>>SURVEYORS

SUMMARY OF ROADWAY QUANTITIES


DATE: 8/26/2022	DN:	DW:	CK:	AP:
FED. RD. DIV. NO.	FEDERAL AID PROJECT NO.			SHEET NO.
6	-----			17
STATE	DIST.	COUNTY		
TEXAS	---	WILLIAMSON		
CONT.	SECT.	JOB	HIGHWAY NO.	
----	--	---	CR 111	

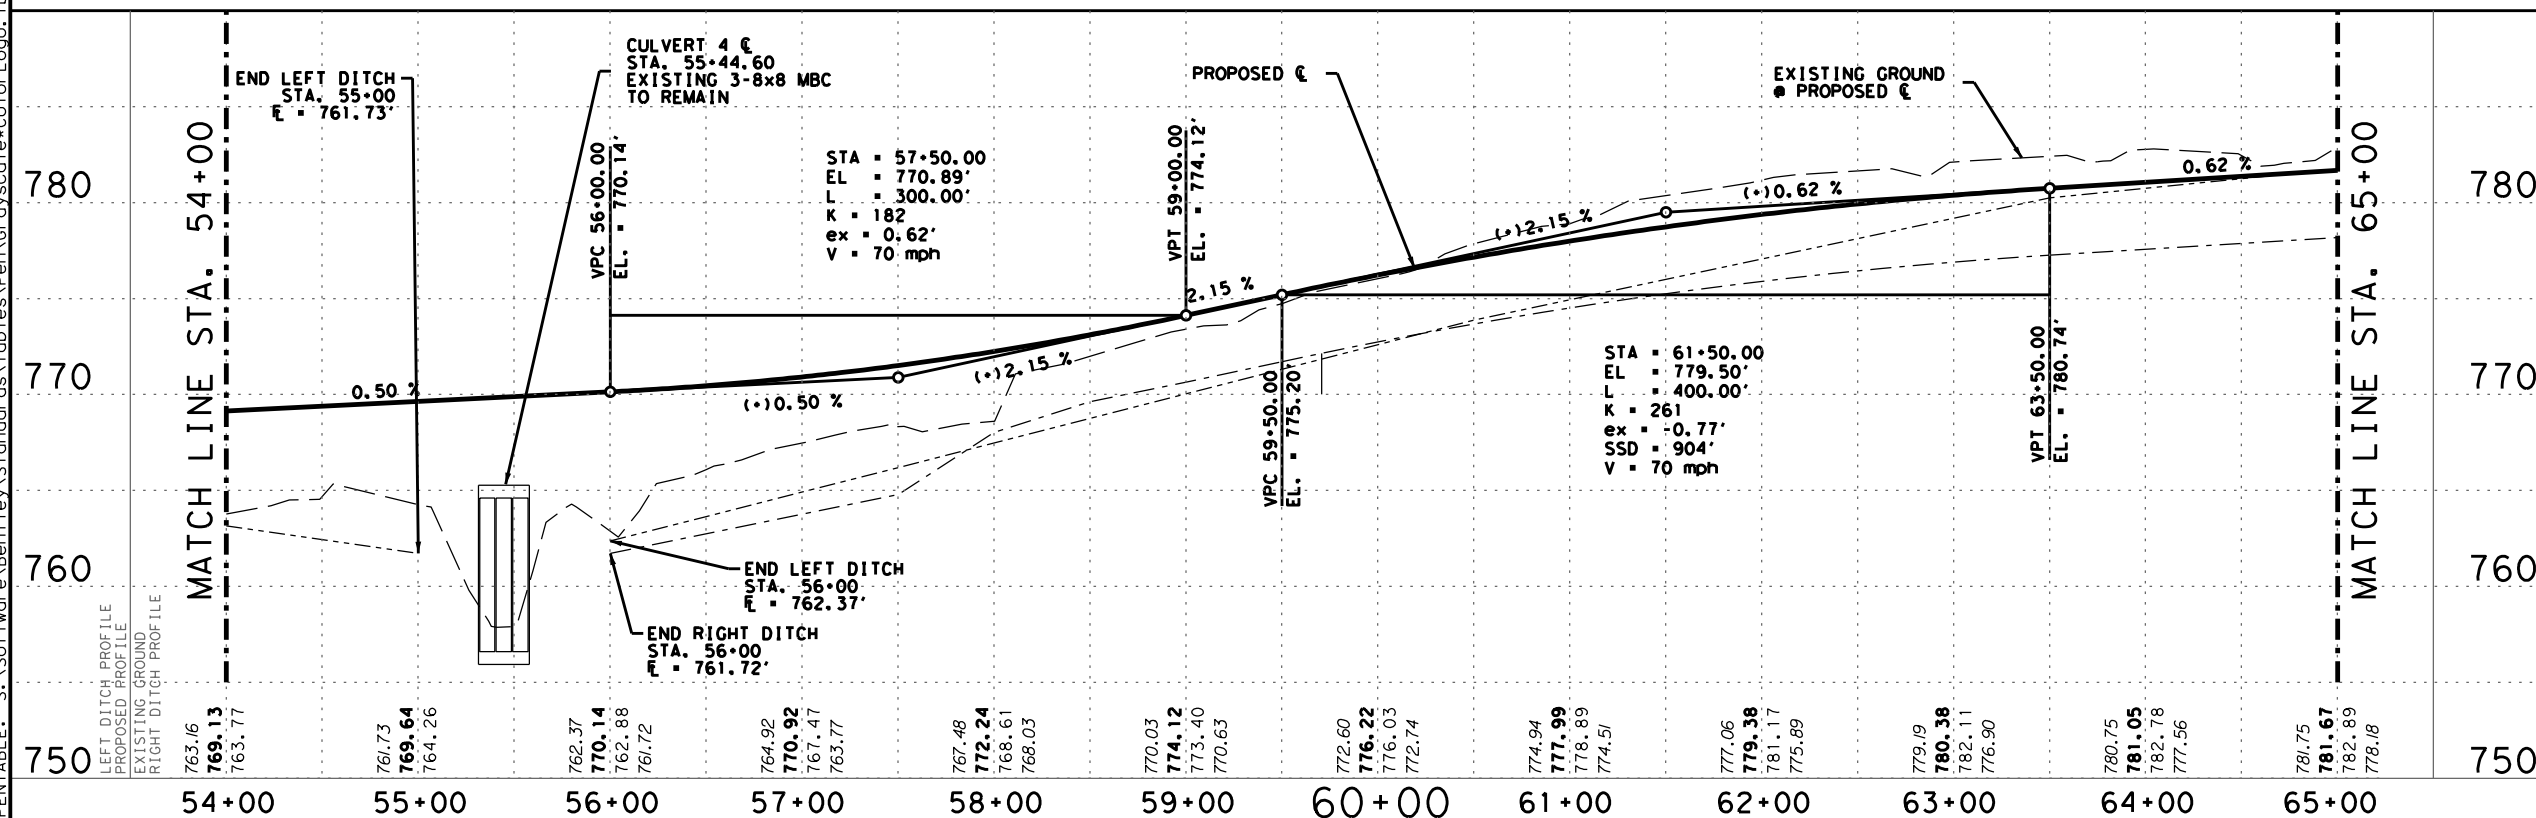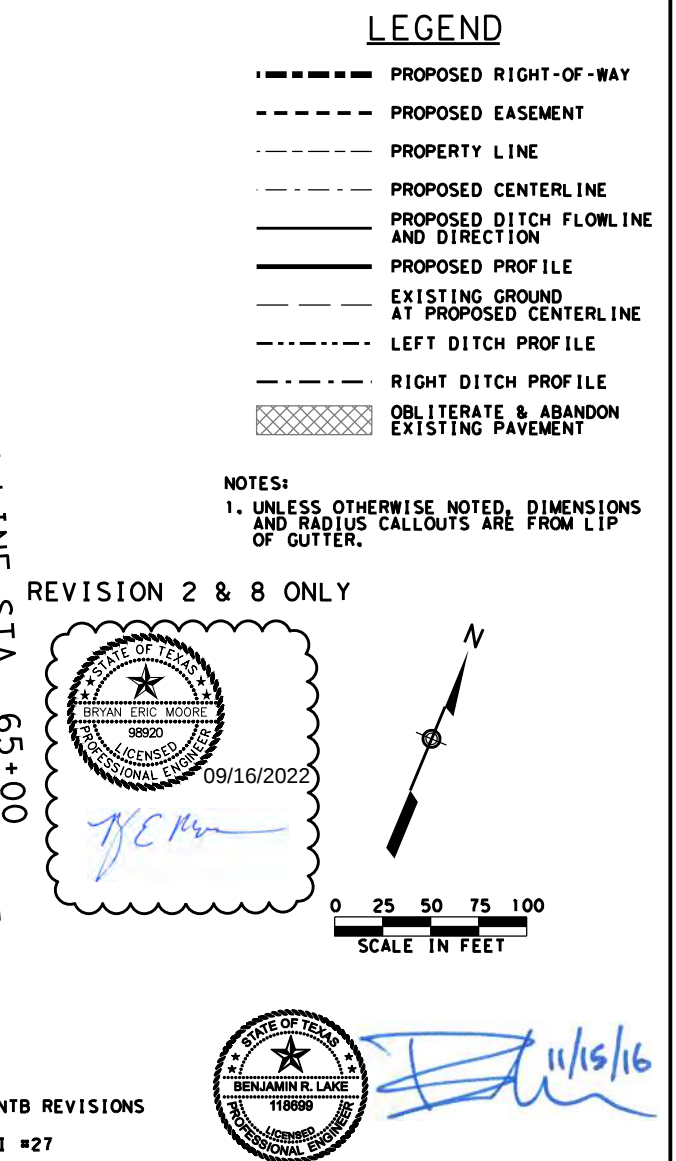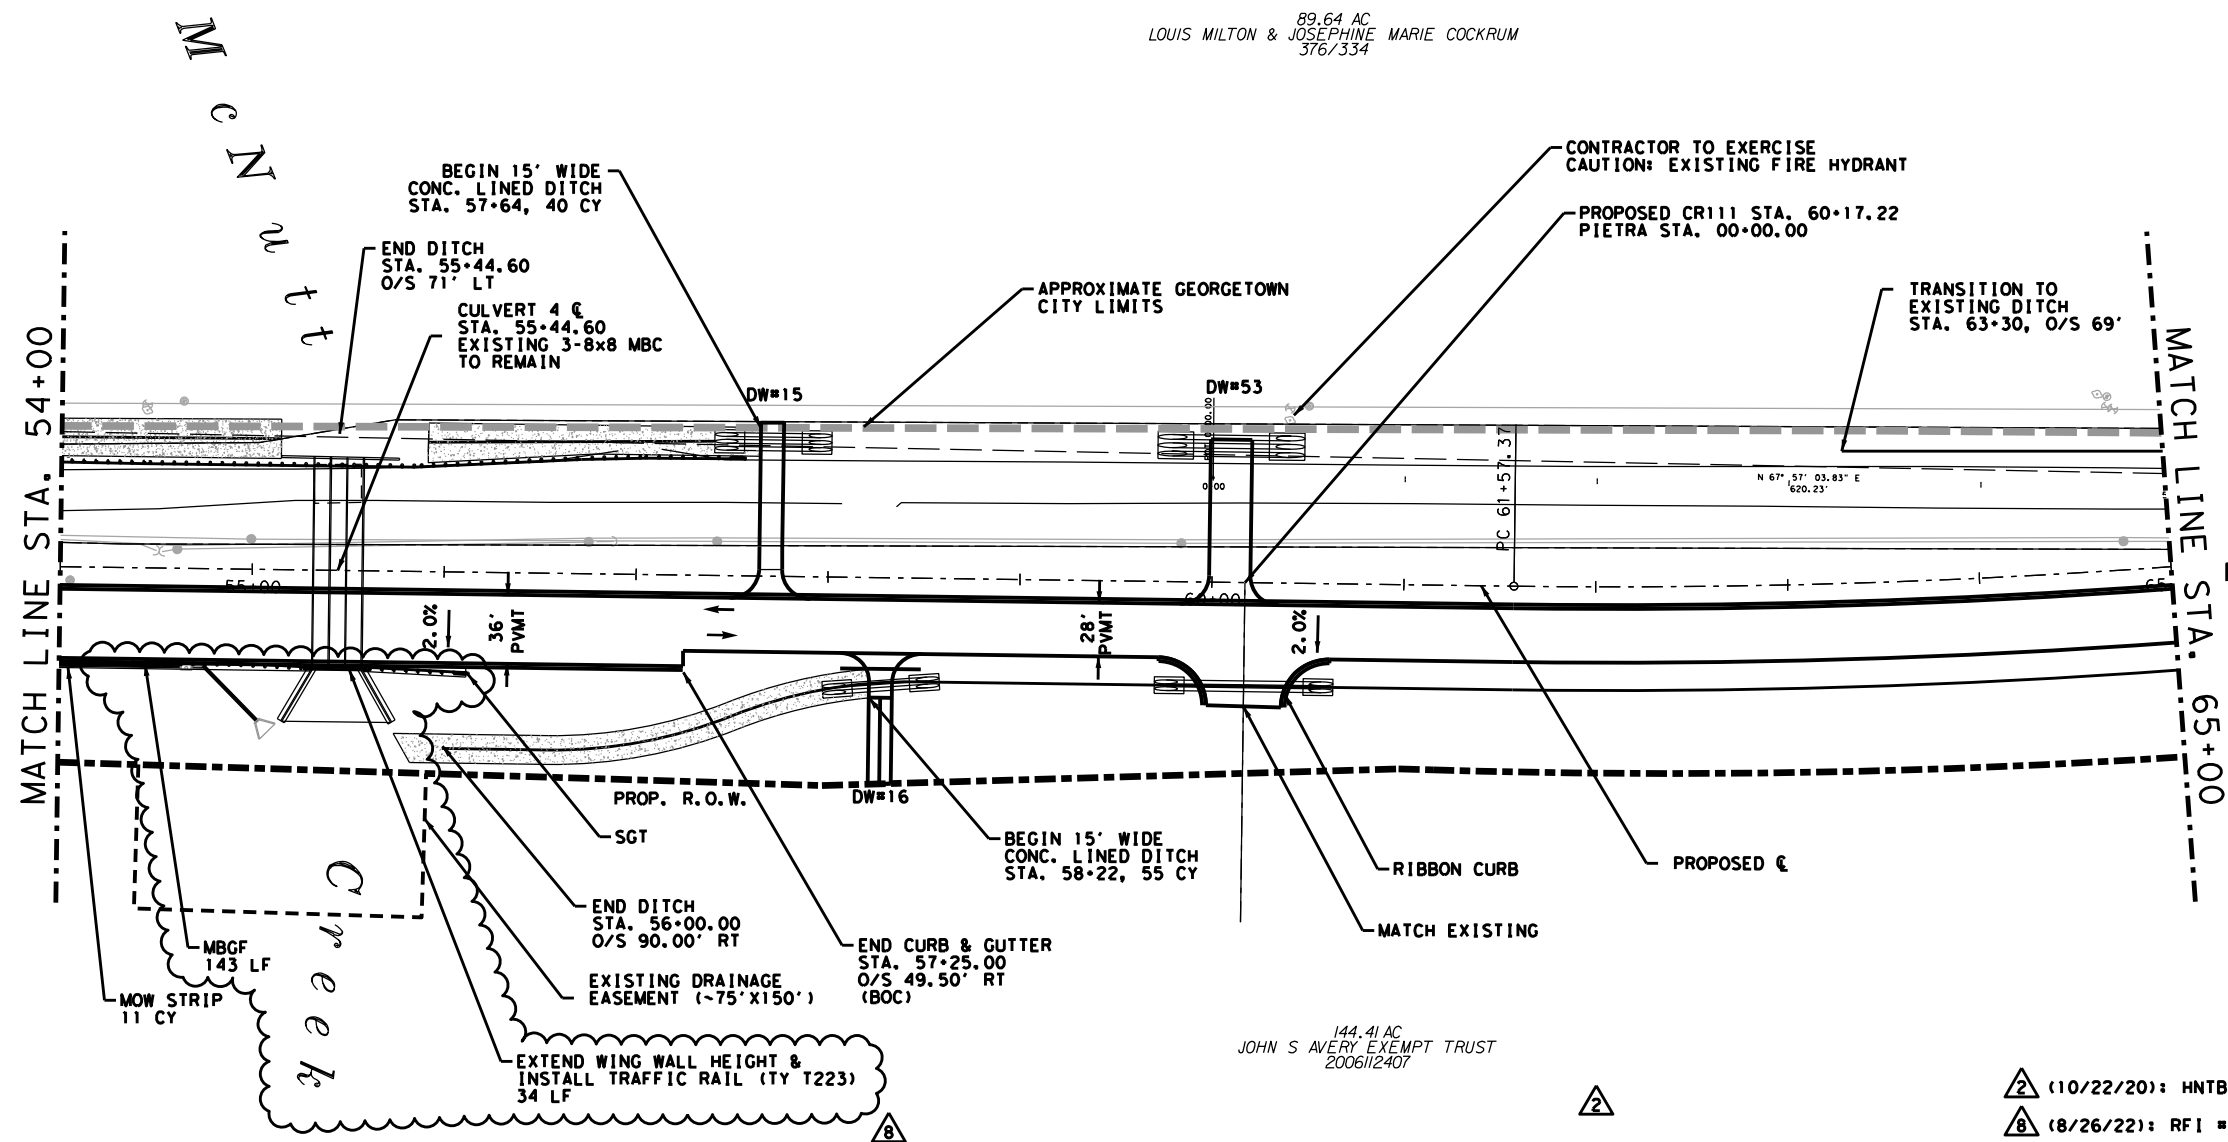


 WILLIAMSON COUNTY 1848				© 2016	
					
ADDRESS		1978 S. AUSTIN AVENUE		GEORGETOWN, TX 78626	
METRO		512.930.9412		TYPE FIRM NO. 181 TBPLS FIRM NO. 10003700	WEB STEGERBIZZELL.COM
SERVICE		>>ENGINEERS		>>PLANNERS	>>SURVEYORS
WILLIAMSON COUNTY CR 111 IMPROVEMENTS					
 CR 111 PLAN & PROFILE					
SHEET 5 OF 18					
DATE: 8/26/2022		DN:	DW:	CK:	AP:
FED. RD. DIV. NO. 6		FEDERAL AID PROJECT NO. ----			SHEET NO. 92
STATE		DIST.	COUNTY		
TEXAS		---	WILLIAMSON		
CONT.		SECT.	JOB		HIGHWAY NO.
----		--	---		CR 111

DISCLAIMER: The use of this standard is governed by the "Texas Engineering Practice Act". No warranty of any kind is made by TxDOT for any purpose whatsoever. TxDOT assumes no responsibility for the conversion of this standard to other formats or for incorrect results or damages resulting from its use.

DATE:
FILE:

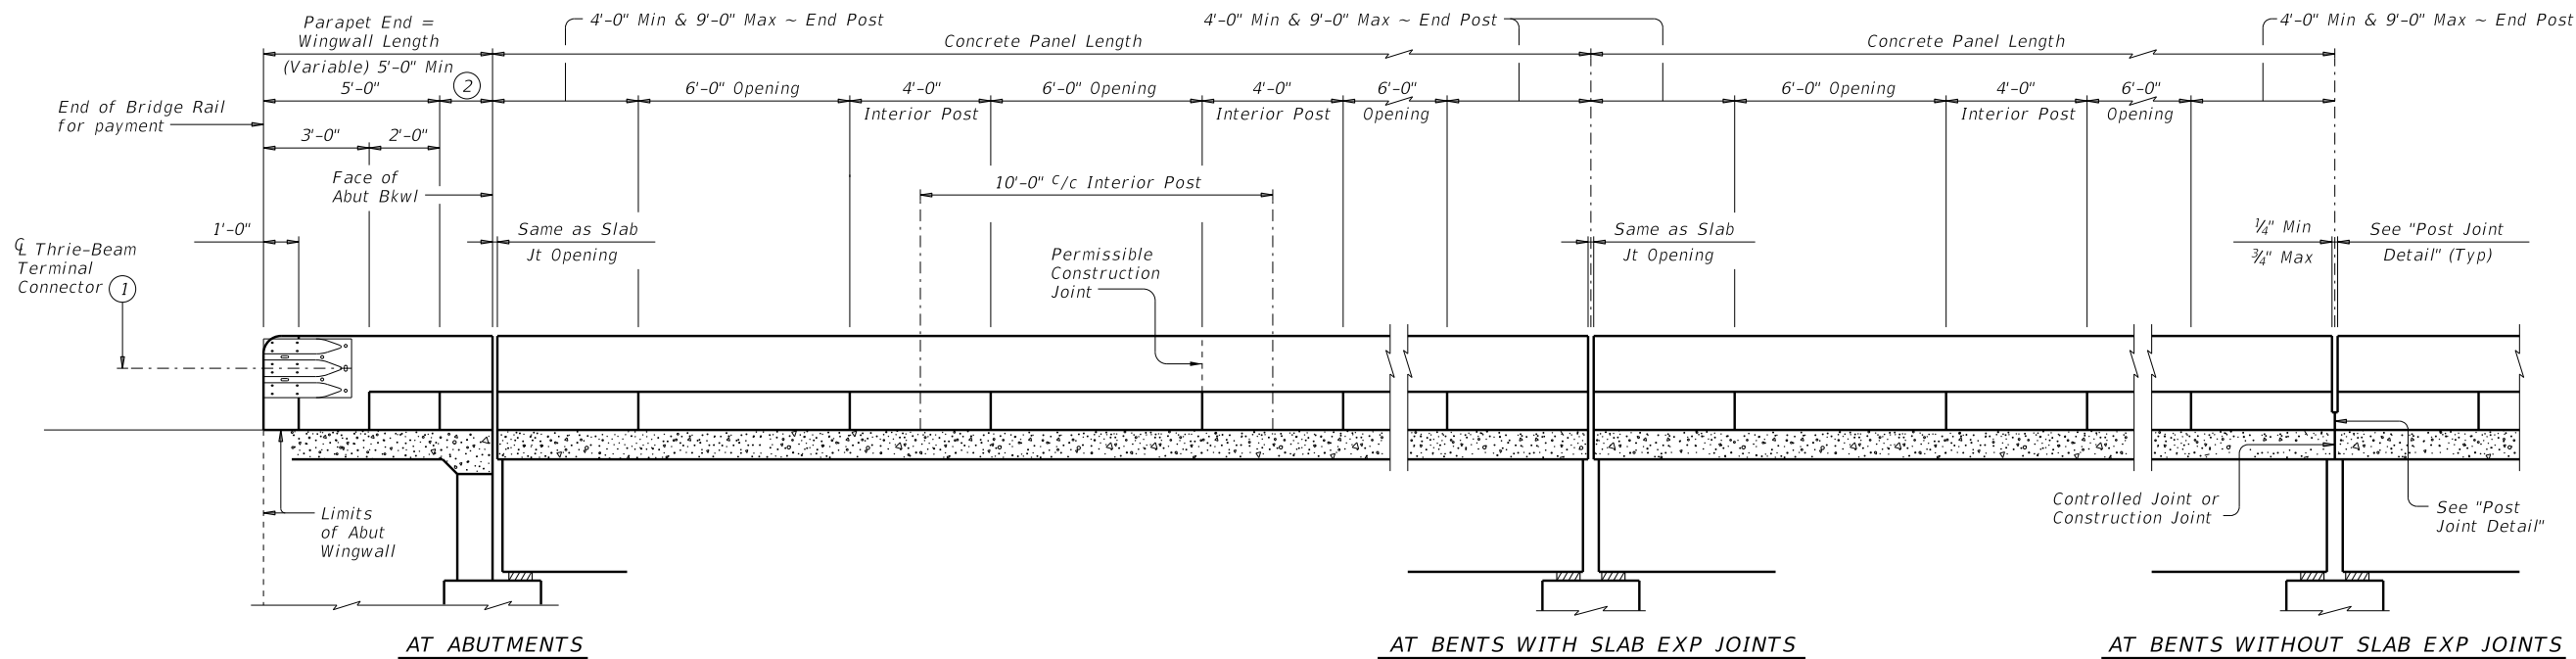

ROADWAY ELEVATION OF RAIL ON BRIDGE

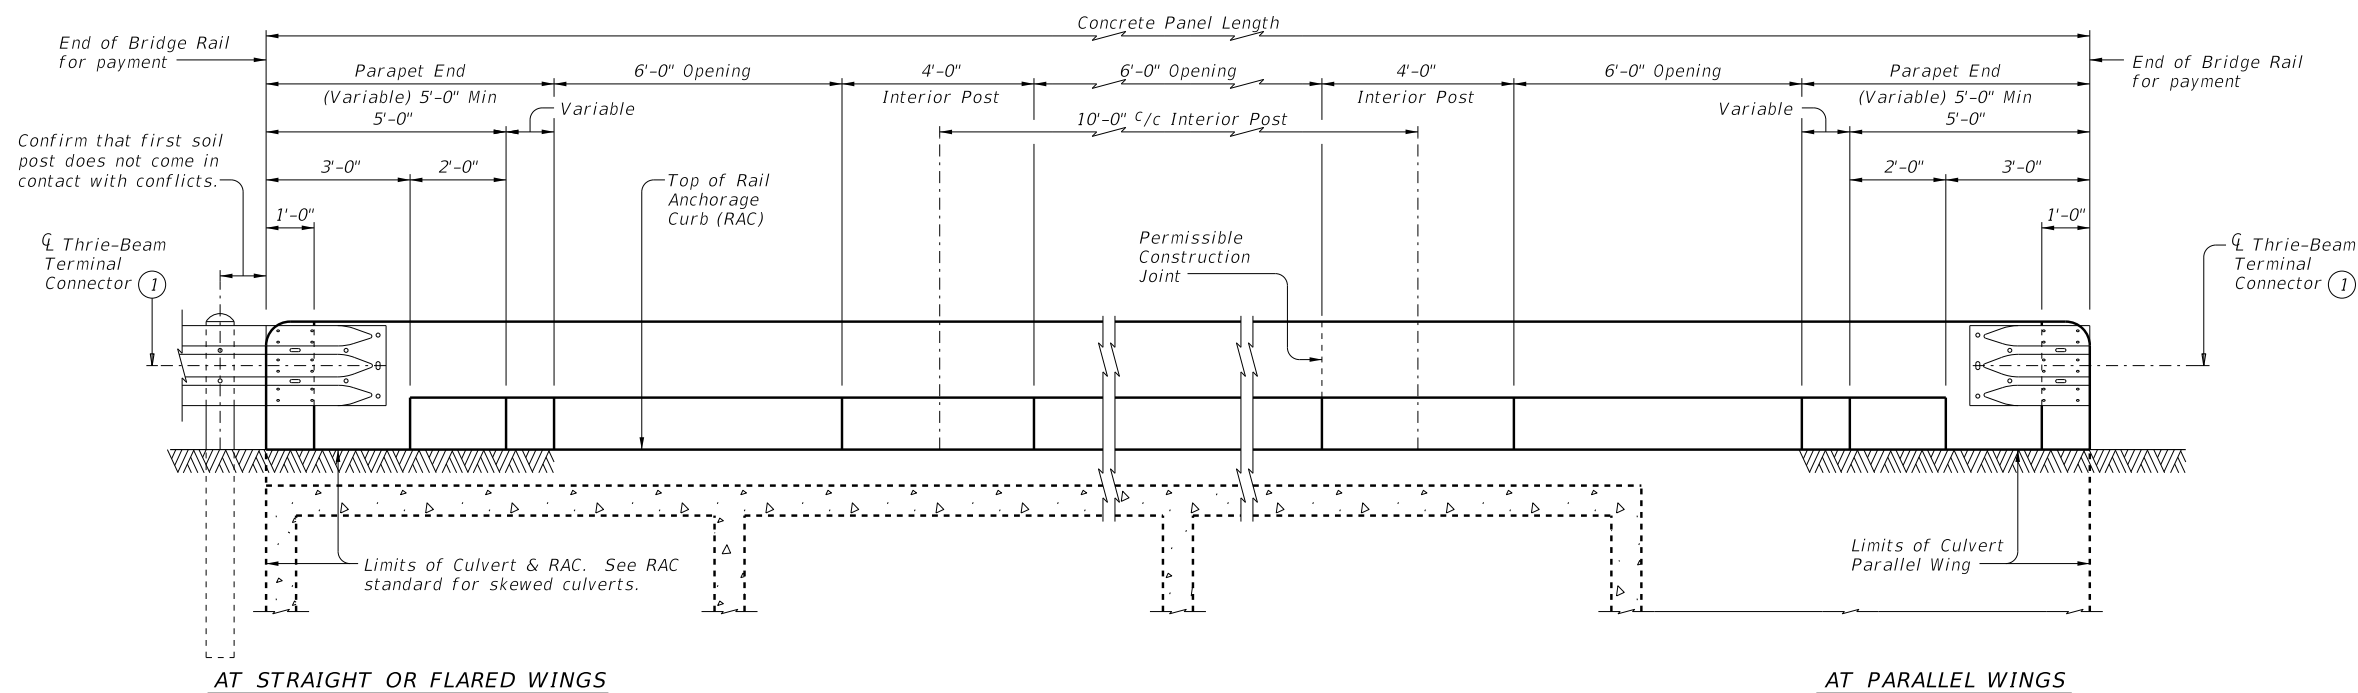

ROADWAY ELEVATION OF RAIL ON BOX CULVERTS

Showing 0° skew culvert. Skewed culverts similar. See RAC standard for details not shown.
Vertical joints in concrete rail are not required, unless shown elsewhere.

- ① Terminal Connectors and associated hardware are to be paid for under the Item "Metal Beam Guard Fence". Attach Metal Beam Guard Fence Transitions to the bridge rail and extend along the embankment unless otherwise shown in the plans.

- ② Wingwall Length minus 5'-0" (Varies)

SHEET 1 OF 3



Bridge
Division
Standard





TRAFFIC RAIL

TYPE T223

FILE: r1std005-19.dgn	DN: TxDOT	CK: TxDOT	DW: JTR	CK: AES
©TxDOT September 2019	CONT	SECT	JOB	HIGHWAY
REVISIONS				
DIST	COUNTY			SHEET NO.
				113A

DISCLAIMER:
The use of this standard is governed by the "Texas Engineering Practice Act". No warranty of any kind is made by TxDOT for any purpose whatsoever. TxDOT assumes no responsibility for the conversion of this standard to other formats or for incorrect results or damages resulting from its use.

DATE:
FILE:

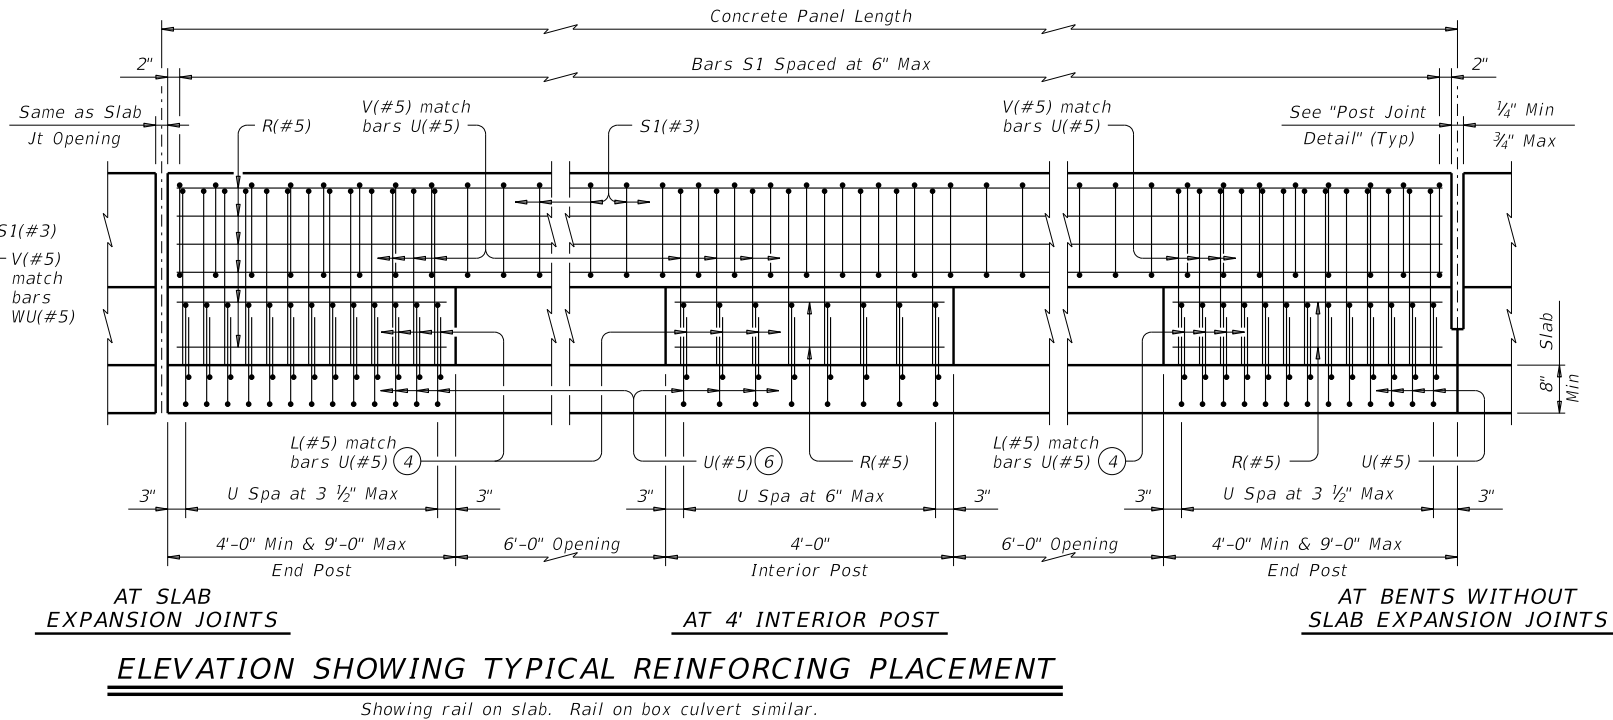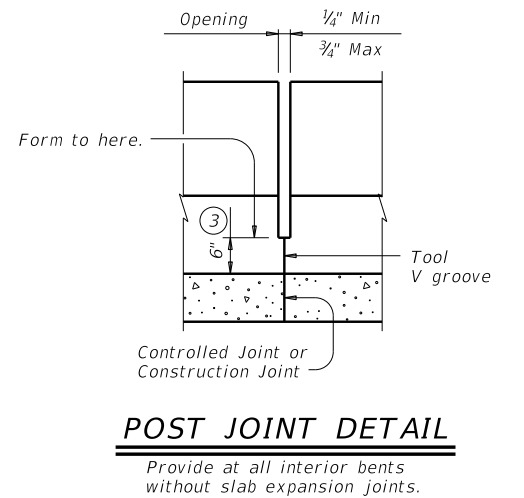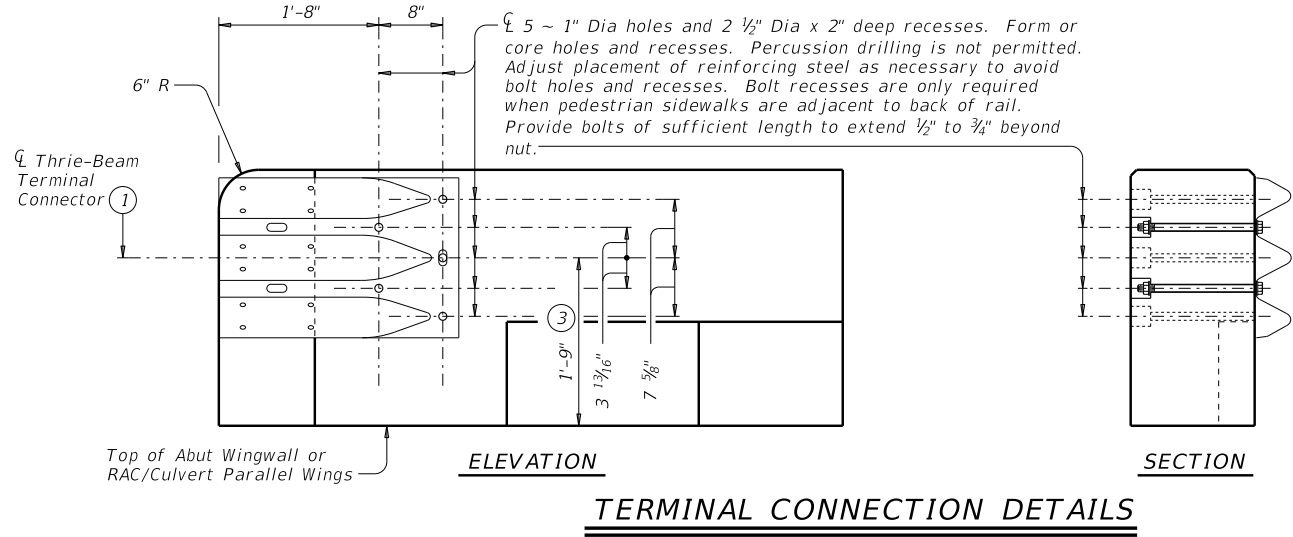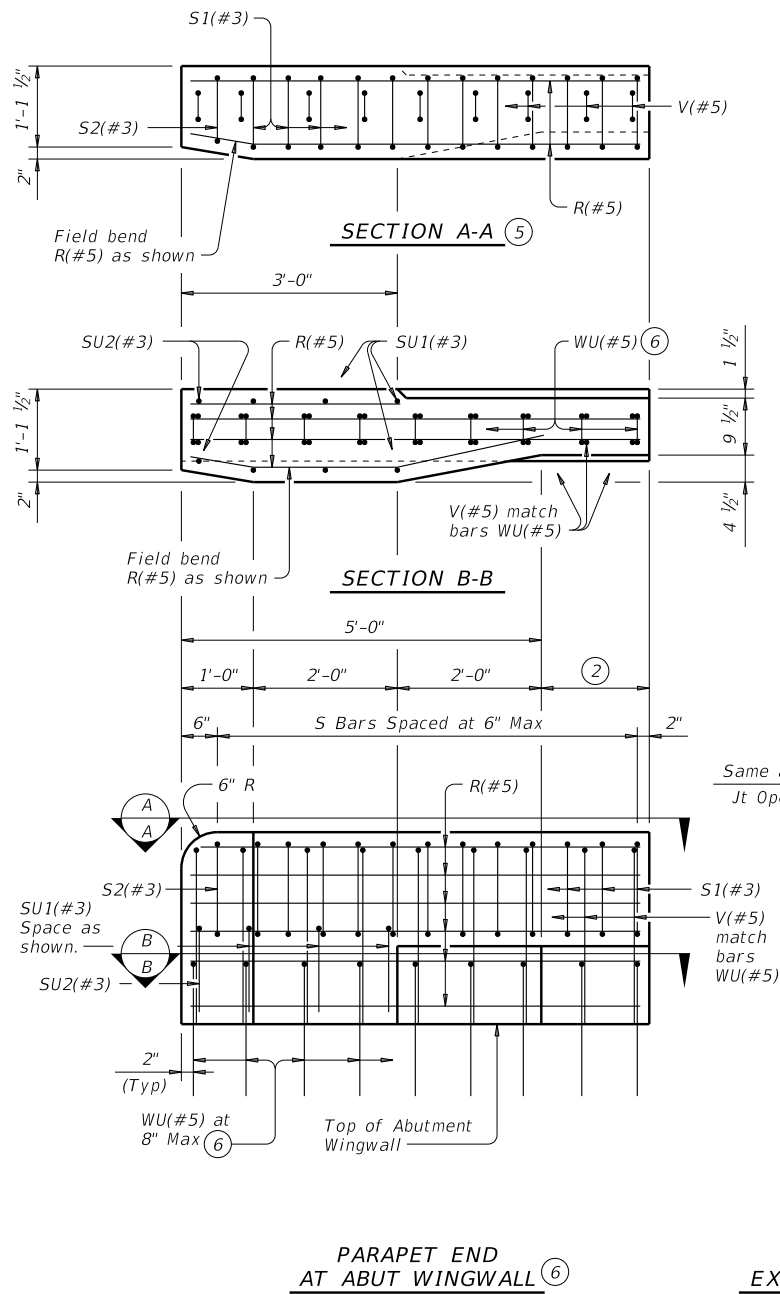

- ① Terminal Connectors and associated hardware are to be paid for under the Item "Metal Beam Guard Fence". Attach Metal Beam Guard Fence Transitions to the bridge rail and extend along the embankment unless otherwise shown in the plans.
- ② Wingwall Length minus 5'-0" (Varies)
- ③ Increase 2" for structures with overlay.
- ④ Bars L(#5) are part of rail reinforcing and are included in unit price bid for railing. Space with Bars U. Bars L match slab bar cover. Bars L may be bundled with top slab reinforcing if spacing is equivalent.
- ⑤ Bars SU1(#3), SU2(#3) and WU(#5) not shown for clarity.
- ⑥ Substitute Bars U(#5) for Bars WU(#5) when parapet end is located on anchorage curb over culvert top slab. Use Bars WU(#5) in culvert parallel wings.

SHEET 2 OF 3

Texas Department of Transportation

Bridge Division Standard


TRAFFIC RAIL

TYPE T223


FILE: r1std005-19.dgn	DN: TxDOT	CK: TxDOT	DW: JTR	CK: AES
©TxDOT September 2019	CONT	SECT	JOB	HIGHWAY
REVISIONS	DIST	COUNTY	SHEET NO.	
			113B	

DISCLAIMER:
The use of this standard is governed by the "Texas Engineering Practice Act". No warranty of any kind is made by TxDOT for any purpose whatsoever. TxDOT assumes no responsibility for the conversion of this standard to other formats or for incorrect results or damages resulting from its use.


DATE:
FILE:

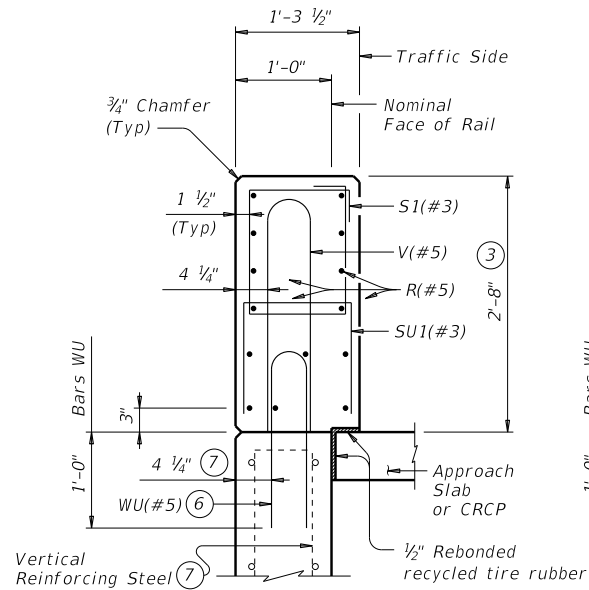


**SECTION C-C
ON ABUTMENT WINGWALLS
OR CIP RETAINING WALLS**

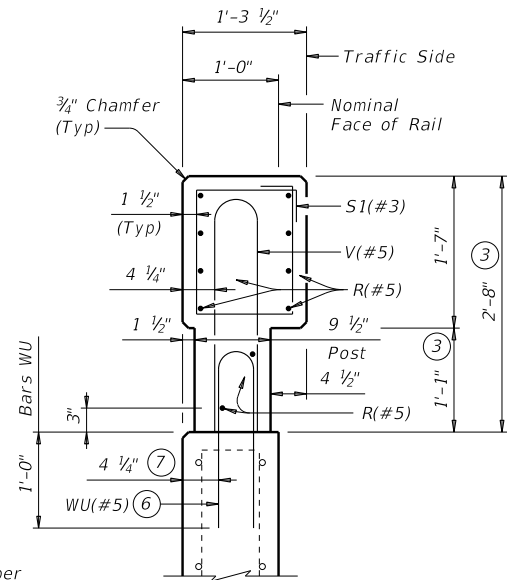


**SECTION D-D
ON ABUTMENT WINGWALLS
OR CIP RETAINING WALLS**

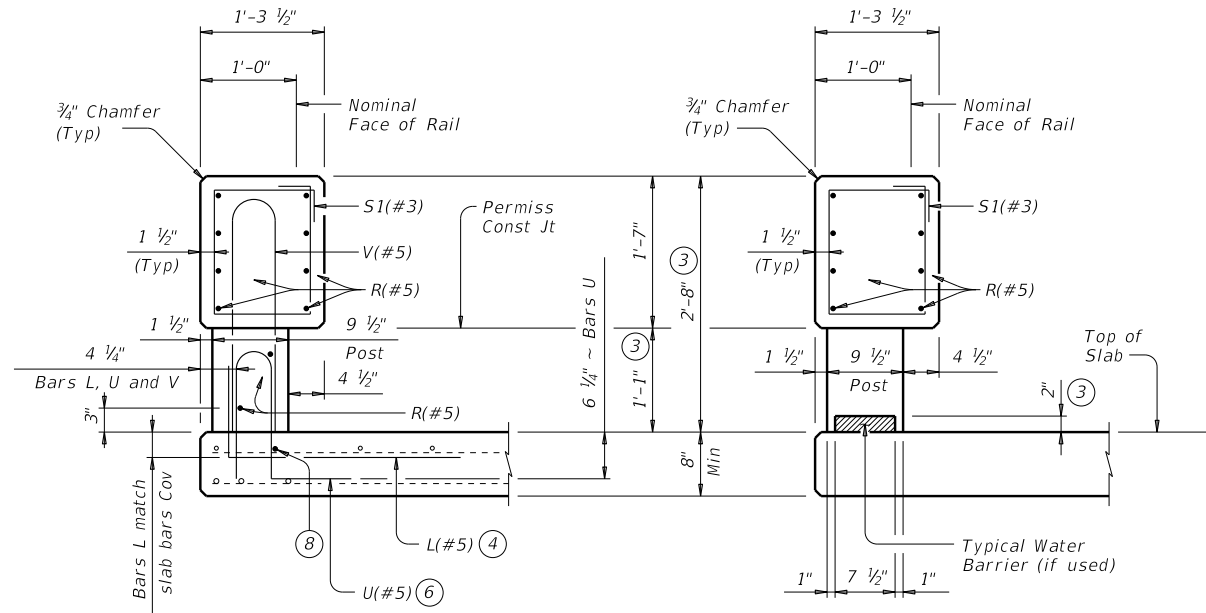

**AT POST
ON BRIDGE SLAB**

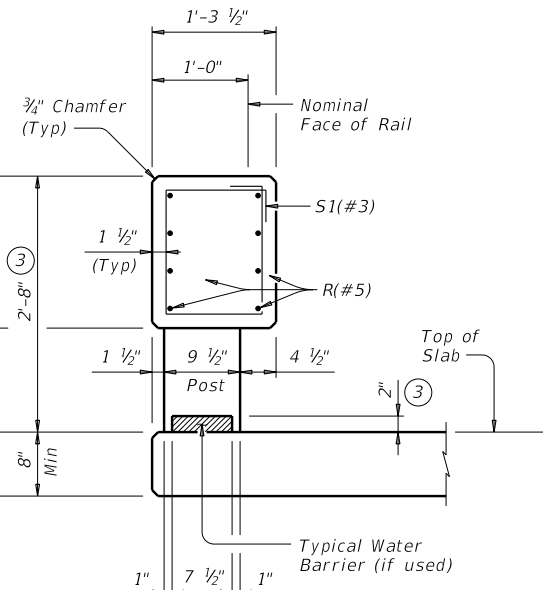

**AT OPENING
ON BRIDGE SLAB**

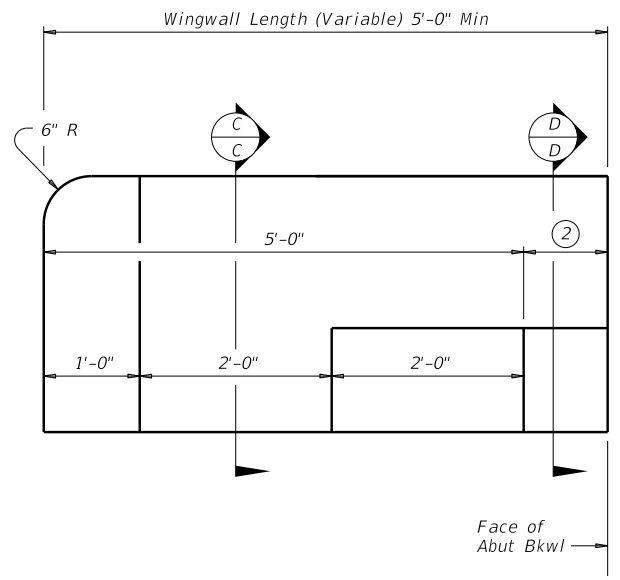

**ELEVATION AT
ABUTMENT WINGWALL**

Box culvert parallel wings or rail anchorage curb similar.

CONSTRUCTION NOTES:

Face of rail and parapet must be vertical transversely unless otherwise shown in the plans or approved by the Engineer.
Provide water barriers at openings draining onto undercrossing roadways and sidewalks. They may be cast-in-place or precast in convenient lengths and bonded to the bridge deck with an approved epoxy cement.
Chamfer all exposed corners.

MATERIAL NOTES:

Provide Class "C" concrete. Provide Class "C" (HPC) if required elsewhere.
Provide Grade 60 reinforcing steel.
Epoxy coat or galvanize all reinforcing steel if slab bars are epoxy coated or galvanized.
Deformed Welded Wire Reinforcing (WWR) (ASTM A1064) of equal size and spacing may be substituted for Bars U, V, and WU unless noted otherwise. Provide the same laps as required for reinforcing bars.
Provide bar laps, where required, as follows:
Uncoated or galvanized ~ #5 = 2'-0"
Epoxy coated ~ #5 = 3'-0"

GENERAL NOTES:


This rail has been evaluated by full-scale crash test to meet MASH TL-3 criteria. This rail can be used for speeds of 50 mph and greater when a TL-3 rated guard fence transition is used. When a TL-2 rated guard fence transition is used, this rail can only be used for speeds of 45 mph and less.
Do not use this railing on bridges with expansion joints providing more than 5" movement.
Rail anchorage details shown on this standard may require modification for select structure types. See appropriate details elsewhere in plans for these modifications.
Shop drawings are not required for this rail.
Average weight of railing with no overlay is 358 plf.

Cover dimensions are clear dimensions, unless noted otherwise.
Reinforcing bar dimensions shown are out-to-out of bar.

SECTIONS THRU RAIL


Sections on box culverts similar.

- Wingwall Length minus 5'-0" (Varies)
- Increase 2" for structures with overlay.
- Bars L(#5) are part of rail reinforcing and are included in unit price bid for railing. Space with Bars U. Bars L match slab bar cover. Bars L may be bundled with top slab reinforcing if spacing is equivalent.
- Substitute Bars U(#5) for Bars WU(#5) when parapet end is located on anchorage curb over culvert top slab. Use Bars WU(#5) in culvert parallel wings.
- When vertical reinforcing has closer clear cover over horizontal reinforcing in abutment wingwalls on traffic side of wall, move the horizontal wingwall/retaining wall reinforcing to the inside of Bars WU where bars conflict.
- Top longitudinal slab bar may be adjusted laterally 3" plus or minus to tie reinforcing.
- At the Contractor's option, Bars V may be replaced by extending Bars U to 2'-5 1/4" above the roadway surface without overlay.

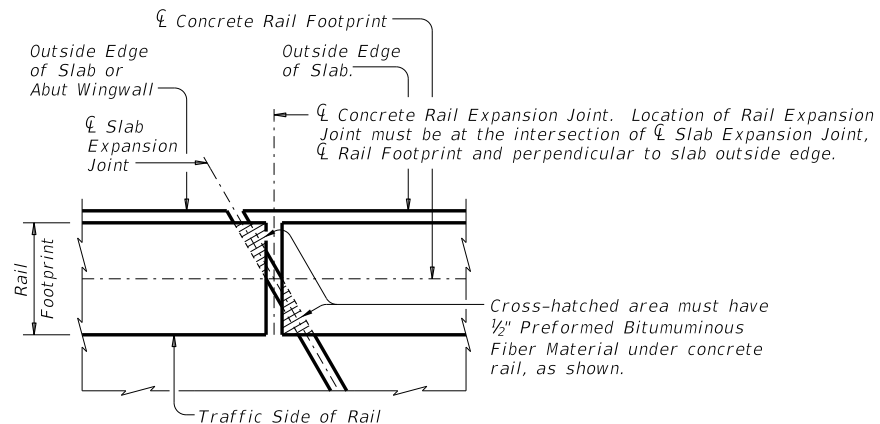


PLAN OF RAIL AT EXPANSION JOINTS


Example showing Slab Expansion Joints without breakbacks.

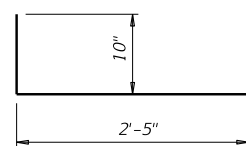


BARS L (#5)

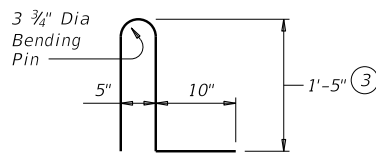


BARS U (#5) 9

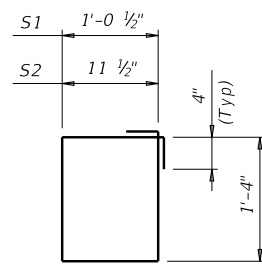


BARS S (#3)

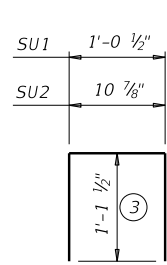

BARS SU (#3)

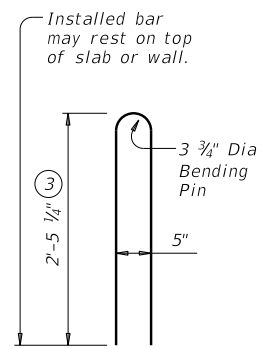

BARS V (#5) 9

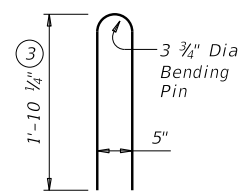

BARS WU (#5)

SHEET 3 OF 3



Texas Department of Transportation

Bridge Division Standard

TRAFFIC RAIL

TYPE T223

FILE: r1std005-19.dgn	DN: TxDOT	CK: TxDOT	DW: JTR	CK: AES
©TxDOT September 2019	CONT	SECT	JOB	HIGHWAY
REVISIONS				
	DIST	COUNTY		SHEET NO.
				113C