

NOTICE OF PROPOSED INSTALLATION

UTILITY LINE ON WILLIAMSON COUNTY RIGHT-OF-WAY

TO: Williamson County Unified Road System

DATE: Oct 24 2008

3151 S. E. Inner Loop, Suite B
Georgetown, Texas 78626

Formal notice is hereby given that Chisholm Trail S.U.D

Company proposes to place a 6" water line KX (and do a road cut on North Lakewood)

Line within the right-of-way of Cherrywood Lane and North Lakewood

as follows: (give location, length, general design, etc.)

The line will be constructed and maintained on the road right-of-way as directed by the Williamson County Unified Road System in accordance with governing laws.

Our firm further understands that the County considers proper traffic control measures as those complying with applicable portions of the Texas Manual of Traffic Control Devices required for adoption by the "Transportation Code" (V.C.T.A. CH.251)

The location and description of the proposed line and appurtenances is more fully shown by ___ copies of drawings attached to this notice.

Construction of this line is proposed to begin on or after the 27 day of OCT 2008.

APPROVAL

This application is hereby approved subject to the following understandings and restrictions.

It is expressly understood that the said County Commissioners' Court does not imply hereby to grant any right, claim, title or easement in or upon this County Road; and it is further understood that in the future, should Williamson County, for any reason, need to work, improve, relocate, widen, increase, add to, decrease, or in any manner change the structure of this road or right-of-way, this line, if affected, will be moved at the direction of the Williamson County Engineer or County Commissioner. This installation work shall not damage any part of the roadway and adequate provisions shall be made to cause a minimum of inconvenience to traffic and adjacent property owners.

APPROVED BY WILLIAMSON COUNTY COMMISSIONERS' COURT

BY: [Signature]
COUNTY ROAD ADMINISTRATOR

DATE: 11/12/08

Firm: Chisholm Trail S.U.D

Authorized Signature

Printed Name

Address: P.O. Box 249

Florence TX 76527

Phone: 254-793-3103

Fax: 254-793-3100



per pd. co. reg. # 59242

Land # 4357351
Road cut
11/5/08
BC

pt. 3

CONTRACTOR'S LIABILITY AGREEMENT

I, LARRY FEAST (Royal Vista) Contractor for Chisholm Trail S.U.D.
in Williamson County, Texas do hereby agree to the following schedules and conditions for doing work within
the right-of-way of Lakewood Drive which is a public roadway
maintained by Williamson County.

1. I will contact the Williamson County Unified Road System at least 48 hours prior to start of construction.
2. All work in the right-of-way will be done between the hours of 8:30 a.m. and 4:30 p.m. on Monday through Friday only.
3. Cuts will be opened for one-half the roadway only, with flagmen on both sides of the work area, allowing one-way traffic through. This type of operation will be held to a minimum and all advance warning signs and barricades shall be as specified in the Texas Manual on Uniform Traffic Control Devices. These cuts will also be filled and entire roadway opened at night and on weekends.
4. Roadside work in ditches alongside the trenched surface may be left opened at night, only if they can be barricaded solidly between open ditch and traveled roadway leaving a minimum 6' of road shoulder between the pavement edge and the barricades. The barricades must be reflective and lighted with warning lights and conform to the requirements of the T.M.U.T.C.D. for nighttime use.
5. Any construction area to be maintained from dusk to dawn shall have Type B High Intensity Steady Burn Warning Lights to delineate the traveled way through and around obstructions in a construction or maintenance area. All warning lights shall be installed to a minimum mounting height of 36" to the bottom of the lens.
6. Construction work and road repair on County right-of-way will be done to Williamson County Standards and to the approval of the Williamson County Unified Road System.
7. I will notify the Williamson County Unified Road System and obtain approval prior to any changes from this agreement if required due to soil conditions or other problems.

11/10/2008
DATE

Williamson County Unified Road System
3151 S. E. Inner Loop, Ste. B
Georgetown, Texas 78626


[Signature]
SIGNED
Royal Vista Inc
CONTRACTOR (PRINT NAME)

350 CR 260
ADDRESS

Lithology Works, Inc
CITY, STATE, ZIP CODE

512-515-6824
PHONE

78642

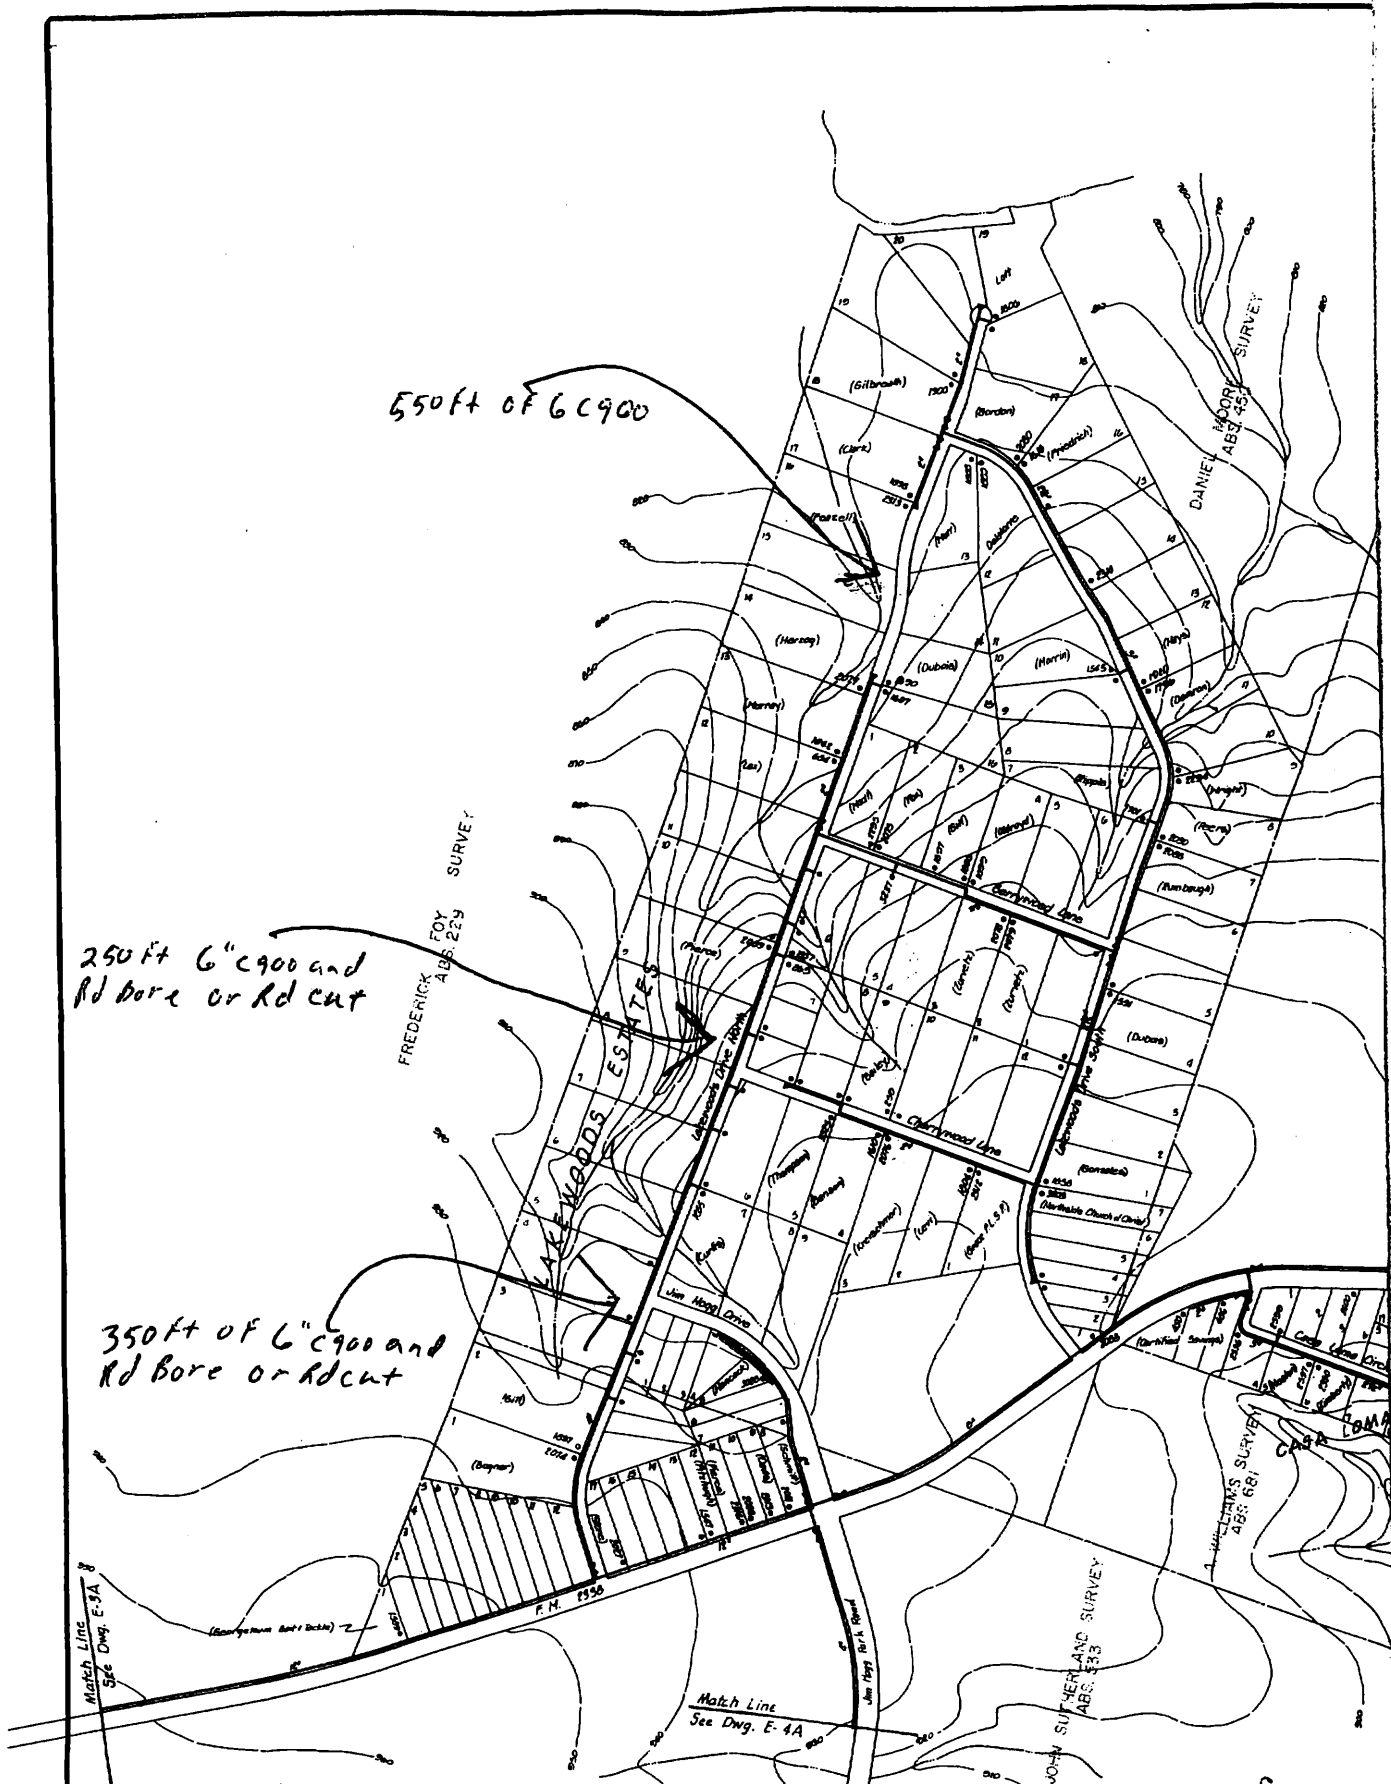

NO.	REVISION	BY	DATE	NO.	REVISION	BY	DATE

DESIGNED BY _____ DATE _____

DRAWN BY _____ DATE 11-82

CHECKED BY _____ DATE 11-82

APPROVED BY _____ DATE _____

RECORD DRAWING

