# WILLIAMSON COUNTY, TEXAS CHANGE ORDER NUMBER: 1

1. CONTRACTOR: The Levy Company		Project:	23IFB21
2. Change Order Work Limits: Sta. 490+00 to	Sta. <b>520+00</b>	Roadway:	RR at Elizabeth Parkway Temp Signals
3. Type of Change(on federal-aid non-exempt projects):	(Major/Minor)	CSJ Number:	
4. Reasons:(3 Max In order	of importance - Primary first)		
· —	nave been altered since the ini the contractor for installing a te nent controller which has a long the Attached	tial design and mporary contro	this Change Order will oller so that the signal
7. New or revised plan sheet(s) are attached and number			
8. New Special Provisions/Specifications to the contract a		☑ N	
9. New Special Provisions to Item $N/A$ No. $N/A$ , Special Provisions to Item $N/A$	cial Specification Item <u>N/</u>	A are attacl	hed.
Each signatory hereby warrants that each has the authorit	ty to execute this Change O	rder (CO).	
The contractor must sign the Change Order and, by doing so, agrees to waive any and all claims for additional compensation due to any and all other	The following informat	•	•
expenses; additional changes for time, overhead and profit; or loss of compensation as a result of this change.	Time Ext. #: N/A [	Days added o	n this CO: N/A
THE CONTRACTOR Date 5/16/2023	Amount added by this cha	nge order:	\$28,245.75
By Andrew Hardy  Typed/Printed Name Andrew Hardy  Typed/Printed Title Project Coordinator			
	<u>I.</u>		
RECOMMENDED FOR EXECUTION:			
	Caumbi C	nor Dec -! (	4 D-1
Project Manager Date	County Commission		1 Date QUEST APPROVAL
	<del> </del>		
	County Commission		
N/A Design Engineer Date	□ APPROVED	□ REG	QUEST APPROVAL
0.00	County Commissi	anor Procinct	2 Doto
Christen Suhlyana Marion	APPROVER	DE/	3 Date QUEST APPROVAL
Program Manager 5/16/2023  Date	_ APPROVED	□ REG	QUEUT AFFRUVAL
Design Engineer's Seal:			
Design Engineer's Ocal.	County Commission	oner Precinct	4 Date
	□ APPROVED		QUEST APPROVAL
	Bill Gravell		May 24, 2023
	Bill Gravell (May 24, 2023 12:03 CDT)  County	ludae	Date
	□ APPROVED	, <b>3</b> ,	24.0

### WILLIAMSON COUNTY, TEXAS

1	Project # Ronald Reagan at Elizabeth Park Temp Signals
TABLE A: Force Account Work and Materials Placed into Stock	<del></del>

LABOR	HOURLY RATE	HOURLY RATE					

TABLE B: Contract Items:

				ORIGINAL + PRE	VIOUSLY REVISED	ADD or (DEDUCT)	NEW		
ITEM	DESCRIPTION	UNIT	UNIT PRICE	QUANTITY	ITEM COST	QUANTITY	QUANTITY	ITEM COST	OVERRUN/ UNDERRUN
618-6029	CONDT (PVC) (SCH 40) (3")	LF	\$20.00	860.00	\$17,200.00	(675.00)	185.00	\$3,700.00	(\$13,500.00)
618-6070	CONDT (RM) (2")	LF	\$38.00	25.00	\$950.00	65.00	90.00	\$3,420.00	\$2,470.00
620-6007	ELEC CONDR (NO.8) BARE	LF	\$1.70	205.00	\$348.50	(10.00)	195.00	\$331.50	(\$17.00)
620-6008	ELEC CONDR (NO.8) INSULATED	LF	\$1.70	1,910.00	\$3,247.00	1,010.00	2,920.00	\$4,964.00	\$1,717.00
620-6009	ELEC CONDR (NO.6) BARE	LF	\$2.00	185.00	\$370.00	(165.00)	20.00	\$40.00	(\$330.00)
620-6010	ELEC CONDR (NO.6) INSULATED	LF	\$2.00	370.00	\$740.00	255.00	625.00	\$1,250.00	\$510.00
625-6003	ZINC-COAT STL WIRE STRAND (3/8")	LF	\$3.50	1,610.00	\$5,635.00	115.00	1,725.00	\$6,037.50	\$402.50
628-6145	ELC SRV TY D 120/240 060(NS)SS(E)SP(O)	EA	\$8,500.00	1.00	\$8,500.00	(1.00)	0.00	\$0.00	(\$8,500.00)
666-6126	REFL PAV MRK TY I (Y) 4" (SLD) (100MIL)	LF	\$1.20	1,550.00	\$1,860.00	10.00	1,560.00	\$1,872.00	\$12.00
684-6010	TRF SIG CBL (TY A) (12 AWG)(5 CONDR)	LF	\$2.75	2,480.00	\$6,820.00	35.00	2,515.00	\$6,916.25	\$96.25
627-6002	TIMBER POLE (CL 2) 40 FT	EA	\$5,300.00	0.00	\$0.00	2.00	2.00	\$10,600.00	\$10,600.00
628-WC01	ELC SRV TY D 120/240 060(NS)SS(E)EX(U)	EA	\$8,700.00	0.00	\$0.00	1.00	1.00	\$8,700.00	\$8,700.00
618-6023	CONDT (PVC) (SCH 40) (2")	LF	\$65.00	0.00	\$0.00	25.00	25.00	\$1,625.00	\$1,625.00
618-6074	CONDT (RM) (3")	LF	\$76.00	0.00	\$0.00	60.00	60.00	\$4,560.00	\$4,560.00
680-WC01	TEMP SIGNAL CONTROLLER/CABINET	EA	\$19,900.00	0.00	\$0.00	1.00	1.00	\$19,900.00	\$19,900.00
_									
		•							
_									
		•							
	<u>-</u>				\$45,670.50			\$73,916.25	\$28,245.75

### CHANGE ORDER REASON(S) CODE CHART

Design Error or Omission	1A. Incorrect PS&E 1B. Other
Differing Site Conditions     (unforeseeable)	2A. Dispute resolution (expense caused by conditions and/or resulting delay)  2B. Unavailable material  2C. New development (conditions changing after PS&E completed)
	<ul> <li>2D. Environmental remediation</li> <li>2E. Miscellaneous difference in site conditions (unforeseeable)(Item 9)</li> <li>2F. Site conditions altered by an act of nature</li> <li>2G. Unadjusted utility (unforeseeable)</li> </ul>
	2H. Unacquired Right-of-Way (unforeseeable)  2I. Additional safety needs (unforeseeable)  2J. Other
3. County Convenience	<ul> <li>3A. Dispute resolution (not resulting from error in plans or differing site conditions)</li> <li>3B. Public relations improvement</li> <li>3C. Implementation of a Value Engineering finding</li> <li>3D. Achievement of an early project completion</li> <li>3E. Reduction of future maintenance</li> </ul>
	<ul> <li>3F. Additional work desired by the County</li> <li>3G. Compliance requirements of new laws and/or policies</li> <li>3H. Cost savings opportunity discovered during construction</li> <li>3I. Implementation of improved technology or better process</li> </ul>
	<ul> <li>3J. Price adjustment on finished work (price reduced in exchange for acceptance)</li> <li>3K. Addition of stock account or material supplied by state provision</li> <li>3L. Revising safety work/measures desired by the County</li> <li>3M. Other</li> </ul>
4. Third Party Accommodation	<ul> <li>4A. Failure of a third party to meet commitment</li> <li>4B. Third party requested work</li> <li>4C. Compliance requirements of new laws and/or policies (impacting third party)</li> <li>4D. Other</li> </ul>
5. Contractor Convenience	<ul> <li>5A. Contractor exercises option to change the traffic control plan</li> <li>5B. Contractor requested change in the sequence and/or method of work</li> <li>5C. Payment for Partnering workshop</li> <li>5D. Additional safety work/measures desired by the contractor</li> <li>5E. Other</li> </ul>
6. Untimely ROW/Utilities	<ul> <li>6A. Right-of-Way not clear (third party responsibility for ROW)</li> <li>6B. Right-of-Way not clear (County responsibility for ROW)</li> <li>6C. Utilities not clear</li> <li>6D. Other</li> </ul>

#### **Williamson County Road Bond Program**

### Ronald Reagan at Elizabeth Park Temporary Signals Williamson County Project No. 23IFB21

#### Change Order No. 1

#### **Reason for Change**

This Change Order will compensate the contractor for quantity adjustments needed due to changes in the field condition. The plans have been revised to span the electric service over the Enterprise gas line versus going underground with the lines.

This Change Order also compensates the contractor for installing and maintaining a temporary controller cabinet due to the lead-time on the delivery of the permanent cabinet. This will allow for the signals to be activated immediately rather than later in the year when the new cabinet is scheduled to be delivered.

The following is a list of new items required for this Change Order.

ITEM	DESCRIPTION	QUANTITY	UNIT
627-6002	TIMBER POLE (CL 2) 40 FT	2.00	EA
628-WC01	ELC SRV TY D 120/240 060(NS)SS(E)EX(U)	1.00	EA
618-6023	CONDT (PVC) (SCH 40) (2")	25.00	LF
618-6074	CONDT (RM) (3")	60.00	LF
680-WC01	TEMP SIGNAL CONTROLLER/CABINET	1.00	EA

This Change Order results in a net increase of \$28,245.75 to the Contract amount, for an adjusted Contract total of \$245,147.97. The original Contract amount was \$216,902.22. As a result of this and all Change Orders to-date, \$28,245.75 has been added to the Contract, resulting in a 13% net increase in the overall Contract cost.

#### **HNTB Corporation**

Oscar Salazar-Bueno, P.E.



16294 IH 35 N. Selma TX 78154 210.497.4500 phone 210-653-2835 fax

April 19, 2023

Mr. Randy Ehresman, P.E. HNTB

Re: Owner - Williamson County

Project - Ronald Reagan Blvd Temp Traffic Signal

Project #23IFB21 Levy Job #2023-887

Field Change – Revised Traffic Signal

Dear Mr. Ehresman:

We offer the attached field change price proposal to account for the changes made to plan shts 2, 7 & 8 in order to address the issues with routing power to the signal intersection. The attached summary table details the quantity changes to the original contract bid items because of the plan revisons, and incorporates corrections made by the Levy team to plan sht 8 (see attached). Furthermore, we have added pricing for five new bid items. An explanation of each new bid item is included below:

- 1. TIMBER POLE (CL 2) 40 FT Added timber poles for routing power overhead between electrical service enclosure & signal controller (poles A1 & A2 on plan sht 7). Includes a down guy for each pole.
- 2. TEMP SIGNAL CONTROLLER/CABINET Provide & install a used signal controller & cabinet mounted to the permanent controller foundation. Temp controller is needed to run the signal system until such time as the permanent controller is available. Permanent controller has a long lead-time. Item includes removal of the temp controller cabinet when no longer needed. Item also includes maintaining the signal system for up to 9 months while waiting for the permanent controller to arrive. Maintenance is to cover the correction of any issues stemming from equipment failures or workmanship and any preventative maintenance steps required. Maintenance does not include issues caused by a 3rd party (e.g. public vehicle accident, Acts of God, damages caused by a contractor, vandalism).
- 3. ELC SRV TY D 120/240 060(NS)SS(E)EX(U) Provide & install electrical service enclosure onto one of the 40' timber poles mentioned above. Item includes tie-in of conduits to bottom of enclosure. Conduit riser going up the pole to be paid separately. Item also includes installing a main breaker enclosure onto the existing PEC power pedestal. PEC to provide & install meter on existing pedestal.
- 4. CONDT (PVC)(SCH 40)(2") Short conduits runs at the foot of each 40' timber pole for the purpose of routing power wiring.
- 5. CONDT (RM)(3") Conduit risers with weather heads mounted to timber signal poles to separate signal cables & detections cables from power cables.



Sincerely,

Andy Ajas, P.E. The Levy Company, Inc.

#### THE LEVY COMPANY, INC.

OWNER: Williamson County

PROJECT: Ronald Reagan Blvd - Temp Signals

PROJECT #: 23IFB21 LEVY JOB NO. 2022-887

FIELD CHANGE: REVISE TRAFFIC SIGNALS DATE: 4/19/2023

FIELD CHANGE:	REVISE TRAFFIC SIGNALS					DATE:	4/19/2023
			ORIG PLUS				
			PREV REVISED		NEW TOTAL		
ITEM	DESCRIPTION	UNIT	QUANT	FC QUANT	QUANT	UNIT PRICE	FC AMOUNT
0300-6001	CONDT (PVC) (SCH 40) (3")	LF	860.00	-675.00	185.00	\$20.00	-\$13,500.00
0400-6001	CONDT (RM) (2")	LF	25.00	65.00	90.00	\$38.00	\$2,470.00
0500-6001	ELEC CONDR (NO.8) BARE	LF	205.00	-10.00	195.00	\$1.70	-\$17.00
0600-6001	ELEC CONDR (NO.8) INSULATED	LF	1,910.00	1,010.00	2,920.00	\$1.70	\$1,717.00
0700-6001	ELEC CONDR (NO.6) BARE	LF	185.00	-165.00	20.00	\$2.00	-\$330.00
0800-6001	ELEC CONDR (NO.6) INSULATED	LF	370.00	255.00	625.00	\$2.00	\$510.00
1000-6001	ZINC-COAT STL WIRE STRAND (3/8")	LF	1,610.00	115.00	1,725.00	\$3.50	\$402.50
1100-6001	ELC SRV TY D 120/240 060(NS)SS(E)SP(O)	EA	1.00	-1.00	0.00	\$8,500.00	-\$8,500.00
1900-6001	REFL PAV MRK TY I (Y) 4" (SLD) (100MIL)	LF	1,550.00	10.00	1,560.00	\$1.20	\$12.00
3300-6001	TRF SIG CBL (TY A)(12 AWG)(5 CONDR)	LF	2,480.00	35.00	2,515.00	\$2.75	\$96.25
	TIMBER POLE (CL 2) 40 FT	EA	0.00	2.00	2.00	\$5,300.00	\$10,600.00
	TEMP SIGNAL CONTROLLER/CABINET	EA	0.00	1.00	1.00	\$19,900.00	\$19,900.00
	ELC SRV TY D 120/240 060(NS)SS(E)EX(U)	EA	0.00	1.00	1.00	\$8,700.00	\$8,700.00
	CONDT (PVC) (SCH 40) (2")	LF	0.00	25.00	25.00	\$65.00	\$1,625.00
	CONDT (RM) (3")	LF	0.00	60.00	60.00	\$76.00	\$4,560.00
	TOTAL FIELD CHANGE AMOUNT						\$28,245.75

[TEM:	0618	0618	0620	0620	0620	0620	0624	0625	Y 10627 \	0628	* 0680
DESC. CODE:	6029	6070	6007	6008	6009	6010	6010	6003	6002	6145	6002
SHT NO.	CONDT (PVC) (SCH 40) (3")	CONDT (RM)	ELEC CONDR (NO.8) BARE	ELEC CONDR (NO.8) INSULATED	ELEC CONDR (NO.6) BARE	ELEC CONDR (NO.6) INSULATED	GROUND BOX TY D (162922) W/ APRON		TIMBER POLE (CL 2) 40 FT	ELC SRV TY D 120/240 060 (NS) SS ( E) SP (O)	INSTALL HI TRF SIG (ISOLATED
	LF	LF_	LF	LF_	LF_	LF	EA	LF.	EA ·	EA	EA
1 OF 1	840	105	195	2280	175	935	2	<u>(1840</u>	2 .	1	1
	(	•				2		\		)	
PROJECT TOTALS	840	105	195	2280	175	935	2	1840	2 ,	1	1

TIMBER	POLE	ES A	RE	
SUBSIDI	ARY	ΤO	ITEM	680.

SUMMARY OF SIGNA	L QUANTITIES											
ITEM:	0682	0682	0682	0682	0682	0682	0682	0682	0684	0684	0690	6306
DESC. CODE:	6001	6002	6003	6004	6005	6006	6051	6052	6010	6049	6137	6002
SHT NO.	VEH SIG SEC (12")LED(G RN)	VEH SIG SEC (12")LED(G RN ARW)	VEH SIG SEC (12")LED(Y EL)	VEH SIG SEC (12")LED(Y EL ARW)	VEH SIG SEC (12")LED(R ED)	VEH SIG SEC (12")LED(R ED ARW)	BACKPLATE W/REFL BRDR (3 SEC) ALUM	BACKPLATE W/REFL BRDR(4 SEC)ALUM	TRF SIG CBL (TY A) (12 AWG) (5 CONDR)	TRF SIG CBL (TY A) (16 AWG) (3 CONDR)	VIVDS CABLE (INSTALL)	VIVDS CAM ASSY FXD LNS
	EA	EA	EA	EA	EA	EA	EA	EA	LF	LF	LF	EΑ
1 OF 1	6	3	6	1	6	1	5	2	2480	1325	1325	3
PROJECT TOTALS	6	3	6	1	6	1	5	2	2480	1325	1325	3

SUMMARY OF SMALL	SIGNS AND PA	AVEMENT MARK	ING QUANTITIE	ES								
ITEM:	0636	0644	0644	0666	0666	0666	0666	0666	0672	0677	0677	0677
DESC. CODE:	6007	6001	6004	6006	6012	6036	6048	6126	6009	6001	6003	6008
SHT NO.	REPLACE EXISTING ALUMINUM SIGNS(TY A)	SUP&AM TY10BWG(1) SA(P)	SUP&AM TY10BWG(1) SA(T)	TY I (W) 4" (DOT) (100MIL)	TY I (W) 4"(SLD) (100MIL)	TY I (W)8"(SLD) (100MIL)	TY I (W) 24" (SLD ) (100MIL)	REFL PAV MRK TY I (Y)4"(SLD) (100MIL)	MRKR TY II-A-A	ELIM EXT PAV MRK & MRKS (4")	ELIM EXT PAV MRK & MRKS (8")	ELIM EXT PAV MRK & MRKS (ARROW)
	SF	EA	EA	LF	LF	LF	LF	LF	EA	LF	LF	EA
1 OF 3			1					995	100	215		1
2 OF 3	9	1		37	30	95	85	565	44	317	300	1
3 OF 3		1	1									
DDO ISOT TOTAL C				7.7	7.0	0.5	0.5	1500	4.4.4	5.70	700	
PROJECT TOTALS	9	2	2	37	30	95	85	1560	144	532	300	2

$\triangle$	CHANGE ORDER NO.1	DAB	3/10/2023
NO.	REVISION	BY	DATE






RONALD REAGAN BLVD. AT ELIZABETH PARK BLVD.

SUMMARY OF QUANTITIES

Designed:	ATG	FED. RD. DIV. NO.	STATE	FEDERAL	AID PRO	JECT NO.	HIGHWAY NO.
Checked:	ATG	Х	TEXAS	SEE '	TITLE S	SHEET	TITLE SHEET
Drawn:	ATG	DIST.	COUNTY	CONTROL NO.	SECTION NO.	JOB NO.	SHEET NO.
Checked:	ATG		WILLIAMSON				2

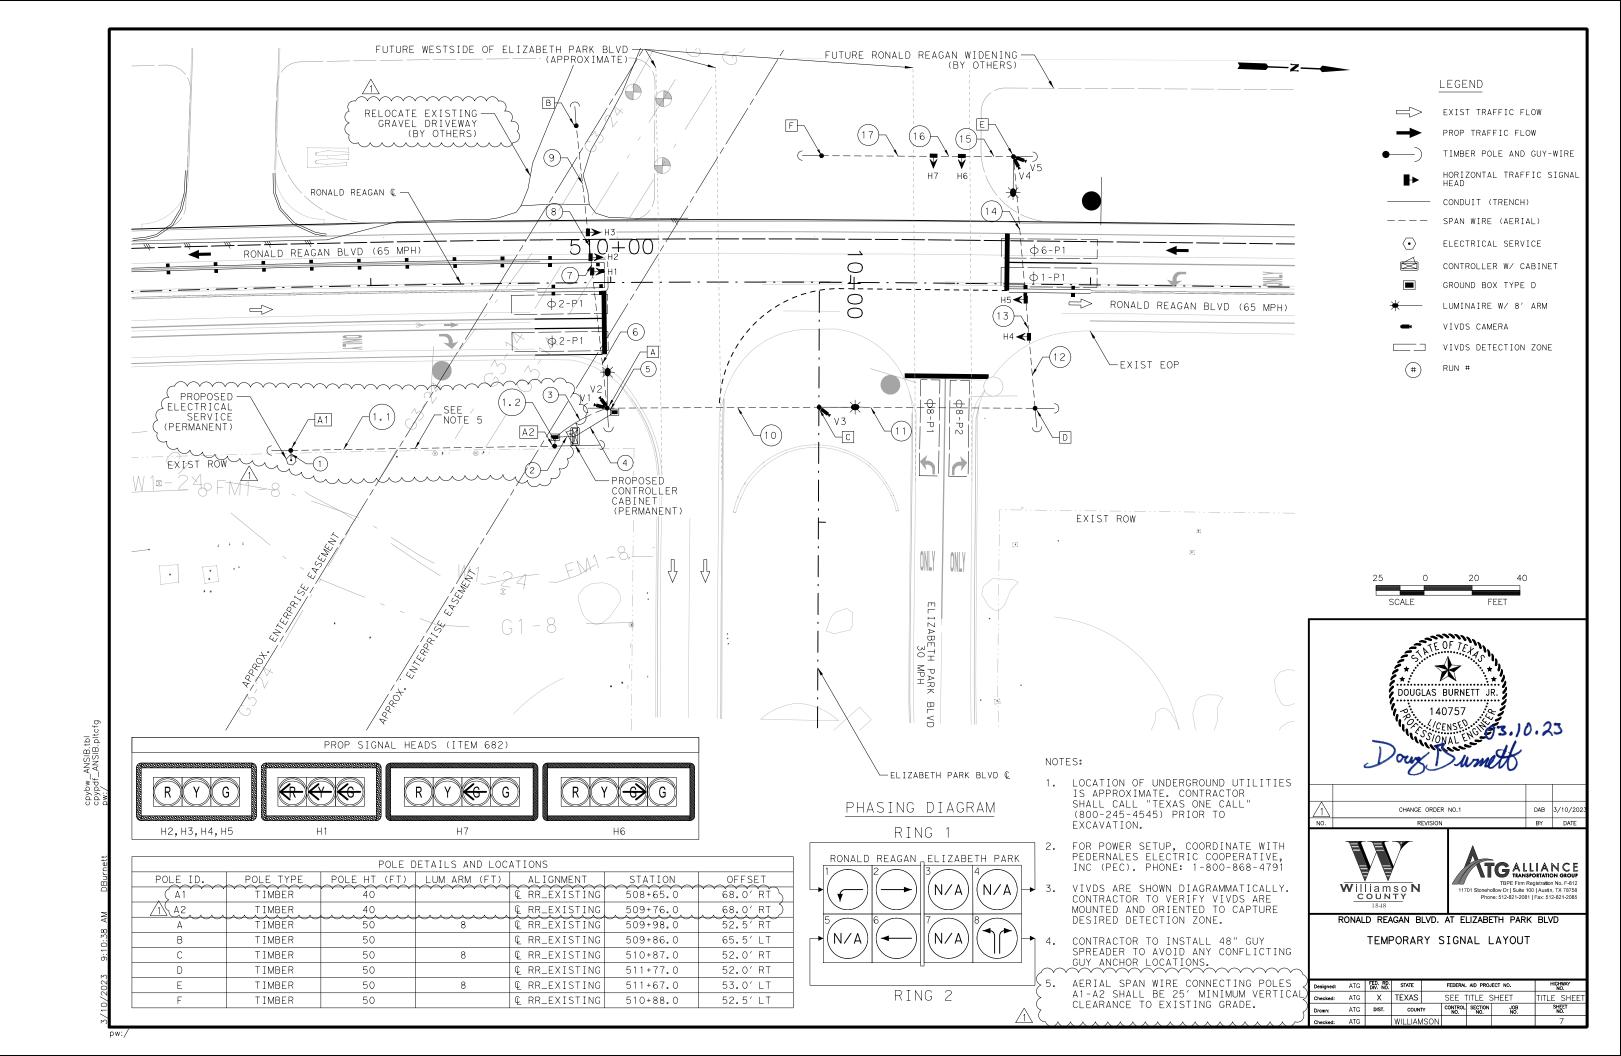

•	
-	
	ĸ
\	
•	
.:	
3	
- =	
- (2	

5/C (SIGNAL)

35

0618

0620

0620

0620

0624

0682

0682

0684

0684

0690

BID CODE

COAX (VIVDS)

NO. 8 BARE

ELIZABETH PARK BLVD TEMP SIGNAL QUANTITY

3/C (VIVDS)

25

CODE DESCRIPTION

6029 CONDT (PVC) (SCH 40) (3")

6007 ELEC CONDR (NO. 8) BARE

6009 ELEC CONDR (NO. 6) BARE

6008 ELEC CONDR (NO. 8) INSULATED

6010 ELEC CONDR (NO. 6) INSULATED

6010 GROUND BOX TY D (162922) W/APRON

6003 ZINC-COAT STL WIRE STRAND (3/8")

6002 INSTALL HWY TRF SIG (ISOLATED)

6002 VEH SIG SEC (12") LED (GRN ARW)

6004 VEH SIG SEC (12")LED (YEL ARW)

6006 VEH SIG SEC (12") LED (RED ARW)

6051 BACKPLATE W/REFL BRDR (3 SEC) ALUM

6052 BACKPLATE W/REFL BRDR (4 SEC) ALUM

6010 TRF SIG CBL (TY A) (12 AWG) (5 CONDR)

6049 TRF SIG CBL (TY A) (16 AWG) (3 CONDR)

6001 VEH SIG SEC (12") LED (GRN)

6003 VEH SIG SEC (12")LED(YEL)

6005 VEH SIG SEC (12") LED (RED)

6137 VIVDS CABLE (INSTALL)

6002 VIVDS CAM ASSY FXD LNS

6145 ELC SRV TY D 120/240 060 (NS) SS (E) SP (O)

6070 CONDT (RM) (2")

	DBurnett
	AM
	8:10:45
1000/	10/2023
0.	0

				CONE	DUCTOR AND C	ONDUIT SCHED	ULE						
DUN	RUN	COND	DUIT	AERIAL SPAN WIRE		POWER/	/GROUND		SIGNAL	VIV	VDS		
RUN NO.	LENGTH (FT)	3" SCH40 PVC TRENCH	2" RM POLE MNT	WIRE STRAND 3/8" GUY	#8 AWG (BARE)	#8 AWG (INS)	#6 AWG (BARE)	#6 AWG (INS)	5/C #12 AWG	3/C #16 AWG	CABLE	2"Sch 40	1 3" RM POLE MAT
(1)	40	* * * * * * * *	1-30			76		3				Trench 1-10	
(1.1	115		4	2 1		2.6		3 1/1				1 10	
1.2	40		1 - 30			26		3 )				1- 10'	1
2	17520	2						2				1	
3	19570	21-15			1	2 6	-					1	1-30
4	25	4							7	5	5	1,21	, ,
5	25 35	1-5'	1-30			3 0			7	5	5	1-5	1-30
6*	125			2					3				
7	20			2					2			1	1
8	25			2					1			1	
9	55			2								1	
10	105			2		× 4			4	3	3	1	}
11×	155			2		3 24	100		4	2	2	1	(
12	45			2		3 2			4	2	2	7	)
13	30			2		2 2			3	2	2	1	1
14*	125			2		3/2-	+100		2	2	2	1	1
15	35			2					2			1	
16	25			2					Ĩ.			1	1
17	60	-		2		=				-			
New	Totals	185	<b>90</b>	1725	~~~~	1920	20	625	2515	1325	1325	25	60
TOT	ALS	840	105	1840	195	2235	175	935	2445	1275	1275	۵	. 0
Di lle	ADDITIONA CONDUCTOR:	L LENGTH ADDED S/CABLE IN CABI	FOR FUTURE TO	P PREPARATION. COI	L AND MOUNT	SLACK TO AD.	JACENT POLE.	-1310	+70	+50	+ 50	+25	+60

860

25

205

1910

185

370

2

1610

6

6

6

5

2480

1325

1325

3

LF

LF

EA

EΑ

EΑ

EA

EA

LF


LF

SIG	NAL POLE CONDUC	TOR QUANT	ITIES	
		VIV	VDS	ILL
POLE	TYPE	CAE	BLE	INS
		3C#16	COAXIAL	#8 C
POLE A	TIMBER	10	10	15
POLE B	TIMBER			
POLE C	TIMBER	5	5	15
POLE D	TIMBER			
POLE E	TIMBER	10	10	15
POLE F	TIMBER			
	TOTALS (LF)	25	25	45

		1.0				1	
		TOTALS (LF)	25	25	45	]	
						-	
			CABLE T	ERMINATIO	N CHART		
	CABLE 1	CABLE 2	CABLE 3	CABLE	E 4 CA	BLE 5	CABLE 6
CONDR	HEAD 1 TO CNTRL 5 CONDR	HEAD 2 TO CNTRL 5 CONDR	HEAD 3 TO CNTRL 5 CONDR	HEAD TO CN 5 CON	TRL TO	EAD 5 CNTRL CONDR	HEAD 6 TO CNTRL 5 CONDR
BLACK	H3 Y ARW PHASE 1	H4 Y PHASE 6	H5 Y PHASE 6	H1 Y		H2 Y ASE 2	H6 Y PHASE 8
WHITE	SIGNAL COMMON	SIGNAL COMMON	SIGNAL COMMON	SIGN. COMM		GNAL DMMON	SIGNAL COMMON
RED	H3 R ARW PHASE 1	H4 R PHASE 6	H5 R PHASE 6	H1 F PHASE		H2 R ASE 2	H6 R PHASE 8
GREEN	H3 G ARW PHASE 1	H4 G PHASE 6	H5 G PHASE 6	H1 ( PHASE		H2 G ASE 2	H6 G(G ARW) PHASE 8
ORANGE	SPARE	SPARE	SPARE	SPAR	RE S	PARE	SPARE

·			ELE	CTRICAL SEF	RVICE DATA						
Elec.		Service	Service	Safety	Main	Lighting	Pane Ibd/	Branch	Branch	Branch	KVA
Service	Electrical Service Description	*Conduit	Conductors	Switch	Ckt. Bkr.	Contactor	Loadcenter	Dircuit	Ckt. Bkr.	Circuit	Load
ID		Size	No./Size	Amps	Pole/Amps	Amps	Amp Rating	ID	Pole/Amps	Amps	
NO. 1	ELC SRV TY D 120/240 060 (NS) SS(E) SP(0)	1 1/4"	3/#6	N/A	2P/60	N/A	100	SIGNAL	2P/30	23	
	223 244 74 2 7237 2 73 333 41137 33 427 31 437	1 17 1	3,0	IV A	21700	N/ A	100	LIGHTING	2P/15	2.13	ю

Refer to the redline markups submitted by the contractor. Clean sheet from Engineer dated 3/10/23 is superseded.

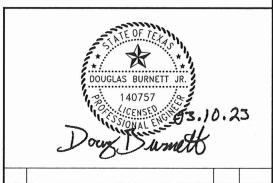

CABLE 7

HEAD7 TO CNTRL 5 CONDR

H7 Y PHASE 8

SIGNAL COMMON

H7 R PHASE 8

H7 G (G ARW)

PHASE 8

SPARE



DAB 3/10/202

TEMPORARY SIGNAL DETAILS
AND SUMMARY

CHANGE ORDER NO.1

Designed:	ATG	FED. RO. DN. NO.	STATE	FEDERAL AND PROJECT NO.			HIGHWAY NO.
Checked:	ATG	X	TEXAS	SEE 1	TITLE S	HEET	TITLE SHEE
Orawn:	ATG	DIST.	COUNTY	CONTROL NO.	SECTION NO.	JOB NO.	SHEET NO.
Checked:	ATG		WILLIAMSON				8

				CON	DUCTOR AND C	ONDUIT SCHED	ULE				
	RUN	CON	DUIT	AERIAL SPAN WIRE		POWER/	GROUND		SIGNAL	VI	VDS
RUN NO.	LENGTH	3" SCH40 PVC TRENCH	_	WIRE STRAND  3/8" GUY	#8 AWG (BARE)	#8 AWG (INS)	#6 AWG (BARE)	#6 AWG (INS)	5/C #12 AWG	3/C #16 AWG	
1	40		1	<b>*</b>	· · · · · · · · · · · · · · · · · · ·	2 2		3			
\$1.1	115			2		2		3 )/	1		
1.2	40		1			2		3, 3,			
2	175		1000000	7000000							

## **SUPERSEDED**

Refer to redline markups submitted by the contractor. This sheet is superseded.

21.12.1	RUN	CONI	TIUC	AERIAL SPAN WIRE		POWER/	GROUND		SIGNAL	VI'	VDS
RUN NO.	LENGTH (FT)	3" SCH40 PVC TRENCH	2" RM POLE MNT	WIRE STRAND 3/8" GUY	#8 AWG (BARE)	#8 AWG (INS)	#6 AWG (BARE)	#6 AWG (INS)	5/C #12 AWG	3/C #16 AWG	CABLE
1	40		1	V V V V V V V V V V V V V V V V V V V	~ ~ ~ ~ ~	2 2	_	3			
1.1	115			2		2		3 1			
1, 2	40		1			2		3, 3,			
2	175	2						2			
3	195	2			1	2					
4	25	4							7	5	5
5	25		1			3			7	5	5
6×	125			2					3		
7	20			2					2		
8	25			2					1		
9	55			2							
10	105			2		3			4	3	3
11*	155			2		3			4	2	2
12	45			2		3			4	2	2
13	30			2		3			3	2	2
14×	125			2		3			2	2	2
15	35			2					2		
16	25			2					1		
17	60			2							
				<del></del>	~~~~~~~~~~~~~~~~~~~~~~~~~~~~~~~~~~~~~~			<del></del>			
TO	ALS	( 840	105	1840 P PREPARATION. COI	195	2235	175	935	2445	1275	1275


	CONDUCTORS/CABLE IN CABINET (LF)										
	5/C (SIGNAL)	3/C (VIVDS)	COAX (VIVDS)	NO. 8 BARE							
İ	35	25	25	5							

		ELIZABETH PARK BLVD TEMP SIGNAL QUANTITY		
BID C	ODE	DESCRIPTION	UNIT	QTY
0618	6029	CONDT (PVC) (SCH 40) (3")	LF	860
0618	6070	CONDT (RM) (2")	LF	25
0620	6007	ELEC CONDR (NO. 8) BARE	LF	205
0620	6008	ELEC CONDR (NO.8) INSULATED	LF	1910
0620	6009	ELEC CONDR (NO.6) BARE	LF	185
0620	6010	ELEC CONDR (NO.6) INSULATED	LF	370
0624	6010	GROUND BOX TY D (162922) W/APRON	EΑ	2
0625	6003	ZINC-COAT STL WIRE STRAND (3/8")	LF	1610
0628	6145	ELC SRV TY D 120/240 060(NS)SS(E)SP(O)	FA	1
0680	6002	INSTALL HWY TRF SIG (ISOLATED)	EΑ	1
0682	6001	VEH SIG SEC (12")LED(GRN)	EΑ	6
0682	6002	VEH SIG SEC (12")LED(GRN ARW)	EΑ	3
0682	6003	VEH SIG SEC (12")LED(YEL)	EA	6
0682	6004	VEH SIG SEC (12")LED(YEL ARW)	EA	1
0682	6005	VEH SIG SEC (12")LED(RED)	EA	6
0682	6006	VEH SIG SEC (12")LED(RED ARW)	EA	1
0682	6051	BACKPLATE W/REFL BRDR (3 SEC) ALUM	EΑ	5
0682	6052	BACKPLATE W/REFL BRDR (4 SEC) ALUM	EΑ	2
0684	6010	TRF SIG CBL (TY A) (12 AWG) (5 CONDR)	LF	2480
0684	6049	TRF SIG CBL (TY A) (16 AWG) (3 CONDR)	LF	1325
0690	6137	VIVDS CABLE (INSTALL)	LF	1325
6306	6002	VIVDS CAM ASSY FXD LNS	ΕA	3

SIGNAL POLE CONDUCTOR QUANTITIES									
		VIV	ILL						
POLE	TYPE	CAE	INS						
		3C#16	COAXIAL	#8 C					
POLE A	TIMBER	10	10	15					
POLE B	TIMBER								
POLE C	TIMBER	5	5	15					
POLE D	TIMBER								
POLE E	TIMBER	10	10	15					
POLE F	TIMBER								
	TOTALS (LF)	25	25	45					

			CABLE TER	MINATION CHA	RT		
	CABLE 1	CABLE 2	CABLE 3	CABLE 4	CABLE 5	CABLE 6	CABLE 7
CONDR COLOR	HEAD 1 TO CNTRL 5 CONDR	HEAD 2 TO CNTRL 5 CONDR	HEAD 3 TO CNTRL 5 CONDR	HEAD 4 TO CNTRL 5 CONDR	HEAD 5 TO CNTRL 5 CONDR	HEAD 6 TO CNTRL 5 CONDR	HEAD7 TO CNTRL 5 CONDR
BLACK	H3 Y ARW	H4 Y	H5 Y	H1 Y	H2 Y	H6 Y	H7 Y
	PHASE 1	PHASE 6	PHASE 6	PHASE 2	PHASE 2	PHASE 8	PHASE 8
WHITE	SIGNAL						
	COMMON						
RED	H3 R ARW	H4 R	H5 R	H1 R	H2 R	H6 R	H7 R
	PHASE 1	PHASE 6	PHASE 6	PHASE 2	PHASE 2	PHASE 8	PHASE 8
GREEN	H3 G ARW	H4 G	H5 G	H1 G	H2 G	H6 G(G ARW)	H7 G(G ARW)
	PHASE 1	PHASE 6	PHASE 6	PHASE 2	PHASE 2	PHASE 8	PHASE 8
ORANGE	SPARE						

			ELE	CTRICAL SER	VICE DATA						
Elec.		Service	Service	Safety	Main	Lighting	Pane Ibd/	Branch	Branch	Branch	KVA
%ervice	Electrical Service Description	*Conduit	Conductors	Switch	Ckt. Bkr.	Contactor	Loadcenter	Dircuit	Ckt. Bkr.	Circuit	Load
ID		Size	No./Size	Amps	Pole/Amps	Amps	Amp Rating	ΙD	Pole/Amps	Amps	
NO. 1	ELC SRV TY D 120/240 060 (NS)SS(E)SP(0)	1 1/4"	3/#6	N/A	2P/60	N/A	100	SIGNAL	2P/30	23	6
INO. I	ELC 3NV 11 D 120/240 080 (N3/33(E)3F(O)	1 1/4	37#6	IN/ A	2 - 7 6 0	IN/ A	100	LIGHTING	2P/15	2.13	•

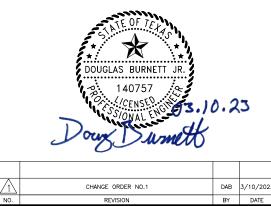

1	CHANGE ORDER NO.1	DAB	3/10/2023
NO.	REVISION	BY	DATE





TEMPORARY SIGNAL DETAILS AND SUMMARY

Designed:	ATG	FED. RD. DIV. NO.	STATE	FEDERAL	HIGHWAY NO.		
Checked:	ATG	Х	TEXAS	SEE TITLE SHEET			TITLE SHEET
Drawn:	ATG	DIST.	COUNTY	CONTROL NO.	SECTION NO.	JOB NO.	SHEET NO.
Checked:	ATG		WILLIAMSC	N			8