# WILLIAMSON COUNTY, TEXAS CHANGE ORDER NUMBER: 19

Contract 9/26/2022 Award Date: NTP Required: Project ☑ Yes □ No Contractor: James Construction Group Number: 22IFB139 **Funding** Project Name: FM3349 at US 79 P332 Source: Sta. 503+00 to Sta. Change Order Work Limits: 536+00 FM3349 Roadway: Type of Change(on federal-aid non-exempt projects): Minor (Major/Minor) CSJ Number: Reasons: 1A (3 Max. - In order of importance - Primary first) Describe the work being revised: 1. Design Error or Omission. 1A Incorrect PS&E: This Change Order compensates the Contractor for replacing the bridge blister anchor bolts for the illumination poles on the northbound and southbound bridges. The as-bid plan set specified the incorrect type of base plate and anchor bolts for the bridge mounted poles. The Contractor submitted an RFI proposing to use the specified base plates with the correct type of anchor bolts. The Engineer of Record (EOR) reviewed the request and agreed with the Contractor's proposal. As a result of this change, 27 previously approved and fabricated anchor bolt sets, will be replaced with the correct type for the specified illumination poles. The supplier did not give the Contractor the option to pay a re-stocking fee for the original anchor bolts. Therefore, 27 anchor bolts will be delivered to Wilco maintenance yard to be used in future projects. Each signatory hereby warrants that each has the authority See Attached New or revised plan sheet(s) are attached and numbered: N/A 7 New Special Provisions/Specifications to the contract are attached: No New Special Provisions to Item N/A No. N/A. Special Specification Item N/A are attached. Each signatory hereby warrants that each has the authority to execute this Change Order (CO). The following information must be provided The contractor must sign the Change Order and, by doing so, agrees to waive any and all claims for additional compensation due to any and all other expenses; additional changes for time, overhead and profit; or loss of compensation as a Time Ext. #: N/A Days added on this CO: 0 sult of this change. Amount added by this change order: \$9,869.00 THE CONTRACTOR Original Contract Amount: \$81,941,038.13 Total Change Orders To-Date: \$2,162,933.94 Typed/Printed Name Percent Change in Original Contract: Typed/Printed Title RECOMMENDED FOR EXECUTION: RECOMMENDED FOR EXECUTION: 8/6/2024 7/16/2024 Senior Construction Engineer Department of Infrastructure Date Date Williamson County 8/6/2024 APPROVED: Valerie Covey Aug 20, 2024 3rd Party Signature Date Presiding Officer of the Date

Williamson County Commissioners Court

# **WILLIAMSON COUNTY, TEXAS**

CHANGE ORDER NUMBER: 19 Project #: 22IFB139

#### TABLE A: Force Account Work and Materials Placed into Stock

LABOR	HOURLY RATE		HOURLY RATE

#### TABLE B: Contract Items:

					ORIGINAL + PRE	VIOUSLY REVISED	ADD or (DEDUCT)		NEW	
ITEM	DESCRIPTION	UNIT	UNI	T PRICE	QUANTITY	ITEM COST	QUANTITY	QUANTITY	ITEM COST	OVERRUN/ UNDERRUN
999 WC16	BRIDGE BLISTER BOLT SETS	LS	\$	9,869.00	0.00	\$ -	1.00	1.00	\$ 9,869.00	\$ 9,869.00
	TOTALS		1			\$ -			\$ 9,869.00	\$ 9,869.00

# CHANGE ORDER REASON(S) CODE CHART

Design Error or Omission	1A. Incorrect PS&E 1B. Other
Differing Site Conditions     (unforeseeable)	2A. Dispute resolution (expense caused by conditions and/or resulting delay) 2B. Unavailable material 2C. New development (conditions changing after PS&E completed) 2D. Environmental remediation 2E. Miscellaneous difference in site conditions (unforeseeable)(Item 9) 2F. Site conditions altered by an act of nature 2G. Unadjusted utility (unforeseeable) 2H. Unacquired Right-of-Way (unforeseeable) 2I. Additional safety needs (unforeseeable) 2J. Other
3. County Convenience	3A. Dispute resolution (not resulting from error in plans or differing site conditions) 3B. Public relations improvement 3C. Implementation of a Value Engineering finding 3D. Achievement of an early project completion 3E. Reduction of future maintenance 3F. Additional work desired by the County 3G. Compliance requirements of new laws and/or policies 3H. Cost savings opportunity discovered during construction 3I. Implementation of improved technology or better process 3J. Price adjustment on finished work (price reduced in exchange for acceptance) 3K. Addition of stock account or material supplied by state provision 3L. Revising safety work/measures desired by the County 3M. Other
4. Third Party Accommodation	<ul> <li>4A. Failure of a third party to meet commitment</li> <li>4B. Third party requested work</li> <li>4C. Compliance requirements of new laws and/or policies (impacting third party)</li> <li>4D. Other</li> </ul>
5. Contractor Convenience	<ul> <li>5A. Contractor exercises option to change the traffic control plan</li> <li>5B. Contractor requested change in the sequence and/or method of work</li> <li>5C. Payment for Partnering workshop</li> <li>5D. Additional safety work/measures desired by the contractor</li> <li>5E. Other</li> </ul>
6. Untimely ROW/Utilities	<ul> <li>6A. Right-of-Way not clear (third party responsibility for ROW)</li> <li>6B. Right-of-Way not clear (County responsibility for ROW)</li> <li>6C. Utilities not clear</li> <li>6D. Other</li> </ul>

## **Williamson County Road Bond Program**

# FM3349 at US 79 Williamson County Project No. 22IFB139

## Change Order No. 19

## **Reason for Change**

This Change Order compensates the Contractor for replacing the bridge blister anchor bolts for the illumination poles on the northbound and southbound bridges. The as-bid plan set specified the incorrect type of base plate and anchor bolts for the bridge mounted poles. The Contractor submitted an RFI proposing to use the specified base plates with the correct type of anchor bolts. The Engineer of Record (EOR) reviewed the request and agreed with the Contractor's proposal. As a result of this change, 27 previously approved and fabricated anchor bolt sets, will be replaced with the correct type for the specified illumination poles. The supplier did not give the Contractor the option to pay a re-stocking fee for the original anchor bolts. Therefore, 27 anchor bolts will be delivered to Wilco maintenance yard to be used in future projects.

Following is summary of new items required for this Change Order.

ITEM	DESCRIPTION	QTY	UNIT
999 WC16	BRIDGE BLISTER BOLT SETS	1	LS

This Change Order results in a net increase of \$9,869.00 to the Contract amount, for an adjusted Contract total of \$84,103,972.07. The original Contract amount was \$81,941,038.13. As a result of this and all Change Orders to-date, \$2,162,933.94. has been added to the Contract, resulting in an 2.64% net increase in the Contract cost. No additional days will be added to or deducted from the Contract as a result of this Change Order.

### **HNTB Corporation**

Oscar Salazar-Bueno, P.E.

# Change Order Worksheet

Contract Name	FM3349 at US79		Solicitation #	22IFB139
Date awarded	9/26/2022			
Awarded Contract A	mount	\$81,941,038.13		
			Percentage Change	
	Change order #1	\$925,354.41	1.13%	
	Change order #2	\$82,000.00	0.10%	
	Change order #3	\$195,302.81	0.24%	
	Change order #4	-\$472,492.20	-0.58%	
	Change order #5	-\$5,274.97	-0.01%	
	Change order #6	\$130,053.00	0.16%	
	Change order #7	\$661,031.30	0.81%	
	Change order #8	\$327,321.48	0.40%	
	Change order #9	-\$368,749.53	-0.45%	
	Change order #10	\$67,965.30	0.08%	
	Change order #11	\$271,902.72	0.33%	
	Change order #12	\$64,791.00	0.08%	
	Change order #13	\$82,301.65	0.10%	
	Change order #14	\$101,248.22	0.12%	
	Change order #15	\$24,513.18	0.03%	
	Change order #16	\$35,324.07	0.04%	
	Change order #17	\$11,849.07	0.01%	
	Change order #18	\$18,623.43	0.02%	
	Change order #19	\$9,869.00	0.01%	
	Total changes to date	\$2,162,933.94	2.64%	(Running totals here)
	Adjusted contract amount	\$84,103,972.07		

# AUSTIN TRAFFIC SIGNAL CONSTRUCTION COMPANY, INC.

P.O. Box 130 Round Rock, Texas 78680 Ph. (512) 255-9951 Fax (512) 255-0146

# June 10, 2024

# CHANGE ORDER PROPOSAL

CONTROL: 0204-02-034

PROJECT: US 79 BRIDGE BLISTERS

HIGHWAY: US 79

COUNTY: WILLIAMSON

Item	Desc.		Unit of	Approx.	Unit Bid	
No.	Code	Bid Item Description	Measure	Quantities	Price	Amount
610		BRIDGE BLISTER BOLT SETS FOR ITEM 610-6208 RD IL TY SA(40S-10)	SET	27	\$347.00	\$0.00
		1.25 " BOLTS-PLATES-NUTS-WASHERS	SET	27.00	\$347.00	\$9,369.00
		DELIVERY LABOR	LS	1.00	\$500.00	\$500.00
					SUBTOTAL	\$9,869.00
					TOTAL	\$9,869.00
		EXCLUSI	ONS			

1) Forklift unloading of anchor bolts onsite

Clark Thomas 512-255-9951 ext 214

**BIDFORM** 





	REQUEST FOR INFORMATION FORM				
RFI NO.: PROJECT: TO:	57 3349 @ US-79 HNTB: ASIF	DATE: 4/2/24  RESPONSE REQUESTED BY DATE: 4/16/24			
REFERENCE PROBLEM: See attached	: Plan Sheets: xxx	Received  04/03/2024  HNTB CORPORATION ROUND ROCK			
RECOMMEN	OFIGINATOR:	Supervisor			
RESPONSE:	Responder	Date			

Sign, Date & Return to HNTB via e-mail or fax.

Mail original to: HNTB Corporation

101 E Old Settlers Blvd, Ste 225 Round Rock, Texas 78664

Attachments to RFI:

Cc:



5880 West Highway 190 LEWISVILLE, Texas 76513 Phone: 972-538-5300 Fax: 866-785-2025

# **Request for Information # 057**

Project FM 3349 @ SH 79 JCG Job# 10906 CSJ # 3486-01-008

To:	From:
ASIF MIRZAZADA	GARY COUCH
HNTB CORPORATION	JAMES CONSTRUCTION GROUP, LLC.
101 E. OLD SETTLERS BLVD. STE.225	5880 W. US HWY190
ROUND ROCK, TX 78664	BELTON, TX 76513
<b>Phone:</b> 512-987-9179	<b>Phone:</b> 254-346-5037
Fax:	Fax:
Email: AMIRZAZADA@HNTB.COM	Email: GCOUCH@PRIM.COM

Subject:	Status:	Response Required By:
Bridge Blister Anchor Bolts	RFI OPEN	4/16/2024

Submittal #:	Drawing #:	Addendum:	Spec Section:	Schedule #:
	ILLUMINATION		600	

Please be advised that this document shall serve as notice pursuant to the terms of the Contract.

The timeliness and/or content of the response may impose time and cost impacts to the project that could not have been reasonably or objectively contemplated at the time of the Bid, which may therefore merit an adjustment to the Contract.

## RFI Detail:

I have noticed error in the bid item description for the illumination poles that need clarification:

There is an error in the bid item description for the illumination poles.

The 27 poles that are listed as "IN RD II (TY SA) 40S are "S" base poles, these are mounted on concrete foundations without a "T" base (mostly behind guard rail).

The description should have read "IN RD IL (TY SA) 40B for bridge blister or retaining wall poles.

See Below the 2 differences:

- 1. Anchor Bolts, the poles have a separate set of anchor bolts listed in the bridge details "BL".
- 2. Handhole height

ATS mention that they don't see many blister poles with the correct handhole height, but we do need the correct anchor bolts (to attach the S base poles to the blister).

Please let me know if the engineer is going to require the correct poles (B base), or will the correct anchor bolt with the S base poles be sufficient? We do have the S base poles materials on MOH.

Suggestion:		



5880 West Highway 190 LEWISVILLE, Texas 76513 Phone: 972-538-5300 Fax: 866-785-2025

## Response:

Response.	
bolt hole diameter size as IN RD IL (TY SA) 40B ("B" basistandard) and retaining wall light pole brackets (RW-LB stype poles the contractor already has MOH for all illumina retaining wall light pole brackets (RW-LB standard). BL ar	ne anchor bolt plate size, anchor bolt circle diameter size, and anchor e) type poles required for bridge illumination pole brackets (BL tandard). Contractor to utilize the (27) IN RD IL (TY SA) 40S ("S" base) tition poles mounted to bridge light pole brackets (BL standard) and nd RW(LB) standards are located within the project plan set. Provide ket standards and RW(LB) retaining wall light bracket standards, for tractor already has MOH. GM@HDR.
Signature: G. Martinez III @ HDR,Inc.	Date: April 19, 2024


						SUMMARY OF	ILLUMINATION QU	ANTITIES						
		0416 6029	0432 6001	0610 6106	0610 6208	0610 6216	0618 6023	0618 6064	0620 6005	0620 6006	0620 6007	0620 6008	0624 6002	0628 6049
PLAN SHEET NO.	STATION TO STATION	DRILL SHAFT (RDWY ILL POLE) (30 IN)	RIPRAP (CONC) (4 IN)	IN RD IL (U/P) (TY 2) (150W EQ) LED	IN RD IL (TY SA) 406-10 (250W EQ) LED	IN RD IL (TY SA) 40T-10 (250W EQ) LED	CONDT (PVC) (SCH 40) (2")	CONDT (RM) (1")	ELEC CONDR (NO.10) BARE	ELEC CONDR (NO. 10) INSULATED	ELEC CONDR (NO.8) BARE	ELEC CONDR (NO.8) INSULATED	GROUND BOX TY A (122311) W/APRON	ELC SRV TY 240/480 060 (NS) SS (T) S
		LF	CY	EA	EA	EA	LF	LF	LF	LF	LF	LF	EA	EA
ILLUMIN	ATION SHEETS													
698	BEGIN TO 426+00	32	1.68			4	844				874	1748	1	
699	426+00 TO 437+00	24	1.61			3	1281				1316	2632	2	
700	437+00 TO 448+00	32	~~\ <sup>96</sup> ~~		Q	4	~15A3~~				1578	3456~~	0003000	1
701	481+00 TO 492+00	16	1.26	Vi	В	2	1075	V1		1	1095	2190	2	VI
702	492+00 TO 503+00	48	2.66	3	-	6	1768	3		1	1813	3626	3	) 1
703	503+00 TO 514+00	8	We.gow	-	7	1	5668		2277	4554	~~~\$526~~~	7052	wyw	1
704	514+00 TO 525+00				7		3007		1316	2632	1841	3682		
705	525+00 TO 536+00	8	0.91		8	1	4180		2119	4238	2191	4382	2	1
706	536+00 TO 547+00	64	3.64			8	2370				2445	4890	4	1
707	547+00 TO 558+00	32	2.24		3	4	1339				1379	2758	3	
708	558+00 TO END	24	1.05			3	461				476	952		
709	UNDERPASS			8	4			518	578	1156				
710	UNDERPASS			8	1			475	535	1070				
							~~~~					·····		
ILLUMINA	TION TOTALS	288	17, 92	16	27	36 (	23536	1 993	6825	13650	18534	37068	V1\ 21	4

JOB 2568



## SUMMARY OF QUANTITIES

GRM GRM	FED. RD. CIV. NO.	FEDERA	HIGHWAY NO.			
GRAPHICS	6			FM 3349		
GRM	STATE	DISTRICT	COUNTY	SHEET NO.		
PKD	TEXAS	AUS	WILLIAMSON			
CHECK	CONTROL	SECTION	J08	31		
PKD	3486	01				

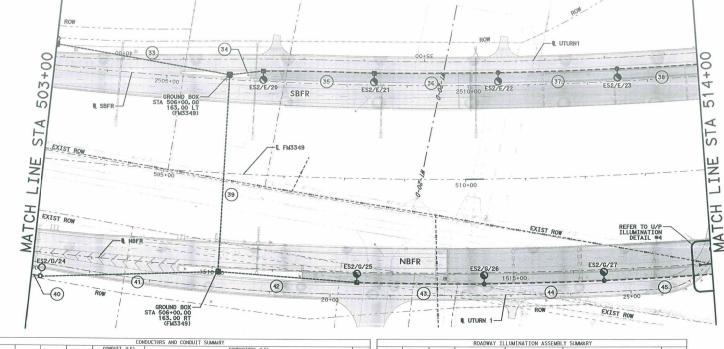

				CONDUIT (LF)	TOUCTORS AND CONDU	CONDUCTORS	(1.5)		_
SERVICE	CIRCUIT	SEGMENT	SEGMENT	0618-6023	0620-6005	0620-6006	0620-6007	0620-6008	
SERVICE	CIRCUIT	NO.	(LF)	2" PVC SCH 40	#10 BARE (GROUND)		8 BARE (GROUND)	#8 XHHW (POWER)	NOTE
	D			1 X 294 = 294		1	y 299 = 299	2 Y 200 - 508	
ES2	E	33	294	1 X 294 = 294		1	X 299 = 299	2 X 299 = 598	
LJL	F	33	234	1 X 294 = 294	1 X 299 = 299	2 X 299 = 598			
	G			1 X 294 = 294		1	X 299 = 299	2 X 299 = 598	
ES2	E	34	56	1 X 56 = 56		1	X 61 = 61	2 X 61 = 122	
LJE	F	34	36	1 X 56 = 56	1 X 61 = 61	2 X 61 = 122			
ES2	E	35	185	1 X 185 = 185		1	X 190 = 190	2 X 190 = 380	-
COL	F	- 55	103	1 X 185 = 185	1 X 190 = 190	2 X 190 = 380			1
ES2	E	36	205	1 X 205 = 205		1	X 210 = 210	2 X 210 = 420	
COL	F	- 50	203	1 X 205 = 205	1 X 210 = 210	2 X 210 = 420			- 1
ES2	E	37	200	1 X 200 = 200		1	X 205 = 205	2 X 205 = 410	- 2
con	F	51	200	1 X 200 = 200	1 ) 205 = 205	2 X 205 = 410			1
ES2	E	38	139	1 X 139 = 139		1	X 144 = 144	2 X 144 = 288	
COL	F		100	1 X 139 = 139	1 × 144 = 144	2 X 144 = 288			- 1
	D			1 X 326 = 326		1	X 331 = 331	2 X 331 = 662	
ES2	F	39	326	1 X 326 = 326	1 X 331 = 331	2 X 331 = 662			
	G			1 X 326 = 326		1	X 331 = 331	2 X 331 = 662	
ES2	D	40	16	1 X 16 = 16		1	X 21 = 21	2 X 21 = 42	
ES2	D	41	294	1 X 294 = 294		1	X 299 - 299	2 X 299 = 598	
ES2	F	42	231	1 X 231 = 231	1 X 236 = 236	2 X 236 = 472			
	G	12	1.01	1 X 231 = 231		1	X 236 = 236	2 X 236 = 472	
ES2	F	43	210	1 X 210 = 210	1 X 215 = 215	2 X 215 = 430			
	G	,,,	2.10	1 X 210 = 210		1	X 215 = 215	2 X 215 = 430	1
ES2	F	44	200	1 X 200 = 200	1 X 205 = 205	2 X 205 = 410			-
	G			1 X 200 = 200		1	X 205 = 205	2 X 205 - 410	1
ES2	F	45	176	1 X 176 = 176	1 X 181 = 181	2 X 181 = 362			•
	G			1 X 176 = 176		1	X 181 = 181	2 X 181 = 362	- 1
TF:	SHEET	TOTAL		5668	2277	4554	3526	7052	

NOTE:
1) COMDUIT SEGMENT RUN EMBEDDED WITHIN THE CONCRETE RETAINING WALL AND/OR BRIDGE STRUCTURE. COORDINATE WITH RETAINING WALL AND/OR BRIDGE
CONTRACTOR PRIOR TO ROUGH-IN.

ERVICE POLE NO.		CIRCUIT	STATION	OFFSET	ASSEMBLY TYPE	NOTES
ES2	20	E	506+56.75	WALL LT (FM3349)	(TYPE ST 40 5-10 (250W EQ) LED	1
ES2	21	E	508+46.25	WALL LT (FM3349)	(TYPE ST 40 S-10 (250W EQ) LED	1
ES2	22	E	SEE BRIDGE DWGS	BRIDGE LT (FM3349)	(TYPE ST 40 S-10 (250W EQ) LED	2
E52	23	E	SEE BRIDGE DWGS	BRIDGE LT (FM3349)	(TYPE ST 40 S-10 (250W EQ) LED	2
ES2	24	D	503+15.00	194.50 RT (FM3349)	(TYPE SA 40 T-10 (250W EQ) LED	
ES2	25	G	508+24.25	WALL RT (FM3349)	(TYPE ST 40 S-10 (250W EQ) LED	1
ES2	26	G	SEE BRIDGE DWGS	BRIDGE LT (FM3349)	(TYPE ST 40 S-10 (250W EQ) LED	2
ES2	27	G	SEE BRIDGE DWGS	BRIDGE RT (FM3349)	(TYPE ST 40 S-10 (250W EQ) LED	2

1) THE FUTURE ILLUMINATION ASSEMBLY WILL BE MOUNTED ON TOP OF THE CONCRETE RETAILING WALL LIGHTING BRACKET, REFER TO RETAINING WALL PLANS FOR ADDITIONAL INFORMATION, ILLUMINATION ASSEMBLY TO BE INSTALLED IN THE FUTURE.

2) THE FUTURE ILLUMINATION ASSEMBLY WILL BE MOUNTED ON THE BRIDGE BLISTER LIGHTING BRACKET. REFER TO BRIDGE PLANS FOR ADDITIONAL INFORMATION. COORDINATE INSTALLATION WITH BRIDGE CONTRACTOR. ILLUMINATION ASSEMBLY TO BE INSTALLED IN THE FUTURE.


	SHEET SUMMARY OF ESTIMATED QUANTITIES		
ITEM#	DESCRIPTION	UNIT	QTY
0416 6029	DRILL SHAFT (RDWY ILL_POLE) (30 IN)	LF	8
0432 6001	RIPRAP (CONC) (4 IN)	CY	0.9
0610 6208	IN RD IL (TY SA) 408-10 (250W EQ) LED	EA	7
0610 6216	IN RD IL (TY SA) 40T-10 (250W EQ) LED	EA	-
0618 6023	CONDT (PVC) (SCH 40) (2")	LF	5668
0620 6005	ELEC CONDR (NO. 10) BARE	LF	2277
0620 6006	ELEC CONDR (NO. 10) INSULATED	LF	4554
0620 6007	ELEC CONDR (NO. 8) BARE	LF	352€
0620 6008	ELEC CONDR (NO. 8) INSULATED	LF	7052
0624 6002	GROUND BOX TY A (122311) W/APRON	EA	2

#### GENERAL NOTES:

- 1. ALL WORK SHALL BE COMPLETED ACCORDING TO THE MOST CURRENT TXDOT STANDARDS, UTILITY COMPANY STANDARDS, AND THE NATIONAL ELECTRIC CODE.
- . THE CONTRACTOR SHALL VERIFY WITH THE UTILITY COMPANIES THE EXACT LOCATION OF EXISTING/PROPOSED UNDERGROUND UTILITIES PRICE TO CONSTRUCTION TO AVOID CONFLICT OR DAMAGE TO THE UTILITIES, THE CONTRACTOR SHALL SEEK THE APPROVAL OF THE ENGINEER AND ADJUST THE OFFSETS TO AVOID DAMAGE TO THE EXISTING/PROPOSED UTILITIES.
- 3. REFER TO ILLUMINATION SUMMARIES, SCHEMATICS, AND TXDOT STANDARDS FOR ADDITIONAL INFORMATION.
- PROPOSED ABOVE GROUND NEMA 3R JUNCTION BOXES SHALL NOT BE PAID FOR DIRECTLY, BUT SHALL BE SUBSIDIARY TO THE VARIOUS BID ITEMS.
- PROVIDE CONDUIT EXPANSION AND DEFLECTION COUPLING PRIOR TO ENTERING BRIDGE MOUNTED JUNCTION BOX FOR TRANSITION FROM UNDERGROUND CONDUIT TO BRIDGE EMBEDDED CONDUIT, COUPLING SHALL ALLOW FOR A MAXIMAN OF 4 HORIZONTAL AND VETICAL MOVEMENT.
- 6. REFER TO BRIDGE DRAWINGS FOR EXACT LOCATION OF BRIDGE MOUNTED ILLUMINATION ASSEMBLIES AND ASSOCIATED INSTALLATION DETAILS.

#### ILLUMINATION LEGEND

- FUTURE TXDOT STANDARD ILLUMINATION ASSEMBLY, 40' MOUNTING HEIGHT, 10 FT. LUMINAIRE ARM, (1) LED LUMINAIRE (250W EQ), SHOE BASE TO BRIDGE BLISTER, TYPE 111 DISTRIBUTION
- FUTURE TXDOT STANDARD ILLUMINATION ASSEMBLY, 40' MOUNTING HEIGHT, 10 FT. LUMINATRE ARM, (1) LED LUMINATRE (250W EQ), SNOE BASE TO' RETAINING WALL LIGHTING BRACKET, TYPE III DISTRIBUTION
- TXDOT STANDARD ILLUMINATION ASSEMBLY, 40'
  MOUNTING HEIGHT, 10 FT. LUMINAIRE ARM, (1)
  LED LUMINAIRE (250W EQ), TRANSFORMER BASE,
  TYPE III DISTRIBUTION
  - TXDOT STANDARD TYPE II UNDERPASS ILLUMINATION ASSEMBLY, (1) LED LUMINAIRE (150W EQ), TYPE III DISTRIBUTION
- ELECTRICAL SERVICE ASSEMBLY, TYPE A, 240/480 VOLT, 1 PHASE, STEEL POLE 0
- GROUND BOX WITH APRON (NEMA 3R)
- GROUND BOX (NEMA 3R)
- $\boxtimes$ JUNCTION BOX (NEMA 3R).
- DISCONNECT SWITCH (NEMA 3R)
- CONDUCTORS IN CONDUIT RUN (RIGID METAL CONDUIT)
  - CONDUCTORS IN CONDUIT RUN (EMBEDDED IN BRIDGE STRUCTURE)
- CONDUCTORS IN CONDUIT RUN (TRENCH) CONDUCTORS IN CONDUIT RUN (BORED)
- (XX) CONDUCTORS/CONDUIT SEGMENT NO.
- X/X/X -- ILLUMINATION ASSEMBLY DESIGNATION
- SERVICE POINT CIRCUIT DESIGNATION ELECTRICAL SERVICE DESIGNATION

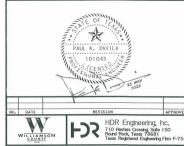



FM 3349


**ILLUMINATION PLAN** 

STA 503+00 TO STA 514+00

SCALE

: 1 "	=100'	SHEET	6 OF 11
N	FED. RD. DIV. NO.	FEDERAL AID PROJECT NO.	HIGHWAY NO.
CS.	6		FM 334
			CHECK.

GRM	DIV. NO.	FEDERA	L AID PROJECT NO.	HIGHWAY NO.
PAPHICS	6			FM 3349
GRM	STATE	DISTRICT	COUNTY	SHEET NO.
PKD	TEXAS	AUS	WILLIAMSON	
CHECK	CONTROL	SECTION	JOB	703
PKD	3486	01	008, ETC	

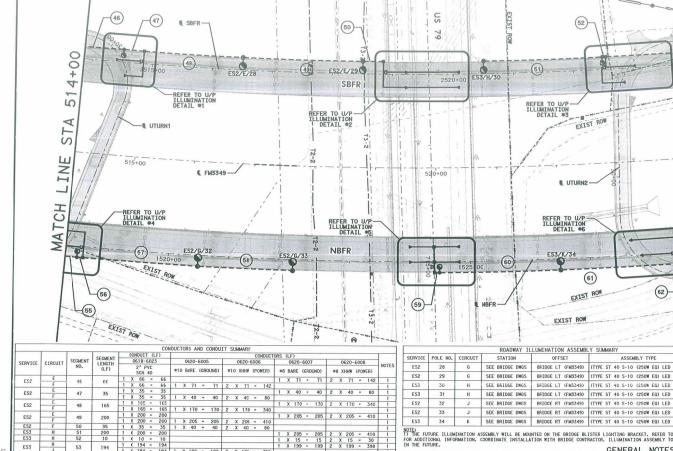

ES3	34	K	SEE BRI	DGE DWGS	BRIDG	E RT	(FM334	9) (TYPE	ST 40	S-10	(250)	W EQ) L	ED	
	TURE ILLUM													
IN THE TO		IEET SUMMA	RY OF EST	IMATED QU	ANTITIES							NOT		

ALL WORK SHALL BE COMPLETED ACCORDING TO THE MOST CURRENT TXDOT STANDARDS, UTILITY COMPANY STANDARDS, AND THE NATIONAL ELECTRIC CODE. EA

	ITEN#	DESCRIPTION	UNIT	QTY	CURRENT TXDOT STANDARDS, UTILITY COMPANY
	0610 6208	IN RD IL (TY SA) 408-10 (250W EQ) LED	EA	7	STANDARDS, AND THE NATIONAL ELECTRIC CODE.
	0618 6023	CONDT (PVC) (SCH 40) (2")	LF	3050	STANDARDS, AND THE MATTORAL ELECTRIC CODE.
	0620 6005	ELEC CONDR (NO. 10) BARE	LF	1316	2. THE CONTRACTOR SHALL VERIFY WITH THE UTILITY
- [	0620 €006	ELEC CONDR (NO. 10) INSULATED	LF	2632	COMPANIES THE EXACT LOCATION OF EXISTING/
-[	0620 €007	ELEC CONDR (NO. 8) BARE	LF	1884	PROPOSED UNDERGROUND UTILITIES PRIOR TO
	0620 €008	ELEC CONDR (NO. 8) INSULATED	LF	3768	CONSTRUCTION TO AVOID CONFLICT OR DAMAGE TO THE
					UTILITIES. THE CONTRACTOR SHALL SEEK THE APPROVA
					OF THE ENGINEER AND ADJUST THE OFFSETS TO AVOID
					DAMAGE TO THE EXISTING/ PROPOSED UTILITIES.

3. REFER TO ILLUMINATION SUMMARIES, SCHEMATICS, AND TXDOT STANDARDS FOR ADDITIONAL INFORMATION.

NOTES

(54)

(53) ES3/H/3

00

5

N

S

V

ST

525

ZI

<del></del>

H

MA

63

0

- 4, PROPOSED ABOVE GROUND NEMA 3R JUNCTION BOXES SHALL NOT BE PAID FOR DIRECTLY, BUT SHALL BE SUBSIDIARY TO THE VARIOUS BID ITEMS.
- 5. PROVIDE CONDUIT EXPANSION AND DEFLECTION COUPLING PRIOR TO ENTERING BRIDGE MOUNTED JUNCTION BOX FOR TRANSITION FROM UNDERGROUND CONDUIT TO BRIDGE EMBEDDED CONDUIT. COUPLING SHALL ALLOW FOR A MAXIMMO OF 4" HORIZONTAL AND VERTICAL MOVEMENT.
- 6. REFER TO BRIDGE DRAWINGS FOR EXACT LOCATION OF BRIDGE MOUNTED ILLUMINATION ASSEMBLIES AND ASSOCIATED INSTALLATION DETAILS.

ILLUMINATION LEGEND

FUTURE TXDOT STANDARD ILLUMINATION ASSEMBLY, 40' MOUNTING HEIGHT, 10 FT. LUMINAIRE ARM, (1) LED LUMINAIRE (250W EQ), SHOE BASE TO BRIDGE BLISTER, TYPE III DISTRIBUTION

FUTURE TXDOT STANDARD ILLUMINATION ASSEMBLY, 40' MOUNTING HEIGHT, 10 FT. LUMINATRE ARM, (1) LED LUMINAIRE (250W EQ). SHOE BASE TO RETAINING WALL LIGHTING BRACKET, TYPE III DISTRIBUTION

TXDOT STANDARD ILLUMINATION ASSEMBLY, 40' MOUNTING HEIGHT, 10 FT. LUMINAIRE ARM, (1) LED LUMINAIRE (250W EQ), TRANSFORMER BASE, TYPE III DISTRIBUTION

TXDOT STANDARD TYPE II UNDERPASS ILLUMINATION ASSEMBLY, (1) LED LUMINAIRE (150W EQ), TYPE III DISTRIBUTION

ELECTRICAL SERVICE ASSEMBLY, TYPE A, 240/480 VOLT, 1 PHASE, STEEL POLE

GROUND BOX WITH APRON (NEMA 3R)

GROUND BOX (NEMA 3R)

 $\boxtimes$ JUNCTION BOX (NEMA 3R).

DISCONNECT SWITCH (NEMA 3R)

CONDUCTORS IN CONDUIT RUN (RIGID METAL CONDUIT)

CONDUCTORS IN CONDUIT RUN (EMBEDDED IN BRIDGE STRUCTURE)

CONDUCTORS IN CONDUIT RUN (TRENCH) CONDUCTORS IN CONDUIT RUN (BORED) ------

(XX) CONDUCTORS/CONDUIT SEGMENT NO.

X/X/X - ILLUMINATION ASSEMBLY DESIGNATION SERVICE POINT CIRCUIT DESIGNATION ELECTRICAL SERVICE DESIGNATION



Texas Department of Transportation

FM 3349

ILLUMINATION PLAN

STA 514+00 TO STA 525+00

CALE: 1"	=100'		SHEET	7 OF 11
GRM GRM	FED. RD. DIV. NO.	FEDERA	L AID PROJECT NO.	HIGHWAY NO.
GRAPHICS	6			FM 334
GRM	STATE	DISTRICT	COUNTY	SHEET NO.
PKD	TEXAS	AUS	WILLIAMSON	
CHECK	CONTROL	SECTION	JOB	704
PKD	3486	01		

ES3

ES2

ES2

ES3

ES3

ES3

54

55 20

56 9

60 200

61

62


63 104

10

192

1 × 104 =

NOTE:
1) COMDUIT SEGMENT RUN EMBEDDED WITHIN THE CONCRETE RETAINING WALL AND/OR BRIDGE STRUCTURE. COORDINATE WITH BETAINING WALL AND/OR BRIDGE
CONTRACTOR PRIOR TO RRUGH-IN.

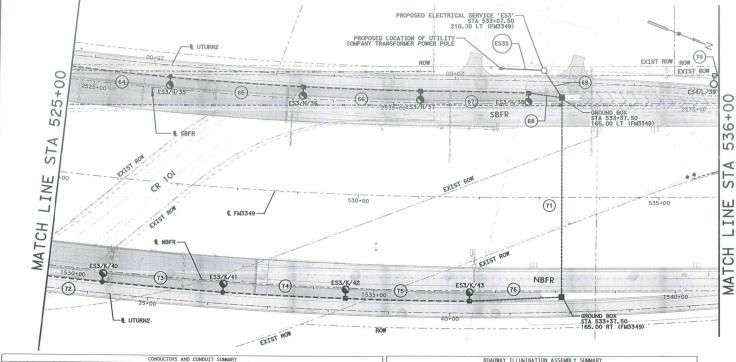

			SEGMENT	CONDUIT (LF)						CC	NDUCT	ORS	(L	-)				_	_	-		T -
SERVICE	CIRCUIT	SEGMENT	LENGTH	0618-6023	062	0-6005	T	01	520-	600	5		C	620-	-600	7		0	620-	6008	8	1
		NO.	(LF)	2" PVC SCH 40	#10 BAR	E (GROUND)	,	10 )	HHW	(PC	WER)	#	8 B	ARE	(GR	(DNUC		8 X	нни	(PC	MER)	NOTES
ES3	-	ES3S	72					-					_		_		$^{+-}$	_		_		2
ES3	Н	64	167	1 X 167 = 167								1	Х	172	2 =	172	2	X	172		344	1
	J		141	1 X 167 = 167	1 X 1	72 = 172	2	χ	172		344											1
ES3	Н	65	223	1 X 223 = 223								1	X	228	3 =	228	2	X	228	-	456	1
	J			1 X 223 = 223	1 X 2	28 = 228	2	X	228		456											1
ES3	Н	66	195	1 X 195 = 195								1	Х	200	) =	200	2	X	200	=	400	1
	J		135	1 X 195 = 195	1 X 20	00 = 200	2	Х	200	-	400								-			1
ES3	Н	67	179	1 X 179 = 179								1	X	184	-	184	2	X	184	-	368	1
	J	.,	110	1 X 179 = 179	1 X 1	84 = 184	2	X	134		368											1
ES3	Н	68	56	1 X 56 = 56			Т					1	Х	61		61	2	X	61	=	122	
	J		00	1 X 56 = 56	1 X 6	1 = 61	2	Х	61	-	122											
	н			1 X 54 = 54								1	Х	59	-	59	2	X	59	=	118	
ES3	J	69	54	1 X 54 = 54	1 X 5	9 = 59	2	Х	59		118									_		
	K			1 X 54 = 54								1	Х	59		59	2	Х	59	-	118	
ES4	L	70	8	1 X 8 = 8			Т					1	X	13		13	2	X	13		26	
ES3	J	71	330	1 X 330 = 330	1 X 33	35 = 335	2	X	335	-	670						-	_		_		
200	K		330	1 X 330 = 330								1	Х	335	-	335	2	X	335	-	670	
ES3	J	72	92	1 X 92 = 92	1 X 9	7 = 97	2	X	97	-	194						_			_		1
200	K	12	J.L	1 X 92 = 92								1	Х	97		97	2	X	97	*	194	1
ES3	J	73	201	1 X 201 = 201	1 X 20	6 = 206	2	X	206		412						_	_		_		1
	K	15	201	1 X 201 = 201								1	Х	206	-	206	2	X	206	*	412	1
ES3	J	74	203	1 X 203 = 203	1 X 20	08 = 208	2	Х	208	п	416							_		_		1
200	K		203	1 X 203 = 203								1	Х	208	-	208	2	X	208		416	1
ES3	J	75	205	1 X 205 = 205	1 X 21	0 = 210	2	X	210		420							_				1
	K	10	203	1 X 205 = 205								1	X	210	=	210	2	X	210		420	1
ES3	J	76	154	1 X 154 = 154	1 X 15	9 = 159	2	X	159		318							-				
200	K	(0.0	134	1 X 154 = 154								1	X	159		159	2	X	159		318	
	SHEET	TOTAL		4180		2119					4238			-		2191		-		_	4382	

<ol> <li>CONDUIT SEGMENT RUN EMBEDDED WIT CONTRACTOR PRIOR TO ROUGH-IN.</li> </ol>	HIN THE CONCRETE	RETAINING WALL AND/OR	BRIDGE STRUCTURE.	COORDINATE WITH RETAINING WALL AND/OF BRIDGE
2) AERIAL SERVICE DROP (CONDUCTORS,	SERVICE GRIPS.	AND SERVICE CONNECTORS	OWNED. INSTALLED	AND CONNECTED TO SERVICE ENTRANCE CONDUCTORS

<ol><li>AERIAL SERVICE DROP (CONDUCTORS,</li></ol>	SERVICE GRIPS, AND	SERVICE CONNECTORS	OWNED.	INSTALLED AND	CONNECTED	TO SERVICE	ENTRANCE	CONDUCTORS	RY
UTILITY COMPANY, COORDINATE WITH UT	ILITY COMPANY REQUI	REMENTS.	,		***************************************	IV OLIVIOL	LITTIONIOL	COMBOCTONS	

SERVICE	POLE NO.	CIRCUIT	STATION	OFFSET	ASSEMBLY TYPE	NOTES
ES3	35	K	SEE BRIDGE DWGS	BRIDGE RT (FM3349)	(TYPE ST 40 S-10 (250W EQ) LED	2
ES3	36	K	529+00,00	WALL LT (FM3349)	(TYPE ST 40 S-10 (250W EQ) LED	1
ES3	37	K	531+00.00	WALL LT (FM3349)	(TYPE ST 40 S-10 (250W EQ) LED	1
ES3	38	K	532+82.00	WALL LT (FM3349)	(TYPE ST 40 S-10 (250W EQ: LED	1
ES4	39	L	535+92.50	201.50 LT (FM3349)	(TYPE SA 40 T-10 (250W EQ: LED	
ES3	40	K	SEE BRIDGE DWGS	BRIDGE RT (FM3349)	(TYPE ST 40 S-10 (250W EQ: LED	2
ES3	41	K	SEE BRIDGE DWGS	BRIDGE RT (FM3349)	(TYPE ST 40 S-10 (250W EQ: LED	2
ES3	42	K	529+85,00	VALL RT (FM3349)	(TYPE ST 40 S-10 (250W EQ) LED	1
ES3	43	K	531+85,00	VALL RT (FM3349)	(TYPE ST 40 S-10 (250W EQ: LED	1

1) THE FUTURE ILLUMINATION ASSEMBLY WILL BE MOUNTED ON TOP OF THE CONCRETE RETAILING WALL LIGHTING BRACKET. REFER TO RETAINING WALL PLANS FOR ADDITIONAL INFORMATION, ILLUMINATION ASSEMBLY TO BE INSTALLED IN THE FUTURE.

2) THE FUTURE ILLUMINATION ASSEMBLY WILL BE MOUNTED ON THE BRIDGE BLISTER LIGHTING BRACKET, REFER TO BRIDGE PLANS FOR ADDITIONAL INFORMATION. COORDINATE INSTALLATION WITH BRIDGE COTTRACTOR. ILLUMINATION ASSEMBLY TO BE INSTALLED IN THE FUTURE.

	SHEET SUMMARY OF ESTIMATED QUANTITIES		
ITEN#	DESCRIPTION	UNIT	QTY
0416 6029	DRILL SHAFT (RDWY ILL POLE) (30 IN)	LF	8
0432 6001	RIPRAP (CONC) (4 IN)	CY	0.91
0610 6208	IN RD IL (TY SA) 408-10 (250W EQ) LE)	EA	8
0610 6216	IN RD IL (TY SA) 40T-10 (250W EQ) LE)	EA	1
0618 6023	CONDT (PVC) (SCH 40) (2")	LF	4180
0620 6005	ELEC CONDR (NO. 10) BARE	LF	2119
0620 6006	ELEC CONDR (NO.10) INSULATED	LF	4238
0620 6007	ELEC CONDR (NO. 8) BARE	LF	2191
0620 6008	ELEC CONDR (NO.8) INSULATED	LF	4382
0624 6002	GROUND BOX TY A (122311) W/APRON	EA	2
0628 6049	ELC SRV TY A 240/480 060 (NS) SS (T) SP (0)	EA	1
	0416 6029 0432 6001 0610 6208 0610 6216 0618 6023 0620 6005 0620 6005 0620 6007 0620 6008 0624 6002	TIEM#   055GRIPTION   0416 6029   0RILL SHAFT (RBWT ILL FOLE ) (30 IN)   0432 0001   RIPRAP (CONC) (4 IN)   050 0010   RIPRAP (4 IN)   050 0010   RIP	TEUP   DESCRIPTION

#### GENERAL NOTES:

- ALL WORK SHALL BE COMPLETED ACCORDING TO THE MOST CURRENT TXDOT STANDARDS, UTILITY COMPANY STANDARDS, AND THE NATIONAL ELECTRIC CODE.
- 2. THE CONTRACTOR SHALL VERIFY WITH THE UTILITY COMPANIES THE EXACT LOCATION OF EXISTING/ PROPOSED UNDERGROUND UTILITIES PRIOR TO CONSTRUCTION TO AVOID CONFLICT OR DAWAGE TO THE UTILITIES. THE CONTRACTOR SHALL SEEK THE APPROVAL OF THE ENGINEER AND ADJUST THE OFFSETS TO AVOID DAWAGE TO THE EXISTING/ PROFOSED UTILITIES.
- 3. REFER TO ILLUMINATION SUMMARIES, SCHEMATICS, AND TXDOT STANDARDS FOR ADDITIONAL INFORMATION.
- . PROPOSED ABOVE GROUND NEMA 3R JUNCTION BOXES SHALL NOT BE PAID FOR DIRECTLY, BUT SHALL BE SUBSIDIARY TO THE VARIOUS BID ITEMS.
- PROVIDE CONDUIT EXPANSION AND DEFLECTION COUPLING PRIOR TO ENTERING BRIDGE MOUNTED JUNCTION BOX FOR TRANSITION FROM UNDERGROUND CONDUIT TO BRIDGE EMBEDDED CONDUIT, COUPLING SHALL ALLOW FOR A MAXIMAM OF 4\* HORIZONTAL AND VERTICAL MOVEMENT.
- 6. REFER TO BRIDGE DRAWINGS FOR EXACT LOCATION OF BRIDGE MOUNTED ILLUMINATION ASSEMBLIES AND ASSOCIATED INSTALLATION DETAILS.

#### ILLUMINATION LEGEND

- FUTURE TXDOT STANDARD ILLUMINATION ASSEMBLY, 40' MOUNTING HEIGHT, 10 FT. LUMINAIRE ARM, (1) LED LUMINAIRE (250W EQ), SHOE BASE TO BRIDGE BLISTER, TYPE III DISTRIBUTION
- FUTURE TXDOT STANDARD ILLUMINATION ASSEMBLY, 40' MOUNTING HEIGHT, 10 FT. LUMINAIRE ARM, (1) LED LUMINAIRE (250W EQ), SHOE BASE TO RETAINING WALL LIGHTING BRACKET, TYPE III DISTRIBUTION
- TXDOT STANDARD ILLUMINATION ASSEMBLY, 40'
  MOUNTING HEIGHT, 10 FT. LUMINAIRE ARM, (1)
  LED LUMINAIRE (250W EQ), TRANSFORMER BASE,
  TYPE III DISTRIBUTION
  - TXDOT STANDARD TYPE II UNDERPASS ILLUMINATION ASSEMBLY, (1) LED LUMINAIRE (150W EQ), TYPE III DISTRIBUTION
- ELECTRICAL SERVICE ASSEMBLY, TYPE A, 240/480 VOLT, 1 PHASE, STEEL POLE 0
- GROUND BOX WITH APRON (NEMA 3R)
- GROUND BOX (NEMA 3R)
- $\boxtimes$ JUNCTION BOX (NEMA 3R)

V

- DISCONNECT SWITCH (NEMA 3R)
- CONDUCTORS IN CONDUIT RUN (RIGID METAL CONDUIT)
  - CONDUCTORS IN CONDUIT RUN (EMBEDDED IN BRIDGE STRUCTURE)
  - CONDUCTORS IN CONDUIT RUN (TRENCH)
- CONDUCTORS IN CONDUIT RUN (BORED) (xx)CONDUCTORS/CONDUIT SEGMENT NO.
- X/X/X ILLUMINATION ASSEMBLY DESIGNATION
- SERVICE POINT CIRCUIT DESIGNATION ELECTRICAL SERVICE DESIGNATION






FM 3349

ILLUMINATION PLAN


STA 525+00 TO STA 536+00

SCALE: 1"	=100'	SHEE	T 8 OF 11
GRM	FED. RD. DIV. NO.	FEDERAL AID PROJECT NO.	HIGHWAY NO.
	6		FM 334
GRAPHICS			


GRM	DIV. NO.	FEDERA	L AID PROJECT NO.	NO.
RAPHICS	6			FM 3349
GRM	STATE	DISTRICT	COUNTY	SHEET NO.
CHECK	TEXAS	AUS	WILLIAMSON	
PKD	CONTROL	SECTION	J08	705
PKD	3486	01	008, ETC	
PKD	3486	01	008, ETC	

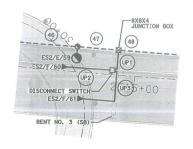

#### UNDERPASS ILLUMINATION DETAIL #1

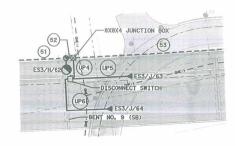

UNDERPASS ILLUMINATION DETAIL #3

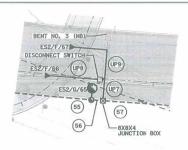

#### UNDERPASS ILLUMINATION DETAIL #4

#### ILLUMINATION LEGEND

FUTURE TXDOT STANDARD ILLUMINATION ASSEMBLY, 40' MOUNTING HEIGHT, 10 FT. LUMINAIRE ARM, (1) LED LUMINAIRE (250W EQ), SHOE BASE TO BRIDGE BLISTER, TYPE 111 DISTRIBUTION

TXDOT STANDARD TYPE II UNDERPASS ILLUMINATION ASSEMBLY, (1) LED LUMINAIRE (150W EQ), TYPE III DISTRIBUTION

 $\boxtimes$ JUNCTION BOX (NEMA 3R).

DISCONNECT SWITCH (NEMA 3R) 


CONDUCTORS IN CONDUIT RUN (RIGID METAL CONDUIT)

CONDUCTORS IN CONDUIT RUN (EMBEDDED IN BRIDGE STRUCTURE)

(XX) CONDUCTORS/CONDUIT SEGMENT NO.

<u>X/X/X</u> → ILLUMINATION ASSEMBLY DESIGNATION

SERVICE POINT CIRCUIT DESIGNATION ELECTRICAL SERVICE DESIGNATION

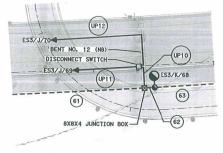

UNDERPASS ILLUMINATION DETAIL #6

SERVICE	POLE NO.	CIRCUIT	CTATION	OFFEFT	LOOPINI W WINE	warea
SERVICE	POLE NO.	CIRCUIT	STATION	OFFSET	ASSEMBLY TYPE	NOTES
ES2	59	E	SEE BRIDGE DWGS	BRIDGE LT (FM3349)	(TYPE ST 40 S-10 (250W EQ) LED	1
ES2	60	F	N/A	N/A	U/P (150W EQ) LED (TYPE 2)	
ES2	61	F	N/A	N/A	U/P (150W EQ) LED (TYPE 2)	
ES3	62	Н	SEE BRIDGE DWGS	BRIDGE LT (FM3349)	(TYPE ST 40 S-10 (250W EQ) LED	1
ES3	63	J	N/A	N/A	U/P (150W EQ) LED (TYPE 2)	
ES3	64	J	N/A	N/A	U/P (150W EQ) LED (TYPE 2)	
ES2	65	G	SEE BRIDGE DWGS	BRIDGE RT (FM3349)	(TYPE ST 40 S-10 (250W EQ) LED	1
ES2	66	F	N/A	N/A	U/P (150W EQ) LED (TYPE 2)	
ES2	67	F	N/A	N/A	U/P (150W EQ) LED (TYPE 2)	
ES3	68	K	SEE BRIDGE DWGS	BRIDGE RT (FM3349)	(TYPE ST 40 S-10 (250W EQ) LED	1
ES3	69	J	N/A	N/A	U/P (150W EQ) LED (TYPE 2)	
ES3	70	J	N/A	N/A	U/P (150W EQ) LED (TYPE 2)	

NOTE:
1) THE FUTURE ILLUMINATION ASSEMBLY WILL BE MOUNTED ON THE BRIDGE BLISTER LIGHTING BRACKET. REFER TO BRIDGE PLANS
FOR ADDITIONAL INFORMATION. COORDINATE INSTALLATION WITH BRIDGE CONTRACTOR. ILLUMINATION ASSEMBLY TO BE INSTALLED
IN THE FUTURE.


			CON	טטע				ONDU	11 3	SUM	MAKT					_			
			SEGMENT				(LF						NDUCT	ORS					
SERVICE	CIRCUIT	SEGMENT NO.	LENGTH	-			6064				620-6				06	20-	006	5	NOTE
		110.	(LF)	1	" R	1610	MET	ΓAL	#1	0 B	ARE	(GR	(DNDC		10 X	HHW	(PO	WER)	
ES2	E, F	46		R	EFER	TO	THE	OVER	ALL	ILL	UNIN	ITA	ON PL	AN S	SHEE	T			1
ES2	E,F	47		R	EFER	R TO	THE	OVER	ALL	ILL	UMIN	ITA	ON PL	AN S	SHEE	T			1
ES2	E, F	48		R	EFEF	R TO	THE	OVER	ALL	ILL	UNIN	ITA	ON PL	AN S	HEE	T			1
ES3	Н	51		R	EFEF	TO S	THE	OVER	ALL	ILL	UMIN	ITA	ON PL	AN S	SHEE	T			1
ES3	Н	52		R	EFEF	R TO	THE	OVER	ALL	ILL	UNIN	ITA	ON PL	AN S	SHEE	T			1
ES3	H, J	53		R	EFER	OT 9	THE	OVER	ALL	ILL	UNIN	ITA	ON PL	AN S	SHEE	T			1
ES2	F,G	55		R	EFER	TO S	THE	OVER	ALL	ILL	UNIN	ITA	ON PL	AN S	SHEE	T			1
ES2	F,G	56		R	EFEF	TO	THE	OVER	ALL	ILL	UNIN	ITA	ON PL	AN S	SHEE	T			1
ES2	G	57		R	EFER	TO	THE	OVER	ALL	ILL	UNIN	ITA	ON PL	AN S	SHEE	T			1
ES3	J, K	61		R	EFER	TO S	THE	OVER	ALL	ILL	UNIN	ATI	ON PL	AN S	HEE	T			1
ES3	J, K	62		R	EFER	TO	THE	OVER	ALL	ILL	UMIN	ITA	ON PL	AN S	SHEE	T			1
ES3	J, K	63		R	EFER	TO	THE	OVER	ALL	ILL	UMIN	ATI	ON PL	AN S	HEE	T			1
ES1	F	UP1	20	1	X	20		20	1	X	25	m	25	2	X	25	=	50	
ES1	F	UP2	36	1	X	36		36	1	X	41	=	41	2	X	41	=	82	
ES2	F	UP3	54	1	X	54	=	54	1	X	59	п	59	2	Х	59	*	118	
ES2	J	UP4	20	1	X	20		20	1	X	25	=	25	2	X	25		50	
ES1	J	UP5	45	1	Х	45		45	1	Х	50		50	2	X	50	=	100	
ES1	J	UP6	62	1	Х	62		62	1	X	67	m	67	2	X	67	=	134	
ES1	F	UP7	20	1	Х	20		20	1	X	25		25	2	X	25	=	50	
ES2	F	UP8	41	1	X	41	=	41	1	X	46	=	46	2	X	46		92	
ES2	F	UP9	53	1	Х	53	ш	53	1	X	58	=	58	2	X	58		116	
ES1	J	UP10	20	1	Х	20	=	20	1	X	25		25	2	X	25		50	
ES1	J	UP11	49	1	X	49		49	1	X	54		54	2	X	54	=	108	
ES1	J	UP12	98	1	X	98		98	1	Х	103		103	2		103	=	206	
	SHEET	TOTAL						518	<u> </u>		-		578	-		. , .		1156	

NOIE: 1) CONDJIT SEGMENT RUN EMBEDDED WITHIN THE CONCRETE RETAINING WALL AND/OR BRIDGE STRUCTURE. COORDINATE WITH RETAINING WALL AND/OR BRIDGE CONTRACTOR PRIOR TO ROUGH-IN.

	SHEET SUMMARY OF ESTIMATED QUANTITIES		
ITEM#	DESCRIPTION	UNIT	QTY
0610 6106	IN RD IL (U/P) (TY 2) (150W EQ) LED	EA	8
0610 6208	IN RD IL (TY SA) 408-10 (250W EQ) LED	EA	4
0618 6064	CONDT (RM) (1")	LF	518
0620 6005	ELEC CONDR (NO. 10) BARE	LF	578
0620 6006	ELEC CONDR (NO. 10) INSULATED	LF	1156

#### GENERAL NOTES:

- ALL WORK SHALL BE COMPLETED ACCORDING TO THE MOST CURRENT TXDOT STANDARDS, UTILITY COMPANY STANDARDS, AND THE NATIONAL ELECTRIC CODE.
- 2. THE CONTRACTOR SHALL VERIFY WITH THE UTILITY COMPANIES THE EXACT LOCATION OF EXISTING/ PROPOSED UNDERGROUND UTILITIES PRIOR TO CONSTRUCTION TO AVOID CONFLICT OR DAMAGE TO THE UTILITIES, THE CONTRACTOR SHALL SEEK THE APPROVAL OF THE ENGINER AND ADJUST THE OFFSETS TO AVOID DAMAGE TO THE EXISTING/ PROPOSED UTILITIES.
- 3. REFER TO ILLUMINATION SUMMARIES, SCHEMATICS, AND TXDOT STANDARDS FOR ADDITIONAL INFORMATION.
- 4. PROPOSED ABOVE GROUND NEMA 3R JUNCTION BOXES SHALL NOT BE FAID FOR DIRECTLY, BUT SHALL BE SUBSIDIARY TO THE VARIOUS BID ITEMS.
- 5. PROVIDE CONDUIT EXPANSION AND DEFLECTION COUPLING PRIOR TO ENTERING BRIDGE MOUNTED JUNCTION BOX FOR TRANSITION FROM UNDERGROUND COMDUIT TO BRIDGE EMBEDDED CONDUIT. COUPLING SHALL ALLOW FOR A MAXIMMO 04 4\* HORIZONTAL AND VERTICAL MOVEMENT.
- 6. REFER TO BRIDGE DRAWINGS FOR EXACT LOCATION OF BRIDGE MOUNTED ILLUMINATION ASSEMBLIES AND ASSOCIATED INSTALLATION DETAILS.

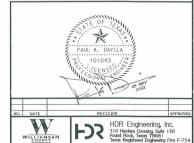




FM 3349

#### **UNDERPASS** ILLUMINATION PLANS

CALE: 1 "=50" SHEET 1 OF 2

GRM	DIV. NO.	FEDERA	L AID PROJECT NO.	NO.
GRAPHICS	6			FM 3349
GRM	STATE	DISTRICT	COUNTY	SHEET NO.
PKD	TEXAS	AUS	WILLIAMSON	
CHECK	CONTROL	SECTION	JOB	709
PKD	3486	01	008, ETC	
			All the same of th	

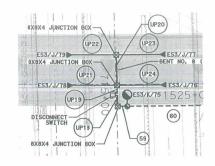

#### UNDERPASS ILLUMINATION DETAIL #5

SERVICE	POLE NO.	CIRCUIT	STATION	OFFSET	ASSEMBLY TYPE	NOTES
ES2	71	F	N/A	N/A	U/P (150W EQ) LED (TYPE 2)	
ES2	72	F	N/A	N/A	U/P (150W EQ) LED (TYPE 2)	
ES3	73	F	N/A	N/A	U/P (150W EQ) LED (TYPE 2)	
ES3	74	F	N/A	N/A	U/P (150W EQ) LED (TYPE 2)	
ES3	75	K	SEE BRIDGE DWGS	BRIDGE RT (FM3349)	(TYPE ST 40 S-10 (250W EQ) LED	1
ES3	76	J	N/A	N/A	U/P (150W EQ) LED (TYPE 2)	
ES3	77	J	N/A	N/A	U/P (150W EQ) LED (TYPE 2)	
ES3	78	J	N/A	N/A	U/P (150W EQ) LED (TYPE 2)	1
ES3	79	J	N/A	N/A	U/P (150W EQ) LED (TYPE 2)	

NOIE:
1) THE FUTURE ILLUMINATION ASSEMBLY WILL BE MOUNTED ON THE BRIDGE BLISTER LIGHTING BRACKET. REFER TO BRIDGE PLANS
FOR ADDITIONAL INFORMATION. COORDINATE INSTALLATION WITH BRIDGE CONTRACTOR. ILLUMINATION ASSEMBLY TO BE INSTALLED
IN THE FUTURE.

			OF OUT UT		CON	IDUI	r (L	F)				CO	NDUCT	ORS	(LF	)			
SERVICE	CIRCUIT	SEGMENT	SEGMENT LENGTH		0	618-	6064			06	20-	005			06	520-	6008	,	LIGHT
OLN TOL	CINCOIT	NO.	(LF)		1" R	1610	ME.	TAL	#1	О В	ARE	(GRC	(DNU	#	10 X	HHW	(PO	WER)	NOTE:
ES2	F	50		R	EFE	R TO	THE	OVER	ALL	ILL	UMIN	ITA	ON PL	AN S	SHEE	T			1
ES3	J	59		R	EFE	R TO	THE	OVER	ALL	ILL	UMIN	ATI	ON PL	AN S	SHEE	T			1
ES3	J, K	60		R	EFE	R TO	THE	OVER	ALL	ILL	UMIN	ATI	ON PL	AN S	HEE	T			1
ES2	F	UP13	20	1	X	20	-	20	1	X	25		25	2	Х	25	=	50	_
ES2	F	UP14	64	1	X	64		64	1	Х	69		69	2	Х	69		138	
ES2	F	UP15	31	1	Х	31	=	31	1	X	36		36	2	X	36	=	72	
ES2	F	UP16	81	1	Х	81		81	1	Х	86		86	2	Х	86	*	172	
ES2	F	UP17	81	1	Х	81		81	1	X	86		86	2	X	86		172	
ES3	J	UP18	15	1	Х	15	и.	15	1	X	20	=	20	2	X	20		40	
ES3	J	UP19	10	1	X	10		10	1	X	15		15	2	X	15	*	30	
ES3	J	UP20	25	1	X	25		25	1	X	30		30	2	X	30		60	_
ES3	J	UP21	37	1	Χ	37	=	37	1	X	42		42	2	X	42		84	
ES3	J	UP22	37	1	X	37	=	37	1	X	42	=	42	2	X	42		84	
ES3	J	UP23	37	1	Х	37		37	1	Х	42	=	42	2	X	42		84	
ES3	J	UP24	37	1	X	37	-	37	1	X	42	=	42	2	X	42		84	
	SHEET	TOTAL						475	-	-			535	-				1070	

NOTE:
1) CONDUIT SEGMENT RUN EMBEDDED WITHIN THE CONCRETE RETAINING WALL AND/OR BRIDGE STRUCTURE.
COORDINATE WITH RETAINING WALL AND/OR BRIDGE CONTRACTOR PRIOR TO ROUGH-IN.

ITEM#	DESCRIPTION	UNIT	QTY
0610 6106	IN RD IL (U/P) (TY 2) (150W EQ) LED	EA	8
0610 6208	IN RD IL (TY SA) 408-10 (250W EQ) LED	EA	1
0618 6064	CONDT (RM) (1") 15	LF	475
0620 6005	ELEC CONDR (NO.10) BARE	LF	535
0620 6006	ELEC CONDR (NO. 10) INSULATED	LF	1070

#### GENERAL NOTES:

- ALL WORK SHALL BE COMPLETED ACCORDING TO THE MOST CURRENT TXDOT STANDARDS, UTILITY COMPANY STANDARDS, AND THE NATIONAL ELECTRIC CODE.
- 2. THE CONTRACTOR SHALL VERIFY WITH THE UTILITY COMPANIES THE EXACT LOCATION OF EXISTING/ PROPOSED UNDERGROUND UTILITIES PRIOR TO CONSTRUCTION TO AVOID CONFLICT OR DAMAGE TO THE UTILITIES. THE CONTRACTOR SHALL SEEK THE APPROVAL OF THE ENGINEER AND ADJUST THE OFFSETS TO AVOID DAMAGE TO THE EXISTING/ PROPOSED UTILITIES.
- 3. REFER TO ILLUMINATION SUMMARIES, SCHEMATICS, AND TXDOT STANDARDS FOR ADDITIONAL INFORMATION.
- 4, PROPOSED ABOVE GROUND NEMA 3R JUNCTION BOXES SHALL NOT BE PAID FOR DIRECTLY, BUT SHALL BE SUBSIDIARY TO THE VARIOUS BID ITEMS,
- 5. PROVIDE CONDUIT EXPANSION AND DEFLECTION COUPLING PRIOR TO ENTERING BRIDGE MOUNTED JUNCTION BOX FOR TRANSITION FROM UNDERGROUND CONDUIT TO BRIDGE EMBEDDED CONDUIT, COUPLING SHALL ALLOW FOR A MXXIMAM OF 4\* HORIZONTAL AND VERTICAL MOVEMENT.
- 6, REFER TO BRIDGE DRAWINGS FOR EXACT LOCATION OF BRIDGE MOUNTED ILLUMINATION ASSEMBLIES AND ASSOCIATED INSTALLATION DETAILS.

#### ILLUMINATION LEGEND

FUTURE TXDOT STANDARD ILLUMINATION ASSEMBLY, 40' MOUNTING HEIGHT, 10 FT. LUMINAIRE ARM, (1) LED LUMINAIRE (250W EQ), SHOE BASE TO BRIDGE BLISTER, TYPE 111 DISTRIBUTION

TXDOT STANDARD TYPE II UNDERPASS ILLUMINATION ASSEMBLY, (1) LED LUMINAIRE (150W EQ), TYPE III DISTRIBUTION 

 $\boxtimes$ JUNCTION BOX (NEMA 3R).

DISCONNECT SWITCH (NEMA 3R) 


CONDUCTORS IN CONDUIT RUN (RIGID METAL CONDUIT)

CONDUCTORS IN CONDUIT RUN (EMBEDDED IN BRIDGE STRUCTURE)

(xx)CONDUCTORS/CONDUIT SEGMENT NO.

X/X/X → ILLUMINATION ASSEMBLY DESIGNATION

SERVICE POINT CIRCUIT DESIGNATION ELECTRICAL SERVICE DESIGNATION

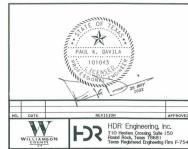

Texas Department of Transportation T<sub>©</sub>

FM 3349

#### **UNDERPASS ILLUMINATION PLANS**

CALE: 1"=50' HIGHWAY NO. GRM FM 3349 SHEET NO. GRM STATE DISTRICT COUNTY AUS TEXAS WILLIAMSON PKD CONTROL SECTION 710 CHECK 01 PKD 3486 008, ETC

AM	
9: 40: 04	
5/25/2022 \$FTIF\$	4111
üü	,

			SHIPP	ING PARTS LIST - P	OLES AND L	UMINAIRE	ARMS		
Nominal	Shoe Base			T-Bas	е		CSB/SSCB Mounted		
Mounting Ht.	Designation			Designation			Designation		
(f+)	Pole A1 A2	Luminaire	Quantity		Luminaire	Quantity		Luminaire	Quantity
20	(Type SA 20 S - 4)	(150W EQ) LED		(Type SA 20 T - 4)	(150W EQ) LED				
	(Type SA 20 S - 4 - 4)	(150W EQ) LED		(Type SA 20 T - 4 - 4)	(150W EQ) LED				
30	(Type SA 30 S - 4)	(250W EQ) LED		(Type SA 30 T - 4)	(250W EQ) LED		(Type SP 28 S - 4)	(250W EQ) LED	
	(Type SA 30 S - 4 - 4)	(250W EQ) LED		(Type SA 30 T - 4 - 4)	(250W EQ) LED		(Type SP 28 S - 4 - 4)	(250W EQ) LED	
	(Type SA 30 S - 8)	(250W EQ) LED		(Type SA 30 T - 8)	(250W EQ) LED		(Type SP 28 S - 8)	(250W EQ) LED	
	(Type SA 30 S - 8 - 8)	(250W EQ) LED		(Type SA 30 T - 8 - 8)	(250W EQ) LED		(Type SP 28 S - 8 - 8)	(250W EQ) LED	
40	(Type SA 40 S - 4)	(250W EQ) LED		(Type SA 40 T - 4)	(250W EQ) LED		(Type SP 38 S - 4)	(250W EQ) LED	
	(Type SA 40 S - 4 - 4)	(250W EQ) LED		(Type SA 40 T - 4 - 4)	(250W EQ) LED		(Type SP 33 S - 4 - 4)	(250W EQ) LED	
	(Type SA 40 S - 8)	(250W EQ) LED		(Type SA 40 T - 8)	(250W EQ) LED		(Type SP 38 S - 8)	(250W EQ) LED	
	(Type SA 50 S - 8 - 8)	(400W EQ) LED		(Type SA 50 T - 8 - 8)	(400W EQ) LED		(Type SP 48 S - 8 - 8)	(400W EQ) LED	
	(Type SA 50 S - 10)	(400W EQ) LED		(Type SA 50 T - 10)	(400W EQ) LED		(Type SP 48 S - 10)	(400W EQ) LED	
	(Type SA 50 S - 10 - 10)	(400W EQ) LED		(Type SA 50 T - 10 - 10)	(400W EQ) LED		(Type SP 48 S - 10 - 10)	(400W EQ) LED	
	(Type SA 50 S - 12)	(400W EQ) LED		(Type SA 50 T - 12)	(400W EQ) LED		(Type SP 48 S - 12)	(400W EQ) LED	
	(Type SA 50 S - 12 - 12)	(400W EQ) LED		(Type SA 50 T - 12 - 12)	(400W EQ) LED		(Type SP 48 S - 12 - 12)	(400W EQ) LED	

	C	THER	
	Quantity		
Pole	Designat A1 A2	Luminaire	Quantity
27.00.17 and a			
- 2			

#### GENERAL NOTES:

- 1. All work, materials and services not shown on the plans which may be necessary for complete and proper construction shall be performed, furnished and installed by the Contractor. Faulty fabrication or poor workmanship in any material, equipment or installation will be considered justification for rejection. Where manufacturers provide warranties or guarantees as a customary trade practice, furnish to the Department such warranties or guarantees.
- 2. The location of poles and fixtures are diagrammatic only and may be shifted by the Engineer to accommodate local conditions. Install or remove poles and luminaires located near overhead electrical lines using established industry and the steep procities and in accordance with laws governing such work. Consult with the appropriate utility company prior to beginning such work.
- Standard Steel Pole Designs. Steel poles fabricated in accordance with the details and dimensions shown herein, shall be considered standard designs. Submission of shop drawings and design calculations for standard designs is not required.
- Optional Steel Pole Designs. Multi-sided steel poles may be allowed as optional designs, if steel poles are permitted or required, pending approval by the Department as outlined below.
- a. Shop Drawings. Optional designs require submission of stop drawings and design calculations bearing the seal of an engineer licensed in the State of Texas, in accordance with Item 441, "Steel Structures." The Department may elect to pre-approve some shop drawings for optionally designed poles. Submission of shop drawings and design calculations is not required for structures fabricated in accordance with the details of shop drawings on the pre-approved list maintained by the TXDCT Traffic Operations Division. Any deviation from the pre-approved shop drawings will require submission of shop drawings of the complete submission of shop drawing submission and special submission of shop drawing submission of shop drawing submission and special shop submission of shop drawing submission submissi

- Aluminum Pole Designs. Aluminum pole designs may be allowed, if aluminum poles are permitted or required, pending approval by the Department as outlined below.
- a. Meet all of the requirements stated above for optional steel pole designs and the following:

  1. Aluminum poles shall be fabricated in accordance with "Structural Welding Code-Aluminum" AWS D1.2.

  2. Aluminum poles shall be fabricated in accordance with "Structural Welding Code-Aluminum" AWS D1.2.

  2. Aluminum poles shall be equipped to the same anchor bolt assembly and be subject to the same geometric restraints and other requirements for steel poles specified herein.

  3. Aluminum poles shall be equipped with vibration mitigation devices, as approved by the engineer.

  4. Pole components shall be constructed using the following material:

  5. Shaft: ASTM B221 or B241 Alloy 6063-76, ASTM B209 Alloy 5066-H34, ASTM B221 Alloy 6005-75.

  5. Base Flanger ASTM B24 Alloy 356.0-T6 or ASTM B108 Alloy 356.0-T6 (Yield strength test required).

  Mast Arm Fitting: ASTM B20 Alloy 5066-16 or ASTM B221 Alloy 6005-15.

  Mast Arms: ASTM B24 Alloy 6061-T6 or ASTM B108 Alloy 356.0-T6.

  Pole Cap: ASTM B209 Alloy 5086-H32 or ASTM B108 or B26 Alloy 356.0-T6.


  Bolts: Stallmless Steel AIST 300 series. Bolts threading into aluminum threads shall be treated with anti-seize compound, Never-Seez Compound, Permatex 133K or equal.

- 6. Special Designs. Poles with architectural treatments shall meet the requirements shown elsewhere in the plans.
- 7. Luminaire Mounting Height. Actual luminaire mounting height shall be the nominal mounting height given on RIP(2) for all pole-arm combinations except for poles with 4 ft. luminaire arms, which shall be 3'-0" lower than the nominal height, unless otherwise shown or directed.

#### EXPLANATION OF ROADWAY ILLUMINATION ASSEMBLY DESIGNATIONS /B


(TYPE SA 50 T - X - X) (400W EQ) LED SA: Pole and mast arm may be steel or— aluminum. ST: Pole and mast arm must be steel.
AL: Pole and mast arm must be aluminum. SP: Special (ovalized) steel or aluminum pole for installing on CSB or SSCB. See standard sheet CSB (4), or SSCB (4). Two numerical digits denote nominal mounting height in feet. Next letter denotes type of base, (S-Shoe Base, T-Transformer Base, or B-Bridge/Ret.Wall Mount) First number denotes length of mast arm-Use of second mast arm is indicated by second dashed number which denotes length in feet. Luminaire rating in watts (i.e. 400W). Equivalent wattage LED fixtures will include EQ (i.e. 400W EQ) Last letters indicate light source (S - High Pressure Sodium; LED - LED luminaire)


SHEET 1 OF 4

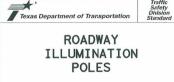

RTP(1)-19

FILE: rip-19.dgn	DN:		CK:	DW:		CKI
© TxDOT January 2007	CONT	SECT	J08	3	н	SHWAY
REVISIONS	3486	01	008,	ETC	FM	3349
7-17 12-19	DIST		COUR	ITY		SHEET NO.
15-19	AUS	WILLIAMSON			723	

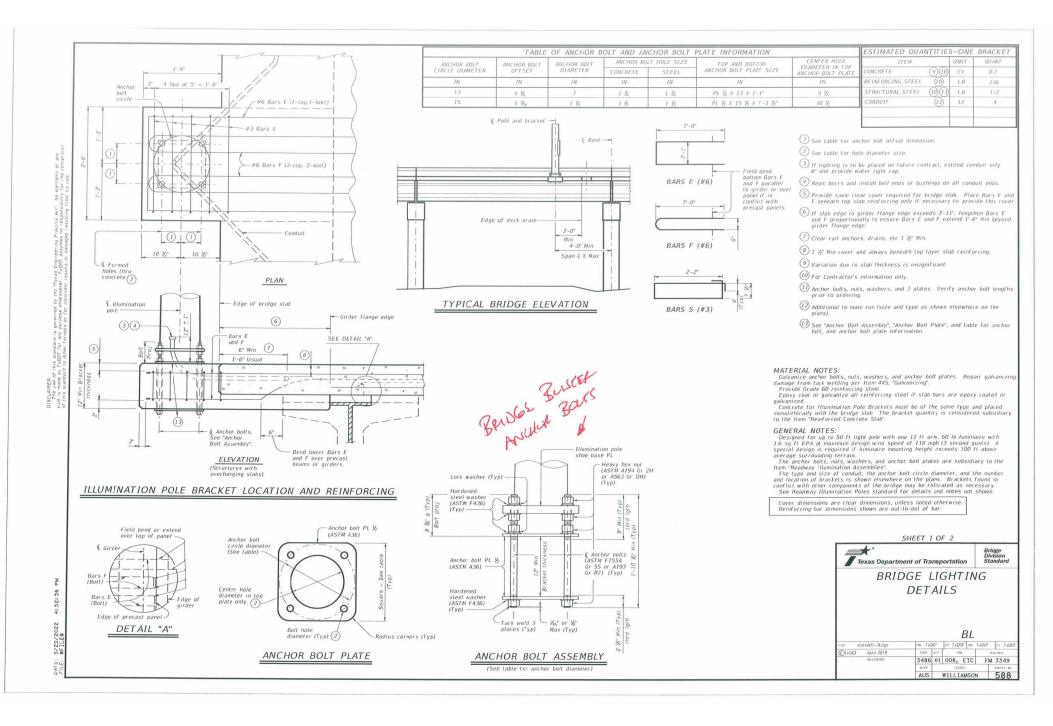

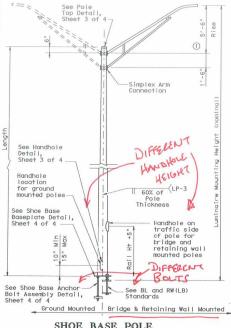

1 B 60% of (LP-3 Pole Thickness See Transformer Base Baseplate Detail, Sheet 4 of 4 See Transformer Base Details, Sheet 4 of 4 See Transformer Base Anchor Bolt Assembly Detail, Sheet 4 of 4

# 1 Simplex Arm Connection Seam Weld located 45° from mast Mount Ing 60% of (LP-3 arm axis-Thickness See Handhole Detail, Sheet 3 of MID. Mdx. See Concrete Traffic Barrier Base Baseplate Detail, \_\_\_\_ Sheet 4 of 4 See Concrete Traffic Barrier Base Anchor Bolt Assembly Detail, Sheet 4 of 4

#### CONCRETE TRAFFIC BARRIER BASE POLE

CONCRE	TE TRAF	FIC BARR	IER BAS	SE POLE	CSB/SS	CB)
Luminaire Mounting	Base	Тор	Length	Pole	Design (K-	
Height (Nominal) (ft)	Diameter (in)	Diameter (in)	(ft)	Thickness (in)	About € of Rail	Perp. to Rail
28.00	9.00	5.78	23.00	0,1196	10.3	13.2
38.00	9.00	4.38	33.00	0.1196	16.6	20.8
48.00	10.50	4.48	43.00	0.1345	25.1	30.5

#### SHOE BASE POLE

	SHOE BASE POLE									
Luminaire Mounting Height (Nominal)(ft)	Base Diameter (in)	Top Diameter (in)	Length (ft)	Pole Thickness (in)	Design Moment (K-ft)					
20.00	7.00	4.90	15.00	0.1196	7.1					
30,00	7.50	4.00	25.00	0.1196	13.2					
31.00-39.00	8.00	4.36-3.24	26.00-34.00	0.1196	20.7					
40.00	8.50	3.60	35.00	0.1196	20.7					
50.00	10.50	4.20	45.00	0.1196	30.3					

		SHOE BAS				
Luminaire Mounting Height (Nominal) (ft)	Base Diameter (in)	Top Diameter (in)	Length (ft)	Pole Thickness (in)	Design Moment (K-ft)	Luminaire Mounting Height (Nominal)(ft)
20.00	7.00	4.90	15.00	0.1196	7.1	20.00
30.00	7.50	4.00	25.00	0.1196	13.2	30.00
31.00-39.00	8.00	4.36-3.24	26.00-34.00	0.1196	20.7	31.00-39.00
40.00	8.50	3.60	35.00	0.1196	20.7	40.00
50.00	10.50	4.20	45.00	0.1196	30.3	50.00

#### GENERAL NOTES:

- 1. Designs conform to AASHTO Standard Specifications for Structural Supports for Highway Signs, Luminaires, and Traffic Signals, 6th Edition (2013) and Interim Revisions thereto. Design 3-Second Gust Wind Speed equals 110 mph with a 1.14 gust factor. A wind importance factor of 0.80 is applied to adjust the wind speed to a 25 year recurrence interval. Design moments listed in tables assume base of pole is above natural ground level.
- Structures are designed to support two 12' luminaire most arms and luminaires. Most arms are designed to support a 60-pound luminaire having an effective projected area of 1.6 square feet.
- Fabrication shall be in accordance with the Specifications and with the details, dimensions, and weld procedures shown herein. Do not submit shop drawings for roadway illumination pole assemblies fabricated in accordance with the details, dimensions, and weld procedures shown herein. Weld references call for preapproved weld procedures which the Fabricator must obtain prior to fabrication. Materials, fabrication telerances, and shipping practices shall meet the requirements of these sheets and the Specifications. In the absence of specified fabrication tolerances, dimensions shall be within the tolerances generally obtainable in normal fabrication
- 4. For mounting heights between values shown in the tables, use base diameter and thickness values for the larger height.

TRANSFORMER BASE POLE

Diamete (in)

5.11

4.21

3.81

3.91

1, 57-3, 45

Rose

(in)

7.00

7.50

8.00

8.50

10.00

TRANSFORMER BASE POLE

13.50

23.50

4.50-32.50

33.50

43.50

Pole hickness (in)

0.1196

0,1196

0.1196

0.1196

0.1196

Moment (K-ft)

7.1

13.2

20.7

20.7

30.3

- 5. Unless otherwise noted, all steel parts shall be galvanized in accordance with Item 445, "Galvanizing."
- Steel poles shall be fabricated in accordance with Item 441, 'Steel Structures." Longitudinal seam welds for pole sections shall have 50% minimum penetration. All welding shall be in accordance with AMS D1.1, Structural Welding
- 7. Two-section poles joined by circumferential welds will not be permitted, unless otherwise shown on the plans. Poles may be fabricated in two sections and field-assembled by the lap-joint method. The two sections shall telescope together with a lap length of not less than 1-1/2 times the shaft diameter at the lap joint.
- Alternate material equal to or better than material specified may be substituted with the approval of the
- Lubricate and tighten anohor bolts, when erecting shoe base poles and concrete traffic barrier base poles, in accordance with Item 449, "Anohor Bolts."
- 10. All poles, except Transformer Base Poles, shall have hand holes with reinforcing frames and covers. For ground mounted shall be poles for the poles of the po
- 11. The finished pole shall have a smooth, uniform finish free of pits, blisters, or other defects. Scratched, chipped, and other danaged galvanized areas on poles and mast arms shall be repaired in accordance with Item 445, "Galvanizina.
- 12. Pole length is based on a 5′-6″ luminaire arm rise. 4 ft. luminaire arms have a 2′-6″ rise. A pole with 4 ft. luminaire arms will have an actual mounting height 3′-0″ less than the nominal mounting height. Increasing the pole length to meet the nominal mounting height is allowed, but unnecessary unless otherwise directed by the engineer.
- 13. Freet transformer base poles in accordance with sheet RID(1).

IN. ELD
0
6
2
5 05
6

#### NOTES:

- 1)2'-6" rise for 4 ft. luminaire arms.
- ②Before ovalized as shown on Concrete Traffic Barrier Base Baseplate details, Sheet 4 of 4.
- (3) A1011 SS Gr 50 may be used instead of HSLAS, provided the material meets the elongation requirements for HSLAS.

#### POLE ASSEMBLY FABRICATION TO FRANCES TARI F

IOLERANCES	ABLE
DIMENSION	TOLERANCE
Shaft length	+1"
I.D. of outside piece of slip fitting pieces	+1/8", -1/16"
O.D. of inside piece of slip fitting pieces	+1/32", -1/8"
Shaft diameter: other	+3/16"
Out of "round"	1/4"
Straightness of shaft	±1/4" in 10 ft
Twist in multi-sided shaft	4° in 50 ft
Perpendicular to baseplate	1/8" in 24"
Pole centered on baseplate	±1/4"
Location of Attachments	±1/4"
Bolt hole spacing	±1/16"

SHEET 2 OF 4

\* Texas Department of Transportation

Traffic Sefety Division Standard

ROADWAY ILLUMINATION **POLES** 

RIP(2) - 19

ILE: rip-19.dgn	DN:		CK:	DW:		CKI
Tx001 January 2007	CONT	SECT	JOE		н	IGHWAY
REVISIONS	3486	01	008,	ETC	FM	3349
7-17 2-19	0157	COUNTY			SHEET NO.	
2-19	AUS	WILLIAMSON				724
738					_	

warranty of the convers

P 4

desumes no responsibility
ts or damages resulting fre

AIMER: The use of this standard is governed by the "T is made by IXBOI for any purpose whatseaver. his standard to other formars or for incorrear.