F.H.W.A. REGION	STATE	PROJECT NO.	SHEET NO.	TOTAL SHEETS	RECORD DRAWING
9	ARIZ.	180-A(205)S	-	-	

180 CN 215

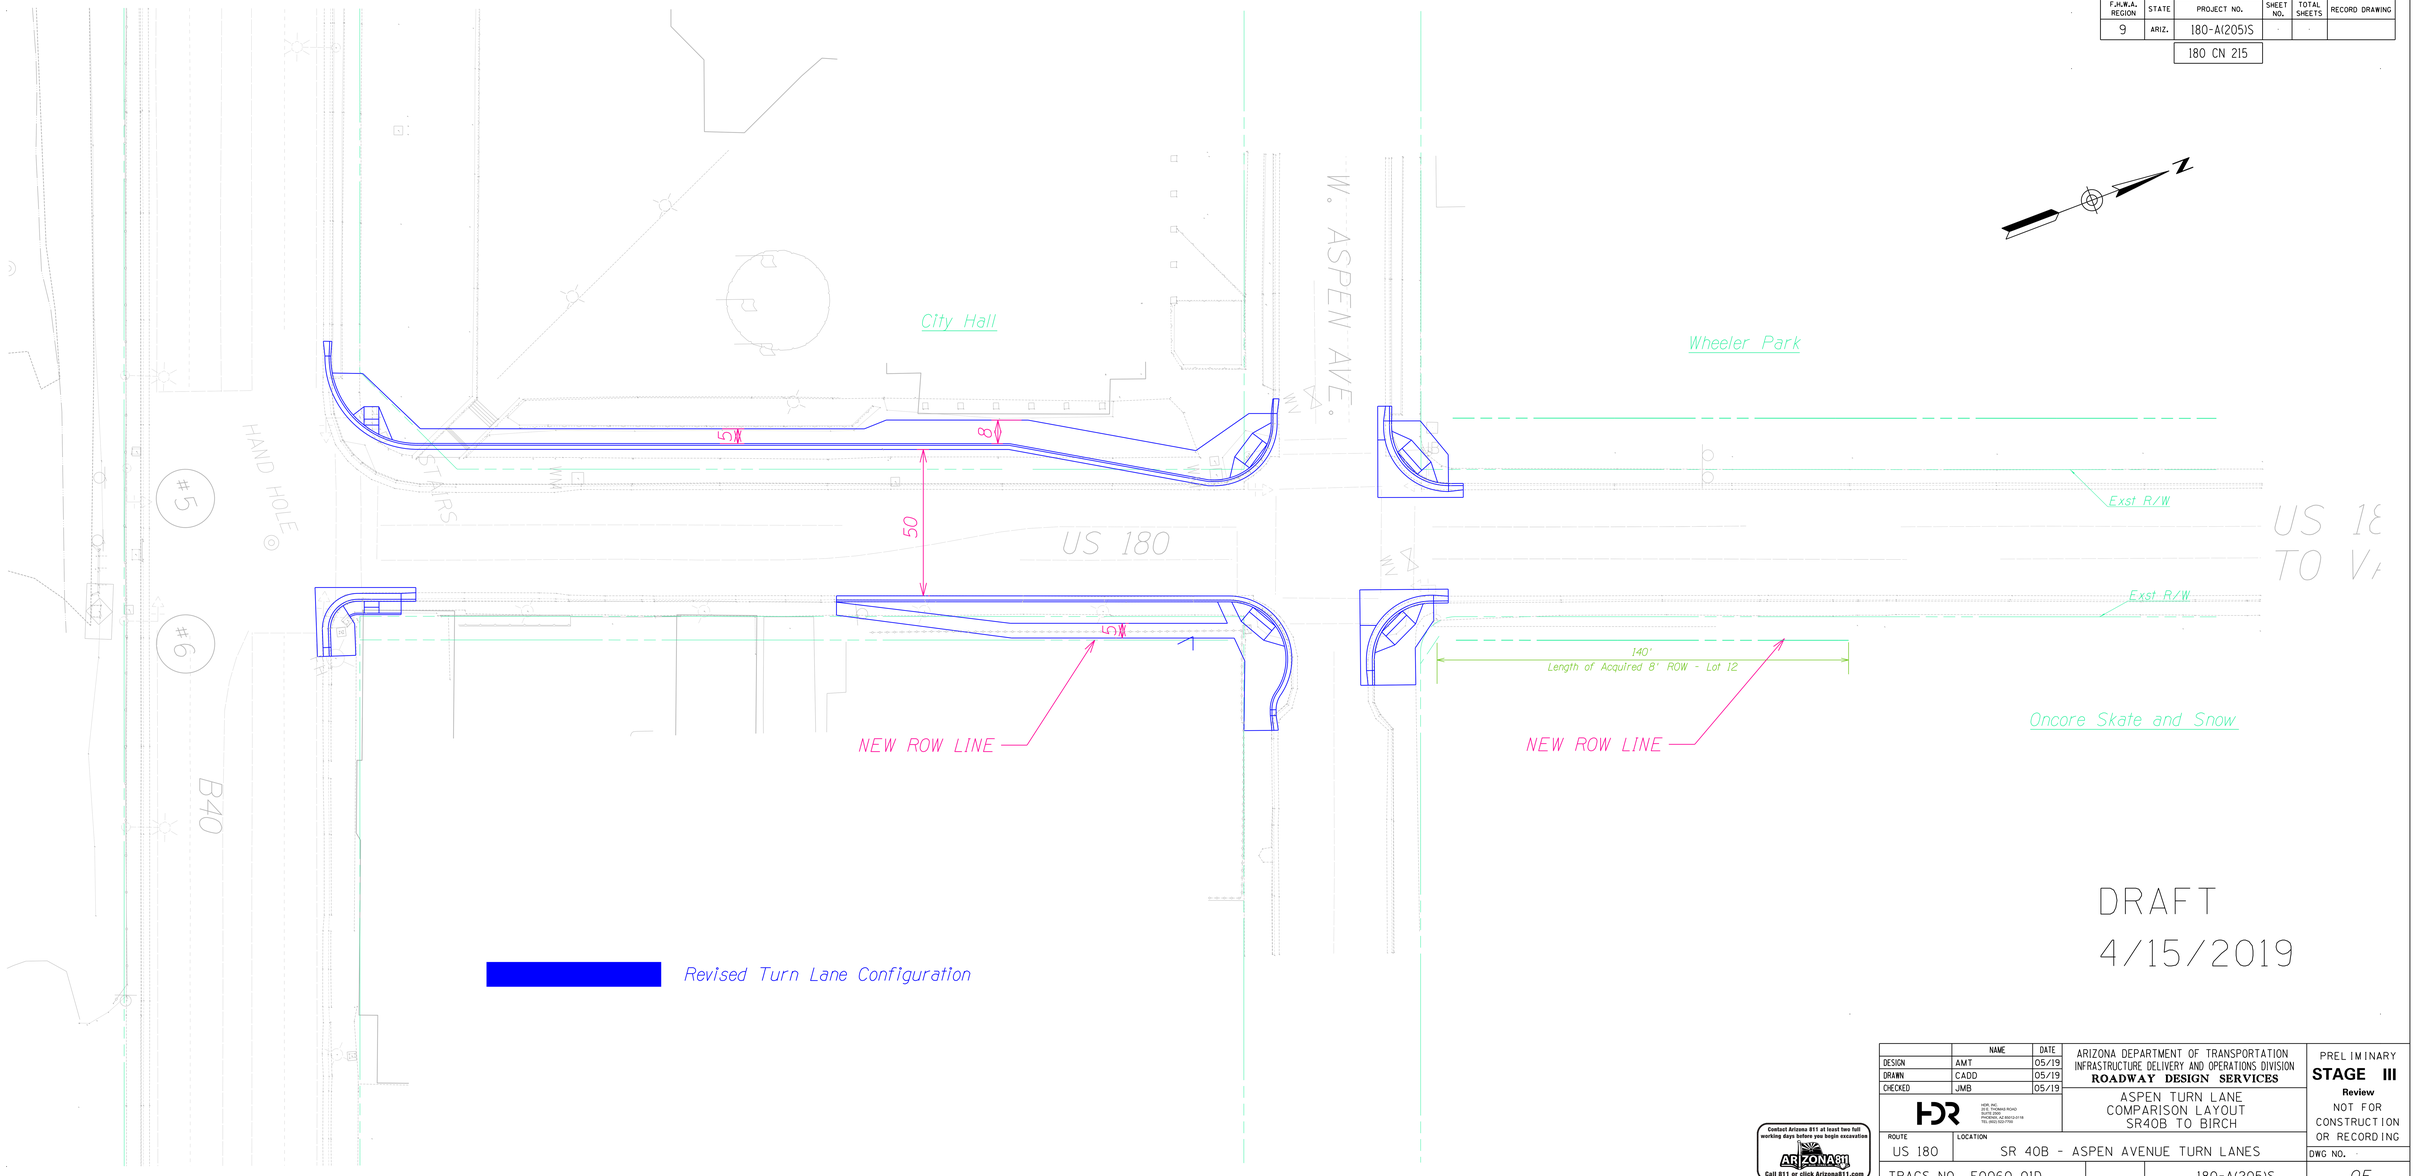

	NAME	DATE
DESIGN	AMT	05/19
DRAWN	CADD	05/19
CHECKED	JMB	05/19

HDR, INC.
2141 E. BROADWAY ROAD
SUITE 200N
PHOENIX, AZ 85072-0118
TEL (602) 522-7700

ARIZONA DEPARTMENT OF TRANSPORTATION
INFRASTRUCTURE DELIVERY AND OPERATIONS DIVISION
ROADWAY DESIGN SERVICES

ASPEN TURN LANE
COMPARISON LAYOUT
SR40B TO BIRCH

PRELIMINARY
STAGE III
Review
NOT FOR CONSTRUCTION OR RECORDING

ROUTE	LOCATION	DWG NO.
US 180	SR 40B - ASPEN AVENUE TURN LANES	
TRACS NO. F0060 01D	180-A(205)S	___ OF ___

Contact Arizona 811 at least two full working days before you begin excavation
ARIZONA811
Call 811 or click Arizona811.com

FILE NAME c:\pwworking\west01\d1107129\F0060_UltimateComparison.dgn PLOT SCALE 1:12.2222 PLOT BY ATILLEY
SURVEY NO. | FINISHED PLANS | REVISIONS | LOCATION | DATE
PLOT DATE Apr. 15, 2019 TIME 2:55:46 PM
SURVEY NO. | FINISHED PLANS | REVISIONS | LOCATION | DATE