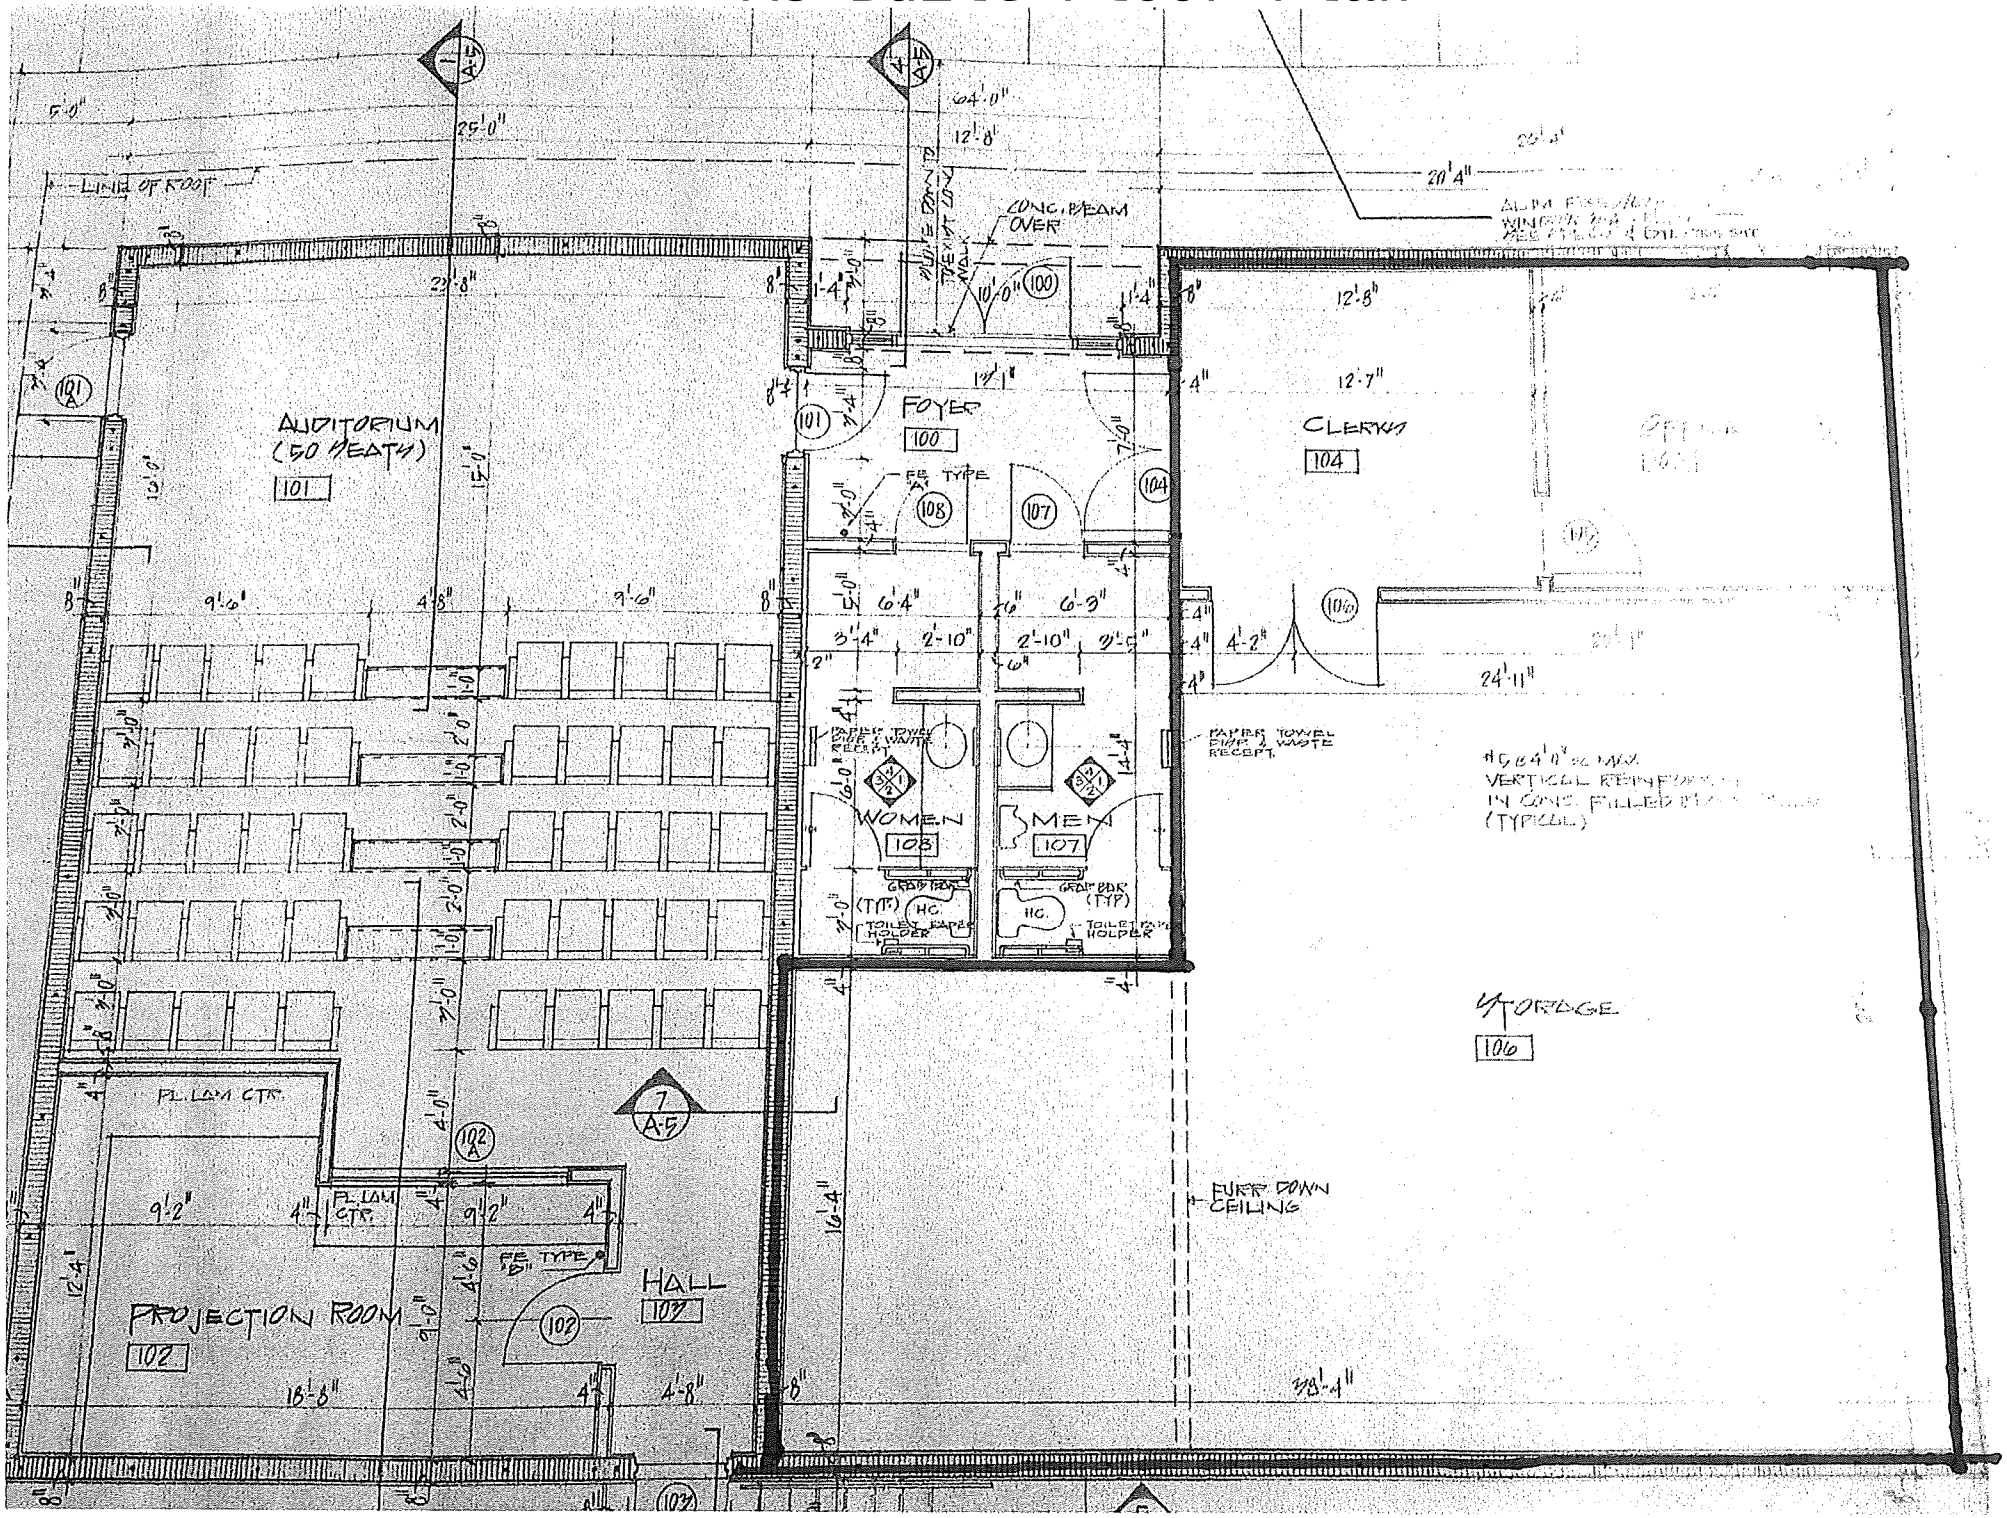As-Built Floor Plan