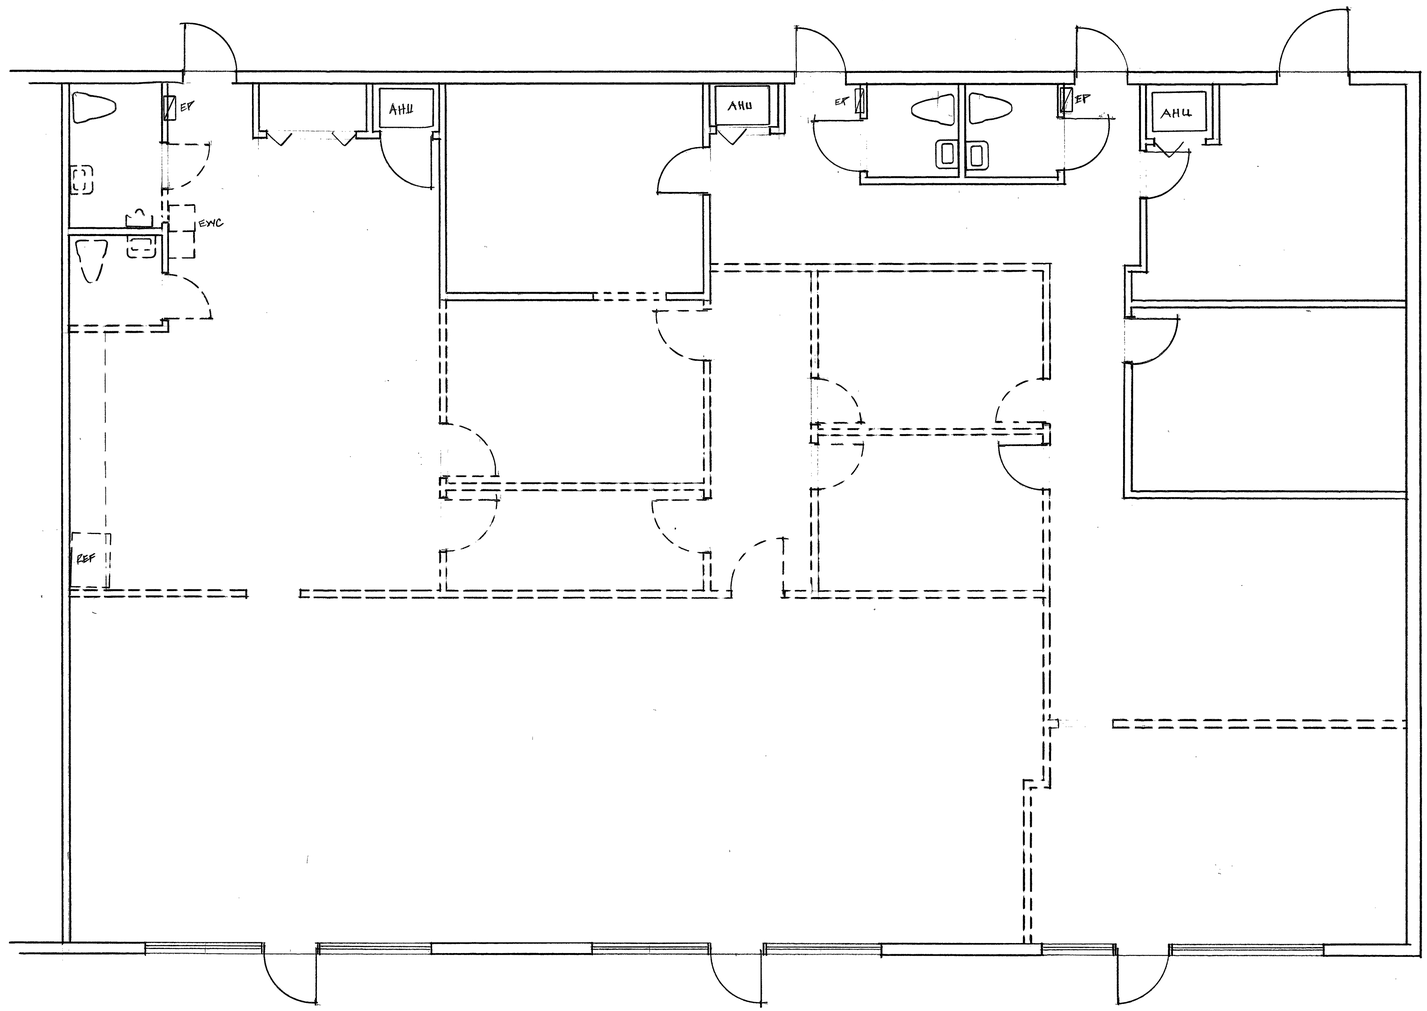

AS-BUILT / DEMOLITION FLOOR PLAN

1/4"

WALL LEGEND

- EXISTING WALLS TO REMAIN
- EXISTING WALLS TO BE REMOVED
- PROPOSED 2X4 FRAME WALLS

ARCHITECT

Architectonic Inc

806 DELAWARE AVENUE
FORT PIERCE, FLORIDA 34950
T: 772 460 7751
F: 772 460 4244

WWW.ARCHITECTONICINC.COM

STATE REG # AA26003348

COPYRIGHT 2017

PROJECT

SPIN WIN II ARCADE

FT. PIERCE, FLORIDA

CLIENT

CONSULTANTS

REGISTRATION

MICHAEL J. SEAL, AIA
AR96898

REVISIONS

NO.	DATE	REVISION

KEY PLAN

SHEET TITLE / SHEET NUMBER

A-2 OF 3

PROJECT NUMBER C19024

DATE 6/26/19

CONDITIONAL USE