



HIDALGO COUNTY PLANNING DEPARTMENT

1304 SOUTH 25TH STREET
EDINBURG TEXAS 78539
Tel. 956-318-2840 Fax. 956-318-2844

Raul E. Sesin, P.E., CFM
Planning Administrator

HIDALGO COUNTY COMMISSIONERS COURT MEETING

DATE: 07-01-2014

PROPOSED ARIA RANCHES SUBDIVISION, PRECINCT No. 4.

ENGINEER: QUINTANILLA, HEADLEY & ASSOCIATES DEVELOPER: RICHARD A. GARZA

PRELIMINARY APPROVAL FINAL APPROVAL FINAL APPROVAL WITH FINANCIAL GUARANTEE WITH VARIANCE
NUMBER OF LOTS: 37 *SINGLE FAMILY *MULTI-FAMILY COMMERCIAL INSTITUTIONAL

LOCATION DESCRIPTION: 300 feet North of Canton Rd on the East side of Alamo Rd.
SUBDIVISION LIES WITHIN THE: ETJ of Edinburg and was approved by the P & Z and City Commission of said City

DRAINAGE REPORT WAS APPROVED BY HCDD#1: ON 07-01-13 PROPERTY LIES WITHIN FLOOD ZONE: "B" AS PER FEMA.
DRAINAGE DESIGN: Drainage will be accomplished by a storm drainage pipe system discharging to an existing drain ditch abutting North of the subdivision. Detention is provided by widening the existing drain ditch.

ROAD R.O.W. DEDICATION: 20 feet on Alamo Road

H.C.R.O.W. FINAL APPROVAL DATE: 06-06-14 : By, Jesse Ozuna PCT 4 R.O.W. AGENT

H.C.H.D APPROVAL DATE: 04-22-13 by: Elizardo "Chardo" Ramos, Environmental Health Division Manager

OSSF & SOIL ANALYSIS WERE CONDUCTED BY: Jose Angel Gonzalez
SEWER SYSTEM: OSSF HAVE BEEN ESCROWED WITH THE COUNTY.

WATER SERVICE PROVIDER: N.A.W.S.C. LINE SIZE: 8" LOCATION: East side of along Alamo Rd

PRELIMINARY APPROVAL FROM THE
HIDALGO COUNTY COMMISSIONERS COURT ON: DECEMBER 03, 2013

REQUEST FOR FINAL APPROVAL WITH: **Cash Deposit:** Amount: \$ 55,500.00 For: OSSF(S) 37
STAFF RECOMMENDS: **Preliminary Approval** subject to comments and future recommendations by planning, other departments and the approval of the City of Edinburg .
 Final Approval subject to recommendations other departments
 Final Approval with financial guarantee.

This subdivision plat has been reviewed and complies with the Hidalgo County Subdivision Rules, Texas Water Development Board Model Subdivision Rules and The Texas Local Government Code.

**SUBDIVISION PLAT OF:
ARIA RANCHES SUBDIVISION**

A 26.15 ACRE TRACT OF LAND OUT OF LOT 13, BLOCK 60, ALAMO LAND AND SUGAR COMPANY'S SUBDIVISION, HIDALGO COUNTY, TEXAS, ACCORDING TO THE MAP OR PLAT THEREOF RECORDED IN VOLUME 1, PAGES 24-26, MAP RECORDS, HIDALGO COUNTY, TEXAS, AND ACCORDING TO WARRANTY DEED WITH VENDOR'S LIEN RECORDED UNDER DOCUMENT NUMBER 2465042 AND WARRANTY DEED RECORDED UNDER DOCUMENT NUMBER 2456982, OFFICIAL RECORDS, HIDALGO COUNTY, TEXAS.

STATE OF TEXAS
COUNTY OF HIDALGO
OWNER'S DEDICATION, CERTIFICATION, AND ATTESTATION

I, RICHARD A. GARZA, MEMBER OF G.R. INVERSIONES, LLC, AS OWNER OF THE 26.15 ACRES TRACT OF LAND ENCOMPASSED WITHIN THE PROPOSED ARIA RANCHES SUBDIVISION, HEREBY SUBMIT THE LAND AS DEFINED IN THIS SUBDIVISION PLAT AND DEDICATE TO PUBLIC USE THE STREET, PARK, AND EASEMENTS SHOWN HEREIN.

I CERTIFY THAT I HAVE COMPLIED WITH THE REQUIREMENTS OF TEXAS LOCAL GOVERNMENT CODE 232.032 AND THAT:

(A) THE WATER QUALITY AND CONNECTIONS TO THE LOTS MEET, OR WILL MEET, THE MINIMUM STATE STANDARDS;
(B) SEWER CONNECTIONS TO THE LOTS OR SEPTIC TANKS MEET, OR WILL MEET, THE MINIMUM STATE STANDARDS;
(C) ELECTRICAL CONNECTIONS PROVIDED TO THE LOTS MEET, OR WILL MEET, THE MINIMUM STATE STANDARDS;
(D) THE CONNECTIONS, IF AVAILABLE, PROVIDED TO THE LOTS MEET, OR WILL MEET, THE MINIMUM STATE STANDARDS.

I ATTEST THAT THE INFORMATION ASSERTED IN THIS PLAT IS TRUE AND COMPLETE.


4/8/14
DATE

RICHARD A. GARZA
MEMBER OF G.R. INVERSIONES, LLC
3910 W. FREDDY GONZALEZ DR.
EDINBURG, TEXAS 78539.

STATE OF TEXAS
COUNTY OF HIDALGO

BEFORE ME, the undersigned authority, on this day personally appeared RICHARD A. GARZA, MEMBER OF G.R. INVERSIONES, LLC known to me to be the person whose name is subscribed to the foregoing instrument, and acknowledged to me that he executed the same for purposes and consideration therein stated.

Given under my hand and seal of office this 8th day of April, 2014.

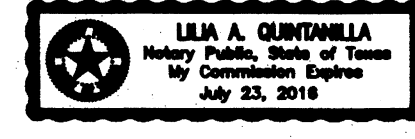 LILIA A. QUINTANILLA - NOTARY PUBLIC


HIDALGO COUNTY
CERTIFICATE OF PLAT APPROVAL
UNDER LOCAL GOVERNMENT CODE § 232.028(b)

WE, THE UNDERSIGNED, CERTIFY THAT THIS PLAT OF THE ARIA RANCHES SUBDIVISION, AS REVISED AND APPROVED BY THE HIDALGO COUNTY COMMISSIONERS COURT ON _____,


Hidalgo County Judge _____ Date _____
Hidalgo County Clerk _____ Date _____

PLANNING & ZONING
COMMISSION CERTIFICATION

I, the undersigned, Chairperson of the Planning and Zoning Commission of the City of Edinburg, hereby certify that this subdivision plat complies with the applicable zoning regulations of the City of Edinburg, Texas, and that the plat conforms to all requirements of the Subdivision Regulations of this City. 


 CHAIRPERSON-PLANNING & ZONING COMMISSION

I, the undersigned, Mayor of the City of Edinburg, hereby certify that this subdivision plat conforms to all requirements of the subdivision regulations of this city where the approval is required.

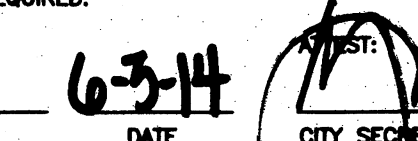 MAYOR'S SIGNATURE
6-3-14 DATE
6-3-14 CITY SECRETARY

THIS PLAT IS HEREBY APPROVED BY HIDALGO COUNTY IRRIGATION DISTRICT NO. 2 ON _____, THIS _____ DAY OF _____, 2014.

NO IMPROVEMENTS OF ANY KIND (INCLUDING WITHOUT LIMITATION, TREES, FENCES, AND BUILDINGS) SHALL BE PLACED UPON HIDALGO COUNTY IRRIGATION DISTRICT #2 RIGHTS OF WAYS OR EASEMENTS.

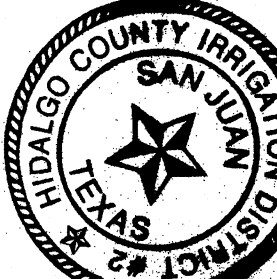

NOTE:
HIDALGO COUNTY DRAINAGE DISTRICT NO. 1 HEREBY CERTIFIES THAT THE DRAINAGE PLANS FOR THIS SUBDIVISION COMPLY WITH THE MINIMUM STANDARDS OF THE DISTRICT ADOPTED UNDER TEXAS LOCAL GOVERNMENT CODE 49.211(C). THE DISTRICT HAS NOT REVIEWED AND DOES NOT CERTIFY THAT THE DRAINAGE STRUCTURES DESCRIBED ARE APPROPRIATE FOR THE SPECIFIC SUBDIVISION, BASED ON GENERALLY ACCEPTED ENGINEERING CRITERIA. IT IS THE RESPONSIBILITY OF THE DEVELOPER OF THE SUBDIVISION AND ITS ENGINEER TO MAKE THESE DETERMINATIONS.


HIDALGO COUNTY DRAINAGE DISTRICT NO. 1


STATE OF TEXAS
COUNTY OF HIDALGO

I, the undersigned, a LICENSED PROFESSIONAL ENGINEER IN THE STATE OF TEXAS, DO HEREBY CERTIFY THAT THE PROPER ENGINEERING CONSIDERATIONS HAVE BEEN GIVEN TO THIS PLAT.

I CERTIFY THAT THE WATER AND SEWER SERVICE FACILITIES FOR LOTS INTENDED FOR RESIDENTIAL PURPOSES DESCRIBED ABOVE ARE IN COMPLIANCE WITH THE MODEL RULES ADOPTED UNDER SECTION 18.343, WATER CODE, THE ESTIMATED COSTS TO INSTALL UNCONSTRUCTED WATER AND SEWER FACILITIES DESCRIBED ABOVE ARE AS FOLLOWS: WATER FACILITIES: THESE WATER FACILITIES WERE CONSTRUCTED AT A COST OF \$ 86,280.00.
SEWER FACILITIES: ON SITE SEWER FACILITIES ARE ESTIMATED TO COST \$ 1,500.00 PER LOT (ALL INCLUSIVE), FOR A TOTAL OF \$ 55,500.00 FOR THE SUBDIVISION. THE SUBDIVIDER HAS PAID A TOTAL OF \$ 55,500.00 TO COVER THE COST OF INSTALLATION OF SEPTIC SYSTEMS.

DATE THIS THE 3RD DAY OF APRIL 2014

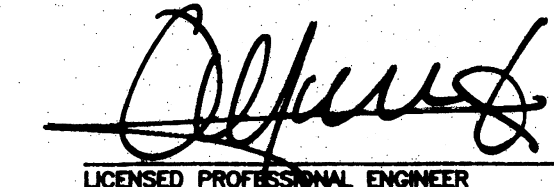
 LICENSED PROFESSIONAL ENGINEER
No. 95534 STATE OF TEXAS

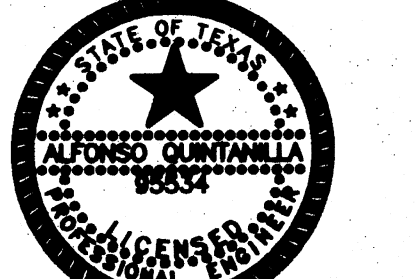

FILED FOR RECORD IN
HIDALGO COUNTY
ARTURO GUJARDO, JR.
HIDALGO COUNTY CLERK

ON _____ AT _____ AM/PM
INSTRUMENT NUMBER _____
OF THE MAP RECORDS OF HIDALGO COUNTY, TEXAS

BY: _____ DEPUTY

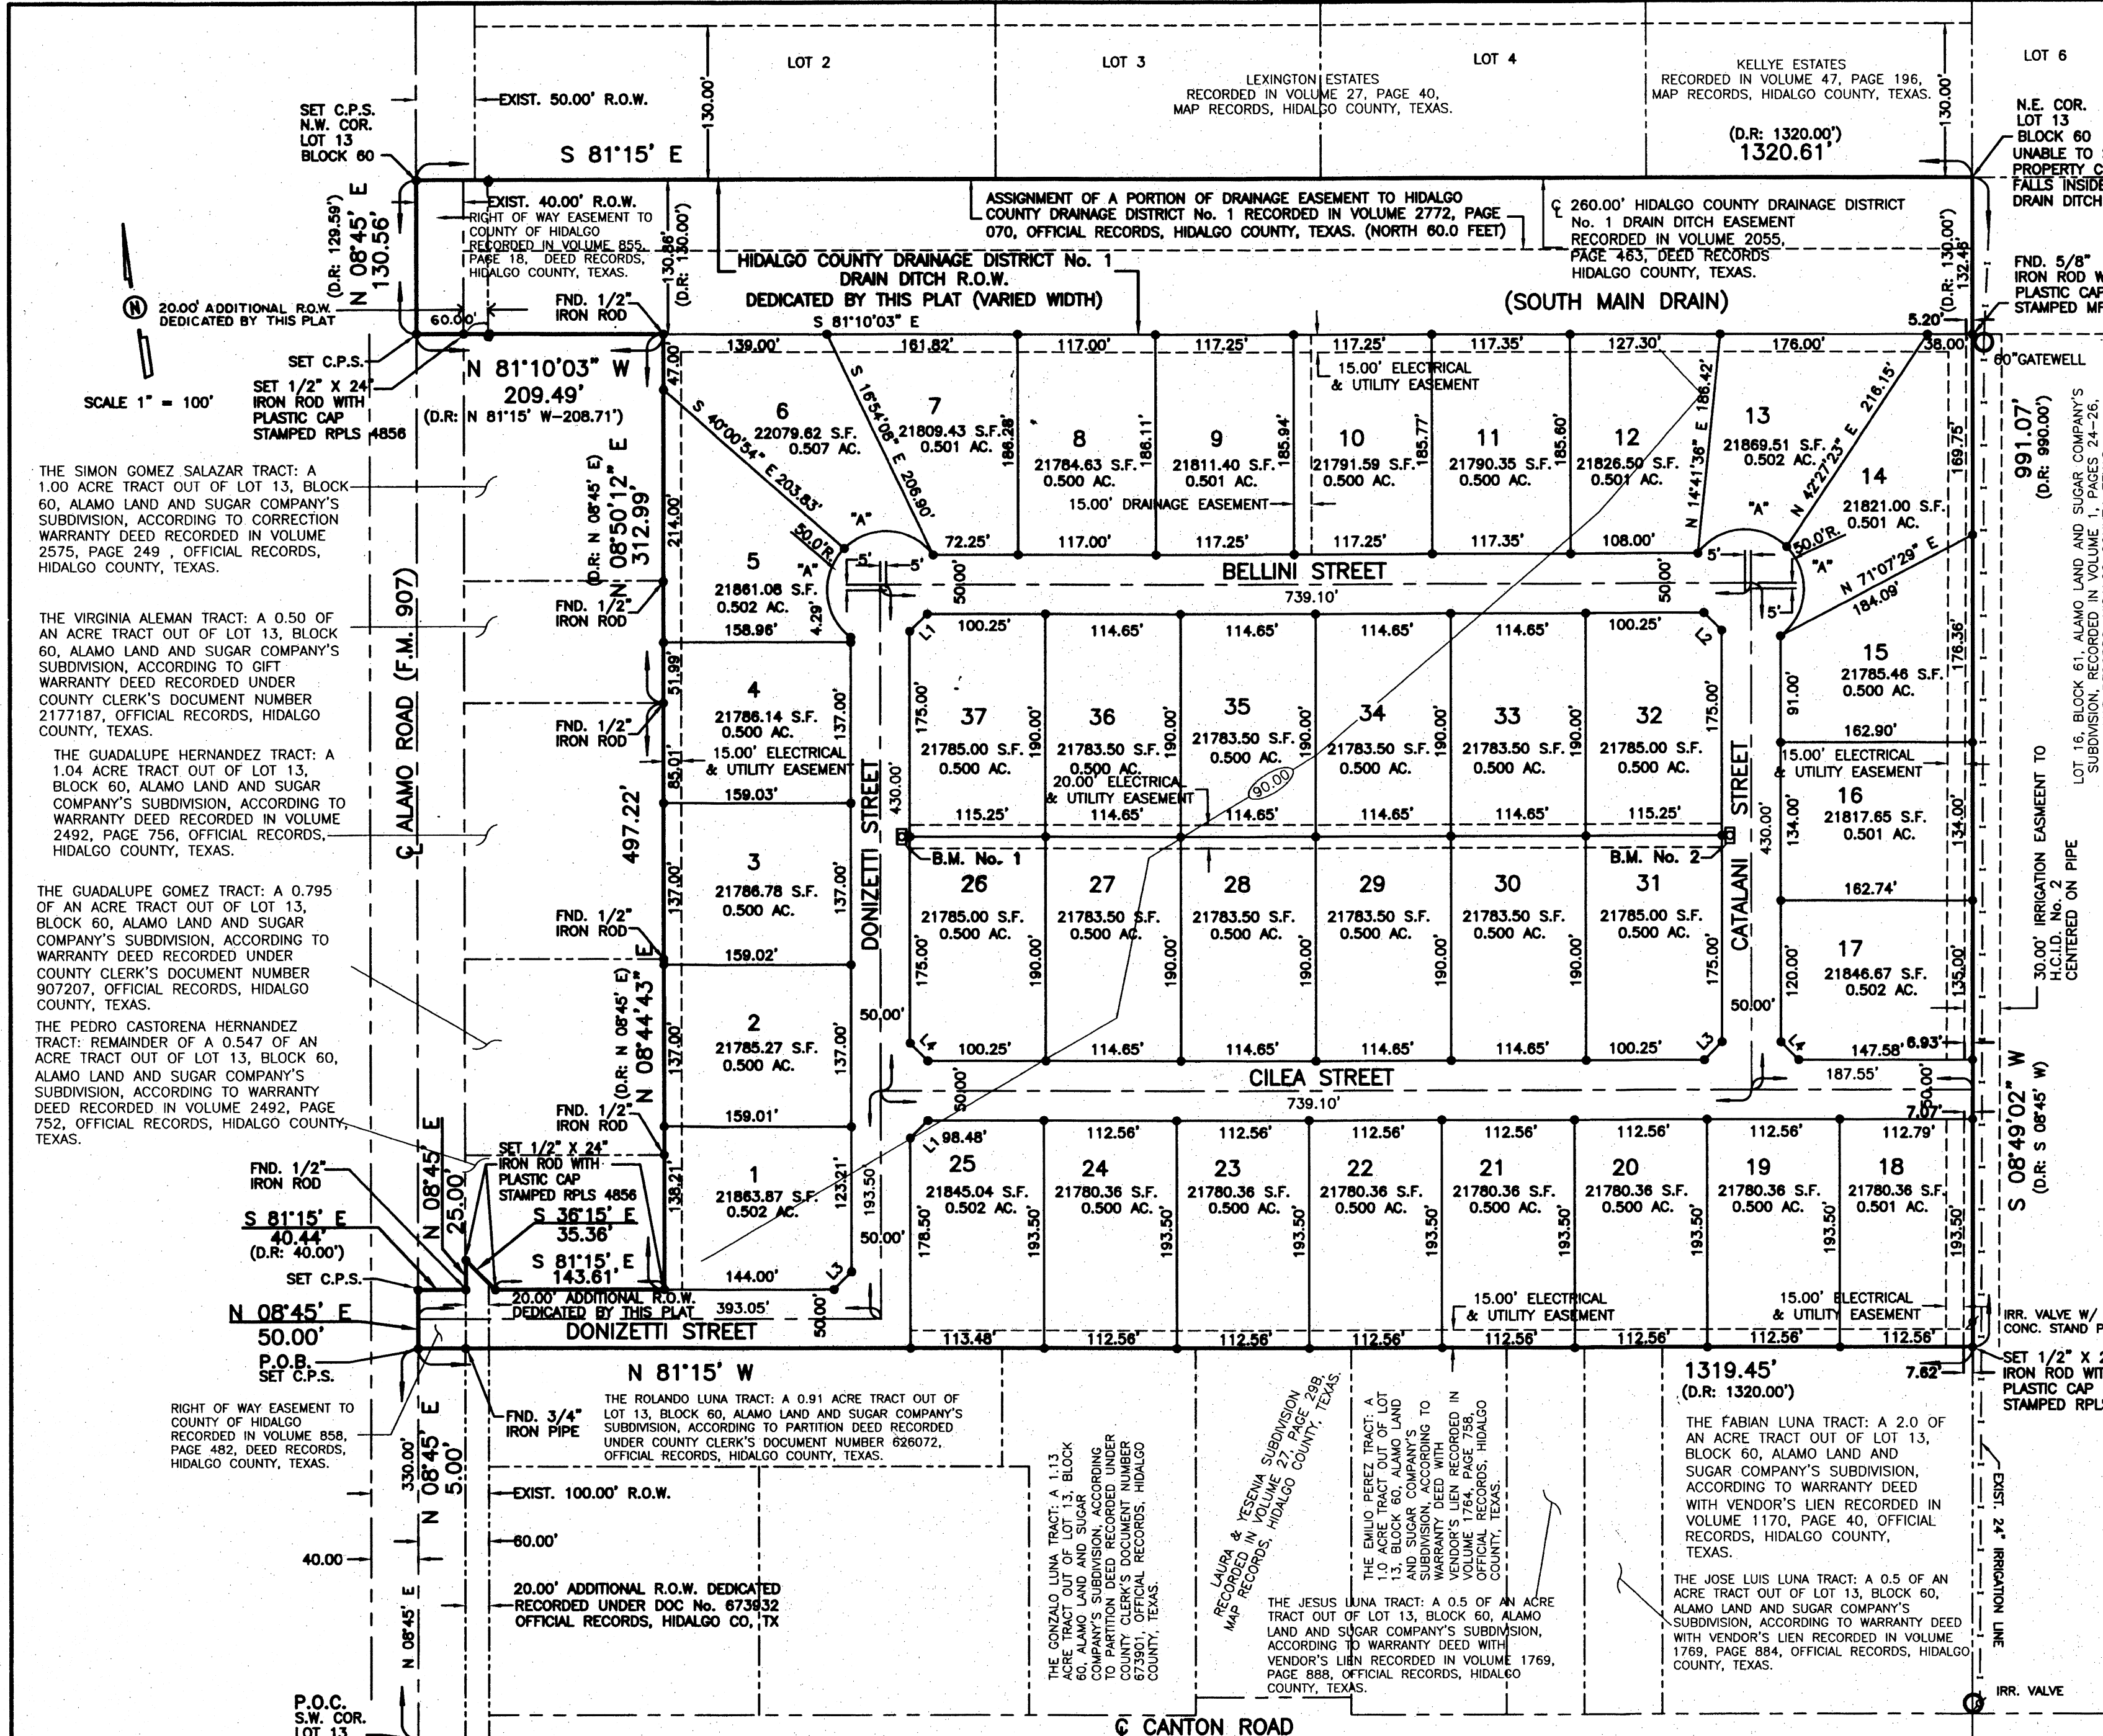

REVISION NOTES

No.	Sheet	Revision	Date	Approved

PLAT NOTES AND RESTRICTIONS:

- FLOOD ZONE LIMITS: ZONE "B" AREAS BETWEEN THE 100-YEAR FLOOD AND 500-YEAR FLOOD; OR CERTAIN AREAS SUBJECT TO 100-YEAR FLOODING WITH AVERAGE DEPTHS LESS THAN (1) FOOT OR WHERE THE CONTRIBUTING DRAINAGE AREA IS LESS THAN ONE SQUARE MILE; OR AREAS PROTECTED BY LEVEES FROM THE BASE FLOOD. (MEDIUM SHADING)
- COMMUNITY-PANEL NUMBER 480334 0425 C
EFFECTIVE DATE: NOVEMBER 16, 1982
CONSTRUCTION OF RESIDENTIAL HOUSING WITHIN ANY AREA OF THE SUBDIVISION THAT IS IN THE 100-YEAR FLOOD PLAN IS PROHIBITED UNLESS THE HOUSING QUALIFIES FOR INSURANCE UNDER THE NATIONAL FLOOD INSURANCE ACT OF 1968 (42 U.S.C. SECTIONS 4001 THROUGH 4127).
- MINIMUM BUILDING SETBACK LINES:
FRONT: 25.00 FEET
REAR: 15.00 FEET OR EASEMENT, WHICHEVER IS GREATER UNLESS OTHERWISE NOTED.
SIDE: 8.00 FEET OR EASEMENT, WHICHEVER IS GREATER CORNER: 10.00 FEET OR EASEMENT, WHICHEVER IS GREATER
- GENERAL NOTE FOR SINGLE FAMILY RESIDENCES:
NO MORE THAN ONE-SINGLE FAMILY DETACHED DWELLING SHALL BE LOCATED ON EACH LOT. THIS MUST BE STIPULATED ON ALL DEEDS AND CONTRACTS FOR DEEDS. NO COMMERCIAL USE SHALL BE ALLOWED. APPLICATIONS FOR CONSTRUCTION ARE REQUIRED PRIOR TO OCCUPANCY OF THE LOT.
- MINIMUM FINISH FLOOR NOTE:
MINIMUM FINISH FLOOR ELEVATION SHALL BE 18" ABOVE TOP OF CENTERLINE OF STREET OR 18" ABOVE NATURAL GROUND, WHICHEVER IS GREATER. ELEVATION CERTIFICATE MAY BE REQUIRED FOR LOTS LOCATED OUTSIDE A DESIGNATED FLOOD ZONE AT THE TIME FOR APPLICATION FOR CONSTRUCTION TO VERIFY PRE AND POST CONSTRUCTION FINISH FLOOR ELEVATIONS. AN ELEVATION CERTIFICATE SHALL BE REQUIRED FOR ALL LOTS WITHIN A DESIGNATED FLOOD ZONE AT THE TIME FOR A DEVELOPMENT PERMIT APPLICATION.
- BENCHMARK NOTE:
THE FOLLOWING BENCHMARK IS IDENTIFIED ON THE FACE OF THE PLAT AND ON THE ATTACHED ENGINEERING PLANS.
B.M. No. 1 ELEVATION= 89.33 TOP OF TYPE "A" INLET LOCATED NEAR THE SOUTHWEST CORNER OF LOT 37 OF THIS SUBDIVISION. NAVD 83 DATUM.
- DRAINAGE:
IN ACCORDANCE WITH THE HIDALGO COUNTY DRAINAGE DISTRICT NO. 1 AND HIDALGO COUNTY REGULATIONS, THIS DEVELOPMENT WILL BE REQUIRED TO DETAIN A TOTAL OF 45,659.38 CUBIC FEET (1.07 ACRE FEET) OF STORM WATER RUNOFF. DRAINAGE RETENTION IN ACCORDANCE WITH THE LOCAL REQUIREMENTS WILL BE ACCOMPLISHED AS FOLLOWS: SEE DRAINAGE REPORT ON SHEET NO.3.
- LEGEND - DENOTES 1/2" IRON ROD SET WITH PLASTIC CAP STAMPED RPLS 4856, UNLESS OTHERWISE NOTED.
- EACH PURCHASED CONTRACT MADE BETWEEN A SUBDIVIDER AND PURCHASER OF A LOT IN THIS SUBDIVISION SHALL CONTAIN A STATEMENT DESCRIBING HOW AND WHEN WATER, SEWER, ELECTRICITY AND GAS SERVICES WILL BE MADE AVAILABLE TO THE SUBDIVISION.
- ALL PUBLIC UTILITIES EASEMENTS DEDICATED BY THIS PLAT SHALL BE A MINIMUM WIDTH OF 15.00 FEET AS PER THE HIDALGO COUNTY MODEL SUBDIVISION RULES. BY SIGNING THIS PLAT DEVELOPER AND ENGINEER CERTIFY THAT ALL OTHER EASEMENTS SHOWN COMPLY WITH THE SIZE REQUIRED BY EACH UTILITY PROVIDER OCCUPYING AN EASEMENT.
- NO STRUCTURE SHALL BE PERMITTED OVER ANY EASEMENT.
EASEMENTS SHALL BE KEPT CLEAR OF FENCES, BUILDINGS, SHEDS, SHRUBS TREES, AND OTHER PLANTINGS (EXCEPT LOW GROWING MATURE TREES, GRASSES, OR FLOWERS) OR OBSTRUCTIONS THAT WOULD INTERFERE WITH THE OPERATIONS AND MAINTENANCE OF THE EASEMENT.

LOCATION OF SUBDIVISION WITH RESPECT TO THE EXTRATERRITORIAL JURISDICTION OF A MUNICIPALITY:
ARIA RANCHES SUBDIVISION, IS LOCATED IN MIDDLE OF HIDALGO COUNTY EAST SIDE OF ALAMO ROAD AND 330.0 FEET NORTH OF CANTON ROAD, THE ONLY NEARBY MUNICIPALITY IS THE CITY OF EDINBURG. ACCORDING TO THE OFFICIAL MAP IN THE OFFICE OF THE SECRETARY OF THE CITY OF EDINBURG (POPULATION 77,100), ARIA RANCHES SUBDIVISION, LIES APPROXIMATELY 1.25 MILES FROM THE CITY LIMITS AND IT IS WITHIN THE CITY'S THREE-MILE EXTRA-TERRITORIAL JURISDICTION (LOCATED UNDER LOCAL GOVERNMENT CODE § 42.221. IT LIES IN PCT. 4

PRINCIPAL CONTACTS:

Name	Address	City & Zip	Phone	Fax
OWNER: RICHARD A. GARZA MEMBER OF G.R. INVERSIONES, LLC	3910 W. FREDDY GONZALEZ DR. EDINBURG, TEXAS 78539	Edinburg, TX 78539	(956)383-6295	(956)381-9221
ENGINEER: ALFONSO QUINTANILLA	124 E. STUBBS EDINBURG, TEXAS 78539	Edinburg, TX 78539	(956)381-6480	(956)381-0527
SURVEYOR: ALFONSO QUINTANILLA	124 E. STUBBS EDINBURG, TEXAS 78539	Edinburg, TX 78539	(956)381-6480	(956)381-0527

QUINTANILLA, HEADLEY AND ASSOCIATES, INC.
CONSULTING ENGINEERS
LAND SURVEYORS
124 E. STUBBS ST.
EDINBURG, TEXAS 78539
ENGINEERING REGISTRATION NUMBER F-1513
SURVEYING REGISTRATION NUMBER 10411-00

LINE DATA TABLE

DATA	BEARING	LENGTH
L1	N 53°45' E	21.21'
L2	S 36°15' E	21.21'
L3	S 53°45' W	21.21'
L4	N 36°15' W	21.21'

CURVE DATA

CURVE	Δ	RADIUS	LENGTH
"A"	98°07'48"	50.00'	85.63'

RIGHT OF WAY EASEMENT

KNOW ALL MEN BY THESE PRESENTS, that the undersigned, owners of the property shown on this plat, their successors, assigns, and transferees (hereinafter called "Grantor" whether one or more persons are named), in consideration of and for one dollar (\$1.00) and other good and valuable consideration paid by North Alamo Water Supply Corporation, (hereinafter called "Grantee"), the receipt and sufficiency of which is hereby acknowledged, do hereby grant, bargain, sell, transfer, convey to and assign, with all appurtenances, an estate in fee simple, perpetual easement with the right to erect, construct, install and thereafter use, operate, impact, repair, maintain, alter, replace, relocate, discontinue, lines and appurtenances over and across the lands shown on this plat, together with the right of ingress and egress over Grantor's adjacent lands of the purpose for which the above mentioned rights are granted. The easement hereby granted shall not exceed 15' in width, and Grantee is hereby authorized to designate the course of the easement herein conveyed except that when the pipeline(s) is installed, the easement herein granted shall be limited to a strip of land 15' in width, the center line thereof being the pipeline installed.

In the event the easement herein granted subsists on a public road and the city, county or state hereafter widens or relocates the public road so as to require the relocation of the water line on installed, Grantor further grants to Grantee an additional easement over and across the land shown on this plat for the purpose of laterally relocate said water line so as to be necessary to clear the road improvements, which easement herein granted shall be limited to a strip of land 15' in width, the center line thereof being the pipeline as relocated.

The consideration recited herein shall constitute payment in full for all damages sustained by Grantor by reason of the installation, maintenance, repair, replacement and relocation of the structures referred to herein. This agreement together with any provisions of this grant shall constitute the entire agreement between the parties hereto and no oral agreement or understanding of any kind shall be binding on the parties hereto unless it is in writing and signed by both parties.

The easement conveyed herein was obtained or improved through Federal financial assistance. This easement is subject to the provisions of Title 46 of the Civil Rights Act of 1964 and the regulations issued pursuant thereto for so long as the easement continues to be used for the same or similar purpose for which financial assistance was extended for so long as the Grantee owns it, whichever is longer.

IN WITNESS WHEREOF the said Grantor executed this instrument this 2nd day of April, 2014.

RICHARD A. GARZA
MEMBER OF G.R. INVERSIONES, LLC
3910 W. FREDDY GONZALEZ DR.
EDINBURG, TEXAS 78539.

INDEX TO SHEETS

SHEET 1.- HEADING INDEX; LOCATION MAP AND ETL; PRINCIPAL CONTACTS; MAP; LOT, STREETS, AND EASEMENT LAYOUT; DESCRIPTION (METES AND BOUNDS); ENGINEER'S & SURVEYOR'S CERTIFICATION; PLAT NOTES AND RESTRICTIONS; OWNER'S ACKNOWLEDGMENT; HEALTH DEPT. CERTIFICATE; COUNTY CLERK'S RECORDING CERTIFICATE; H.C.D.D. No. 1 CERTIFICATION, HIDALGO COUNTY IRRIGATION DISTRICT No. 2 CERTIFICATION; COUNTY JUDGE APPROVAL; REVISION NOTES.

SHEET 2.- ENGINEERING REPORT, INCLUDING DESCRIPTION OF WATER AND WASTE WATER/OSSF AND ENGINEER'S CERTIFICATION (ENGLISH AND SPANISH VERSION), COUNTY CLERK'S RECORDING CERTIFICATE

SHEET 3.- DRAINAGE REPORT INCLUDING DESCRIPTION OF DRAINAGE SYSTEM, MAP OF TOPOGRAPHY AND DRAINAGE, AND ENGINEERING CERTIFICATION; REVISION NOTES; COUNTY CLERK'S RECORDING CERTIFICATE

**HIDALGO COUNTY
CERTIFICATE OF PLAT APPROVAL**

I, THE UNDERSIGNED, CERTIFY THAT THIS PLAT OF ARIA RANCHES SUBDIVISION WAS REVISED AND APPROVED BY THE HIDALGO COUNTY HEALTH DEPARTMENT ON _____

RICHARD A. GARZA
MEMBER OF G.R. INVERSIONES, LLC
3910 W. FREDDY GONZALEZ DR.
EDINBURG, TEXAS 78539.

ALFONSO QUINTANILLA
CONSULTING ENGINEERS
LAND SURVEYORS
124 E. STUBBS ST.
EDINBURG, TEXAS 78539
ENGINEERING REGISTRATION NUMBER F-1513
SURVEYING REGISTRATION NUMBER 10411-00

ALFONSO QUINTANILLA
CONSULTING ENGINEERS
LAND SURVEYORS
124 E. STUBBS ST.
EDINBURG, TEXAS 78539
ENGINEERING REGISTRATION NUMBER F-1513
SURVEYING REGISTRATION NUMBER 10411-00

SHEET NO. 1
DATE PREPARED: _____
DATE REVISION: _____

FILENAME: F:\DATA\SUBDIV\HIDALGO CO\ARIA RANCHES SUBDIVISION\PLAT
DATE PREPARED: _____
DATE REVISION: _____

FINAL ENGINEERING REPORT FOR ARIAS RANCHES SUBDIVISION

BY ALFONSO QUINTANILLA, P.E.
WATER SUPPLY: Description, Costs, and Operability date
 BY ALFONSO QUINTANILLA, P.E.

ARIAS RANCHES SUBDIVISION WILL BE PROVIDED WITH POTABLE WATER BY THE NORTH ALAMO WATER SUPPLY CORPORATION "N.A.W.S.C." THE SUBDIVIDER AND N.A.W.S.C. HAVE ENTERED INTO A CONTRACT IN WHICH N.A.W.S.C. HAS PROMISED TO PROVIDE SUFFICIENT WATER TO THE SUBDIVISION FOR AT LEAST 30 YEARS AND N.A.W.S.C. HAS PROVIDED DOCUMENTATION TO SUFFICIENTLY ESTABLISH THE LONG TERM QUANTITY AND QUALITY OF THE AVAILABLE WATER SUPPLIES TO THE FULL DEVELOPMENT OF THIS SUBDIVISION. N.A.W.S.C. HAS AN EXISTING 8" DIAMETER WATERLINE RUNNING ON THE EAST SIDE OF ALAMO ROAD.

THE WATER SYSTEM FOR ARIAS RANCHES SUBDIVISION CONSISTS OF AN 8" DIAMETER WATERLINE THAT TAPS INTO THE SAID EXISTING 8" WATERLINE. THE 8" DIAMETER WATERLINE RUNS EAST ALONG THE SOUTH SIDE OF DONIZETTI ROAD. THE 8" DIAMETER WATERLINE RUNS NORTH AND RUNS NORTH ALONG THE EAST SIDE OF DONIZETTI STREET.

ON THE SOUTHWEST CORNER OF LOT 26, AN 8" DIAMETER WATER LINE RUNS EAST ALONG THE NORTH SIDE OF CILEA STREET, ENDING WITH A 2" FLUSH VALVE NEAR THE SOUTHEAST CORNER OF LOT 17.

ON THE NORTHWEST CORNER OF LOT 37, ANOTHER 8" DIAMETER WATERLINE TURNS EAST AND RUNS ALONG THE SOUTH SIDE OF BELLINI STREET. ON THE NORTHEAST CORNER OF LOT 32, THE 8" DIAMETER WATERLINE TURNS SOUTH AND RUNS ALONG THE WEST SIDE OF CATALINA STREET, LOOPING WITH THE 8" WATERLINE ON CILEA STREET.

FROM THE 8" WATERLINES SEVENTEEN (17) 1" DUAL WATER SERVICES RUN TO PAIRS OF LOTS BEFORE SPLITTING INTO 3/4" DIAMETER SINGLE SERVICES AND FIVE (5) 3/4" SINGLE SERVICE WATER LINES GOING TO THE METER BOXES FOR EACH LOT.

THE 8" LINE, THE DUAL SERVICES AND 3/4" SINGLE SERVICES, AND THE METER BOXES WILL BE INSTALLED, AT A TOTAL COST OF \$ 86,280.00, OR \$ 2,311.89 PER LOT. IN ADDITION, THE SUBDIVIDER HAS PAID N.A.W.S.C. THE SUM OF \$ 14,700.00, WHICH COVERS THE \$ 378.38 COST PER LOT AS STATED IN THE 30 YEAR WATER SERVICE AGREEMENT WHICH SUM REPRESENTS THE TOTAL COST OF WATER METER, WATER RIGHTS ACQUISITION FEES, AND ALL MEMBERSHIP OR OTHER FEES ASSOCIATED WITH CONNECTING THE INDIVIDUAL LOTS IN THE SUBDIVISION TO N.A.W.S.C. UPON REQUEST BY THE LOT OWNER, THE SUBDIVIDER WILL INSTALL AT NO CHARGE THE WATER METER FOR THAT LOT. THE SUBDIVIDER HAS INSTALLED FOUR (4) FIRE HYDRANTS AT A UNIT COST OF \$ 3,100.00 FOR A TOTAL COST OF \$ 12,400.00. THE ENTIRE WATER FACILITIES HAVE BEEN APPROVED AND ACCEPTED BY N.A.W.S.C. AND SAID DISTRIBUTION SYSTEM IS OPERABLE AS OF THE DATE OF THE RECORDING OF THE PLAT.

SEWAGE FACILITIES: Description, Costs, and Operability Date

SEWAGE FROM ARIAS RANCHES SUBDIVISION, WILL BE TREATED BY INDIVIDUAL ON-SITE SEWAGE FACILITIES ("OSSF") CONSISTING OF A STANDARD DUAL COMPARTMENT SEPTIC TANK AND A DRAINFIELD ON EACH LOT. THE SITE EVALUATOR (LICENSE NUMBER OS 12258) HAS EVALUATED THE SUITABILITY OF THE SUBDIVISION SITE FOR OSSF AND SUBMITTED A REPORT CONCLUDING THAT THE SITE IS SUITABLE FOR OSSF. THE REPORT WAS REVIEWED AND APPROVED BY THE HIDALGO COUNTY HEALTH DEPARTMENT. HIGHLIGHTS OF THE REPORT ARE AS FOLLOWS AND THE DRAINAGE EASEMENTS.

EACH LOT IN THE PROPOSED SUBDIVISION IS AT LEAST 1/2 ACRE IN SIZE THE UNITED STATES OF AGRICULTURE SOIL CONSERVATION SERVICE SOIL SURVEY BOOK INDICATED A SANDY CLAY LOAM, THE SITE EVALUATOR (LICENSE NUMBER OS 12258) HAD FOUR (4) TEST BORINGS MADE AT OPPOSITE AREAS OF THE SUBDIVISION AT THE CENTERS OF LOTS 8, 12, 20 AND 25 (ADDITIONAL BORINGS WERE UNNECESSARY BECAUSE THE SOILS ARE VERY UNIFORM WITHIN THIS LIMITED AREA.) THE SOIL REPORT AS PREPARED BY THE SITE EVALUATOR (LICENSE NUMBER OS 12258) INDICATES A UNIFORM SANDY CLAY LOAM (WITH TEXTURE CLASS III) EXTENDING MORE THAN 24" BELOW THE BOTTOM OF ANY PROPOSED EXCAVATIONS. THE SUBDIVISION DRAINS WELL, THE 10-YEAR FLOODPLAIN BEING CONTAINED WITHIN THE STREET AND THE DRAINAGE EASEMENTS.

THE ESTIMATED COST TO INSTALL A SEPTIC SYSTEM ON AN INDIVIDUAL LOT IS \$ 1,500.00, INCLUDING THE COSTS FOR THE REQUIRED PERMIT AND LICENSE. NO OSSF HAVE BEEN INSTALLED AS OF THE TIME OF APPLICATION FOR FINAL PLAT APPROVAL.

WITH THE FILING OF THIS FINAL PLAT, THE SUBDIVIDER IS PROVIDING ADEQUATE FINANCIAL GUARANTEES OF PERFORMANCE IN THE FORM OF A PERSONAL CHECK REPRESENTING A "CASH IN HAND" IN THE AMOUNT OF \$ 55,500.00, WHICH IS THE ESTIMATED TOTAL COST TO INSTALL A SEPTIC TANK SYSTEM ON EACH LOT. THE SUBDIVIDER WILL INCLUDE THE COST OF A SEPTIC TANK SYSTEM IN THE SALE PRICE OF THE LOT.

AT ANY TIME AFTER THE LOT IS SOLD, THE PURCHASER MAY INITIATE INSTALLATION OF A SEPTIC SYSTEM BY WRITING OR CALLING THE SUBDIVIDER AND THEN FILING WITH THE HIDALGO COUNTY HEALTH DEPARTMENT AN APPLICATION FOR A PERMIT TO CONSTRUCT A SEPTIC SYSTEM. SEPTIC TANK SYSTEMS SHALL BE INSTALLED ON THE LOT PRIOR TO THE COUNTY ISSUING A FINAL LIGHT AND WATER CLEARANCE.


CERTIFICATION:

BY MY SIGNATURE BELOW, I CERTIFY THAT THE WATER AND SEWAGE SERVICE FACILITIES DESCRIBED ABOVE ARE IN COMPLIANCE WITH THE MODEL RULES ADOPTED UNDER TEXAS WATER CODE, TITLE 16, CHAPTER 16.343, WATER CODE. I CERTIFY THAT THE ESTIMATED COSTS TO INSTALL UNCONSTRUCTED WATER AND ON-SITE SEWAGE FACILITIES, DISCUSSED ABOVE, ARE AS FOLLOWS:

WATER FACILITIES - THESE FACILITIES HAVE BEEN FULLY CONSTRUCTED, WITH THE INSTALLATION OF WATER METERS, WILL COST A GRAND TOTAL OF \$ 100,980.00 WHICH EQUALS TO \$ 2,729.19 PER LOT.

SEWAGE FACILITIES - SEPTIC SYSTEM IS ESTIMATED TO COST \$ 1,500.00 PER LOT (ALL INCLUSIVE), FOR A TOTAL OF \$ 5,500.00 FOR THE ENTIRE SUBDIVISION.

ALFONSO QUINTANILLA, P.E. No. 95534
 DATE 6-6-14

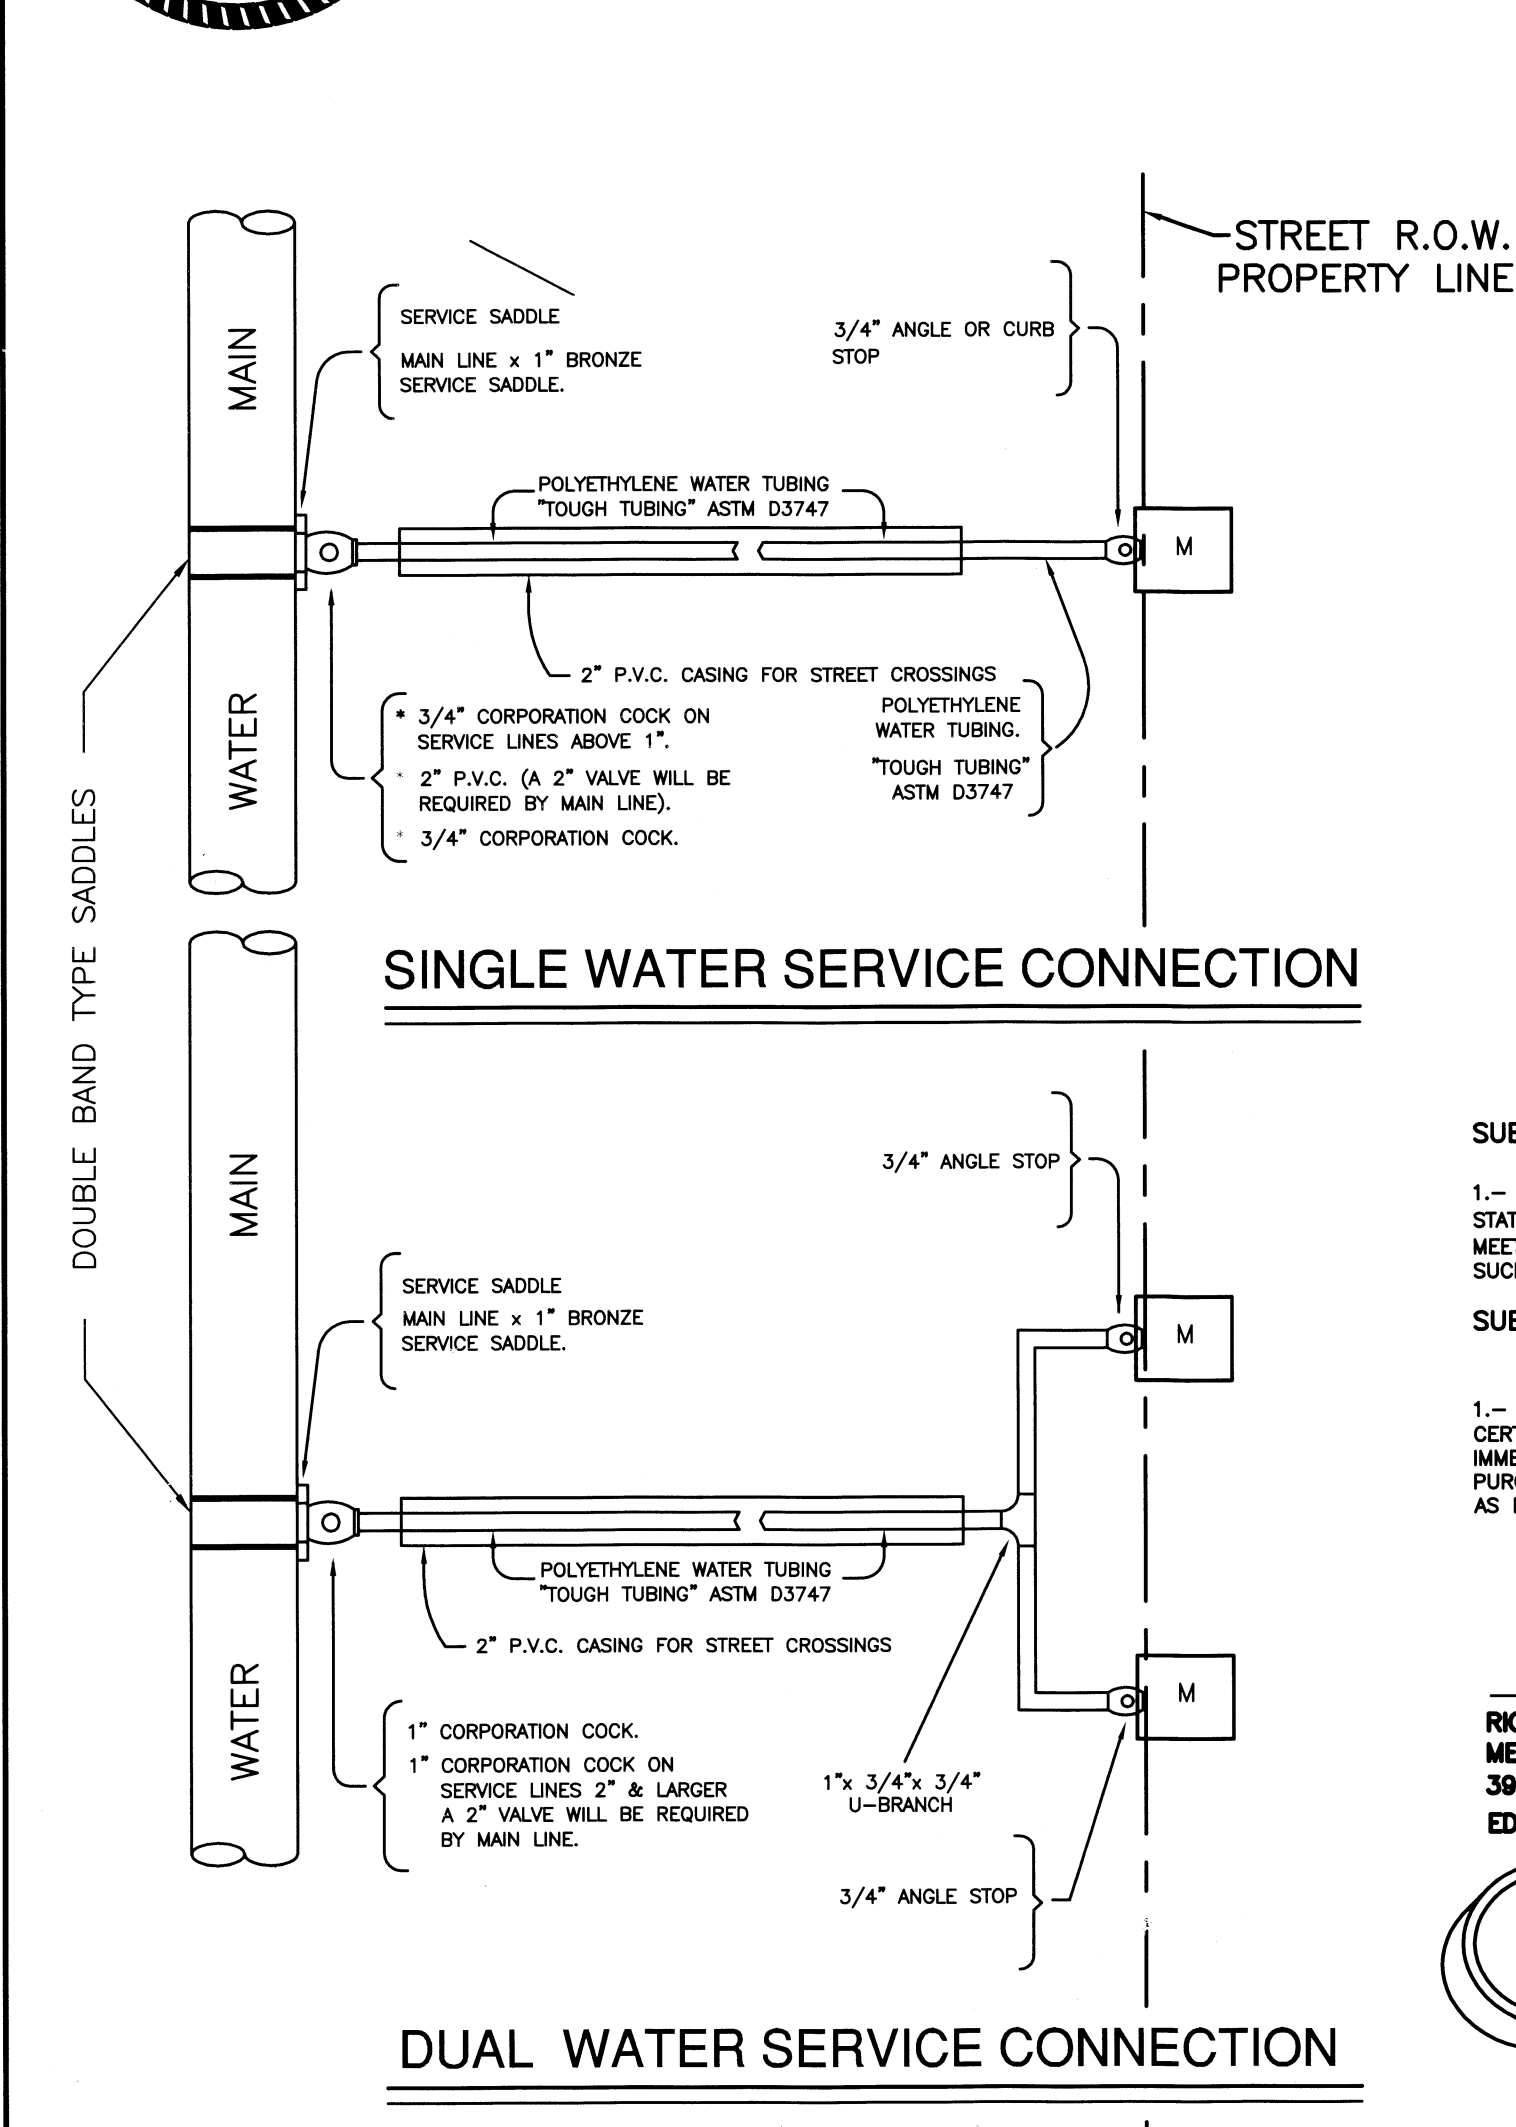

SUBDIVIDER CERTIFICATION
 1. - BY COMPLETING THE IMPROVEMENTS DESCRIBED ON THE PLAT, SUBDIVIDER WILL COMPLY WITH MINIMUM STATE STANDARDS AND THAT (a) WATER QUALITY AND CONNECTIONS INCLUDING WATER METERS TO THE LOTS MEET SUCH STANDARDS AND (b) SEWER CONNECTIONS TO THE LOTS OR SEPTIC TANKS MEET OR WILL MEET SUCH STANDARDS AND WILL BE CONSTRUCTED IN ACCORDANCE WITH STATE AND COUNTY REGULATIONS.

SUBDIVIDER STATEMENT:
 1. - (WE), **RICHARD A. GARZA MEMBER OF G.R. INVERSIONES, LLC** SUBDIVIDERS OF ARIAS RANCHES SUBDIVISION HEREBY CERTIFY ARE REQUIRED PRIOR TO BUILDING ON ANY LOT AND THAT AN ADEQUATE DRINKING WATER SOURCE IS IMMEDIATELY AVAILABLE TO EACH LOT OF THE TYPE, QUALITY & QUANTITY TO ENABLE EACH PERSON PURCHASING A LOT HAVE ADEQUATE WATER TO COMPLY WITH THE REGULATIONS AND THE LAWS OF THE STATE AS REQUIRED BY STATE AND COUNTY REGULATIONS.

RICHARD A. GARZA
 MEMBER OF G.R. INVERSIONES, LLC
 3910 W. FREDDY GONZALEZ DR.
 EDINBURG, TEXAS. 78539.

6-6-14
 DATE

STATE OF TEXAS
 COUNTY OF HIDALGO
 BEFORE ME, the undersigned notary public, on this day personally appeared
RICHARD A. GARZA, OWNER OF G.R. INVERSIONES, LLC
 Safety Driver License to be the person whose name is subscribed to the foregoing instrument, who, being by me first duly sworn, declared that the statements therein are true and correct
 Given under my hand and seal of office this 6th day of June, 2014.

NEYDA S. RAMIREZ
 Notary Public, State of Texas
 My Commission Expires March 17, 2017

NEYDA S. RAMIREZ - NOTARY PUBLIC


6-6-14
 DATE

QUINTANILLA, HEADLEY AND ASSOCIATES, INC.
 CONSULTING ENGINEERS • LAND SURVEYORS
 124 E. STUBBS ST, EDINBURG, TEXAS 78539
 ENGINEERING REGISTRATION NUMBER F-1315
 SURVEYING REGISTRATION NUMBER 100411-00

COST ESTIMATE

WATER DISTRIBUTION:	\$ 86,280.00
PAVING IMPROVEMENTS:	\$ 266,892.50
DRAINAGE IMPROVEMENTS:	\$ 94,282.50
SEPTIC TANK (OSSF):	\$ 55,500.00

MAP OF WATER DISTRIBUTION SYSTEM/ MAPA DE DISTRIBUCION DE AGUA

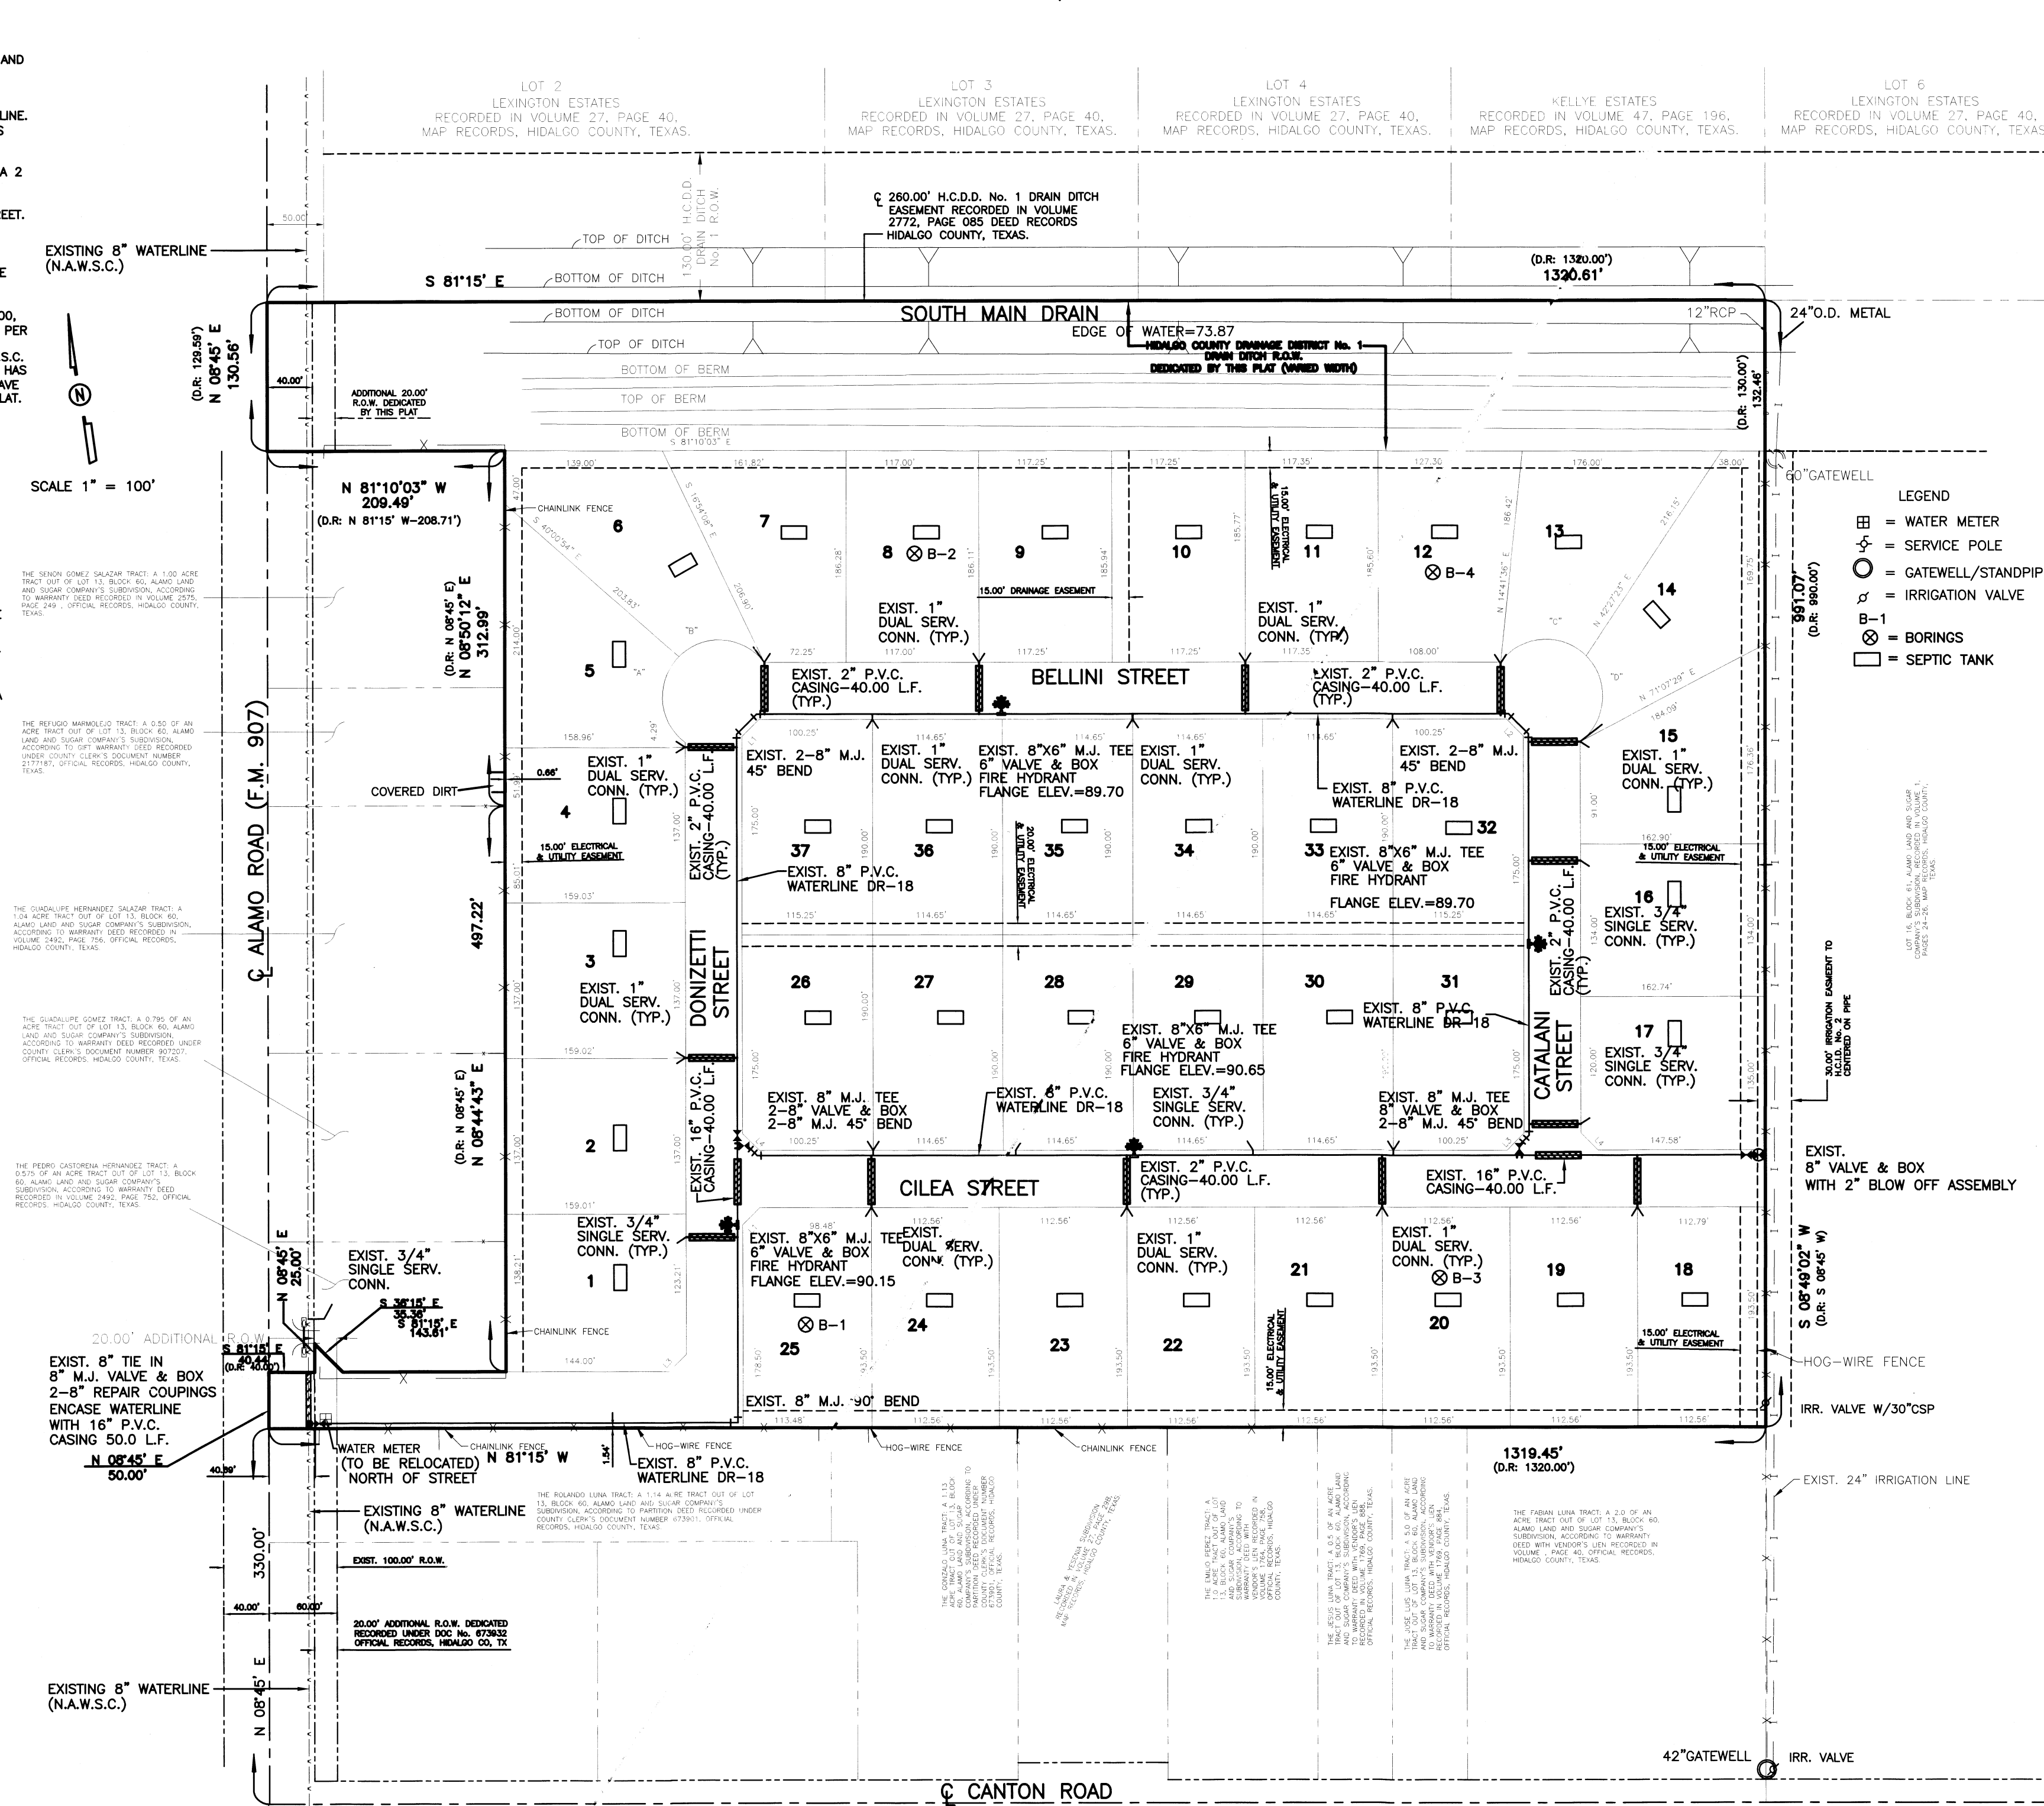

ARIA RANCHES SUBDIVISION

A 26.15 ACRE TRACT OF LAND OUT OF LOT 13, BLOCK 60, ALAMO LAND AND SUGAR COMPANY'S SUBDIVISION, HIDALGO COUNTY, TEXAS, ACCORDING TO THE MAP OR PLAT THEREOF RECORDED IN VOLUME 1, PAGES 24-26, MAP RECORDS, HIDALGO COUNTY, TEXAS, AND ACCORDING TO WARRANTY DEED WITH VENDOR'S LIEN RECORDED UNDER DOCUMENT NUMBER 2465402 AND WARRANTY DEED RECORDED UNDER DOCUMENT NUMBER 2465882, OFFICIAL RECORDS, HIDALGO COUNTY, TEXAS.

REPORTE FINAL DE INGENIERIA PARA LA SUBDIVISION DE ARIAS RANCHES SUBDIVISION :
 BY ALFONSO QUINTANILLA, P.E.

PROVISION DE AGUA: Descripción, Gastos, y Fecha de Inicio
 LA SUBDIVISION ARIAS RANCHES SUBDIVISION, RECIBIRA SU PROVISION DE AGUA DE NORTH ALAMO WATER SUPPLY CORPORATION (LA COMPANIA DE AGUA DE NORTH ALAMO) ("N.A.W.S.C."). EL DUERO DE LA SUBDIVISION Y LA COMARIA N.A.W.S.C. HAN FIRMADO UN CONTRATO POR EL CUAL LA SUBDIVISION RECIBIRA SU PROVISION DE AGUA POR LOS PROXIMOS 30 AÑOS. N.A.W.S.C. TENDRA QUE REPRESENTAR DOCUMENTACION PARA DEMOSTRAR A LARGO PLAZO LA CANTIDAD Y CALIDAD DE AGUA ACCESIBLE PARA SERVIR EL FUTURO DESARROLLO DE LA SUBDIVISION. N.A.W.S.C. TIENE UNA LINEA EXISTENTE DE 8" PULGADAS DE DIAMETRO QUE CORRE POR EL LADO ESTE DE LA CALLE ALAMO ROAD.

EL SISTEMA DE PROVISION DE AGUA PARA ARIAS RANCHES SUBDIVISION CONSISTE DE UNA LINEA DE AGUA DE 8" PULGADAS DE DIAMETRO QUE CONECTA CON LA LINEA EXISTENTE DE AGUA DE 8" DE DIAMETRO QUE CORRE POR LA ALAMO ROAD. LA LINEA DE AGUA DE 8" DE DIAMETRO CORRE ESTE POR EL LADO SUR DE LA CALLE DONIZETTI STREET. LA LINEA DE AGUA DE 8" DE DIAMETRO VOLTEA NORTE Y CORRE POR EL LADO ESTE DE DONIZETTI STREET.

EN LA ESQUINA NOROCCIDENTE DE LOT 26, UNA LINEA DE AGUA DE 8" DE DIAMETRO CORRE ESTE POR EL LADO NORTE DE LA CALLE CILEA STREET, TERMINANDO CON UNA VALVULA DE 2" EN LA ESQUINA SUDOCIDENTE DE LOTE 17.

EN LA ESQUINA SURESTE DE LOTE 37, OTRA LINEA DE AGUA DE 8" DE DIAMETRO CORRE ESTE POR EL LADO SUR DE LA CALLE BELLINI STREET. EN LA ESQUINA NOROCCIDENTE DE LOTE 32, LA LINEA DE AGUA DE 8" DE DIAMETRO VOLTEA SUR Y CORRE POR EL LADO OESTE DE LA CALLE CATALINA STREET, CONECTANDO CON LA LINEA DE AGUA LOCALIZADA EN CILEA STREET.

DE LAS LINEAS EXISTENTES 8" PULGADAS Y PROPUESTA DE 8" PULGADAS DE DIAMETRO DIOS Y SIETE (17) CONDUCTOS DOBLES DE 1 PULGADA DE DIAMETRO Y TRES (3) LINEAS DE 3/4 DE PULGADA QUE CORREN HACIA LOS MEDIDORES DE AGUA DE LOS LOTES.

LA LINEA PROPUESTA DE 8 PULGADAS, LOS SERVICIOS DOBLES DE 1 PULGADA Y LOS SERVICIOS SIMPLES HAN SIDO INSTALADOS A UN COSTO TOTAL DE US\$ 86,280.00 O US\$ 2,311.89 POR LOTE. EL DUERO DE LA SUBDIVISION HA TAMBIEN PAGADO US\$ 14,700.00 O US\$ 378.38 POR LOTE A N.A.W.S.C. . EL COSTO DE LA INSTALACION DE CADA MEDIDOR Y LOS GASTOS DE CONEXION CUANDO EL DUERO DE CADA LOTE SOLICITE UN MEDIDOR DE AGUA, LA COMPANIA N.A.W.S.C. LO INSTALARA SIN GASTO AL DUERO. EL DUERO DE LA SUBDIVISION TAMBIEN HA INSTALADO CUATRO (4) BOCAS DE RIEGO (FIRE HYDRANT) A UN COSTO DE US\$ 3,100.00 POR CADA UNA CUAL GASTA UNA CANTIDAD TOTAL US\$ 12,400.00. EL SISTEMA DE AGUA ESTARA EN FUNCIONAMIENTO COMPLETO ANTES O EN LA FECHA, EN LA CUAL LA SUBDIVISION SEA REGISTRADA EN EL CONDADO DE HIDALGO.

DRENAJE: Descripción, Gastos y Fecha de Inicio
 EL DRENAJE DE ARIAS RANCHES SUBDIVISION, TENDRA FOSAS SEPTICAS INDIVIDUALES (OSSF) CONSISTIENDO EN UN DISEÑO NORMAL, CON DOBLE COMPARTIMIENTO DE FOSA SEPTICA (OSSF) Y UN CAMPO DE DRENAJE EN CADA SOLAR. EL EVALUADOR (LIC# OS 12258) DE ENSUCHE HA INSPECCIONADO, EVALUADO Y REPORTADO QUE LA UBICACION DE LA SUBDIVISION ES CONVENIENTE PARA FOSAS SEPTICAS (OSSF). EL REPORTE FUE EXAMINADO Y APROBADO POR EL DEPARTAMENTO DE SALUD DEL CONDADO DE HIDALGO.

CADA SOLAR EN LA SUBDIVISION MIDE MEDIO ACRE DE TAMAÑO. EL LIBRO DE SERVICIOS Y CONSERVACION DEL SUELO DEL DEPARTAMENTO DE AGRICULTURA DE LOS ESTADOS UNIDOS (USDA) INDICA UNA MEZCLA DE BARRO ARENOSO. EL EVALUADOR (LIC# OS 12258) HIZO CUATRO (4) PRUEBAS CON AGUJEROS EN EL CENTRO DE LOS LOTES 8, 12, 20 Y 25 (PRUEBAS ADICIONALES NO FUERON NECESARIAS PORQUE EL SUELO ES MUY UNIFORME DENTRO DEL AREA DELIMITADA). EL SUELO ES UNIFORME, DE BARRO ARENOSO (CON TEXTURA CLASE III) EXTENDIDO A MAS DE 24 PULGADAS BAJO EL FONDO DE CUALQUIER EXCAVACION POR EL EVALUADOR (LIC# OS 12258). NO HAY PRESENCIA DE AGUA SUBTERRANEA BAJO LA CAPA DE 24 PULGADAS DE FONDO DE LAS EXCAVACIONES.

EL COSTO ESTIMADO PARA LA INSTALACION DE UN SISTEMA INDIVIDUAL DE FOSAS SEPTICAS POR SOLAR SON US\$ 1,500.00, INCLUYENDO EL COSTO DEL PERMISO REQUERIDO Y LICENCIA. EN ESTOS MOMENTOS NINGUNA FOSA SEPTICA HA SIDO INSTALADA EN EL PROCESO DE LA APROBACION FINAL.

CON EL ARCHIVAMIENTO DEL PLAN FINAL, EL DUERO DE LA SUBDIVISION PROPORCIONARA UNA GARANTIA FINANCIERA ADECUADA CON DESAMPARO EN FORMA DE UN CHEQUE PERSONAL REPRESENTANDO UN "DEPOSITO EN EFECTIVO" OBTENIDO POR EL CONDADO DE HIDALGO EN LA CANTIDAD DE US\$ 55,500.00, QUE ES EL COSTO TOTAL ESTIMADO PARA INSTALAR UN SISTEMA DE FOSAS SEPTICAS EN CADA TERRENO. EL DUERO DE LA SUBDIVISION INCLUIRA EL COSTO DE UN SISTEMA DE FOSAS SEPTICAS EN EL PRECIO DE VENTA DEL TERRENO.


EN CUALQUIER MOMENTO DESPUES DE QUE EL TERRENO SEA VENDIDO, EL COMPRADOR PUEDE INICIAR LA INSTALACION DE UN SISTEMA SEPTICO ESCRIBIENDO O LLAMANDO AL DUERO DE LA SUBDIVISION Y ENTONCES ARCHIVANDO EN EL DEPARTAMENTO DE SALUD DEL CONDADO DE HIDALGO UNA APLICACION PARA UN PERMISO DE CONSTRUIR PARA UN SISTEMA SEPTICA. LAS FOSAS SEPTICAS DEBEN DE ESTAR INSTALADAS ANTES QUE EL CONDADO DE HIDALGO PUEDA APROBAR LA AUTORIZACION DE LUZ Y AGUA.

CERTIFICACION
 CON MI FIRMA, CERTIFICO QUE LOS SERVICIOS Y SISTEMAS DE AGUA Y DE DRENAJE, DESCRITOS EN ESTE DOCUMENTO, CUMPLEN CON LAS MODEL SUBDIVISION RULES (LAS REGLAS GOBERNANDO A LAS SUBDIVISIONES), ADOPTADAS EN LA SECCION 16.343 DEL TEXAS WATER CODE (CODIGO DE AGUA DE TEXAS). CERTIFICO QUE LOS GASTOS PARA INSTALAR LOS SISTEMAS DE AGUA Y DE DRENAJE SON:

AGUA: EL SISTEMA/SERVICIO DE AGUA ESTA TOTALMENTE CONSTRUIDO, CON LA INSTALACION DE LOS MEDIDORES DE AGUA. EL GRAN COSTO TOTAL ES DE US\$ 100,980.00 LO CUAL EQUIVALE A US\$ 2,729.19 POR LOTE.

DRENAJE: SE ESTIMA QUE LA FOSAS SEPTICAS COSTARAN US\$ 1,500.00 A UN COSTO TOTAL DE US\$ 55,500.00 PARA TODA LA SUBDIVISION.

ALFONSO QUINTANILLA, P.E. No. 95534
 DATE 6-6-14

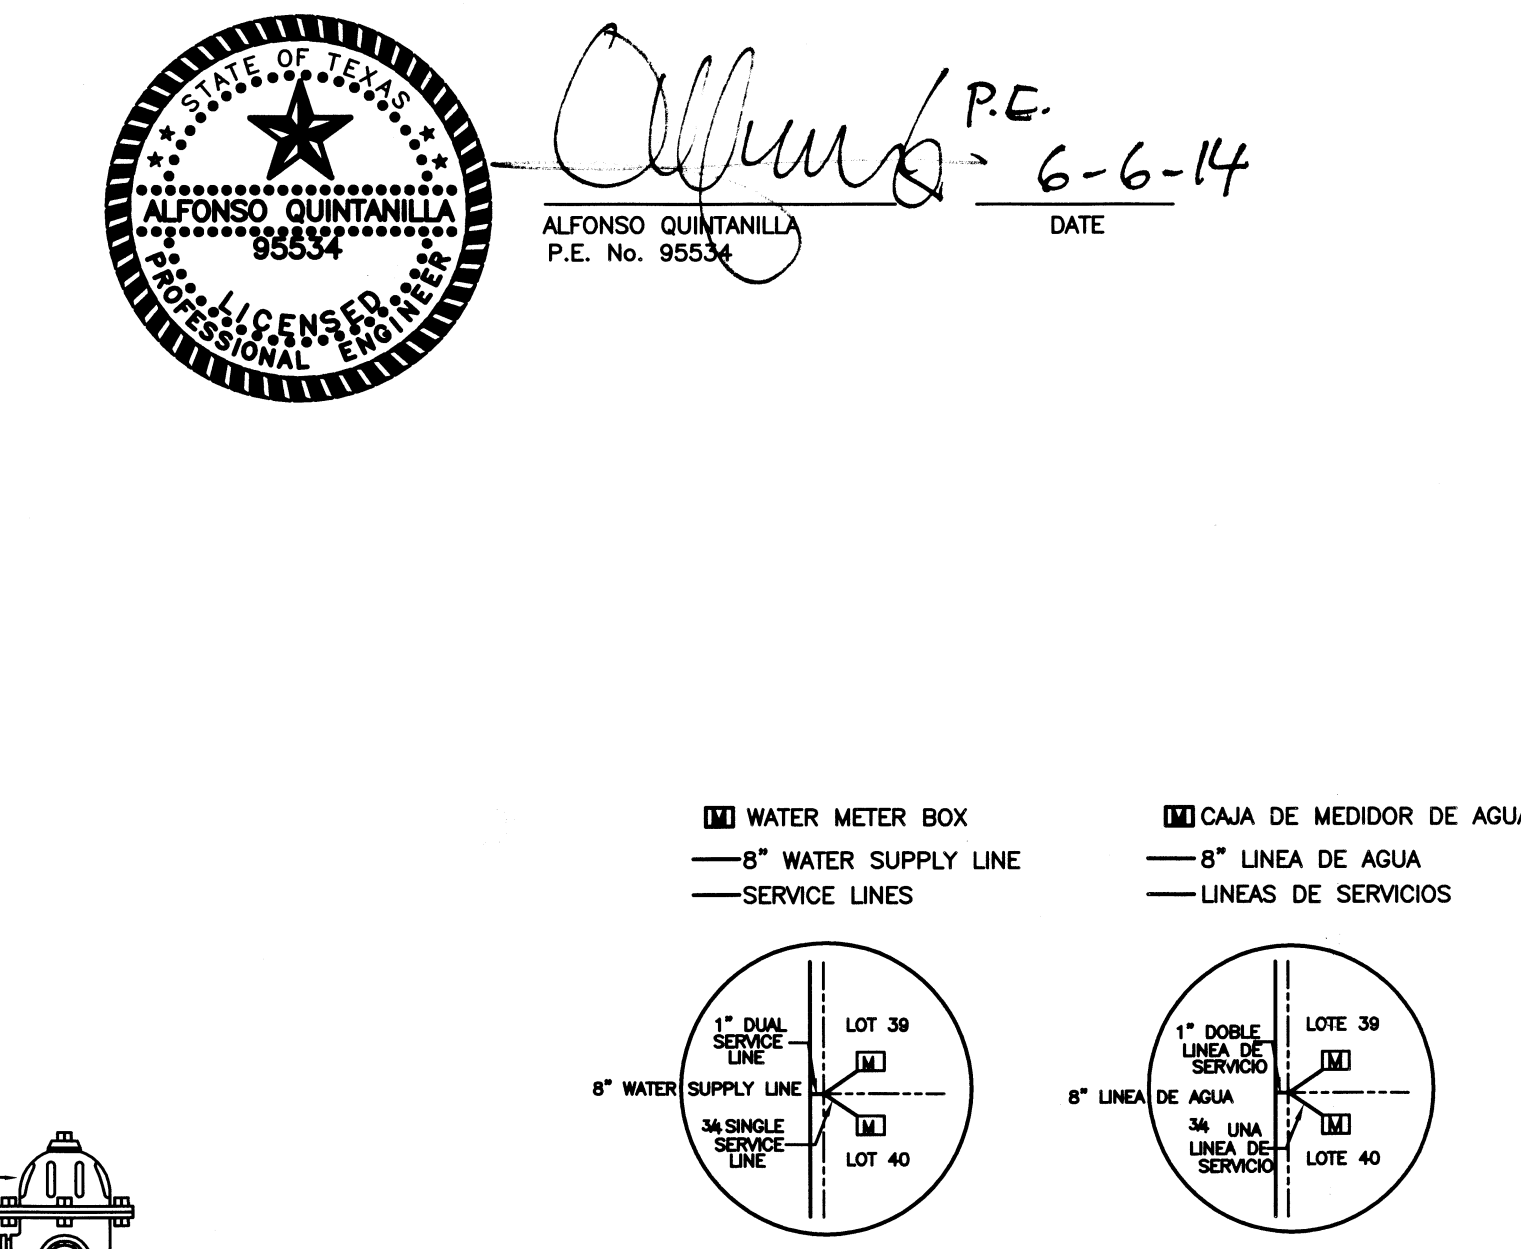

FILED FOR RECORD IN
 HIDALGO COUNTY
 ARTURO GUJARDO, JR.
 HIDALGO COUNTY CLERK

ON: _____ AT _____ AM/PM
 INSTRUMENT NUMBER _____
 OF THE MAP RECORDS OF HIDALGO COUNTY, TEXAS
 BY: _____ DEPUTY






SHEET NO. 2
 OF 3 SHEETS

FILENAME:	F:\DATA\SUBDIVISION\EDINBURG\ARIAS RANCHES SUBDIVISION\B-PLAT
DATE PREPARED:	PREPARED BY
CHECKED BY:	CHECKED BY
APPROVED BY:	APPROVED BY

MAP OF TOPOGRAPHY AND DRAINAGE / MAPA DE TOPOGRAFIA Y DRENAJE

ARIA RANCHES SUBDIVISION

A 26.15 ACRE TRACT OF LAND OUT OF LOT 13, BLOCK 60, ALAMO LAND AND SUGAR COMPANY'S SUBDIVISION, HIDALGO COUNTY, TEXAS, ACCORDING TO THE MAP OR PLAT THEREOF RECORDED IN VOLUME 1, PAGES 24-26, MAP RECORDS, HIDALGO COUNTY, TEXAS, AND ACCORDING TO WARRANTY DEED WITH VENDOR'S LIEN RECORDED UNDER DOCUMENT NUMBER 2465042 AND WARRANTY DEED RECORDED UNDER DOCUMENT NUMBER 2456982, OFFICIAL RECORDS, HIDALGO COUNTY, TEXAS.

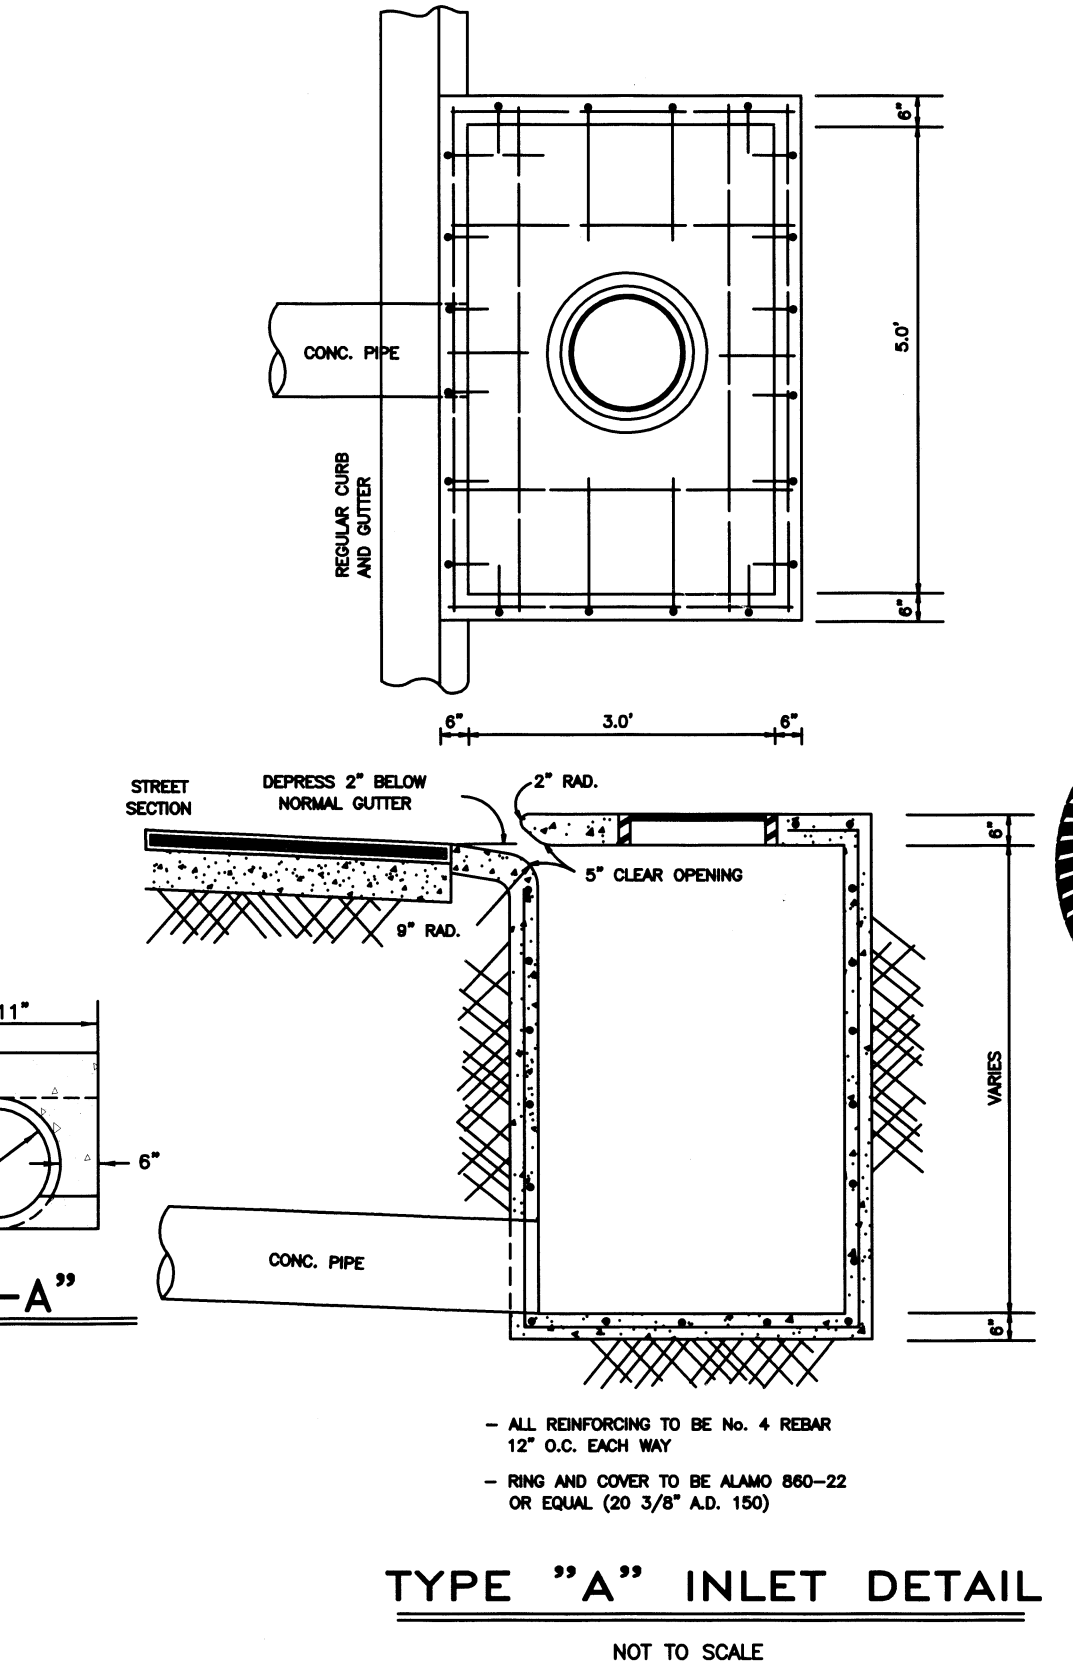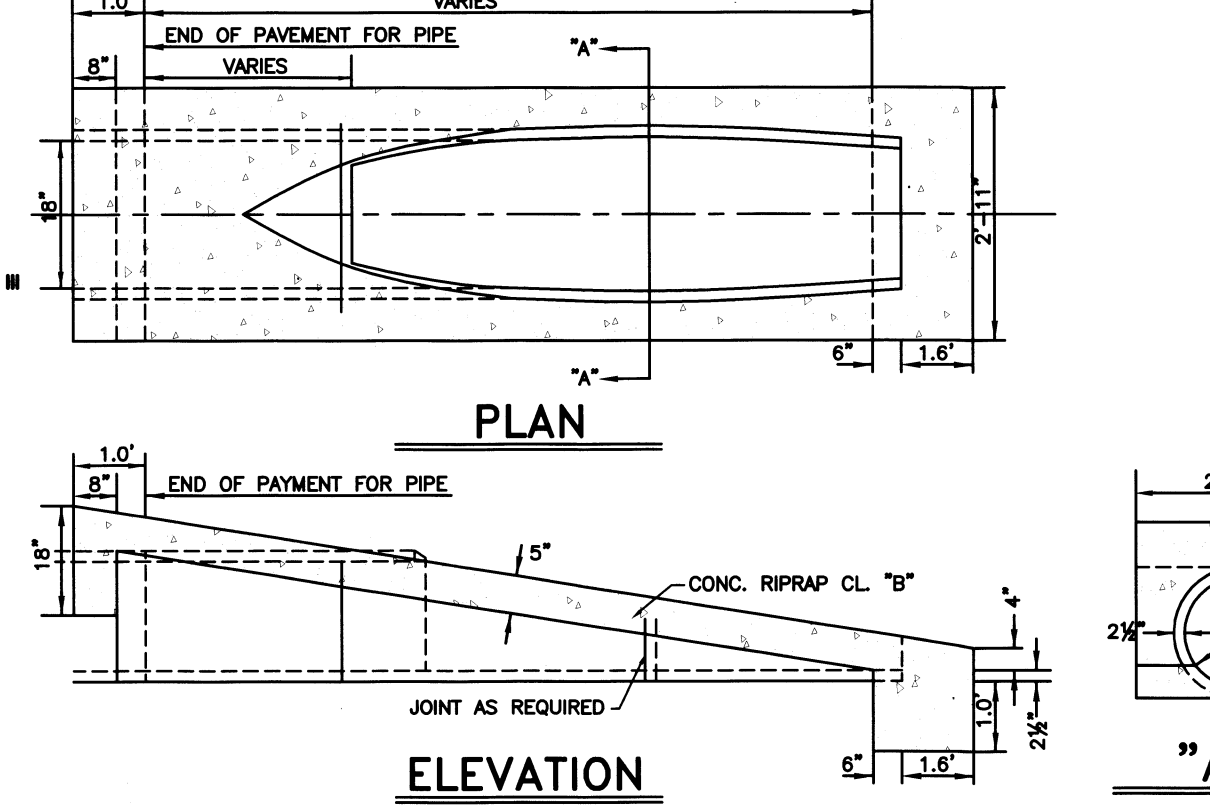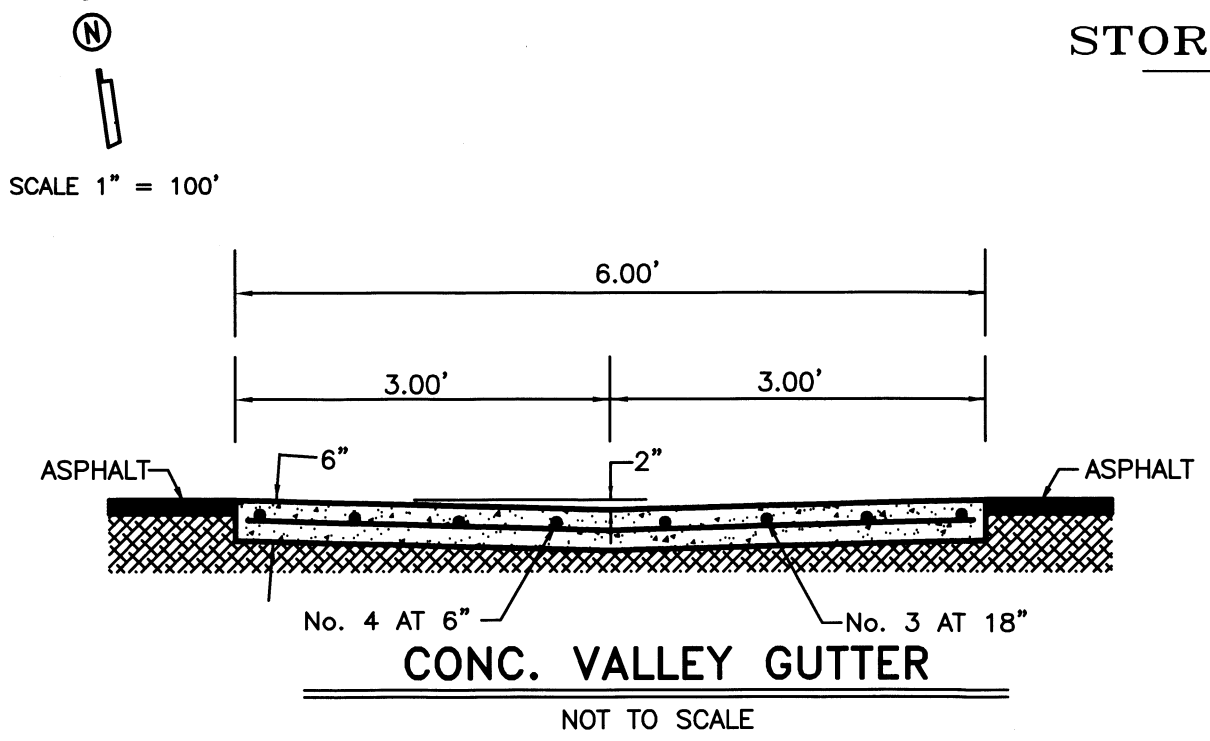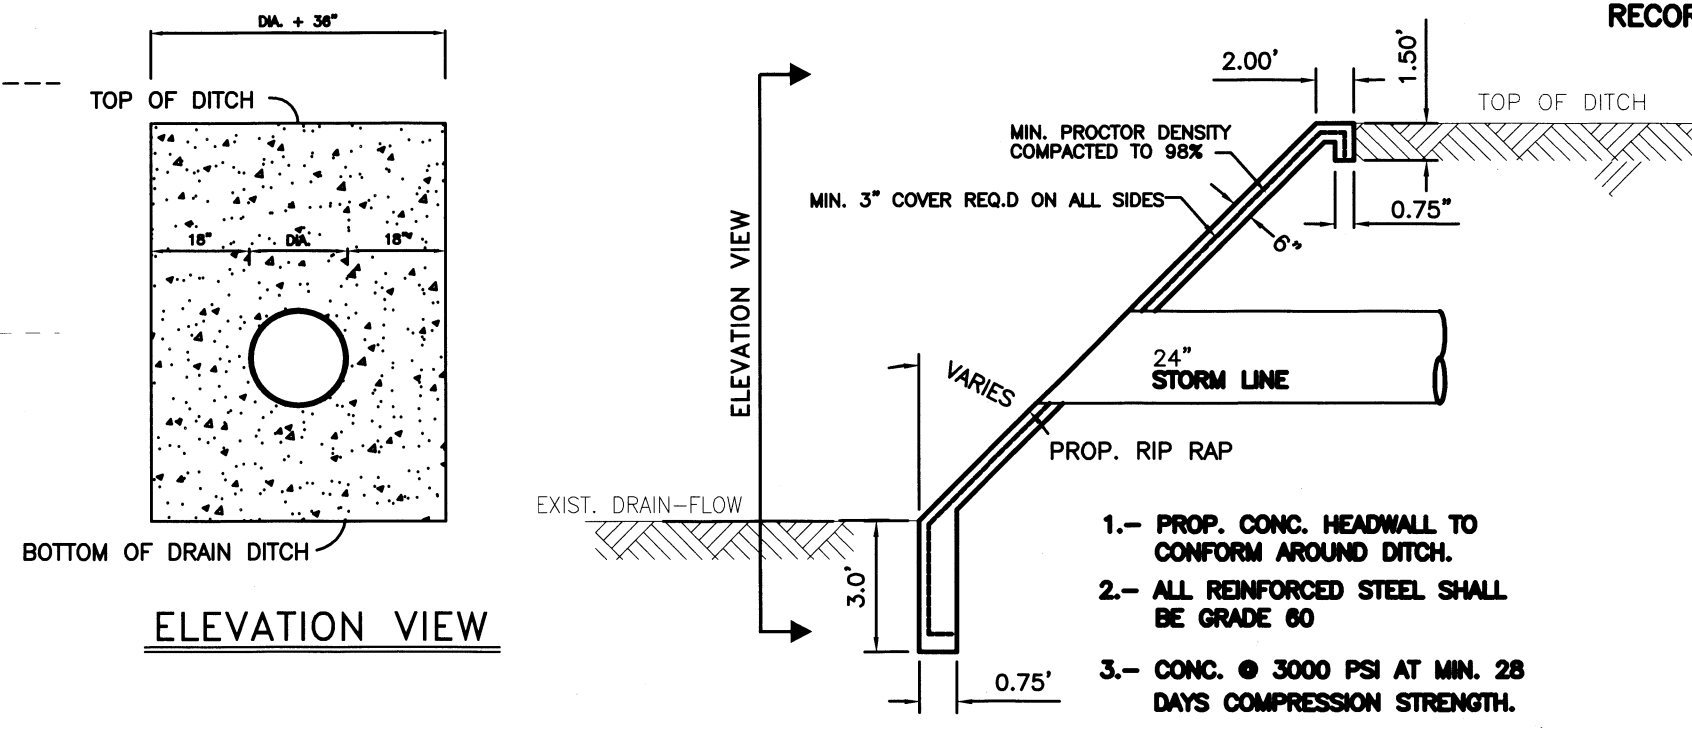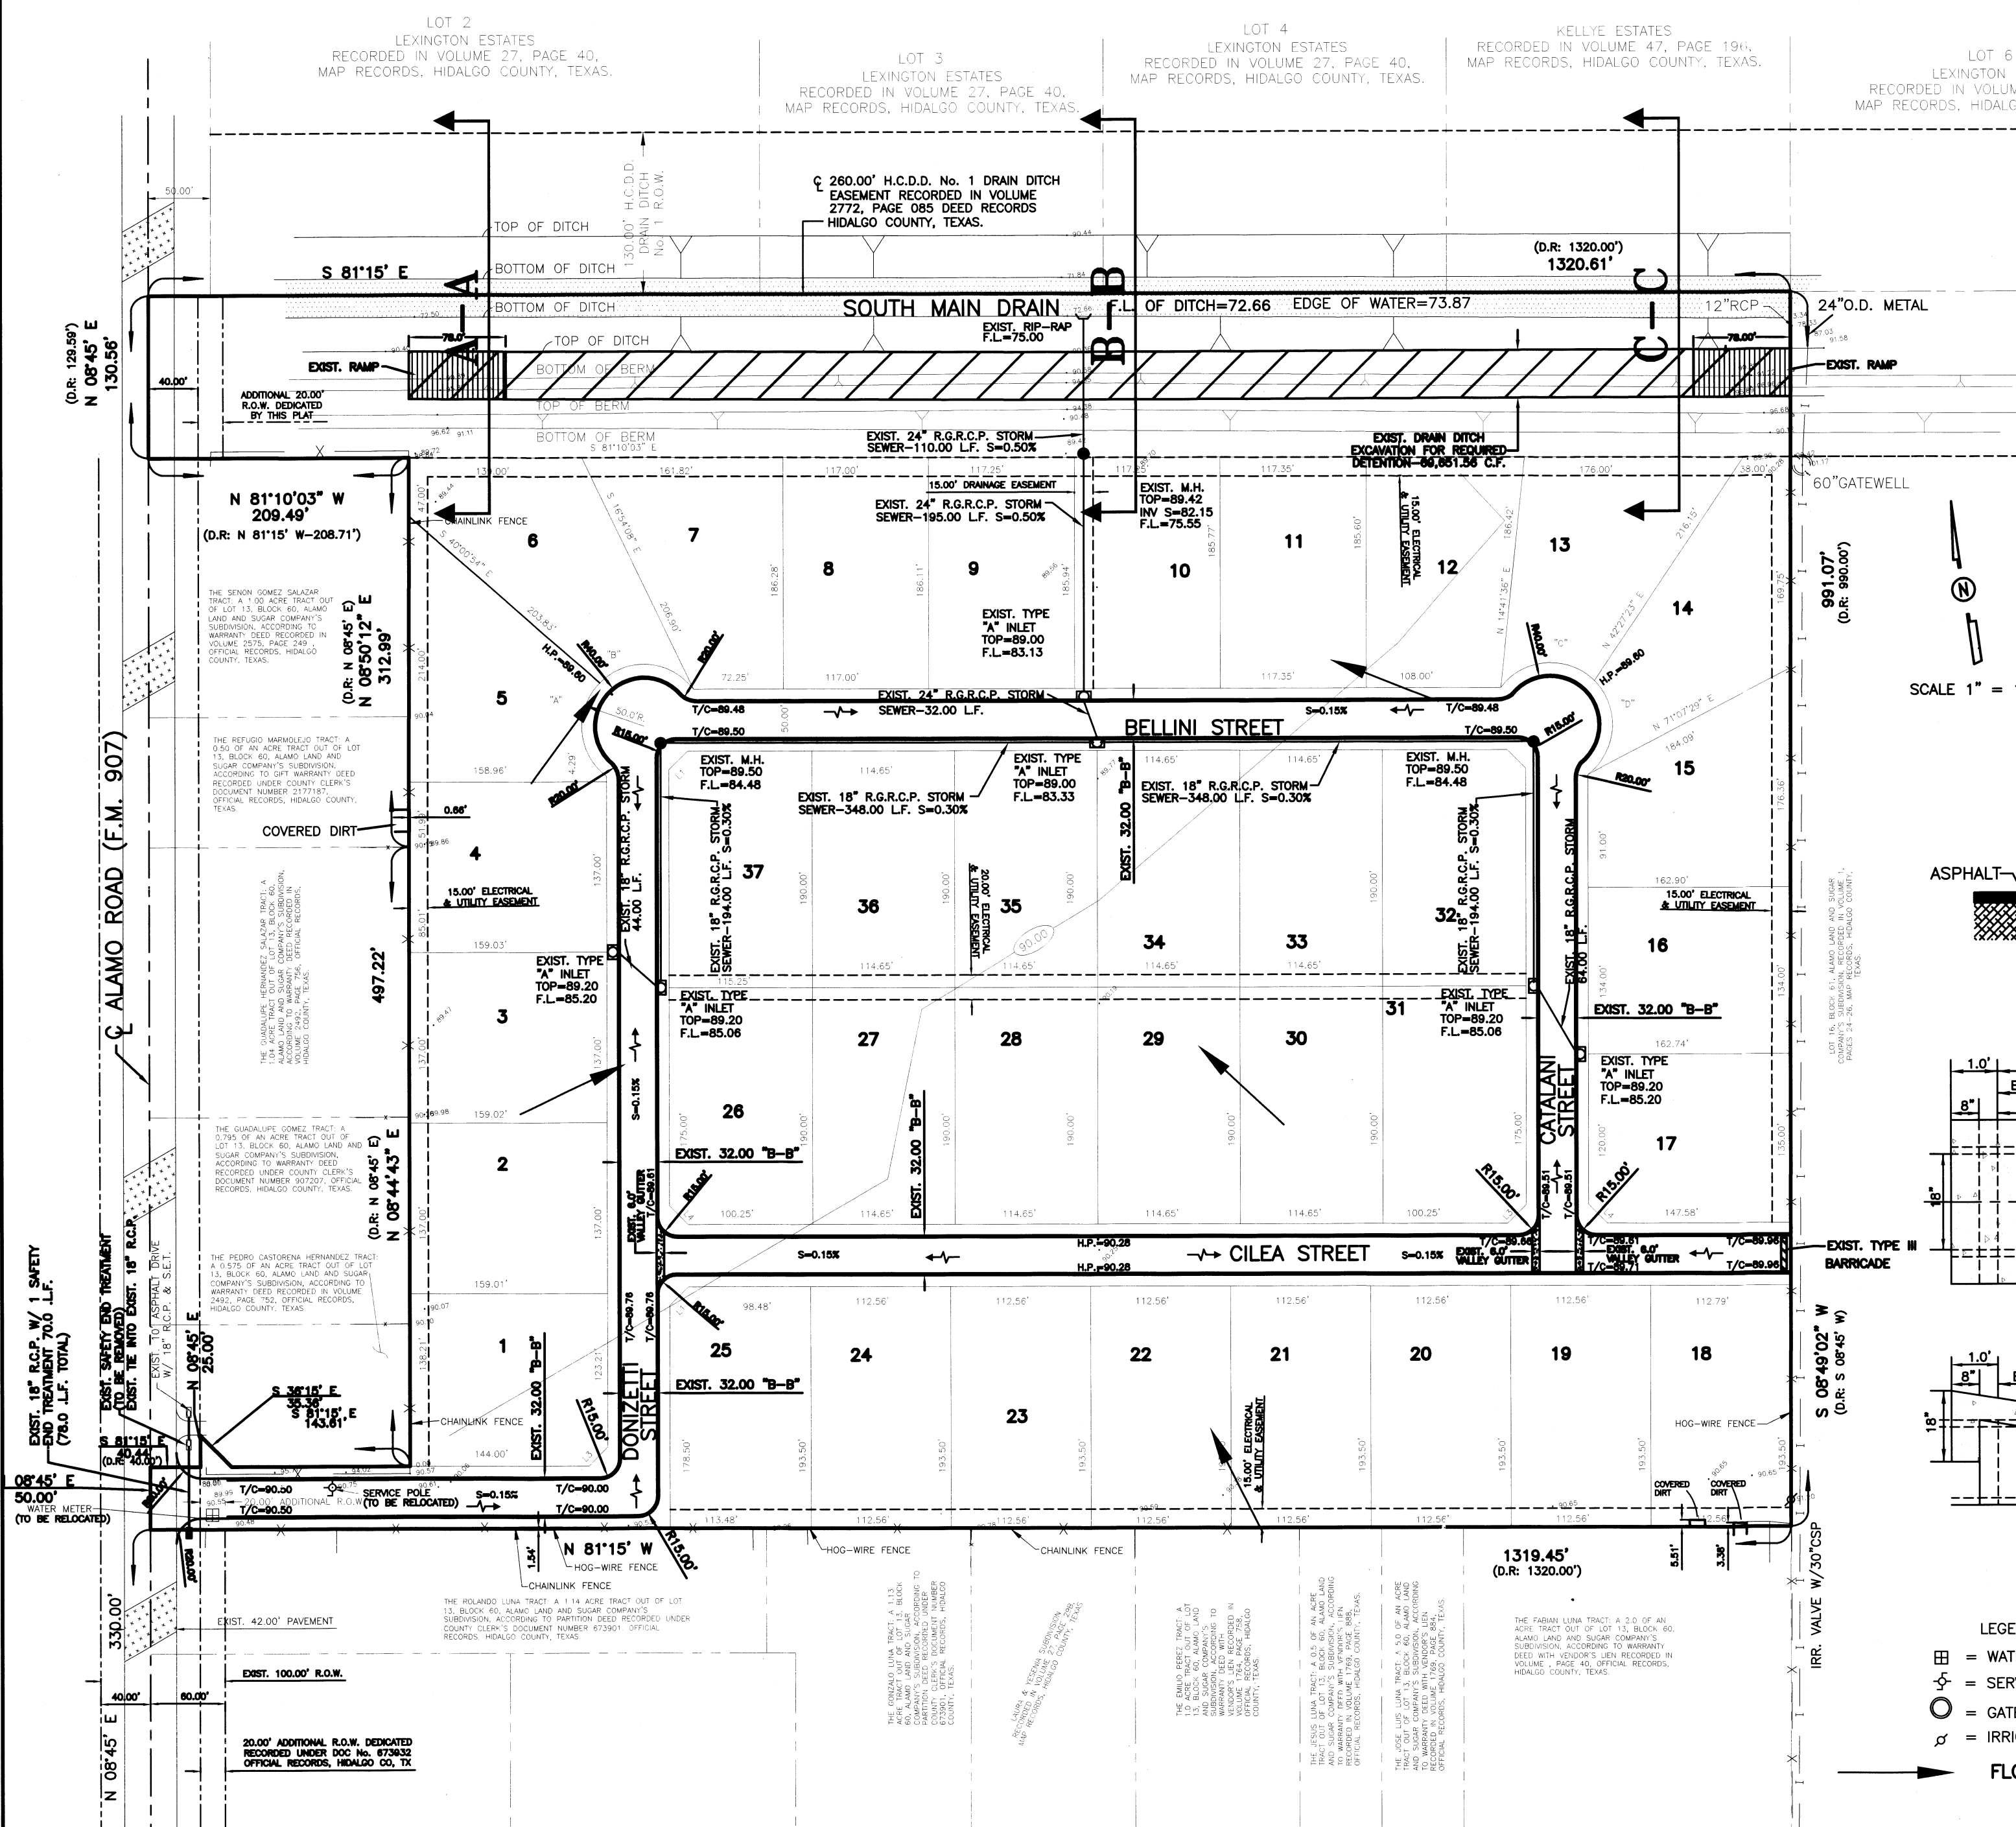

DRAINAGE REPORT FOR: ARIA RANCHES SUBDIVISION
By ALFONSO QUINTANILLA, P.E.

Aria Ranches Subdivision is a 26.15 acre tract of land out of Lot 13, Block 60, Alamo Land and Sugar Company's Subdivision, Hidalgo County, Texas, according to the map or plat thereof recorded in Volume 1, Pages 24-26, map records, Hidalgo County, Texas, and according to warranty deed recorded in Volume 1199, Page 256, and deed recorded in Volume 1225, Page 190, official records, Hidalgo County, Texas. This subdivision is located on the east side of Alamo Road (F.M. 907) and 330 feet north of Canton Road. The proposed subdivision will consist of 37 residential lots.

The tract is Zone "B" as per FEMA Flood Insurance Rate Map, Community Panel No. 480334 0425 C, dated on November 16, 1982.

This soil is sandy clay loam and clay loam. This soil is well drained. Permeability is moderate. Plasticity Index has a range of 11-23. See attached Soil Survey of Hidalgo County, Texas tables.


Presently, the site has very minimal runoff. The existing runoff for the proposed subdivision is $Q = 6.15$ cubic feet per second based on a 10-year storm.

After development the runoff will be $Q = 18.70$ cubic feet per second for an increase of $Q = 12.55$ cubic feet per second. Detention will be 46,669.38 cubic feet (1.07 acre feet) and will be accomplished by excavating this volume within the existing Hidalgo County Drainage District No. 1 (The South Main Drain). Street runoff will flow into proposed type "A" inlets that drain into a proposed storm sewer system consisting of a 18 inch and 24 inch drain line. The proposed drain lines will drain into the aforementioned South Main Drain.





THE COUNTY DRAINAGE DITCH FLOWS NORTH THEN EAST. THE DRAINAGE DITCH CARRIES WATER EASTWARD WHERE IT EPTIES INTO LAGUNA MADRE. THE 10 EAR FLOOD IS CONTAINED WITH THE RIGHT-OF-WAY OF THE STREET AND WITHIN THE DRAINAGE SWALES OF THE SUBDIVISION AS SHOWN BELOW. A RESTRICTIVE COVENANT (SET OUT ON SHEET 1 UNDER PLAT NOTES AND RESTRICTIONS) PROHIBITS THE CONSTRUCTION OF RESIDENTIAL HOUSING IN ANY AREA OF THE SUBDIVISION THAT IS IN A FLOODPLAIN UNLESS THE HOUSING QUALIFIES FOR INSURANCE UNDER THE NATIONAL FLOOD INSURANCE ACT OF 1968. AS FURTHER NOTED ON SHEET 1, THE FINISHED FLOOR ELEVATION OF EACH HOUSE IS REQUIRED TO BE AT LEAST 18 INCHES ABOVE THE TOP OF THE AVERAGE HEIGHT OF THE CURB IN FRONT OF THE LOT. THESE MEASURES PROVIDE POSITIVE DRAINAGE AWAY FROM ALL BUILDINGS. AVOID CONCENTRATING RUNOFF ONTO OTHER LOTS, AND COORDINATE INDIVIDUAL LOT DRAINAGE WITH THE GENERAL STORM DRAINAGE PATTERN FOR THE AREA. THE MAP BELOW ILLUSTRATES THE FLOW PATTERNS OF THE RUNOFF.

CERTIFICATION:
BY MY SIGNATURE BELOW, I CERTIFY THAT THE 100-YEAR FLOODPLAIN FOR ZONE "B" [AREAS BETWEEN LIMITS OF THE 100-YEAR FLOOD AND 500-YEAR FLOOD; OR CERTAIN AREAS SUBJECT TO 100-YEAR FLOODING WITH AVERAGE DEPTHS LESS THAN ONE (1) FOOT OR WHERE THE CONTRIBUTING DRAINAGE IS LESS THAN ONE SQUARE MILE, OR AREAS PROTECTED BY LEVEES FROM THE BASE FLOOD. (MEDIUM SHADING)] AS DESCRIBED PANEL NUMBER 480334 0425 C DATED NOVEMBER 16, 1982.

CERTIFICATION:
BY MY SIGNATURE BELOW, I CERTIFY THAT THE 100-YEAR FLOODPLAIN FOR ZONE "B" [AREAS BETWEEN LIMITS OF THE 100-YEAR FLOOD AND 500-YEAR FLOOD; OR CERTAIN AREAS SUBJECT TO 100-YEAR FLOODING WITH AVERAGE DEPTHS LESS THAN ONE (1) FOOT OR WHERE THE CONTRIBUTING DRAINAGE IS LESS THAN ONE SQUARE MILE, OR AREAS PROTECTED BY LEVEES FROM THE BASE FLOOD. (MEDIUM SHADING)] AS DESCRIBED PANEL NUMBER 480334 0425 C DATED NOVEMBER 16, 1982.

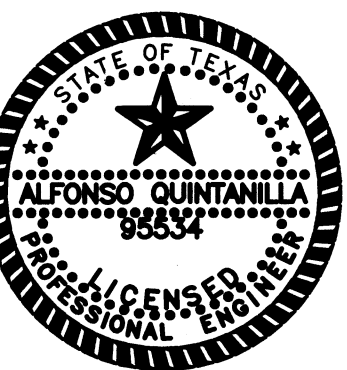

Alfonso Quintanilla P.E.
ALFONSO QUINTANILLA
P.E. No. 95534
DATE 6-6-14

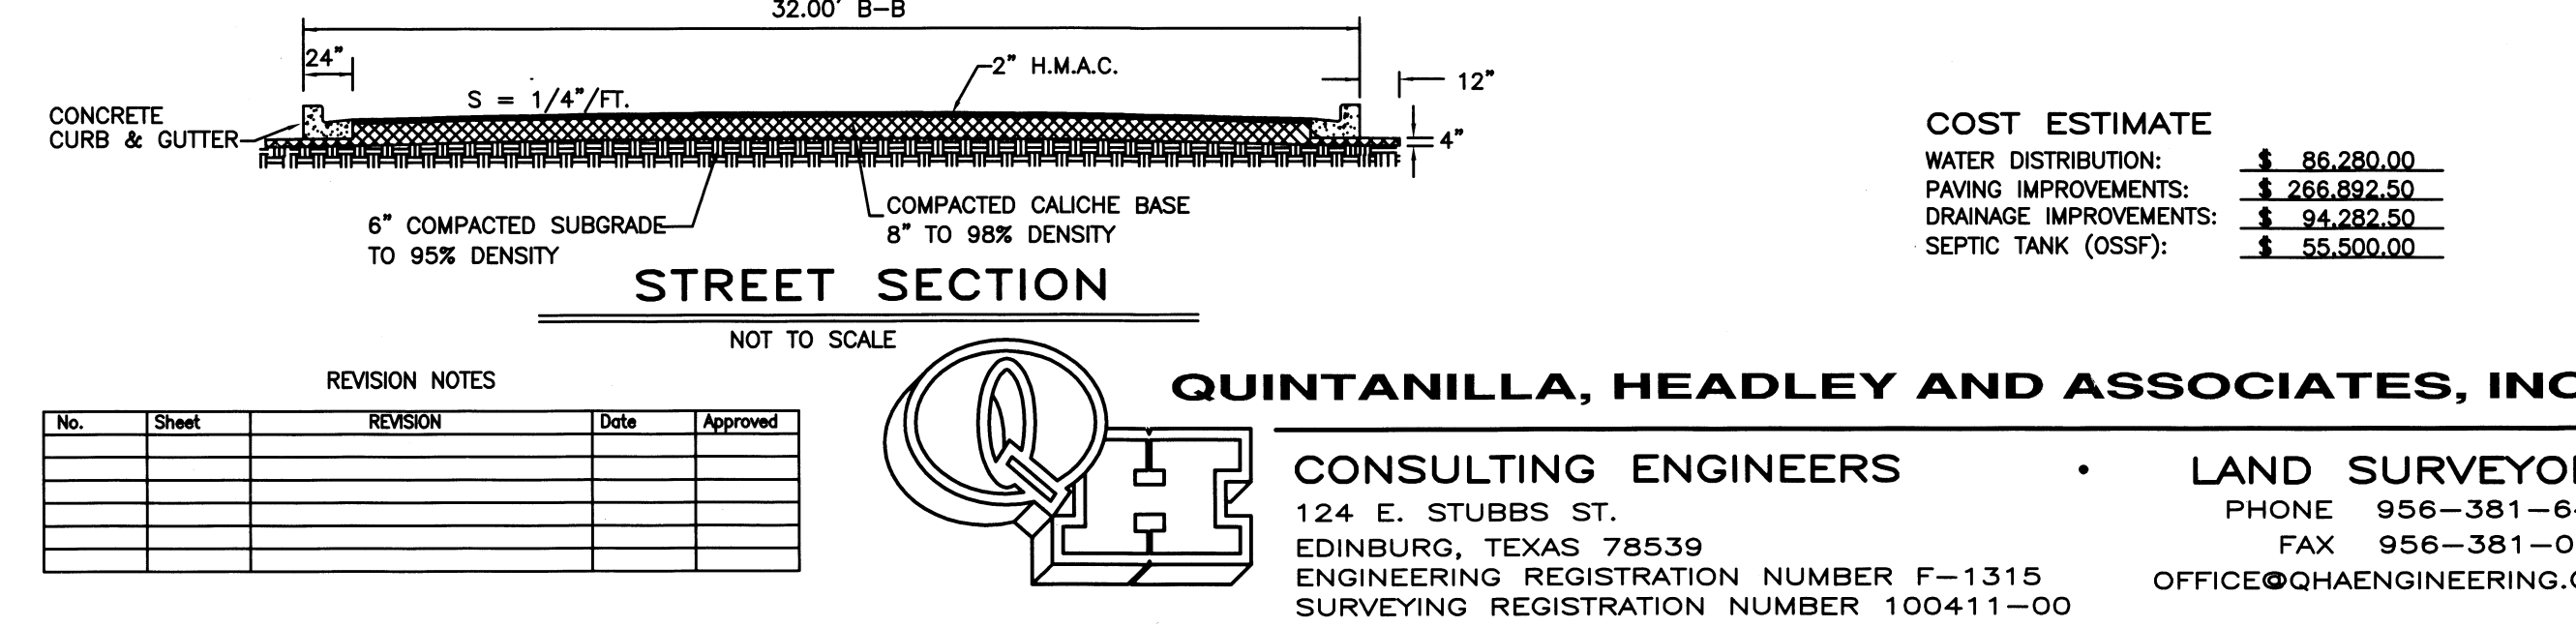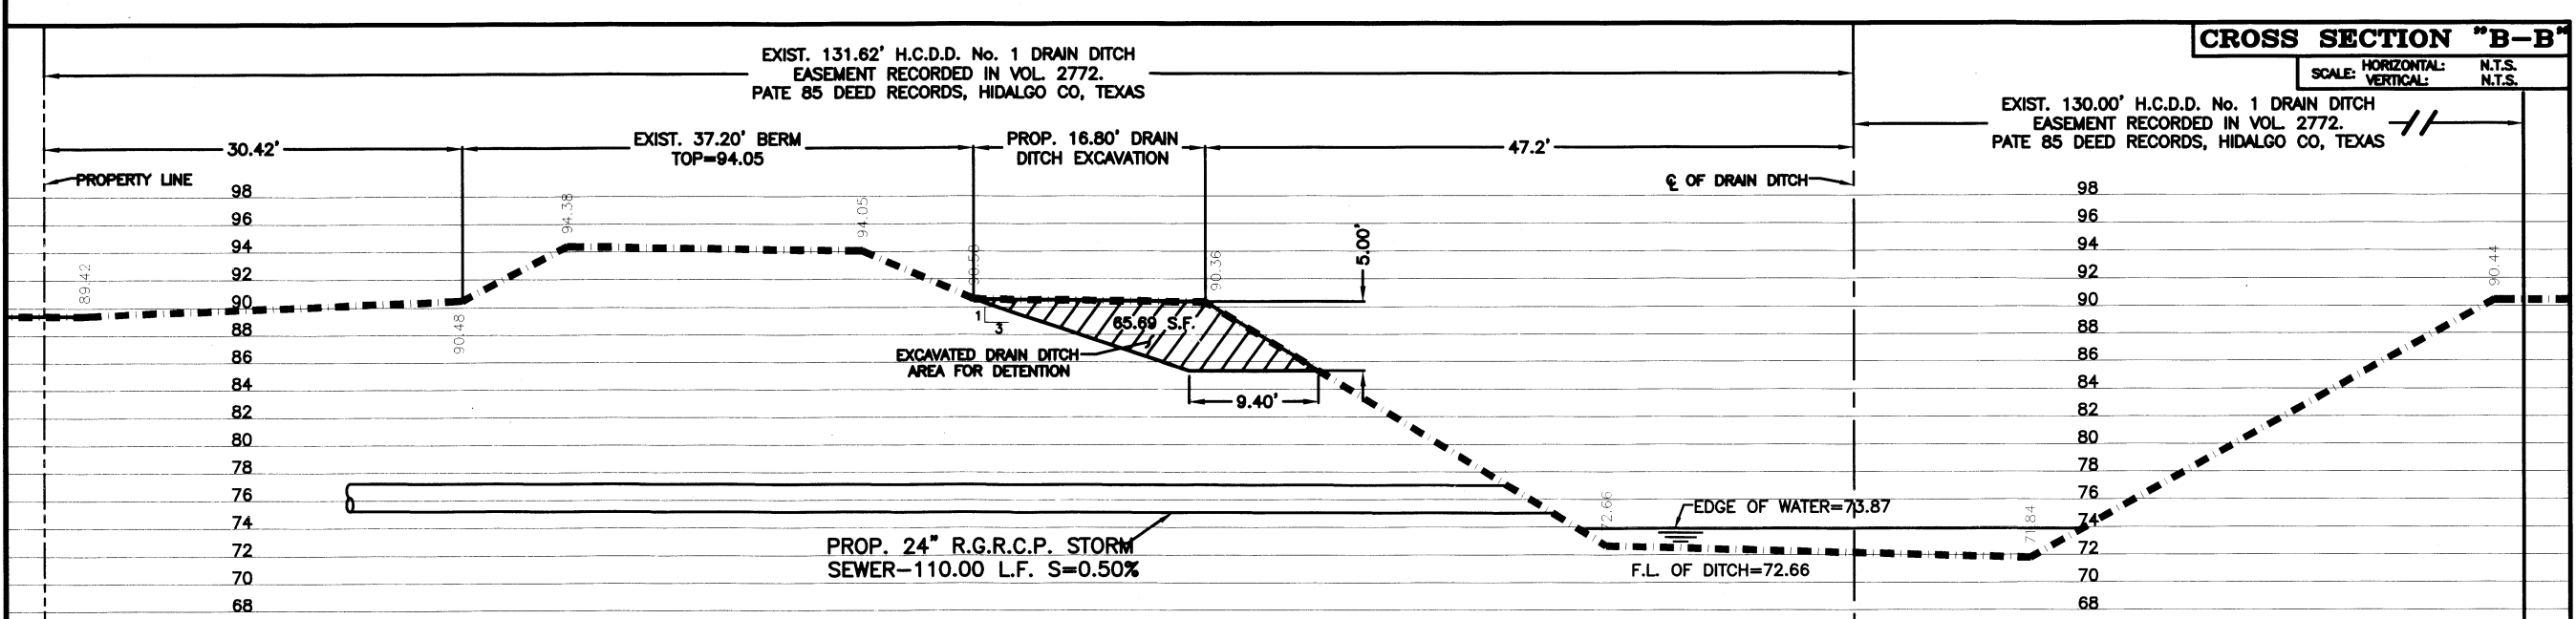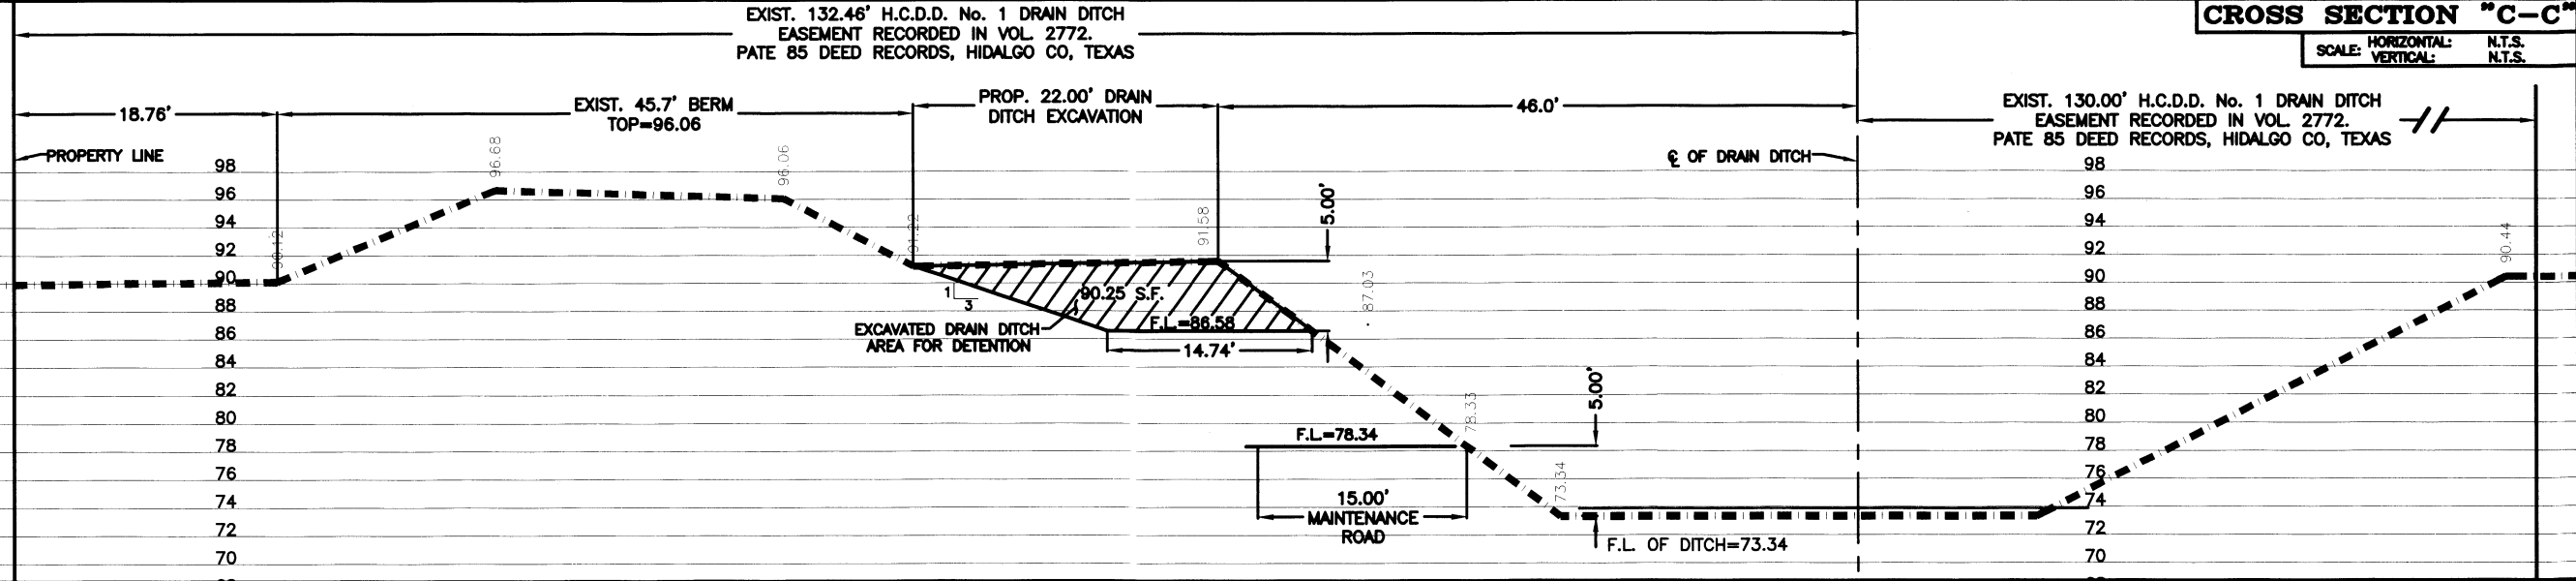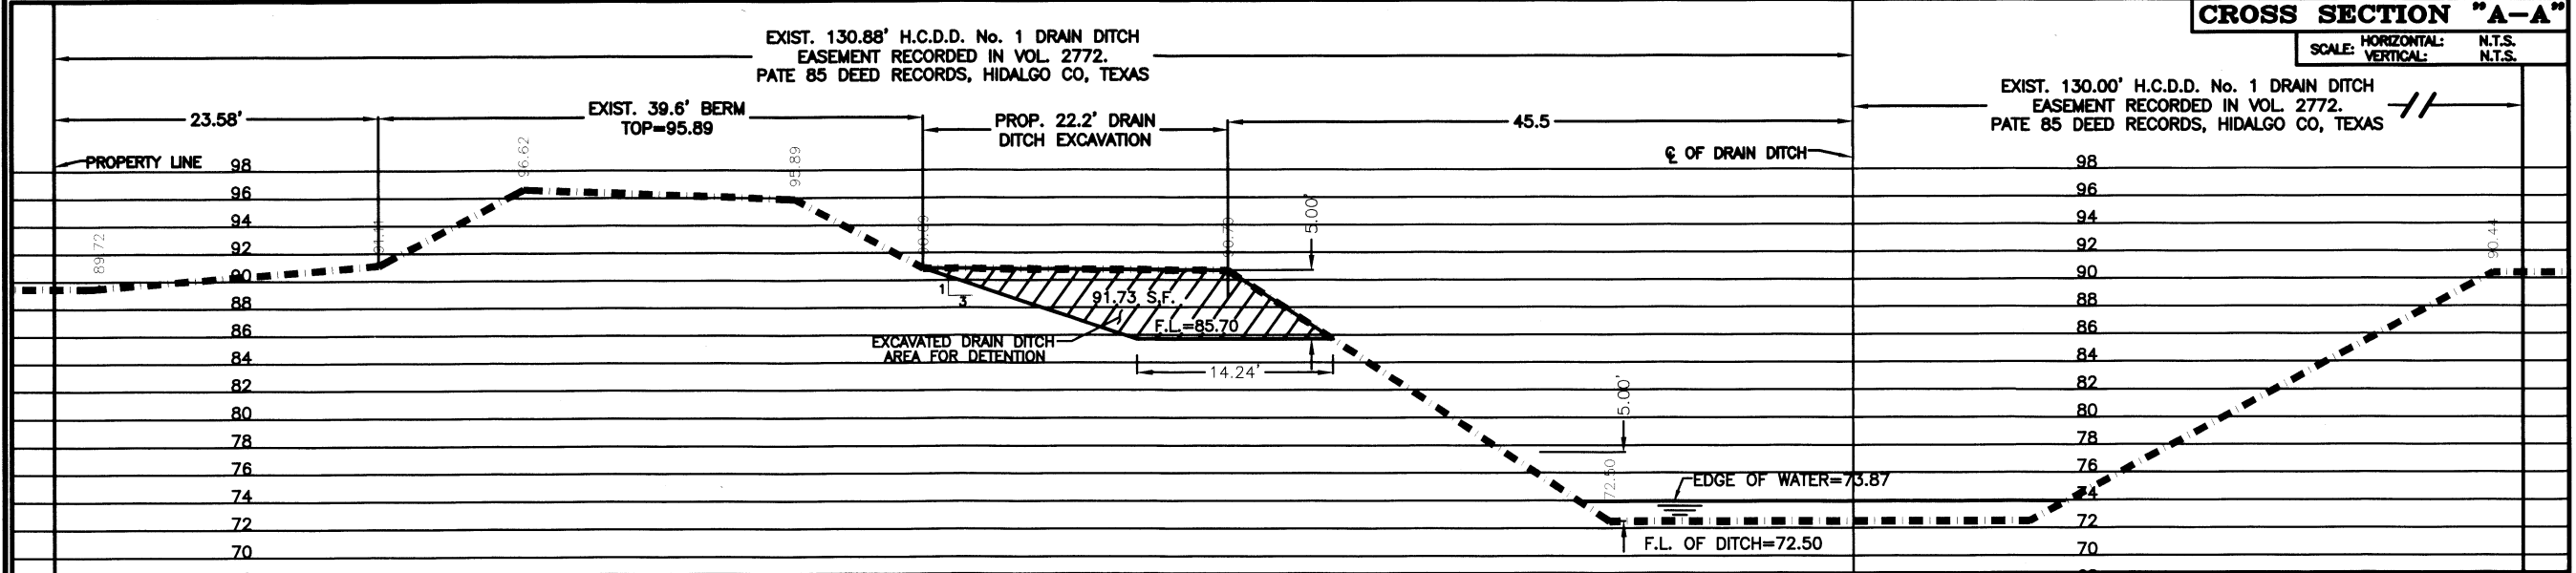

COST ESTIMATE

WATER DISTRIBUTION:	\$ 88,280.00
PAVING IMPROVEMENTS:	\$ 256,822.50
DRAINAGE IMPROVEMENTS:	\$ 94,282.50
SEPTIC TANK (OSSF):	\$ 55,500.00




FILED FOR RECORD IN HIDALGO COUNTY
ARTURO GUJARDO, JR.
HIDALGO COUNTY CLERK

ON: _____ AT _____ AM/PM
INSTRUMENT NUMBER _____
OF THE MAP RECORDS OF HIDALGO COUNTY, TEXAS
BY: _____ DEPUTY

REVISION NOTES

No.	Sheet	REVISION	Date	Approved

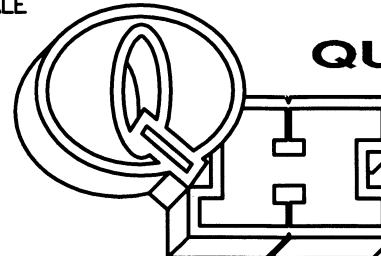

QUINTANILLA, HEADLEY AND ASSOCIATES, INC.
CONSULTING ENGINEERS • LAND SURVEYORS
124 E. STUBBS ST. PHONE 956-381-6480
EDINBURG, TEXAS 78539 FAX 956-381-0527
ENGINEERING REGISTRATION NUMBER F-1315 OFFICE@QHAENGINEERING.COM
SURVEYING REGISTRATION NUMBER 100411-00

SHEET NO. 3 OF 3 SHEETS

FILENAME	DATE PREPARED	PREPARED BY	CHECKED BY	APPROVED BY
F:\DATA\SUBDIVS\EDINBURG\ARIA RANCHES SUBDIVISION\B-PLAT	MAY 9, 2013	LG		