



HIDALGO COUNTY PLANNING DEPARTMENT

1304 SOUTH 25TH STREET
EDINBURG TEXAS 78539
Tel. 956-318-2840 Fax. 956-318-2844

T.J. Arredondo, CFM
Director of Planning

HIDALGO COUNTY COMMISSIONERS COURT MEETING

DATE: 3-06-2018

PROPOSE ALBERTA VILLAGE SUBDIVISION, PRECINCT No. 4.

ENGINEER: MELDEN & HUNT, INC. DEVELOPER: JULIO & MELISSA CARRANZA

PRELIMINARY APPROVAL FINAL APPROVAL FINAL APPROVAL WITH FINANCIAL GUARANTEE WITH VARIANCE

NUMBER OF LOTS: 34 *SINGLE FAMILY *MULTI-FAMILY COMMERCIAL INSTITUTIONAL

LOCATION DESCRIPTION: NORTH OF ALBERTA ROAD APPROXIMATELY ¼ MILE WEST OF RAUL LONGORIA ROAD.

SUBDIVISION LIES WITHIN THE: ETJ OF EDINBURG AND WAS APPROVED BY THE P & Z AND CITY COMMISSION OF SAID CITY

DRAINAGE REPORT WAS APPROVED BY HCDD#1: ON 6-09-2017 PROPERTY LIES WITHIN FLOOD ZONE: "B" AS PER FEMA.

DRAINAGE DESIGN: DRAINAGE CONSISTS OF STORM SEWER SYSTEM AND DETENTION WILL BE PROVIDED BY WIDENING THE EXISTING DRAIN DITCH LOCATED APPROXIMATELY 400 FEET EAST OF THE PROPOSED SUBDIVISION DEVELOPMENT.

ROAD R.O.W. DEDICATION: 25.00 FEET ONTO ALBERTA ROAD.

H.C.R.O.W. FINAL APPROVAL DATE: 2-15-2018 BY, JOE OCHOA, PCT. 4 R.O.W. AGENT

H.C.H.D. FINAL APPROVAL DATE: N/A BY, ENVIRONMENTAL HEALTH DIVISION MANAGER

SEWER SYSTEM: SANITARY SEWER BY: CITY OF EDINBURG LINE SIZE: 8" LOCATION: ALBERTA ROAD.

WATER SERVICE PROVIDER: N.A.W.S.C. LINE SIZE: 8" LOCATION: ALBERTA ROAD.

H.C.E.O.C. FINAL APPROVAL DATE: 2-20-2018: BY MARTIN RAMIREZ ENVIRONMENTAL COMPLIANCE COORDINATOR

LARGE CONSTRUCTION

The applicant has submitted the required NOI as per Part II, Section E of the TPDES General Permit for Construction Activities (TXR150000) along with a copy of the Erosion Control Plan for the proposed project.

REQUEST FOR FINAL APPROVAL WITH: **Letter of Credit No. 5143-500 submitted to City of Edinburg: Amount: \$ 157,581.69**

For: **Paving and Drainage**


PRELIMINARY APPROVAL FROM THE
HIDALGO COUNTY COMMISSIONERS COURT ON: 6-27-2017

STAFF RECOMMENDS: **Preliminary Approval** subject to comments and future recommendations by planning, other departments and the approval of the City of EDINBURG.

Final Approval subject to recommendations other departments

This subdivision plat has been reviewed and complies with the Hidalgo County Subdivision Rules,

* *Texas Water Development Board Model Subdivision Rules and The Texas Local Government Code.*

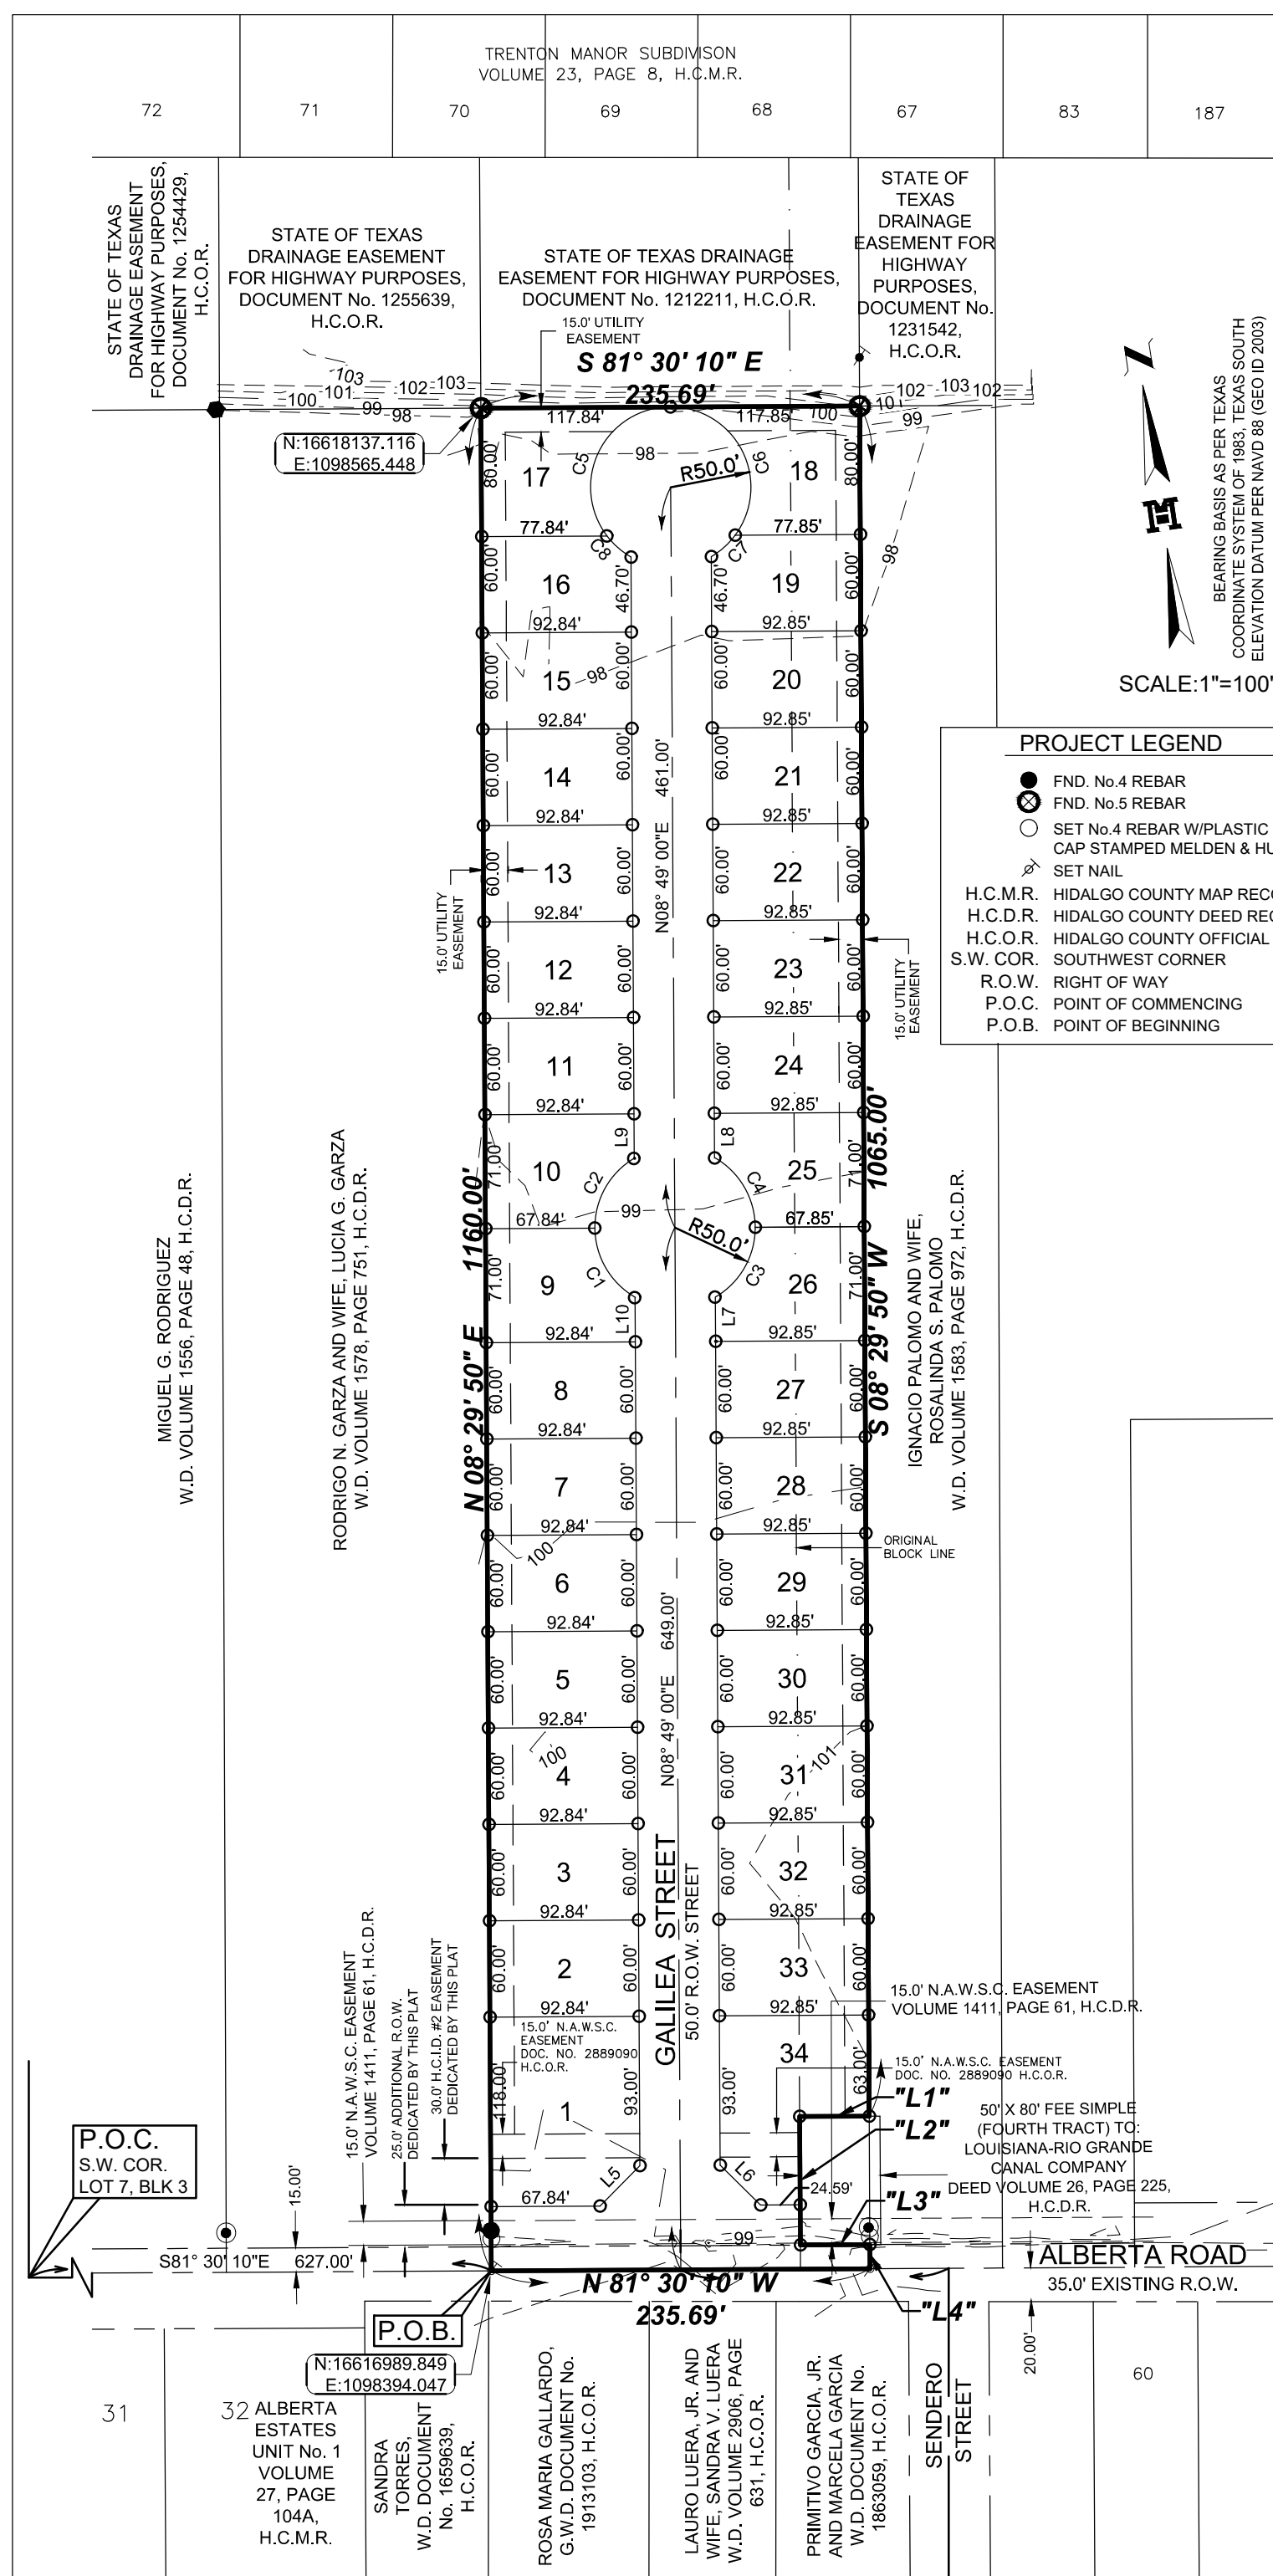

SUBDIVISION MAP OF ALBERTA VILLAGE SUBDIVISION BEING 6.197 ACRES OUT OF LOT 6, BLOCK 2 AND LOT 7, BLOCK 3 JOHN CLOSER, ET AL SUBDIVISION VOL. 0, PGS. 4-5, H.C.M.R. HIDALGO COUNTY, TEXAS

- GENERAL PLAT NOTES & RESTRICTIONS:
HIDALGO COUNTY GENERAL SUBDIVISION PLAT NOTES
- FLOOD ZONE STATEMENT:**
FLOOD ZONE DESIGNATION: ZONE "B" AREAS BETWEEN LIMITS OF THE 100-YEAR FLOOD AND 500-YEAR FLOOD; OR CERTAIN AREA SUBJECT TO 100-YEAR FLOODING WITH AVERAGE DEPTHS LESS THAN ONE (1) FOOT OR WHERE THE CONTRIBUTING DRAINAGE AREA IS LESS THAN ONE SQUARE MILE; OR AREAS PROTECTED BY LEVEES FROM THE BASE FLOOD. COMMUNITY-PANEL NO. 480334 0425 C EFFECTIVE DATE: NOVEMBER 16, 1982.
 - SETBACKS:**
FRONT: 20.00 FEET
REAR: 10.00 FEET OR EASEMENT WHICHEVER IS GREATER
SIDE: 10.00 FEET OR EASEMENT WHICHEVER IS GREATER
 - THIS DEVELOPMENT IS FOR SINGLE-FAMILY USE.
 - MINIMUM FINISHED FLOOR ELEVATION SHALL BE 18" ABOVE TOP OF CURB OF STREET OR 18" ABOVE NATURAL GROUND, WHICHEVER IS GREATER. ELEVATION CERTIFICATE MAY BE REQUIRED FOR LOTS LOCATED OUTSIDE A DESIGNATED FLOOD ZONE AT THE TIME OF APPLICATION FOR CONSTRUCTION TO VERIFY PRE AND POST CONSTRUCTION FINISHED FLOOR ELEVATIONS. AN ELEVATION CERTIFICATE SHALL BE REQUIRED FOR ALL LOTS WITHIN A DESIGNATED FLOOD ZONE AT THE TIME FOR A DEVELOPMENT PERMIT APPLICATION.
 - THE FOLLOWING BENCHMARKS ARE IDENTIFIED ON THE FACE OF THE PLAT AND ON THE ATTACHED ENGINEERING PLANS:
--B.M. NO. 1--ELEV. 89.00 N.G.V.D. 29 DESCRIPTIONS: ALUMINUM DISK SET IN CONCRETE SLAB AT THE SOUTHWEST CORNER OF LOT 1 OF THIS SUBDIVISION.
 - IN ACCORDANCE WITH THE HIDALGO COUNTY DRAINAGE DISTRICT NO. 1 AND HIDALGO COUNTY REQUIREMENTS, THIS DEVELOPMENT WILL BE REQUIRED TO DETAIN A TOTAL OF 27,952 CUBIC-FEET 0.642 ACRE-FEET OF STORM WATER RUNOFF. DRAINAGE RETENTION IN ACCORDANCE WITH THE LOCAL REQUIREMENTS WILL BE ACCOMPLISHED AS FOLLOWS: (SEE SHEET NO. 3 FOR STORM SEWER IMPROVEMENTS.) THE DEVELOPER SHALL BE RESPONSIBLE TO DETAIN AND ACCOMMODATE MORE THAN THE DETAINED VOLUME SHOWN ABOVE IF IT IS DETERMINED AT THE DEVELOPMENT PERMIT STATE ABOVE DUE TO THE IMPERVIOUS AREA BEING GREATER THAN PLAT ENGINEER CONSIDERED FOR HIS CALCULATIONS OF THIS SUBDIVISION.
 - ALL LOTS SHALL HAVE A POSTDISPOSE FINISH GRADE FROM THE REAR OF THE LOT TO THE CURB AND/OR ROADSIDE DITCH AT A 1% SLOPE TO ACCOMPLISH POSITIVE DRAINAGE. THIS IS IN ACCORDANCE WITH HIDALGO COUNTY APPENDIX 5: COUNTY CONSTRUCTION.
 - NO STRUCTURE SHALL BE PERMITTED OVER ANY EASEMENT. EASEMENTS SHALL BE KEPT CLEAR OF BUILDINGS, SHEDS, SHRUBS TREES, AND OTHER PLANTINGS (EXCEPT LOW, LESS THAN 18 INCHES MATURE HEIGHT, GROUND COVER, GRASS, OR FLOWERS) AND OTHER OBSTRUCTIONS THAT WOULD INTERFERE WITH THE OPERATIONS AND MAINTENANCE OF THE EASEMENT.
 - EACH PURCHASE CONTRACT MADE BETWEEN A SUBDIVIDER AND PURCHASER OF A LOT IN THIS SUBDIVISION SHALL CONTAIN A STATEMENT DESCRIBING HOW AND WHEN WATER, SEWER, ELECTRICITY, AND GAS SERVICES WILL BE MADE AVAILABLE TO THE SUBDIVISION.
 - ALL PUBLIC UTILITIES EASEMENTS DEDICATED BY THIS PLAT SHALL BE A MINIMUM WIDTH OF 15.00 FEET AS PER THE HIDALGO COUNTY MODEL SUBDIVISION RULES. BY SIGNING THIS PLAT, DEVELOPER AND ENGINEER CERTIFY THAT ALL OTHER EASEMENTS SHOWN COMPLY WITH THE SIZE REQUIRED BY EACH UTILITY PROVIDER OCCUPYING AN EASEMENT.
 - THERE ARE NO VISIBLE WATER WELLS WITHIN 150 FEET FROM THE BOUNDARIES ON THIS SUBDIVISION
 - CLEARANCES FOR WATER METERS: (ONLY FOR LOTS BEING AS PER LOCAL GOVERNMENT CODE REQUIREMENTS. SANITARY SEWER MUST BE CONNECTED TO A RESIDENCE PRIOR TO THE COUNTY PROCESSING A FINAL CLEARANCE FOR A WATER METER. A SEWER TAP INSPECTION SHALL BE PROVIDED FROM THE ENTITY SERVICE PROVIDER PRIOR TO RECEIVING A CLEARANCE FOR WATER METER(S).
 - LOT 1 AND 34 SHALL NOT HAVE ACCESS ONTO ALBERTA ROAD.
 - EACH LOT SHALL HAVE ITS OWN WATER METER.
 - SIDEWALK WILL BE REQUIRED ALONG ALBERTA ROAD AND WITHIN THE SUBDIVISION AS PER LATEST CITY OF EDINBURG ENGINEERING STANDARDS MANUAL OR AS DIRECTED BY CITY ENGINEER.
 - ALL INTERIOR LOTS SHALL HAVE 4-FT SIDEWALKS.
 - ALL CONSTRUCTION SHALL COMPLY WITH STORM WATER POLLUTION PREVENTION PLAN (SWPP) REQUIREMENTS.
 - NO MORE THAN ONE-SINGLE FAMILY DETACHED DWELLING SHALL BE LOCATED ON EACH LOT. THIS MUST BE STIPULATED ON ALL DEEDS AND CONTRACTS FOR DEEDS.
 - ALL BEARING AND DISTANCES ARE BASED ON GRID COORDINATES.

RIGHT OF WAY EASEMENT

KNOWN ALL MEN BY THESE PRESENTS, THAT THE UNDERSIGNED, OWNERS OF THE PROPERTY SHOWN ON THIS PLAT, THEIR SUCCESSORS, ASSIGNS, AND TRANSFERREES (HEREINAFTER CALLED "GRANTOR" WHETHER ONE OR MORE PERSONS ARE NAMED), IN CONSIDERATION OF ONE DOLLAR (\$1.00) AND OTHER GOOD AND VALUABLE CONSIDERATION PAID BY NORTH ALAMO WATER SUPPLY CORPORATION, (HEREINAFTER CALLED "GRANTEE"), THE RECEIPT AND SUFFICIENCY OF WHICH IS HEREBY ACKNOWLEDGED, DOES HEREBY GRANT, BARGAIN, SELL, TRANSFER AND CONVEY TO SAID GRANTEE, ITS SUCCESSORS AND ASSIGNS, AN EXCLUSIVE PERPETUAL EASEMENT WITH THE RIGHT TO ERECT, CONSTRUCT, INSTALL AND LAY AND THEREAFTER USE, OPERATE, INSPECT, REPAIR, MAINTAIN, REPLACE AND REMOVE WATER DISTRIBUTION LINES AND APPURTENANCES OVER AND ACROSS THE LANDS SHOWN ON THIS PLAT, TOGETHER WITH THE RIGHT OF INGRESS AND EGRESS OVER GRANTOR'S ADJACENT LANDS FOR THE PURPOSE FOR WHICH THE ABOVE-MENTIONED RIGHTS ARE GRANTED. THE EASEMENT HEREBY GRANTED SHALL NOT EXCEED 15' IN WIDTH, AND GRANTEE IS HEREBY AUTHORIZED TO DESIGNATE THE COURSE OF THE EASEMENT HEREIN CONVEYED EXCEPT THAT WHEN THE PIPELINE(S) IS INSTALLED, THE EASEMENT HEREIN GRANTED SHALL BE LIMITED TO A STRIP OF LAND 15' IN WIDTH, THE CENTER LINE THEREOF BEING THE PIPELINE INSTALLED.

IN THE EVENT THE EASEMENT HEREBY GRANTED ABUTS ON A PUBLIC ROAD AND THE CITY, COUNTY OR STATE HEREAFTER WIDENS OR RELOCATES THE PUBLIC ROAD SO AS TO REQUIRE THE RELOCATION OF THIS WATER LINE AS INSTALLED, GRANTOR FURTHER GRANTS TO GRANTEE AN ADDITIONAL EASEMENT OVER AND ACROSS THE LAND SHOWN ON THIS PLAT FOR THE PURPOSE OF LATERALLY RELOCATING SAID WATER LINE AS MAY BE NECESSARY TO CLEAR THE ROAD IMPROVEMENTS, WHICH EASEMENT HEREBY GRANTED SHALL BE LIMITED TO A STRIP OF LAND 15' IN WIDTH, THE CENTER LINE THEREOF BEING THE PIPELINE AS RELOCATED.

THE CONSIDERATION RECITED HEREIN SHALL CONSTITUTE PAYMENT IN FULL FOR ALL DAMAGES SUSTAINED BY GRANTOR BY REASON OF THE INSTALLATION, MAINTENANCE, REPAIR, REPLACEMENT AND RELOCATION OF THE STRUCTURES REFERRED TO HEREIN. THIS AGREEMENT TOGETHER WITH OTHER PROVISIONS OF THIS GRANT SHALL CONSTITUTE AN EASEMENT FOR THE BENEFIT OF THE GRANTEE, ITS SUCCESSORS, AND ASSIGNS. THE GRANTOR AGREES THAT IT IS THE OWNER OF THE ABOVE-DESCRIBED LANDS AND THAT SAID LANDS ARE FREE AND CLEAR OF ALL ENCUMBRANCES AND LIENS, EXCEPT THE FOLLOWING:

THE EASEMENT CONVEYED HEREIN WAS OBTAINED OR IMPROVED THROUGH FEDERAL FINANCIAL ASSISTANCE. THIS EASEMENT IS SUBJECT TO THE PROVISIONS OF THE TITLE VI OF THE CIVIL RIGHTS ACT OF 1964 AND THE REGULATIONS ISSUED PURSUANT THERETO FOR SO LONG AS THE EASEMENT CONTINUES TO BE USED FOR THE SAME OR SIMILAR PURPOSE FOR WHICH FINANCIAL ASSISTANCE WAS EXTENDED OR FOR SO LONG AS THE GRANTEE OWNS IT, WHICHEVER IS LONGER.

IN WITNESS WHEREOF, THE SAID GRANTOR HAS EXECUTED THIS INSTRUMENT THE DAY OF _____ 20__

(GRANTOR'S SIGNATURE)

(GRANTOR'S SIGNATURE)

ACKNOWLEDGMENT

THE STATE OF TEXAS §
COUNTY OF HIDALGO §

BEFORE ME, THE UNDERSIGNED, A NOTARY PUBLIC IN AND FOR SAID COUNTY AND STATE, ON THIS DAY PERSONALLY APPEARED JULIO CESAR CARRANZA AND WIFE MELISSA YOLANDA CARRANZA KNOWN TO ME TO BE THE PERSON(S) WHOSE NAME(S) IS (ARE) SUBSCRIBED TO THE FOREGOING INSTRUMENT, AND ACKNOWLEDGED TO ME THAT HE (SHE) (THEY) EXECUTED THE SAME FOR THE PURPOSES AND CONSIDERATION THEREIN EXPRESSED.

GIVEN UNDER MY HAND AND SEAL OF OFFICE THIS THE _____ DAY OF _____, 20__

NOTARY PUBLIC, STATE OF TEXAS
MY COMMISSION EXPIRES:

METES AND BOUNDS DESCRIPTION

ALBERTA VILLAGE SUBDIVISION BEING 6.197 ACRES, SITUATED IN THE CITY OF EDINBURG, COUNTY OF HIDALGO, TEXAS, BEING A PART OR PORTION OUT OF LOT 7, BLOCK 3 AND LOT 6, BLOCK 2, JOHN CLOSER ET AL SUBDIVISION, ACCORDING TO THE PLAT THEREOF RECORDED IN VOLUME _____ PAGES _____, HIDALGO COUNTY MAP RECORDS, SAID 6.197 ACRES WERE CONVEYED TO CARRANZA DEVELOPMENT LLC BY VIRTUE OF A WARRANTY DEED RECORDED UNDER DOCUMENT NUMBER 2854242, HIDALGO COUNTY OFFICIAL RECORDS, SAID 6.197 ALSO BEING MORE PARTICULARLY DESCRIBED AS FOLLOWS:

COMMENCING AT THE SOUTHWEST CORNER OF SAID LOT 7, BLOCK 3;

THENCE, S 81° 30' 10" E ALONG THE SOUTH LINE OF SAID LOT 7, BLOCK 3 AND WITHIN THE EXISTING RIGHT-OF-WAY OF ALBERTA ROAD, A DISTANCE OF 827.00 FEET TO A NAIL SET [NORTHING: 16616989.849, EASTING: 1098394.047] FOR THE SOUTHWEST CORNER AND POINT OF BEGINNING OF THIS HEREIN DESCRIBED TRACT;

- THENCE, N 08° 29' 50" E AT A DISTANCE OF 15.00 FEET PASS A NO. 4 REBAR SET ON THE EXISTING NORTH RIGHT-OF-WAY LINE OF ALBERTA ROAD, AT A DISTANCE OF 25.02 FEET PASS A NO. 4 REBAR FOUND IN LINE, CONTINUING A TOTAL DISTANCE OF 1,160.00 FEET TO A NO. 5 REBAR FOUND [NORTHING: 16618137.116, EASTING: 1098565.448] FOR THE NORTHWEST CORNER OF THIS TRACT;
- THENCE, S 81° 30' 10" E AT A DISTANCE OF 192.44 FEET PASS THE EAST LINE OF SAID LOT 7, BLOCK 3, AND THE WEST LINE OF SAID LOT 6, BLOCK 2, CONTINUING A TOTAL DISTANCE OF 235.69 FEET TO A NO. 5 REBAR FOUND FOR THE NORTHEAST CORNER OF THIS TRACT;
- THENCE, S 08° 29' 50" W A DISTANCE OF 1,065.00 FEET TO A NO. 4 REBAR SET FOR AN OUTSIDE CORNER OF THIS TRACT;
- THENCE, N 81° 30' 10" W A DISTANCE OF 43.25 FEET TO A NO. 4 REBAR SET FOR AN INSIDE CORNER OF THIS TRACT;
- THENCE, S 08° 29' 50" W A DISTANCE OF 80.00 FEET TO A NO. 4 REBAR SET ON THE EXISTING NORTH RIGHT-OF-WAY LINE OF ALBERTA ROAD, FOR AN INSIDE CORNER OF THIS TRACT;
- THENCE, S 81° 30' 10" E ALONG THE EXISTING NORTH RIGHT-OF-WAY LINE OF ALBERTA ROAD, A DISTANCE OF 43.25 FEET TO A NO. 4 REBAR SET FOR AN OUTSIDE CORNER OF THIS TRACT;
- THENCE, S 08° 29' 50" W A DISTANCE OF 15.00 FEET TO A NAIL SET FOR THE SOUTHEAST CORNER OF THIS TRACT;
- THENCE, N 81° 30' 10" W ALONG THE SOUTH LINE OF SAID LOT 6, BLOCK 2 AND LOT 7, BLOCK 3 AND WITHIN THE EXISTING RIGHT-OF-WAY OF ALBERTA ROAD, A DISTANCE OF 235.69 FEET TO THE POINT OF BEGINNING AND CONTAINING 6.197 ACRES OF LAND, WHICH 0.081 OF ONE ACRE LIES WITHIN THE EXISTING RIGHT-OF-WAY OF ALBERTA ROAD, LEAVING AN EXISTING NET OF 6.116 ACRES OF LAND, MORE OR LESS.

HIDALGO COUNTY CERTIFICATE OF PLAT APPROVAL UNDER LOCAL GOVERNMENT CODE § 232.028 (A)

WE THE UNDERSIGNED CERTIFY THAT THIS PLAT OF ALBERTA VILLAGE SUBDIVISION WAS REVIEWED AND APPROVED BY THE HIDALGO COUNTY COMMISSIONERS COURT ON _____ DAY OF _____, 20__.

HIDALGO COUNTY JUDGE _____

ATTEST: HIDALGO COUNTY CLERK _____

"I, THE UNDERSIGNED, CHAIRPERSON OF THE PLANNING AND ZONING COMMISSION OF THE CITY OF EDINBURG, HEREBY CERTIFY THAT THIS SUBDIVISION PLAT KNOWN AS ALBERTA VILLAGE SUBDIVISION CONFORMS TO ALL REQUIREMENTS OF THE SUBDIVISION REGULATIONS OF THIS CITY WHEREIN MY APPROVAL IS REQUIRED AND HAS BEEN APPROVED FOR RECORDING ON THE _____ DAY OF _____, 20__."

CHAIRPERSON PLANNING AND ZONING COMMISSION _____

I, THE UNDERSIGNED, MAYOR OF THE CITY OF EDINBURG, HEREBY CERTIFY THAT THIS SUBDIVISION PLAT CONFORMS TO ALL REQUIREMENTS OF THE SUBDIVISION REGULATIONS OF THIS CITY WHEREIN MY APPROVAL IS REQUIRED.

MAYOR CITY OF EDINBURG _____

HIDALGO COUNTY CERTIFICATE OF PLAT APPROVAL HIDALGO COUNTY DRAINAGE DISTRICT NO. 1

HIDALGO COUNTY DRAINAGE DISTRICT NO. 1 HEREBY CERTIFIES THAT THE DRAINAGE PLANS FOR THIS SUBDIVISION COMPLY WITH THE MINIMUM STANDARDS OF THE DISTRICT ADOPTED UNDER TEXAS WATER CODE 49.211 (c). THE DISTRICT HAS NOT REVIEWED AND DOES NOT CERTIFY THAT THE DRAINAGE STRUCTURES DESCRIBED ARE APPROPRIATE FOR THE SPECIFIC SUBDIVISION, BASED ON GENERALLY ACCEPTED ENGINEERING CRITERIA. IT IS THE RESPONSIBILITY OF THE DEVELOPER AND HIS ENGINEER TO MAKE THEIR DETERMINATIONS.

HIDALGO COUNTY DRAINAGE DISTRICT NO. 1

RAUL E. SESIN P. E., C. F. M. DATE: _____
GENERAL MANAGER

HIDALGO COUNTY CERTIFICATE OF PLAT APPROVAL IRRIGATION DISTRICT NO. 2

THIS PLAT IS HERE BY APPROVED BY THE HIDALGO COUNTY IRRIGATION DISTRICT NO. 2, DATED THIS THE _____ DAY OF _____, 2018

PRESIDENT _____

ATTEST: SECRETARY _____

NO IMPROVEMENT OF ANY KIND (INCLUDING WITHOUT LIMITATION TREES, FENCES AND BUILDINGS) SHALL BE PLACED UPON HIDALGO COUNTY IRRIGATION DISTRICT #2 RIGHT-OF-WAYS OR EASEMENTS.

STATE OF TEXAS
COUNTY OF HIDALGO

WE, THE UNDERSIGNED, OWNERS OF THE LAND SHOWN ON THIS PLAT AND DESIGNATED HEREIN AS THE ALBERTA VILLAGE SUBDIVISION, ADDITION TO THE CITY OF EDINBURG, TEXAS, AND WHOSE NAME IS SUBSCRIBED HERETO, HEREBY DEDICATE TO THE USE OF THE PUBLIC FOREVER ALL STREETS, ALLEYS, PARKS, WATERCOURSES, DRAINS, EASEMENTS AND PUBLIC PLACES THEREON SHOWN FOR THE PURPOSE AND CONSIDERATIONS THEREIN EXPRESSED.

CARRANZA DEVELOPMENT, LLC
A TEXAS LIMITED LIABILITY COMPANY

JULIO CESAR CARRANZA, MEMBER DATE: _____
2318 SUPREME DRIVE
EDINBURG, TEXAS 78542

MELISSA YOLANDA CARRANZA, MEMBER DATE: _____
2318 SUPREME DRIVE
EDINBURG, TEXAS 78542

STATE OF TEXAS
COUNTY OF HIDALGO

BEFORE ME, THE UNDERSIGNED AUTHORITY, ON THIS DAY PERSONALLY APPEARED JULIO CESAR CARRANZA, KNOWN TO ME TO BE THE PERSON WHOSE NAME IS SUBSCRIBED TO THE FOREGOING INSTRUMENT, AND ACKNOWLEDGED TO ME THAT THEY EXECUTED THE SAME FOR THE PURPOSED AND CONSIDERATION THEREIN GIVEN UNDER MY HAND AND SEAL OF OFFICE, THIS THE _____ DAY OF _____, 20__

NOTARY PUBLIC, HIDALGO COUNTY, TEXAS
MY COMMISSION EXPIRES:

STATE OF TEXAS
COUNTY OF HIDALGO

BEFORE ME, THE UNDERSIGNED AUTHORITY, ON THIS DAY PERSONALLY APPEARED MELISSA YOLANDA CARRANZA, KNOWN TO ME TO BE THE PERSON WHOSE NAME IS SUBSCRIBED TO THE FOREGOING INSTRUMENT, AND ACKNOWLEDGED TO ME THAT THEY EXECUTED THE SAME FOR THE PURPOSED AND CONSIDERATION THEREIN GIVEN UNDER MY HAND AND SEAL OF OFFICE, THIS THE _____ DAY OF _____, 20__


NOTARY PUBLIC, HIDALGO COUNTY, TEXAS
MY COMMISSION EXPIRES:

STATE OF TEXAS
COUNTY OF HIDALGO:

I, THE UNDERSIGNED, MARIO A. REYNA, A LICENSED PROFESSIONAL ENGINEER IN THE STATE OF TEXAS, DO HEREBY CERTIFY THAT THE PROPER ENGINEERING CONSIDERATION HAS BEEN GIVEN TO THIS PLAT.

MARIO A. REYNA, P.E. # 117368 DATE: _____
DATE PREPARED: 1-10-2017
ENGINEERING JOB NO. 16199.00


MELDEN & HUNT, INC. TEXAS REGISTRATION F-1435

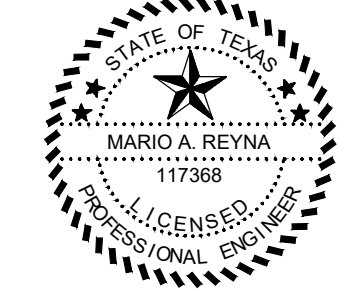

STATE OF TEXAS
COUNTY OF HIDALGO:

I, THE UNDERSIGNED, FRED L. KURTH, A REGISTERED PROFESSIONAL LAND SURVEYOR, IN THE STATE OF TEXAS, DO HEREBY CERTIFY THAT THE HEREIN PRESENTED PLAT AND DESCRIPTION OF ALBERTA VILLAGE SUBDIVISION, WERE PREPARED FROM A SURVEY OF THE PROPERTY MADE ON THE GROUND BY ME OR UNDER MY SUPERVISION ON 1-10-17, AND THAT IT IS A TRUE AND ACCURATE REPRESENTATION OF THE SUBDIVISION OF THE LANDS HEREON DESCRIBED.

FRED L. KURTH, R.P.L.S. # 4750 DATE SURVEYED: 7-05-17
T- 1041, PGS. 9-12
SURVEY JOB NO. 16199.08

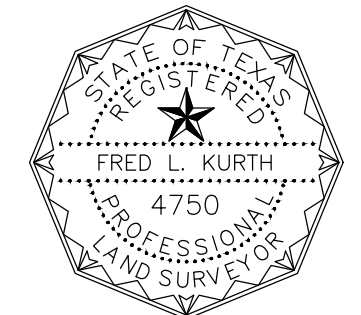

MELDEN & HUNT, INC.
TEXAS REGIST. F-1435
MELDEN & HUNT INC.
CONSULTANTS ENGINEERS SURVEYORS
115 W. MCINTYRE EDINBURG, TX. 78541
227 N. FM. 3167 RIO GRANDE CITY, TX. 78582
E-MAIL: www.meldenandhunt.com
ESTABLISHED 1947

DRAWN BY: CIRO/EM DATE 01-10-2017
SURVEYED, CHECKED DATE _____
FINAL CHECK DATE _____

Lot Area Table			Lot Area Table		
Lot #	SQ. FT.	Area	Lot #	SQ. FT.	Area
1	10643.20	0.244	18	6059.73	0.139
2	5570.64	0.128	19	5457.35	0.125
3	5570.64	0.128	20	5570.70	0.128
4	5570.85	0.128	21	5570.70	0.128
5	5570.70	0.128	22	5570.70	0.128
6	5570.70	0.128	23	5570.70	0.128
7	5570.70	0.128	24	5570.70	0.128
8	5570.70	0.128	25	5824.26	0.134
9	5824.48	0.134	26	5824.26	0.134
10	5824.48	0.134	27	5570.70	0.128
11	5570.70	0.128	28	5570.70	0.128
12	5570.70	0.128	29	5570.70	0.128
13	5570.70	0.128	30	5570.70	0.128
14	5570.70	0.128	31	5570.70	0.128
15	5570.70	0.128	32	5570.70	0.128
16	5457.35	0.125	33	5570.70	0.128
17	6059.73	0.139	34	8264.38	0.190

Curve Table						
Curve #	Length	Radius	Delta	Chord Direction	Chord Length	Tangent
C1	52.35	50.00	059° 59' 36"	S21° 29' 58"E	50.00'	28.86'
C2	52.35	50.00	059° 59' 36"	S38° 29' 38"W	49.99'	28.86'
C3	52.36	50.00	060° 00' 00"	N38° 29' 50"E	50.00'	28.87'
C4	52.36	50.00	060° 00' 00"	N21° 30' 10"W	50.00'	28.87'
C5	110.71	50.00	126° 52' 06"	S35° 03' 41"W	89.44'	100.00'
C6	110.71	50.00	126° 52' 06"	N18° 04' 02"W	89.44'	100.00'
C7	20.18	50.00	023° 07' 48"	N56° 55' 55"E	20.05'	10.23'
C8	20.18	50.00	023° 07' 48"	S39° 56' 16"E	20.05'	10.23'

Lot Line Table		
Line #	Length	Direction
L1	43.25	N81° 30' 10"W
L2	80.00	S08° 29' 50"W
L3	43.25	S81° 30' 10"E
L4	15.00	S08° 29' 50"W
L5	35.36	S53° 29' 50"W
L6	35.36	S36° 30' 10"E
L7	27.70	N08° 29' 50"E
L8	27.70	N08° 29' 50"E
L9	27.70	S08° 29' 50"W
L10	27.70	S08° 29' 50"W

LOCATION OF SUBDIVISION WITH RESPECT TO THE EXTRATERRITORIAL JURISDICTION OF A MUNICIPALITY:

ALBERTA VILLAGE SUBDIVISION IS LOCATED IN THE SOUTHEAST PART OF HIDALGO COUNTY ON THE NORTH SIDE OF ALBERTA ROAD, APPROXIMATELY 0.36 OF ONE MILE EAST OF ITS INTERSECTION WITH "I" ROAD AND ALBERTA ROAD, THE OFFICIAL NEARBY MUNICIPALITY IS THE CITY OF EDINBURG, ACCORDING TO THE OFFICIAL MAP IN THE OFFICE OF THE SECRETARY OF THE CITY OF EDINBURG (POPULATION: 83,920). ALBERTA VILLAGE LIES APPROXIMATELY 0.1 MILE FROM THE CITY LIMITS (AND IS WITHIN THE 2-MILE EXTRATERRITORIAL JURISDICTION (ETJ) UNDER LOCAL GOVERNMENT CODE § 212.001 AND 42.021. THIS SUBDIVISION FALLS WITHIN PRECINCT 4.

PRINCIPAL CONTACTS	NAME	ADDRESS	CITY & ZIP	PHONE	FAX
OWNER:	CARRANZA DEVELOPMENT LLC	2318 SUPREME DRIVE	EDINBURG, TX 78542	(956) 207-0987	FAX
ENGINEER:	MARIO A. REYNA	115 W. MCINTYRE	EDINBURG, TX 78541	(956) 381-0981	(956) 381-1839
SURVEYOR:	FRED L. KURTH	115 W. MCINTYRE	EDINBURG, TX 78541	(956) 381-0981	(956) 381-1839



INDEX TO SHEET OF ALBERTA VILLAGE

- SHEET 1: HEADING; INDEX; LOCATION MAP AND ETJ; PRINCIPAL CONTACTS; MAP; LOT, STREET, AND EASEMENT LAYOUT; DESCRIPTION (METES AND BOUNDS); SURVEYOR'S CERTIFICATION; PLAT NOTES AND RESTRICTIONS; OWNER'S DEDICATION, CERTIFICATION, ATTESTATION; ENGINEERING CERTIFICATION CITY; APPROVAL CERTIFICATE; COUNTY CLERK'S RECORDING CERTIFICATE; REVISION NOTES, IRRIGATION DISTRICT, H.C.D.D. NO. 1.
- SHEET 2: ENGINEERING REPORT, INCLUDING DESCRIPTION OF WATER AND WASTE WATER / SANITARY SEWER AND ENGINEERS CERTIFICATION (ENGLISH AND SPANISH VERSION).
- SHEET 3: MAP OF TOPOGRAPHY AND DRAINAGE; DRAINAGE REVISION NOTES, DRAINAGE REPORT, INCLUDING DESCRIPTION OF DRAINAGE AND DITCH WIDENING, ENGINEERING CERTIFICATION; CONSTRUCTION DETAILS.




FILED FOR RECORD IN
HIDALGO COUNTY
ARTURO GUAJARDO, JR.
HIDALGO COUNTY CLERK

ON: _____ AT _____ AM/PM

INSTRUMENT NUMBER _____ OF THE MAP RECORDS OF HIDALGO COUNTY, TEXAS

BY: _____ DEPUTY

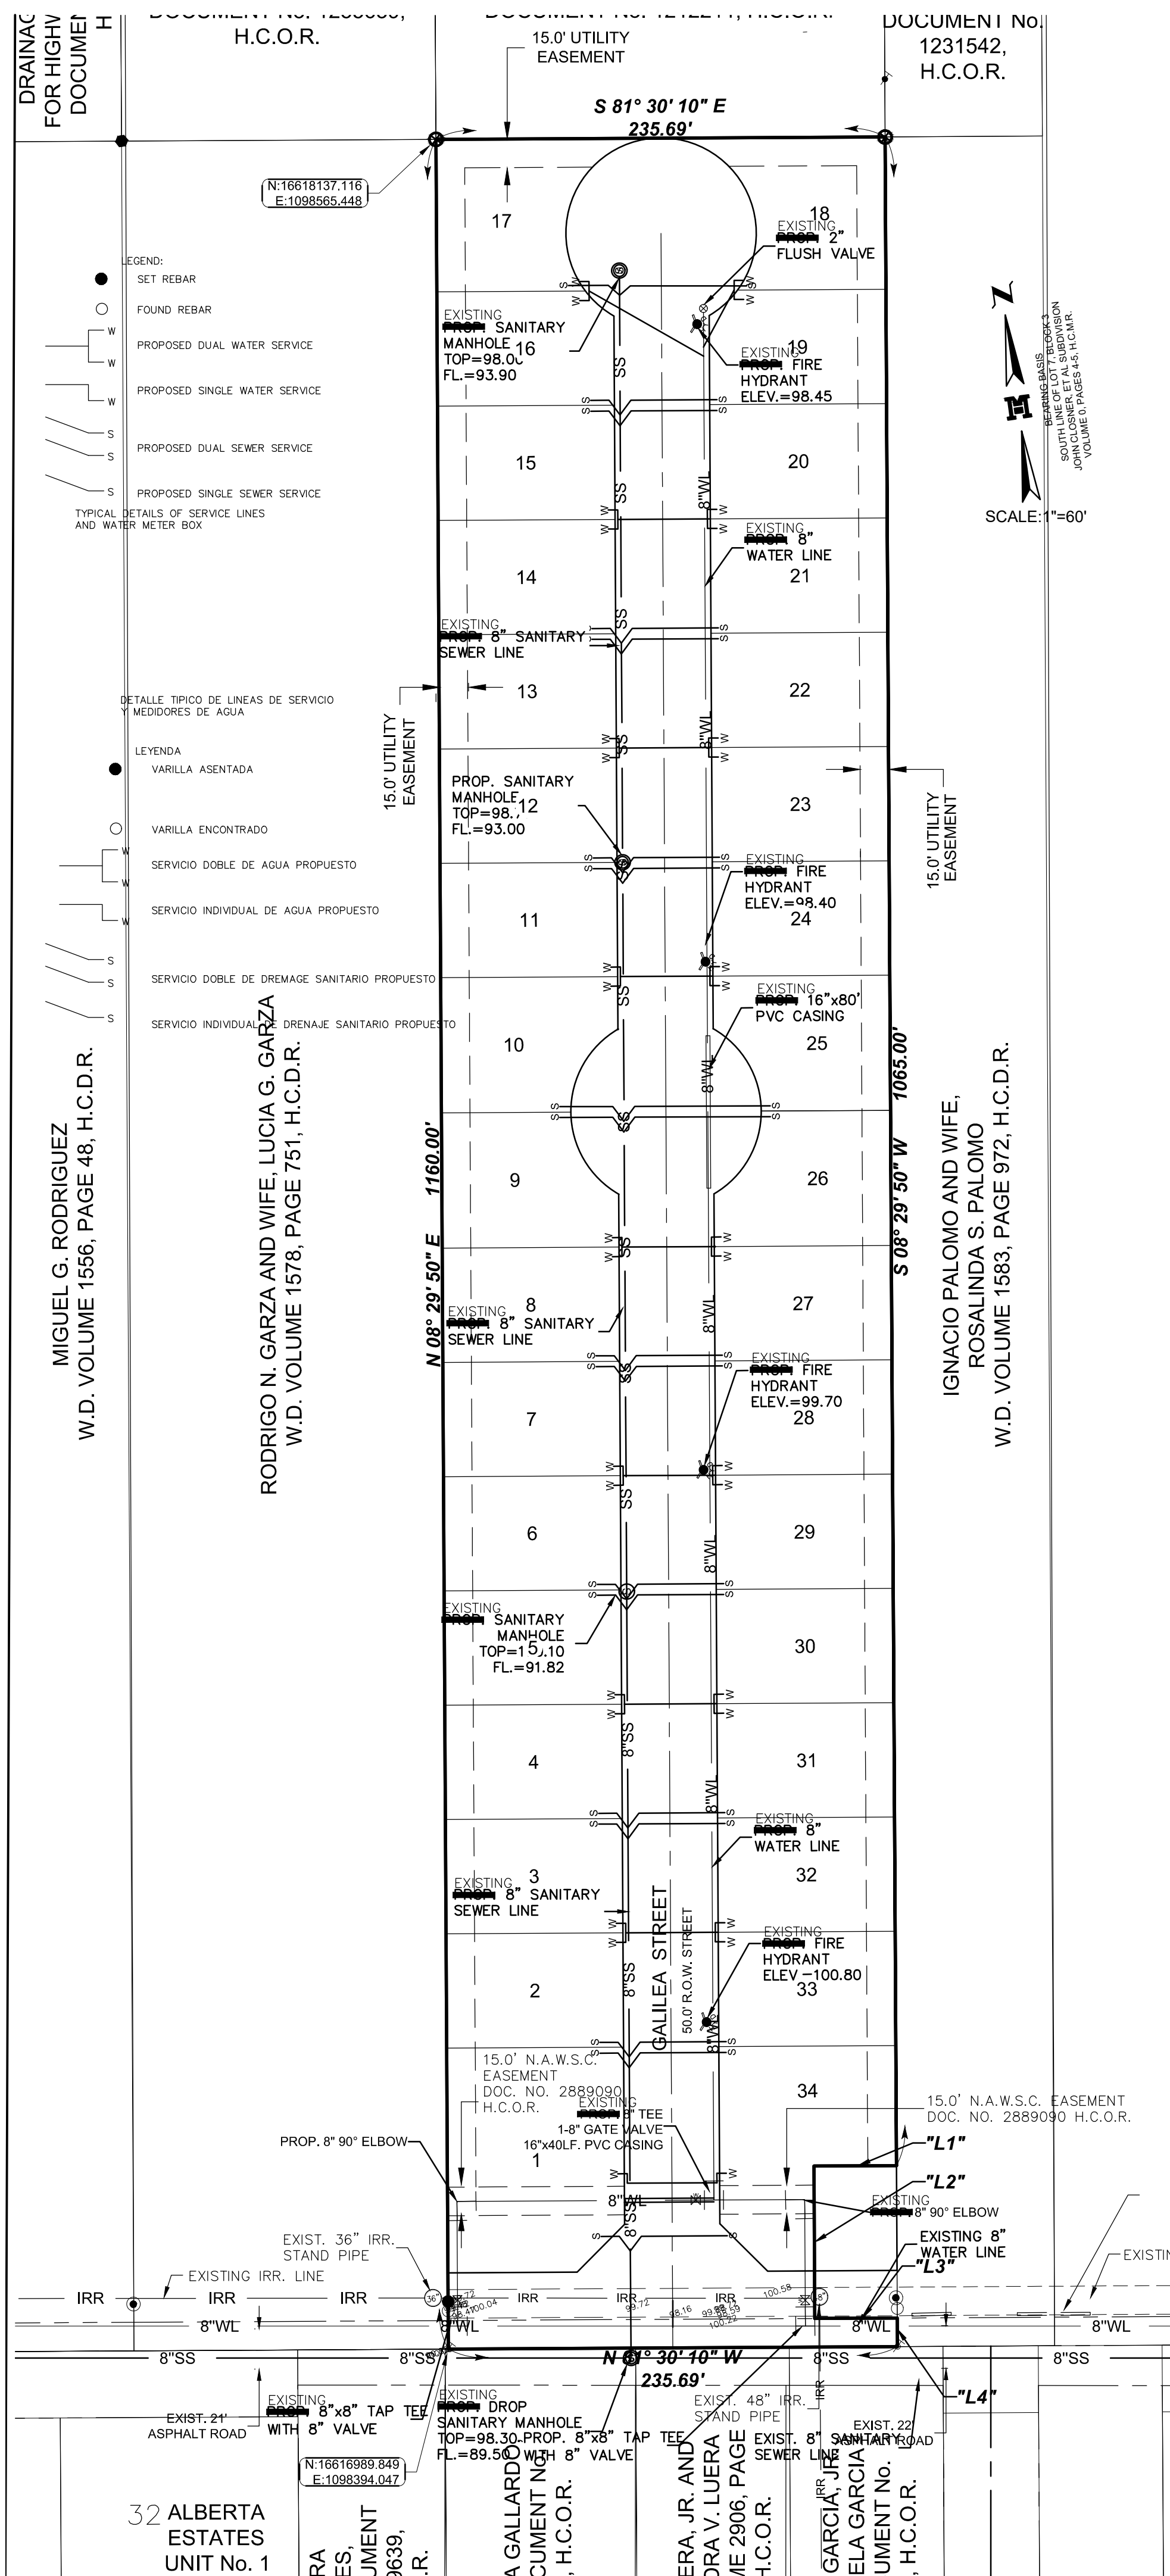

WATER SUPPLY: DESCRIPTION, COST, AND OPERABILITY DATE:

ALBERTA VILLAGE WILL BE PROVIDED WITH POTABLE WATER BY NORTH ALAMO WATER SUPPLY CORPORATION (N.A.W.S.C.). THE SUBDIVIDER AND N.A.W.S.C. HAVE ENTERED INTO A CONTRACT IN WHICH N.A.W.S.C. HAS PROMISED TO PROVIDE SUFFICIENT WATER TO THE SUBDIVISION FOR AT LEAST 30 YEARS AND N.A.W.S.C. HAS PROVIDED DOCUMENTATION TO SUFFICIENTLY ESTABLISH THE LONG TERM QUANTITY AND QUALITY OF THE AVAILABLE WATER SUPPLIES TO SERVE THE FULL DEVELOPMENT OF THIS SUBDIVISION.

N.A.W.S.C. HAS AN EXISTING 8" DIAMETER WATER LINE RUNNING ALONG AND WITHIN THE NORTH RIGHT-OF-WAY OF ALBERTA ROAD. THE WATER SYSTEM FOR ALBERTA VILLAGE CONSISTS OF AN 8" DIAMETER WATER LINE THAT TAPS INTO THE EXISTING 8" LINE IN TWO PLACES. THIS 8" WATER LINE CONNECTS TO THE EXISTING 8" WATER LINE AT THE SOUTHWEST CORNER OF LOT 1 RUNNING NORTH INTO A N.A.W.S.C. EASEMENT THEN THE 8" LINE THEN RUNS EAST TO THE EAST LINE OF LOT 34 THEN RUNS SOUTH CONNECTING TO THE EXISTING 8" WATER LINE. ANOTHER 8" WATER LINE OF LOT 1 CONNECTS TO THE PREVIOUSLY MENTIONED WATER LINE AT THE SOUTHWEST CORNER OF LOT 34 THEN RUNS NORTH ALONG AND WITHIN THE EAST RIGHT-OF-WAY OF GALILEA STREET ENDING WITH A FLUSH VALVE ON THE NORTHWEST CORNER OF LOT 19.

WATER DISTRIBUTION FOR THE ALBERTA VILLAGE CONSISTS OF EIGHTEEN 1/2" DIAMETER DUAL SERVICE LINES RUN TO PAIRS OF LOTS BEFORE SPLITTING INTO 3/4" DIAMETER SERVICE LINES. SAID SERVICES TERMINATE AT THE WATER METER BOXES FOR EACH LOT. THE 8" LINE, THE DUAL SERVICES, AND THE METER BOXES HAVE ALREADY BEEN INSTALLED, AT A TOTAL COST OF \$ 46,830.00, OR \$ 1,377.35 PER LOT. IN ADDITION, THE SUBDIVIDER HAS PAID N.A.W.S.C. THE SUM OF \$ 37,450.00, WHICH COVERS THE \$ 1,101.47 COST PER LOT AS STATED IN THE 30 YEAR WATER SERVICE AGREEMENT WHICH SUM REPRESENTS THE TOTAL COST OF WATER METER, RIGHTS ACQUISITION FEES, AND ALL MEMBERSHIP OR OTHER FEES ASSOCIATED WITH CONNECTING THE INDIVIDUAL LOTS IN THE SUBDIVISION TO N.A.W.S.C. UPON REQUEST BY THE LOT OWNER, N.A.W.S.C. WILL PROMPTLY INSTALL AT NO CHARGE THE WATER METER FOR THAT LOT. THE SUBDIVIDER HAS INSTALLED 4 FIRE HYDRANTS AT A UNIT COST OF \$ 3,200.00 FOR A TOTAL COST OF \$ 12,800.00. THE ENTIRE WATER FACILITIES HAVE BEEN APPROVED AND ACCEPTED BY N.A.W.S.C. AND SAID DISTRIBUTION SYSTEM IS OPERABLE AS OF THE DATE OF THE RECORDING OF THIS PLAT.

WASTEWATER SUPPLY: DESCRIPTION, COST, AND OPERABILITY DATE:

ALBERTA VILLAGE WILL BE TREATED BY WASTEWATER SERVICE FROM CITY OF EDINBURG. THE SUBDIVIDER AND CITY OF EDINBURG HAVE ENTERED INTO A CONTRACT IN WHICH CITY OF EDINBURG HAS PROMISED TO TREAT THE SUFFICIENT WASTEWATER FOR AT LEAST 30 YEARS AND THE CITY OF EDINBURG HAS PROVIDED DOCUMENTATION TO SUFFICIENTLY ESTABLISH THE LONG TERM QUANTITY AND QUALITY OF THE AVAILABLE WASTEWATER SUPPLIES TO SERVE THE FULL DEVELOPMENT OF THIS SUBDIVISION.

CITY OF EDINBURG HAS AN EXISTING 8" DIAMETER SEWER LINE RUNNING ALONG THE SOUTH SIDE OF THE RIGHT-OF-WAY OF ALBERTA ROAD. THE WASTEWATER SYSTEM FOR ALBERTA VILLAGE CONSISTS OF AN 8" DIAMETER SEWER LINE THAT TAPS INTO THE EXISTING 8" LINE. THIS 8" LINE THEN RUNS NORTH ALONG AND WITHIN THE WEST RIGHT-OF-WAY OF GALILEA STREET ENDING WITH A 48" SANITARY SEWER MANHOLE ON THE NORTHEAST CORNER OF LOT 17.

FROM THE 8" LINE THIRTY-SIX (36) 4" DIAMETER SEWER SERVICE LINES RUN FOR EACH LOT. THE 8" LINE, 4" SERVICE LINE AND FOUR (4) 48" SANITARY SEWER MANHOLES HAVE BEEN INSTALLED, AT A TOTAL COST OF \$ 48,614.00 OR \$ 1,429.82 PER LOT. IN ADDITION, THE SUBDIVIDER HAS PAID THE CITY OF EDINBURG THE SUM OF \$ 3,060.00 WHICH COVERS THE \$ 90.00 PER LOT AS STATED IN THE 30 YEAR WASTE WATER SERVICE AGREEMENT WHICH SUM REPRESENTS THE TOTAL COST OF THE SERVICES AND ACQUISITION FEES, AND ALL MEMBERSHIP OR OTHER FEES ASSOCIATED WITH CONNECTING THE INDIVIDUAL LOTS IN THE SUBDIVISION TO THE CITY OF EDINBURG. THE ENTIRE WASTE WATER FACILITIES HAVE BEEN APPROVED AND ACCEPTED BY CITY OF EDINBURG AND SAID DISTRIBUTION SYSTEM IS OPERABLE AS OF THE DATE OF THE RECORDING OF THIS PLAT.

ENGINEER CERTIFICATION: BY MY SIGNATURE BELOW, I CERTIFY THAT THE WATER AND SEWAGE SERVICE FACILITIES DESCRIBED ABOVE ARE IN COMPLIANCE WITH THE MODEL RULES ADOPTED UNDER SECTION 16.343, WATER CODE. I CERTIFY THAT THE COSTS TO INSTALL WATER AND SEWAGE FACILITIES, DISCUSSED ABOVE, ARE AS FOLLOWS:

WATER FACILITIES - THESE FACILITIES FULLY CONSTRUCTED, WITH THE INSTALLATION OF WATER METERS, WILL COST A GRAND TOTAL OF \$ 84,280.00 WHICH EQUALS TO \$ 2,478.82 PER LOT.

SEWAGE FACILITIES - THESE FACILITIES FULLY CONSTRUCTED WILL COST A GRAND TOTAL OF \$ 51,674.00 WHICH EQUALS TO \$ 1,519.82 PER LOT.

STATE OF TEXAS
COUNTY OF HIDALGO

BEFORE ME, THE UNDERSIGNED AUTHORITY, ON THIS DAY PERSONALLY APPEARED JULIO CESAR CARRANZA, KNOWN TO ME, THE PERSON WHOSE NAME IS SUBSCRIBED TO THE FOREGOING INSTRUMENT AND ACKNOWLEDGED TO BE THAT HE EXECUTED THE SAME FOR PURPOSED AND CONSIDERATION THEREIN STATED, GIVEN UNDER MY HAND AND SEAL OF OFFICE

THIS THE _____ DAY OF _____, 20____

STATE OF TEXAS
COUNTY OF HIDALGO

BEFORE ME, THE UNDERSIGNED AUTHORITY, ON THIS DAY PERSONALLY APPEARED MELISSA YOLANDA CARRANZA, KNOWN TO ME, THE PERSON WHOSE NAME IS SUBSCRIBED TO THE FOREGOING INSTRUMENT AND ACKNOWLEDGED TO BE THAT HE EXECUTED THE SAME FOR PURPOSED AND CONSIDERATION THEREIN STATED, GIVEN UNDER MY HAND AND SEAL OF OFFICE

THIS THE _____ DAY OF _____, 20____

STATE OF TEXAS
COUNTY OF HIDALGO

PROVISIÓN DE AGUA: DESCRIPCIÓN, GASTOS Y FECHAS DE INICIO

N.A.W.S.C. HA PRESENTADO DOCUMENTACIÓN PARA DEMOSTRAR A LARGO PLAZO LA CANTIDAD Y CALIDAD DE AGUA ACCESIBLE PARA SERVIR EL FUTURO DESARROLLO DE LA SUBDIVISION.

EL SISTEMA DE PROVISIÓN DE AGUA PARA LA SUBDIVISION ALBERTA VILLAGE CONSISTE DE UN CONDUCTO DE AGUA DE 8 PULGADAS DE DIÁMETRO QUE PASA POR EL LADO NORTE DEL DERECHO DE VÍA (RIGHT OF WAY) DE LA CARRETERA ALBERTA ROAD. EL SISTEMA DE PROVISIÓN DE AGUA DE LA SUBDIVISION ALBERTA VILLAGE CONSISTE DE UN CONDUCTO DE AGUA DE 8 PULGADAS DE DIÁMETRO QUE SE CONECTA CON EL CONDUCTO DE AGUA EXISTENTE DE 8 PULGADAS EN DOS LUGARES. ESTA LINEA DE 8 PULGADAS QUAL SE CONECTA A LA LINEA EXISTENTE DE 8 PULGADAS EN EL LADO SURESTE DE LOTE 1 CORRIENDO AL NORTE DENTRO DE UNA CONSECCION DE 15 PIES DE N.A.W.S.C. LUEGO CORE AL ESTE A LA LINEA ESTE DE LOTE 34 LUEGO CORE AL SUR CONECTANDO A LA CONDUCTO DE AGUA EXISTENTE EN EL LADO SURESTE DE LOTE 34. TORA LINEA DE 8 PULGADAS SE CONECTA A LA LINEA DE AGUE PREVIAMENTE MONSEONADA Y CUAL SIGUE HACIA EL NORTE POR EL LADO ESTE DE LA CALLE GALILEA STREET, TERMINARA CON UNA VALVULA DE PRESION DE 2 PULGADAS DE DIÁMETRO LOCALIZADA AL NOROESTE DE LOTE 20.

DEL CONDUCTO DE AGUA DE 8 PULGADAS SE PRODUCEN DIECIOCHO CONDUCTOS DE AGUA DE 1 PULGADA DE DIÁMETRO PARA CADA DOS LOTES. ESTOS CONDUCTOS SE SEPARAN PARA PRODUCIR DOS CONDUCTOS DE AGUA DE 3/4 DE PULGADA DE DIÁMETRO PARA CADA LOTE. SE HAN INSTALADO EL CONDUCTO DE AGUA DE 8 PULGADAS DE DIÁMETRO, LOS DOBLE CONDUCTOS DE AGUA DE 1 PULGADA DE DIÁMETRO, EL CONDUCTO DE 3/4 DE PULGADA DE DIÁMETRO, Y LOS MEDIDORES MECANICOS DE AGUA A UN COSTO TOTAL DE \$ 46,830.00 O \$ 1,377.35 POR LOTE. EL DUEÑO DE LA SUBDIVISION TAMBIEN LE HA PAGADO A LA COMPAÑIA N.A.W.S.C. \$ 37,450.00, QUE CUBRE EL COSTO DEL MEDIDOR MECANICO DE AGUA PARA CADA LOTE, \$ 1,101.47. ESTE PRECIO INCLUYE EL COSTO DE LA INSTALACION DE CADA MEDIDOR Y LOS GASTOS DE CONEXION. CUANDO EL DUEÑO DE CADA LOTE SOLICITE UN MEDIDOR DE AGUA, LA COMPAÑIA N.A.W.S.C. LO INSTALARA SIN ALGUN GASTO AL DUEÑO. EL DUEÑO DE LA SUBDIVISION TAMBIEN HA INSTALADO 4 BOCAS DE RIEGO (FIRE HYDRANT) A UN COSTO DE \$ 3,200.00 POR CADA UNO CUAL GASTA CANTIDAD TOTAL \$12,800.00. EL SISTEMA DE AGUA ESTARA EN FUNCIONAMIENTO COMPLETO ANTES O EN LA FECHA, EN LA CUAL LA SUBDIVISION SEA REGISTRADA EN EL CONDADO DE HIDALGO.

DRENAJE: DESCRIPCIÓN, GASTOS Y FECHA DE INICIO PARA FACILITAR EL DRENAJE PARA LA SUBDIVISION ALBERTA VILLAGE RECIBIRÁ SU PROVISIÓN DE DRENAJE SANITARIO DE LA CIUDAD DE EDINBURG. EL DUEÑO Y LA CIUDAD DE EDINBURG HAN FIRMADO UN CONTRATO POR EL CUAL LA SUBDIVISION RECIBIRÁ SU PROVISIÓN DE DRENAJE SANITARIO POR LOS PRÓXIMOS 30 AÑOS. LA CIUDAD DE EDINBURG HA PRESENTADO DOCUMENTACIÓN PARA DEMOSTRAR A LARGO PLAZO LA CANTIDAD Y CALIDAD DE DRENAJE SANITARIO ACCESIBLE PARA SERVIR EL FUTURO DESARROLLO DE LA SUBDIVISION.

EL SISTEMA DE PROVISIÓN DE DRENAJE SANITARIO PARA LA SUBDIVISION ALBERTA VILLAGE CONSISTE DE UN CONDUCTO DE DRENAJE DE 8 PULGADAS DE DIÁMETRO QUE PASA POR EL LADO SUR DEL DERECHO DE VÍA (RIGHT OF WAY) DE LA CARRETERA ALBERTA ROAD. EL SISTEMA DE PROVISIÓN DE DRENAJE SANITARIO DE LA SUBDIVISION ALBERTA VILLAGE CONSISTE DE UN CONDUCTO DE DRENAJE DE 8 PULGADAS DE DIÁMETRO QUE SE CONECTA CON EL CONDUCTO DE DRENAJE SANITARIO EXISTENTE DE 8 PULGADAS. ESTA LINEA DE 8 PULGADAS QUAL SIGUE HACIA EL NORTE POR EL LADO OESTE DE LA CALLE GALILEA STREET, TERMINARA CON UNA ALCANTARILLA DE 48 PULGADAS DE DIÁMETRO LOCALIZADA AL NOROESTE DE LOTE 17.

DE ESTAS LINEAS DE DRENAJE SANITARIO DE 8 PULGADAS, TENSASIES (36) LINEAS DE SERVICIO DE 4 PULGADAS SERAN EXTENDIDAS HA CADA LOTE. LA LINEAS DE 8 PULGADAS, DE 4 PULGADAS Y OCHO (4) ALCANTARILLAS HAN SIDO INSTALADAS, HA UN COSTO TOTAL DE \$ 48,614.00 O \$ 1,429.82 POR LOTE. EL DUEÑO DE LA SUBDIVISION TAMBIEN LE HA PAGADO A LA CIUDAD DE EDINBURG UN COSTO TOTAL DE \$ 3,060.00, O \$ 90.00 POR LOTE. EL SISTEMA DE DRENAJE SANITARIO ESTARA EN FUNCIONAMIENTO COMPLETO ANTES O EN LA FECHA, EN LA CUAL LA SUBDIVISION SEA REGISTRADA EN EL CONDADO DE HIDALGO.

CERTIFICACIÓN: CON MI FIRMA, CERTIFICO QUE LOS SERVICIOS Y SISTEMAS DE AGUA Y DE DRENAJE, DESCRITOS EN ESTE DOCUMENTO CUMPLEN CON LAS MODEL SUBDIVISION RULES (LAS REGLAS GOBERNANDO A LAS SUBDIVISIONES), ADOPTADAS EN LA SECCION 16.343 DEL TEXAS WATER CODE (CÓDIGO DE AGUA DE TEXAS). CERTIFICO QUE LOS GASTOS PARA INSTALAR LOS SISTEMAS DE AGUA Y DE DRENAJE SON:

AGUA: EL SISTEMA/SERVICIO DE AGUA SERA INSTALADO Y COMPLETAMENTE CONSTRUIDO MENOS EL MEDIDOR MECANICO DE AGUA QUE COSTARA UN TOTAL DE \$ 84,280.00 O \$ 2,478.82 POR LOTE.


DRENAJE: SE ESTIMA QUE EL DRENAJE COSTARA UN COSTO TOTAL DE \$ 51,674.00 O \$ 1,519.82 POR LOTE.

FIRMA DE INGENIERO _____ FECHA _____




MAP OF WATER DISTRIBUTION SYSTEM MAPA DE SISTEMA DE DISTRIBUCION DE AGUA

SUBDIVISION MAP OF
ALBERTA VILLAGE
A TRACT OF LAND BEING 6.276 ACRES
OUT OF LOT 6, BLOCK 2 AND
LOT 7, BLOCK 3
JOHN CLOSER, ET AL SUBDIVISION
VOL. 0, PGS. 4-5, H.C.M.R.
HIDALGO COUNTY, TEXAS

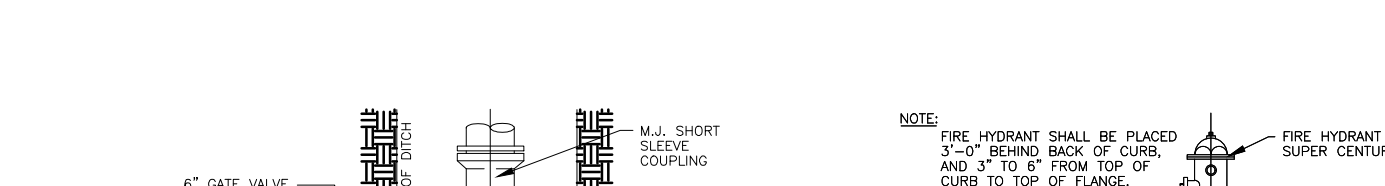


TYPICAL FIRE HYDRANT INSTALLATION

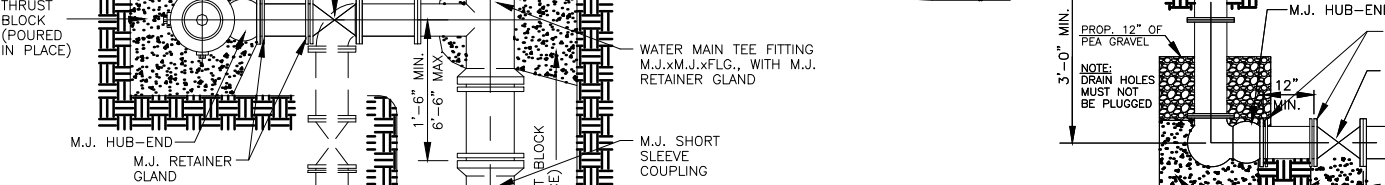

TYPICAL WATER METER INSTALLATION




TYPICAL VALVE and VALVE BOX INSTALLATION

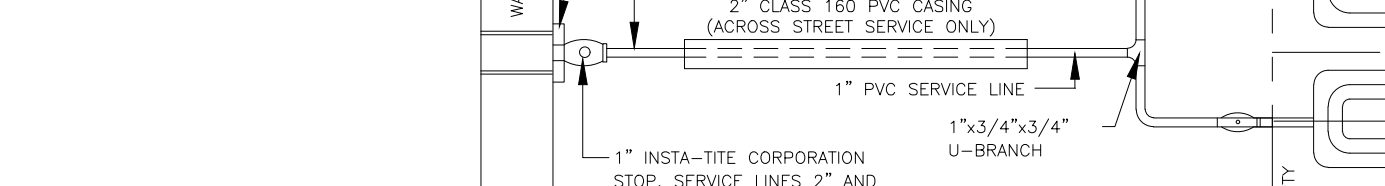






DUAL WATER SERVICE CONNECTION

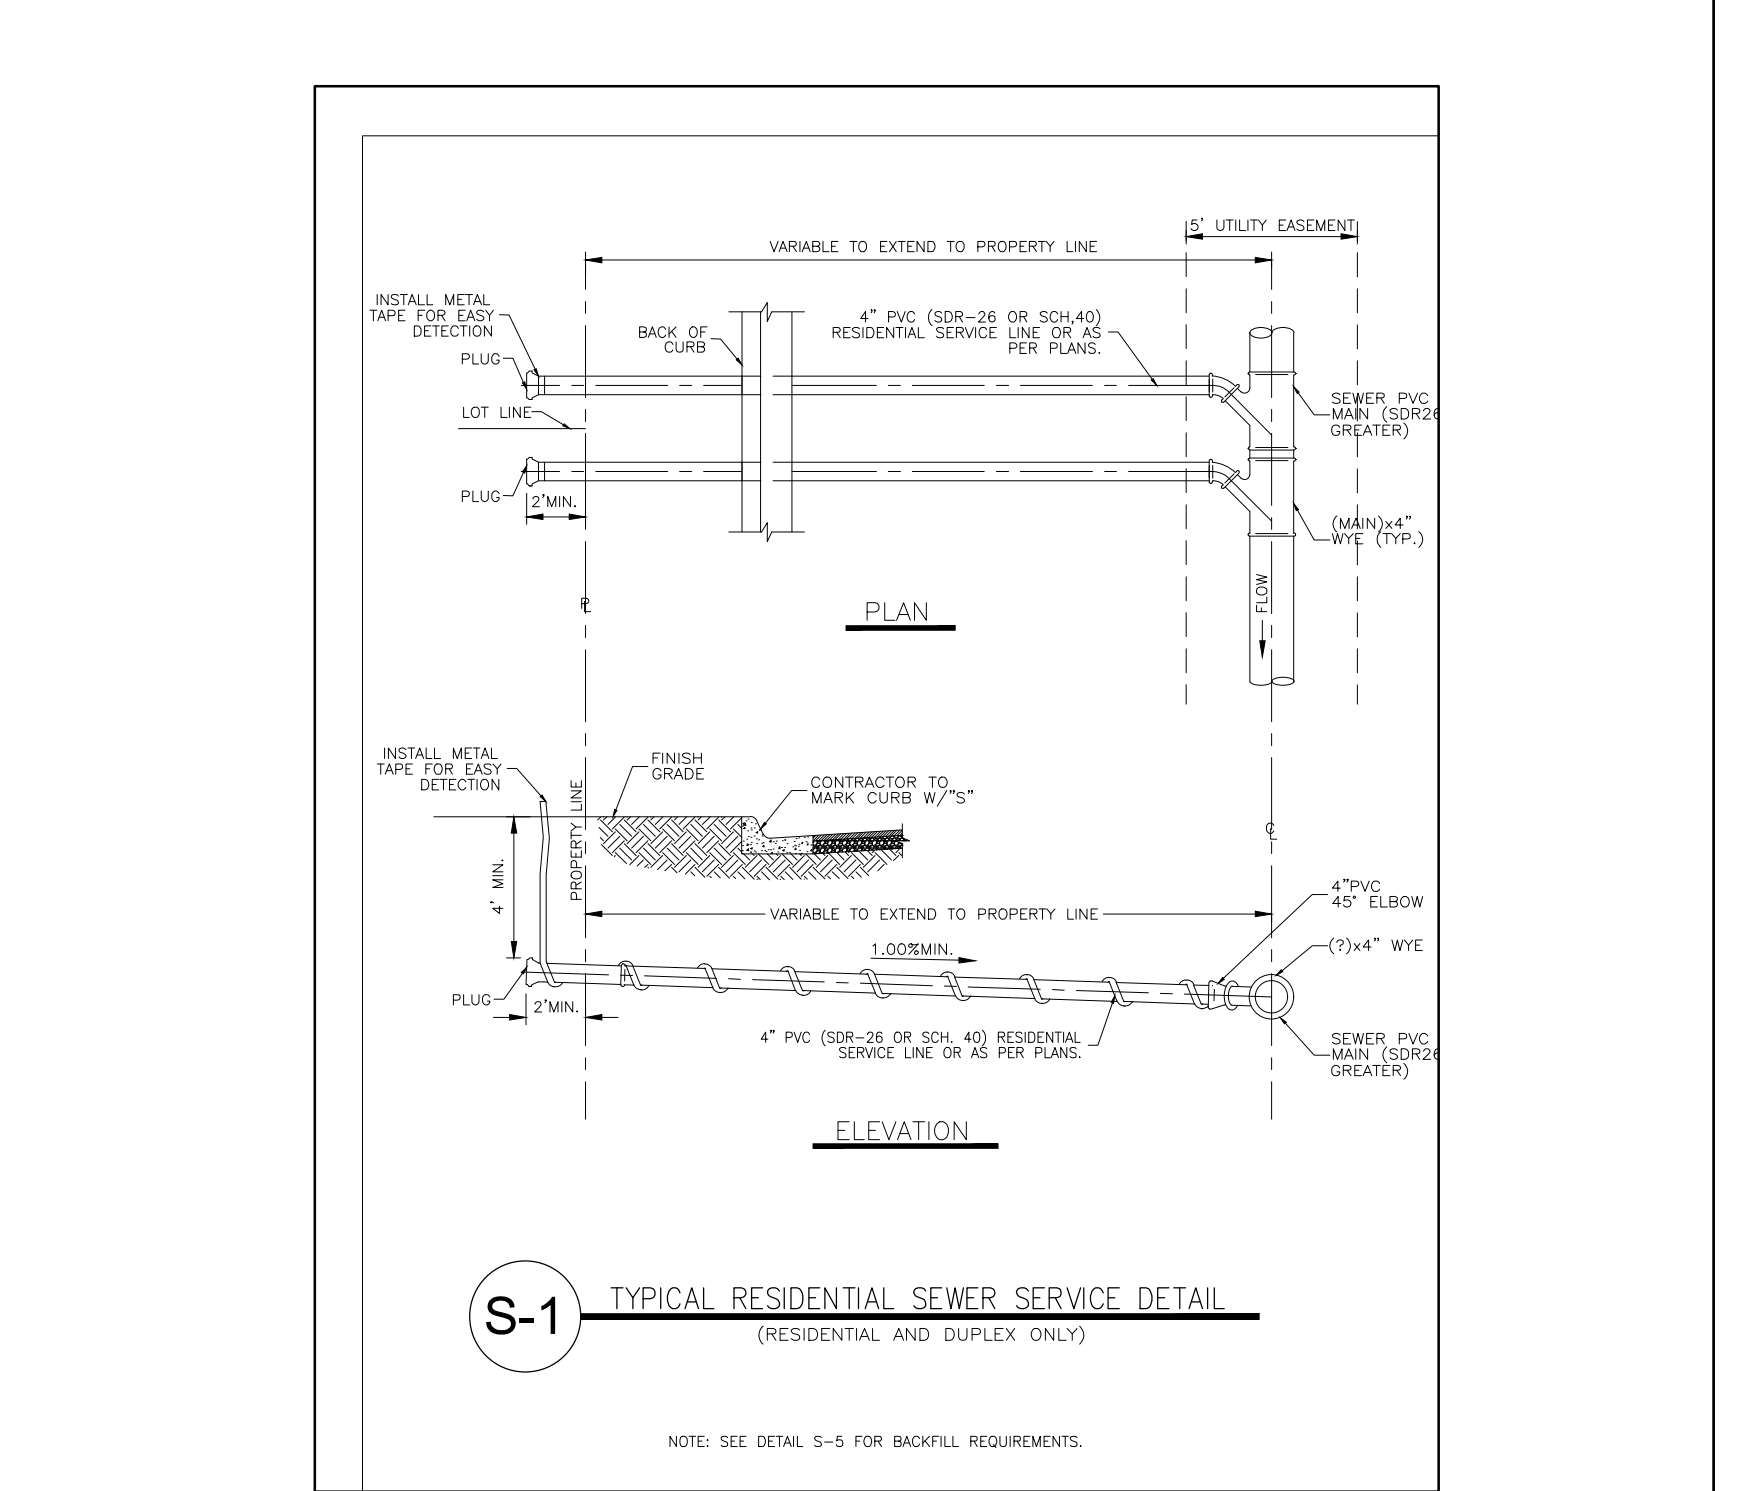


TYPICAL RESIDENTIAL SEWER SERVICE DETAIL

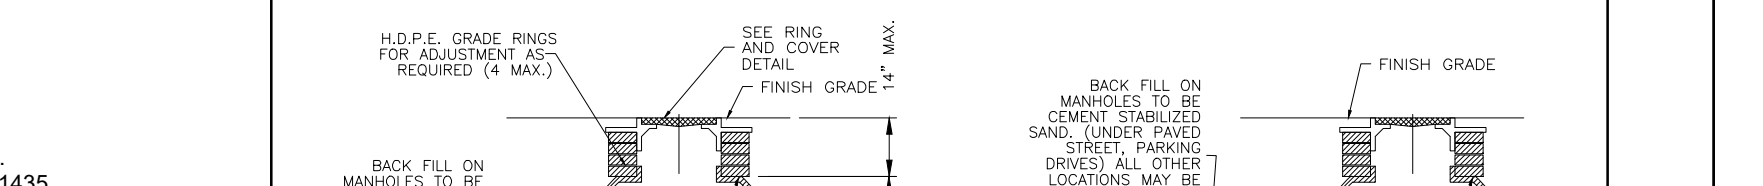


TYPICAL FIBERGLASS MANHOLE With DROP STRUCTURE

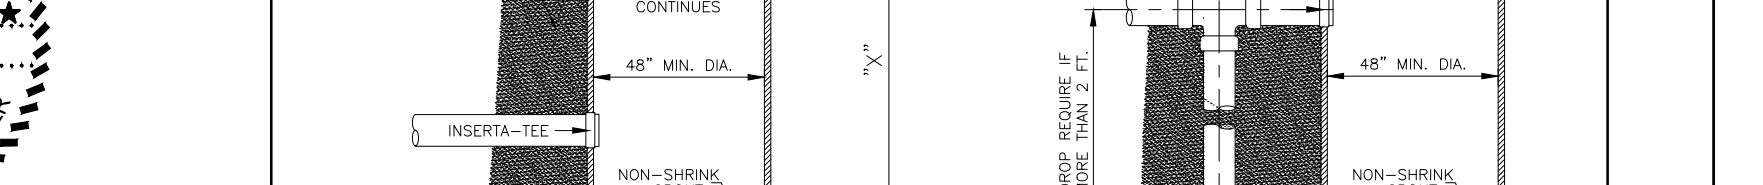



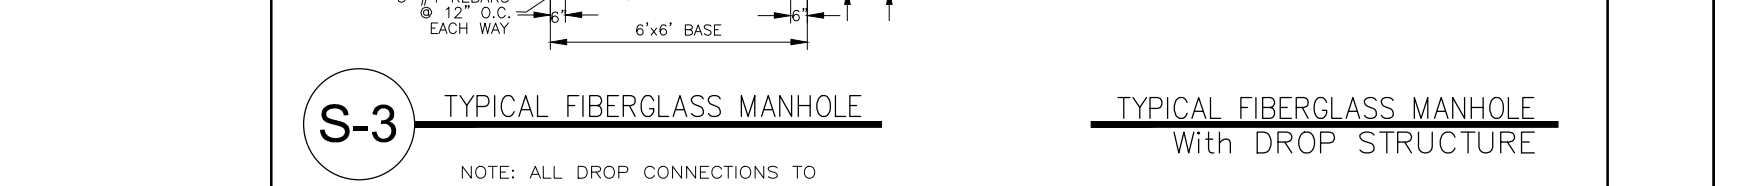


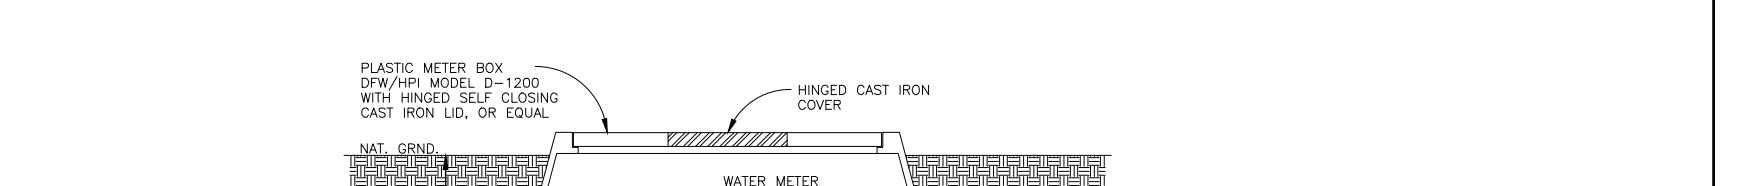



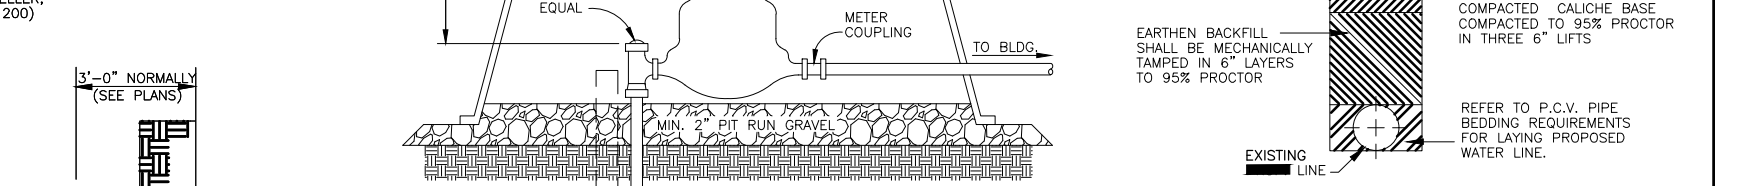


PAVED AND UNPAVED STREET BACKFILL DETAIL




TYPICAL WATER METER INSTALLATION

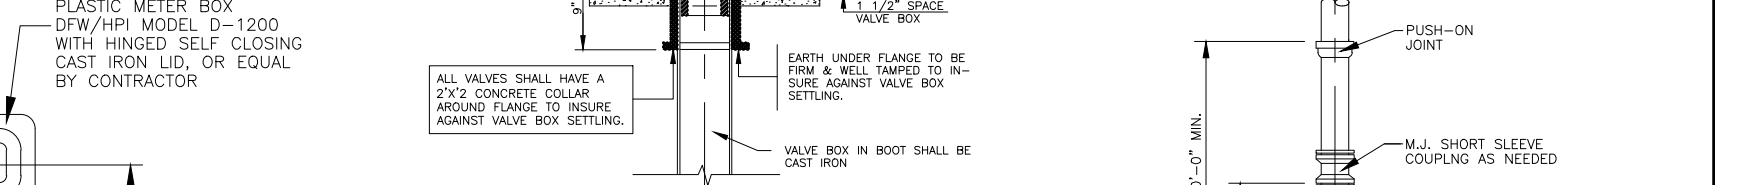







TYPICAL VALVE and VALVE BOX INSTALLATION

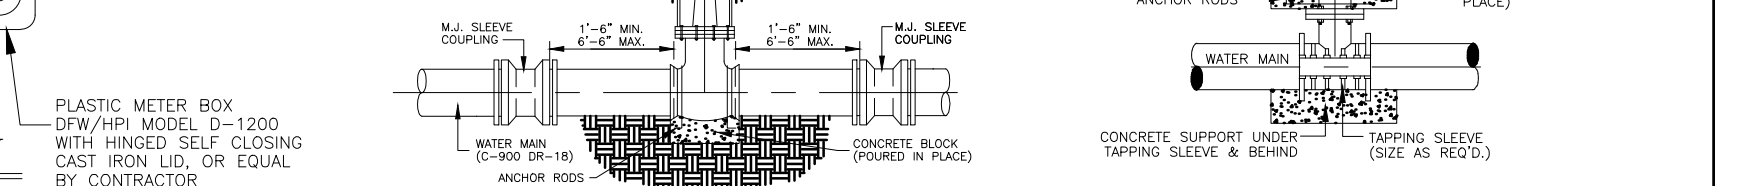






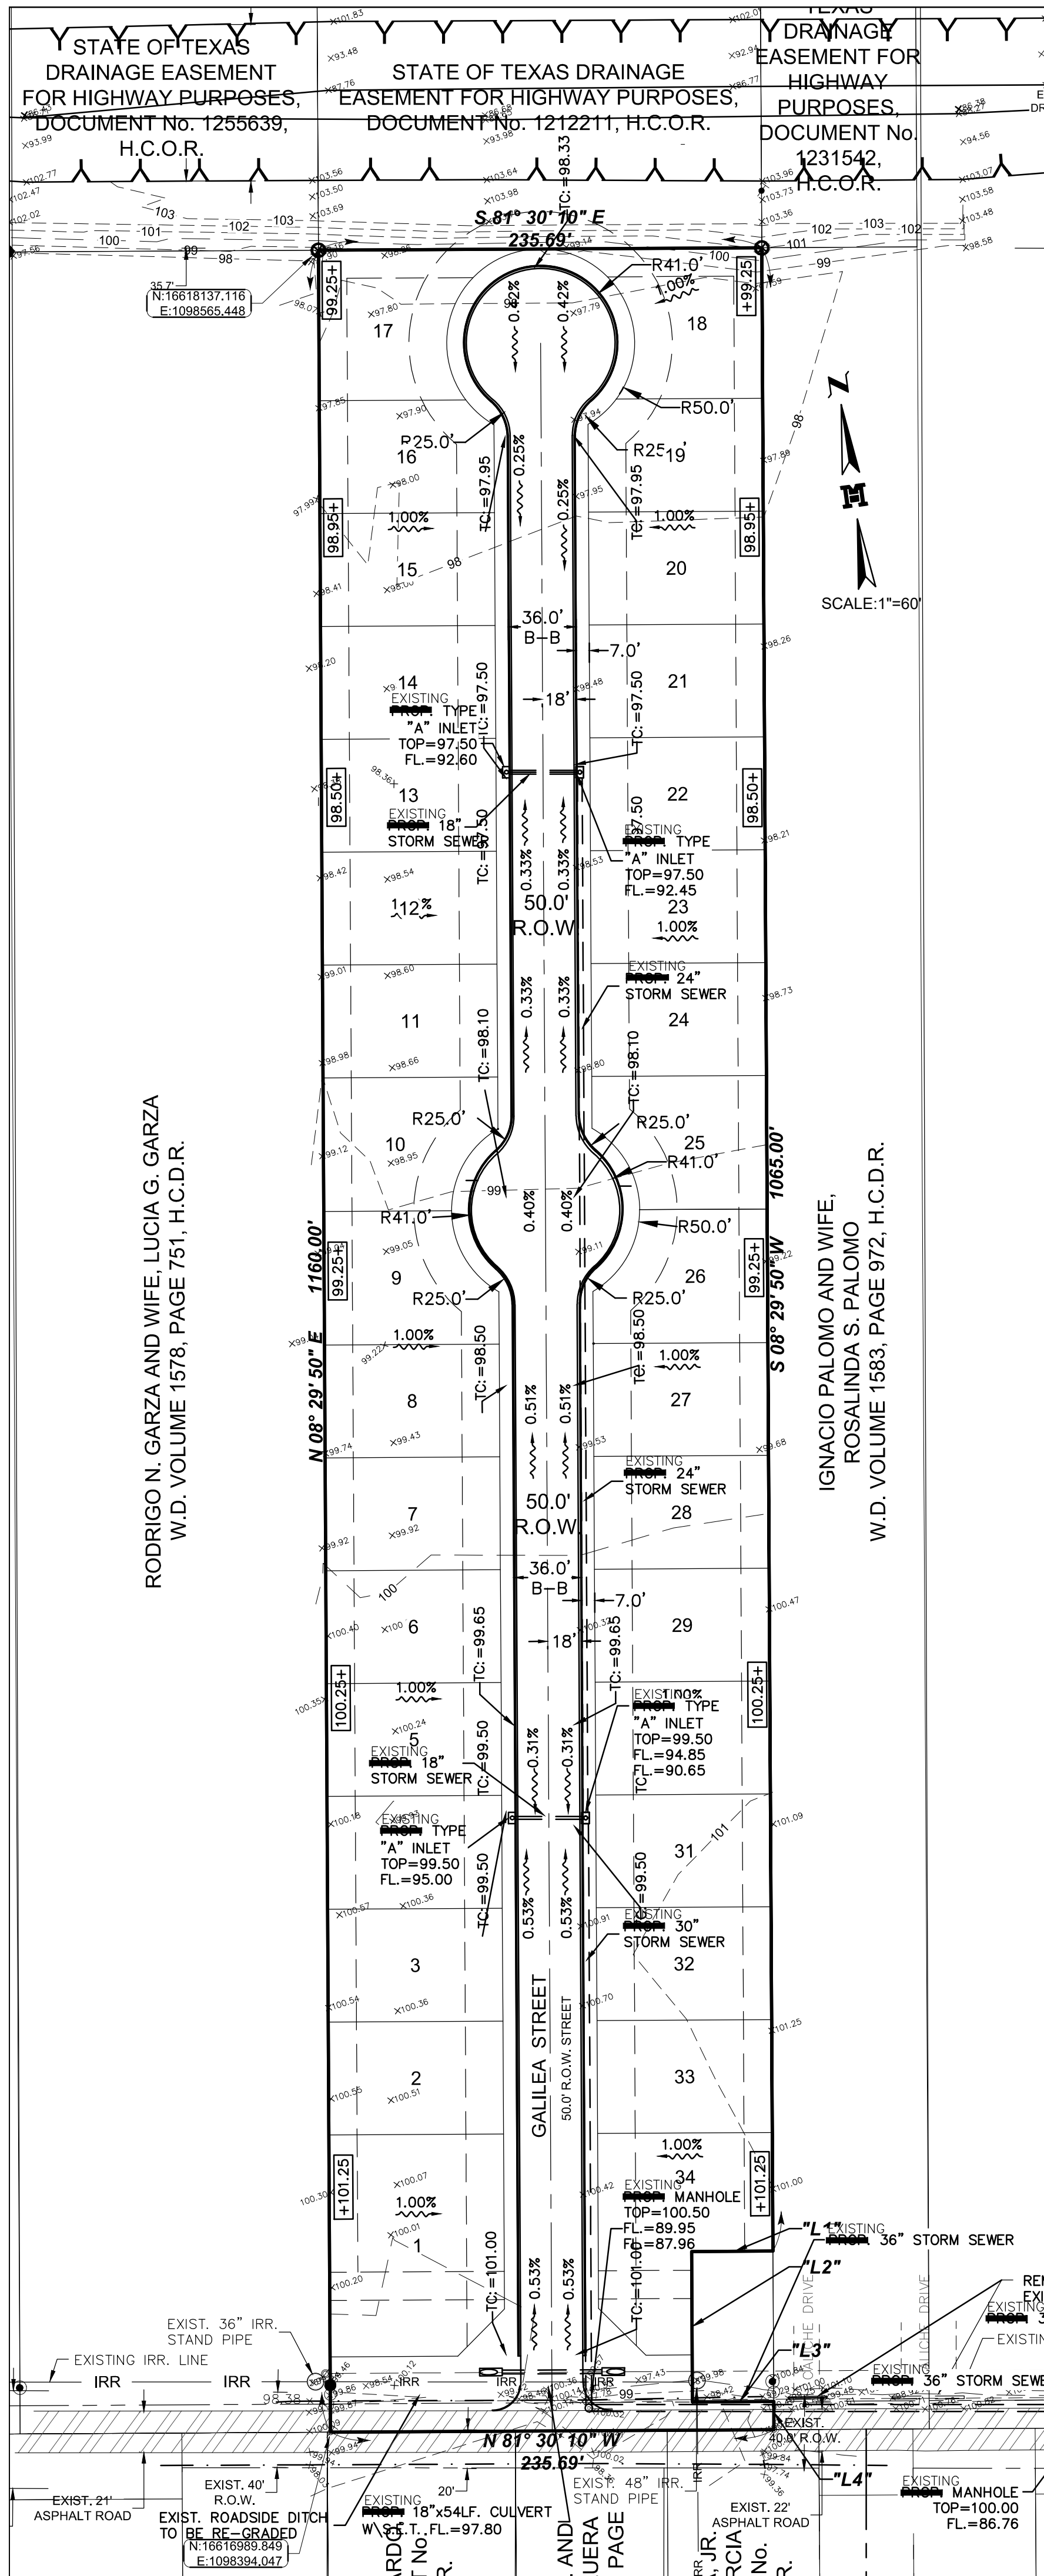

MAP OF TOPOGRAPHY AND DRAINAGE:
MAPA DE TOPOGRAFIA Y DESAGUE:
SUBDIVISION MAP OF
ALBERTA VILLAGE
A TRACT OF LAND BEING 6.276 ACRES
OUT OF LOT 6, BLOCK 2 AND
LOT 7, BLOCK 3
JOHN CLOSNER, ET AL SUBDIVISION
VOL. 0, PGS. 4-5, H.C.M.R.
HIDALGO COUNTY, TEXAS

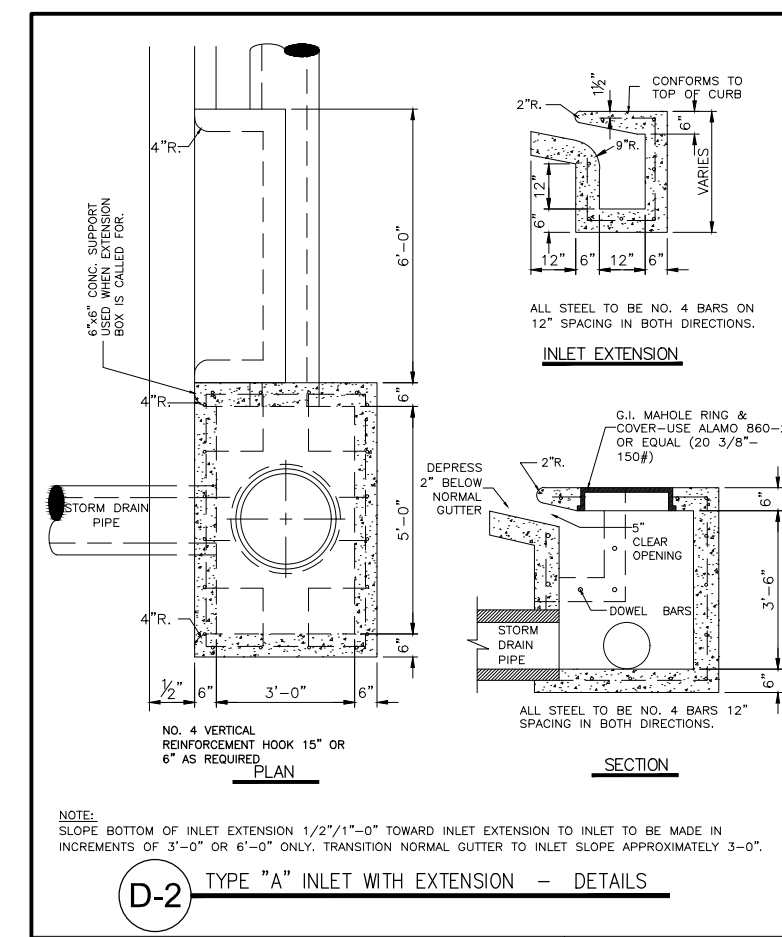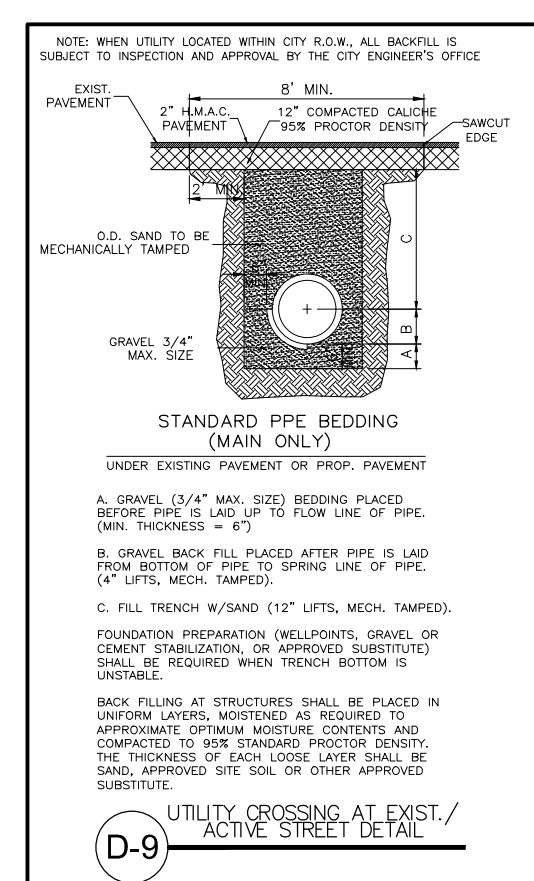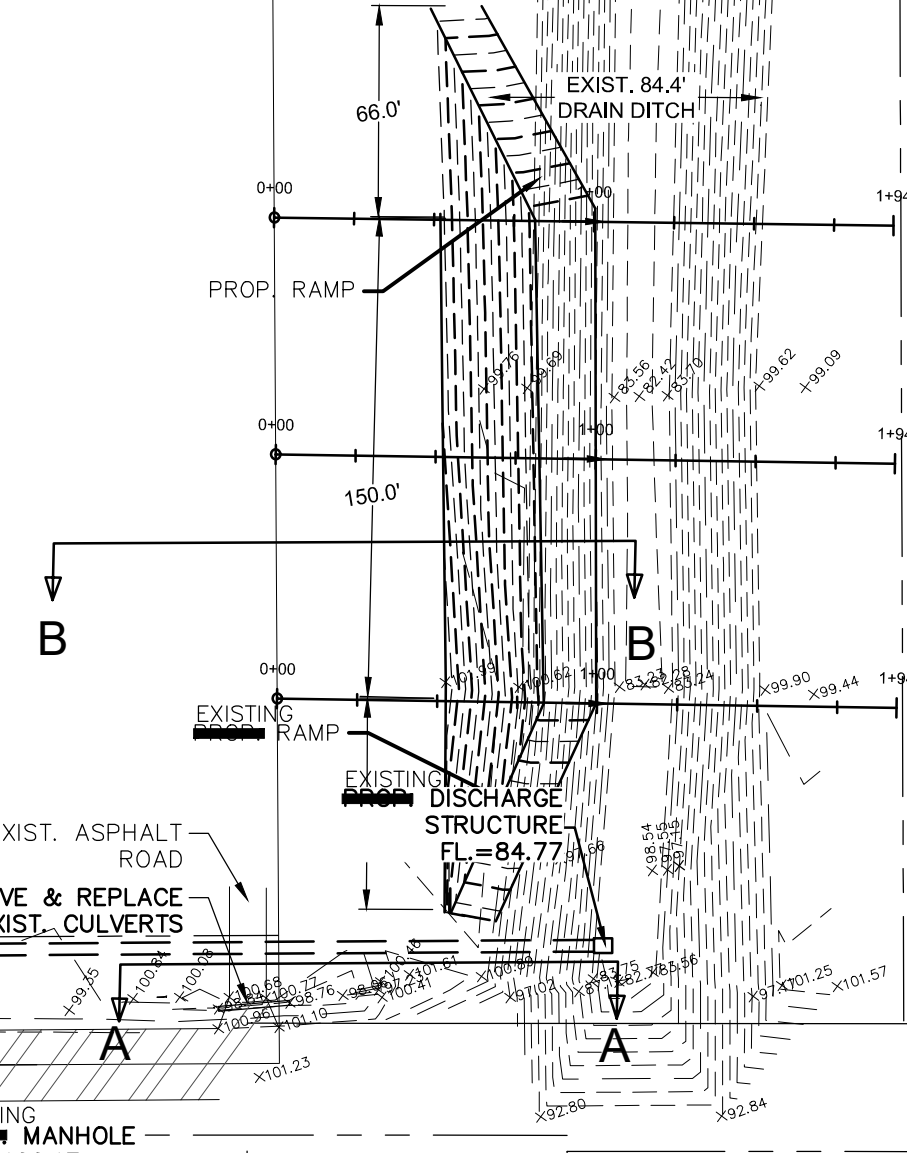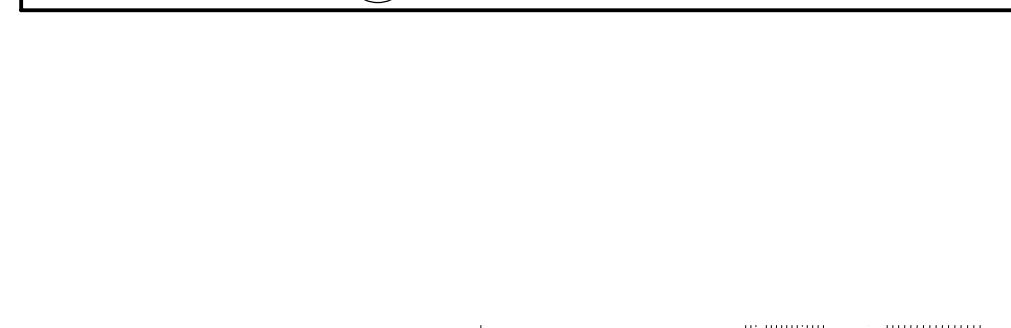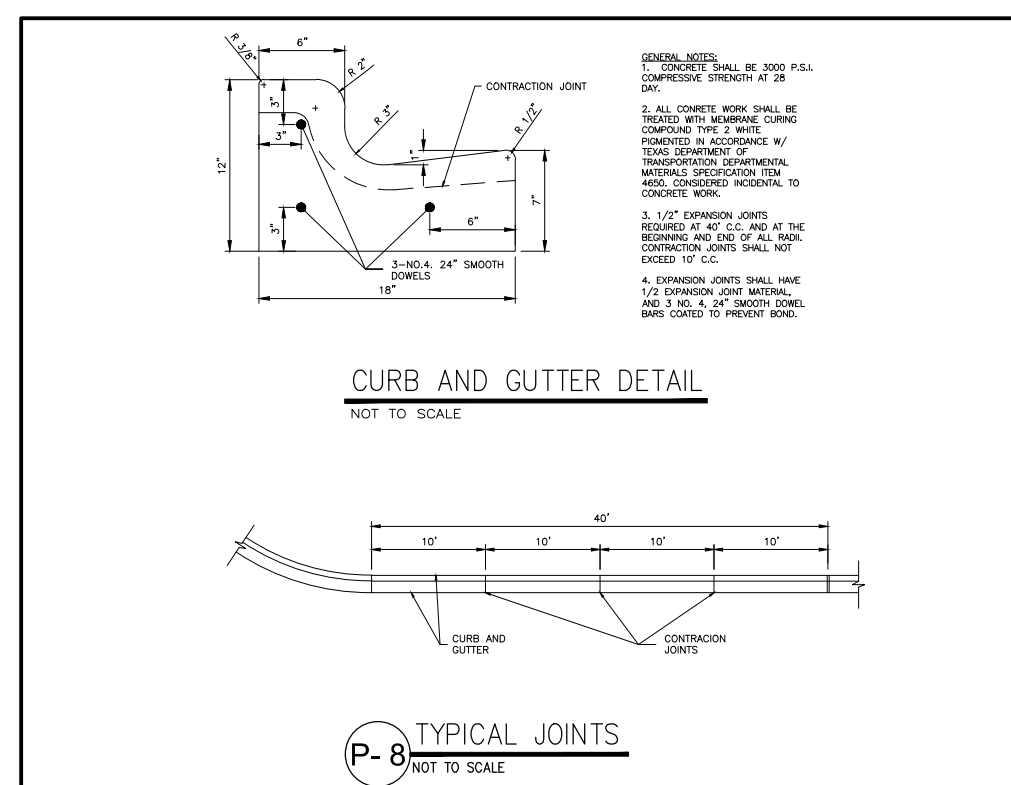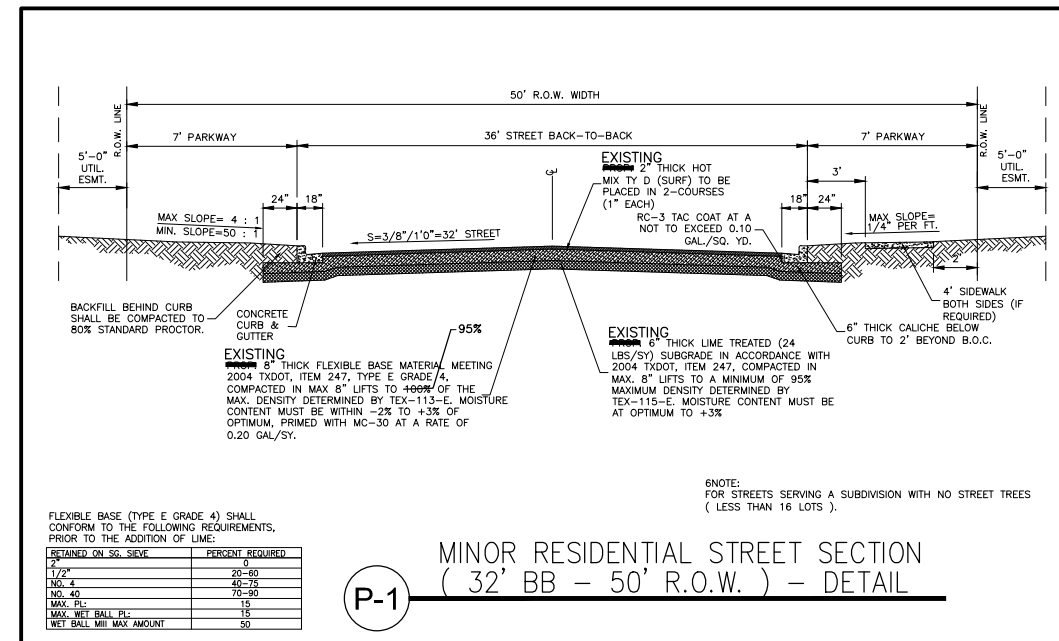

DETENTION REQUIRED = 27,952 C.F.
DETENTION PROVIDED = 28,435 C.F.

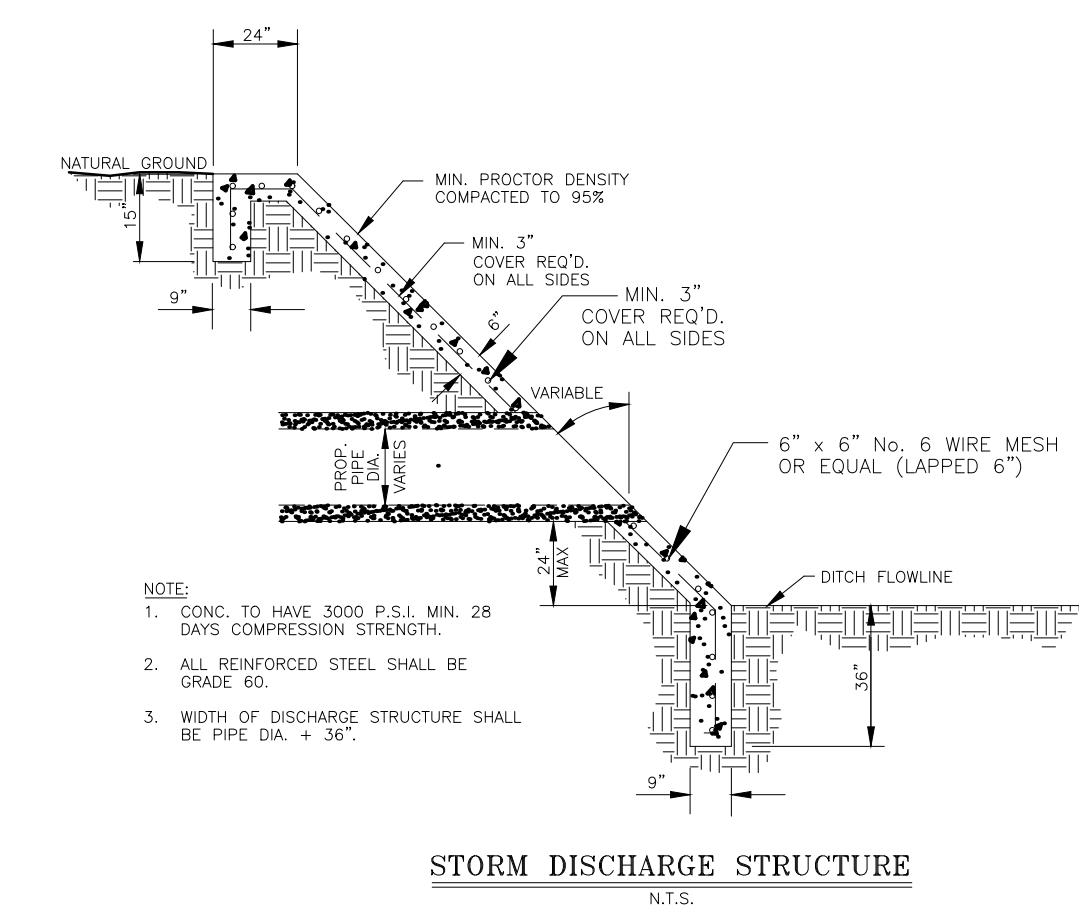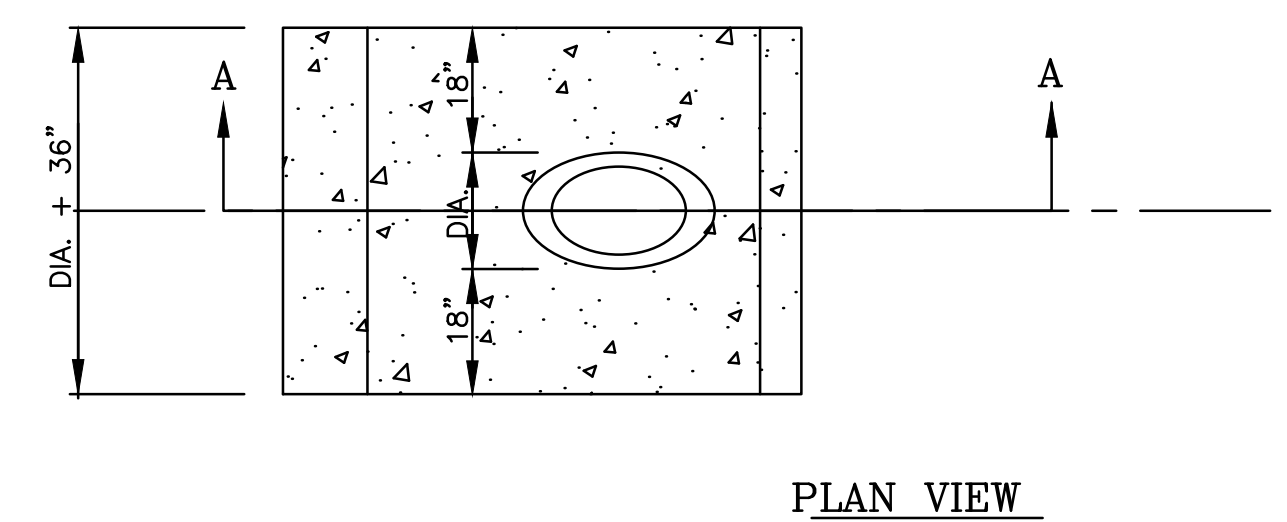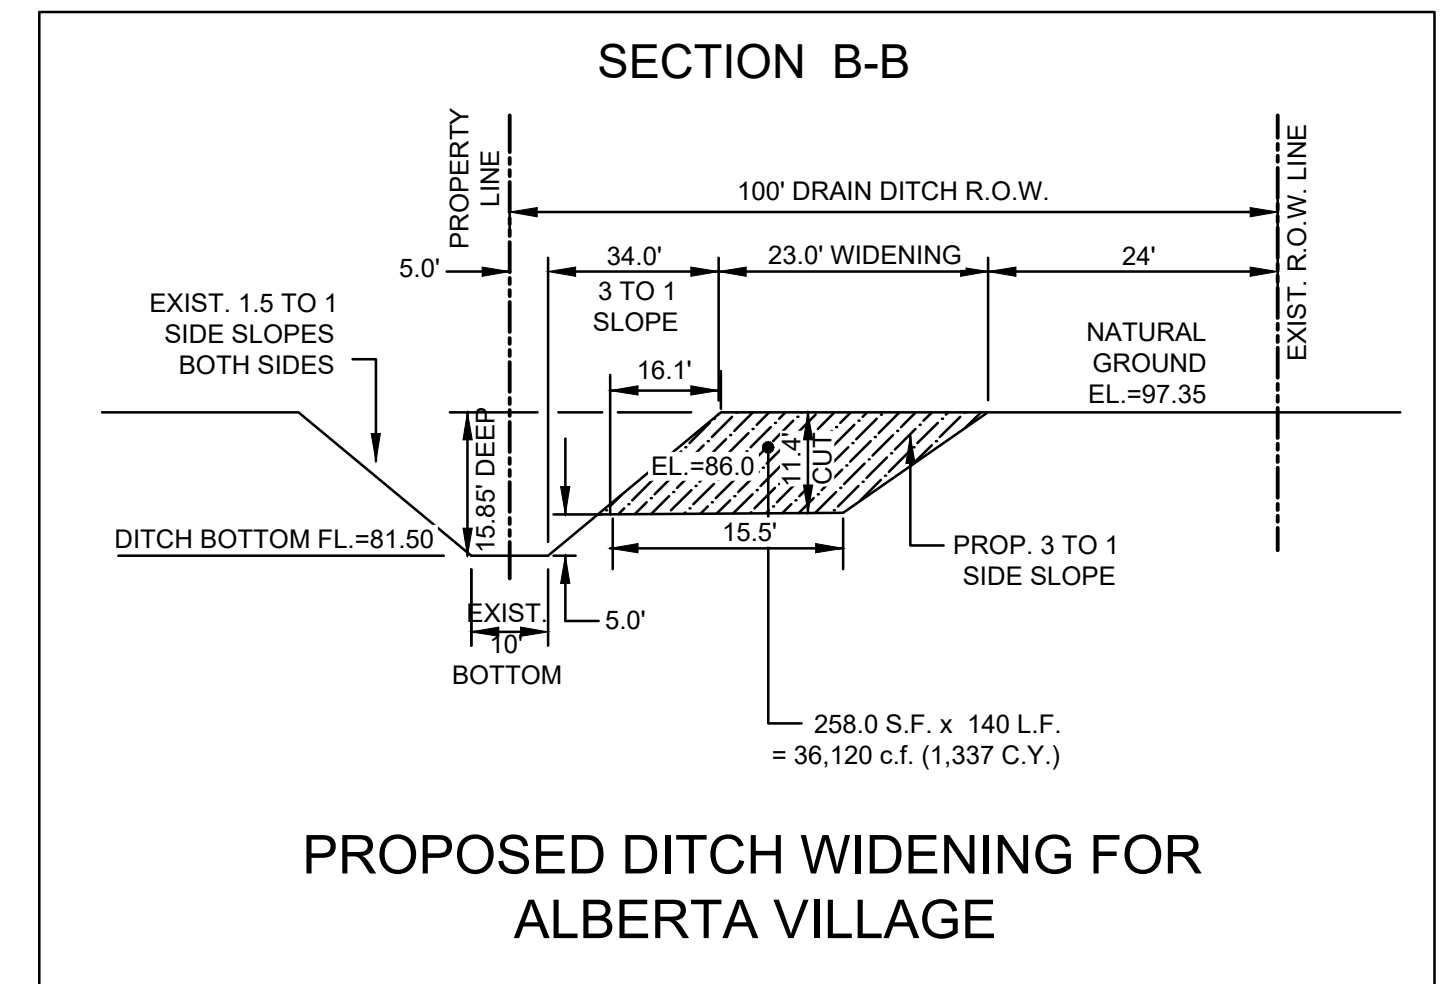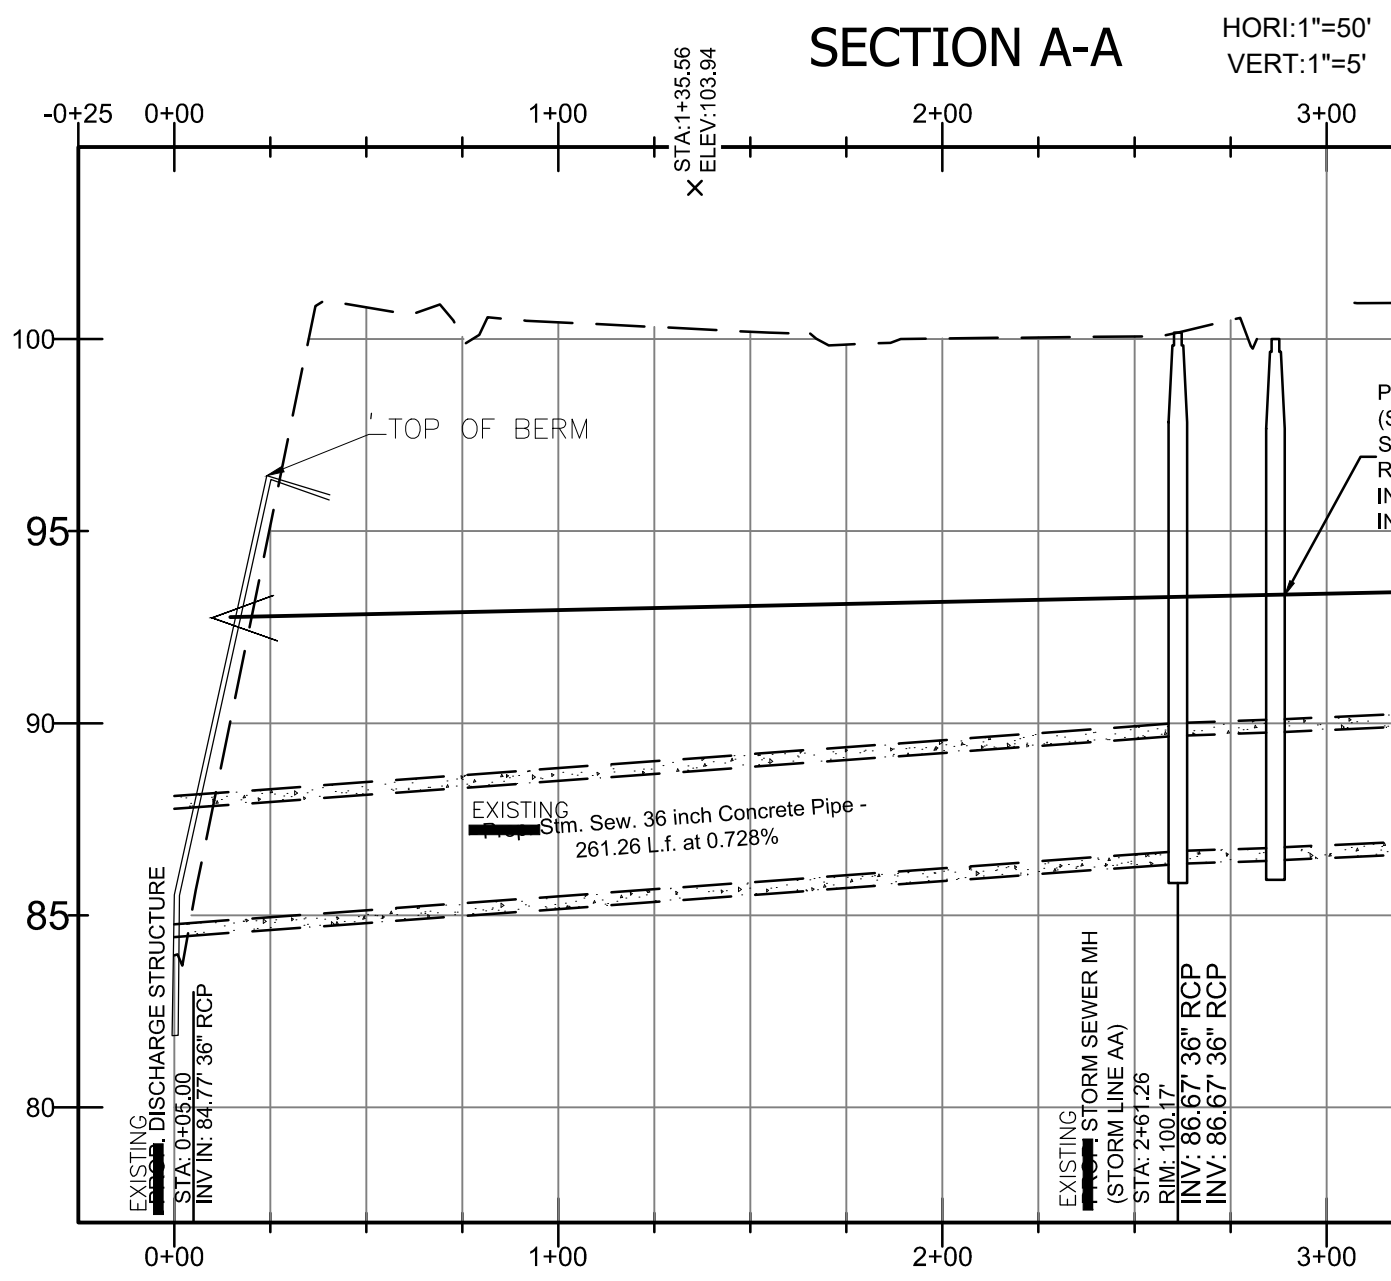

H.C.D.D.#1 STORM DISCHARGE STRUCTURE