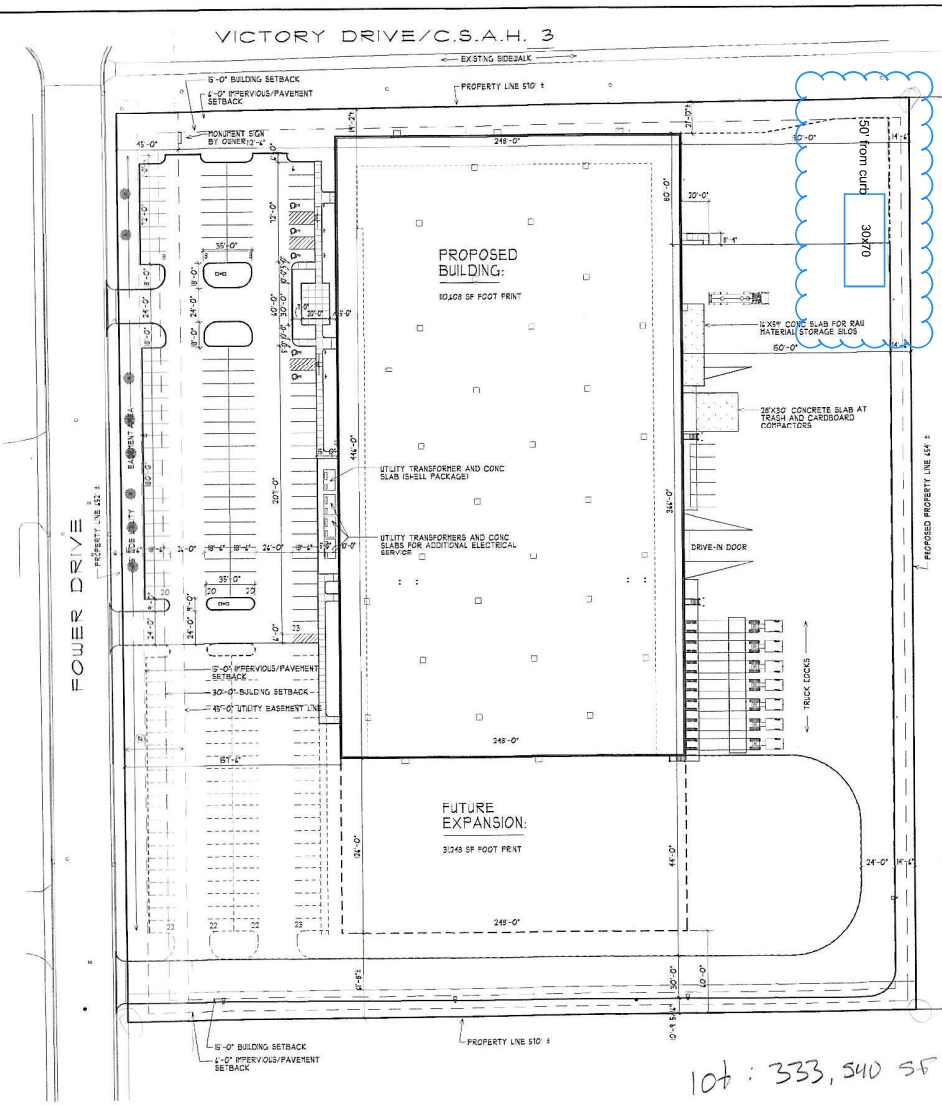

lot : 333,540 SF

Building : 90,768
storage : 2100
total : 92,868 SF

SITE PLAN
SCALE: 1" = 40'-0"

NORTH

DATE	BY
01/11/13	CLR
02/12/13	CLR
04/14/13	CLR/JAC
01/13	CLR/JAC
02/04/13	CLR/JAC
04/24/13	CLR/JAC
10/10/13	CLR/JAC
01/07/14	CLR/JAC
04/01/14	CLR/JAC

REVISIONS
ISSUED FOR BUILDING PLAN PERMIT
ISSUED FOR BUILDING PERMIT
REVISED PER CITY COMMENTS AND ACCEPTED ALTERNATES/OWNER REVISIONS
REVISED SHELL STAIR, EVE WASH STATION TO BE BY OWNER PER CO #17-2
REVISED TO INCLUDE ACCEPTED ALTERNATES/OWNER REVISIONS
REVISED PER CITY COMMENTS AND OWNER REVISIONS
REVISIONS FOR FIRE SUPPRESSION (FOR FOUS USE) TO SPRINKLER LA (OL) MOVED PLUMBING
REVISIONS PER CHANGE ORDER #3 (TT) AND #1 (SHELL)
REVISIONS PER CHANGE ORDER #4 (SHELL)
ISSUED FOR AS BUILT DOCUMENTS

DRAWN BY: JAC
CHECKED: CLR
APPROVED BY: CLR
ISSUE DATE: 03/12/13

PROJECT: PROPOSED NEW FACILITY FOR: IQI POWER DRIVE
MANKATO, MN 56001
CLIENT #12-01-0062

SITE PLAN
TENANT IMPROVEMENTS

APPRO DEVELOPMENT
2976 GRENADA AVE
LAKELAND, MN 55043
PH: 952-461-2171
FAX: 952-461-2173
EMAIL: dfreeman@approdevelopment.com

PROJECT #: 12-01-0062

SHEET
A1-3
TENANT IMPROVEMENTS