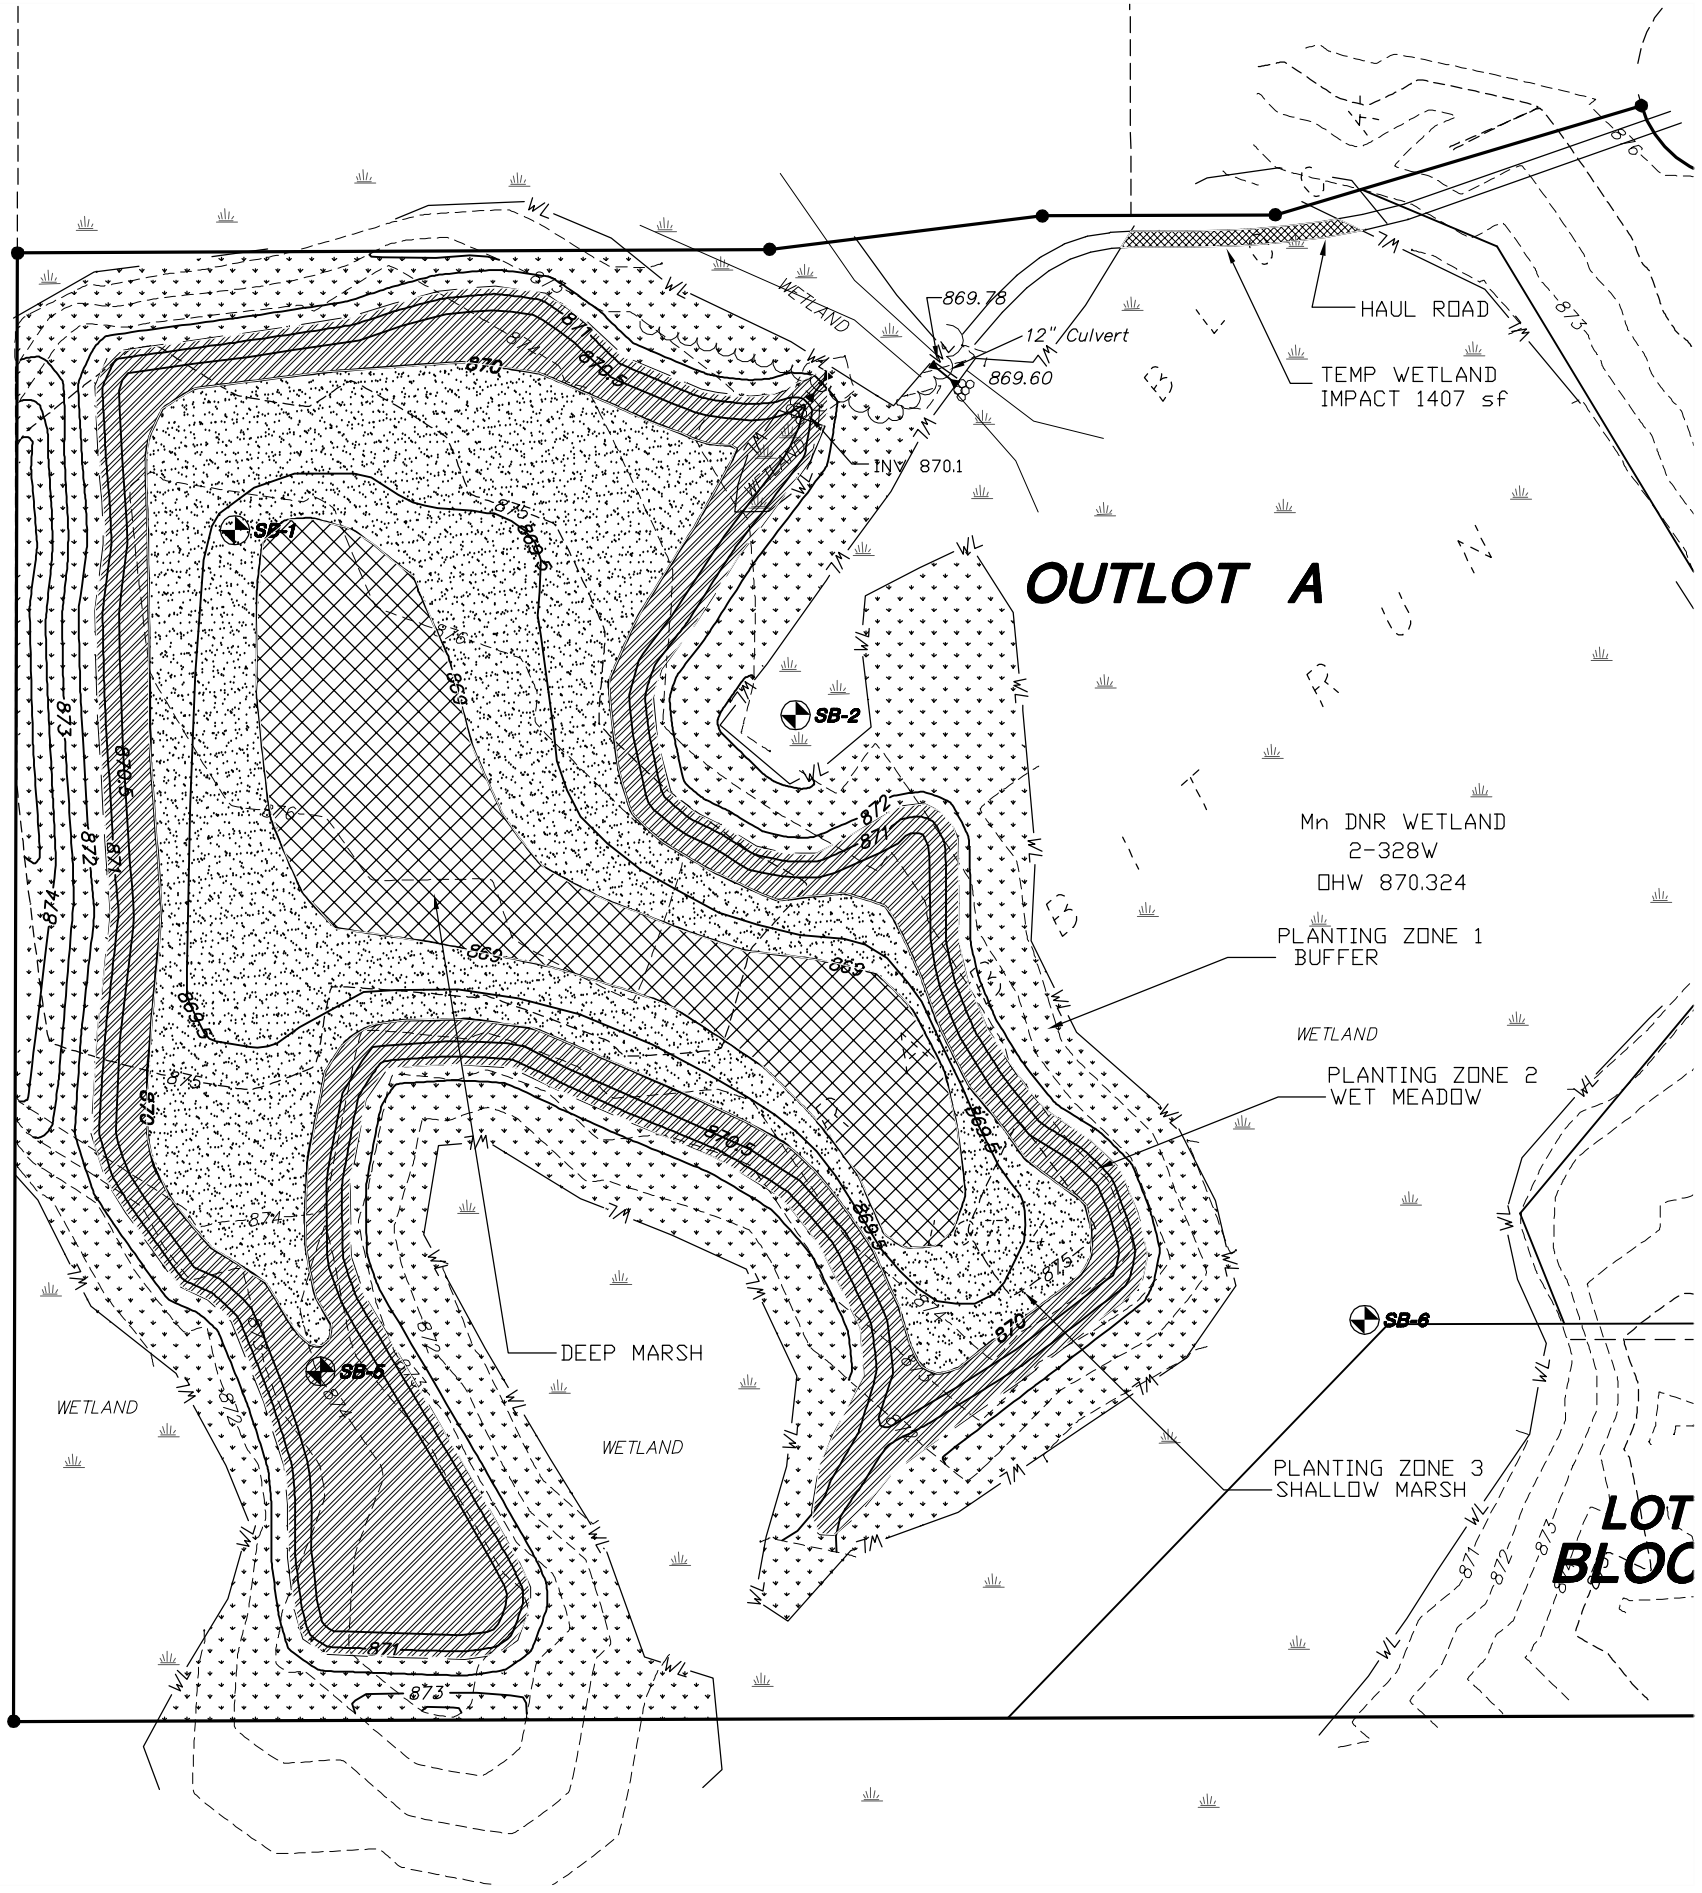

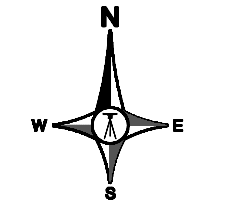

1 INCH = 60 FEET (22" X 34" SHEET)
1 INCH = 120 FEET (11" X 17" SHEET)

PLANTING ZONE 1 BUFFER	4.07 AC	ABOVE ELEV 871.5
PLANTING ZONE 2 WET MEADOW	2.55 AC	ELEV 870.5 to 871.5
PLANTING ZONE 3 SHALLOW MARSH	3.02 AC	ELEV 869.0 to 870.5
PLANTING ZONE 4 DEEP MARSH	1.26 AC	BELOW ELEV 869.0

DATE	REVISIONS	BY
	RECORD DRAWING	

ANDERSON PASSE & ASSOCIATES

ELMCREST SANCTUARY

END USE PLAN

RAMSEY, MINNESOTA

I HEREBY CERTIFY THAT THIS PLAN, SPECIFICATION, OR REPORT WAS PREPARED BY ME OR UNDER MY DIRECT SUPERVISION AND THAT I AM A DULY LICENSED PROFESSIONAL ENGINEER UNDER THE LAWS OF THE STATE OF MINNESOTA.

DATE 5/29/12 REG. NO. 24019

BRENT RIGNELL

DRAWN	BTR/PJD
DATE	2/15/12
SCALE	1"=60'
PROJECT	03-09
CHECKED	BTR
APPROVED	BTR

MAP 3