N

W E

S

GRAPHIC SCALE

20 0 10 20 40

(IN FEET)

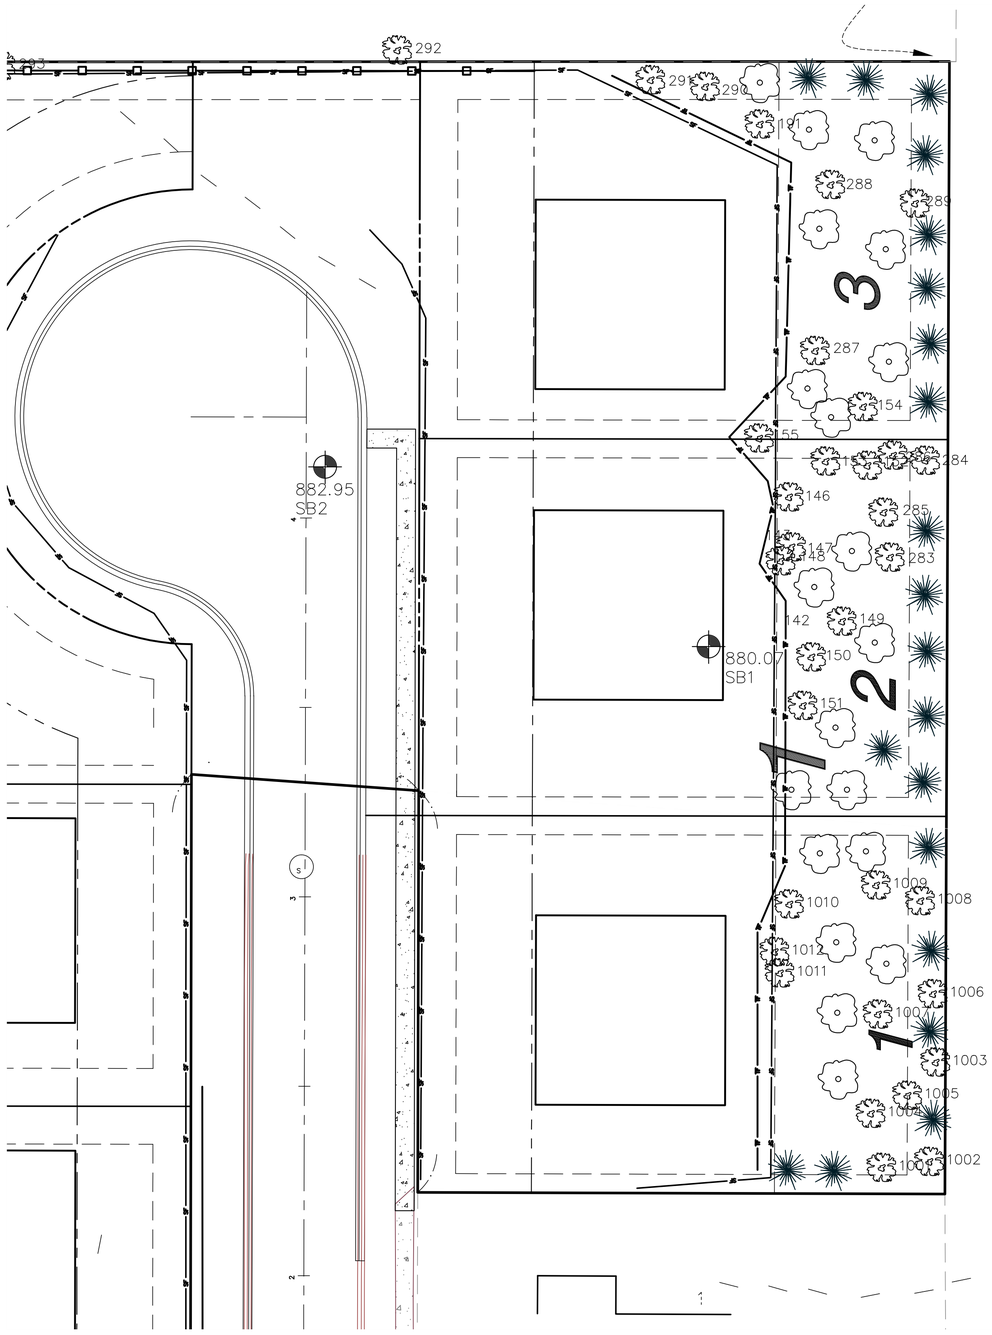

TRANSITION AREA TREES TO BE SAVED

TAG	SPECIES	CAL INCH	GRADE	CONDITION
146	Boxelder	8	3	Unhealthy
147	Boxelder	9	4	
148	Boxelder	8	4	
149	Oak, Red	30	6	
150	Boxelder	13	3	Unhealthy
151	Boxelder	8	4	
152	Boxelder	9	2	Unhealthy
153	Maple, Red	9	2	Unhealthy
154	Boxelder	8	2	Unhealthy
155	Boxelder	8	4	
191	Oak, Bur	23	6	
283	Cherry, Black	8	5	
284	Boxelder	10	4	
285	Boxelder	9	4	
286	Elm, American	10	4	
287	Boxelder	8	4	
288	Boxelder	8	2	Unhealthy
289	Boxelder	9	2	Unhealthy
290	Oak, Bur	10	5	
291	Boxelder	8	4	
1001	Boxelder	8	3	Unhealthy
1002	Ash, Green	21	4	
1003	Boxelder	13	4	
1004	Boxelder	11	3	Unhealthy
1005	Boxelder	22	3	Unhealthy
1006	Cherry, Black	9	3	Unhealthy
1007	Boxelder	9	4	
1008	Hackberry	18	5	
1009	Cherry, Black	16	5	
1010	Oak, Pin	10	3	Unhealthy
1011	Oak, Pin	17	3	stems, unhealt
1012	Oak, Pin	19	3	Unhealthy
32		386		

PROPOSED CONIFEROUS TREES /QTY

DENOTES BLACK HILLS SPRUCE (PICEA GLAUCA DENSATA) — *20 EACH*

PROPOSED ORNAMENTAL TREES /QTY

DENOTES FLOWERING CRAB TREE — *20 EACH*

EXISTING OVERSTORY TREES /QTY

DENOTES DECIDUOUS TREE — *32 EACH*

LINE TYPE & SYMBOL LEGEND

- SB-5 — *DENOTES SOIL BORING*
- *CURB & GUTTER (SURMOUNTABLE)*
- TF — *TREE FENCE*
- SF — *SILT FENCE*
- *SETBACK*
- *EASEMENT*
- *LOT LINE*
- *R/W*
- *CENTERLINE*

DATE	REVISIONS	BY

RECORD DRAWING

ROSHELL ENGINEERING, LLC
6192 267 TH CT WYOMING, MN 55092
PHONE: 763.286.0521

ESTATES OF SILVER OAKS
2ND ADDITION
TRANSITION AREA PLANTINGS
RAMSEY, MINNESOTA

I HEREBY CERTIFY THAT THIS PLAN, SPECIFICATION, OR REPORT WAS PREPARED BY ME OR UNDER MY DIRECT SUPERVISION AND THAT I AM A DULY LICENSED PROFESSIONAL ENGINEER UNDER THE LAWS OF THE STATE OF MINNESOTA.

DATE 8/29/2017 *REG. NO. 24039*

BRENT ROSHELL

DRAWN	BR
DATE	6/27/17
SCALE	AS SHOWN
PROJECT	RE10-17
CHECKED	BTR
APPROVED	BTR

L2