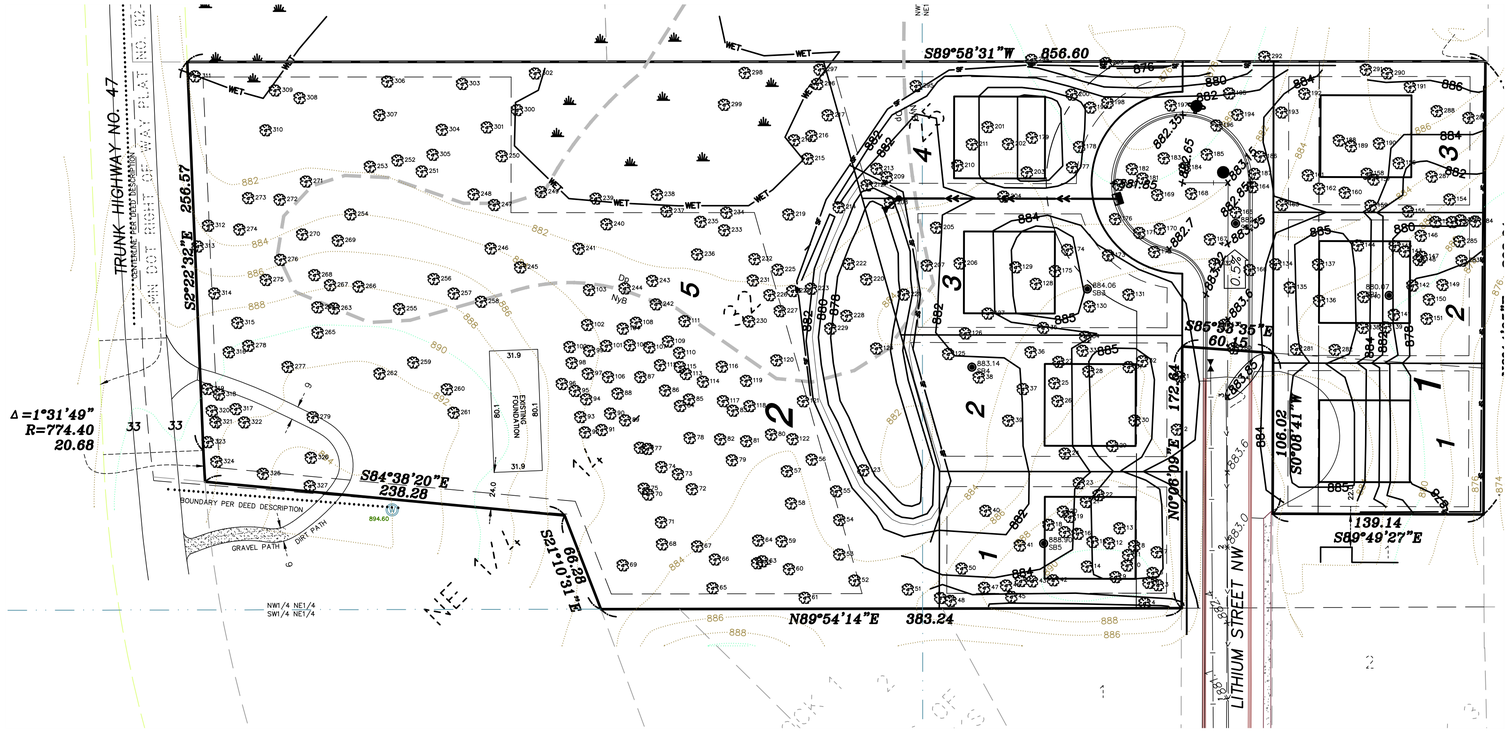

NOTE: TREES TO REMAIN SHALL BE PROTECTED FROM CONSTRUCTION ACTIVITY BY MEANS OF FENCING OR OTHER APPROVED METHOD.

TREES SAVED (174)

50	Boxelder	17
51	Ash, Green	11
53	Elm, Siberian	10
54	Boxelder	9
55	Boxelder	8
56	Boxelder	10
57	Ash, Green	14
58	Cherry, Black	9
59	Boxelder	13
60	Boxelder	14
61	Elm, American	20
62	Boxelder	13
63	Elm, American	8
64	Boxelder	14
65	Elm, Siberian	9
66	Elm, American	9
67	Elm, American	9
68	Boxelder	12
69	Boxelder	17
70	Elm, American	9
71	Boxelder	12
72	Elm, Siberian	9
73	Boxelder	8
74	Boxelder	9
75	Boxelder	10
76	Boxelder	13
77	Boxelder	9
78	Elm, Siberian	12
79	Oak, Red	24
80	Boxelder	21
81	Boxelder	15
82	Boxelder	16
83	Elm, Siberian	10
84	Elm, Siberian	12
85	Elm, Siberian	11
86	Elm, Siberian	8
87	Elm, Siberian	8
88	Elm, Siberian	8
89	Elm, Siberian	9
90	Elm, Siberian	13
91	Elm, Siberian	13
92	Elm, Siberian	13
93	Elm, Siberian	10
94	Elm, Siberian	18
95	Elm, Siberian	11
96	Elm, Siberian	8
97	Elm, Siberian	8
98	Elm, Siberian	9
99	Elm, Siberian	9
100	Elm, Siberian	15
101	Elm, Siberian	9
102	Elm, Siberian	14
103	Elm, Siberian	17
104	Elm, Siberian	8
105	Elm, Siberian	8
106	Elm, Siberian	10
107	Elm, Siberian	10
108	Elm, Siberian	9
109	Elm, Siberian	9
110	Elm, Siberian	9
111	Elm, Siberian	15
112	Elm, Siberian	10
113	Elm, Siberian	10
114	Elm, Siberian	9
115	Elm, Siberian	8
116	Elm, Siberian	11
117	Elm, Siberian	8
118	Elm, Siberian	12
119	Elm, Siberian	11
120	Elm, Siberian	9
121	Boxelder	9
122	Boxelder	10
215	Oak, Red	10
216	Cedar, Red	7
217	Cedar, Red	11
218	Oak, Red	7
219	Oak, Red	7
224	Elm, American	9
225	Oak, Red	13
226	Boxelder	8
227	Boxelder	8
230	Elm, Siberian	12
231	Elm, American	11
232	Boxelder	11
233	Elm, Siberian	16
234	Elm, American	10
235	Elm, Siberian	10
236	Elm, American	8
237	Elm, Siberian	10
238	Boxelder	10
239	Oak, Bur	6
240	Elm, Siberian	13
241	Elm, Siberian	19
242	Elm, Siberian	8
243	Elm, Siberian	12
244	Elm, Siberian	9
245	Elm, Siberian	20
246	Elm, Siberian	19
247	Boxelder	11
248	Boxelder	8
249	Aspen	12
250	Ash, Green	8
251	Elm, American	13
252	Elm, American	8
253	Oak, Bur	33
254	Elm, Siberian	25
255	Boxelder	19
256	Ash, Green	10
257	Boxelder	12
258	Elm, Siberian	18
259	Boxelder	12
260	Elm, American	9
261	Boxelder	8
262	Boxelder	10
263	Hackberry	10
264	Elm, Siberian	13
265	Ash, Green	12
266	Elm, Siberian	19
267	Elm, Siberian	8
268	Elm, Siberian	8
269	Elm, Siberian	12
270	Elm, American	16
271	Elm, Siberian	12
272	Elm, Siberian	11
273	Oak, Bur	32
274	Elm, American	10
275	Elm, Siberian	17
276	Elm, Siberian	9
277	Pine, Ponderosa	17
278	Oak, Bur	33
279	Elm, Siberian	10
280	Oak, Red	12
281	Maple, Red	12
282	Oak, Red	12
290	Oak, Bur	10
291	Boxelder	8
292	Oak, Bur	12
293	Elm, Siberian	10
294	Hackberry	8
295	Oak, Bur	26
296	Aspen	8
297	Aspen	9
298	Aspen	14
299	Aspen	8
300	Ash, Green	9
301	Ash, Green	8
302	Oak, Bur	7
303	Ash, Green	9
304	Oak, Bur	36
305	Elm, American	8
306	Oak, Bur	30
307	Elm, American	9
308	Oak, Bur	35
309	Ash, Green	9
310	Oak, Bur	27
311	Aspen	9
312	Oak, Bur	28
313	Oak, Bur	29
314	Oak, Red	8
315	Oak, Red	10
316	Cedar, Red	7
317	Cedar, Red	7
318	Cedar, Red	6
319	Cedar, Red	10
320	Cedar, Red	8
321	Cedar, Red	9
322	Oak, Bur	12
323	Oak, Bur	39
324	Oak, Bur	15
325	Oak, Bur	25
326	Maple, Silver	36
327	Pine, Ponderosa	13

TREES REMOVED (153)

1	Boxelder	12
2	Cherry, Black	11
3	Oak, Red	6
4	Oak, Red	16
5	Oak, Red	10
6	Oak, Red	4
7	Oak, Red	7
8	Oak, Red	5
9	Oak, Red	10
10	Oak, Red	7
11	Oak, Red	12
12	Oak, Red	11
13	Oak, Red	6
14	Oak, Red	22
15	Oak, Red	22
16	Oak, Red	8
17	Oak, Red	11
18	Oak, Red	19
19	Oak, Red	17
20	Oak, Red	14
21	Oak, Red	17
22	Cedar, Red	6
23	Oak, Red	14
24	Oak, Red	20
25	Oak, Bur	21
26	Oak, Bur	10
27	Oak, Bur	12
28	Oak, Bur	16
29	Oak, Bur	28
30	Ash, Green	9
31	Oak, Bur	20
32	Boxelder	13
33	Boxelder	11
34	Oak, Bur	20
35	Oak, Bur	14
36	Ash, Green	14
37	Oak, Bur	15
38	Oak, Bur	18
39	Oak, Red	12
40	Oak, Red	11
41	Oak, Red	17
42	Oak, Red	5
43	Cedar, Red	8
44	Oak, Red	4
45	Oak, Bur	5
46	Oak, Red	4
47	Oak, Red	6
50	Boxelder	17
123	Boxelder	8
124	Oak, Bur	23
125	Ash, Green	9
126	Oak, Bur	17
127	Boxelder	9
128	Hackberry	14
129	Cherry, Black	10
130	Oak, Bur	16
131	Oak, Bur	12
132	Oak, Bur	16
133	Boxelder	10
134	Boxelder	9
135	Cherry, Black	10
136	Elm, American	8
137	Boxelder	13
138	Cherry, Black	11
139	Boxelder	12
140	Boxelder	9
141	Boxelder	9
142	Cedar, Red	14
143	Boxelder	15
144	Oak, Bur	19
145	Ash, Green	10
146	Boxelder	8
147	Boxelder	9
148	Boxelder	8
149	Oak, Red	30
150	Boxelder	13
151	Boxelder	8
152	Boxelder	9
153	Maple, Red	9
154	Boxelder	8
155	Boxelder	8
156	Oak, Bur	21
157	Cedar, Red	9
158	Ash, Green	9
159	Cedar, Red	13
160	Oak, Red	14
161	Boxelder	18
162	Cedar, Red	7
163	Oak, Bur	17
164	Boxelder	13
165	Boxelder	8
166	Boxelder	8
167	Boxelder	8
168	Oak, Bur	21
169	Oak, Bur	17
170	Oak, Bur	11
171	Ash, Green	9
172	Elm, American	9
173	Cherry, Black	8
174	Oak, Bur	27
175	Elm, American	12
176	Boxelder	8
177	Boxelder	10
178	Boxelder	8
179	Boxelder	9
180	Oak, Red	7
181	Oak, Red	10
182	Oak, Red	16
183	Elm, American	10
184	Oak, Bur	16
185	Oak, Bur	23
186	Boxelder	9
187	Boxelder	13
188	Boxelder	8
189	Cedar, Red	4
190	Boxelder	11
191	Oak, Bur	23
192	Oak, Bur	23
193	Oak, Bur	18
194	Oak, Bur	15
195	Oak, Bur	18
196	Oak, Bur	20
197	Oak, Bur	18
198	Oak, Red	6
199	Oak, Red	8
200	Boxelder	10
201	Boxelder	10
202	Boxelder	9
203	Ash, Green	13
204	Oak, Bur	27
205	Oak, Bur	20
206	Ash, Green	8
207	Elm, American	15
208	Oak, Bur	30
209	Elm, American	12
210	Ash, Green	8
211	Oak, Red	7
212	Aspen	14
213	Ash, Green	8
214	Oak, Red	10
220	Oak, Bur	28
221	Oak, Bur	20
222	Boxelder	8
223	Oak, Red	20
228	Cherry, Black	11
229	Oak, Red	12
283	Cherry, Black	8
284	Boxelder	10
285	Boxelder	9
286	Elm, American	10
287	Boxelder	8
288	Boxelder	8
289	Boxelder	9

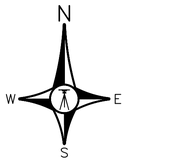

GRAPHIC SCALE

50 0 25 50 100

(IN FEET)

LINE TYPE & SYMBOL LEGEND

- FLARED END SECTION
- STORM SEWER
- SB-5 — DENOTES SOIL BORING
- W — PROPOSED WELL LOC.
- EXIST TREE LINE
- TF — TREE FENCE
- SF — SILT FENCE
- PROPOSED CONTOUR
- EXIST CONTOUR
- SETBACK
- EASEMENT
- LOT LINE
- R/W
- EDGE OF BITUMINOUS
- CENTERLINE

TREE PROTECTION FENCE SHALL BE INSTALLED AND THE LOCATION APPROVED BY THE CITY BEFORE COMMENCEMENT OF OTHER WORK, INCLUDING SILT FENCE INSTALLATION.

AN ARBORIST SHALL BE CONSULTED TO DEVELOP A PLAN TO PROTECT EXISTING OAK TREES FROM OAK WILT.

ANY CLEARING OF OAK TREES SHALL BE PERFORMED PRIOR TO APRIL 15TH OR AFTER JULY 15TH TO MINIMIZE EXPOSURE OR INTRODUCTION OF OAK WILT.

BY | REVISIONS | DATE

RECORD DRAWING

ROSHELL ENGINEERING, LLC
6192 267 TH CT WYOMING, MN 55092
PHONE: 763.286.0521

SILVER OAKS 2ND ADDITION

TREE PLAN

RAMSEY, MINNESOTA

I HEREBY CERTIFY THAT THIS PLAN, SPECIFICATION, OR REPORT WAS PREPARED BY ME OR UNDER MY DIRECT SUPERVISION AND THAT I AM A DULY LICENSED PROFESSIONAL ENGINEER UNDER THE LAWS OF THE STATE OF MINNESOTA.

DATE 5/4/17 REG. NO. 24013

BRENT ROSHELL

DRAWN	BR
DATE	5/2/17
SCALE	1"=50'
PROJECT	RE10-17
CHECKED	BTR
APPROVED	BTR

T1